

THE SCHOOL DISTRICT OF PHILADELPHIA  
SCHOOL REFORM COMMISSION  
Office of Capital Programs  
440 North Broad Street, Third Floor – Suite 371  
Philadelphia, PA 19130-4015

TELEPHONE: (215) 400-4730

**Addendum No. 2**

**Subject:** JOSEPH PENNELL ELEMENTARY SCHOOL  
FIRE ALARM REPLACEMENT  
SDP CONTRACT NO. B-001C OF 2017/2018

**Location:** JOSEPH PENNELL ELEMENTARY SCHOOL  
1800 WEST NEDRO AVENUE  
PHILADELPHIA, PA 19141

---

This Addendum, **dated 23<sup>rd</sup> of January 2018**, shall modify and become part of the Contract Documents for the work of this project. Any items not mentioned herein, or affected by, shall be performed strictly in accordance with the original documents.

---

**1. Revised Drawings**

- 1.1. E000: See attached sketch ECKS-1.
- 1.2. E100.1: See attached sketch ECKS-2.
- 1.3. E100.2: See attached sketch ECKS-3.
- 1.4. E101: See attached sketch ECKS-4.

**2. Reissued Drawings:**

- 2.1. E105: See attached.

END OF ADDENDUM NO. 2 NARRATIVE.  
REFERENCED DRAWINGS FOLLOW.

---


12. FIRE ALARM SYSTEM RISER SHOWN ON THIS DRAWING IS TYPICAL ONLY & IT MAY NOT INDICATE ALL PERIPHERAL DEVICES; REFER TO THE PLANS FOR LOCATIONS & QUANTITIES OF THE ALL PERIPHERAL DEVICES. PLANS & FIRE ALARM SYSTEM RISER MAY NOT INDICATE ALL REQUIRED POWER BOOSTER PANELS; SUPPLIER SHALL PROVIDE ALL REQUIRED POWER BOOSTER PANELS FOR THE COMPLETE SYSTEM & THE CONTRACTOR SHALL INSTALL & WIRE ALL POWER BOOSTER PANEL FOR THE COMPLETE SYSTEM.



13. CONTRACTOR SHALL PROVIDE THE FOLLOWING SPARE EQUIPMENT/DEVICES TO FURNISH & INSTALL AT ADDITIONAL LOCATIONS IF REQUESTED BY OWNER. CONTRACTOR SHALL INCLUDE THE COST OF INSTALLATION & WIRING FOR ALL SPARE DEVICES/EQUIPMENT IN THE BASE BID.


- A. (15) SMOKE DETECTORS
- B. (5) HEAT DETECTORS, ADDRESSABLE COMBINATION TYPE
- C. (2) HEAT DETECTORS, CONVENTIONAL COMBINATION TYPE (FOR HIGH CEILING AREAS)
- D. (1) HEAT DETECTORS, CONVENTIONAL TYPE FIXED HIGH TEMPERATURE SENSOR TYPE 190F DEGREE RATED
- E. (5) MANUAL PULL STATIONS W/ PROTECTIVE COVER & ALARM
- F. (5) COMBINATION HORN/STROBE NOTIFICATION DEVICES
- G. (5) VISUAL STROBE NOTIFICATION DEVICES
- H. (3) WEATHERPROOF HEAT DETECTORS, CONVENTIONAL TYPE FIXED TEMPERATURE

<b>JOSEPH PENNELL ELEMENTARY SCHOOL</b> 1800 NEDRO AVENUE, PHILADELPHIA, PA 19141 FIRE ALARM SYSTEM REPLACEMENT - SCHOOL DISTRICT OF PHILADELPHIA			SPEC. NO. B-001c of 2017/18	LOCATION NO. 6340
			REVISION: ADDENDUM #2	
E000 <small>SHEET REFERENCED</small>	1 <small>REVISION No.</small>	1/23/18 <small>DATE</small>	<b>Princeton Engineering Services, PC</b> 101 Morgan Lane, Suite 205 Plainsboro, NJ 08536	
			DRAWING NO. <b>ECSK-1</b>	

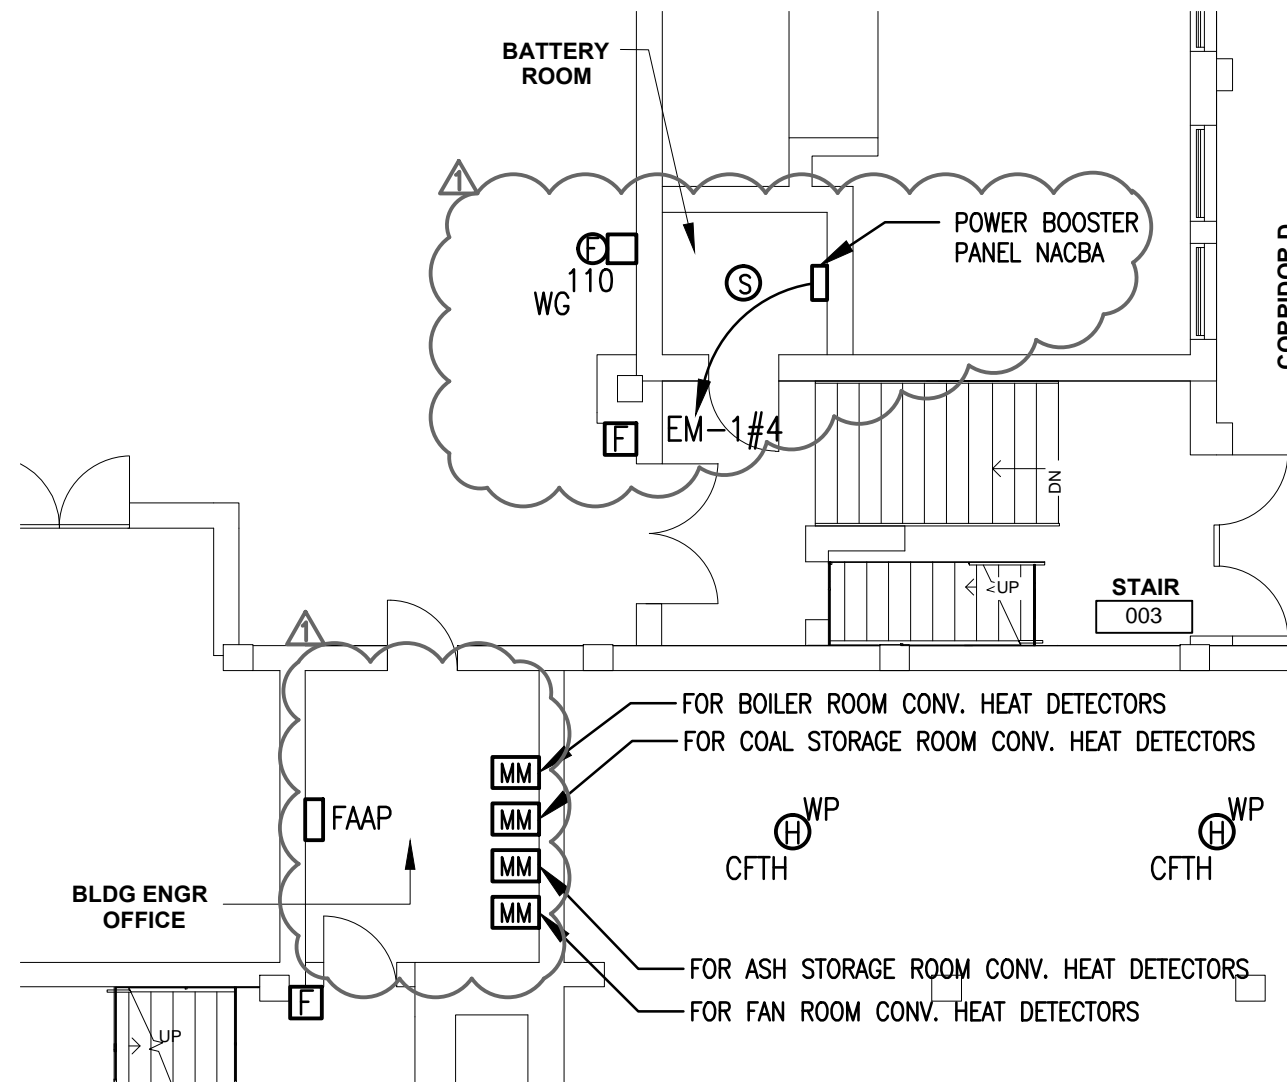


**1**  
**E100.1** **BASEMENT FIRE ALARM PLAN**  
 SCALE: 1/8" = 1'-0"

<b>JOSEPH PENNELL ELEMENTARY SCHOOL</b> 1800 NEDRO AVENUE, PHILADELPHIA, PA 19141 FIRE ALARM SYSTEM REPLACEMENT - SCHOOL DISTRICT OF PHILADELPHIA			SPEC. NO. B-001c of 2017/18	LOCATION NO. 6340
E100.1    1    1/23/18			REVISION: ADDENDUM #2	
SHEET REFERENCED    REVISION No.    DATE			Princeton Engineering Services, PC 101 Morgan Lane, Suite 205 Plainsboro, NJ 08536	
			DRAWING NO. <b>ECSK-2</b>	

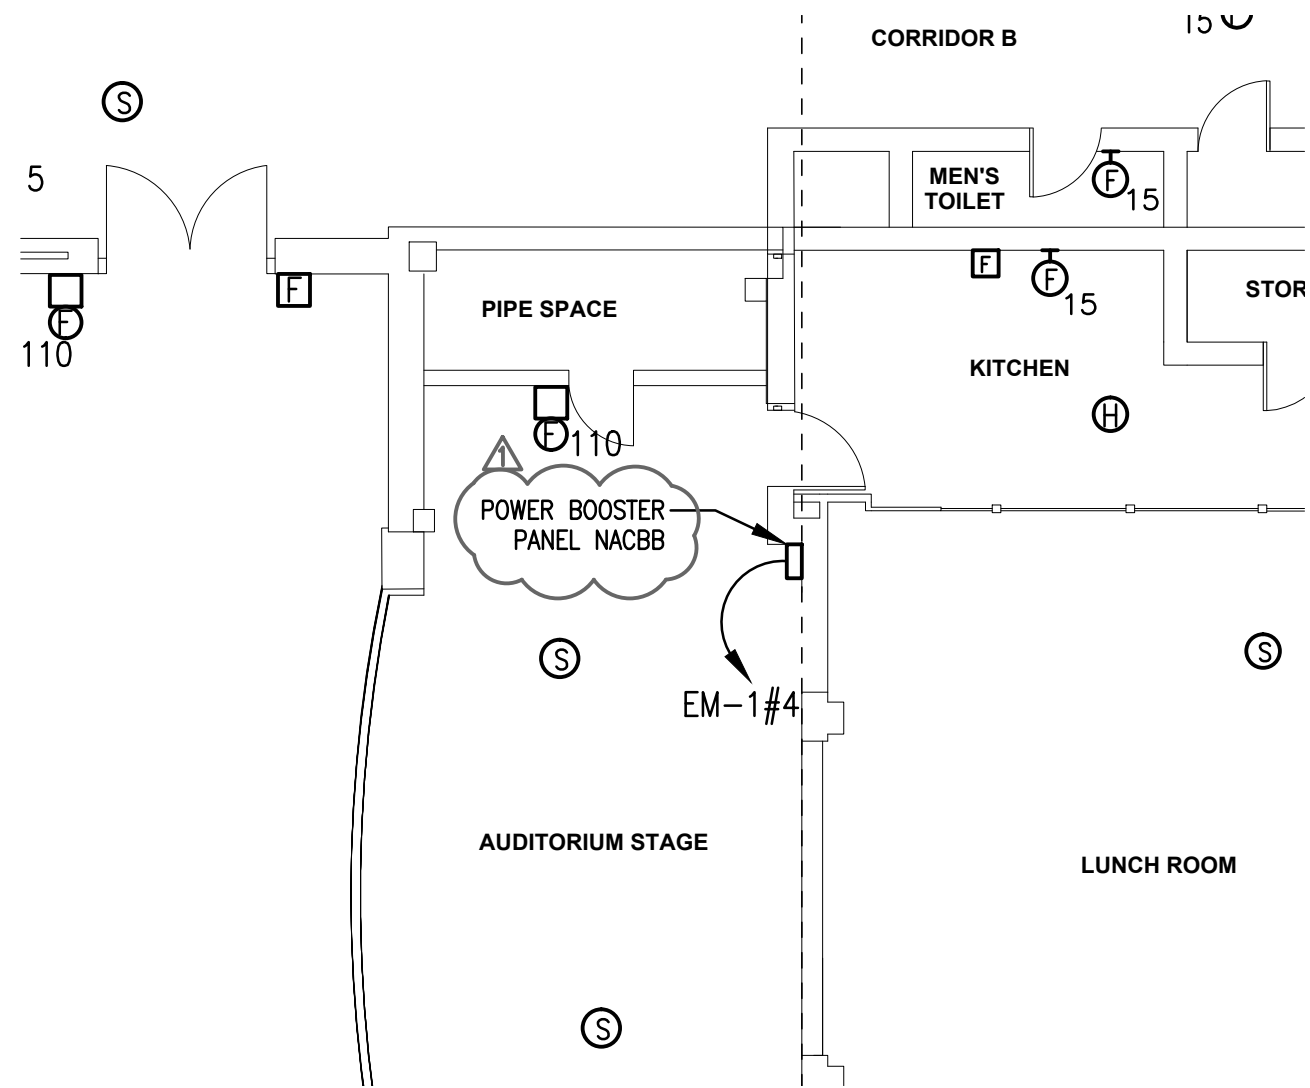

1
E100.2
**GROUND FLOOR FIRE ALARM PLAN - AUDITORIUM**  
 SCALE: 1/8" = 1'-0"

<b>JOSEPH PENNELL ELEMENTARY SCHOOL</b> <small>1800 NEDRO AVENUE, PHILADELPHIA, PA 19141          FIRE ALARM SYSTEM REPLACEMENT - SCHOOL DISTRICT OF PHILADELPHIA</small>			SPEC. NO. B-001c of 2017/18	LOCATION NO. 6340
SHEET REFERENCED: E100.1    REVISION No.: 1    DATE: 1/23/18			REVISION: ADDENDUM #2	
Princeton Engineering Services, PC <small>101 Morgan Lane, Suite 205          Plainsboro, NJ 08536</small>			DRAWING NO. <b>ECSK-3</b>	

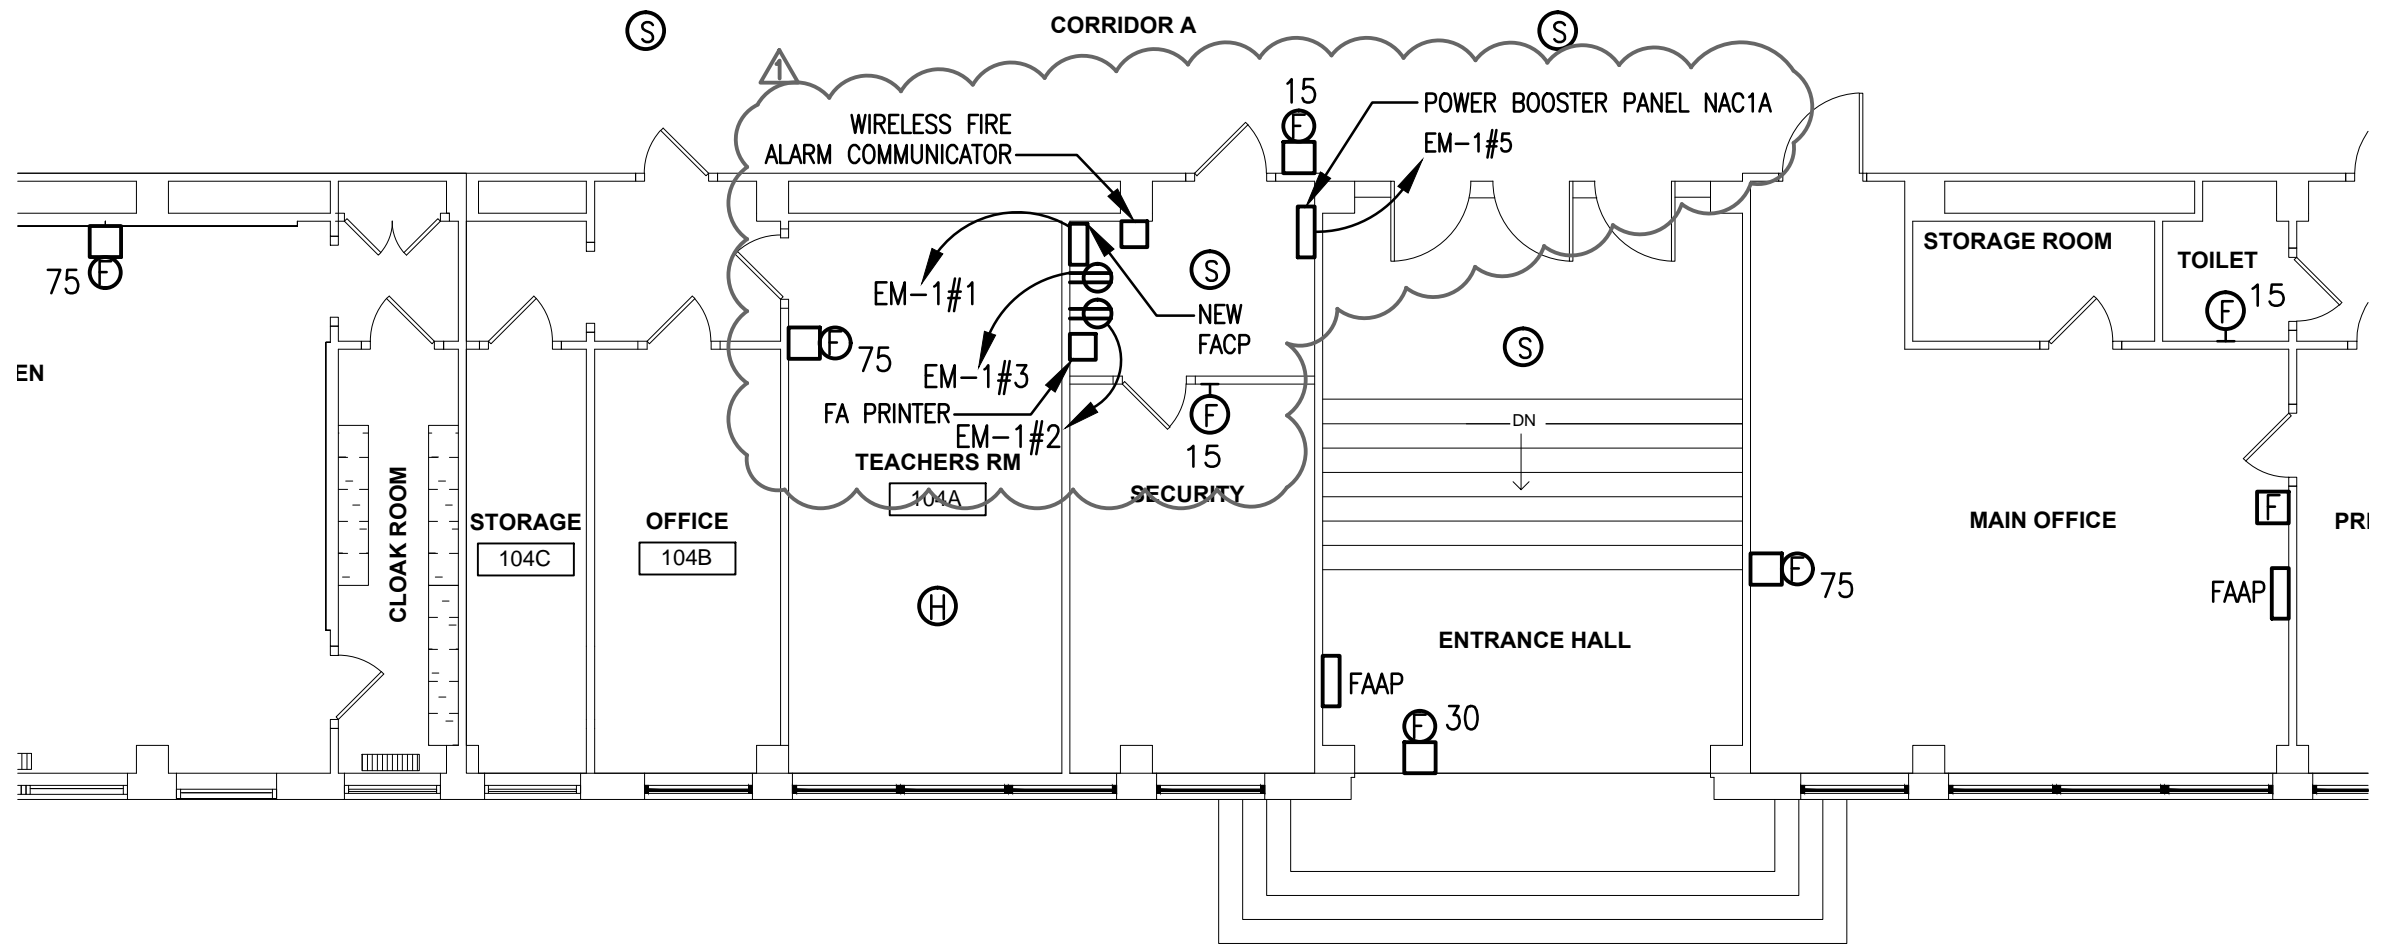

1 FIRST FLOOR FIRE ALARM PLAN  
 E101 SCALE: 1/8" = 1'-0"

<b>JOSEPH PENNELL ELEMENTARY SCHOOL</b> 1800 NEDRO AVENUE, PHILADELPHIA, PA 19141 FIRE ALARM SYSTEM REPLACEMENT - SCHOOL DISTRICT OF PHILADELPHIA			SPEC. NO. B-001c of 2017/18	LOCATION NO. 6340
E101      1      1/23/18			REVISION: ADDENDUM #2	
SHEET REFERENCED      REVISION No.      DATE			Princeton Engineering Services, PC 101 Morgan Lane, Suite 205 Plainsboro, NJ 08536	
			DRAWING NO. <b>ECSK-4</b>	

