


BLDG C

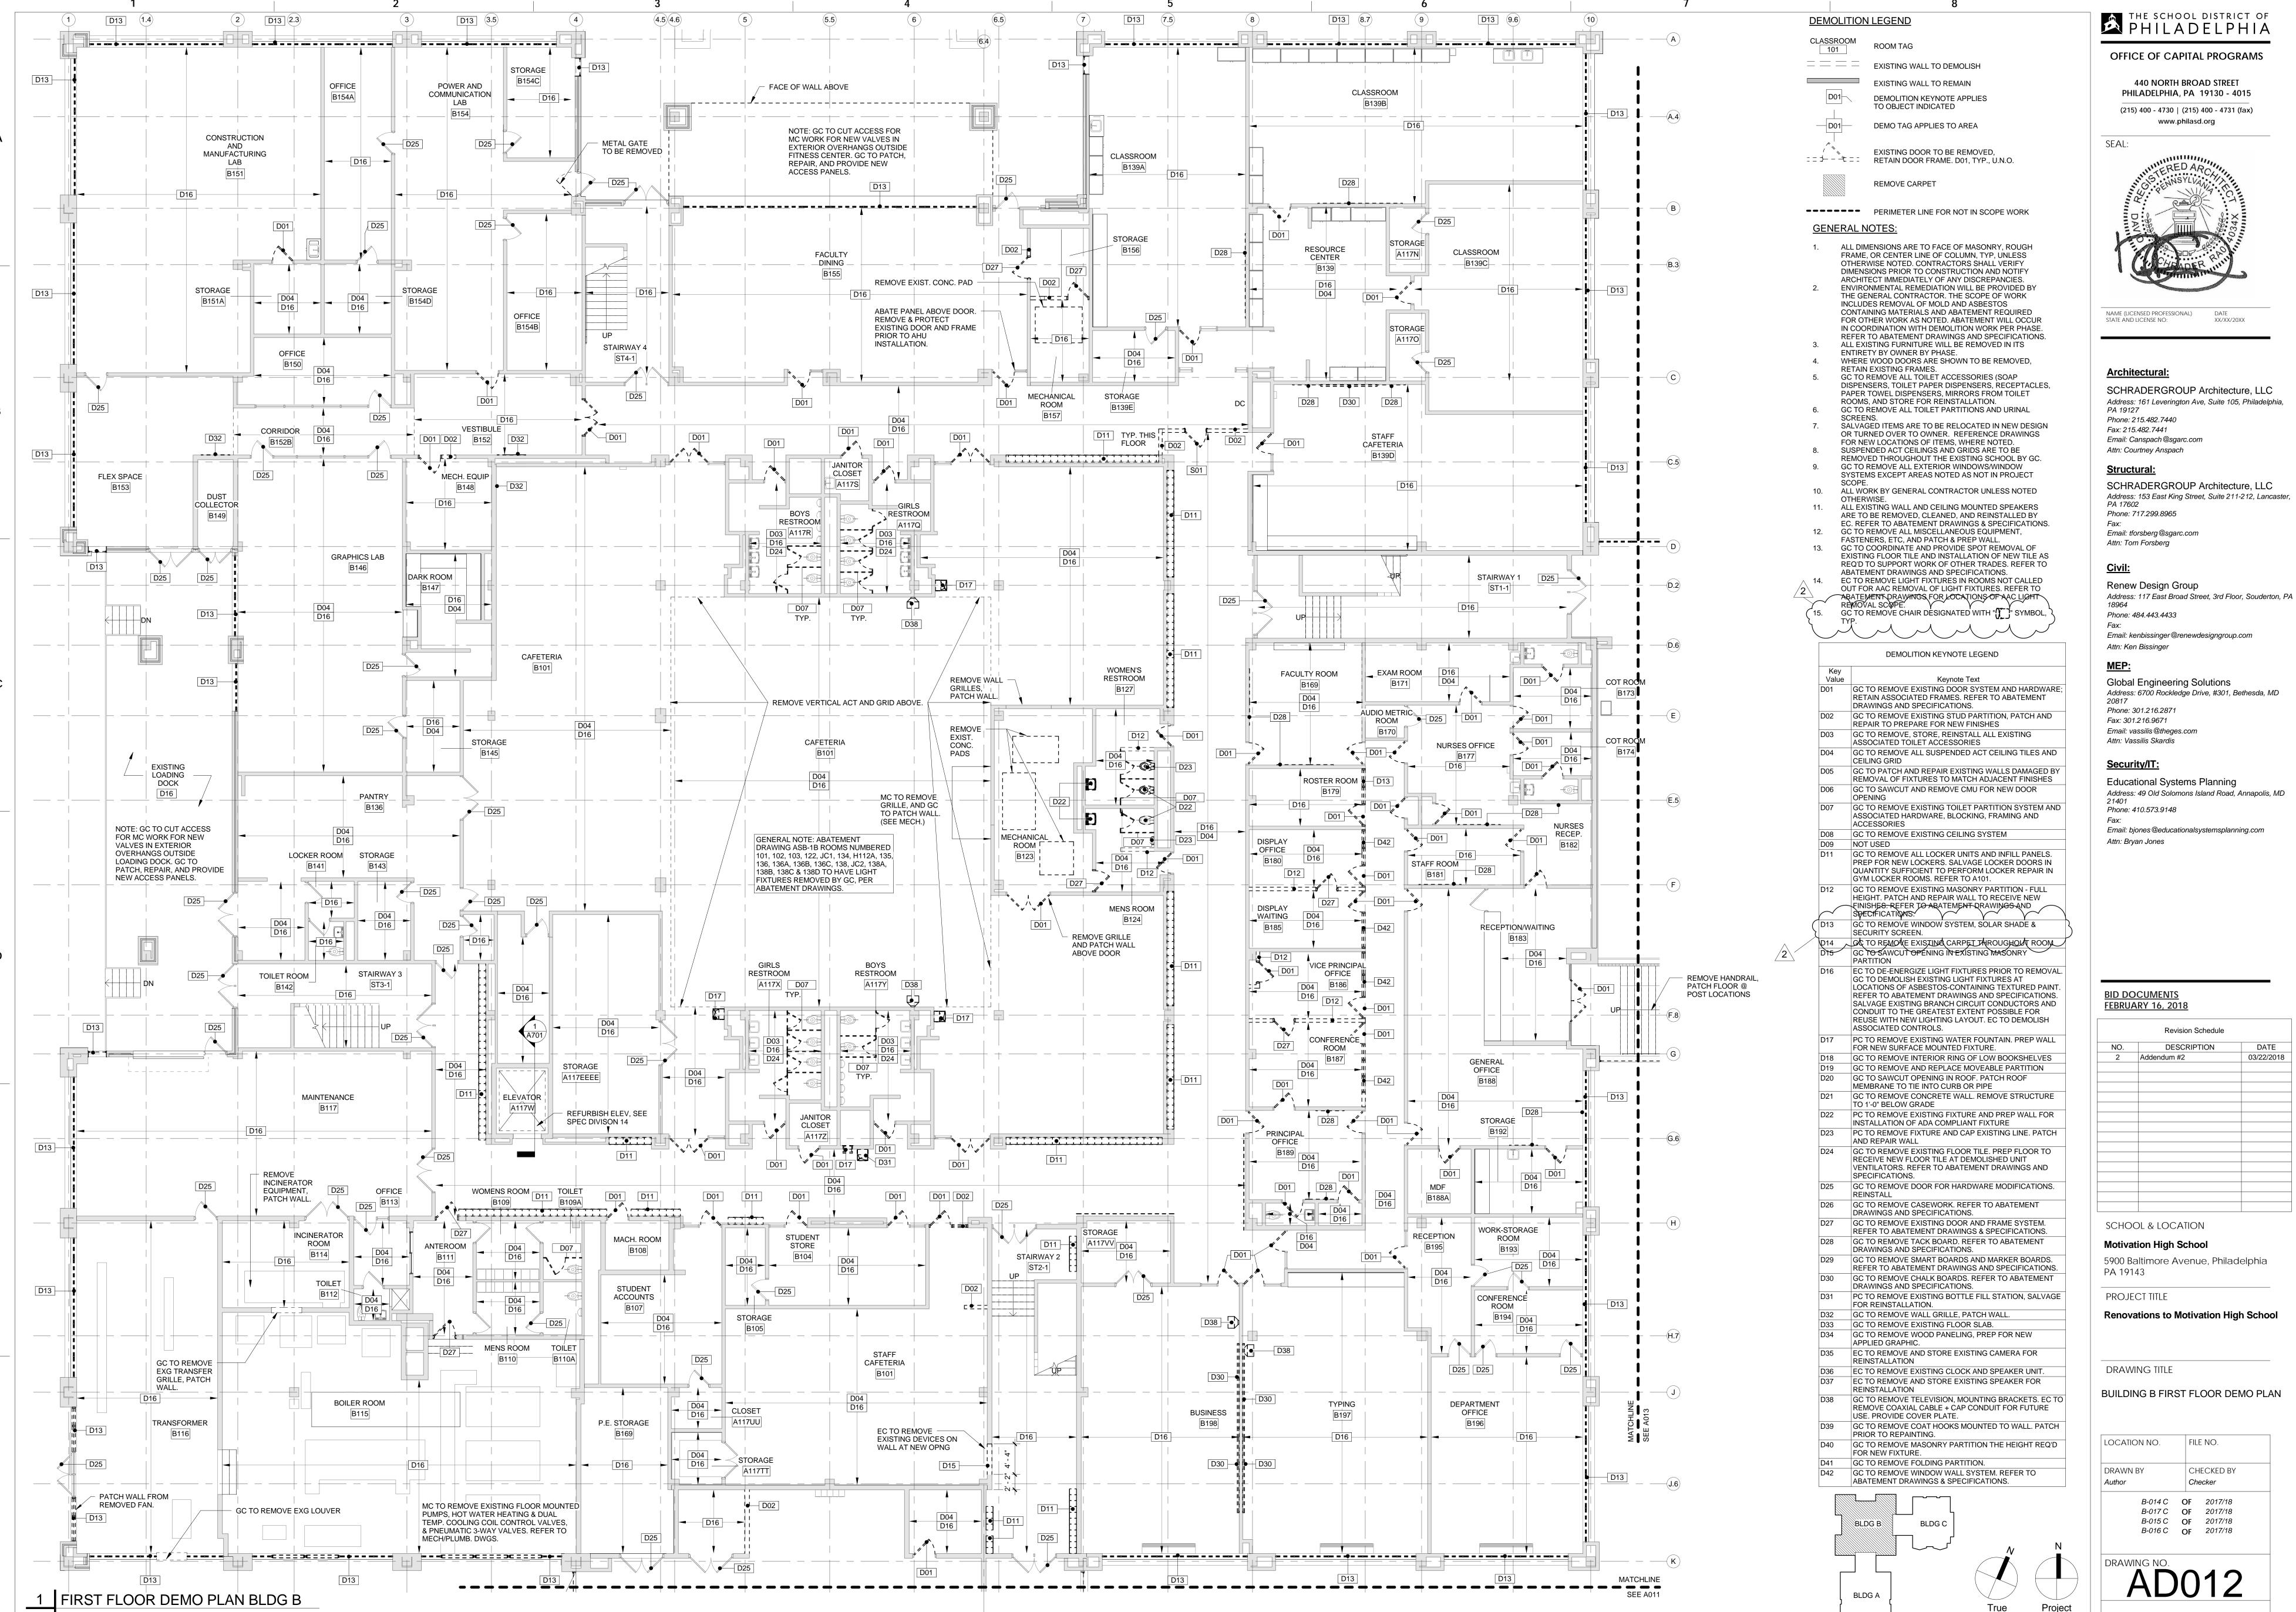

AD012 | SCALE: 1/8" = 1'-0"




SCHRADERGROUP Architecture, LLC

Address: 6700 Rockledge Drive, #301, Bethesda, MD

Address: 49 Old Solomons Island Road, Annapolis, MD

Email: bjones@educationalsystemsplanning.com


03/22/2018

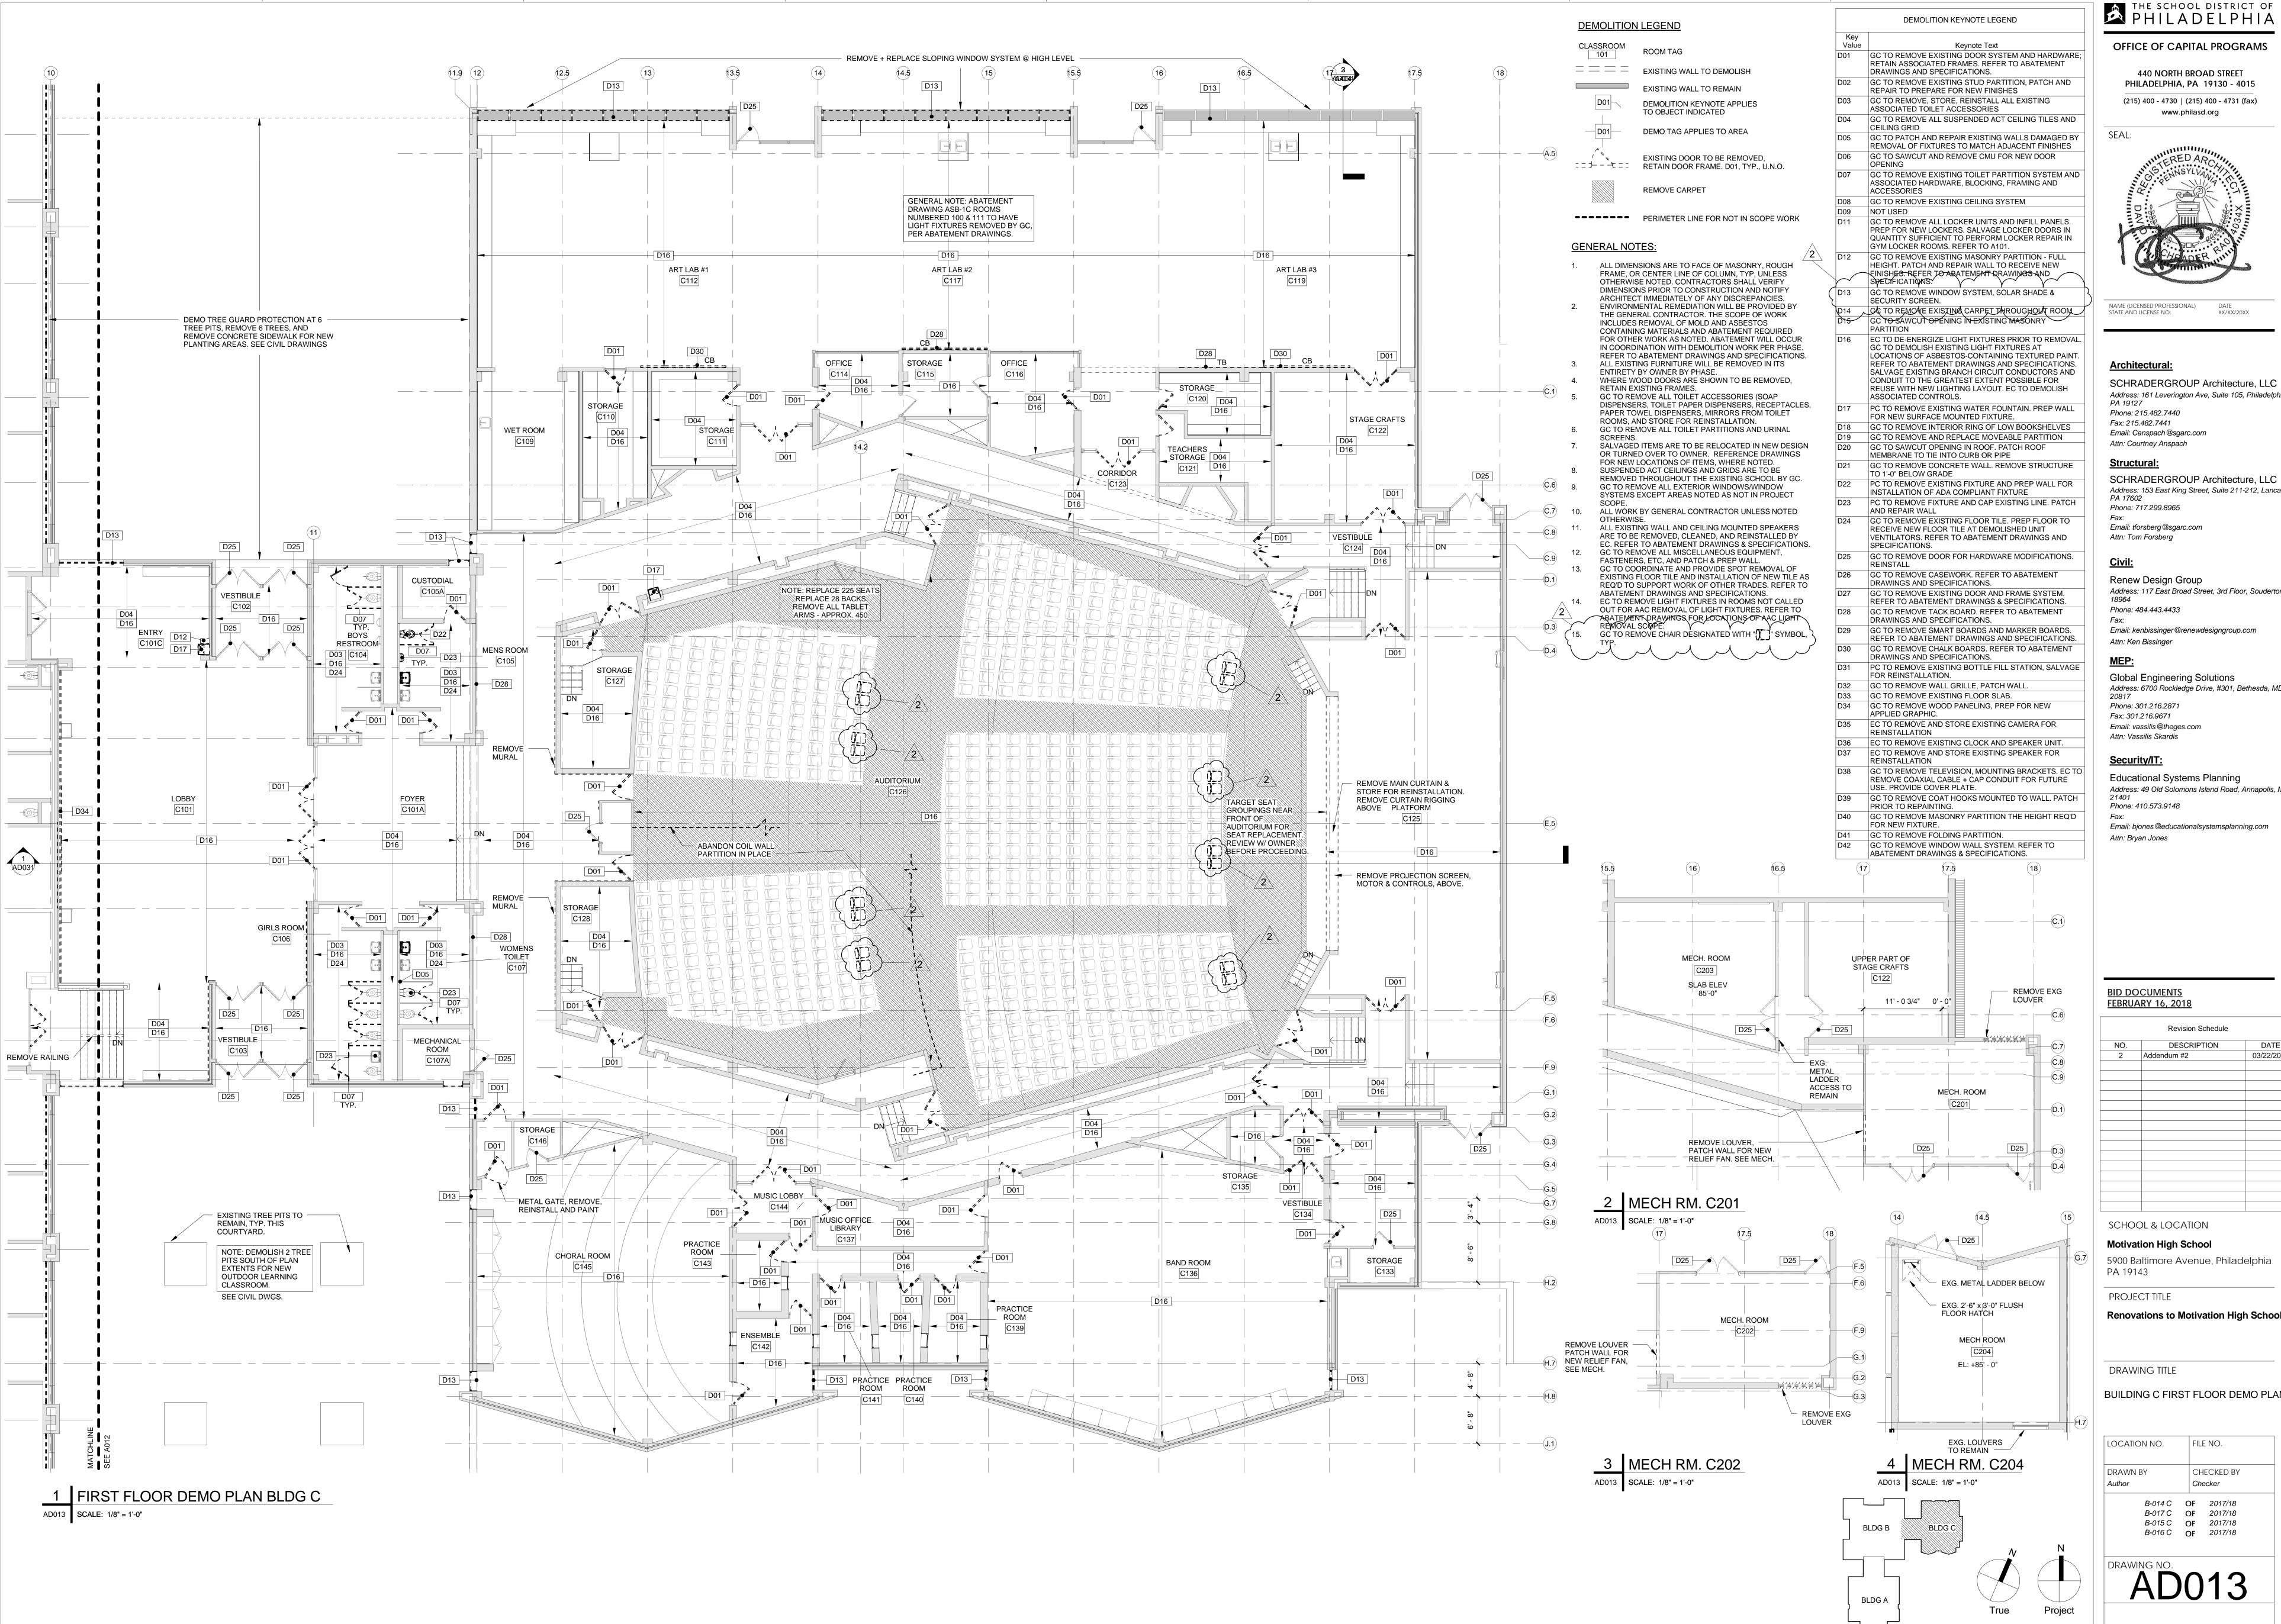

OFFICE OF CAPITAL PROGRAMS

440 NORTH BROAD STREET PHILADELPHIA, PA 19130 - 4015

www.philasd.org

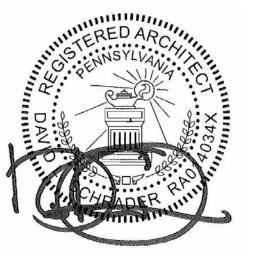

NAME (LICENSED PROFESSIONAL)

**Architectural:** SCHRADERGROUP Architecture, LLC

Address: 161 Leverington Ave, Suite 105, Philadelphia, PA 19127 Phone: 215.482.7440

Fax: 215.482.7441 Email: Canspach@sgarc.com

Attn: Courtney Anspach

Address: 153 East King Street, Suite 211-212, Lancaster, PA 17602 Phone: 717.299.8965

Email: tforsberg@sgarc.com Attn: Tom Forsberg

Renew Design Group Address: 117 East Broad Street, 3rd Floor, Souderton, PA

Email: kenbissinger@renewdesigngroup.com

Attn: Ken Bissinger

Global Engineering Solutions Address: 6700 Rockledge Drive, #301, Bethesda, MD

Fax: 301.216.9671 Email: vassilis@theges.com

Attn: Vassilis Skardis

Security/IT:

**Educational Systems Planning** Address: 49 Old Solomons Island Road, Annapolis, MD

Phone: 410.573.9148

Email: bjones@educationalsystemsplanning.com

Attn: Bryan Jones

	Revision Schedule	
NO.	DESCRIPTION	DATE
2	Addendum #2	03/22/2018

SCHOOL & LOCATION Motivation High School 5900 Baltimore Avenue, Philadelphia


PROJECT TITLE

Renovations to Motivation High School

BUILDING C FIRST FLOOR DEMO PLAN

CHECKED BY B-014 C OF 2017/18 B-017 C OF 2017/18 B-015 C OF 2017/18 B-016 C OF 2017/18

FILE NO.

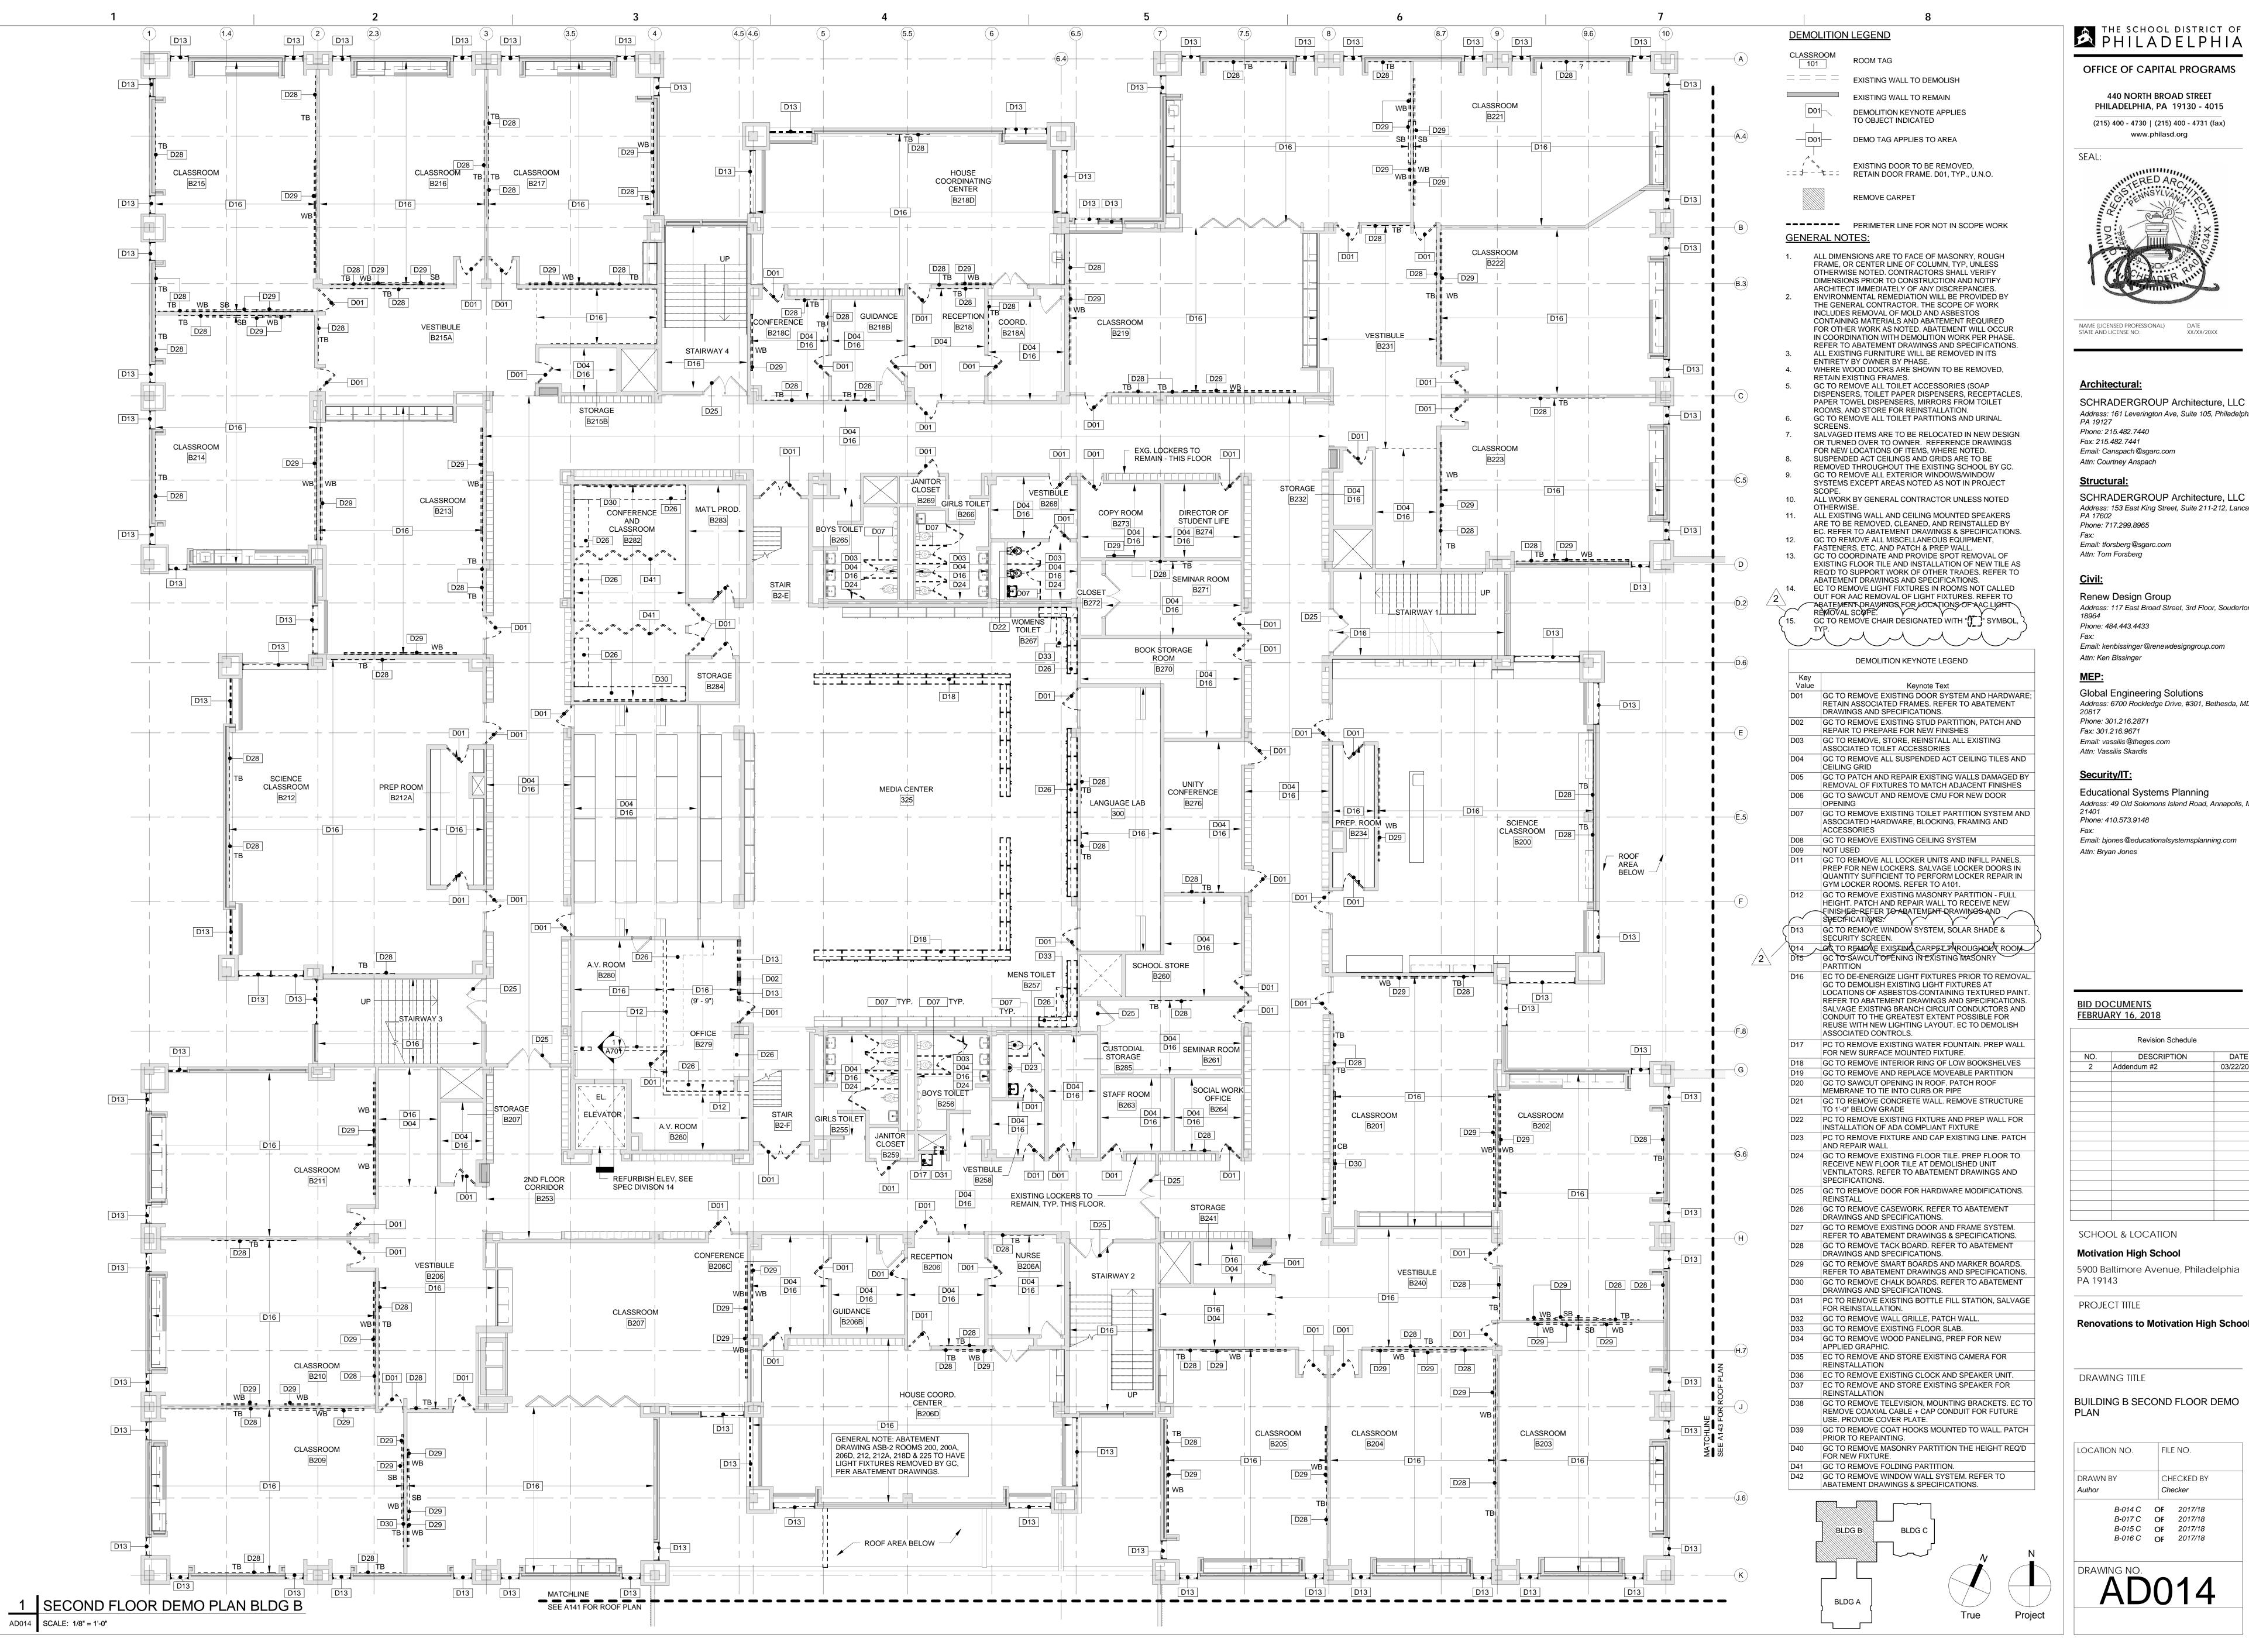

**OFFICE OF CAPITAL PROGRAMS** 

440 NORTH BROAD STREET PHILADELPHIA, PA 19130 - 4015 (215) 400 - 4730 | (215) 400 - 4731 (fax)



www.philasd.org

NAME (LICENSED PROFESSIONAL)

**Architectural:** SCHRADERGROUP Architecture, LLC

Address: 161 Leverington Ave, Suite 105, Philadelphia, Phone: 215.482.7440 Fax: 215.482.7441

Email: Canspach@sgarc.com Attn: Courtney Anspach

Structural:

Address: 153 East King Street, Suite 211-212, Lancaster, PA 17602 Phone: 717.299.8965

Email: tforsberg@sgarc.com

Attn: Tom Forsberg

Civil:

Renew Design Group Address: 117 East Broad Street, 3rd Floor, Souderton, PA

Phone: 484.443.4433

Email: kenbissinger@renewdesigngroup.com Attn: Ken Bissinger

Global Engineering Solutions Address: 6700 Rockledge Drive, #301, Bethesda, MD

Phone: 301.216.2871 Fax: 301.216.9671 Email: vassilis@theges.com

Attn: Vassilis Skardis

Security/IT:

**Educational Systems Planning** 

Address: 49 Old Solomons Island Road, Annapolis, MD

Phone: 410.573.9148

Email: bjones @educationalsystemsplanning.com

Attn: Bryan Jones

FEBRUARY 16, 2018				
Revision Schedule				
NO.	DESCRIPTION	DATE		
2	Addendum #2	03/22/2018		

SCHOOL & LOCATION Motivation High School

PA 19143


Renovations to Motivation High School

BUILDING B SECOND FLOOR DEMO

PLAN

CHECKED BY Checker B-014 C OF 2017/18 B-017 C OF 2017/18 B-015 C OF 2017/18 B-016 C OF 2017/18

FILE NO.

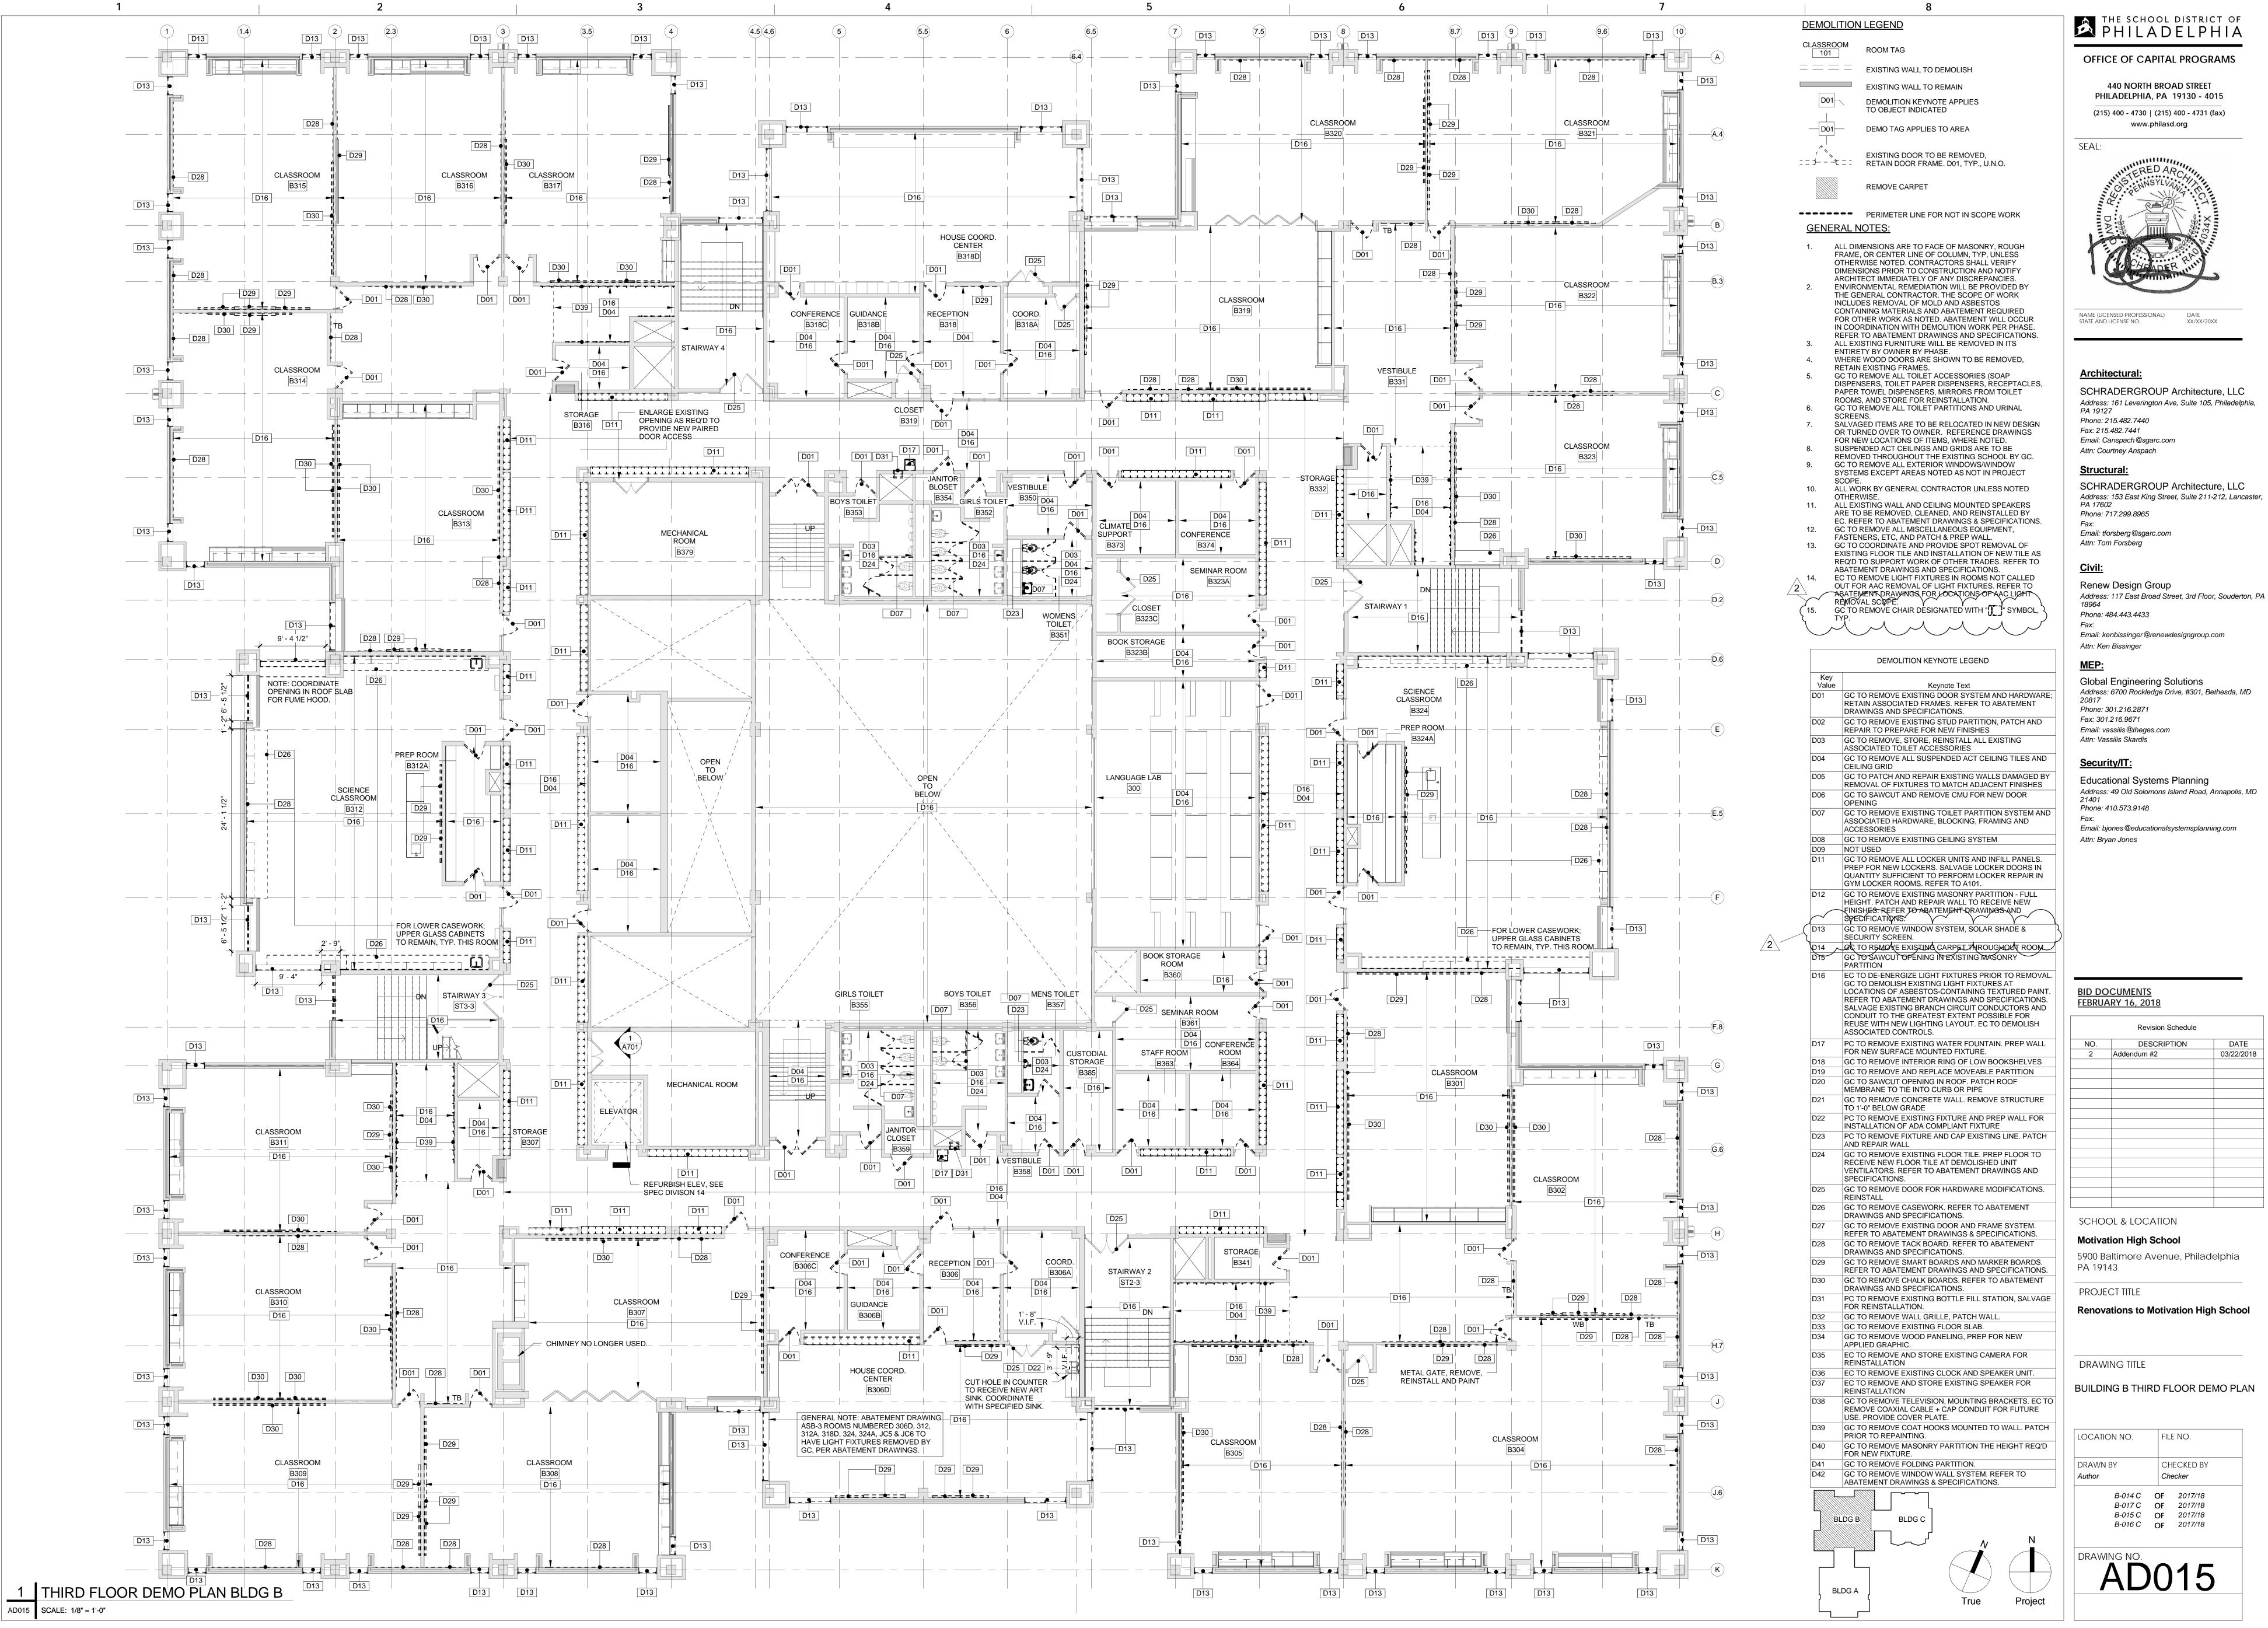

OFFICE OF CAPITAL PROGRAMS

440 NORTH BROAD STREET PHILADELPHIA, PA 19130 - 4015




www.philasd.org

NAME (LICENSED PROFESSIONAL) STATE AND LICENSE NO:

**Architectural:** SCHRADERGROUP Architecture, LLC

Address: 161 Leverington Ave, Suite 105, Philadelphia, Phone: 215.482.7440 Fax: 215.482.7441

Email: Canspach @sgarc.com Attn: Courtney Anspach

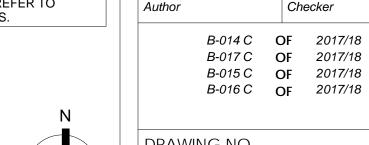


FILE NO.

CHECKED BY

Revision Schedule


DESCRIPTION

03/22/2018

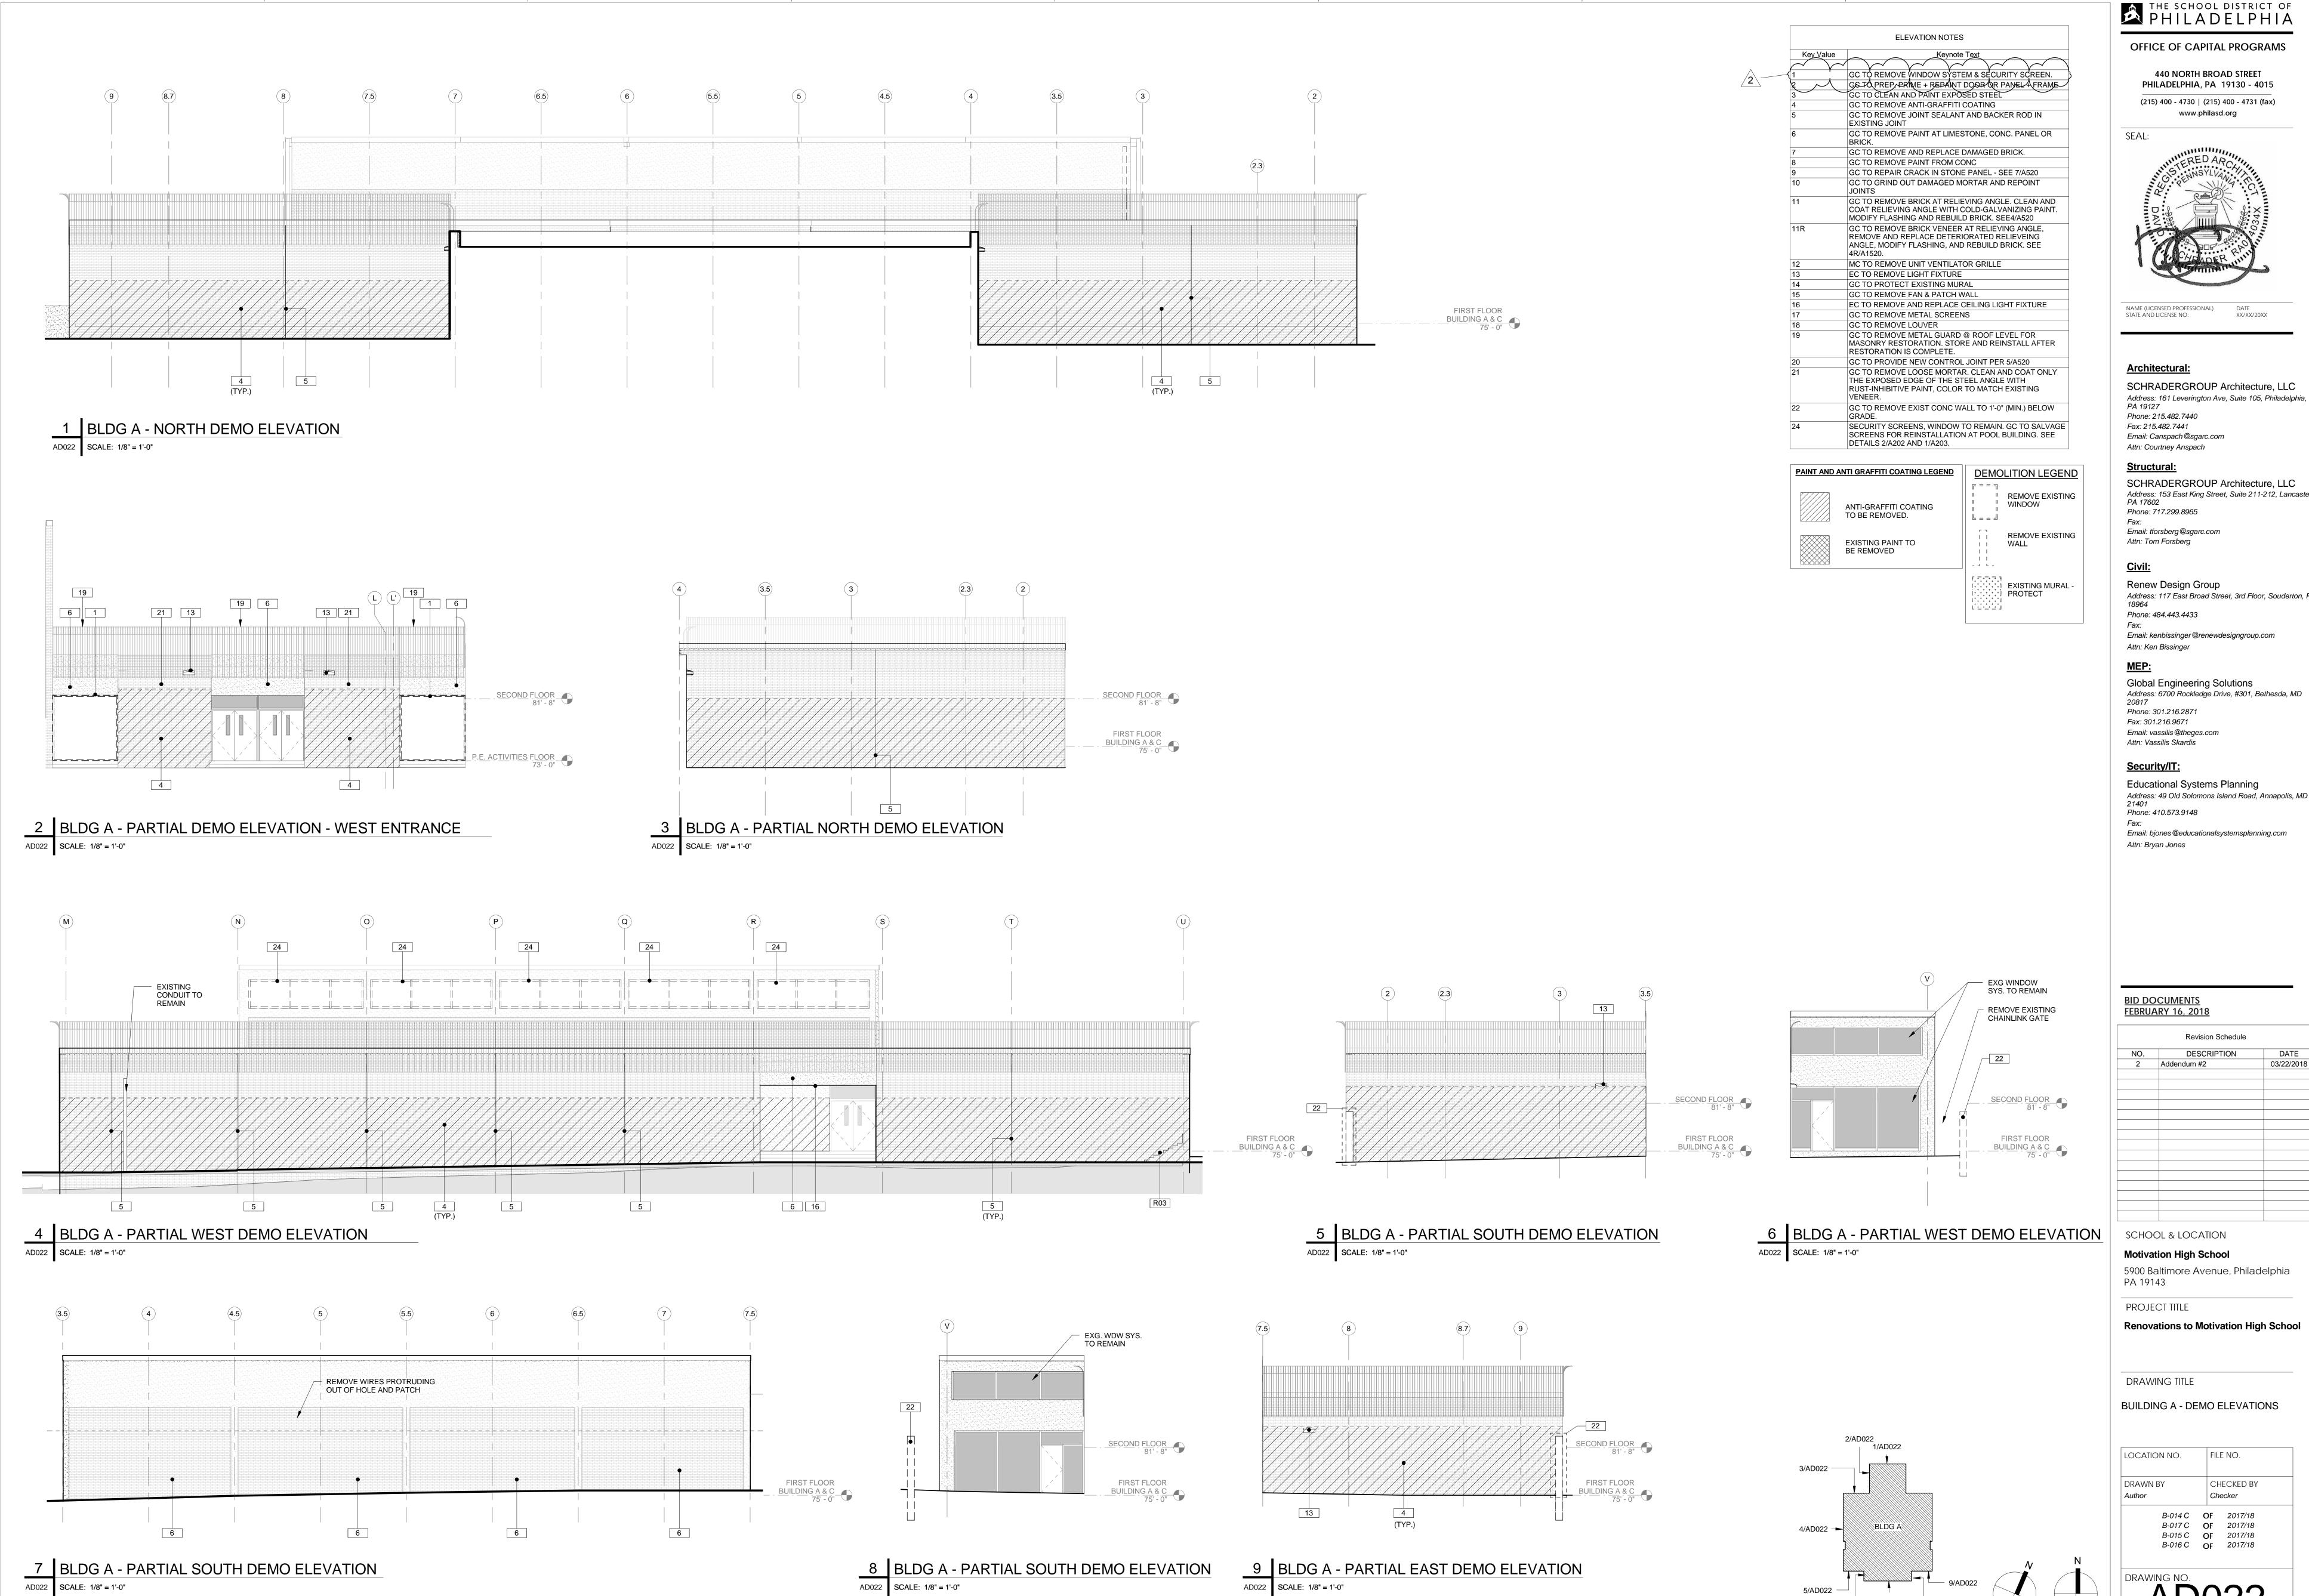

OFFICE OF CAPITAL PROGRAMS

440 NORTH BROAD STREET PHILADELPHIA, PA 19130 - 4015 (215) 400 - 4730 | (215) 400 - 4731 (fax)

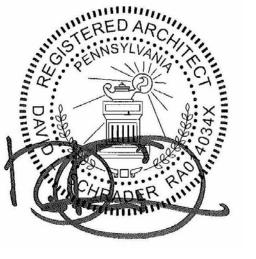

www.philasd.org

NAME (LICENSED PROFESSIONAL)

**Architectural:** SCHRADERGROUP Architecture, LLC

PA 19127 Phone: 215.482.7440 Fax: 215.482.7441 Email: Canspach@sgarc.com

Attn: Courtney Anspach

SCHRADERGROUP Architecture, LLC Address: 153 East King Street, Suite 211-212, Lancaster, PA 17602

Email: tforsberg@sgarc.com Attn: Tom Forsberg

Renew Design Group

Address: 117 East Broad Street, 3rd Floor, Souderton, PA Phone: 484.443.4433

Email: kenbissinger@renewdesigngroup.com

Attn: Ken Bissinger

Global Engineering Solutions

Address: 6700 Rockledge Drive, #301, Bethesda, MD 20817

Fax: 301.216.9671 Email: vassilis@theges.com

Attn: Vassilis Skardis

Educational Systems Planning

Address: 49 Old Solomons Island Road, Annapolis, MD Phone: 410.573.9148

Email: bjones@educationalsystemsplanning.com

Attn: Bryan Jones

BID DOCUMENTS FEBRUARY 16. 2018

BRUARY 16, 2018					
	Revision Schedule				
NO.	DESCRIPTION	DATE			
2	Addendum #2	03/22/2018			

SCHOOL & LOCATION **Motivation High School** 


PROJECT TITLE

**Renovations to Motivation High School** 


DRAWING TITLE

**BUILDING A - DEMO ELEVATIONS** 


LOCATION NO. FILE NO. CHECKED BY B-014 C OF 2017/18 B-017 C OF 2017/18 B-015 C OF 2017/18 B-016 C OF 2017/18

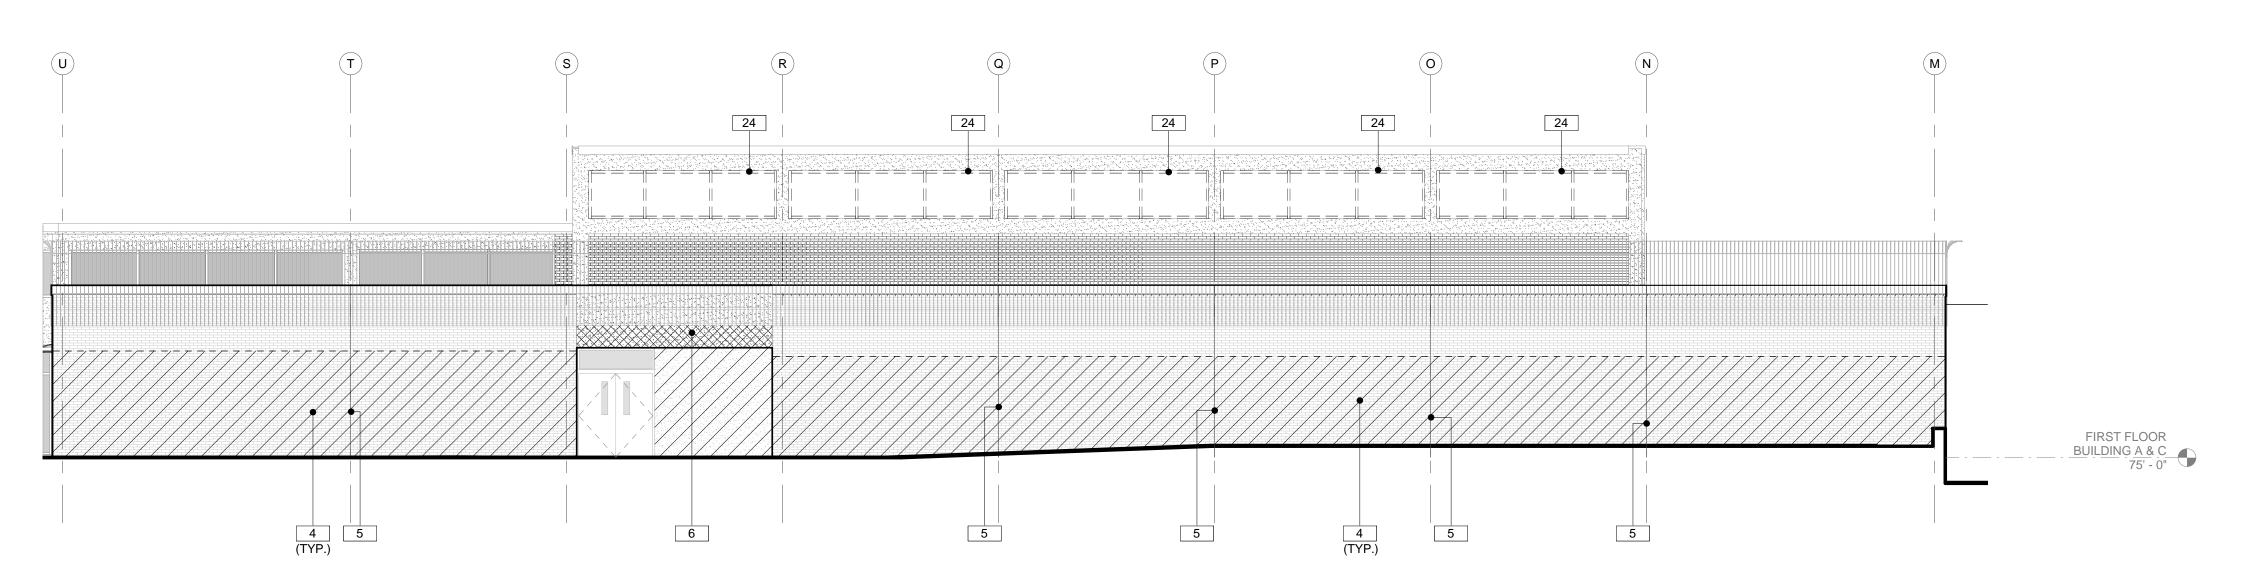


# 1 BLDG A - EAST DEMO ELEVATION AD023 SCALE: 1/8" = 1'-0"

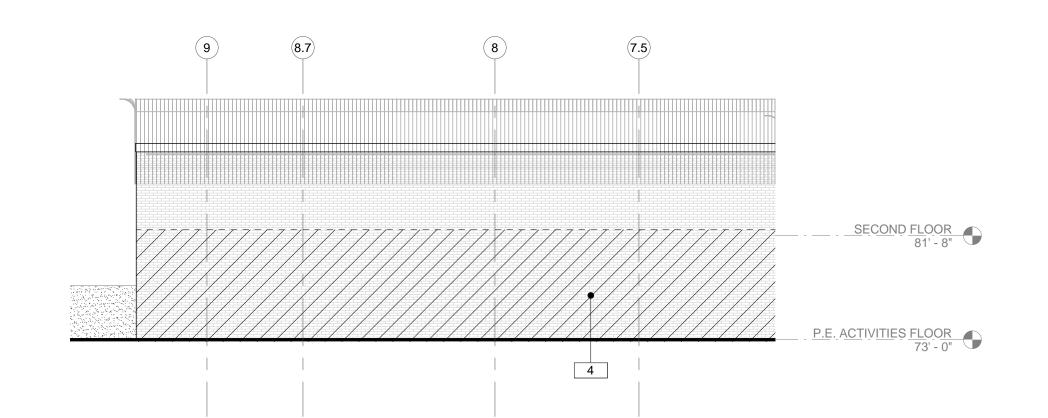


2 BLDG A - PARTIAL NORTH DEMO ELEVATION
AD023 SCALE: 1/8" = 1'-0"

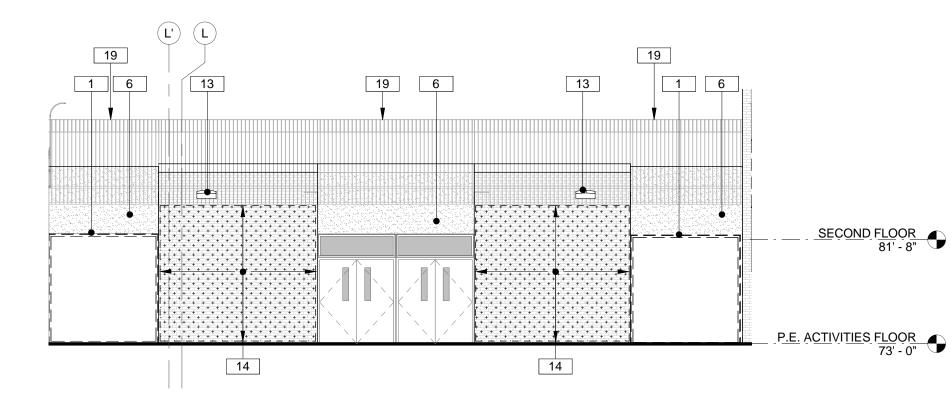

3 BLDG A - PARTIAL DEMO ELEVATION - EAST ENTRANCE
AD023 SCALE: 1/8" = 1'-0"

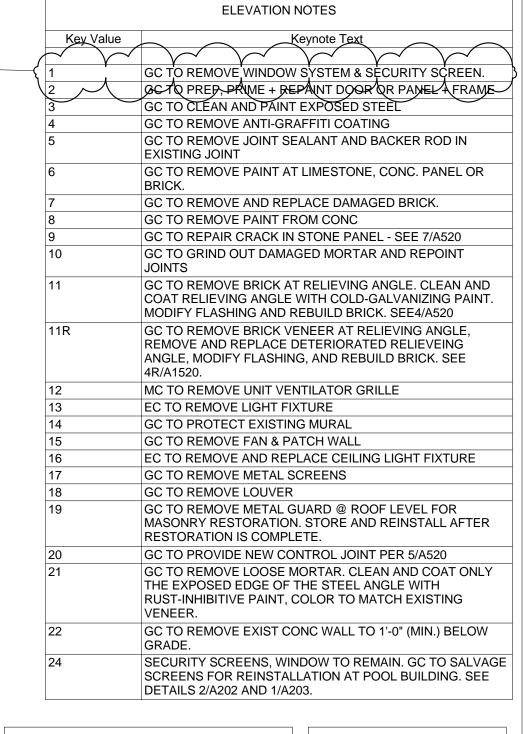

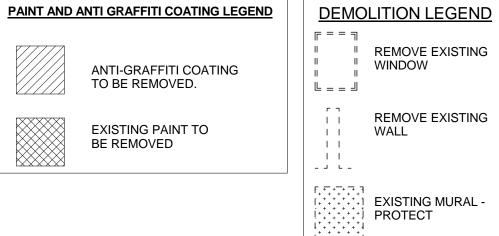

# THE SCHOOL DISTRICT OF PHILADELPHIA

OFFICE OF CAPITAL PROGRAMS

440 NORTH BROAD STREET PHILADELPHIA, PA 19130 - 4015

(215) 400 - 4730 | (215) 400 - 4731 (fax)

www.philasd.org

SEAL:



NAME (LICENSED PROFESSIONAL) STATE AND LICENSE NO:

### **Architectural:**

SCHRADERGROUP Architecture, LLC Address: 161 Leverington Ave, Suite 105, Philadelphia,

Phone: 215.482.7440 Fax: 215.482.7441 Email: Canspach@sgarc.com

# Attn: Courtney Anspach

Structural: SCHRADERGROUP Architecture, LLC

Address: 153 East King Street, Suite 211-212, Lancaster,

Phone: 717.299.8965

Email: tforsberg@sgarc.com Attn: Tom Forsberg

Renew Design Group Address: 117 East Broad Street, 3rd Floor, Souderton, PA 18964 Phone: 484.443.4433

Email: kenbissinger@renewdesigngroup.com

Attn: Ken Bissinger

Global Engineering Solutions Address: 6700 Rockledge Drive, #301, Bethesda, MD

Phone: 301.216.2871 Fax: 301.216.9671 Email: vassilis@theges.com

Attn: Vassilis Skardis

# Security/IT:

Educational Systems Planning Address: 49 Old Solomons Island Road, Annapolis, MD

Phone: 410.573.9148

Email: bjones@educationalsystemsplanning.com Attn: Bryan Jones

BID DOCUMENTS FEBRUARY 16, 2018				
	Revision Schedule			
NO.	DESCRIPTION	DATE		
2	Addendum #2	03/22/2018		
		+		

SCHOOL & LOCATION

**Motivation High School** 

5900 Baltimore Avenue, Philadelphia PA 19143

PROJECT TITLE Renovations to Motivation High School

DRAWING TITLE

BUILDING A - DEMO ELEVATIONS

LOCATION NO. FILE NO.

CHECKED BY DRAWN BY B-017 C OF 2017/18 B-015 C OF 2017/18 B-016 C OF 2017/18

BLDG A



OFFICE OF CAPITAL PROGRAMS

440 NORTH BROAD STREET PHILADELPHIA, PA 19130 - 4015



NAME (LICENSED PROFESSIONAL)

SCHRADERGROUP Architecture, LLC Address: 161 Leverington Ave, Suite 105, Philadelphia,

Email: Canspach@sgarc.com

SCHRADERGROUP Architecture, LLC Address: 153 East King Street, Suite 211-212, Lancaster,

Email: tforsberg@sgarc.com

Address: 117 East Broad Street, 3rd Floor, Souderton, PA

Email: kenbissinger@renewdesigngroup.com

Global Engineering Solutions Address: 6700 Rockledge Drive, #301, Bethesda, MD

Email: vassilis@theges.com

**Educational Systems Planning** 

Address: 49 Old Solomons Island Road, Annapolis, MD

Email: bjones@educationalsystemsplanning.com


Revision Schedule				
NO.	DESCRIPTION	DATE		
2	Addendum #2	03/22/201		

SCHOOL & LOCATION **Motivation High School** 

**Renovations to Motivation High School** 

**BUILDING B - DEMO ELEVATIONS** 

FILE NO. CHECKED BY B-014 C OF 2017/18 B-017 C OF 2017/18 B-015 C OF 2017/18 B-016 C OF 2017/18

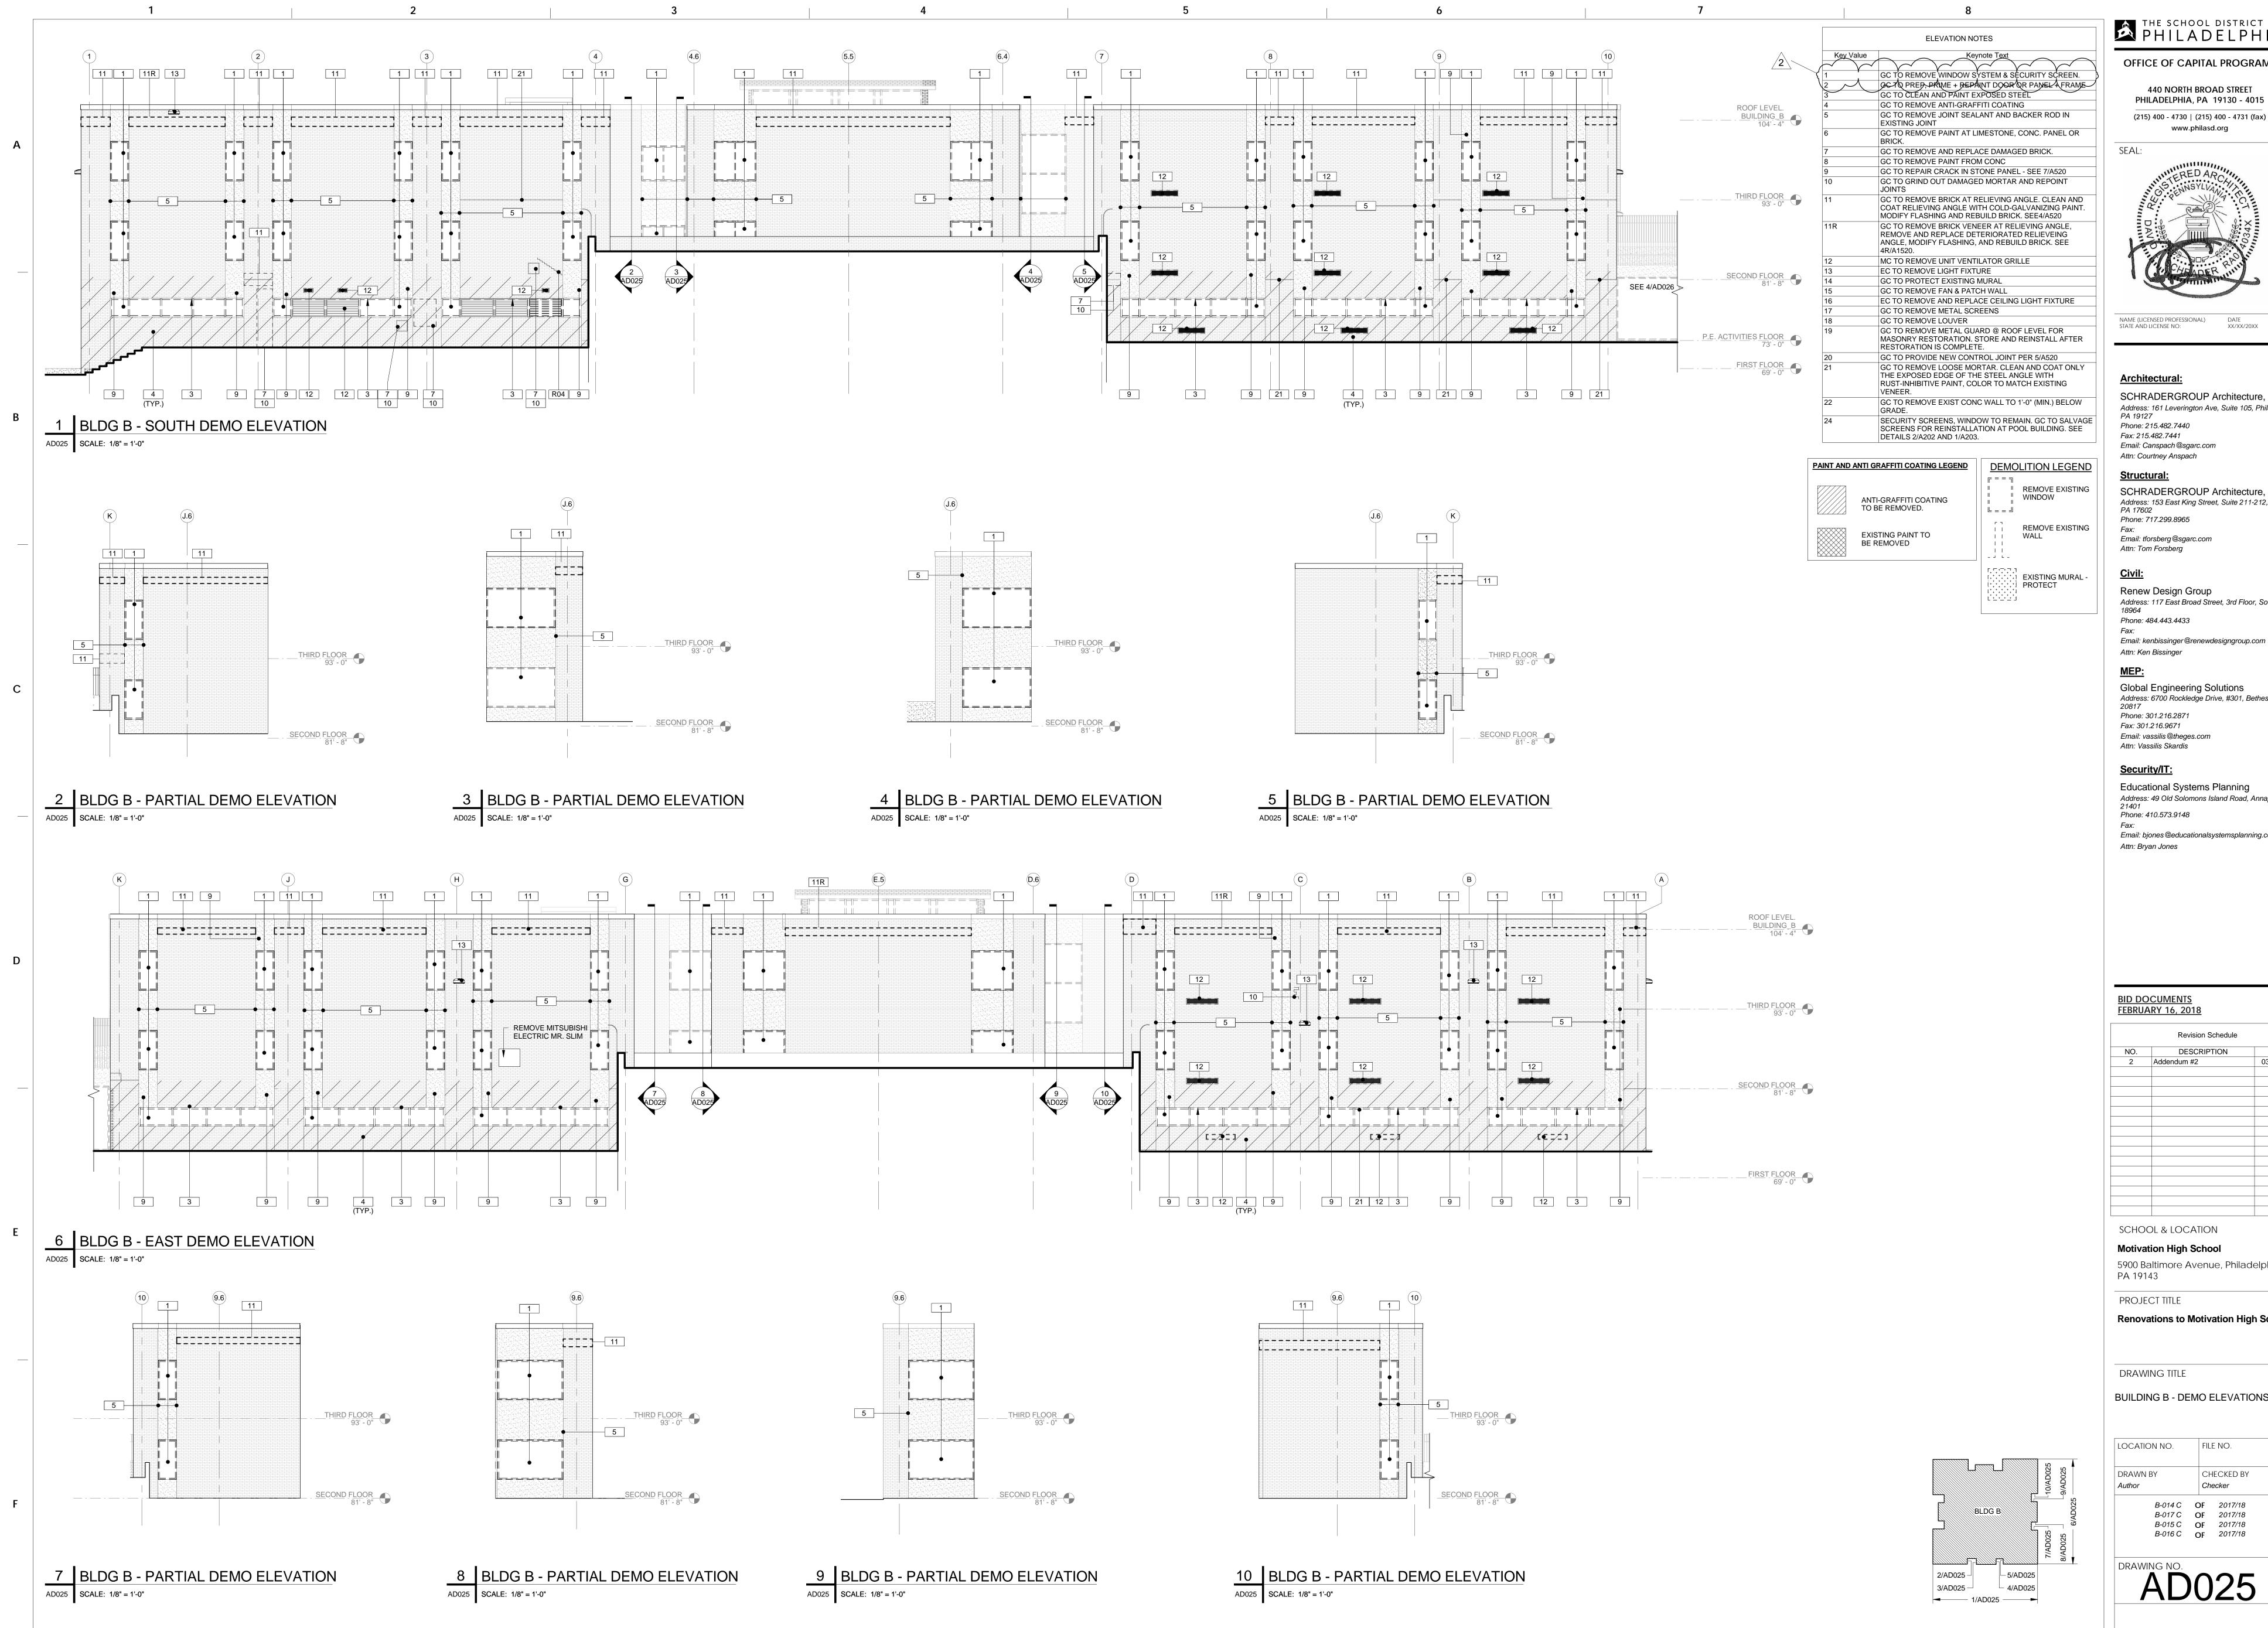

OFFICE OF CAPITAL PROGRAMS

440 NORTH BROAD STREET PHILADELPHIA, PA 19130 - 4015



NAME (LICENSED PROFESSIONAL)

SCHRADERGROUP Architecture, LLC Address: 161 Leverington Ave, Suite 105, Philadelphia,

Email: Canspach@sgarc.com

SCHRADERGROUP Architecture, LLC Address: 153 East King Street, Suite 211-212, Lancaster,

Email: tforsberg@sgarc.com

Address: 117 East Broad Street, 3rd Floor, Souderton, PA

Email: kenbissinger@renewdesigngroup.com

Address: 6700 Rockledge Drive, #301, Bethesda, MD

Email: vassilis@theges.com

**Educational Systems Planning** 

Address: 49 Old Solomons Island Road, Annapolis, MD

Email: bjones@educationalsystemsplanning.com

FEBRU	<u>ARY 16, 2018</u>	
	Revision Schedule	
NO.	DESCRIPTION	DATE
2	Addendum #2	03/22/2018
1		


SCHOOL & LOCATION

5900 Baltimore Avenue, Philadelphia

Renovations to Motivation High School

BUILDING B - DEMO ELEVATIONS

LOCATION NO.		FIL	LE NO.	
DRAWN BY Author		•	HECKED BY necker	
B-014 C B-017 C B-015 C B-016 C	Ċ	OF OF OF OF	2017/18 2017/18 2017/18 2017/18	

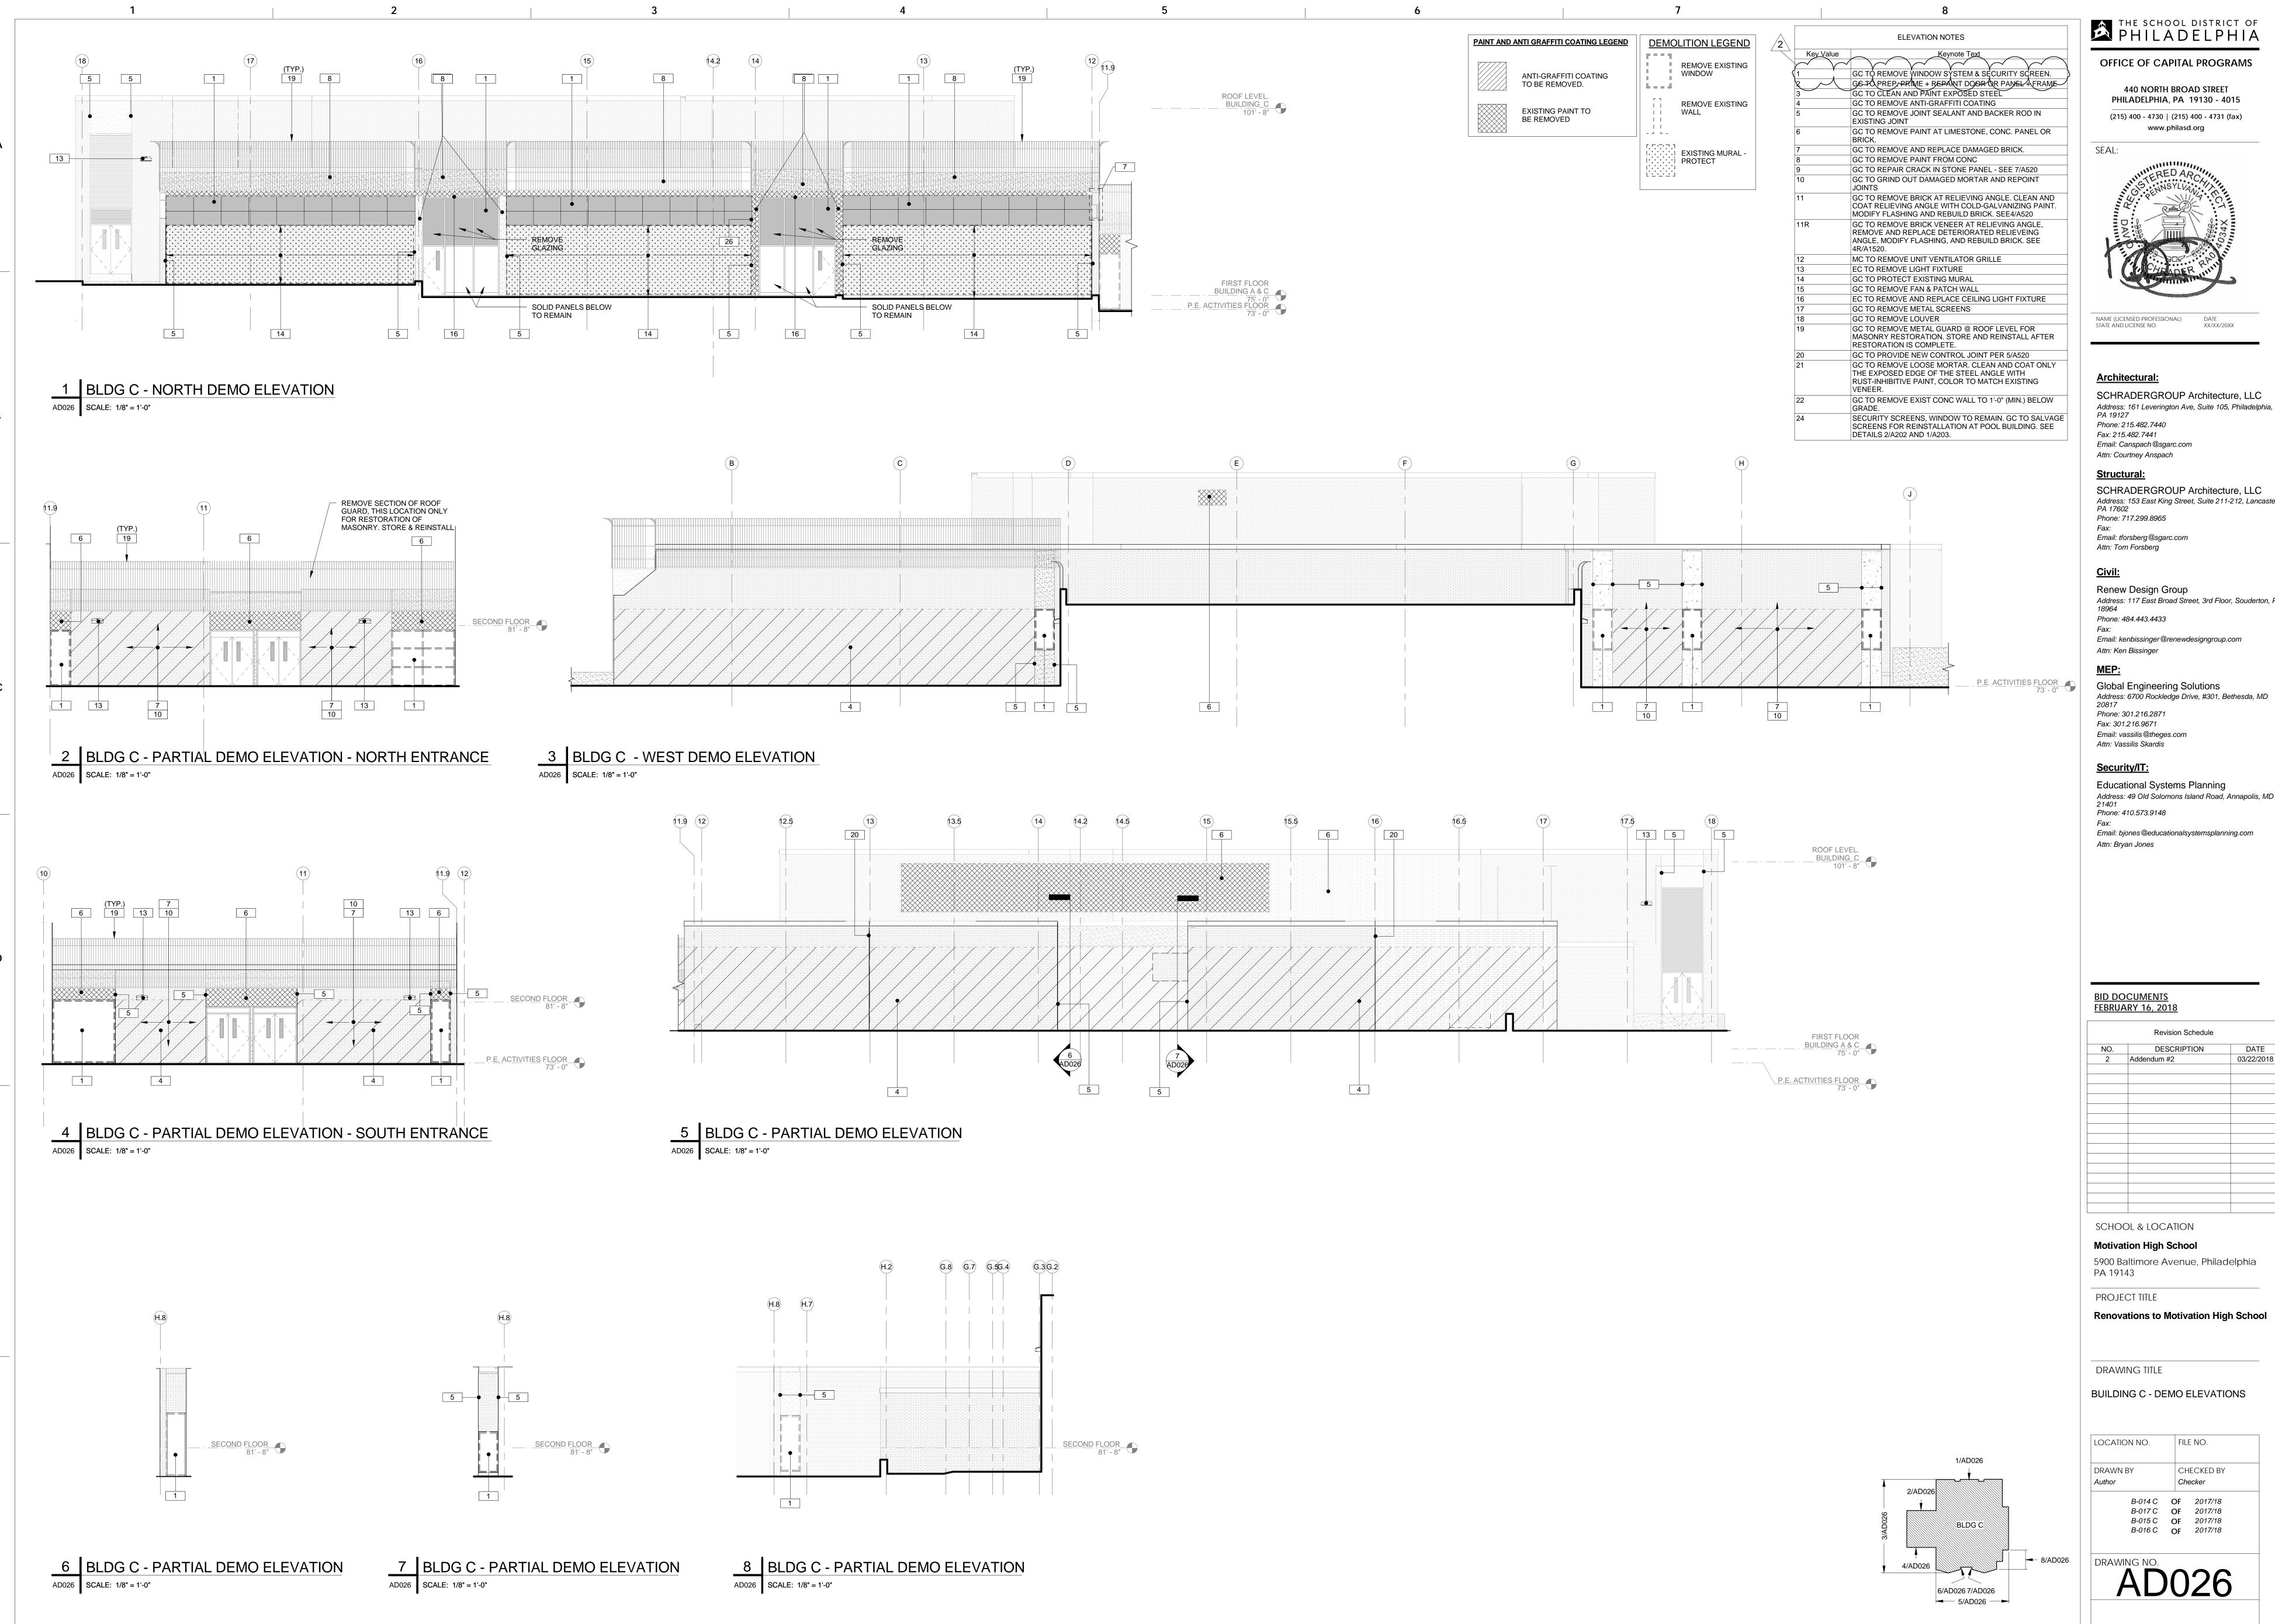

OFFICE OF CAPITAL PROGRAMS

440 NORTH BROAD STREET PHILADELPHIA, PA 19130 - 4015 (215) 400 - 4730 | (215) 400 - 4731 (fax)



NAME (LICENSED PROFESSIONAL)

**Architectural:** 

SCHRADERGROUP Architecture, LLC

Phone: 215.482.7440 Fax: 215.482.7441

Email: Canspach@sgarc.com Attn: Courtney Anspach

SCHRADERGROUP Architecture, LLC Address: 153 East King Street, Suite 211-212, Lancaster,

Email: tforsberg@sgarc.com

Renew Design Group Address: 117 East Broad Street, 3rd Floor, Souderton, PA

Email: kenbissinger@renewdesigngroup.com Attn: Ken Bissinger

Global Engineering Solutions

Address: 6700 Rockledge Drive, #301, Bethesda, MD
20817

Fax: 301.216.9671 Email: vassilis@theges.com Attn: Vassilis Skardis

Educational Systems Planning

Address: 49 Old Solomons Island Road, Annapolis, MD Phone: 410.573.9148

Email: bjones@educationalsystemsplanning.com Attn: Bryan Jones

Revision Schedule					
NO.	NO. DESCRIPTION				
2	Addendum #2	03/22/2018			

SCHOOL & LOCATION


**Motivation High School** 5900 Baltimore Avenue, Philadelphia

PROJECT TITLE


**Renovations to Motivation High School** 

**BUILDING C - DEMO ELEVATIONS** 


FILE NO. CHECKED BY B-014 C OF 2017/18 B-017 C OF 2017/18 B-015 C OF 2017/18 B-016 C OF 2017/18

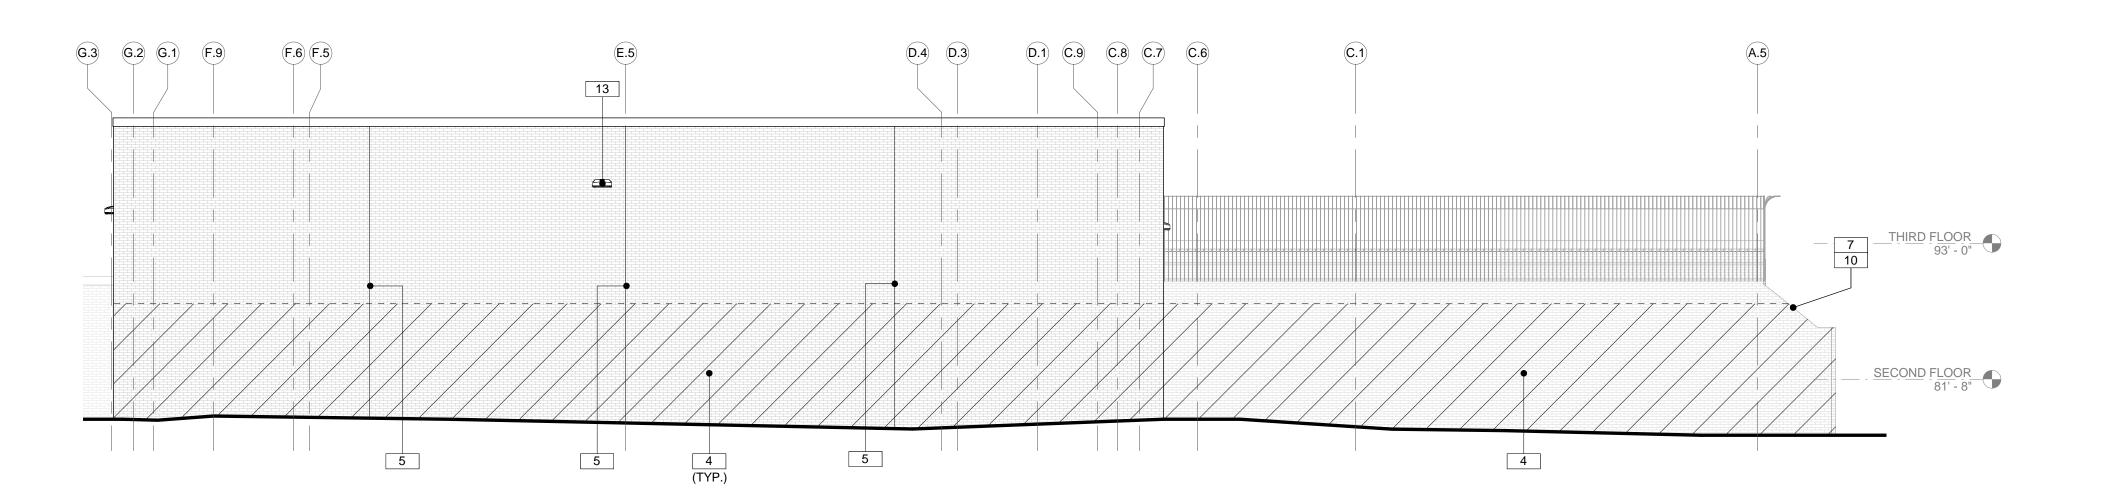


1 BLDG B - PARTIAL EAST DEMO ELEVATION AD027 SCALE: 1/8" = 1'-0"

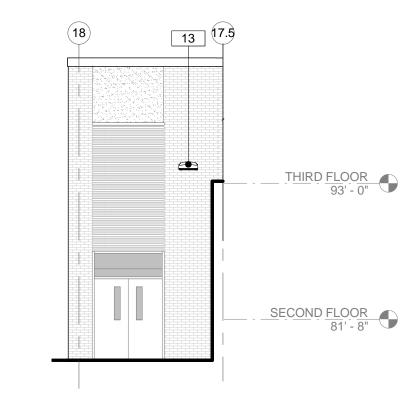

2 BLDG B - PARTIAL DEMO ELEVATION
AD027 SCALE: 1/8" = 1'-0"

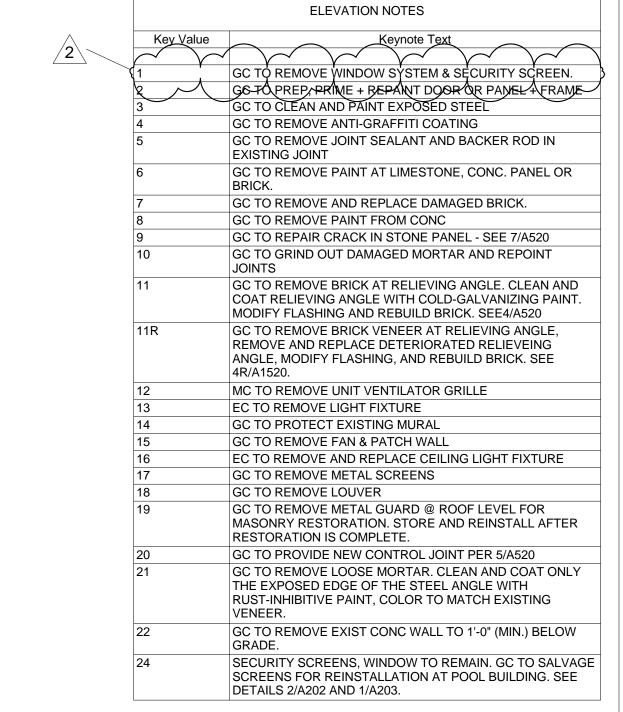

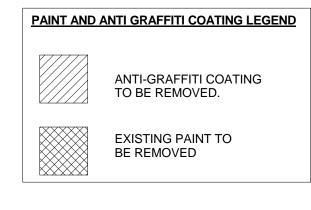

DEMOLITION LEGEND		
	REMOVE EXISTING WINDOW	
	REMOVE EXISTING WALL	
F, F, T,	EXISTING MURAL - PROTECT	

# THE SCHOOL DISTRICT OF PHILADELPHIA

www.philasd.org

OFFICE OF CAPITAL PROGRAMS

440 NORTH BROAD STREET PHILADELPHIA, PA 19130 - 4015 (215) 400 - 4730 | (215) 400 - 4731 (fax)

SEAL:



NAME (LICENSED PROFESSIONAL) STATE AND LICENSE NO:

### **Architectural:**

SCHRADERGROUP Architecture, LLC Address: 161 Leverington Ave, Suite 105, Philadelphia,

PA 19127 Phone: 215.482.7440 Fax: 215.482.7441 Email: Canspach@sgarc.com

# Attn: Courtney Anspach

Structural: SCHRADERGROUP Architecture, LLC

Phone: 717.299.8965 Email: tforsberg@sgarc.com

Attn: Tom Forsberg

# Civil:

PA 17602

Renew Design Group Address: 117 East Broad Street, 3rd Floor, Souderton, PA 18964 Phone: 484.443.4433

Address: 153 East King Street, Suite 211-212, Lancaster,

Email: kenbissinger@renewdesigngroup.com Attn: Ken Bissinger

Global Engineering Solutions Address: 6700 Rockledge Drive, #301, Bethesda, MD

Phone: 301.216.2871 Fax: 301.216.9671 Email: vassilis@theges.com Attn: Vassilis Skardis

### Security/IT:

Educational Systems Planning

Address: 49 Old Solomons Island Road, Annapolis, MD Phone: 410.573.9148

Email: bjones@educationalsystemsplanning.com Attn: Bryan Jones

# BID DOCUMENTS FEBRUARY 16, 2018

Revision Schedule				
NO.	DATE			
2	Addendum #2	03/22/2018		

SCHOOL & LOCATION

**Motivation High School** 

5900 Baltimore Avenue, Philadelphia PA 19143


Renovations to Motivation High School


DRAWING TITLE

PROJECT TITLE

BUILDING C - DEMO ELEVATIONS

LOCATION NO.	FIL	E NO.
DRAWN BY	CH	IECKED BY
Author	Ch	ecker
B-014 C	OF	2017/18
B-017 C	OF	2017/18
B-015 C	OF	2017/18
B-016 C	OF	2017/18

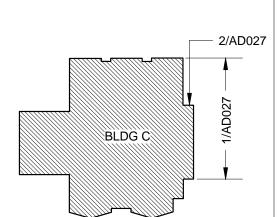


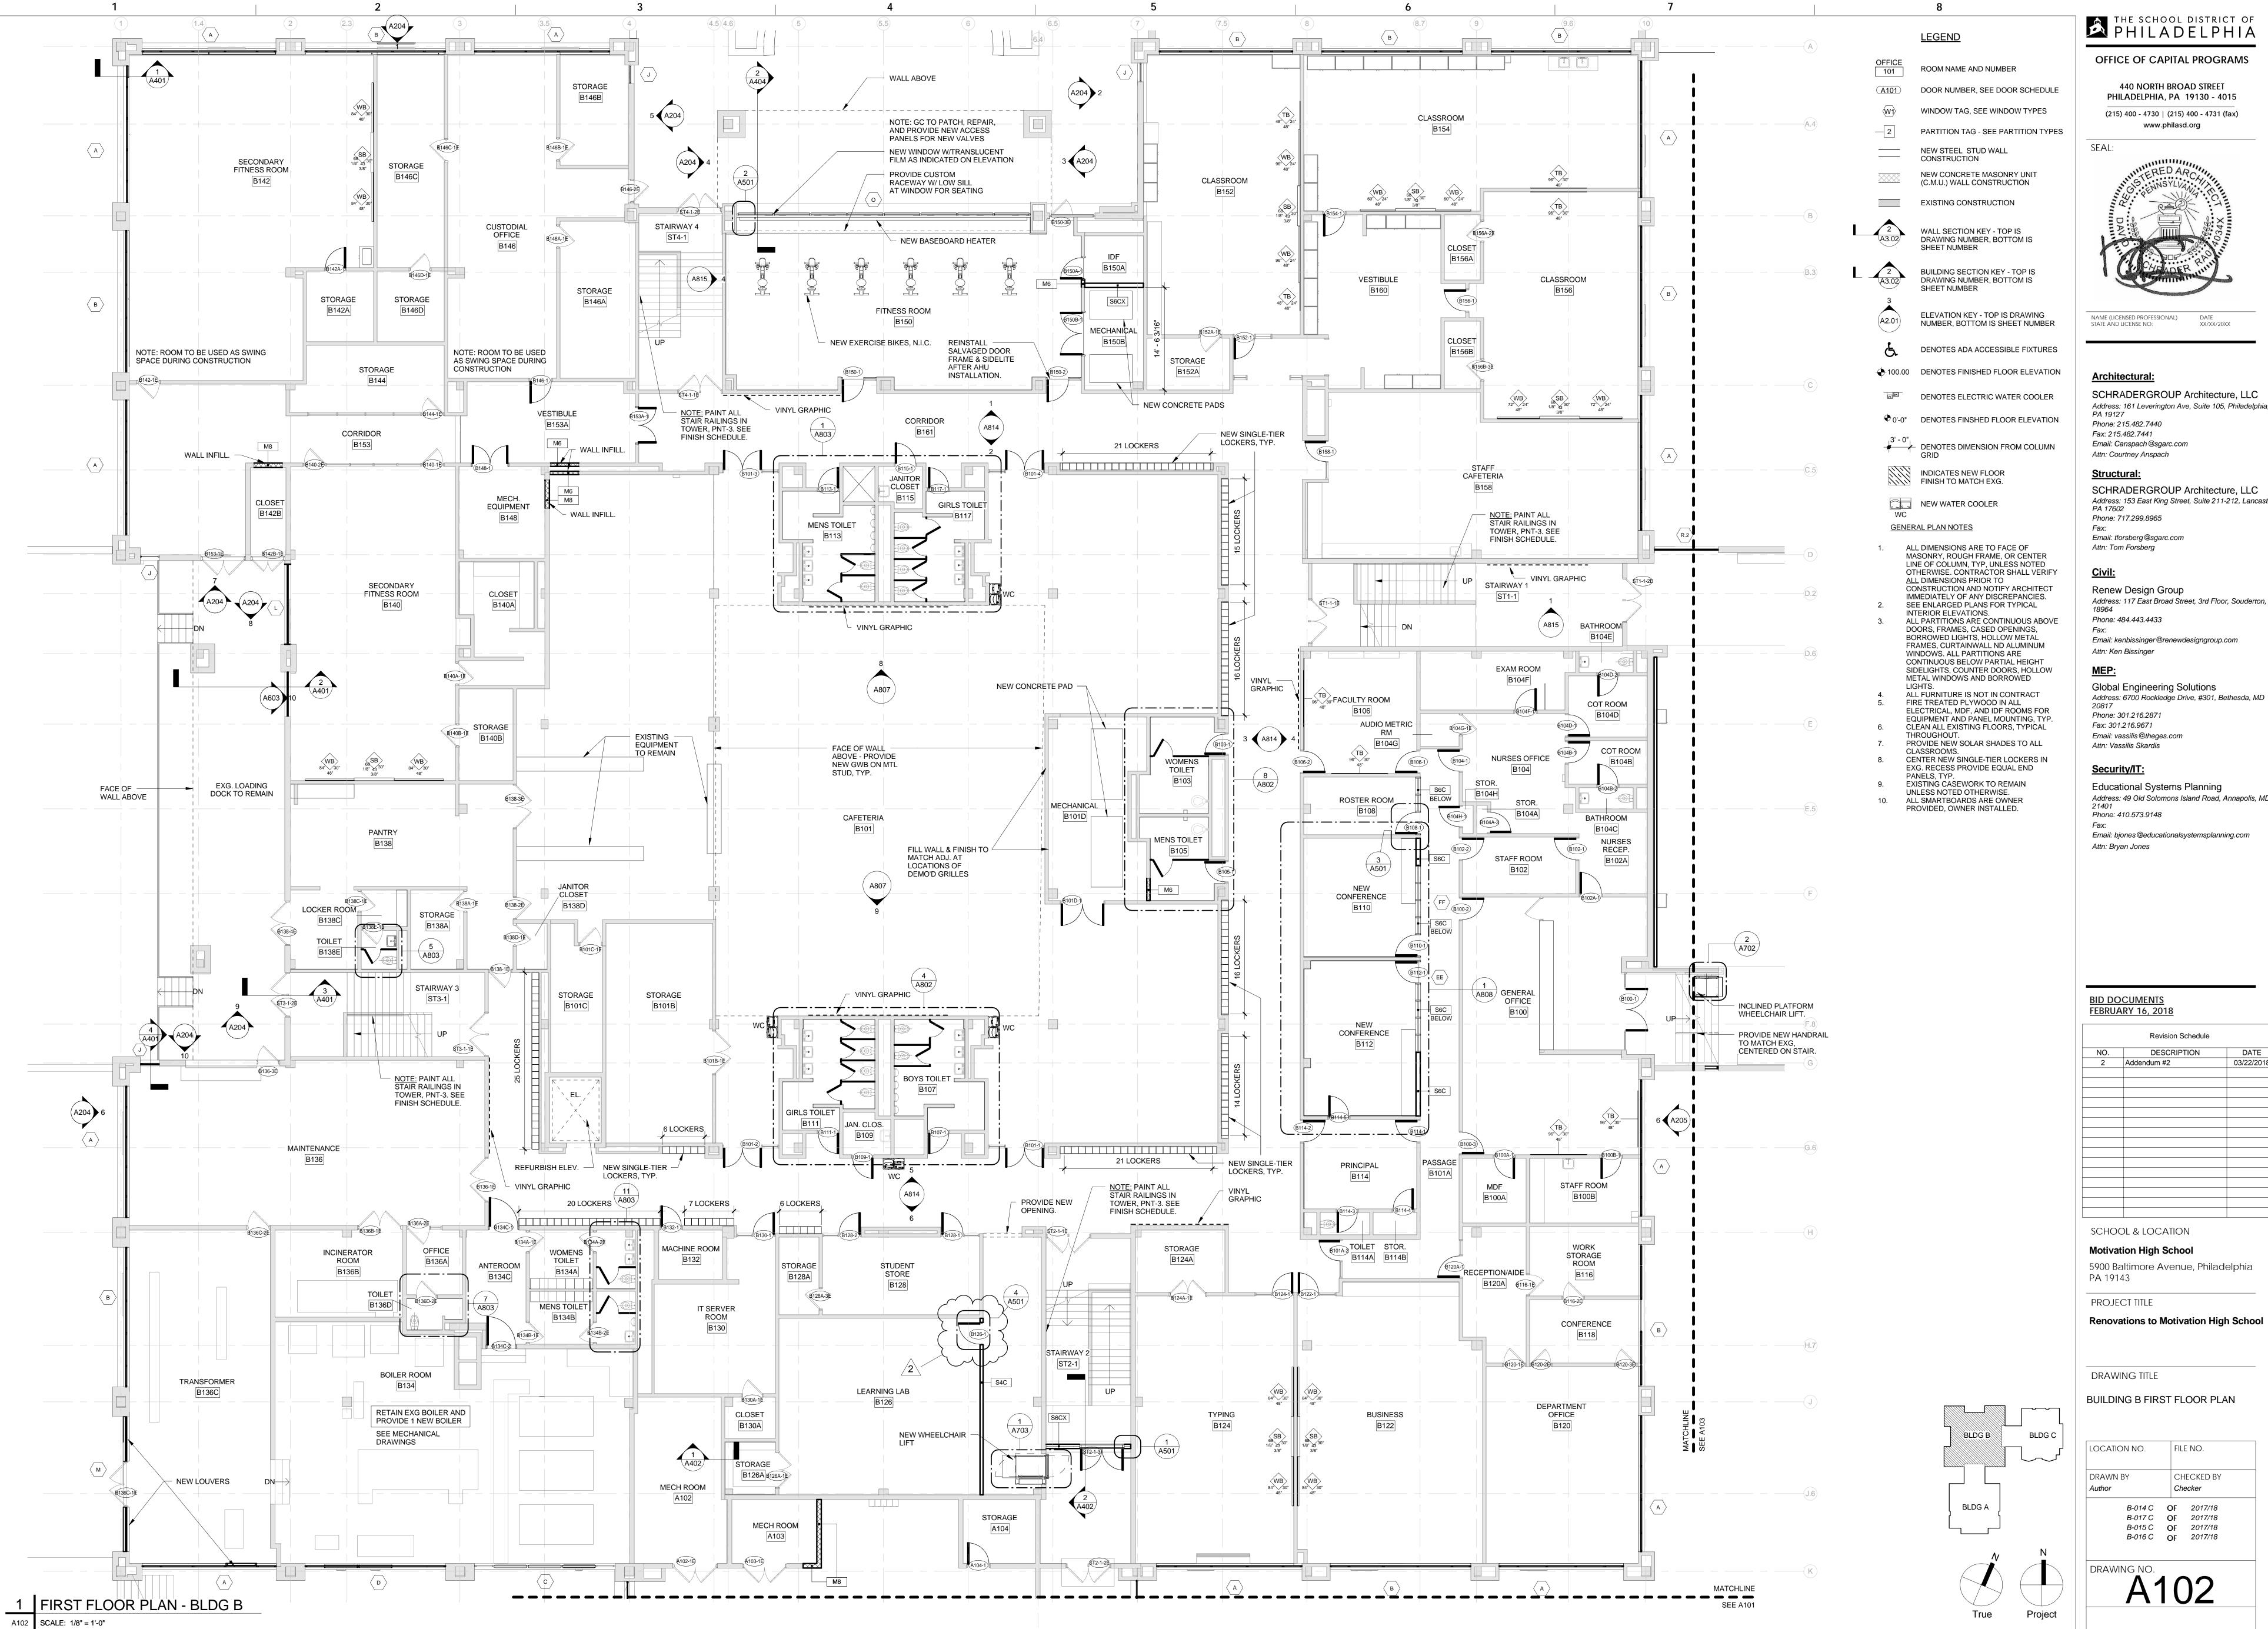

OFFICE OF CAPITAL PROGRAMS

440 NORTH BROAD STREET PHILADELPHIA, PA 19130 - 4015

(215) 400 - 4730 | (215) 400 - 4731 (fax) www.philasd.org

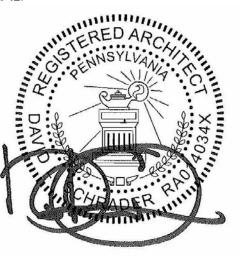

NAME (LICENSED PROFESSIONAL)

**Architectural:** 

SCHRADERGROUP Architecture, LLC Address: 161 Leverington Ave, Suite 105, Philadelphia,

Phone: 215.482.7440 Fax: 215.482.7441

Email: Canspach@sgarc.com Attn: Courtney Anspach

SCHRADERGROUP Architecture, LLC Address: 153 East King Street, Suite 211-212, Lancaster, Phone: 717.299.8965

Email: tforsberg@sgarc.com Attn: Tom Forsberg

Renew Design Group Address: 117 East Broad Street, 3rd Floor, Souderton, PA Phone: 484.443.4433

Email: kenbissinger@renewdesigngroup.com Attn: Ken Bissinger

Global Engineering Solutions Address: 6700 Rockledge Drive, #301, Bethesda, MD Phone: 301.216.2871

Fax: 301.216.9671 Email: vassilis@theges.com Attn: Vassilis Skardis

**Educational Systems Planning** Address: 49 Old Solomons Island Road, Annapolis, MD

Phone: 410.573.9148

Email: bjones@educationalsystemsplanning.com Attn: Bryan Jones

Revision Schedule DESCRIPTION 03/22/2018 Addendum #2

SCHOOL & LOCATION **Motivation High School** 5900 Baltimore Avenue, Philadelphia


PROJECT TITLE


DRAWING TITLE

BUILDING B FIRST FLOOR PLAN

LOCATION NO. FILE NO. CHECKED BY DRAWN BY

B-017 C OF 2017/18 B-015 C OF 2017/18 B-016 C OF 2017/18

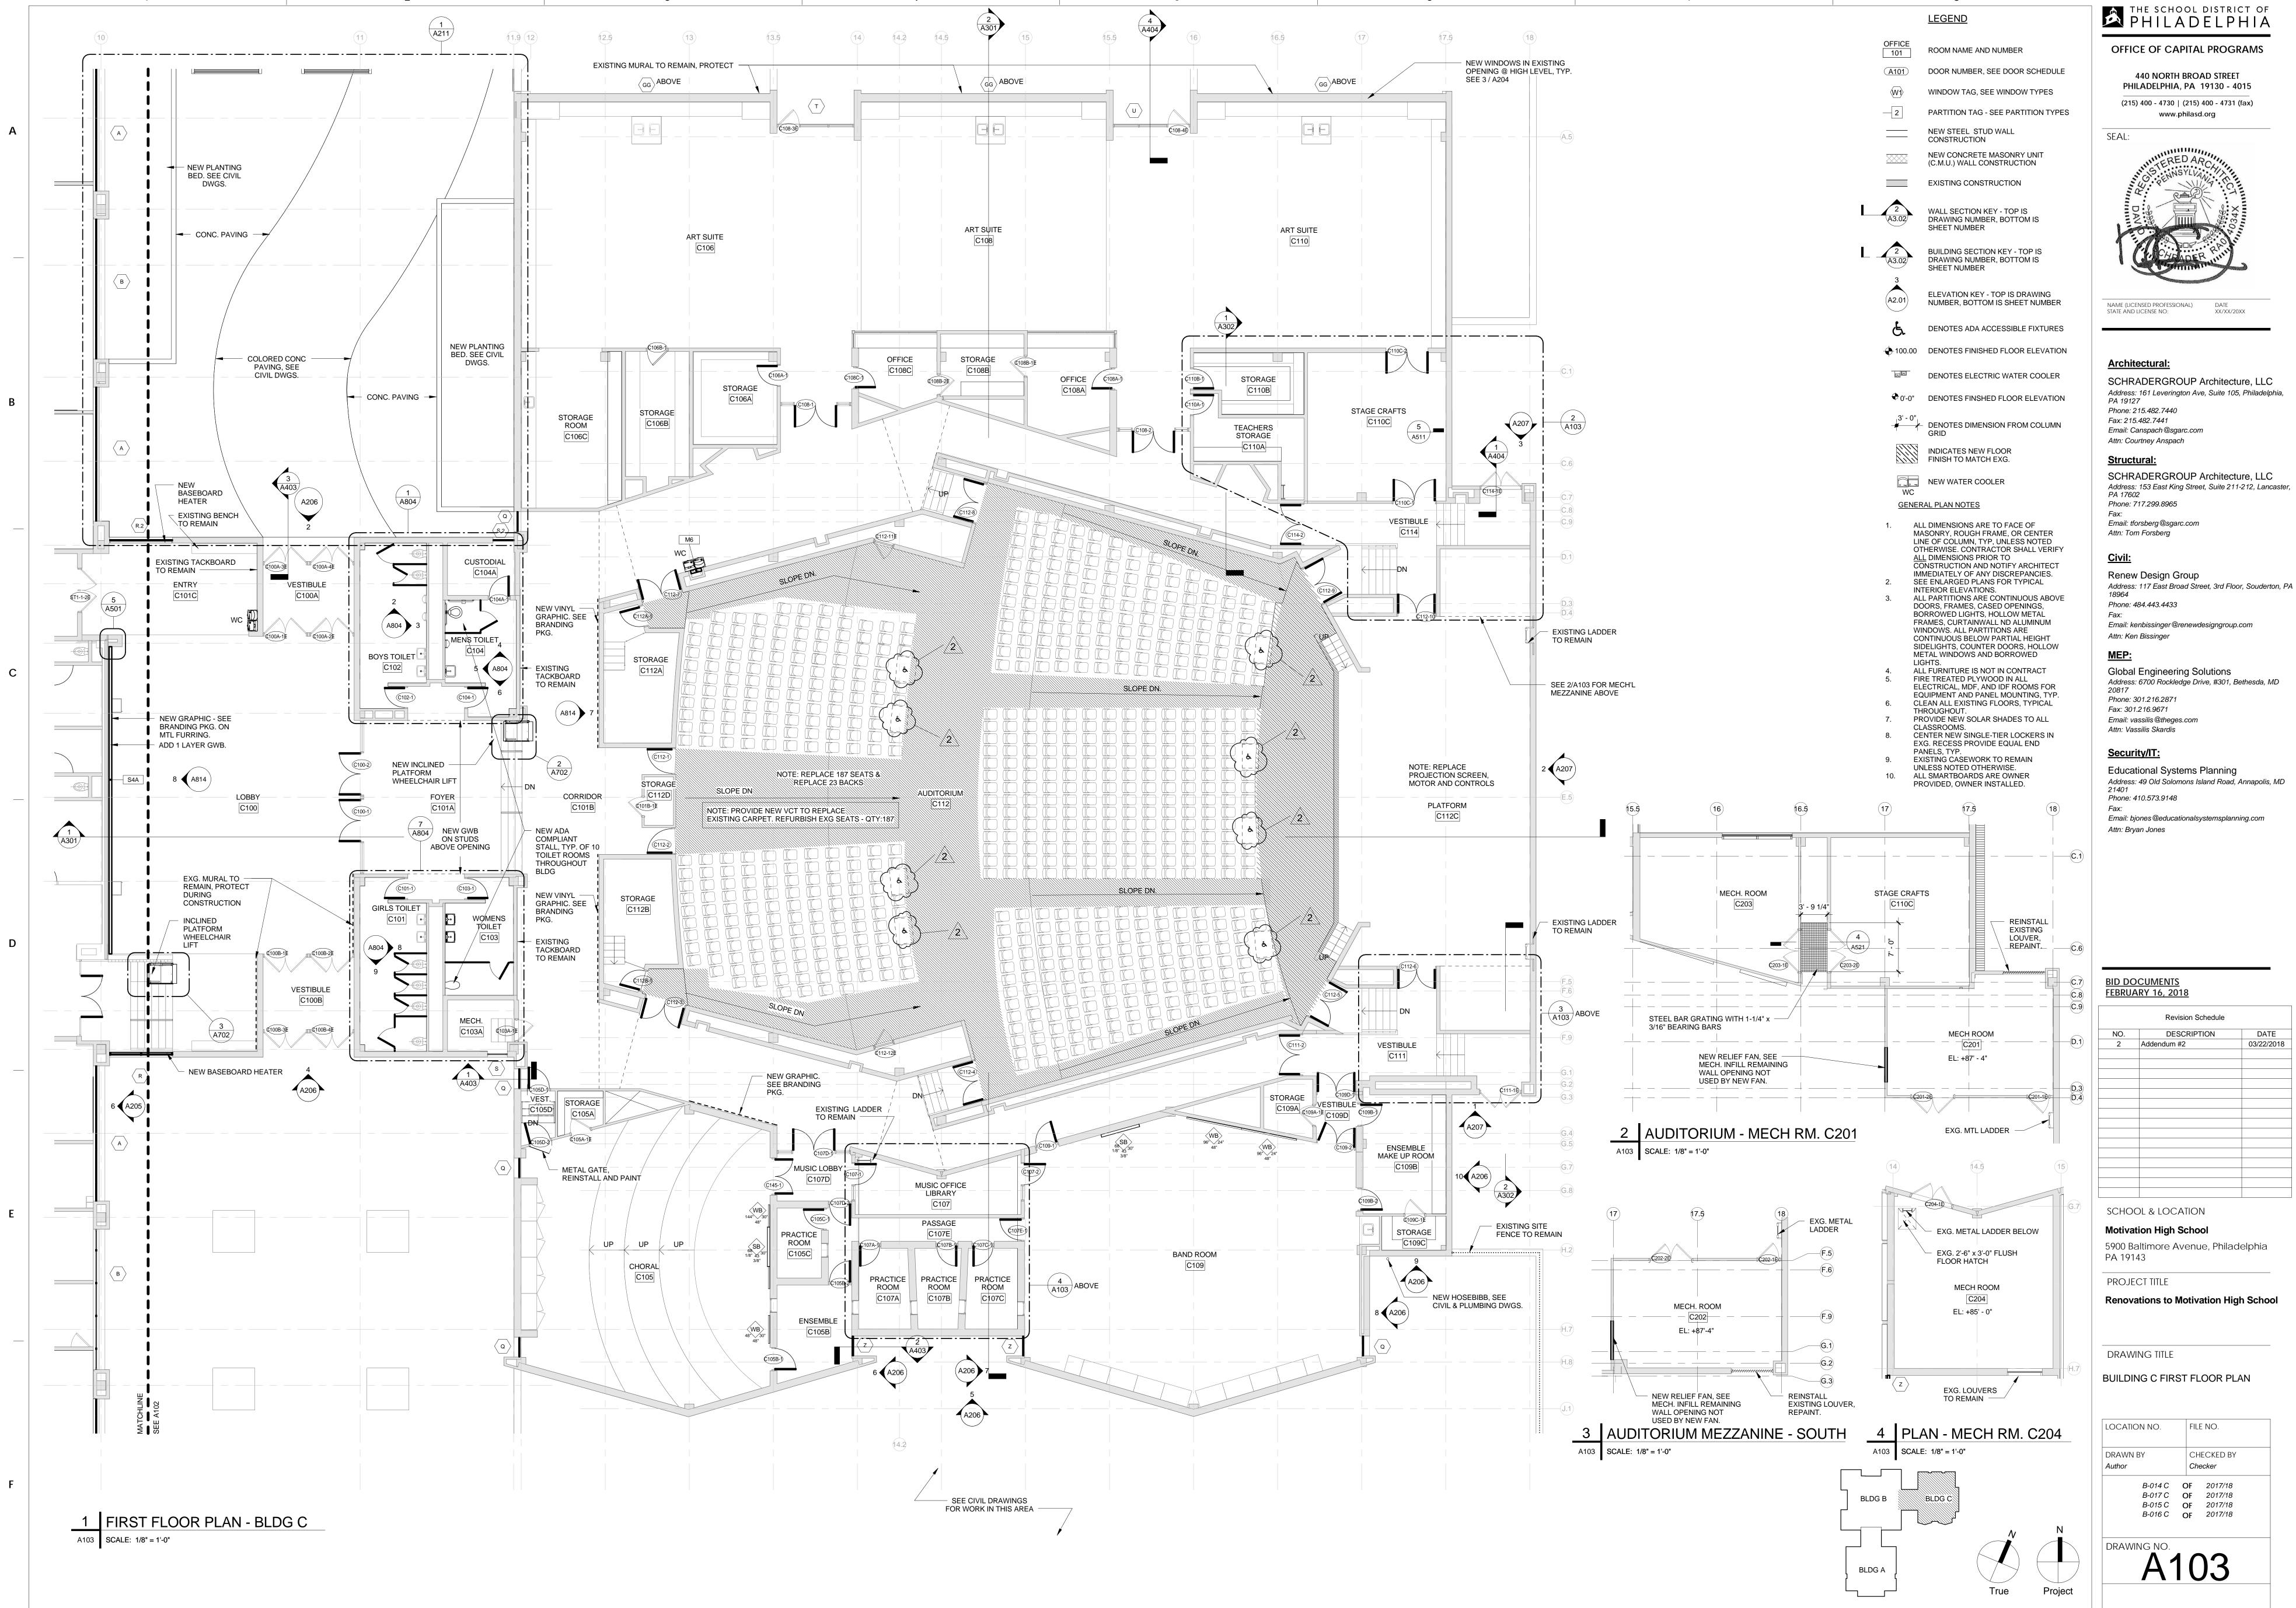

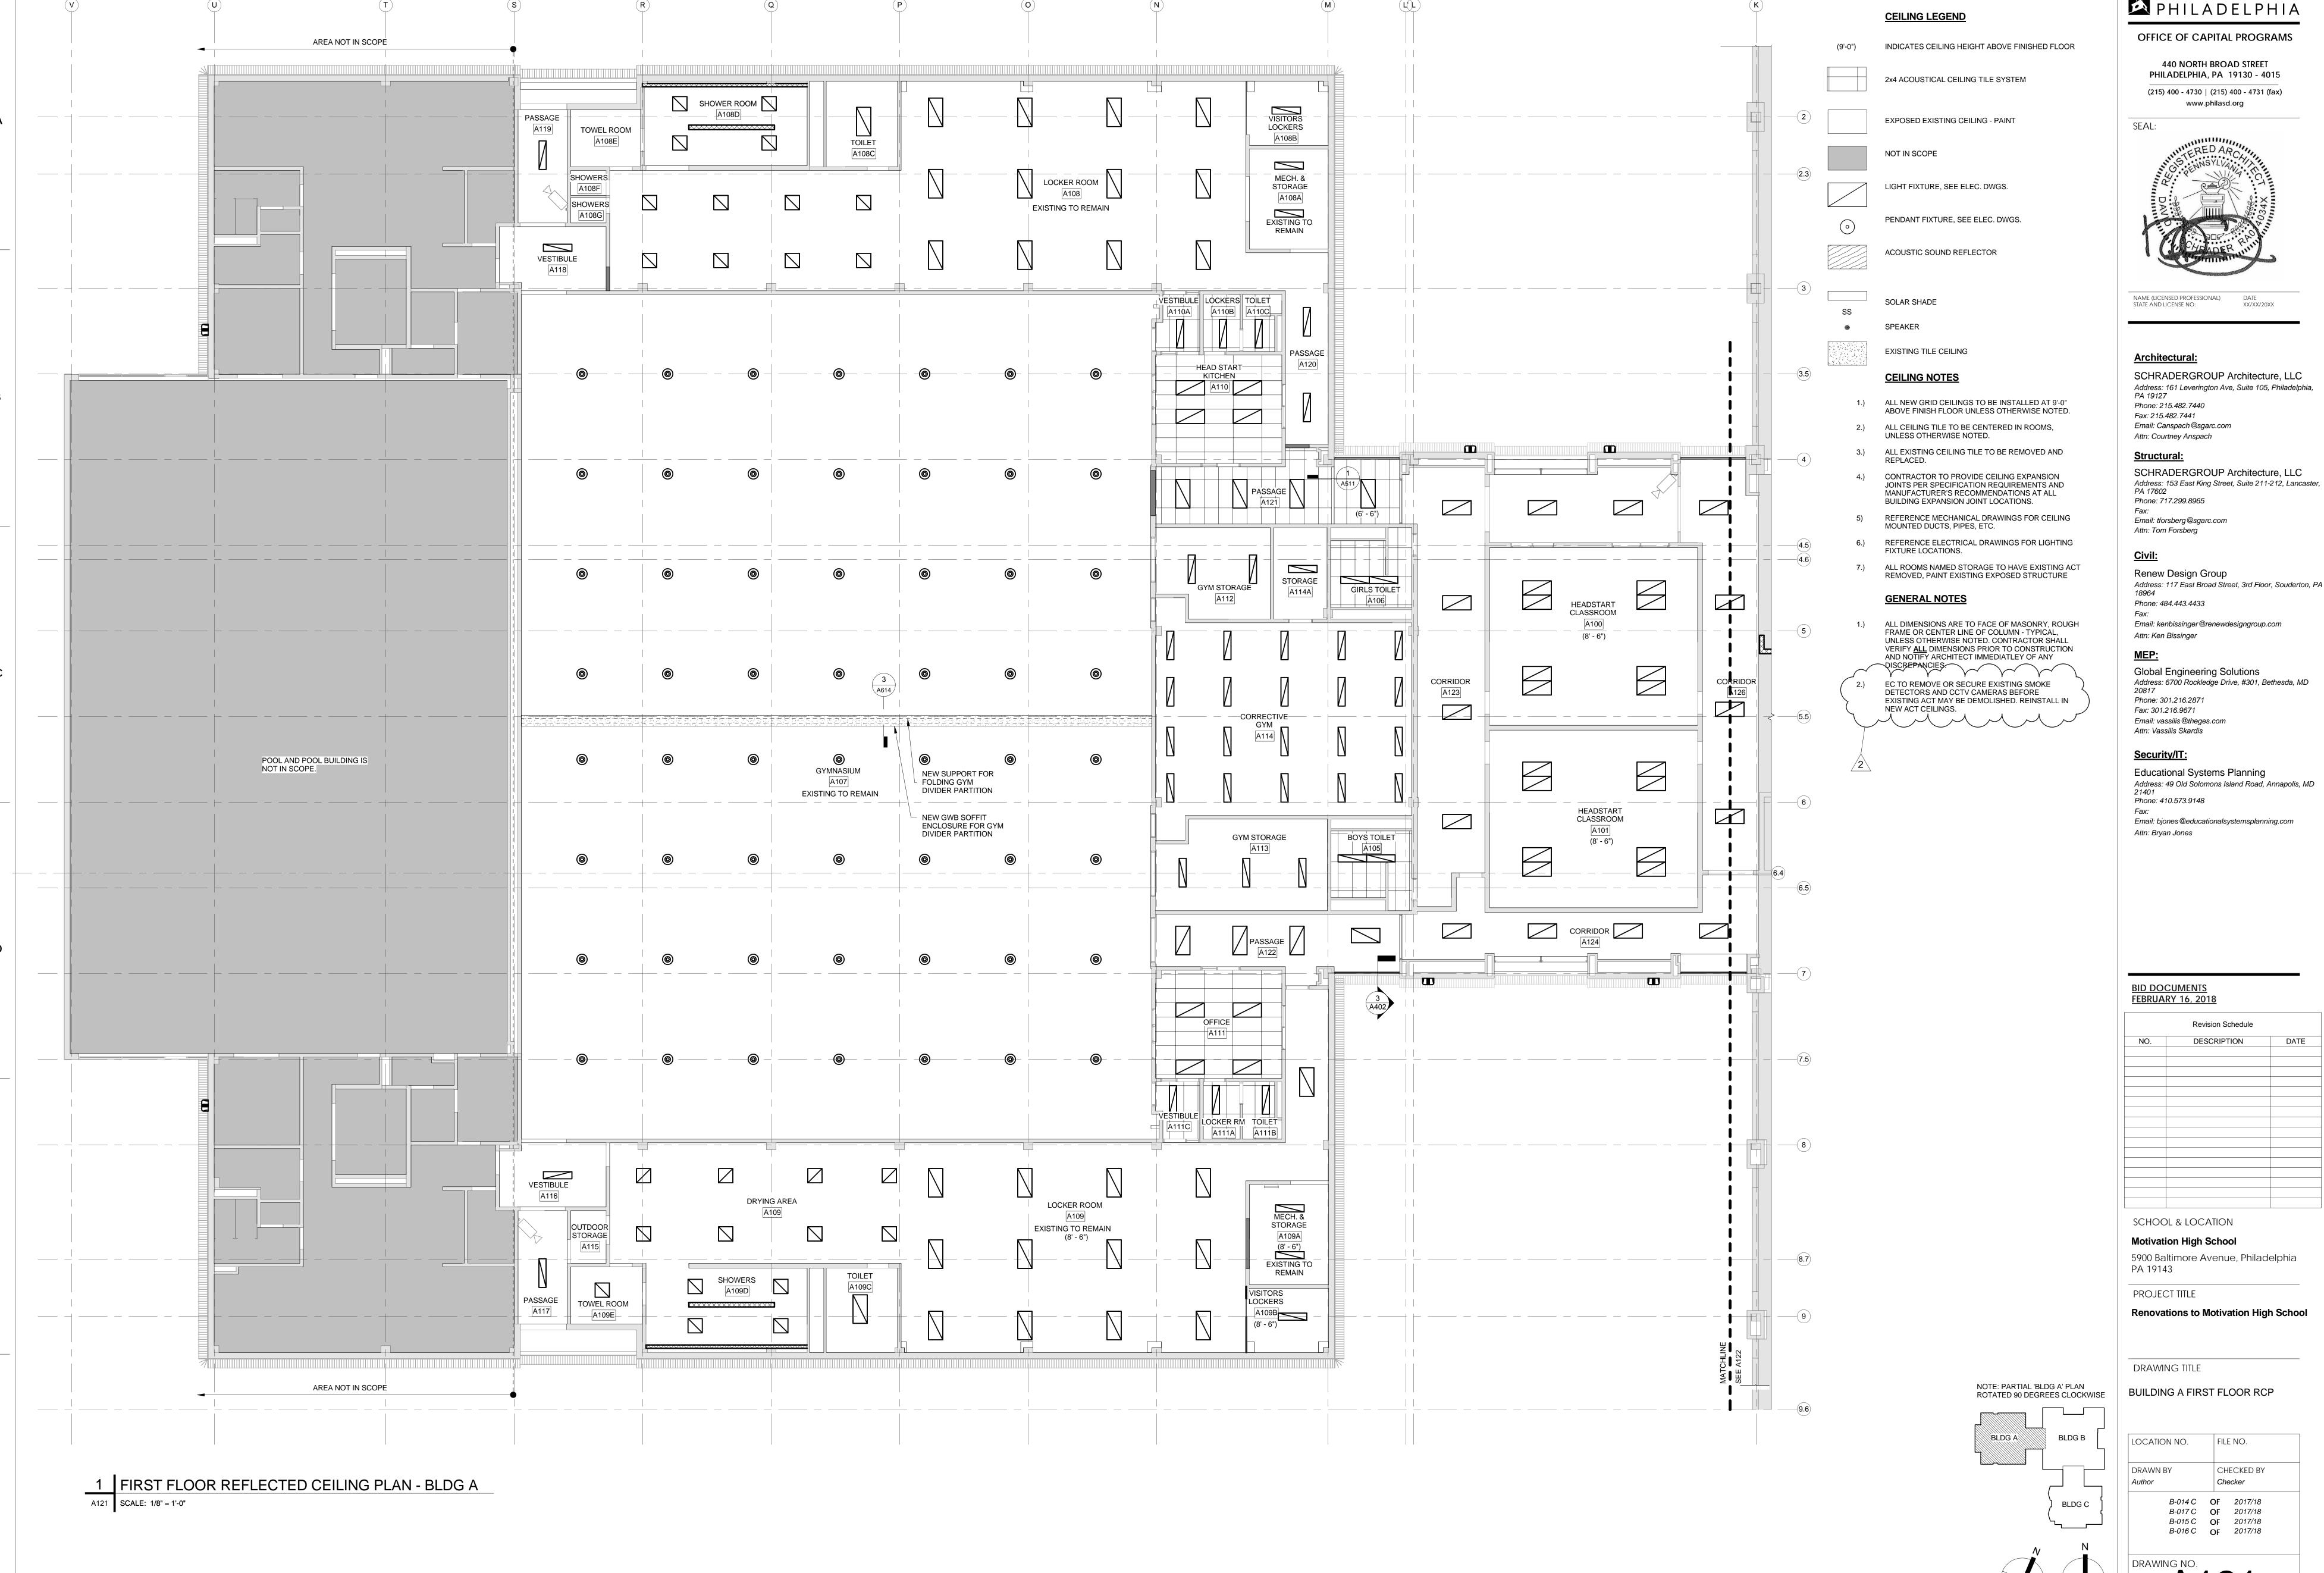

OFFICE OF CAPITAL PROGRAMS

440 NORTH BROAD STREET PHILADELPHIA, PA 19130 - 4015



NAME (LICENSED PROFESSIONAL)

SCHRADERGROUP Architecture, LLC Address: 161 Leverington Ave, Suite 105, Philadelphia,

Address: 117 East Broad Street, 3rd Floor, Souderton, PA

Email: kenbissinger@renewdesigngroup.com

Global Engineering Solutions Address: 6700 Rockledge Drive, #301, Bethesda, MD

**Educational Systems Planning** Address: 49 Old Solomons Island Road, Annapolis, MD

Email: bjones@educationalsystemsplanning.com


Revision Schedule DESCRIPTION

SCHOOL & LOCATION **Motivation High School** 5900 Baltimore Avenue, Philadelphia

Renovations to Motivation High School

BUILDING A FIRST FLOOR RCP


FILE NO. CHECKED BY B-014 C OF 2017/18 B-017 C OF 2017/18 B-015 C OF 2017/18 B-016 C OF 2017/18

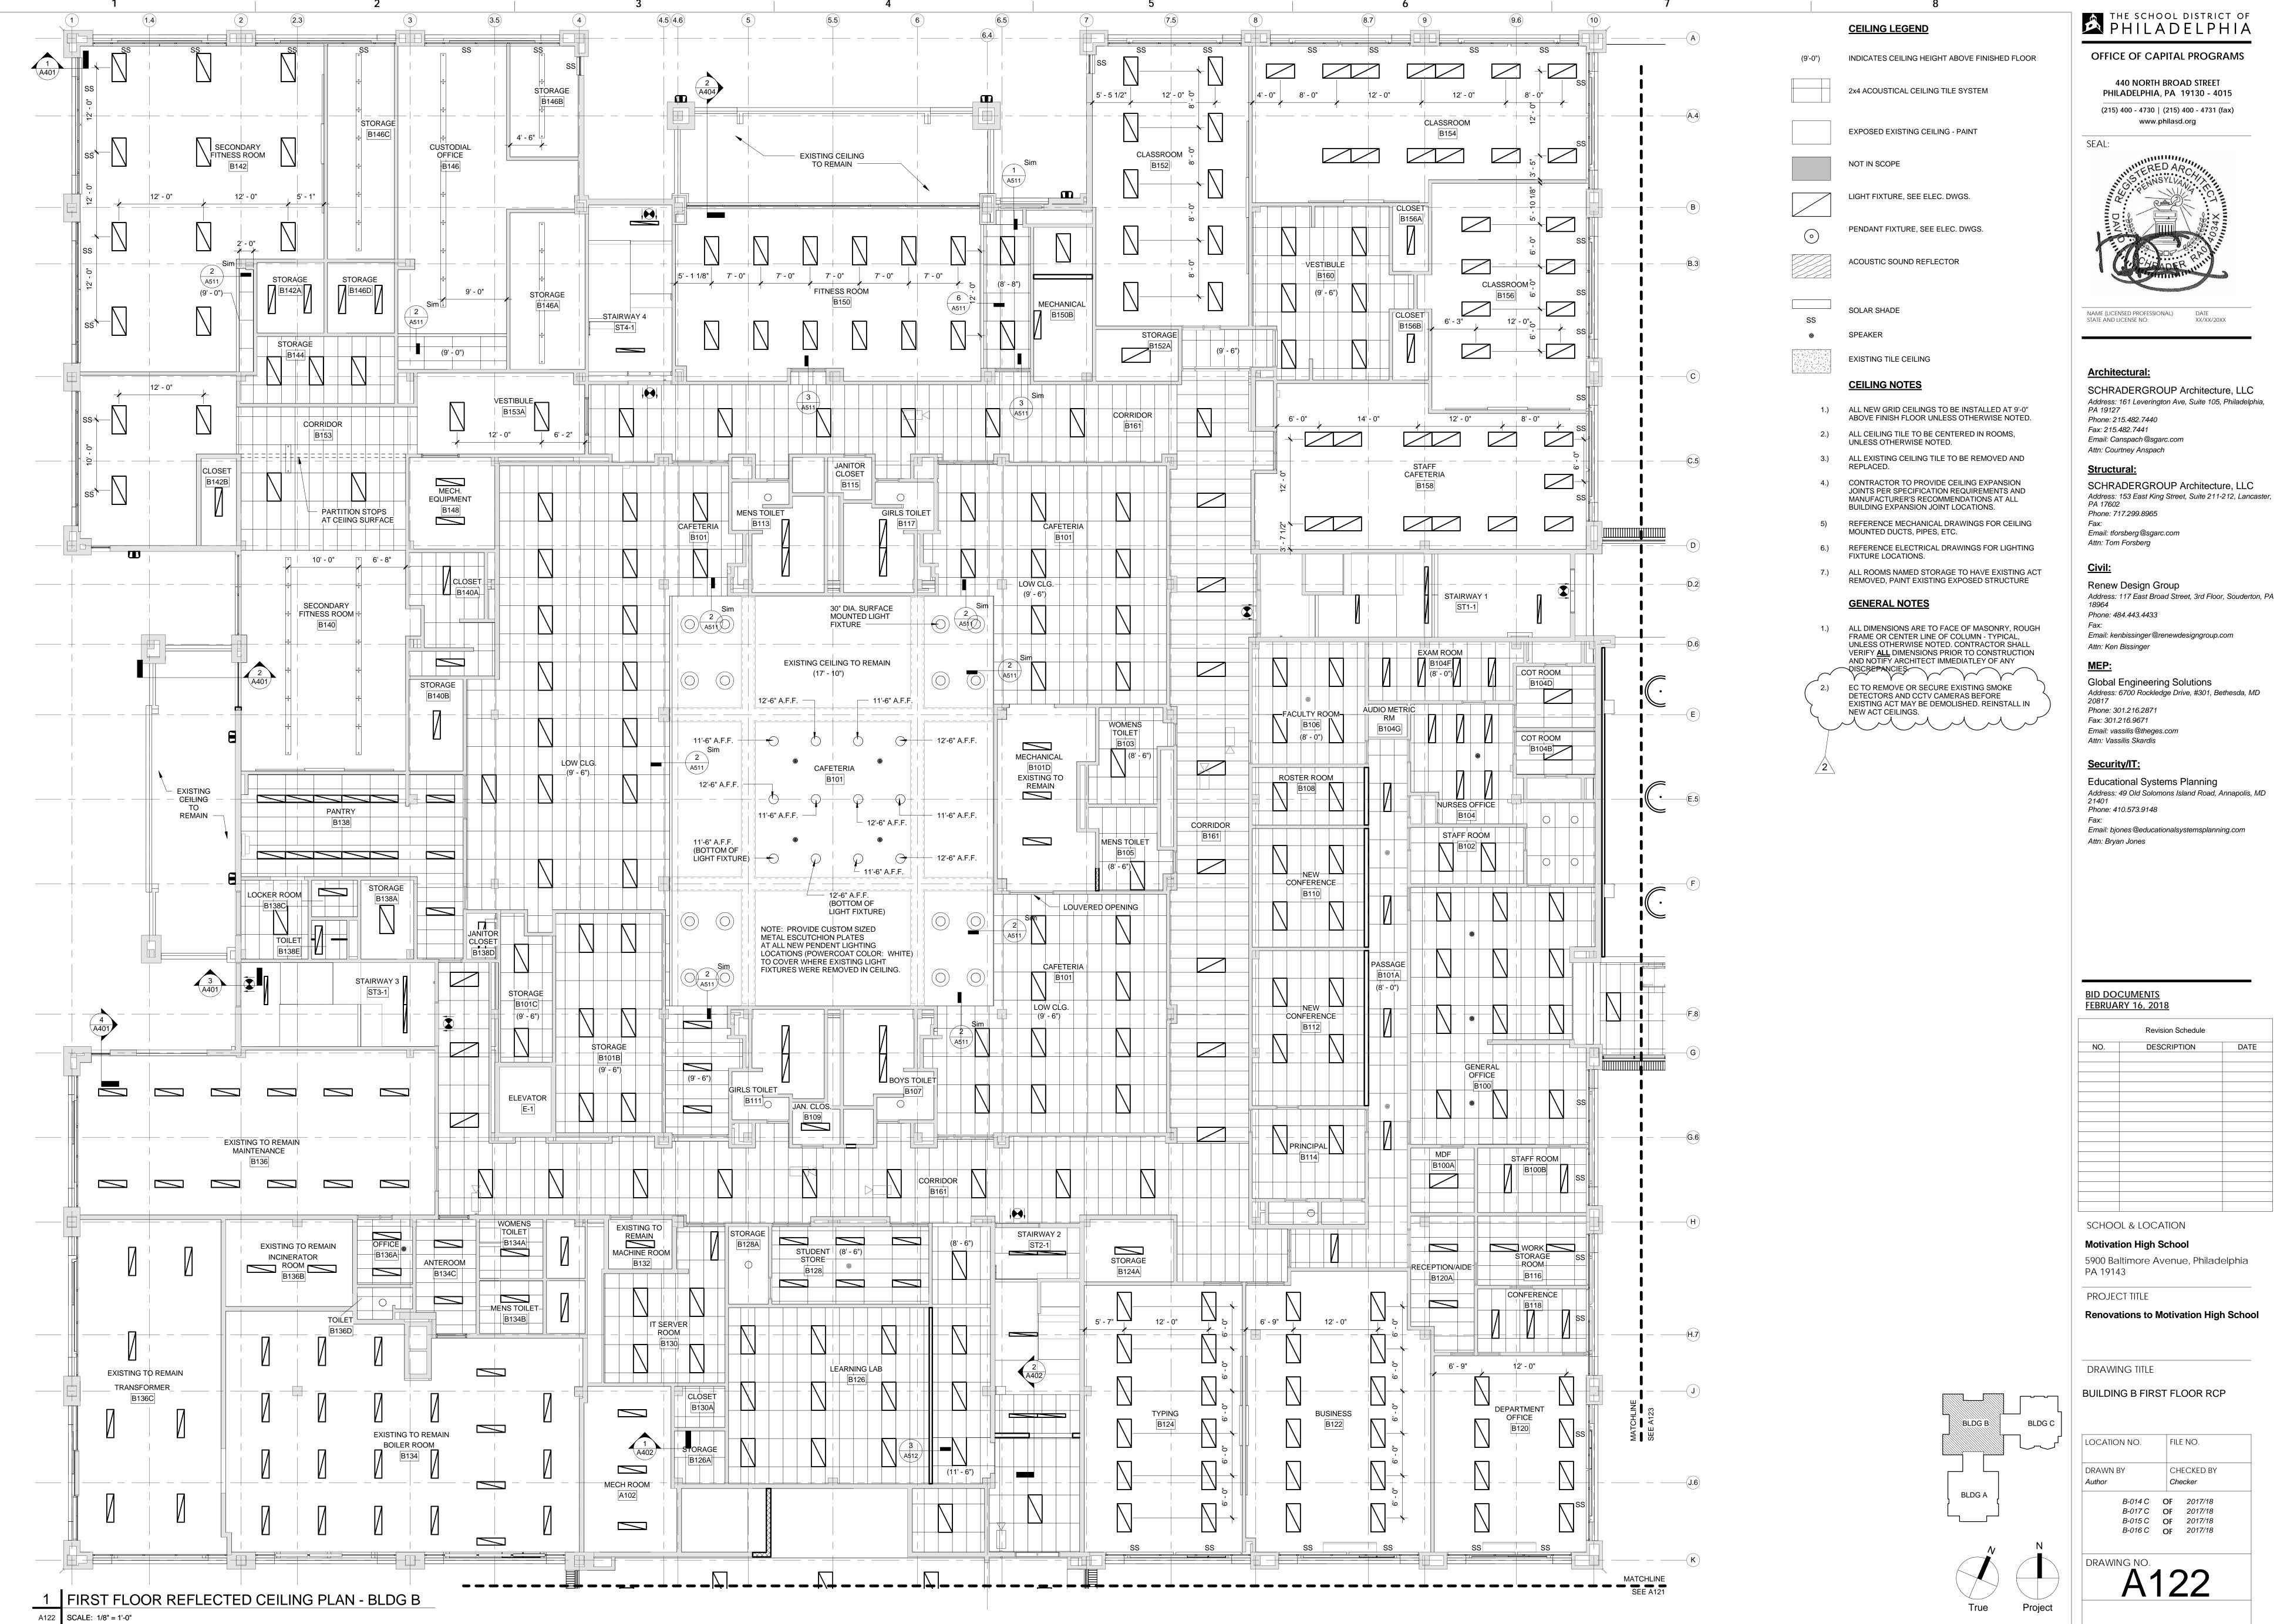

OFFICE OF CAPITAL PROGRAMS

440 NORTH BROAD STREET PHILADELPHIA, PA 19130 - 4015

www.philasd.org

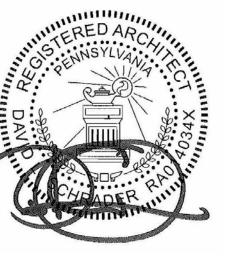

NAME (LICENSED PROFESSIONAL) STATE AND LICENSE NO:

**Architectural:** 

SCHRADERGROUP Architecture, LLC Address: 161 Leverington Ave, Suite 105, Philadelphia,

PA 19127 Phone: 215.482.7440 Fax: 215.482.7441

Email: Canspach@sgarc.com Attn: Courtney Anspach

Fax: 301.216.9671 Email: vassilis@theges.com

**Educational Systems Planning** Address: 49 Old Solomons Island Road, Annapolis, MD

Phone: 410.573.9148

Email: bjones@educationalsystemsplanning.com Attn: Bryan Jones

FEBRUARY 16, 2018 Revision Schedule DESCRIPTION

SCHOOL & LOCATION Motivation High School


PROJECT TITLE


Renovations to Motivation High School


DRAWING TITLE

BUILDING B FIRST FLOOR RCP

LOCATION NO. FILE NO. CHECKED BY B-017 C OF 2017/18 B-015 C OF 2017/18 B-016 C OF 2017/18

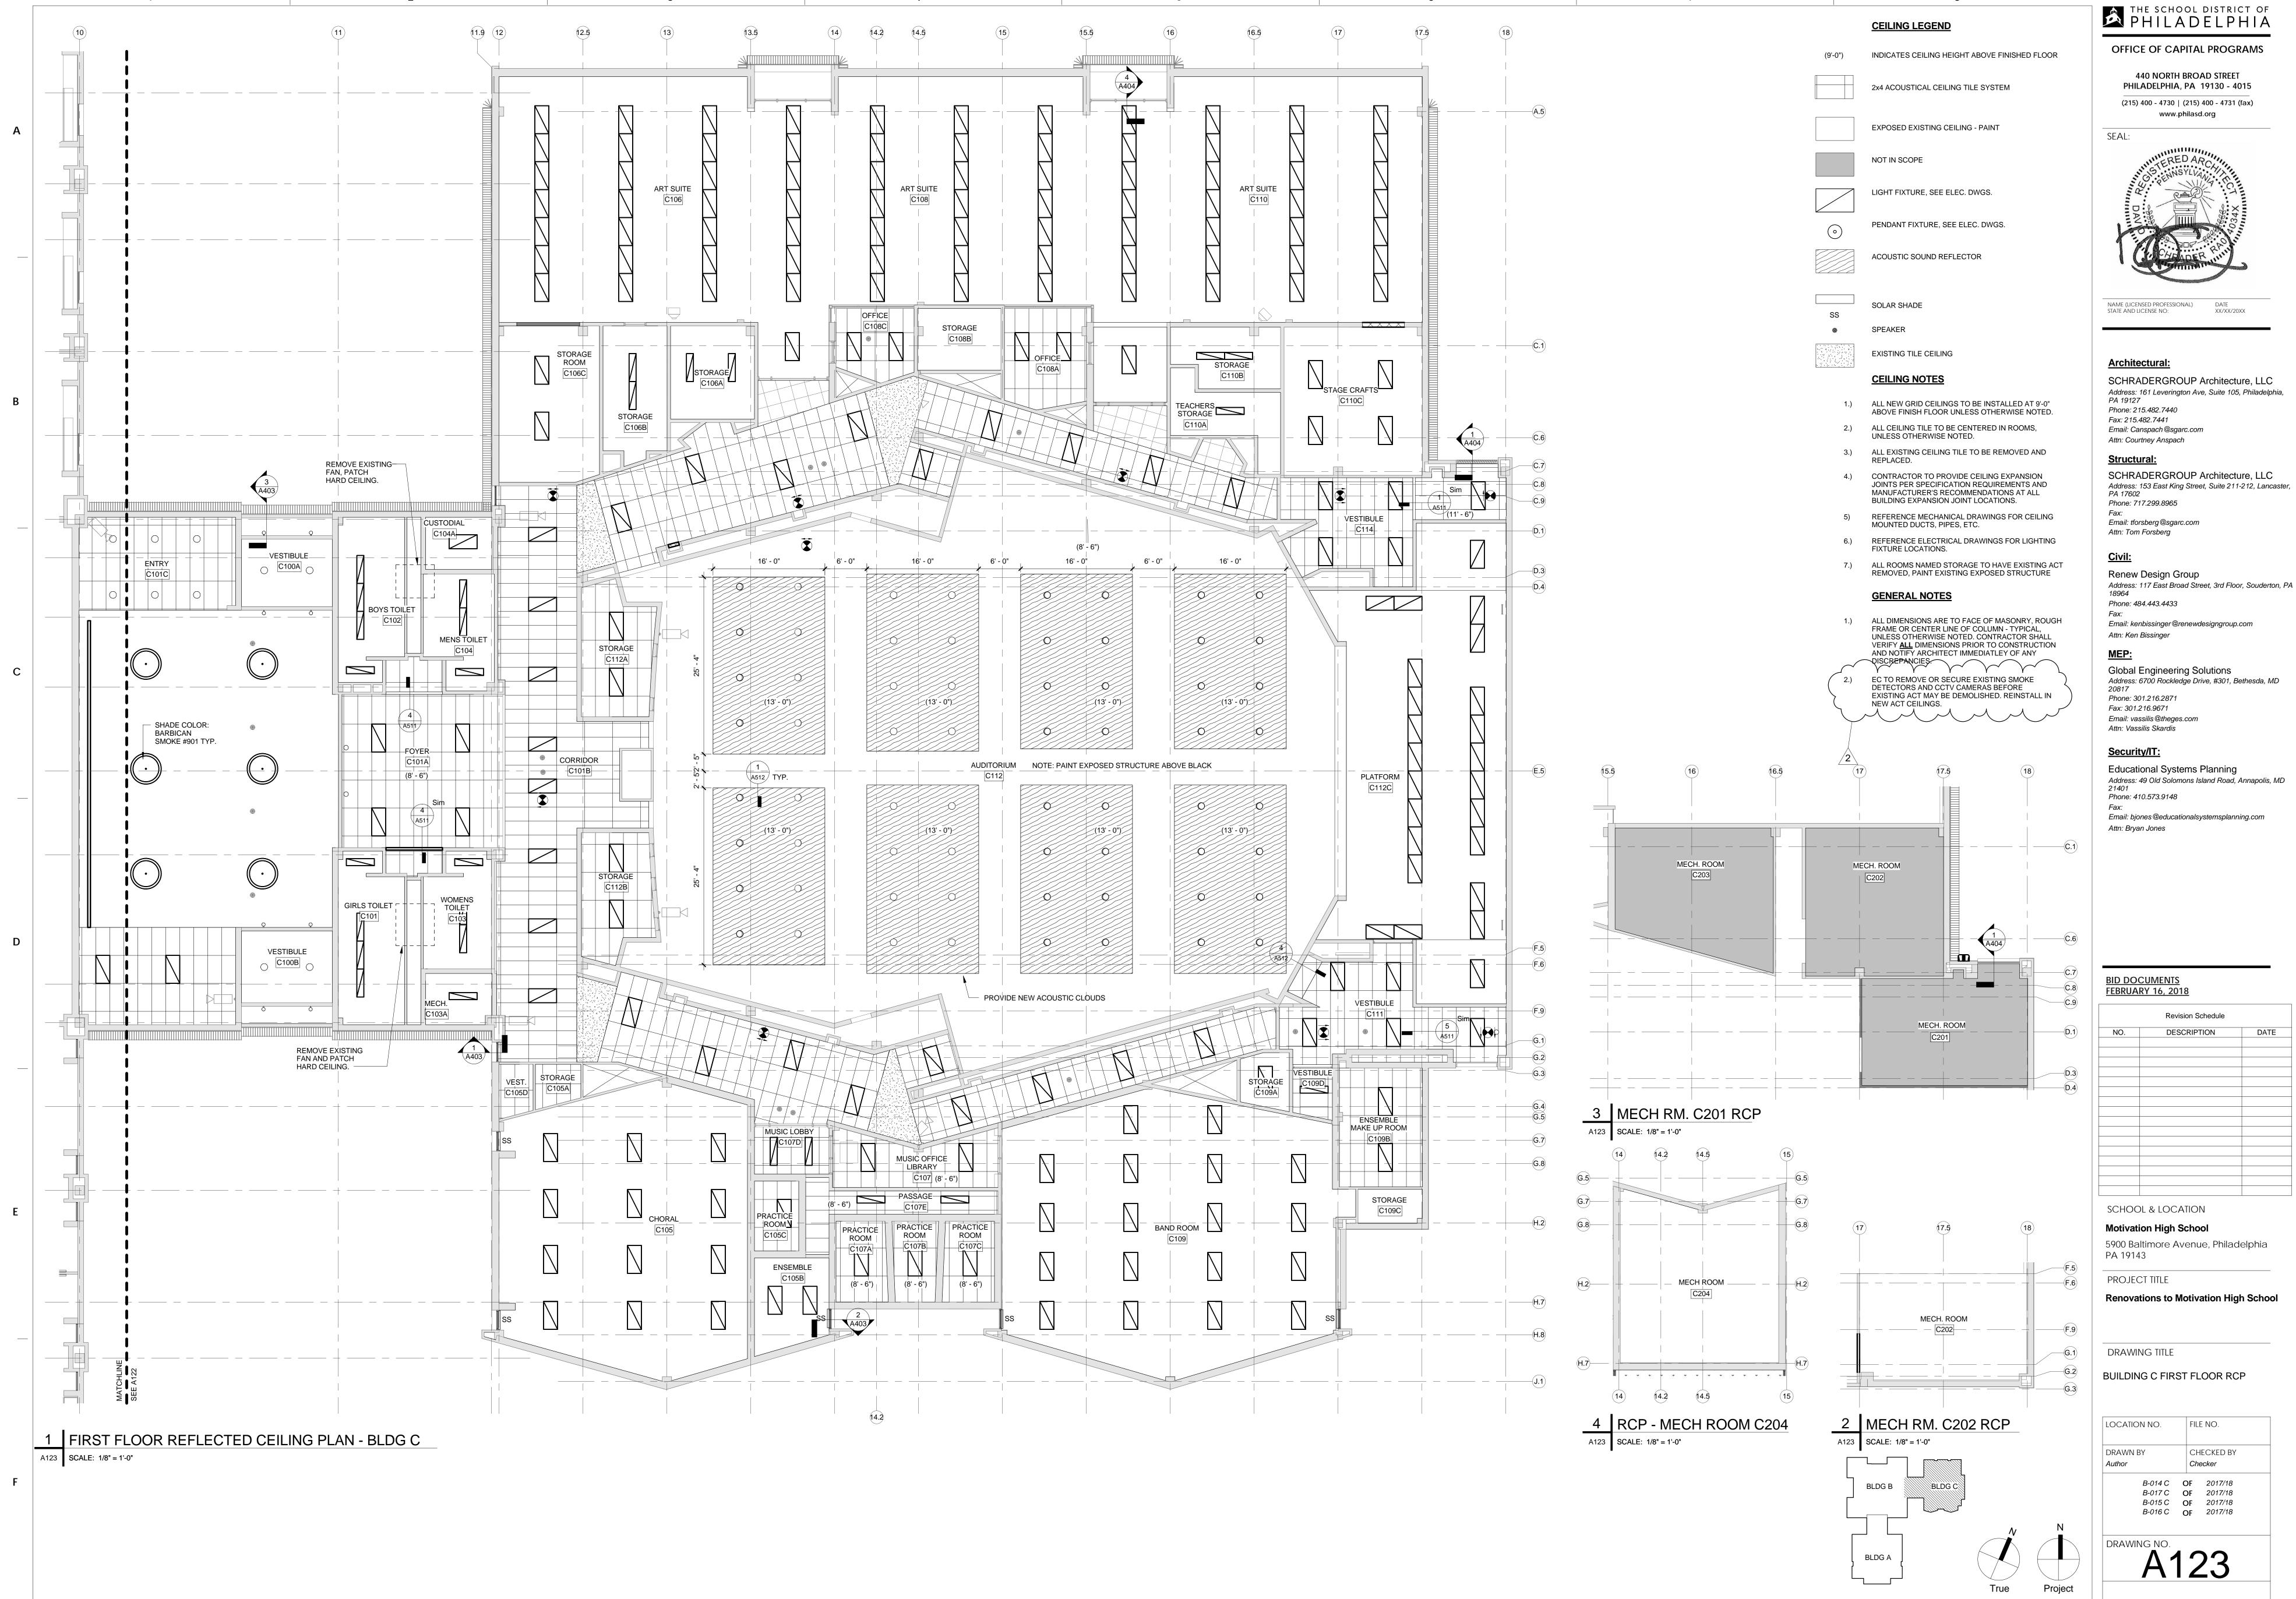

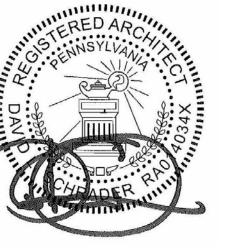

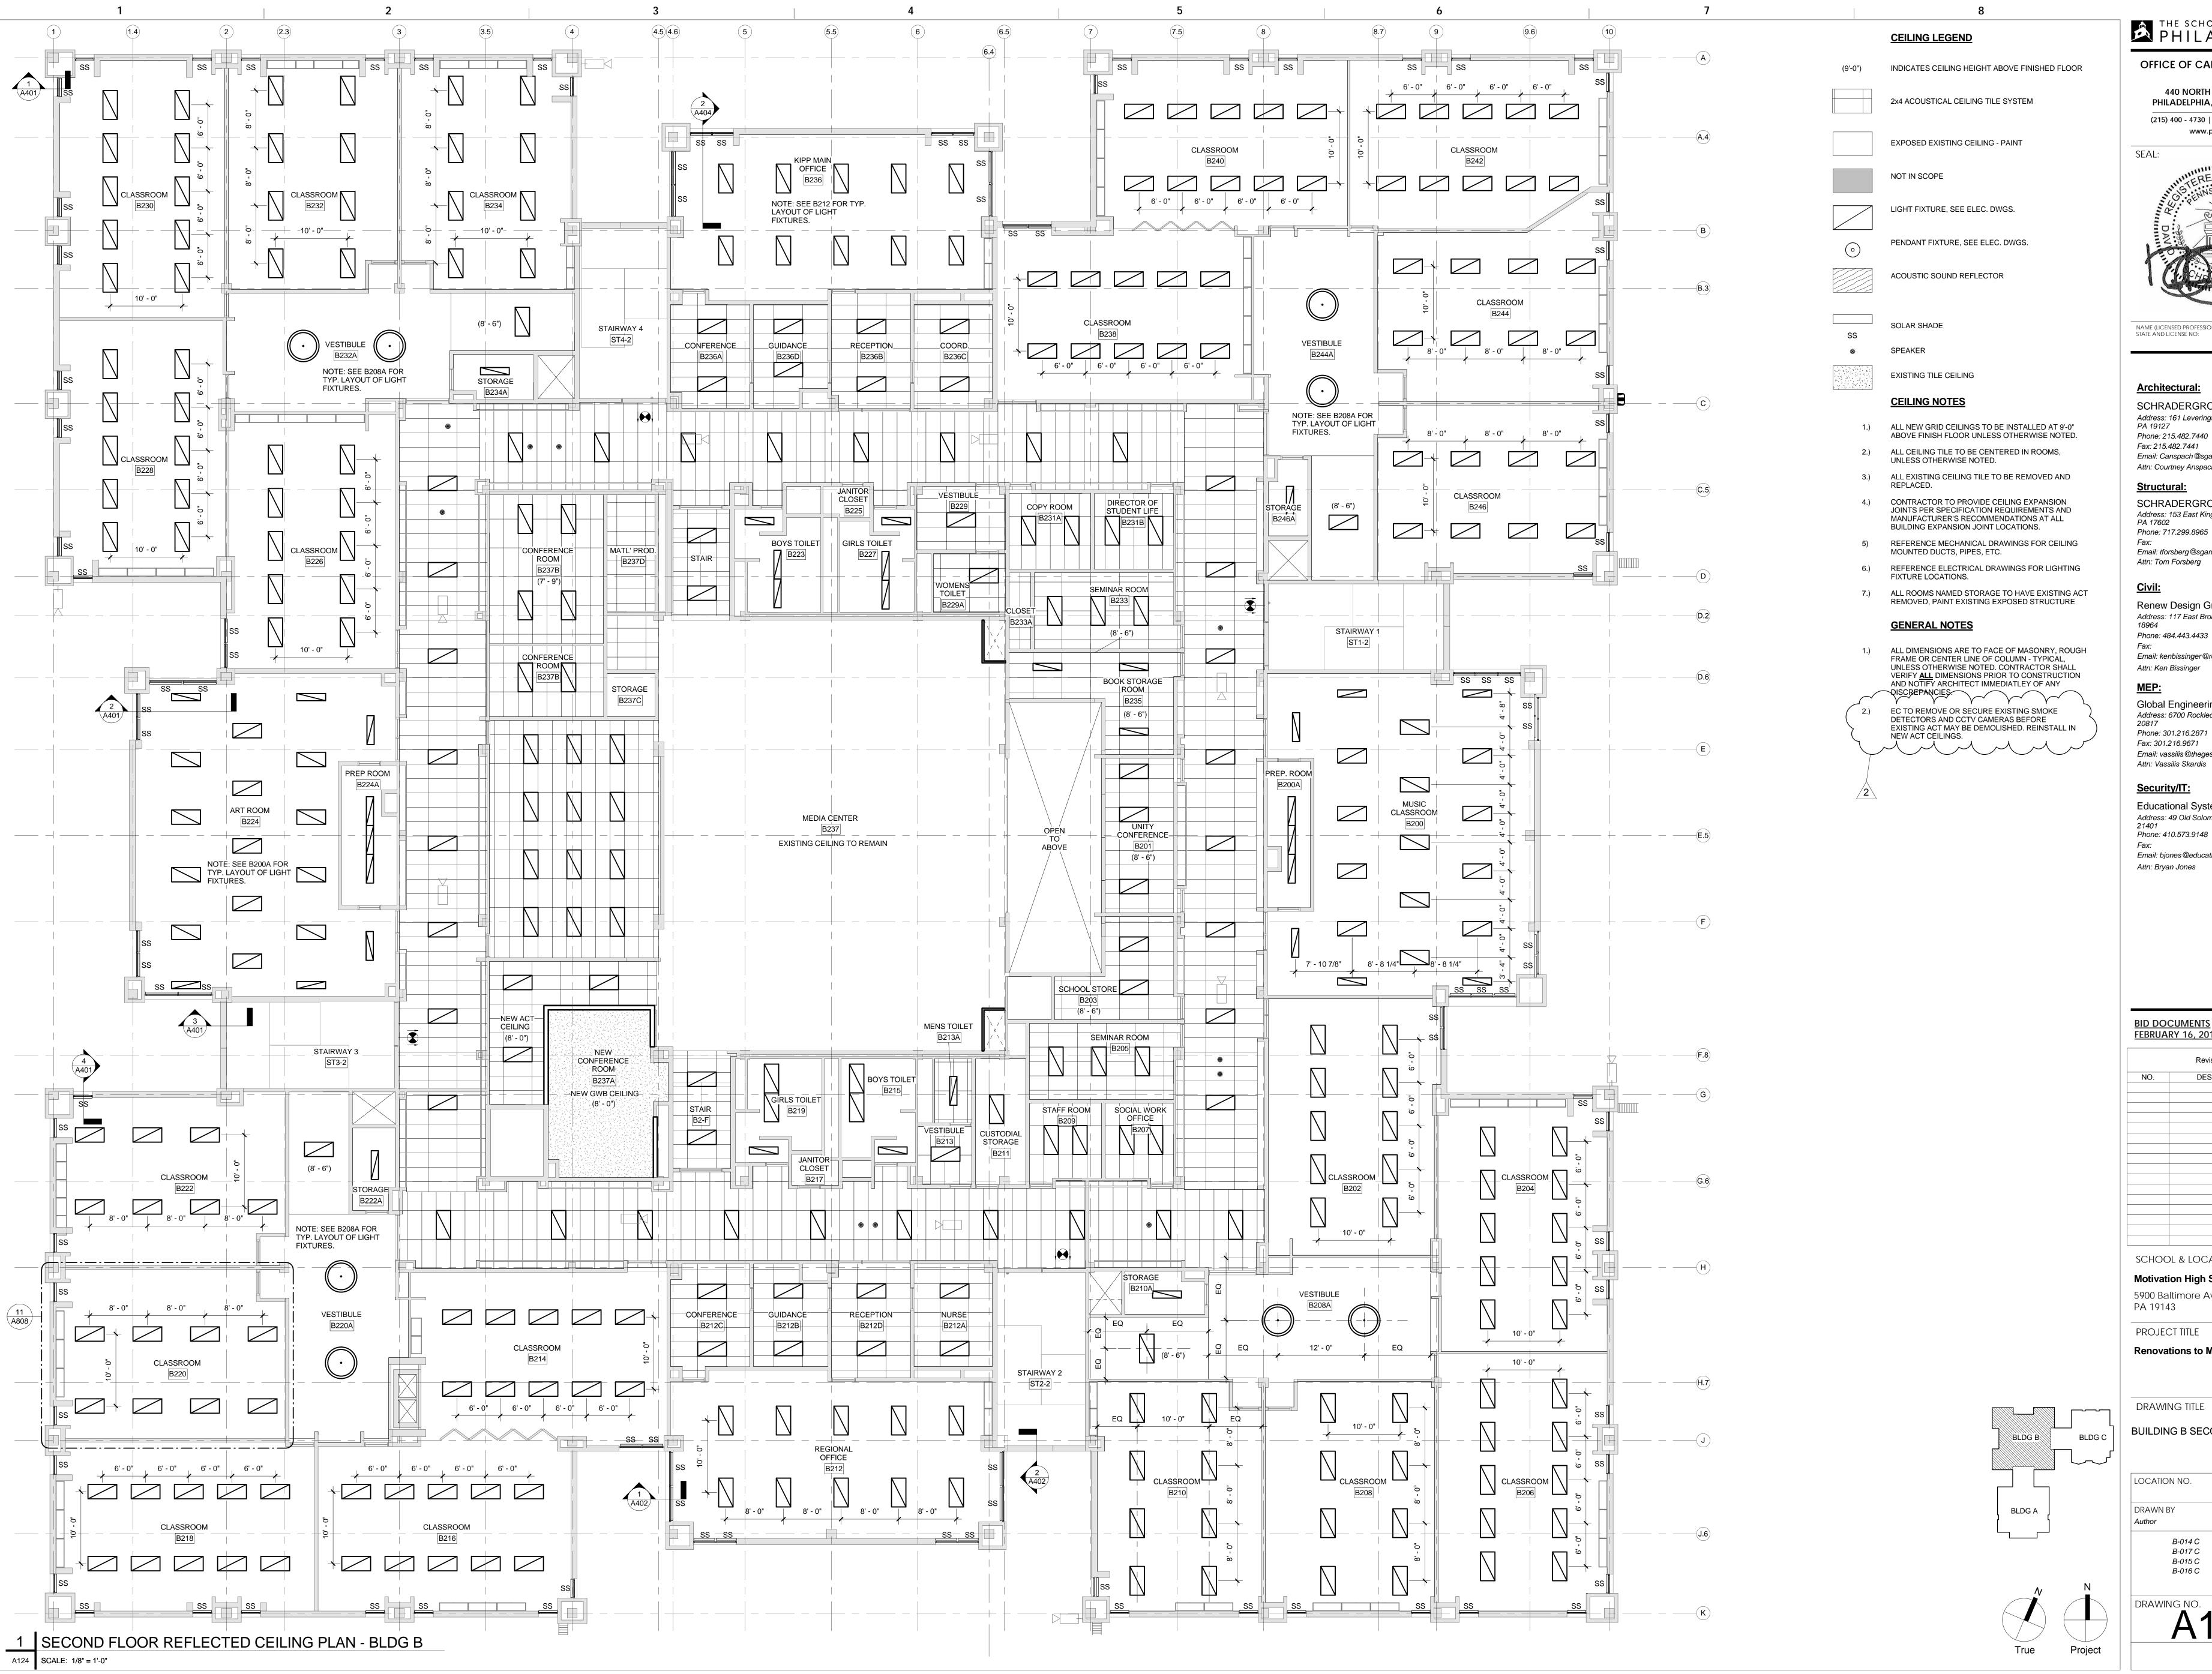


OFFICE OF CAPITAL PROGRAMS

(215) 400 - 4730 | (215) 400 - 4731 (fax) www.philasd.org

440 NORTH BROAD STREET PHILADELPHIA, PA 19130 - 4015

SEAL:

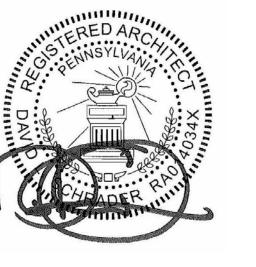

NAME (LICENSED PROFESSIONAL) STATE AND LICENSE NO:

**Architectural:** 

SCHRADERGROUP Architecture, LLC Address: 161 Leverington Ave, Suite 105, Philadelphia,

Phone: 215.482.7440 Fax: 215.482.7441 Email: Canspach@sgarc.com Attn: Courtney Anspach

Structural: SCHRADERGROUP Architecture, LLC

PA 19127

Address: 153 East King Street, Suite 211-212, Lancaster, PA 17602

Phone: 717.299.8965

Email: tforsberg@sgarc.com Attn: Tom Forsberg

Civil:

Renew Design Group Address: 117 East Broad Street, 3rd Floor, Souderton, PA 18964 Phone: 484.443.4433

Email: kenbissinger@renewdesigngroup.com Attn: Ken Bissinger

Global Engineering Solutions
Address: 6700 Rockledge Drive, #301, Bethesda, MD Phone: 301.216.2871

Fax: 301.216.9671 Email: vassilis@theges.com Attn: Vassilis Skardis

Security/IT:

**Educational Systems Planning** Address: 49 Old Solomons Island Road, Annapolis, MD

Email: bjones@educationalsystemsplanning.com Attn: Bryan Jones

BID DOCUMENTS FEBRUARY 16, 2018						
	Revision Schedule					
NO.	DESCRIPTION	DATE				

SCHOOL & LOCATION **Motivation High School** 5900 Baltimore Avenue, Philadelphia

PROJECT TITLE


Renovations to Motivation High School

DRAWING TITLE

BUILDING B SECOND FLOOR RCP

FILE NO. LOCATION NO. DRAWN BY CHECKED BY B-017 C OF 2017/18 B-015 C OF 2017/18

B-016 C OF 2017/18

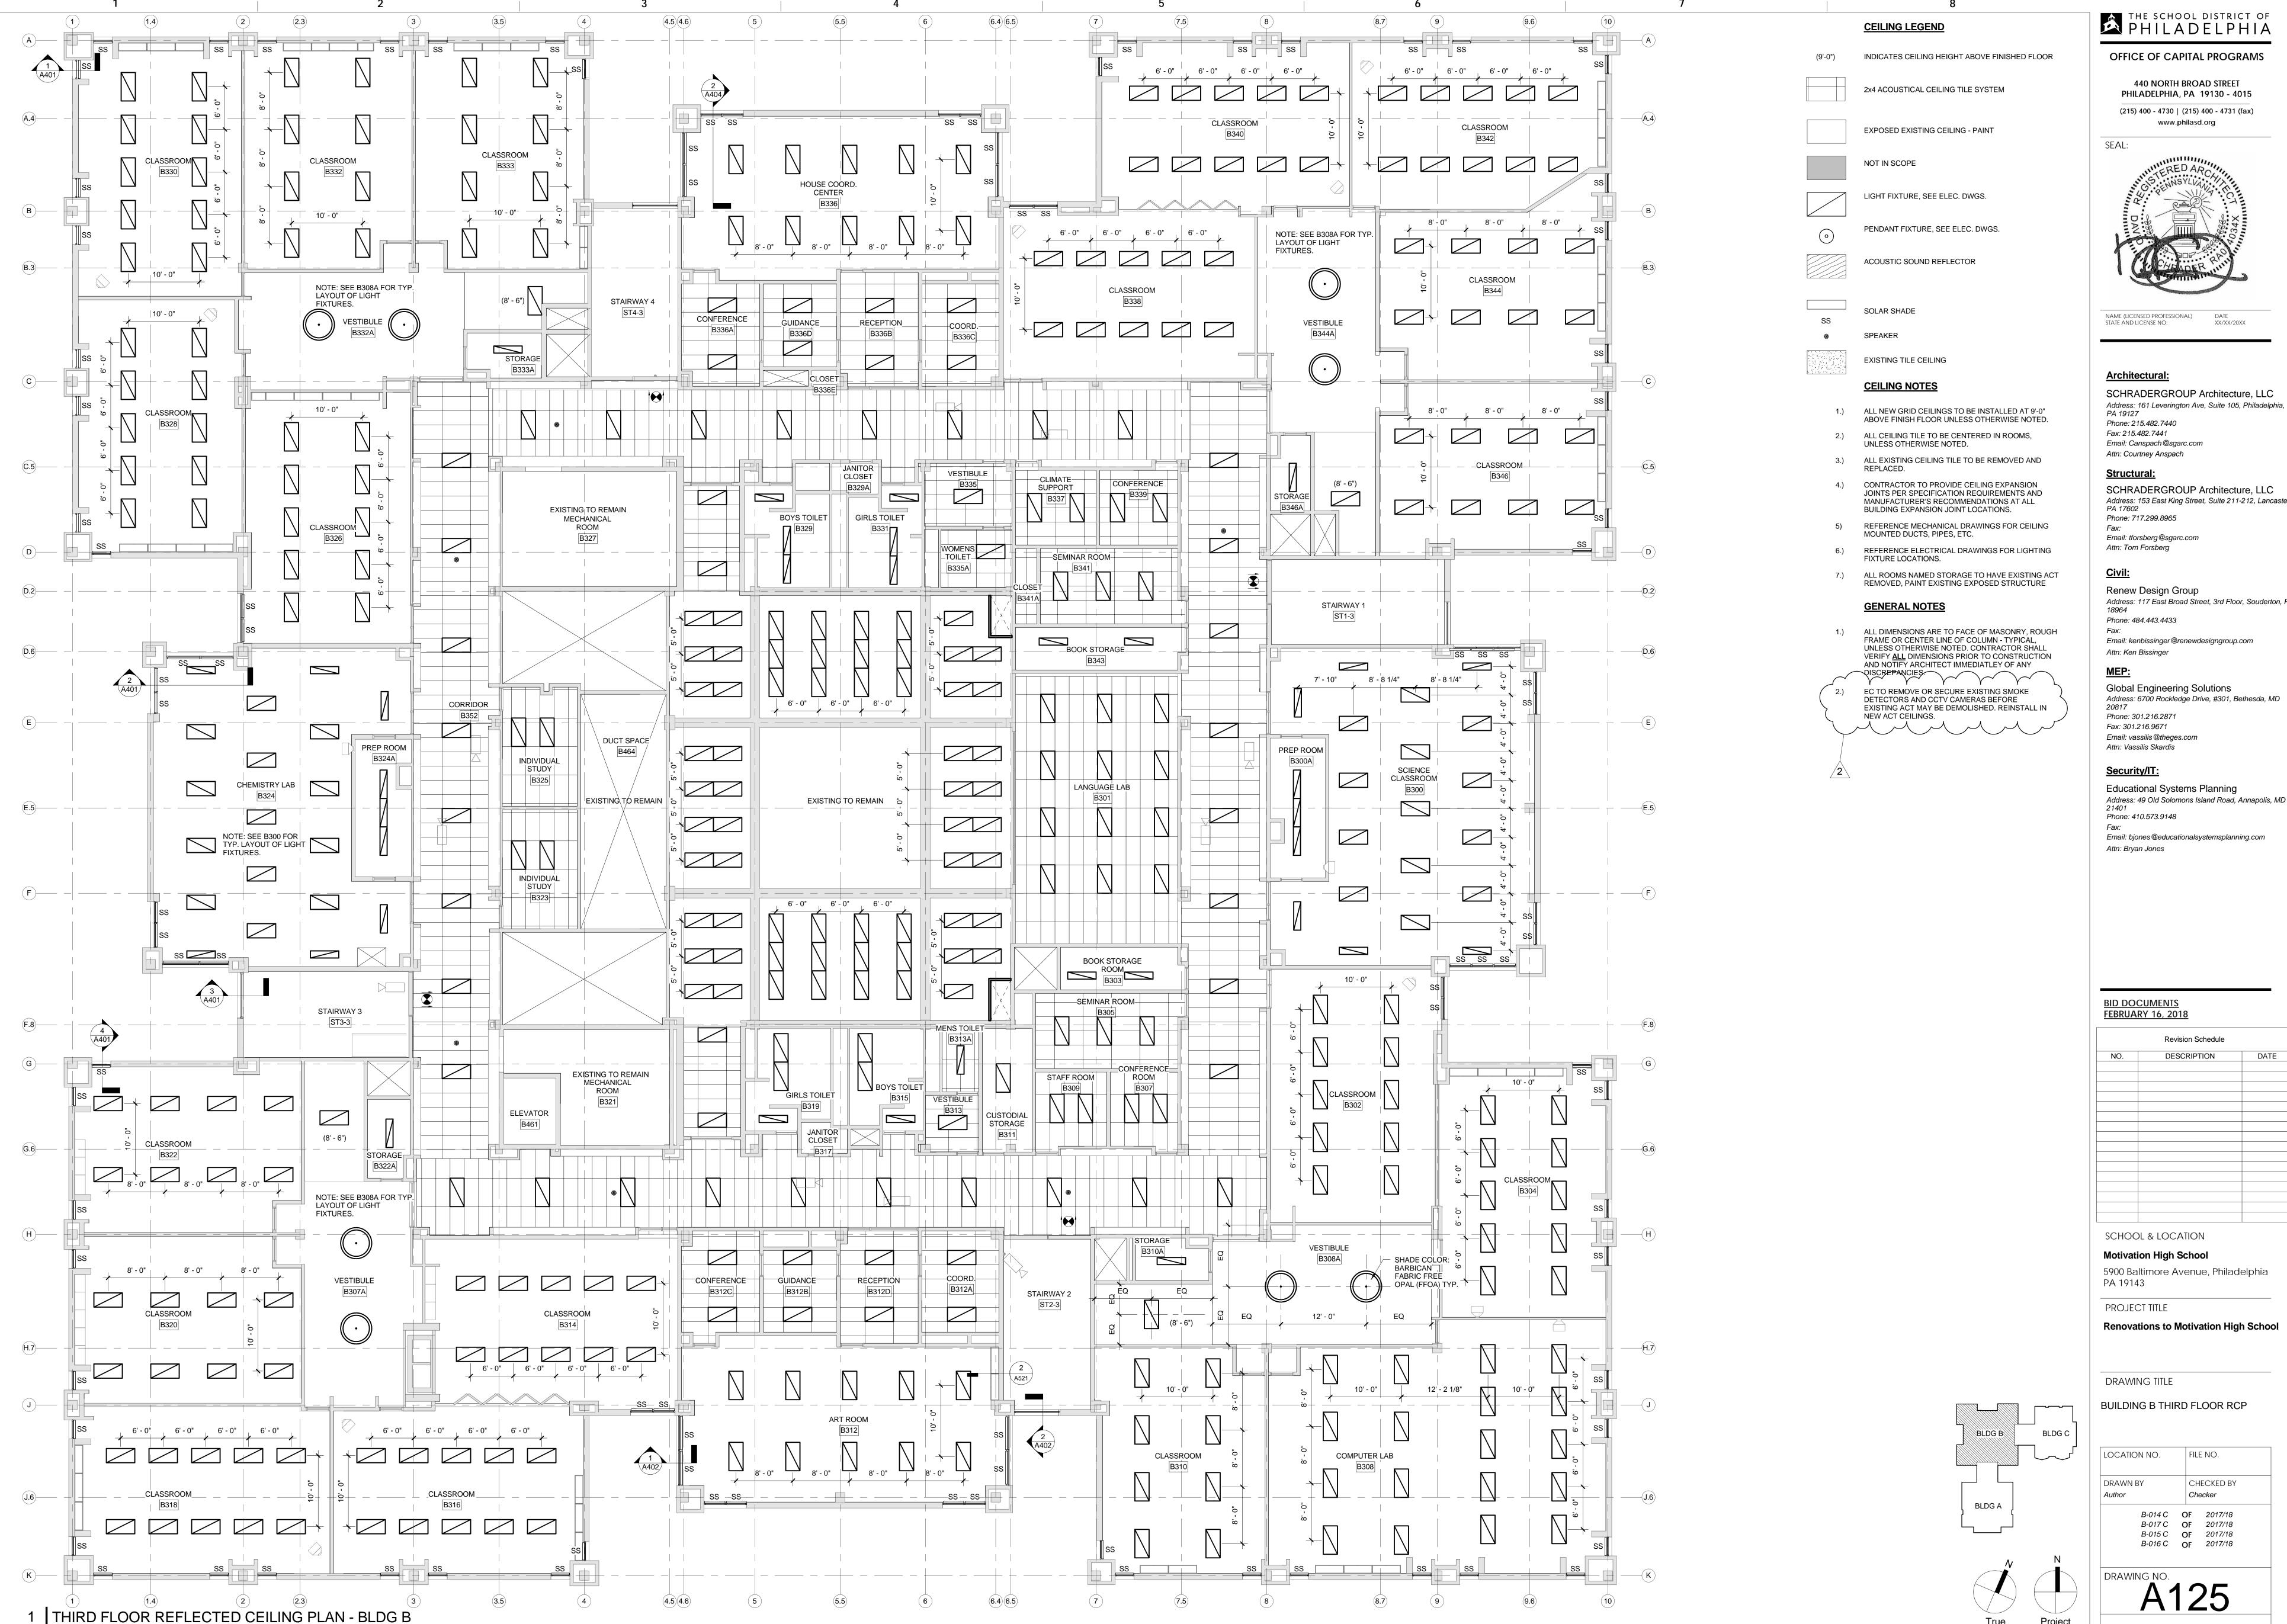


A125 SCALE: 1/8" = 1'-0"

THE SCHOOL DISTRICT OF PHILADELPHIA

OFFICE OF CAPITAL PROGRAMS

www.philasd.org

440 NORTH BROAD STREET PHILADELPHIA, PA 19130 - 4015 (215) 400 - 4730 | (215) 400 - 4731 (fax)

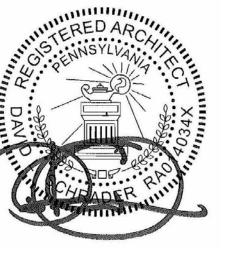

NAME (LICENSED PROFESSIONAL)

**Architectural:** 

SCHRADERGROUP Architecture, LLC

Phone: 215.482.7440 Fax: 215.482.7441

Attn: Courtney Anspach

Address: 161 Leverington Ave, Suite 105, Philadelphia,

Email: Canspach@sgarc.com

Structural:

SCHRADERGROUP Architecture, LLC Address: 153 East King Street, Suite 211-212, Lancaster, Phone: 717.299.8965

Email: tforsberg@sgarc.com Attn: Tom Forsberg

Renew Design Group Address: 117 East Broad Street, 3rd Floor, Souderton, PA

Phone: 484.443.4433 Email: kenbissinger@renewdesigngroup.com

Attn: Ken Bissinger

Phone: 301.216.2871

Fax: 301.216.9671 Email: vassilis@theges.com Attn: Vassilis Skardis

Security/IT:

**Educational Systems Planning** Address: 49 Old Solomons Island Road, Annapolis, MD

Email: bjones@educationalsystemsplanning.com Attn: Bryan Jones

**BID DOCUMENTS** 

Revision Schedule								
NO.	DESCRIPTION	DATE						

SCHOOL & LOCATION **Motivation High School** 5900 Baltimore Avenue, Philadelphia

PROJECT TITLE

Renovations to Motivation High School

DRAWING TITLE


BUILDING B THIRD FLOOR RCP

CHECKED BY B-017 C OF 2017/18 B-015 C OF 2017/18 B-016 C OF 2017/18

FILE NO.

				DOOR				FRA			GLAZING	FIRE	
NO.	TYPE	WIDTH	HEIGHT	THICKNESS		FINISH	Туре	MATERIAL	FINISH	DEPTH	TYPE	RATING	Comments  PEMOVE AND REPLACE EXISTING HARDWARE
100-1E 100-2E	EX	3' - 0" 3' - 0"	7' - 0"	0' - 1 3/4"	EX - Wood EX - Wood	EX	EX EX	EX	Paint Paint				REMOVE AND REPLACE EXISTING HARDWARE REMOVE AND REPLACE EXISTING HARDWARE
100-2L 101-1E	EX	3' - 0"	7' - 0"	0' - 1 3/4"	EX - Wood	EX	EX	EX	Paint				REMOVE AND REPLACE EXISTING HARDWARE
4101-2E	EX	3' - 0"	7' - 0"	0' - 1 3/4"	EX - Wood	EX	EX	EX	Paint			-	EXISTING TO REMAIN
A102-1E	EX	6' - 0"	7' - 0"	0' - 1 3/4"	EX - Hollow Metal	Paint	EX	EX	Paint			-	REMOVE AND REPLACE EXISTING HARDWARE
A103-1E	EX	6' - 0"	7' - 0"	0' - 1 3/4"	EX - Hollow Metal	Paint	EX	EX	Paint			-	REMOVE AND REPLACE EXISTING HARDWARE
A104-1	Α	3' - 0"	7' - 0"	0' - 1 3/4"	Wood	Stain	EX	EX	Paint			-	
A105-1	А	2' - 10"	7' - 0"	0' - 1 3/4"	Wood	Stain	EX	EX	Paint			-	
A106-1	Α	2' - 10"		0' - 1 3/4"	Wood	Stain	EX	EX	Paint			-	
A107-1	Α	3' - 0"		0' - 1 3/4"	Wood	Stain	EX	EX	Paint			-	
A107-2	A	3' - 0"	7' - 2"	0' - 1 3/4"	Wood	Stain	EX	EX	Paint			-	EVICENIA TO DEMANA
A108-1E	EX	6' - 0" 5' - 0"	7' - 0"	0' - 1 3/4"	EX - Wood	EX	EX	EX	Paint Paint			-	EXISTING TO REMAIN
A108A-1E A108E-1E	EX	2' - 10"	_	0' - 1 3/4"	EX - Wood EX - Wood	EX	EX	EX	Paint			-	EXISTING TO REMAIN REMOVE AND REPLACE EXISTING HARDWARE
A108E-1E A108E-2E	EX	2' - 10"		0' - 1 3/4"	EX - Wood	EX	EX	EX	Paint				REMOVE AND REPLACE EXISTING HARDWARE
A109-1E	EX	6' - 0"	7' - 0"	0' - 1 3/4"	EX - Wood	EX	EX	EX	Paint				EXISTING TO REMAIN
A109A-1E	EX	5' - 0"	7' - 0"	0' - 1 3/4"	EX - Wood	EX	EX	EX	Paint			-	EXISTING TO REMAIN
A109E-1E	EX	2' - 10"		0' - 1 3/4"	EX - Wood	EX	EX	EX	Paint			-	EXISTING TO REMAIN
A109E-2E	EX	2' - 10"	4' - 0"	0' - 1 3/4"	EX - Wood	EX	EX	EX	Paint			-	EXISTING TO REMAIN
A110-1	D	3' - 0"	7' - 0"	0' - 1 3/4"	Wood	Stain	EX	EX	Paint			-	
A110A-1	D	3' - 0"	7' - 0"	0' - 1 3/4"	Wood	Stain	EX	EX	Paint			-	
A110A-2	D	3' - 0"		0' - 1 3/4"	Wood	Stain	EX	EX	Paint			-	
A110B-1	А	2' - 10"		0' - 1 3/4"	Wood	Stain	EX	EX	Paint			-	
A110C-1	A	2' - 10"	7' - 0"	0' - 1 3/4"	Wood	Stain	EX	EX	Paint			-	
A111-1	D	3' - 0"	7' - 0"	0' - 1 3/4"	Wood	Stain	EX	EX	Paint			-	
A111A-1	A	2' - 10"		0' - 1 3/4"	Wood	Stain	EX	EX	Paint			-	
A111B-1	A D	2' - 10" 3' - 0"	7' - 0"	0' - 1 3/4"	Wood	Stain	EX	EX	Paint			-	
A111C-1 A111C-2	D	3' - 0"	7' - 0"	0' - 1 3/4"	Wood Wood	Stain Stain	EX	EX EX	Paint Paint			-	
A1110-2 A112-1	A	6' - 0"		0' - 1 3/4"	Wood	Stain	EX	EX	Paint			-  _	
A113-1	A	6' - 0"		0' - 1 3/4"	Wood	Stain	EX	EX	Paint			-  -	
A114-1	D	3' - 0"	7' - 2"	0' - 1 3/4"	Wood	Stain	EX	EX	Paint			-	
A114-2	D	3' - 0"	7' - 2"	0' - 1 3/4"	Wood	Stain	EX	EX	Paint			_	
A114A-1	Α	3' - 0"	7' - 0"	0' - 1 3/4"	Wood	Stain	EX	EX	Paint			-	
A115-1E	EX	3' - 0"	7' - 0"	0' - 1 3/4"	EX - Wood	EX	EX	EX	Paint			-	EXISTING TO REMAIN
A116-1	Α	6' - 0"	7' - 2"	0' - 1 3/4"	Wood	Stain	3	Hollow Metal	Paint	0' - 5 3/4"		-	
A116-2E	EX	3' - 0"	7' - 0"	0' - 1 3/4"	EX - Hollow Metal	Paint	EX	EX	Paint			-	REMOVE AND REPLACE EXISTING HARDWARE
A117-1E	EX	6' - 0"	7' - 0"	0' - 1 3/4"	EX - Hollow Metal	Paint	EX	EX	Paint			-	REMOVE AND REPLACE EXISTING HARDWARE
A117-2E	EX	6' - 2"		0' - 1 3/4"	EX - Hollow Metal	Paint	EX	EX	Paint			-	REMOVE AND REPLACE EXISTING HARDWARE
A118-1	Α	6' - 0"	7' - 2"	0' - 1 3/4"	Wood	Stain	3	Hollow Metal	Paint	0' - 5 3/4"		-	
A118-2E	EX	3' - 0"	7' - 0"	0' - 1 3/4"	EX - Hollow Metal	Paint	EX	EX	Paint			-	REMOVE AND REPLACE EXISTING HARDWARE
A119-1E	EX	6' - 0"	7' - 0"	0' - 1 3/4"	EX - Hollow Metal	Paint	EX	EX	Paint			-	REMOVE AND REPLACE EXISTING HARDWARE
A119-2E A121-1	EX D	6' - 2" 6' - 0"	7' - 0"	0' - 1 3/4"	EX - Hollow Metal Wood	Paint Stain	EX EX	EX	Paint Paint			-	REMOVE AND REPLACE EXISTING HARDWARE
A121-1 A121-2	A	3' - 0"	7' - 0"	0' - 1 3/4"	Wood	Stain	EX	EX	Paint			<del>-</del>	
A121-2 A121-3	D	6' - 0"	1	0' - 1 3/4"	Wood	Stain	EX	EX	Paint			-  -	REMOVABLE CENTER MULLION
A122-1	D	6' - 0"		0' - 1 3/4"	Wood	Stain	EX	EX	Paint			-	REMOVABLE GENTER MOLLIGIA
A122-2	A	3' - 0"		0' - 1 3/4"	Wood	Stain	EX	EX	Paint			-	
A122-3	D	6' - 0"	7' - 0"	0' - 1 3/4"	Wood	Stain	EX	EX	Paint			-	REMOVABLE CENTER MULLION
A123-1E	EX	3' - 0"	7' - 0"	0' - 1 3/4"	EX - Wood	EX	EX	EX	Paint			-	REMOVE AND REPLACE EXISTING HARDWARE
A123-2E	EX	6' - 0"	7' - 0"	0' - 1 3/4"	EX - Hollow Metal	Paint	EX	EX	Paint				REMOVE AND REPLACE EXISTING HARDWARE
A124-1E	EX	6' - 2"	7' - 0"	0' - 1 3/4"	EX - Hollow Metal	Paint	EX	EX	Paint			-	REMOVE AND REPLACE EXISTING HARDWARE
A124-2E	EX	6' - 2"	7' - 0"	0' - 1 3/4"	EX - Hollow Metal	Paint	EX	EX	Paint			-	REMOVE AND REPLACE EXISTING HARDWARE
A125-1E	EX	6' - 2"		0' - 1 3/4"	EX - Hollow Metal	Paint	EX	EX	Paint			-	REMOVE AND REPLACE EXISTING HARDWARE
A125-2E	EX	6' - 2"		0' - 1 3/4"	EX - Hollow Metal	Paint	EX	EX	Paint			-	REMOVE AND REPLACE EXISTING HARDWARE
A126-1E	EX	6' - 0"		0' - 1 3/4"	EX - Wood	EX	EX	EX	Paint			-	REMOVE AND REPLACE EXISTING HARDWARE
A126-2E	EX	6' - 0"	7' - 0"	0' - 1 3/4"	EX - Hollow Metal	Paint	EX	EX	Paint			-	REMOVE AND REPLACE EXISTING HARDWARE
C100-1 C100-2	D D	6' - 0" 6' - 0"	7' - 0"	0' - 1 3/4"	Wood	Stain	EX	EX	Paint Paint			-  _	
C101-1	Α	2' - 10"	7' - 0"	0' - 1 3/4"	Wood	Stain	EX	EX	Paint			-	
C101B-1E	EX	2' - 8"	7' - 0"	0' - 1 3/4"	EX - Wood	EX	EX	EX	EX			-	EXISTING TO REMAIN
C102-1	A	2' - 10"	7' - 0"	0' - 1 3/4"	Wood	Stain	EX	EX	Paint			-	
C103-1	Α	2' - 10"		0' - 1 3/4"	Wood	Stain	EX	EX	Paint			-	
C103A-1E	EX	3' - 0"		0' - 1 3/4"	EX - Wood	EX	EX	EX	Paint			-	REMOVE AND REPLACE EXISTING HARDWARE
C104-1	А	2' - 10"		0' - 1 3/4"	Wood	Stain	EX	EX	Paint			-	
C104A-1	Α	2' - 10"		0' - 1 3/4"	Wood	Stain	EX	EX	Paint			-	
C105A-1E	EX	2' - 10"		0' - 1 3/4"	EX - Wood	EX	EX	EX	Paint			-	EXISTING TO REMAIN
C105B-1	D	3' - 0"	7' - 0"	0' - 1 3/4"	Wood	Stain	EX EX	EX	Paint			-	

	DOOR AND FRAME SCHEDULE - BUILDING A & C									
NO.	TYPE WID	TH HEIGH	DOOR	S MATERIAL	FINISH	Type	FRAN MATERIAL	ME FINISH	GLAZING TYPE	FIRE RATING Comments
C105C-1	D 2' - 10'	7' - 0"	0' - 1 3/4"	Wood	Stain	EX	EX	Paint	DEI III	- Comments
	D 3' - 0" A 3' - 0"	7' - 0" 7' - 0"	0' - 1 3/4" 0' - 1 3/4"	Wood Wood	Stain Stain	EX EX	EX EX	Paint Paint		<del>-</del>
C106A-1	A 2' - 10'	7' - 0"	0' - 1 3/4"	Wood	Stain	EX	EX	Paint		<del>                                   </del>
C106B-1	EX 2' - 10'	7' - 0"	0' - 1 3/4"	EX - Wood	EX	EX	EX	Paint		90
C107-1 C107-2	D 3' - 0"	7' - 0" 7' - 0"	0' - 1 3/4" 0' - 1 3/4"	Wood Wood	Stain Stain	EX	EX EX	Paint Paint		-  -
C107A-1	D 2' - 10'	7' - 0"	0' - 1 3/4"	Wood	Stain	EX	EX	Paint		-
	D 2' - 10'	7' - 0" 7' - 0"	0' - 1 3/4" 0' - 1 3/4"	Wood Wood	Stain Stain	EX EX	EX EX	Paint Paint		-  -
	D 6' - 0"	7' - 0"	0' - 1 3/4"	Wood	Stain	EX	EX	Paint		-
C107D-2 C107E-1	D 3' - 0"	7' - 0" 7' - 0"	0' - 1 3/4" 0' - 1 3/4"	Wood Wood	Stain Stain	EX EX	EX EX	Paint Paint		-
C108-1	D 6' - 0"	7' - 0"	0' - 1 3/4"	Wood	Stain	EX	EX	Paint		-
C108-2	D 6' - 0"	7' - 0"	0' - 1 3/4"	Wood	Stain	EX	EX	Paint		-
C108-3E C108-4E	EX 3' - 0" EX 3' - 0"	7' - 0" 7' - 0"	0' - 1 3/4" 0' - 1 3/4"	EX - Hollow Metal EX - Hollow Metal	Paint Paint	EX EX	EX EX	Paint Paint		- REMOVE AND REPLACE EXISTING HARDWARE - REMOVE AND REPLACE EXISTING HARDWARE
C108A-1	D 2' - 10'	7' - 0"	0' - 1 3/4"	Wood	Stain	EX	EX	Paint		-
	EX 2' - 10' EX 2' - 10'	7' - 0" 7' - 0"	0' - 1 3/4" 0' - 1 3/4"	EX - Wood	EX EX	EX EX	EX EX	Paint Paint		- EXISTING TO REMAIN - EXISTING TO REMAIN
C108B-ZE C108C-1	D 2' - 10'	7' - 0"	0' - 1 3/4"	EX - Wood Wood	Stain	EX	EX	Paint		- LAIGHING TO KLIVIAIIN
C109-1	D 3' - 0"	7' - 0"	0' - 1 3/4"	Wood	Stain	EX	EX	Paint		-
C109-2 C109A-1E	D 5' - 4" EX 2' - 10'	7' - 0" 7' - 0"	0' - 1 3/4"	Wood EX - Wood	Stain EX	EX	EX	Paint Paint		- EXISTING TO REMAIN
C109B-1	D 3' - 0"	7' - 0"	0' - 1 3/4"	Wood	Stain	EX	EX	Paint		-
C109B-2	A 3' - 0" EX 2' - 10'	7' - 0" 7' - 0"	0' - 1 3/4" 0' - 1 3/4"	Wood EX - Wood	Stain	EX EX	EX EX	Paint Paint		- EXISTING TO REMAIN
	D 5' - 4"	7' - 0"	0' - 1 3/4"	Wood Wood	EX Stain	EX	EX	Paint		- EXISTING TO REIVIAIN
C110A-1	A 2' - 10'	7' - 0"	0' - 1 3/4"	Wood	Stain	EX	EX	Paint		-
C110B-1 C110C-1	A 2' - 10' A 6' - 0"	7' - 0" 7' - 0"	0' - 1 3/4" 0' - 1 3/4"	Wood Wood	Stain Stain	EX EX	EX EX	Paint Paint		-  -
C110C-2	A 6' - 0"	7' - 0"	0' - 1 3/4"	Wood	Stain	EX	EX	Paint		-
C111-1E	EX 5' - 8"	8' - 0"	0' - 1 3/4"	EX - Hollow Metal	Paint	EX	EX	Paint		- REMOVE AND REPLACE EXISTING HARDWARE
C111-2 C112-1	D 5' - 8" D 3' - 6"	7' - 0" 7' - 0"	0' - 1 3/4" 0' - 1 3/4"	Wood Wood	Stain Stain	EX EX	EX EX	Paint Paint		-  -
	D 3' - 6"	7' - 0"	0' - 1 3/4"	Wood	Stain	EX	EX	Paint		-
C112-3 C112-4	D 5' - 8"	7' - 0" 7' - 0"	0' - 1 3/4" 0' - 1 3/4"	Wood Wood	Stain Stain	EX EX	EX EX	Paint Paint		-
C112-4 C112-5	D 5' - 8"	7' - 0"	0' - 1 3/4"	Wood	Stain	EX	EX	Paint		-
C112-6	D 5' - 4"	7' - 0"	0' - 1 3/4"	Wood	Stain	EX	EX	Paint		-
C112-7 C112-8	D 5' - 8" D 5' - 8"	7' - 0" 7' - 0"	0' - 1 3/4" 0' - 1 3/4"	Wood Wood	Stain Stain	EX EX	EX EX	Paint Paint		-  -
C112-9	D 5' - 8"	7' - 0"	0' - 1 3/4"	Wood	Stain	EX	EX	Paint		-
	D 5' - 4" EX 2' - 8"	7' - 0" 4' - 0"	0' - 1 3/4" 0' - 1 3/4"	Wood EX - Wood	Stain EX	EX EX	EX EX	Paint Paint		- EXISTING TO REMAIN
	EX 2'-8"	4' - 0"	0' - 1 3/4"	EX - Wood	EX	EX	EX	Paint		- EXISTING TO REMAIN
C112A-1	A 2' - 10'	7' - 0"	0' - 1 3/4"	Wood	Stain	EX	EX	Paint		-
C112B-1 C114-1E	A 2' - 10' EX 5' - 8"	7' - 0" 7' - 0"	0' - 1 3/4" 0' - 1 3/4"	Wood EX - Hollow Metal	Stain Paint	EX	EX	Paint Paint		- REMOVE AND REPLACE EXISTING HARDWARE
C114-2	D 5' - 8"	7' - 0"	0' - 1 3/4"	Wood	Stain	EX	EX	Paint		-
C145-1	D 5' - 0"	7' - 0"	0' - 1 3/4"	Wood	Stain	EX	EX	Paint		- EVISTING TO DEMAIN
C201-1E C201-2E	EX 3' - 0" EX 6' - 0"	6' - 10" 6' - 10"	0' - 1 3/4" 0' - 1 3/4"	EX - Wood EX - Wood	EX EX	EX EX	EX EX	Paint Paint		- EXISTING TO REMAIN - EXISTING TO REMAIN
C202-1E	EX 3' - 0"	6' - 10"	0' - 1 3/4"	EX - Wood	EX	EX	EX	Paint		- EXISTING TO REMAIN
202-2E 203-1E	EX 6' - 0" EX 6' - 0"	6' - 10" 4' - 0"	0' - 1 3/4" 0' - 1 3/4"	EX - Wood EX - Wood	EX EX	EX EX	EX EX	Paint Paint		- EXISTING TO REMAIN - EXISTING TO REMAIN
	EX 6' - 0"	6' - 2"	0' - 1 3/4"	EX - Wood	EX	EX	EX	Paint		- EXISTING TO REMAIN
	EX 6' - 0"	5' - 6"	0' - 1 3/4"	EX - Wood	EX	EX	EX	Paint		- EXISTING TO REMAIN
	EX 6' - 0" EX 6' - 0"	7' - 0" 7' - 0"	0' - 1 3/4" 0' - 1 3/4"	EX - Hollow Metal EX - Hollow Metal	Paint Paint	EX EX	EX EX	Paint Paint		- REMOVE AND REPLACE EXISTING HARDWARE - REMOVE AND REPLACE EXISTING HARDWARE
ST1-2-1E	EX 6' - 0"	7' - 0"	0' - 1 3/4"	EX - Hollow Metal	Paint	EX	EX	Paint		- REMOVE AND REPLACE EXISTING HARDWARE
	EX 6' - 0" EX 6' - 0"	7' - 0" 7' - 0"	0' - 1 3/4" 0' - 1 3/4"	EX - Hollow Metal EX - Hollow Metal	Paint Paint	EX EX	EX EX	Paint Paint		- REMOVE AND REPLACE EXISTING HARDWARE - REMOVE AND REPLACE EXISTING HARDWARE
	EX 6' - 0"	7' - 0"	0' - 1 3/4"	EX - Hollow Metal	Paint	EX	EX	Paint		- REMOVE AND REPLACE EXISTING HARDWARE - REMOVE AND REPLACE EXISTING HARDWARE
ST2-1-3	D 6' - 0"	7' - 0"	0' - 1 3/4"	Hollow Metal	Paint	1	Hollow Metal	Paint	0' - 8 1/4"	60 MIN
	EX 6' - 0" EX 6' - 0"	7' - 0" 7' - 0"	0' - 1 3/4" 0' - 1 3/4"	EX - Hollow Metal EX - Hollow Metal	Paint Paint	EX EX	EX EX	Paint Paint		- REMOVE AND REPLACE EXISTING HARDWARE - REMOVE AND REPLACE EXISTING HARDWARE
	EX 6' - 0"	7' - 0"	0' - 1 3/4"	EX - Hollow Metal	Paint	EX	EX	Paint		- REMOVE AND REPLACE EXISTING HARDWARE - REMOVE AND REPLACE EXISTING HARDWARE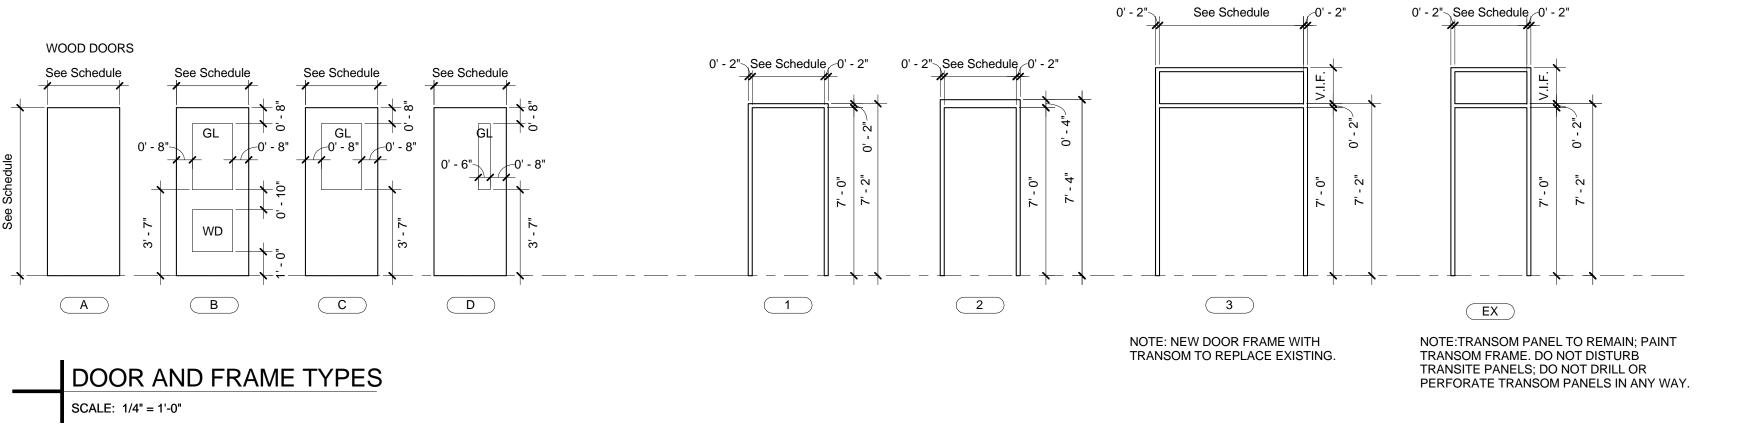
### OFFICE OF CAPITAL PROGRAMS

440 NORTH BROAD STREET PHILADELPHIA, PA 19130 - 4015 (215) 400 - 4730 | (215) 400 - 4731 (fax)

SEAL:



www.philasd.org

NAME (LICENSED PROFESSIONAL)

STATE AND LICENSE NO: XX/XX/20XX

### Architectural:

SCHRADERGROUP Architecture, LLC

Address: 161 Leverington Ave, Suite 105, Philadelphia, PA 19127
Phone: 215.482.7440
Fax: 215.482.7441
Email: Canspach@sgarc.com

# Email: Canspach@sgarc.com Attn: Courtney Anspach

Structural:
SCHRADERGROUP Architecture, LLC
Address: 153 East King Street, Suite 211-212, Lancaster, PA 17602

Fax: Email: tforsberg@sgarc.com Attn: Tom Forsberg

## <u>Civil:</u>

Phone: 717.299.8965

Renew Design Group

Address: 117 East Broad Street, 3rd Floor, Souderton, PA 18964 Phone: 484.443.4433

Email: kenbissinger@renewdesigngroup.com
Attn: Ken Bissinger

### <sub>°</sub> <u>ЕР:</u>

Global Engineering Solutions

Address: 6700 Rockledge Drive, #301, Bethesda, MD 20817

Phone: 301.216.2871 Fax: 301.216.9671 Email: vassilis@theges.com

# Attn: Vassilis Skardis

Security/IT:

Educational Systems Planning

Address: 40 Old Solomons Island Road, Apparolis, MI

Address: 49 Old Solomons Island Road, Annapolis, MD 21401 Phone: 410.573.9148

Fax:
Email: bjones @educationalsystemsplanning.com

Attn: Bryan Jones

### BID DOCUMENTS FEBRUARY 16, 2018

	Revision Schedule	
NO.	DESCRIPTION	DATE
2	Addendum #2	03/22/201

SCHOOL & LOCATION

**Motivation High School**5900 Baltimore Avenue, Philadelphia PA 19143

PROJECT TITLE

Renovations to Motivation High School

DRAWING TITLE


DOOR SCHEDULE

LOCATION NO. FILE NO.

DRAWN BY CHECKED BY Checker

B-014 C OF 2017/18 B-017 C OF 2017/18 B-015 C OF 2017/18 B-016 C OF 2017/18


DRAWING NO.
A601

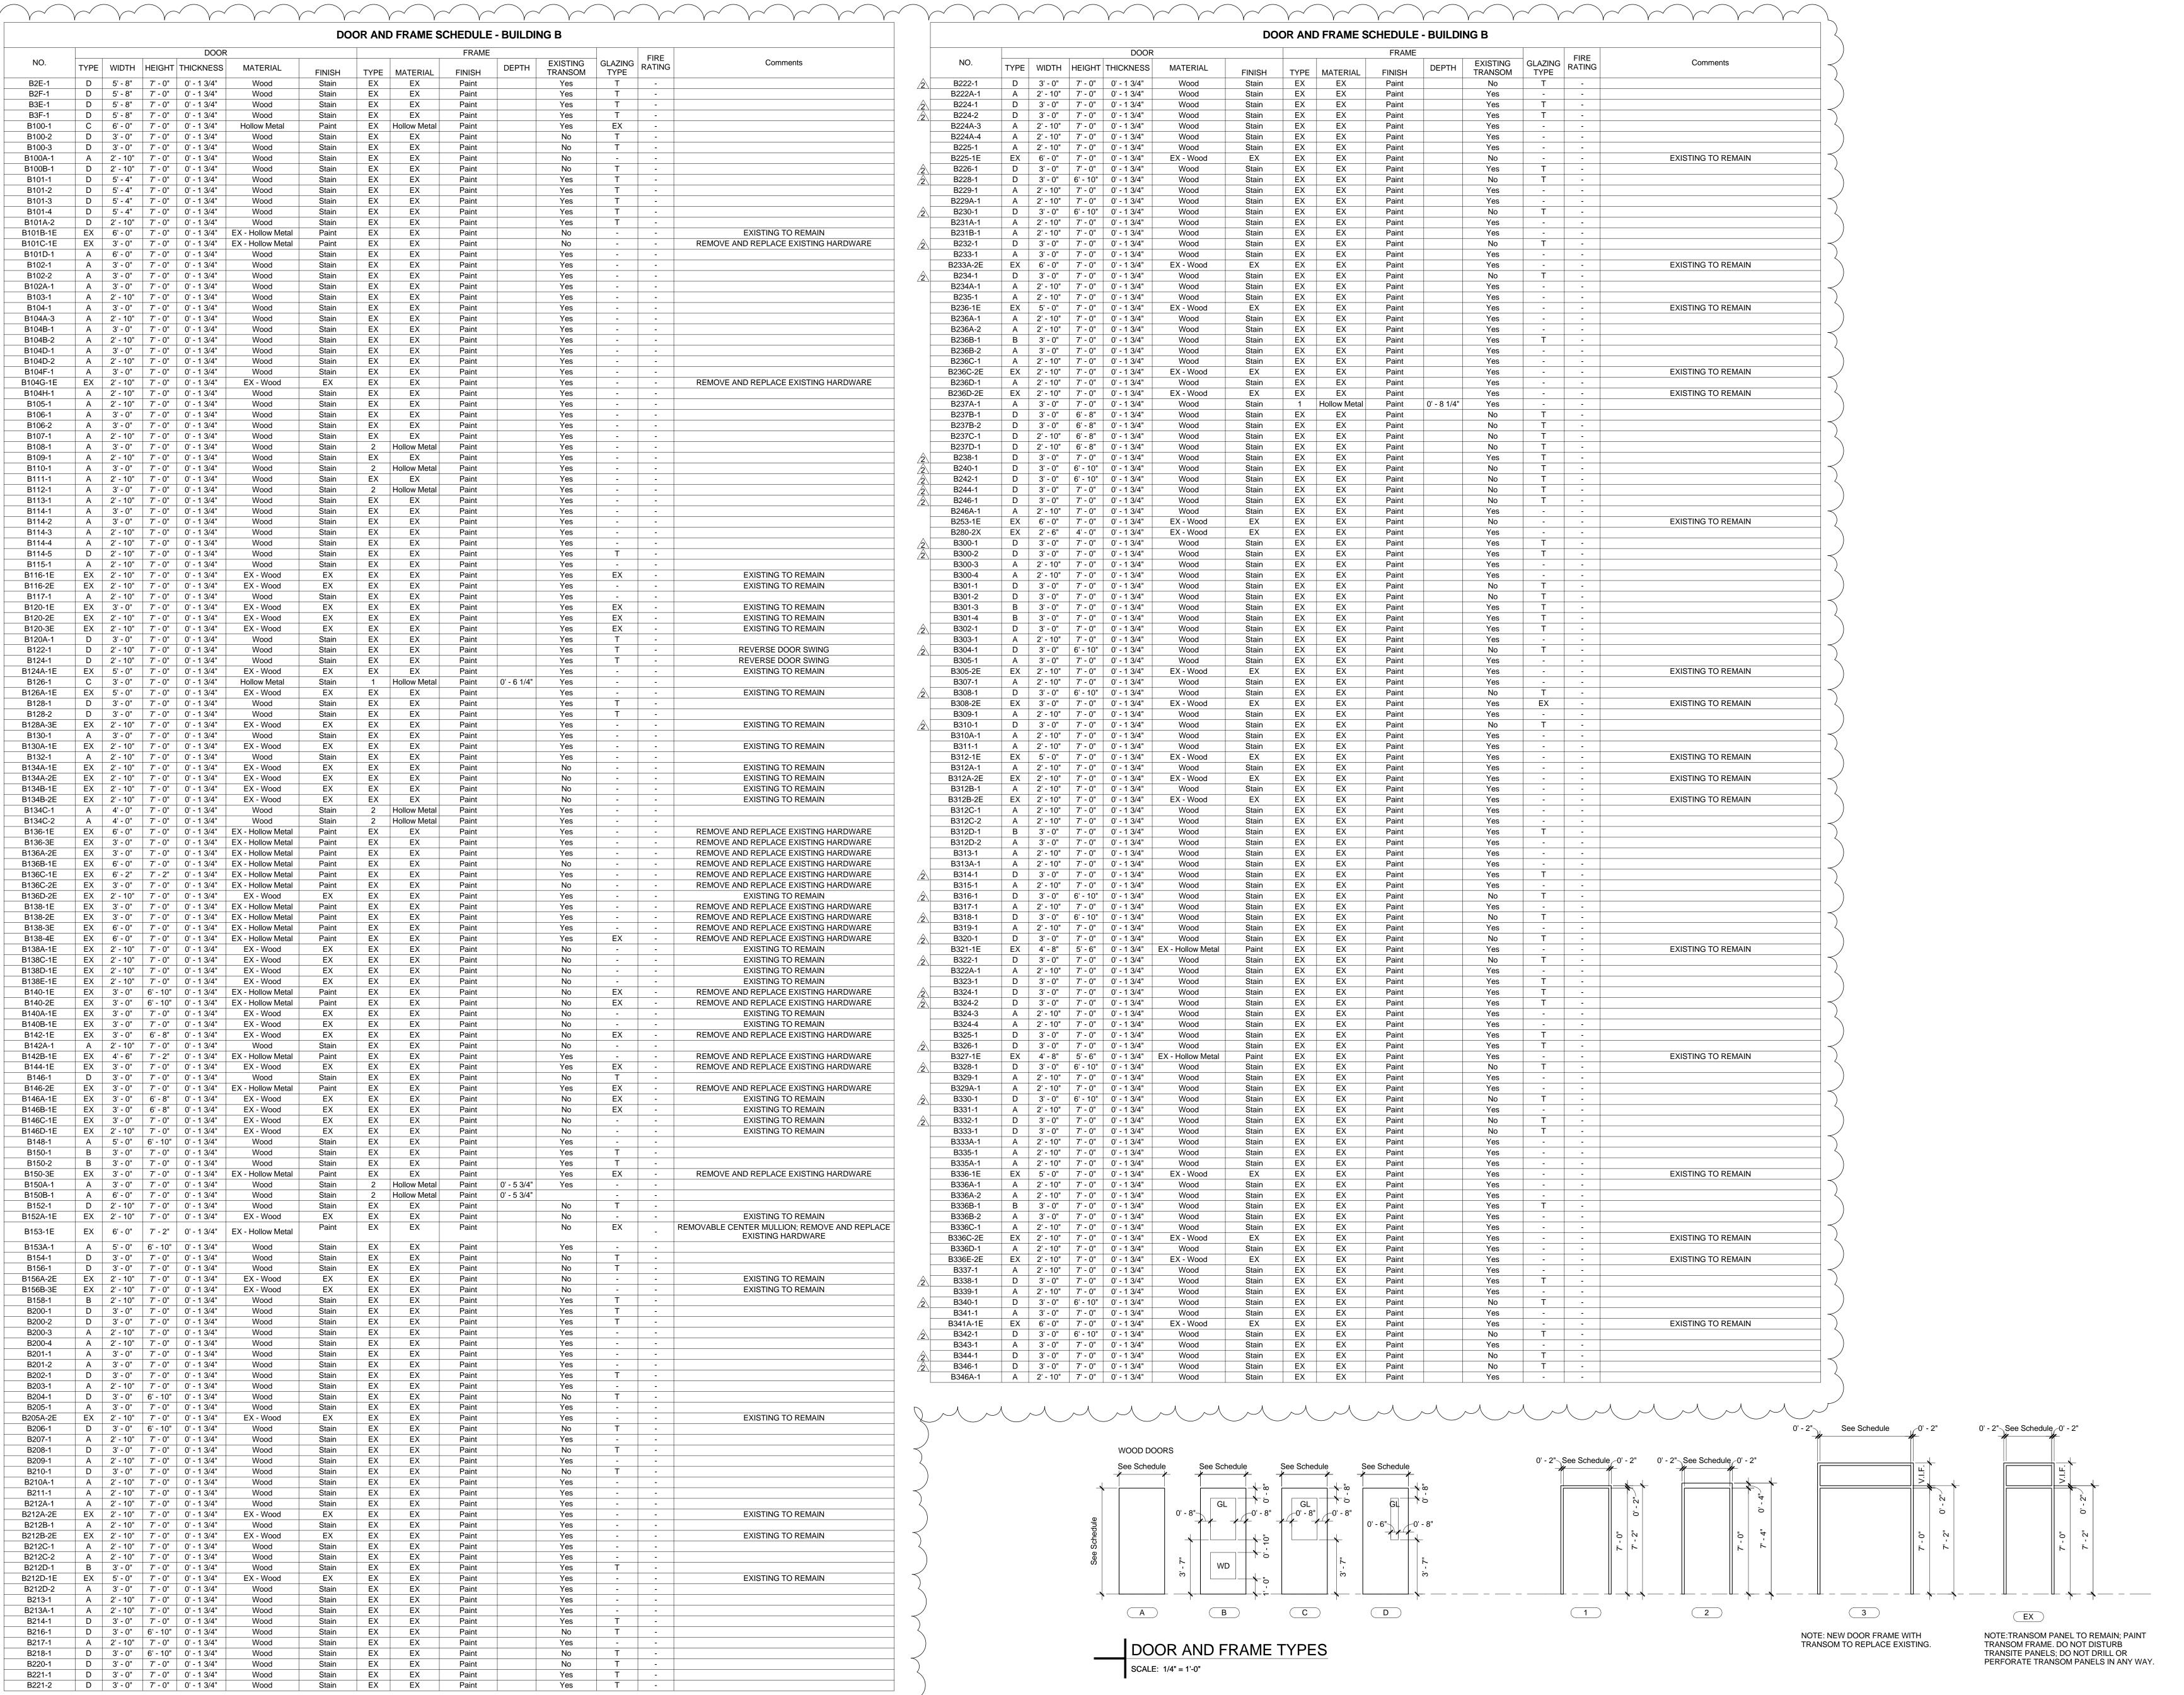

OFFICE OF CAPITAL PROGRAMS

440 NORTH BROAD STREET PHILADELPHIA, PA 19130 - 4015 (215) 400 - 4730 | (215) 400 - 4731 (fax) www.philasd.org

SEAL:

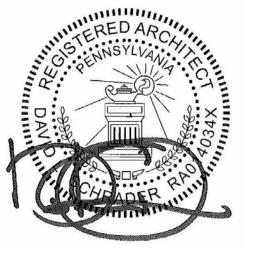

NAME (LICENSED PROFESSIONAL)
STATE AND LICENSE NO:

XX/XX/20XX

### Architectural:

SCHRADERGROUP Architecture, LLC Address: 161 Leverington Ave, Suite 105, Philadelphia,

PA 19127
Phone: 215.482.7440
Fax: 215.482.7441
Email: Canspach@sgarc.com

# Attn: Courtney Anspach Structural:

SCHRADERGROUP Architecture, LLC
Address: 153 East King Street, Suite 211-212, Lancaster, PA 17602
Phone: 717.299.8965

Email: tforsberg@sgarc.com
Attn: Tom Forsberg

## Civil:

Renew Design Group

Address: 117 East Broad Street, 3rd Floor, Souderton, PA
18964

Phone: 484.443.4433

Email: kenbissinger@renewdesigngroup.com Attn: Ken Bissinger

# Global Engineering Solutions

Address: 6700 Rockledge Drive, #301, Bethesda, MD 20817
Phone: 301.216.2871

Fax: 301.216.9671 Email: vassilis@theges.com Attn: Vassilis Skardis

# Security/IT:

Educational Systems Planning

Address: 49 Old Solomons Island Road, Annapolis, MD
21401

Phone: 410.573.9148

Fax:

Email: bjones @educationalsystemsplanning.com

Email: bjones @educationalsystemsplanning.com
Attn: Bryan Jones

# BID DOCUMENTS

**FEBRUARY 16, 2018** 

<u> </u>									
Revision Schedule									
NO.	NO. DESCRIPTION								
2	Addendum #2	03/22/2018							

SCHOOL & LOCATION

Motivation High School

5900 Baltimore Avenue, Philadelphia

PROJECT TITLE

Renovations to Motivation High School

DRAWING TITLE

DOOR SCHEDULE

PA 19143


LOCATION NO. FILE NO.

DRAWN BY CHECKED BY

Author Checker

B-014 C OF 2017/18 B-017 C OF 2017/18 B-015 C OF 2017/18 B-016 C OF 2017/18


DRAWING NO.

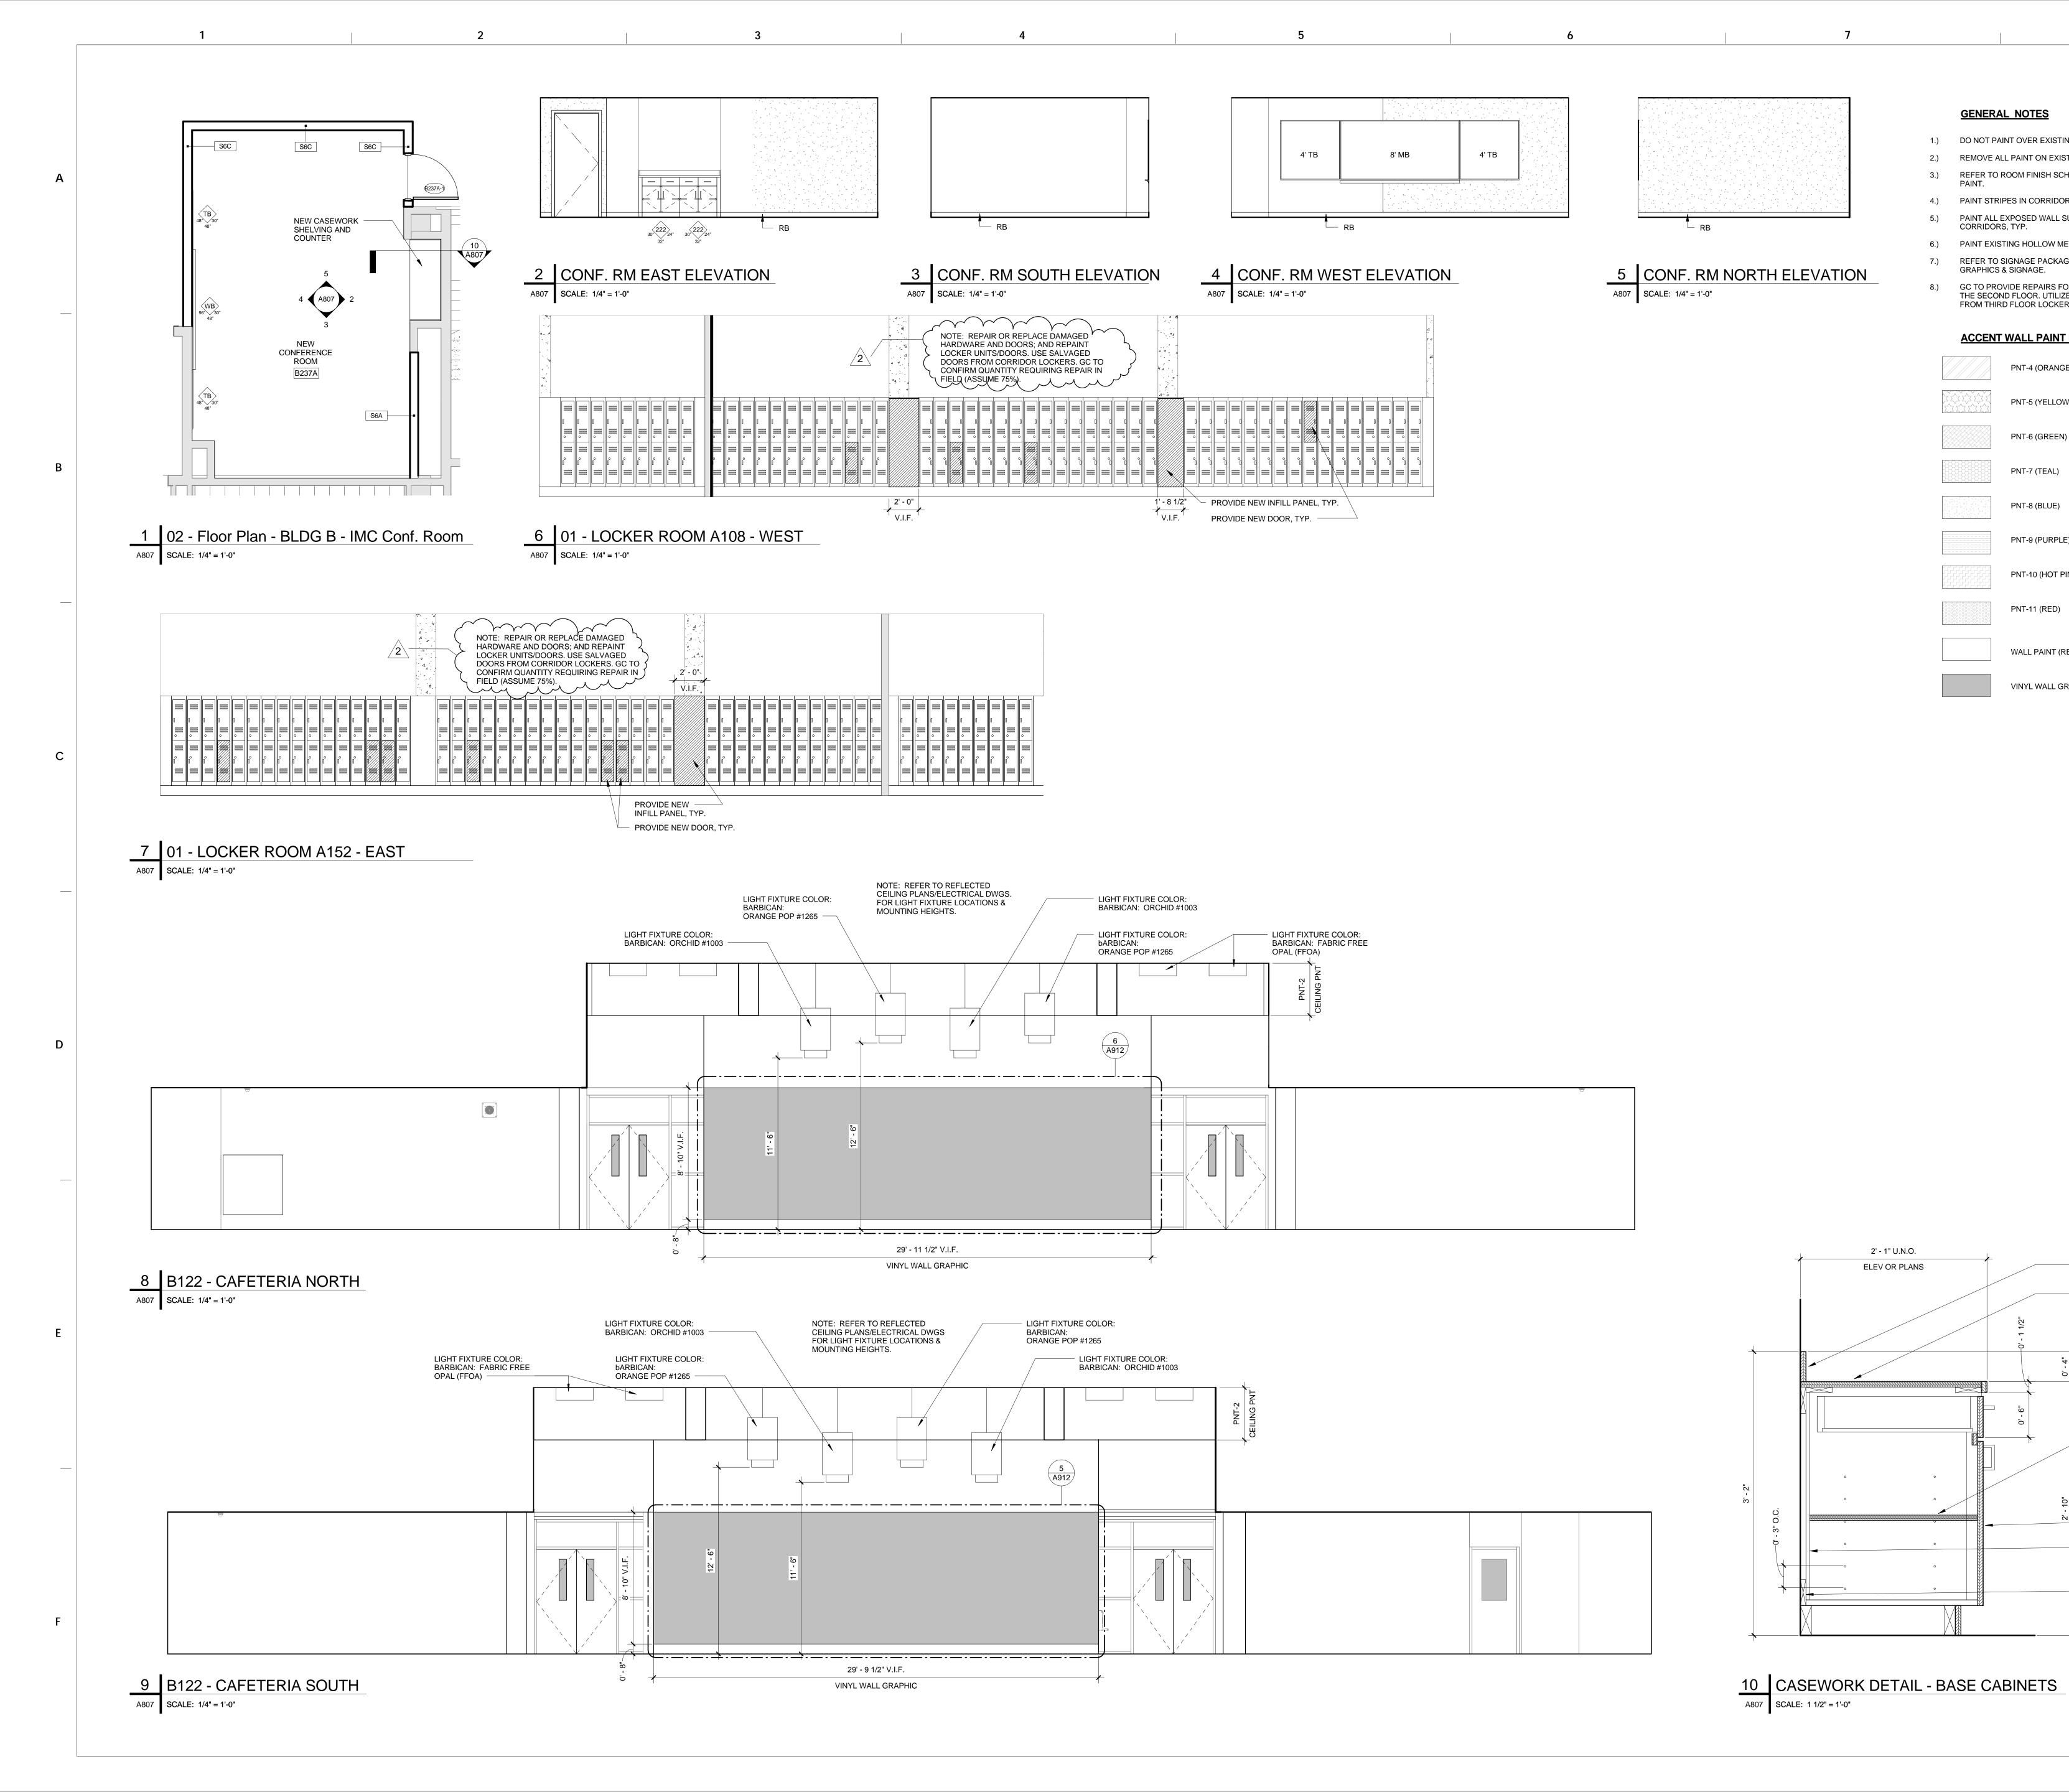

- REMOVE ALL PAINT ON EXISTING GLAZED BLOCK BASE.
- REFER TO ROOM FINISH SCHEDULE FOR TYPICAL WALL
- 4.) PAINT STRIPES IN CORRIDORS ARE TO BE CONTINUOUS

- THE SECOND FLOOR. UTILIZE SALVAGED COMPONENTS FROM THIRD FLOOR LOCKERS BEFORE PURCHASING NEW.


### **ACCENT WALL PAINT EXTENTS LEGEND**

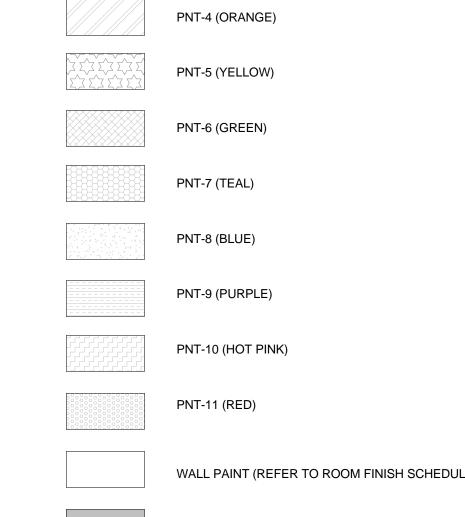

### **GENERAL NOTES**

- 1.) DO NOT PAINT OVER EXISTING GLAZED BLOCK BASE.

- 5.) PAINT ALL EXPOSED WALL SURFACES THROUGHOUT
- 6.) PAINT EXISTING HOLLOW METAL FRAMES.
- REFER TO SIGNAGE PACKAGE FOR ALL VINYL WALL GRAPHICS & SIGNAGE.
- 8.) GC TO PROVIDE REPAIRS FOR 40 PERCENT OF LOCKERS ON

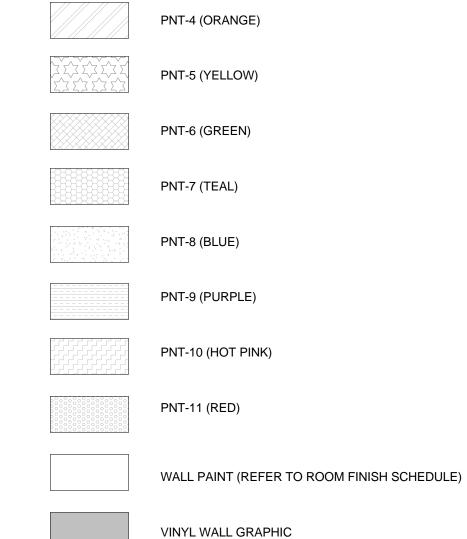

### **Architectural:**

SEAL:

SCHRADERGROUP Architecture, LLC

THE SCHOOL DISTRICT OF PHILADELPHIA

OFFICE OF CAPITAL PROGRAMS

440 NORTH BROAD STREET PHILADELPHIA, PA 19130 - 4015

(215) 400 - 4730 | (215) 400 - 4731 (fax)

www.philasd.org

Address: 161 Leverington Ave, Suite 105, Philadelphia, Phone: 215.482.7440 Fax: 215.482.7441

NAME (LICENSED PROFESSIONAL)

STATE AND LICENSE NO:

Email: Canspach@sgarc.com Attn: Courtney Anspach

Structural:

Phone: 717.299.8965

Email: tforsberg@sgarc.com Attn: Tom Forsberg

Renew Design Group Address: 117 East Broad Street, 3rd Floor, Souderton, PA Phone: 484.443.4433

SCHRADERGROUP Architecture, LLC

Address: 153 East King Street, Suite 211-212, Lancaster,

Email: kenbissinger@renewdesigngroup.com

Attn: Ken Bissinger

## Global Engineering Solutions

Address: 6700 Rockledge Drive, #301, Bethesda, MD Phone: 301.216.2871

Fax: 301.216.9671 Email: vassilis@theges.com

Attn: Vassilis Skardis

# Security/IT:

**Educational Systems Planning** Address: 49 Old Solomons Island Road, Annapolis, MD

Phone: 410.573.9148 Email: bjones@educationalsystemsplanning.com

Attn: Bryan Jones

### **BID DOCUMENTS** FEBRUARY 16, 2018

DATE 03/22/2		NO.
	dendum #2	

SCHOOL & LOCATION

**Motivation High School** 5900 Baltimore Avenue, Philadelphia PA 19143

PROJECT TITLE

PLAM BACKSPLASH

PLAM COUNTER

PLAM ADJUSTABLE

MELAMINE BACK PNL

WD BLOCKING AS

PLAM PNL


Renovations to Motivation High School

DRAWING TITLE

FIRST FLOOR - CONFERENCE,

CORRIDOR, & CAFETERIA ENLARGED PLANS AND ELEVATIONS LOCATION NO. FILE NO.

CHECKED BY DRAWN BY B-014 C OF 2017/18 B-017 C OF 2017/18 B-015 C OF 2017/18 B-016 C OF 2017/18

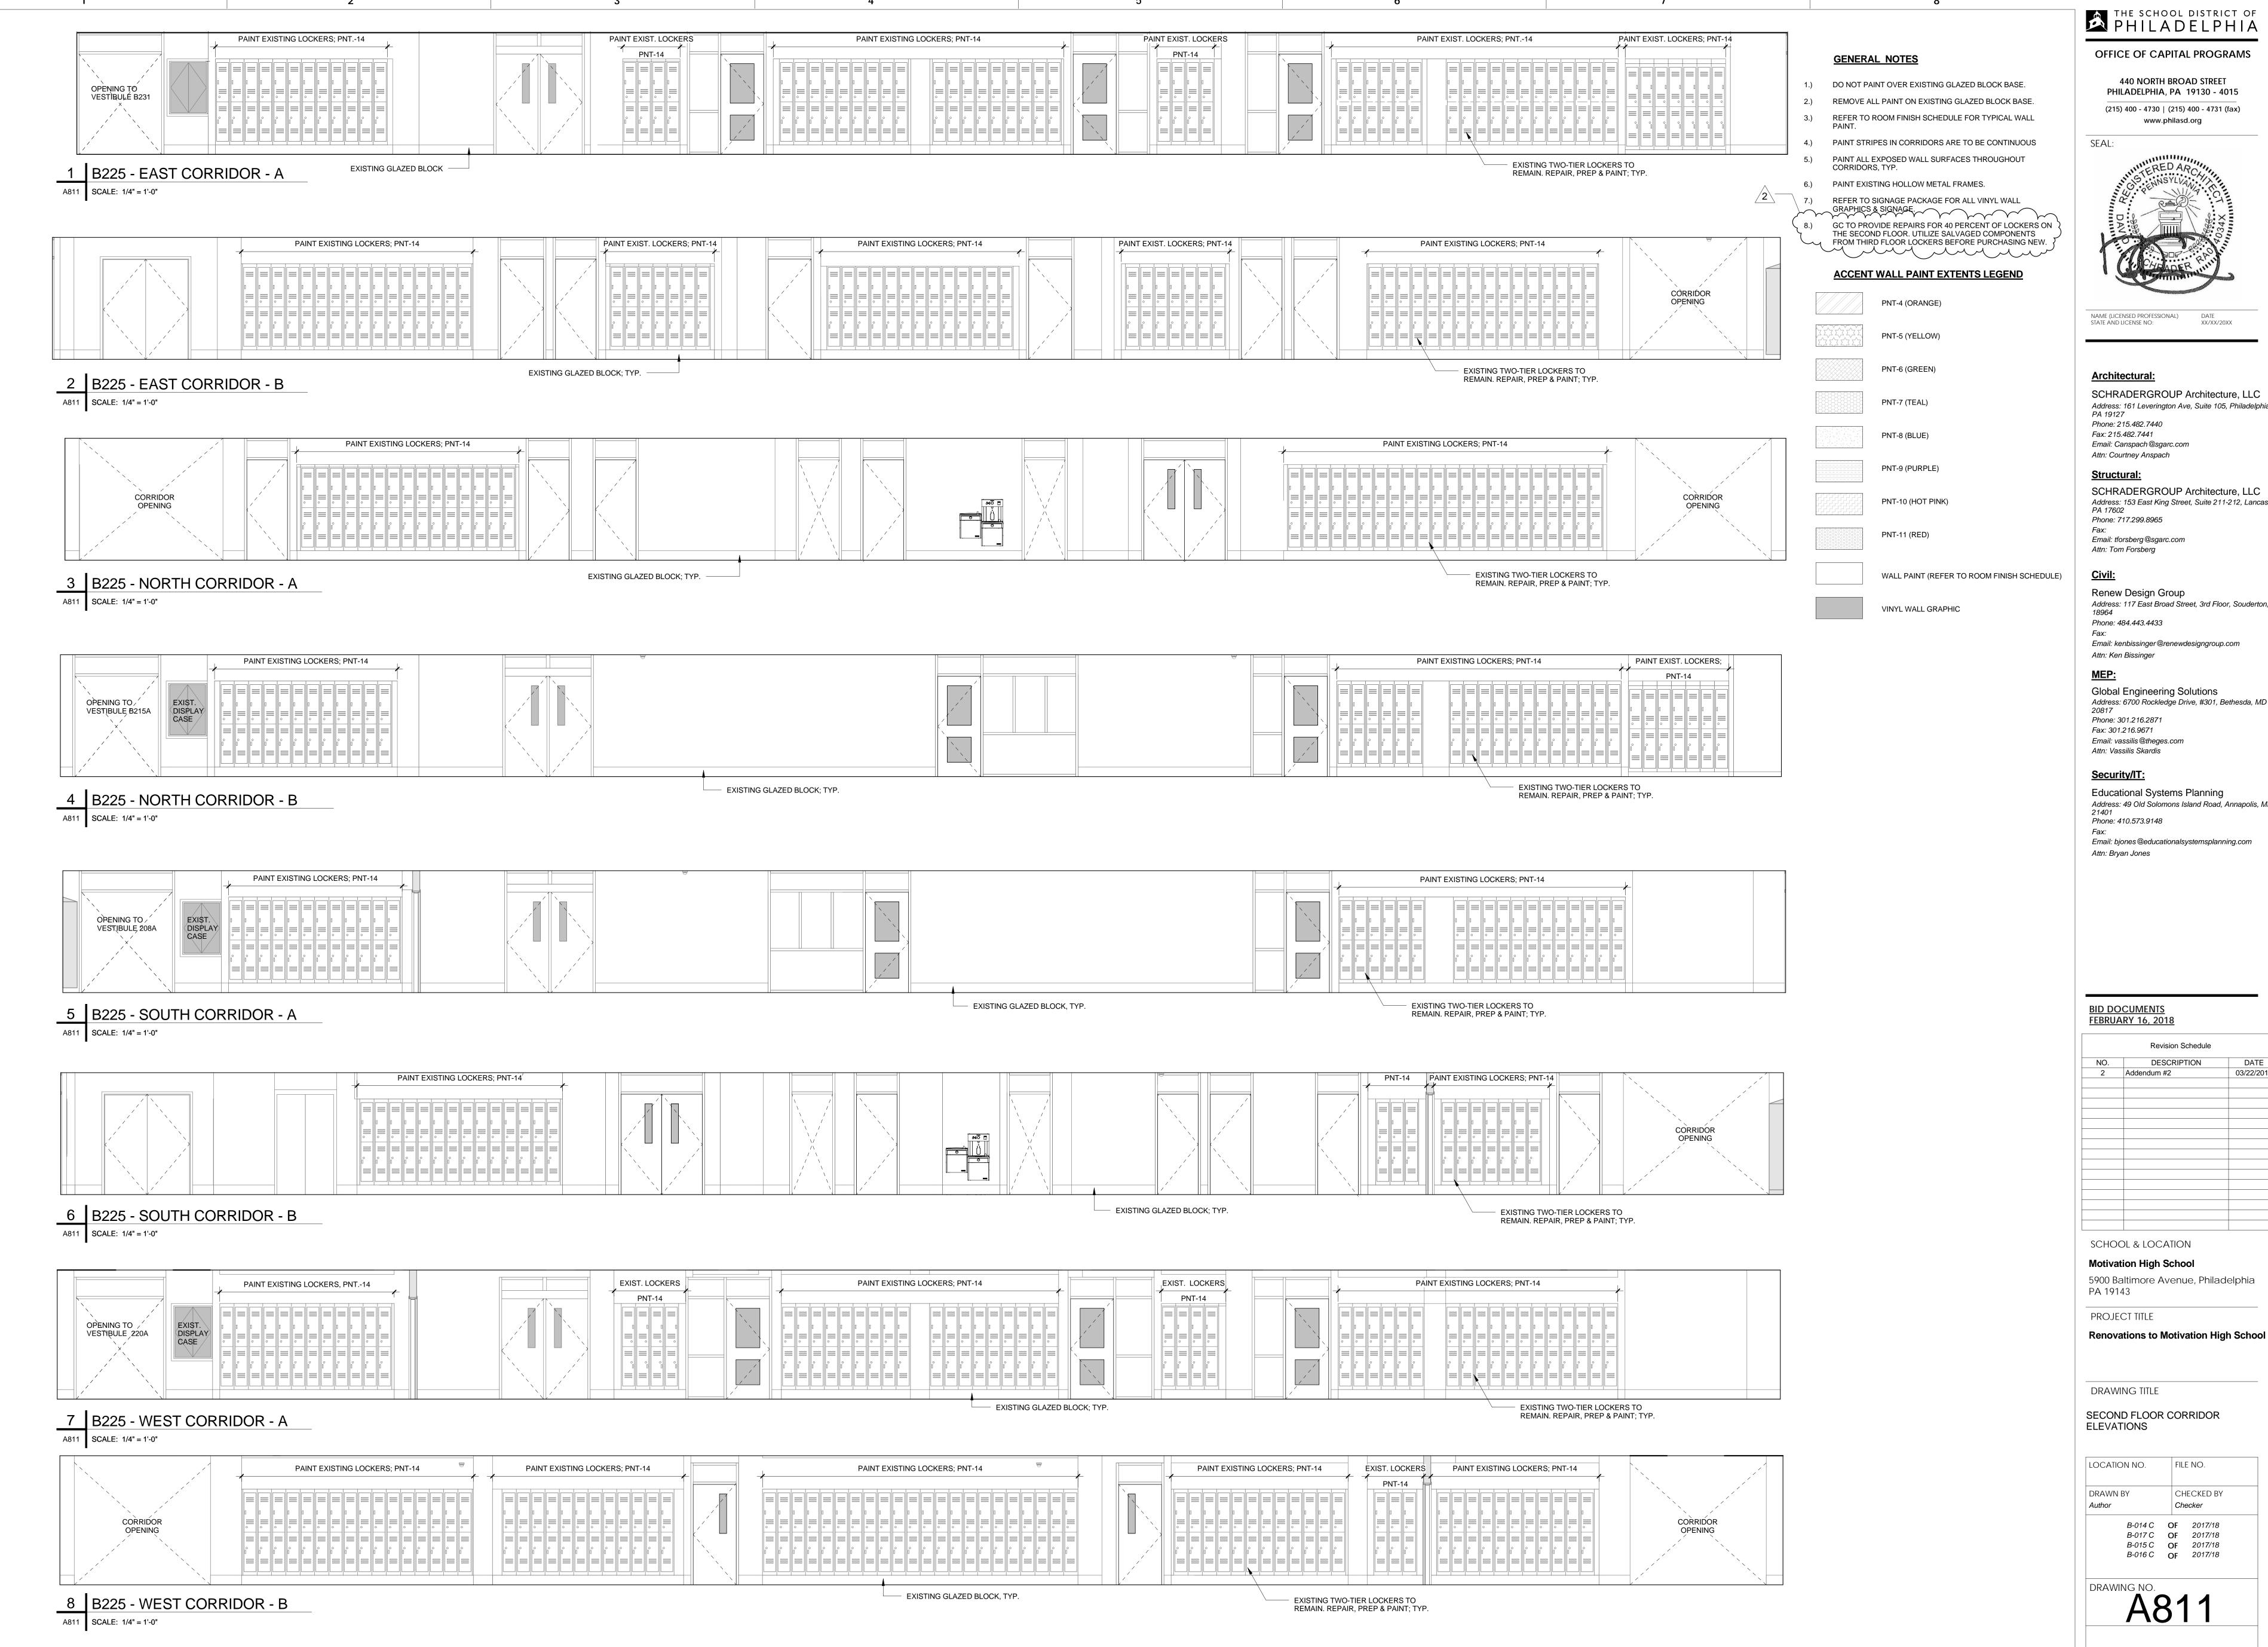

OFFICE OF CAPITAL PROGRAMS

440 NORTH BROAD STREET PHILADELPHIA, PA 19130 - 4015 (215) 400 - 4730 | (215) 400 - 4731 (fax)



www.philasd.org

NAME (LICENSED PROFESSIONAL)

**Architectural:** 

SCHRADERGROUP Architecture, LLC Address: 161 Leverington Ave, Suite 105, Philadelphia,

Phone: 215.482.7440 Fax: 215.482.7441 Email: Canspach@sgarc.com Attn: Courtney Anspach

SCHRADERGROUP Architecture, LLC

Address: 153 East King Street, Suite 211-212, Lancaster, PA 17602 Phone: 717.299.8965

Email: tforsberg@sgarc.com Attn: Tom Forsberg

Renew Design Group Address: 117 East Broad Street, 3rd Floor, Souderton, PA Phone: 484.443.4433

Email: kenbissinger@renewdesigngroup.com Attn: Ken Bissinger

Global Engineering Solutions Address: 6700 Rockledge Drive, #301, Bethesda, MD

Fax: 301.216.9671 Email: vassilis@theges.com Attn: Vassilis Skardis

Security/IT:

Educational Systems Planning

Address: 49 Old Solomons Island Road, Annapolis, MD Phone: 410.573.9148

Email: bjones@educationalsystemsplanning.com Attn: Bryan Jones

**BID DOCUMENTS** 

<u>FEBRU</u>	FEBRUARY 16, 2018						
	Revision Schedule						
NO.	DESCRIPTION	DATE					
2	Addendum #2	03/22/20					

SCHOOL & LOCATION Motivation High School 5900 Baltimore Avenue, Philadelphia PA 19143

PROJECT TITLE

SECOND FLOOR CORRIDOR **ELEVATIONS** 

DRAWN BY	CH	CHECKED BY		
Author	Ch	Checker		
B-014 C	OF	2017/18		
B-017 C	OF	2017/18		
B-015 C	OF	2017/18		
B-016 C	OF	2017/18		

DRAWING NO.

ROOM FINISH SCHEDULE										
		FLOOR	BASE	WALL	FINISH	CEILING	FINISH	CASEWORK	K FINISH	
ROOM#	NAME	FINISH	TYPE	WALLS	ACCENT	MATERIAL	FINISH	COUNTERTOP	CABINET	COMMENTS
\100	HEADSTART CLASSROOM	ETR	ETR	PNT-1	-	ETR	PNT-2	-	-	
	HEADSTART CLASSROOM	ETR	ETR	PNT-1	-	ETR	PNT-2	-	-	
	MECH ROOM	ETR	ETR	PNT-1	-	ETR	PNT-2	-	-	
	MECH ROOM STORAGE	ETR ETR	ETR ETR	PNT-1 PNT-1	-	ETR ETR	PNT-2 PNT-2			
	BOYS TOILET	CT-1	CT-4	PNT-1	-	ACT-1	PN1-2 -	-	-	TP-1
	GIRLS TOILET	CT-1	CT-4	PNT-1	-	ACT-1	-	-	-	TP-1
	GYMNASIUM	ETR	ETR	PNT-1	-	ETR	PNT-2	-	-	VINYL FLOOR GRAPHIC; FOLDING PARTITION
108	LOCKER ROOM	ETR	ETR	PNT-1	-	ETR	PNT-2	-	-	REPAIR & REPAINT EXIST. LOCKERS
	MECH. & STORAGE	ETR	ETR	PNT-1	-	ETR	PNT-2	-	-	
108B	VISITORS LOCKERS	ETR	ETR	PNT-1	-	ETR	PNT-2	-	-	REPAIR & REPAINT EXIST. LOCKERS
08C 08D	TOILET SHOWER ROOM	CT-1 ETR/CT-2	CT-4 ETR/CT-3	PNT-1 PNT-1	-	ETR ETR	PNT-2 PNT-2	-	-	TP-1
08E	TOWEL ROOM	ETR/C1-2	ETR	PNT-1	-	ETR	PNT-2 PNT-2	-	-	
	SHOWERS	ETR	ETR	ETR/PNT-1	-	ETR	PNT-2	-	-	
	SHOWERS	ETR	ETR	ETR/PNT-1	-	ETR	PNT-2	-	-	
09	LOCKER ROOM	ETR	ETR	PNT-1	-	ETR	PNT-2	-	-	REPAIR & REPAINT EXIST. LOCKERS
	DRYING AREA	ETR	ETR	PNT-1	-	ETR	PNT-2	-	-	
	MECH. & STORAGE	ETR	ETR	PNT-1	-	ETR	PNT-2	ETR	ETR	
09B	VISITORS LOCKERS	ETR	ETR CT 4	PNT-1	-	ETR	PNT-2	-	-	REPAIR & REPAINT EXIST. LOCKERS
09C 09D	TOILET SHOWERS	CT-1 ETR CT/CT-2	CT-4 ETR/CT-3	PNT-1 PNT-1	-	ETR ETR	PNT-2 PNT-2	-	-	TP-1
109E	TOWEL ROOM	ETR CT/CT-2	ETR	PNT-1	-	ETR	PNT-2 PNT-2	-	-	
	HEAD START KITCHEN	ETR	ETR	PNT-1	-	ACT-1	-	-	-	PROVIDE WATER RESISTANT AND WASHABLE CEILING TILE
	VESTIBULE	ETR	ETR	PNT-1	-	ACT-1	-	-	-	
110B	LOCKERS	ETR	ETR	PNT-1	-	ACT-1	-	-	-	
10C	TOILET	ETR	ETR	PNT-1	-	ACT-1	-	-	-	
	OFFICE	ETR	ETR	PNT-1	-	ACT-1	-	-	-	
11A 11B	LOCKER RM TOILET	ETR ETR	ETR ETR	PNT-1 PNT-1	-	ACT-1 ACT-1	_	-	-	
11C	VESTIBULE	ETR	ETR	PNT-1	-	ACT-1	<u>-</u>	-	-	
	GYM STORAGE	ETR	ETR	PNT-1	-	ETR	PNT-2	-	-	
	GYM STORAGE	ETR	ETR	PNT-1	-	ETR	PNT-2	-	-	
114	CORRECTIVE GYM	ETR	ETR	PNT-1	-	ETR	PNT-2	-	-	
	STORAGE	ETR	ETR	PNT-1	-	ETR	PNT-2	-	-	
	OUTDOOR STORAGE	ETR	ETR	PNT-1	-	ETR	PNT-2	-	-	
116	VESTIBULE	ETR	ETR	PNT-1	-	ETR	PNT-2	-	-	NOT IN COORE
116 117	VESTIBULE PASSAGE	ETR ETR	ETR ETR	PNT-1 PNT-1	-	ETR ETR	PNT-2 PNT-2	-	-	NOT IN SCOPE
	DRYING	ETR	ETR	ETR	-	ETR	- FINT-Z	-	-	NOT IN SCOPE
	MECH.	ETR	ETR	ETR	-	ETR	-	-	-	NOT IN SCOPE
117A	MECH.	ETR	ETR	ETR	-	ETR	-	-	-	NOT IN SCOPE
118	VESTIBULE	ETR	ETR	PNT-1	-	ETR	PNT-2	-	-	
	DRESSING	ETR	ETR	ETR	-	ETR	-	-	-	NOT IN SCOPE
	PASSAGE	ETR	ETR	PNT-1	-	ETR	PNT-2	-	-	
	DRESSING PASSAGE	ETR ETR	ETR ETR	ETR PNT-1	-	ETR	PNT-2	-	-	NOT IN SCOPE
20	TOILET	ETR	ETR	ETR	-	ETR ETR	- PN1-2	-	-	NOT IN SCOPE
	PASSAGE	ETR	ETR	PNT-1	-	ACT-1	-	-	-	NOT IN GOOT E
	PASSAGE	ETR	ETR	PNT-1	-	ETR	PNT-2	-	-	
22	TOWEL ROOM	ETR	ETR	ETR	-	ETR	-	-	-	NOT IN SCOPE
	SHOWERS	ETR	ETR	ETR	-	ETR	-	-	-	NOT IN SCOPE
	CORRIDOR	ETR	ETR	PNT-1	-	ETR	PNT-2	-	-	NEW LOCKERS
	POOL STORAGE	ETR	ETR	ETR	-	ETR	- DNT 2	-	-	NOT IN SCOPE
	CORRIDOR PASSAGE	ETR ETR	ETR ETR	PNT-1 ETR	-	ETR ETR	PNT-2	<u>-</u>	-	VINYL WALL GRAPHICS  NOT IN SCOPE
	CORRIDOR	ETR	ETR	PNT-1	-	ACT-1	<u>-</u>	-	-	INOT IN SCOPE
	CORRIDOR	ETR	ETR	PNT-1	-	ETR	PNT-2	ETR	ETR	
26	TOILET	ETR	ETR	ETR	-	ETR	-	-	-	NOT IN SCOPE
27	LOCKER ROOM	ETR	ETR	ETR		ETR	-	-	-	NOT IN SCOPE
	OFFICE	ETR	ETR	ETR	-	ETR	-	-	-	NOT IN SCOPE
	NATATORIUM	ETR	ETR	ETR	-	ETR	-	-	-	NOT IN SCOPE
31	MECHANICAL ROOM	ETR	ETR	ETR	-	ETR	-	-	-	NOT IN SCORE
32 33	JAN.	ETR ETR	ETR ETR	ETR ETR	-	ETR ETR	<u>-</u>	-	-	NOT IN SCOPE  NOT IN SCOPE
33 34	TOILET	ETR	ETR	ETR	-	ETR	-	-	-	NOT IN SCOPE  NOT IN SCOPE
	DRESSING	ETR	ETR	ETR	-	ETR	<u>-</u>	-	-	NOT IN SCOPE
	DRESSING	ETR	ETR	ETR	-	ETR	<u>-</u>	-	-	NOT IN SCOPE
	DRYING	ETR	ETR	ETR	-	ETR	-	-	-	NOT IN SCOPE
138	SHOWERS	ETR	ETR	ETR	-	ETR	-	-	-	NOT IN SCOPE
140	TOILET	ETR	ETR	ETR	-	ETR	-	-	-	NOT IN SCOPE
	LOCKER ROOM	ETR	ETR	ETR	-	ETR	-	-	-	NOT IN SCOPE
142	OFFICE	ETR	ETR	ETR	-	ETR	-	-	-	NOT IN SCOPE

FINISH SPE	CIFICATIONS	FINISH SPECIFICATIONS			<u>CIFICATIONS</u>	FINISH SPECIFICATIONS	
ACOUSTICA	L CEILING PANEL (ACP):	PAINT (PNT)		PLASTIC LAN	MINATE (PLAM)	TOILET PARTITIONS (TP)	
ACT-1	MFR: ARMSTRONG STYLE: ULTIMA NUMBER: 1913 COLOR: WHITE	PNT-1	(TYPICAL WALL PAINT) MFR: SHERWIN-WILLIAMS COLOR: SW 7657 TINSMITH	PLAM-1	(COUNTER TOPS) MFR: WILSONART COLOR: 4879-38 STEEL MESH	TP-1	MFR: SCRANTON PRODUCTS STYLE: HINY HIDERS COLOR: ONYX
	SIZE: 24" x 48" x 3/4"; 15/16" SQUARE LAY-IN SUSPENSION SYSTEM FINISH: BLIZZARD WHITE	PNT-2	(TYPICAL CEILING) MFR: SHERWIN-WILLIAMS COLOR: SW 7757 HIGH REFLECTIVE WHITE	PLAM-2	(VERTICAL SURFACES) MFR: WILSONART COLOR: 7909-60 FUSION MAPLE		FINISH: ORANGE PEEL
ACT-2	MFR: KINETICS NOISE CONTROL STYLE: OVATION REFLECTOR/DIFFUSER PANELS	PNT-3	(HOLLOW METAL TRIM)	RUBBER BAS	SE (RB)	VINYL COMPO	OSTITION TILE (VCT)
	COLOR: WILSONART 7909-60 FUSION MAPLE SIZE: 4' x 10' MAX PANEL SIZE (AUDITORIUM)		MFR: SHERWIN-WILLIÁMS COLOR: SW 7068 GRIZZLE GRAY	RB-1	MFR: JOHNSONITE COLOR: TO MATCH EXISTING SGFT BASE	VCT-1	(AUDITORIUM & UNIT VENTILATOR - FLOOR PATCH) MFR: AZROCK VCT COLOR: V-232 ASPHALT
ACT-3	MFR: ARMSTRONG STYLE: CLEAN ROOM VL UNPERFORATED 15/16" GRID	PNT-4	(ORANGE ACCENT) MFR: SHERWIN-WILLIAMS COLOR: SW6886 INVIGORATE	RB-2	HEIGHT: 4"  MFR: JOHNSONITE	VCT-2	SIZE: 12" x 12"  (CONFERENCE ROOMS)
	NUMBER: 870 COLOR: WHITE SIZE: 24" x 48" x 5/8" (KITCHEN/PREP AREAS)	PNT-5	TO MATCH PANTONE COLOR: PQ-ORANGE021C  (YELLOW ACCENT)  MFR: SHERWIN-WILLIAMS	DI IRRED EI (	COLOR: BLAK HEIGHT: 4"  DORING (RUB)		MFR: AZROCK VCT COLOR: V-207 SILVER MIST SIZE: 12" x 12"
CERAMIC TI			COLOR: SW 6904 GUSTO GOLD TO MATCH PANTONE COLOR: PQ-130C	RUB-1	MFR: MONDO INDOOR SPORT	ROLLER SHAD	DES
CT-1	(TOILET ROOM FLOOR TILE)	PNT-6	(GREEN ACCENT)		STYLE: SPORT IMPACT COLOR: 008 BLACK	WT-1	MFR: MECHOSHADES
O1-1	MFR: DALTILE STYLE: KEYSTONES MOSAIC TILE COLOR: D023 GALAXY	FINT-0	MFR: SHERWIN-WILLIAMS COLOR: SW 6748 GREENS TO MATCH PANTONE COLOR: PQ-3415C		SIZE: 10MM 3' x 3' TILE	VV 1-1	STYLE: MANUAL ROLLER SHADES COLOR: QUICKSHIP PROGRAM 5312 CHARCOAL OPENNESS: 5%
	SIZE: 2" X 2" X 1/4" EPOXY GROUT COLOR: MAPEI 19 PEARL GRAY	PNT-7	(TEAL ACCENT)	SEALED COM	NCRETE (SC)	TACKBOARDS	
CT-2	MORTAR BED THICKNESS: THINSET  (GYM SHOWER FLOOR TILE - PATCH)		MFR: SHERWIN-WILLIAMS COLOR: SW 6941 NIFTY TURQUOISE TO MATCH PANTONE COLOR: PQ-326C	S.CONC-1	SEALED CONCRETE	17 (O1 (DO) 11 (DO)	MFR: CLARIDGE STYLE: FABRICORK
	MFR: DALTILE STYLE: KEYSTONES MOSAIC TILE	PNT-8	(LIGHT BLUE ACCENT)	EPOXY RESI		OVAN FOLDING	COLOR: KL498 WINTHROPE
	COLOR: D182 SUEDE GRAY SIZE: 2 " X 2" EPOXY GROUT COLOR: MAPEI 19 PEARL GRAY		MFR: SHERWIN-WILLIAMS COLOR: TO MATCH PANTONE COLOR: PQ-306C	EPOXY-1	SCIENCE CLASSROOM COUNTERTOPS MFR: ICI CAMPBELLRHEA STYLE: RHEARESIN (EPOXY RESIN)	GYM FOLDING	MFR: HUFCOR
CT-3	(GYM SHOWER WALL BASE) MFR: DALTILE	PNT-9	(DARK BLUE ACCENT) MFR: SHERWIN-WILLIAMS	WOOD CASE	COLOR: BLACK ONYX EWORK		STYLE: CAIRN PATTERN COLOR: 44-306 GREY FLANNEL TRIM COLOR: GRAY
	STYLE: SEMI GLOSS AND MATTE COLOR: 0182 SIZE: COVE BASE 6" X 6"		COLOR: SW 6966 BLUEBLOOD TO MATCH PANTONE COLOR: PQ-286C	WD-1	SCIENCE CLASSROOM CABINETS	WOOD DOORS	<u>S</u>
07.4	EPOXY GROUT COLOR: MAPEI 19 PEARL GRAY	PNT-10	(HOT PINK ACCENT) MFR: SHERWIN-WILLIAMS		MFR: CAMPBELL RHEA WOOD SPECIES: MAPLE COLOR: 2000 MAPLE HONEY		MFR: MASONITE ARCHITECTURAL DOOR SPECIES: WHITE BIRCH
CT-4	(TOILET ROOM BASE) MFR: DALTILE STYLE: KEYSTONES MOSAIC TILE		COLOR: SW 6840 EXUBERANT PINK TO MATCH PANTONE COLOR: PQ-RHODAMINERDC	LABORATOR	RY FUME HOOD		STAIN COLOR: HONEY
	COLOR: D023 GALAXY SIZE: 6" BUILT-UP COVE BASE EPOXY GROUT COLOR: MAPEI 19 PEARL GRAY	PNT-11	(RED ACCENT) MFR: SHERWIN-WILLIAMS COLOR: SW 6868 REAL RED TO MATCH PANTONE COLOR: PQ-199C		MFR: LABSHIELD COLOR: 1567800 BATTLESHIP GRAY		
LOCKER CC	LOR (LC)	PNT-12	(AUDITORIUM CEILING)				
LC-1	MFR: PENCO PRODUCTS COLOR: 028 GRAY		MFR: SHERWIN-WILLIAMS COLOR: SW 6989 DOMINO				
		PNT-13	(PURPLE ACCENT - MUSIC DEPT) MFR: SHERWIN-WILLIAMS COLOR: SW 6982 AFRICAN VIOLET TO MATCH PANTONE COLOR: PQ-2617C				

(EXISTING LOCKERS - ELECTROSTATIC PAINT) COLOR: TO MATCH NEW LOCKER PAINT COLOR

(TYPICAL CLASSROOM ACCENT WALL PAINT & AUDITORIUM)

MFR: SHERWIN-WILLIAMS COLOR: SW 9163 TIN LIZZIE

(NAVY ACCENT PAINT) MFR: SHERWIN-WILLIAMS COLOR: SW 9178 IN THE NAVY

**GENERAL NOTES:** 

VENTILATOR COLOR.

VERIFIED IN FIELD WITH SDP.

1. PAINT ALL FIN TUBE RADIATOR COVERS TO MATCH UNIT

SECURE ALL LOOSE FIN TUBE COVERS, PROVIDE NEW COVERS WHERE MISSING/DAMAGED BEYOND REPAIR FIRST


USING COMPONENTS SALVAGED FROM OTHER LOCATIONS, THEN NEW. PROVIDE NEW AT TEN LOCATIONS TO BE

THE SCHOOL DISTRICT OF PHILADELPHIA

OFFICE OF CAPITAL PROGRAMS

440 NORTH BROAD STREET PHILADELPHIA, PA 19130 - 4015 (215) 400 - 4730 | (215) 400 - 4731 (fax) www.philasd.org

SEAL:

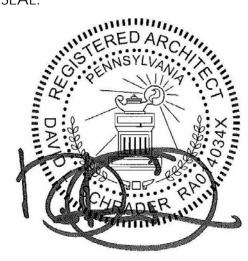

NAME (LICENSED PROFESSIONAL) STATE AND LICENSE NO:

## **Architectural:**

SCHRADERGROUP Architecture, LLC

Address: 161 Leverington Ave, Suite 105, Philadelphia, PA 19127 Phone: 215.482.7440 Fax: 215.482.7441 Email: Canspach@sgarc.com Attn: Courtney Anspach

# Structural:

SCHRADERGROUP Architecture, LLC Address: 153 East King Street, Suite 211-212, Lancaster, PA 17602 Phone: 717.299.8965

Email: tforsberg@sgarc.com Attn: Tom Forsberg

# Civil:

Renew Design Group Address: 117 East Broad Street, 3rd Floor, Souderton, PA 18964 Phone: 484.443.4433

Email: kenbissinger@renewdesigngroup.com

# Attn: Ken Bissinger

Global Engineering Solutions

Address: 6700 Rockledge Drive, #301, Bethesda, MD
20817

Phone: 301.216.2871

Fax: 301.216.9671 Email: vassilis@theges.com Attn: Vassilis Skardis

### Security/IT:

Educational Systems Planning Address: 49 Old Solomons Island Road, Annapolis, MD 21401 Phone: 410.573.9148

Fax: Email: bjones@educationalsystemsplanning.com Attn: Bryan Jones

# BID DOCUMENTS FEBRUARY 16, 2018

	Revision Schedule	
NO.	DESCRIPTION	DATE
2	Addendum #2	03/22/2018

SCHOOL & LOCATION

**Motivation High School** 5900 Baltimore Avenue, Philadelphia PA 19143

PROJECT TITLE

Renovations to Motivation High School


DRAWING TITLE

FINISH SCHEDULE

LOCATION NO.	FILE NO.				
DRAWN BY Author	CHECKED BY Checker				
	OF 2017/18 OF 2017/18				

B-015 C OF 2017/18

B-016 C OF 2017/18

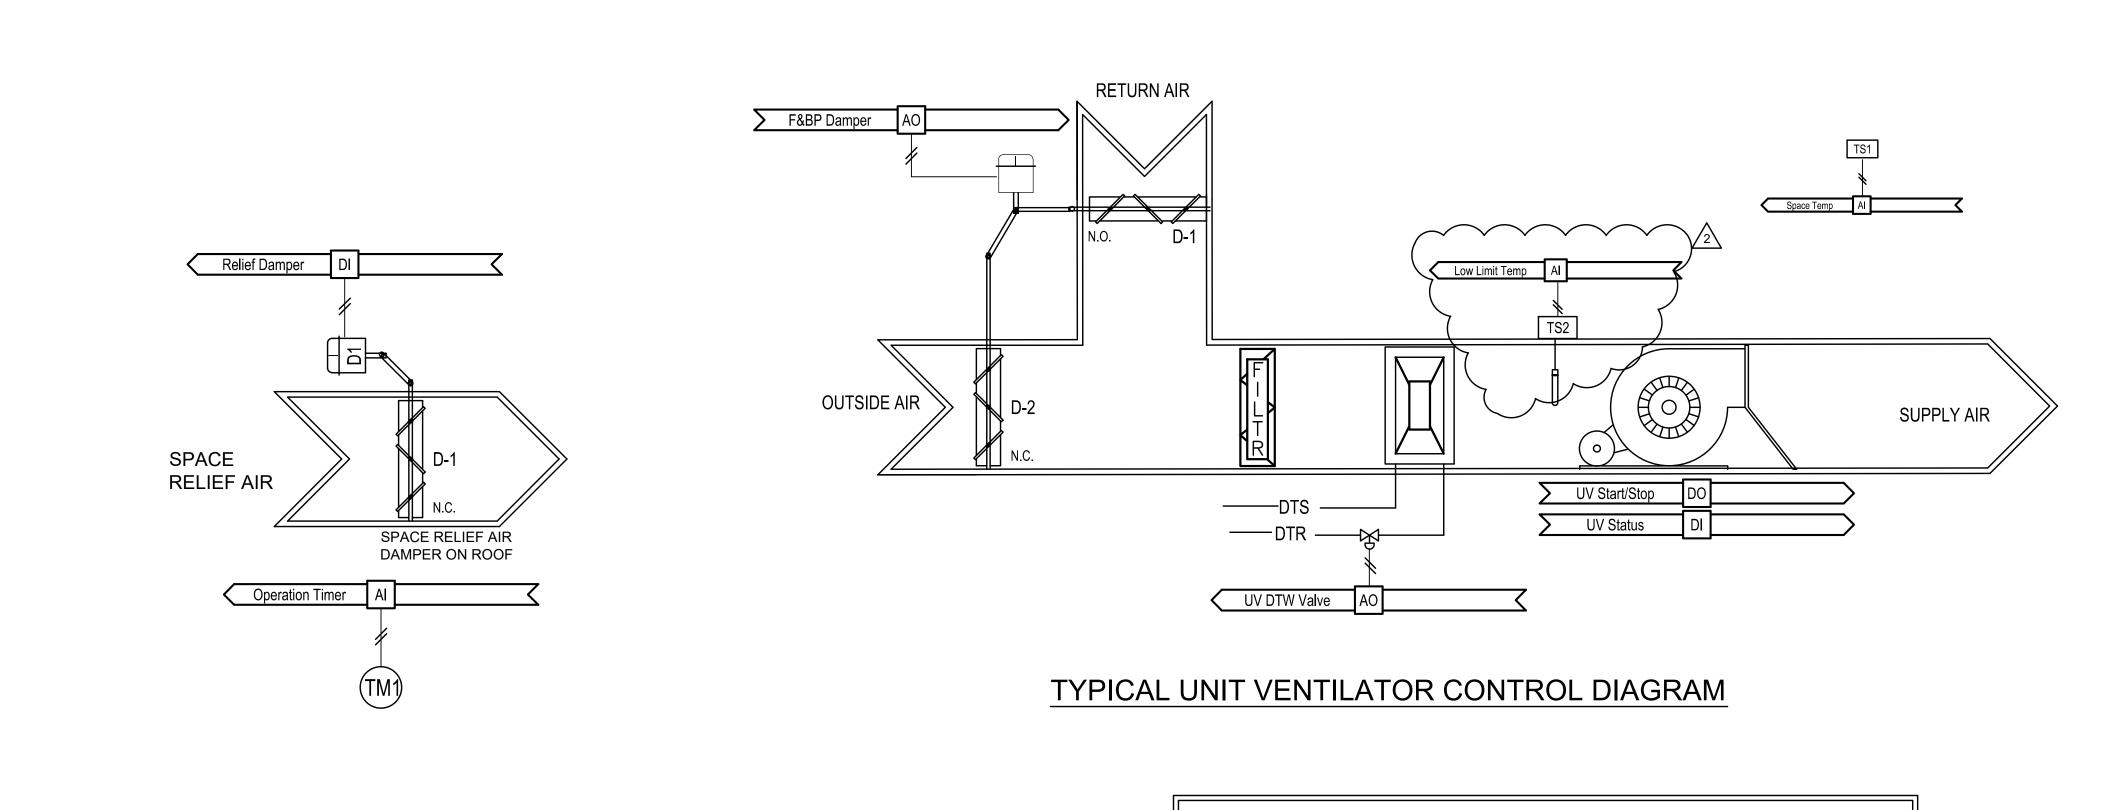

UV Start/Stop

UV Status


TYPICAL UNIT VENTILATOR WITHOUT FRESH AIR INTAKE CONTROL DIAGRAM

RETURN AIR

——DTS —

——DTR ——⋈—

UV DTW Valve AO

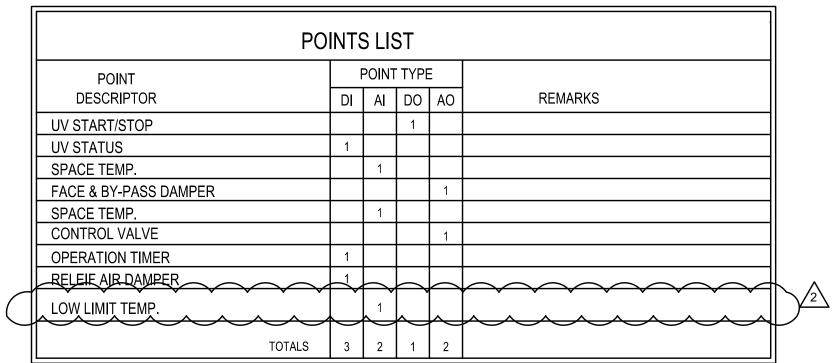

SUPPLY AIR

# TYPICAL UNIT VENTILATOR SEQUENCE OF OPERATION

### SYSTEM DESCRIPTION:

1. SYSTEM IS CONSTANT VOLUME, VARIABLE TEMPERATURE

2. SYSTEM OPERATES 12-HOURS A DAY

### SPACE TEMPERATURE CONTROL:

OCCUPIED MODE:

WHEN OCCUPIED, UV UNIT SHALL BE ENABLED AND FAN SHALL RUN CONTINUOUSLY.

DURING OCCUPIED MODE, OUTSIDE AIR DAMPER SHALL OPEN TO MINIMUM POSITION. FACE AND BY-PASS DAMPER SHALL MAINTAIN OUTDOOR AIR DAMPER POSITION TO MINIMUM SET POINT DURING OCCUPIED

### HEATING AND COOLING:

SPACE AIR TEMPERATURE SENSOR MAINTAINS ROOM TEMPERATURE SETPOINT BY MODULATING DUAL TEMPERATURE CONTROL VALVE (HEATING OR COOLING).

### UNOCCUPIED MODE:

DURING UNOCCUPIED MODE (SET BY TIMER), OUTSIDE AIR DAMPER SHALL CLOSE AND RA DAMPER SHALL SPACE TEMPERATURE SHALL MODULATE CONTROL VALVE TO MAINTAIN ROOM TEMPERATURE SET POINT - 85F (Adj.) SUMMER AND 60F (Adj.) WINTER

### SPACE PRESSURE CONTROL:

SPACE RELIEF AIR DAMPER SHALL BE FULLY WHEN BUILDING IS IN OCCUPIED MODE. DAMPER SHALL CLOSE IN UNOCCUPIED MODE.

SAFETY CIRCUITS:

LOW LIMIT STAT TS2 SHALL DISABLE UNIT FAN AND CLOSE OA DAMPER UPON SENSING TEMPERATURE

## SYSTEM DESCRIPTION:

## **HEATING AND COOLING:**

SPACE AIR TEMPERATURE SENSOR MAINTAINS ROOM TEMPERATURE SETPOINT BY MODULATING DUAL

- 85F (Adj.) SUMMER AND 60F (Adj.) WINTER

POINTS LIST					
POINT		POINT	TYPE	=	
DESCRIPTOR	DI	Al	DO	AO	REMARKS
FCU START/STOP			1		
FCU STATUS	1				
SPACE TEMP.		1			
CONTROL VALVE				1	

TOTALS 1 1 1 1

# TYPICAL FAN COIL UNIT SEQUENCE OF OPERATION

1. SYSTEM IS CONSTANT VOLUME, VARIABLE TEMPERATURE 2. SYSTEM OPERATES 12-HOURS A DAY

## SPACE TEMPERATURE CONTROL:

## OCCUPIED MODE:

WHEN OCCUPIED, FAN COIL UNIT SHALL BE ENABLED AND FAN SHALL RUN CONTINUOUSLY. NEW EXHAUST FANS ASSOCIATED WITH CLASSROOM VENTILATION SHALL ENABLED DURING OCCUPIED

TEMPERATURE CONTROL VALVE (HEATING OR COOLING).

## **UNOCCUPIED MODE:**

SPACE TEMPERATURE SHALL MODULATE CONTROL VALVE TO MAINTAIN ROOM TEMPERATURE SET POINT

POINTS LIST					
POINT		POINT	TYPE		
DESCRIPTOR	DI	AI	DO	AO	REMARKS
FCU START/STOP			1		
FCU STATUS	1				
SPACE TEMP.		1			
CONTROL VALVE				1	

# THE SCHOOL DISTRICT OF PHILADELPHIA

## OFFICE OF CAPITAL PROGRAMS

www.philasd.org

440 NORTH BROAD STREET PHILADELPHIA, PA 19130 - 4015 (215) 400 - 4730 | (215) 400 - 4731 (fax)

SEAL:



NAME (LICENSED PROFESSIONAL) STATE AND LICENSE NO:

### **Architectural:**

SCHRADERGROUP Architecture, LLC Address: 161 Leverington Ave, Suite 105, Philadelphia, PA 19127 Phone: 215.482.7440

SCHRADERGROUP Architecture, LLC

Address: 153 East King Street, Suite 211-212, Lancaster,

### Fax: 215.482.7441 Email: Canspach@sgarc.com

Attn: Courtney Anspach Structural:

# Phone: 717.299.8965

Email: tforsberg@sgarc.com Attn: Tom Forsberg

### <u>Civil:</u>

PA 17602

Renew Design Group Address: 117 East Broad Street, 3rd Floor, Souderton, PA Phone: 484.443.4433

Email: kenbissinger@renewdesigngroup.com Attn: Ken Bissinger

Global Engineering Solutions® Address: 6700 Rockledge Drive, #301, Bethesda, MD 20817

Phone: 301.216.2871 Fax: 301.216.9671 Email: vassilis@theges.com Attn: Vassilis Skardis

### Security/IT:

Attn: Bryan Jones

Educational Systems Planning Address: 49 Old Solomons Island Road, Annapolis, MD Phone: 410.573.9148

Email: bjones@educationalsystemsplanning.com

BID DOCUMENTS FEBRUARY 16, 2018 Revision Schedule 

SCHOOL & LOCATION

**Motivation High School** 

5900 Baltimore Avenue, Philadelphia PA 19143


PROJECT TITLE Renovations to Motivation High

DRAWING TITLE

School

MECHANICAL CONTROLS

LOCATION NO. 17-015		FILE NO.
DRAWN BY		CHECKED BY
B-017 C ( B-015 C (	)I	F 2017/18 F 2017/18 F 2017/18
B-016 C 🕜	ì	F 2017/18

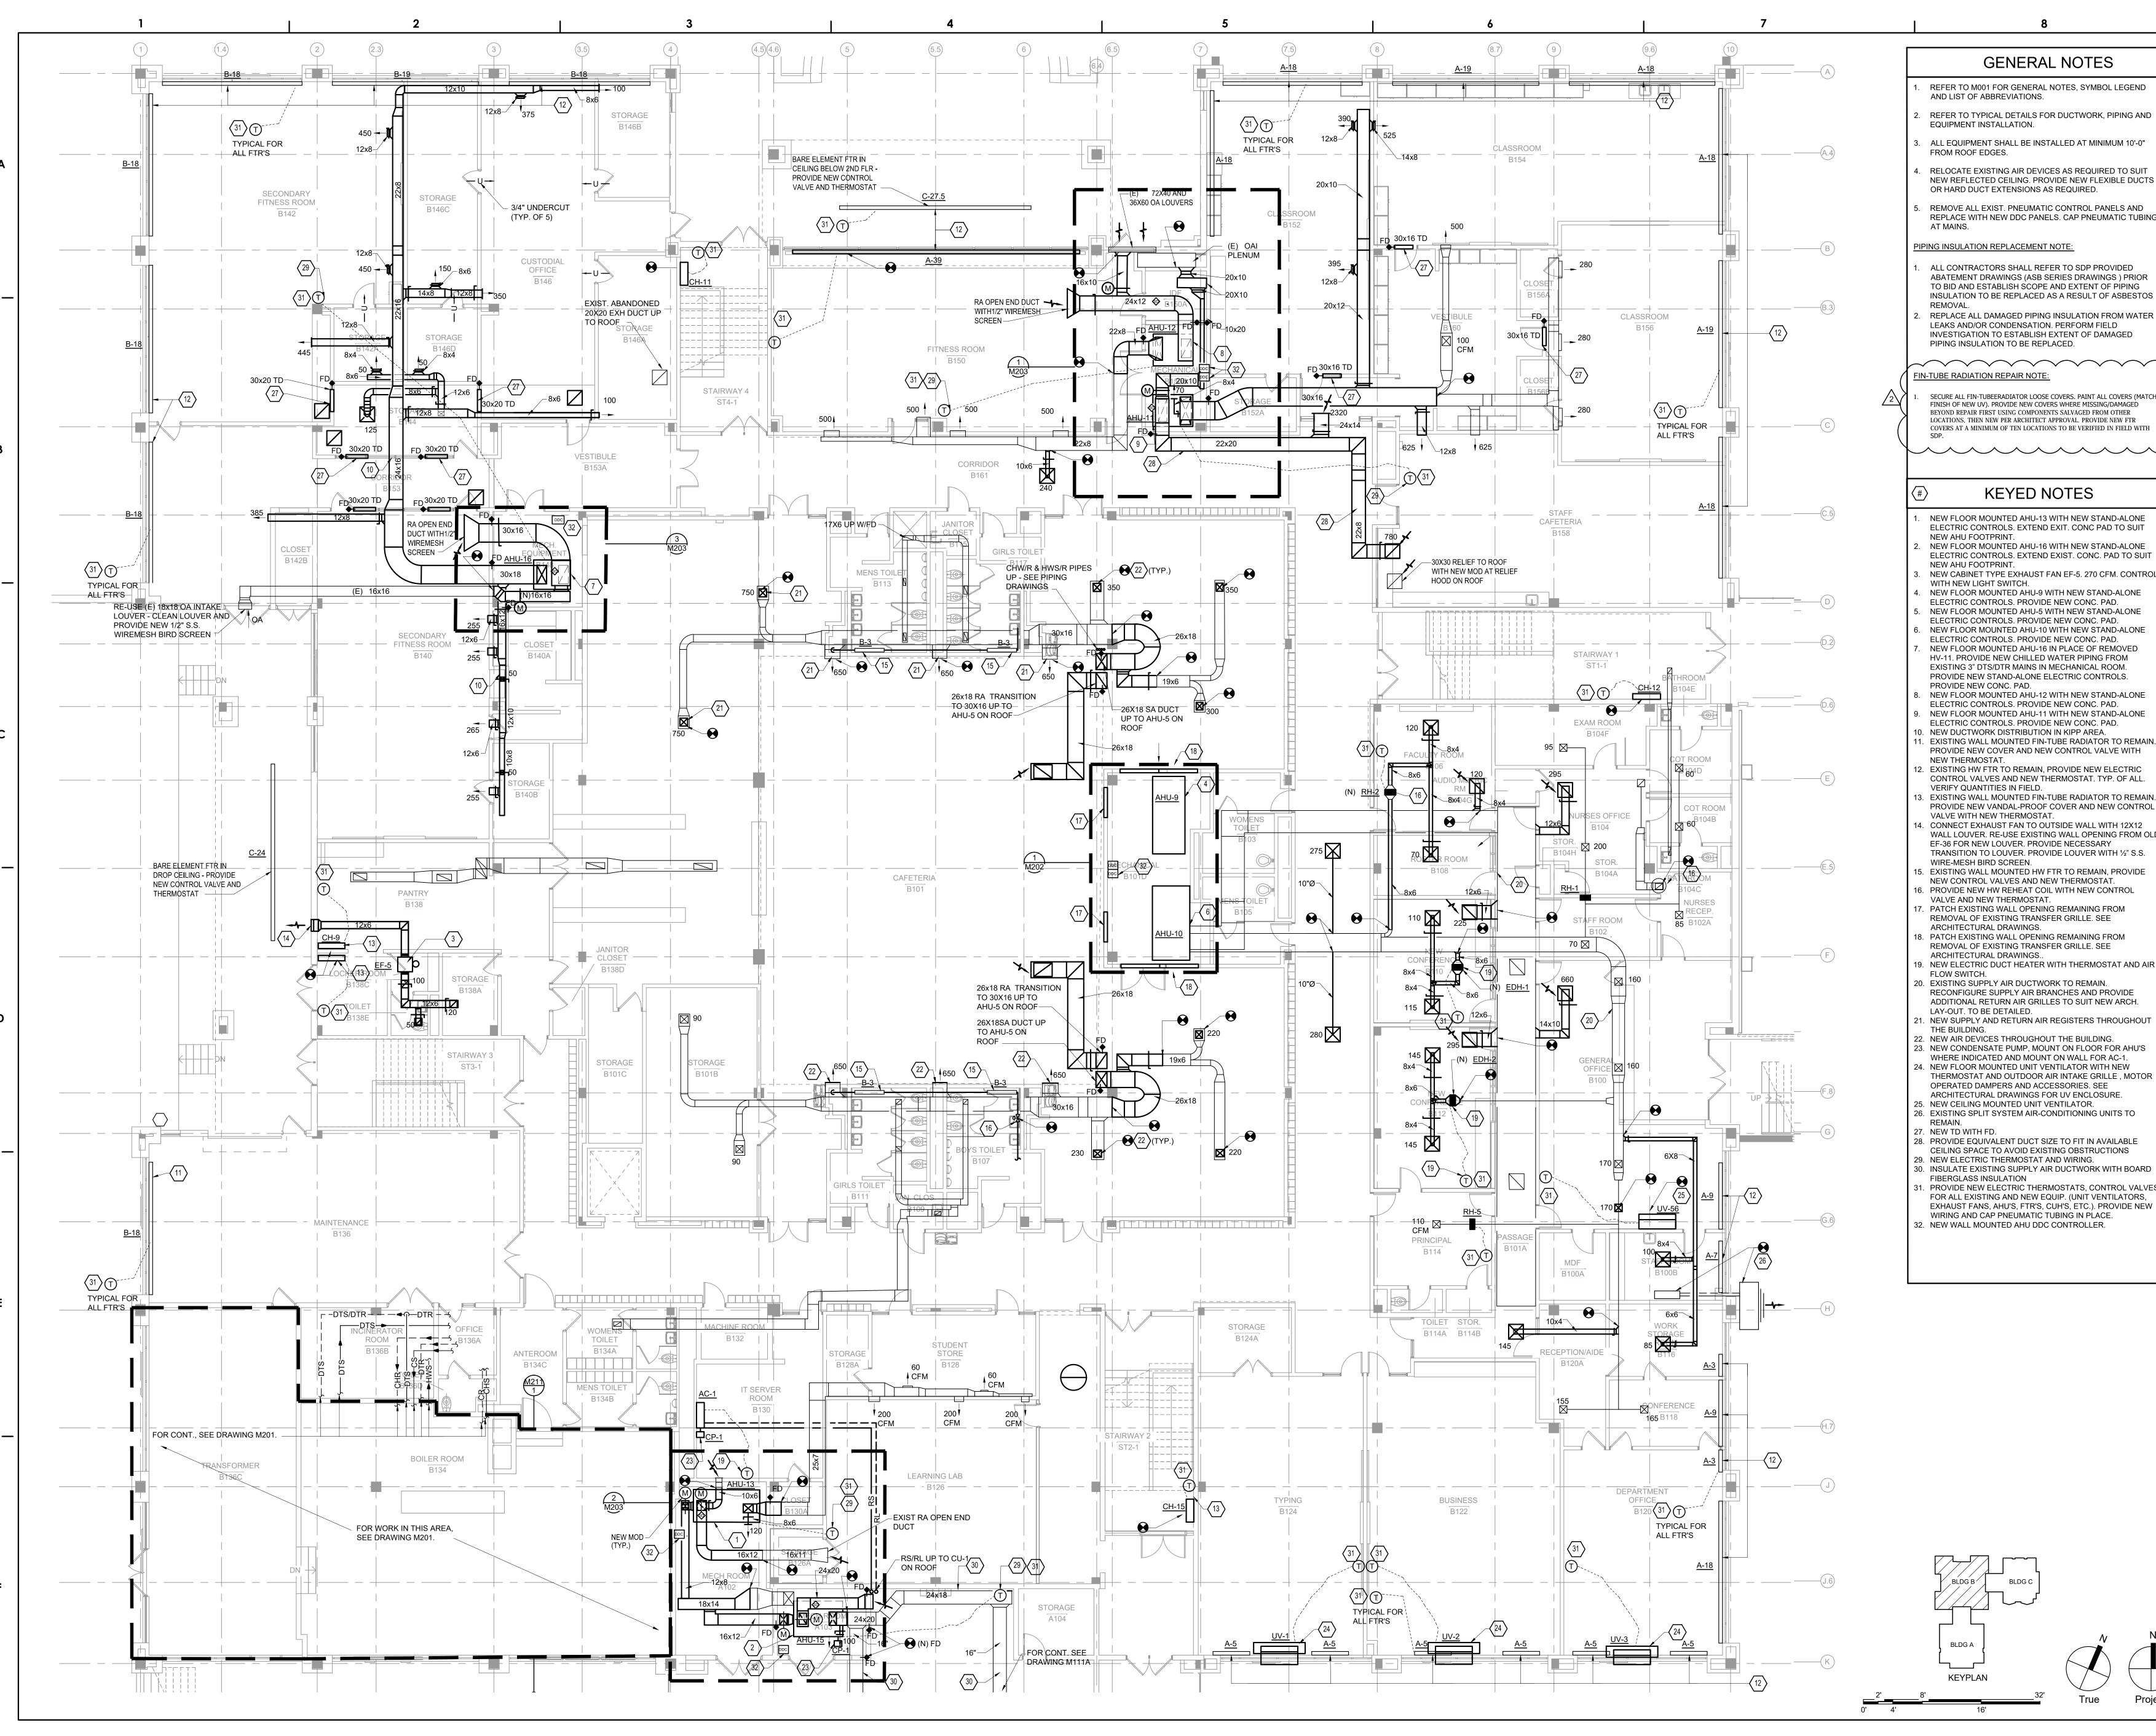

## **GENERAL NOTES**

THE SCHOOL DISTRICT OF PHILADELPHIA

OFFICE OF CAPITAL PROGRAMS

440 NORTH BROAD STREET

PHILADELPHIA, PA 19130 - 4015

(215) 400 - 4730 | (215) 400 - 4731 (fax)

www.philasd.org

SEAL:

NAME (LICENSED PROFESSIONAL) STATE AND LICENSE NO:

Architectural:

Email: Canspach@sgarc.com

Attn: Courtney Anspach

Structural:

Phone: 717.299.8965

Attn: Tom Forsberg

Phone: 484.443.4433

Attn: Ken Bissinger

Email: tforsberg@sgarc.com

Renew Design Group

Global Engineering Solutions®

Phone: 301.216.2871

Attn: Vassilis Skardis

Phone: 410.573.9148

Attn: Bryan Jones

FEBRUARY 16, 2018

Email: vassilis@theges.com

Educational Systems Planning

Fax: 301.216.9671

Security/IT:

PA 17602

SCHRADERGROUP Architecture, LLC

Address: 161 Leverington Ave, Suite 105, Philadelphia,

SCHRADERGROUP Architecture, LLC

Address: 153 East King Street, Suite 211-212, Lancaster,

Address: 117 East Broad Street, 3rd Floor, Souderton, PA

Address: 6700 Rockledge Drive, #301, Bethesda, MD

Address: 49 Old Solomons Island Road, Annapolis, MD

Email: bjones@educationalsystemsplanning.com

Revision Schedule

Addendum # 2

DESCRIPTION DATE

Email: kenbissinger@renewdesigngroup.com

- REFER TO M001 FOR GENERAL NOTES, SYMBOL LEGEND
- REFER TO TYPICAL DETAILS FOR DUCTWORK, PIPING AND
- EQUIPMENT INSTALLATION.
- ALL EQUIPMENT SHALL BE INSTALLED AT MINIMUM 10'-0" FROM ROOF EDGES.
- RELOCATE EXISTING AIR DEVICES AS REQUIRED TO SUIT
- NEW REFLECTED CEILING. PROVIDE NEW FLEXIBLE DUCTS OR HARD DUCT EXTENSIONS AS REQUIRED.
- REMOVE ALL EXIST. PNEUMATIC CONTROL PANELS AND REPLACE WITH NEW DDC PANELS. CAP PNEUMATIC TUBING
- PIPING INSULATION REPLACEMENT NOTE:
- ALL CONTRACTORS SHALL REFER TO SDP PROVIDED ABATEMENT DRAWINGS (ASB SERIES DRAWINGS ) PRIOR TO BID AND ESTABLISH SCOPE AND EXTENT OF PIPING INSULATION TO BE REPLACED AS A RESULT OF ASBESTOS
- REPLACE ALL DAMAGED PIPING INSULATION FROM WATER LEAKS AND/OR CONDENSATION. PERFORM FIELD INVESTIGATION TO ESTABLISH EXTENT OF DAMAGED

### FIN-TUBE RADIATION REPAIR NOTE:

- SECURE ALL FIN-TUBEERADIATOR LOOSE COVERS. PAINT ALL COVERS (MATCH FINISH OF NEW UV). PROVIDE NEW COVERS WHERE MISSING/DAMAGED BEYOND REPAIR FIRST USING COMPONENTS SALVAGED FROM OTHER LOCATIONS. THEN NEW PER ARCHITECT APPROVAL, PROVIDE NEW FTR
  - PA 19127 Phone: 215.482.7440 Fax: 215.482.7441

### **KEYED NOTES**

- NEW FLOOR MOUNTED AHU-13 WITH NEW STAND-ALONE ELECTRIC CONTROLS. EXTEND EXIT. CONC PAD TO SUIT
- NEW AHU FOOTPRINT NEW FLOOR MOUNTED AHU-16 WITH NEW STAND-ALONE
- ELECTRIC CONTROLS. EXTEND EXIST. CONC. PAD TO SUIT NEW AHU FOOTPRINT
- NEW CABINET TYPE EXHAUST FAN EF-5. 270 CFM. CONTROL WITH NEW LIGHT SWITCH.
- NEW FLOOR MOUNTED AHU-9 WITH NEW STAND-ALONE
- ELECTRIC CONTROLS. PROVIDE NEW CONC. PAD. NEW FLOOR MOUNTED AHU-5 WITH NEW STAND-ALONE
- ELECTRIC CONTROLS. PROVIDE NEW CONC. PAD. NEW FLOOR MOUNTED AHU-10 WITH NEW STAND-ALONE ELECTRIC CONTROLS. PROVIDE NEW CONC. PAD.
- NEW FLOOR MOUNTED AHU-16 IN PLACE OF REMOVED HV-11. PROVIDE NEW CHILLED WATER PIPING FROM EXISTING 3" DTS/DTR MAINS IN MECHANICAL ROOM.
- PROVIDE NEW STAND-ALONE ELECTRIC CONTROLS. PROVIDE NEW CONC. PAD.
- NEW FLOOR MOUNTED AHU-12 WITH NEW STAND-ALONE ELECTRIC CONTROLS. PROVIDE NEW CONC. PAD.
- NEW FLOOR MOUNTED AHU-11 WITH NEW STAND-ALONE ELECTRIC CONTROLS. PROVIDE NEW CONC. PAD.
- . NEW DUCTWORK DISTRIBUTION IN KIPP AREA. EXISTING WALL MOUNTED FIN-TUBE RADIATOR TO REMAIN.
- PROVIDE NEW COVER AND NEW CONTROL VALVE WITH
- EXISTING HW FTR TO REMAIN, PROVIDE NEW ELECTRIC CONTROL VALVES AND NEW THERMOSTAT, TYP, OF ALL.
- VERIFY QUANTITIES IN FIELD. . EXISTING WALL MOUNTED FIN-TUBE RADIATOR TO REMAIN
- VALVE WITH NEW THERMOSTAT. . CONNECT EXHAUST FAN TO OUTSIDE WALL WITH 12X12
- WALL LOUVER. RE-USE EXISTING WALL OPENING FROM OLD EF-36 FOR NEW LOUVER. PROVIDE NECESSARY TRANSITION TO LOUVER. PROVIDE LOUVER WITH 1/2" S.S.
- WIRE-MESH BIRD SCREEN. . EXISTING WALL MOUNTED HW FTR TO REMAIN, PROVIDE
- NEW CONTROL VALVES AND NEW THERMOSTAT. PROVIDE NEW HW REHEAT COIL WITH NEW CONTROL
- VALVE AND NEW THERMOSTAT. . PATCH EXISTING WALL OPENING REMAINING FROM
- REMOVAL OF EXISTING TRANSFER GRILLE. SEE ARCHITECTURAL DRAWINGS. . PATCH EXISTING WALL OPENING REMAINING FROM
- REMOVAL OF EXISTING TRANSFER GRILLE. SEE ARCHITECTURAL DRAWINGS.. . NEW ELECTRIC DUCT HEATER WITH THERMOSTAT AND AIR
- ). EXISTING SUPPLY AIR DUCTWORK TO REMAIN. RECONFIGURE SUPPLY AIR BRANCHES AND PROVIDE
- ADDITIONAL RETURN AIR GRILLES TO SUIT NEW ARCH. LAY-OUT. TO BE DETAILED. . NEW SUPPLY AND RETURN AIR REGISTERS THROUGHOUT
- THE BUILDING. 2. NEW AIR DEVICES THROUGHOUT THE BUILDING.
- 23. NEW CONDENSATE PUMP, MOUNT ON FLOOR FOR AHU'S WHERE INDICATED AND MOUNT ON WALL FOR AC-1.
- THERMOSTAT AND OUTDOOR AIR INTAKE GRILLE, MOTOR OPERATED DAMPERS AND ACCESSORIES. SEE
- ARCHITECTURAL DRAWINGS FOR UV ENCLOSURE. . NEW CEILING MOUNTED UNIT VENTILATOR.
- 26. EXISTING SPLIT SYSTEM AIR-CONDITIONING UNITS TO
- 7. NEW TD WITH FD.
- 28. PROVIDE EQUIVALENT DUCT SIZE TO FIT IN AVAILABLE
- CEILING SPACE TO AVOID EXISTING OBSTRUCTIONS 29. NEW ELECTRIC THERMOSTAT AND WIRING.
- 30. INSULATE EXISTING SUPPLY AIR DUCTWORK WITH BOARD FIBERGLASS INSULATION
- . PROVIDE NEW ELECTRIC THERMOSTATS, CONTROL VALVES FOR ALL EXISTING AND NEW EQUIP. (UNIT VENTILATORS, EXHAUST FANS, AHU'S, FTR'S, CUH'S, ETC.). PROVIDE NEW WIRING AND CAP PNEUMATIC TUBING IN PLACE.

# SCHOOL & LOCATION

**Motivation High School** 

5900 Baltimore Avenue, Philadelphia PA 19143


PROJECT TITLE

**Renovations to Motivation High** School

DRAWING TITLE

BUILDING B - LEVEL 1 - HVAC -NEW WORK

CATION NO. 015		FILE NO.
AWN BY		CHECKED BY
B-014 C B-017 C B-015 C B-016 C	01 01 01	2017/18 2017/18

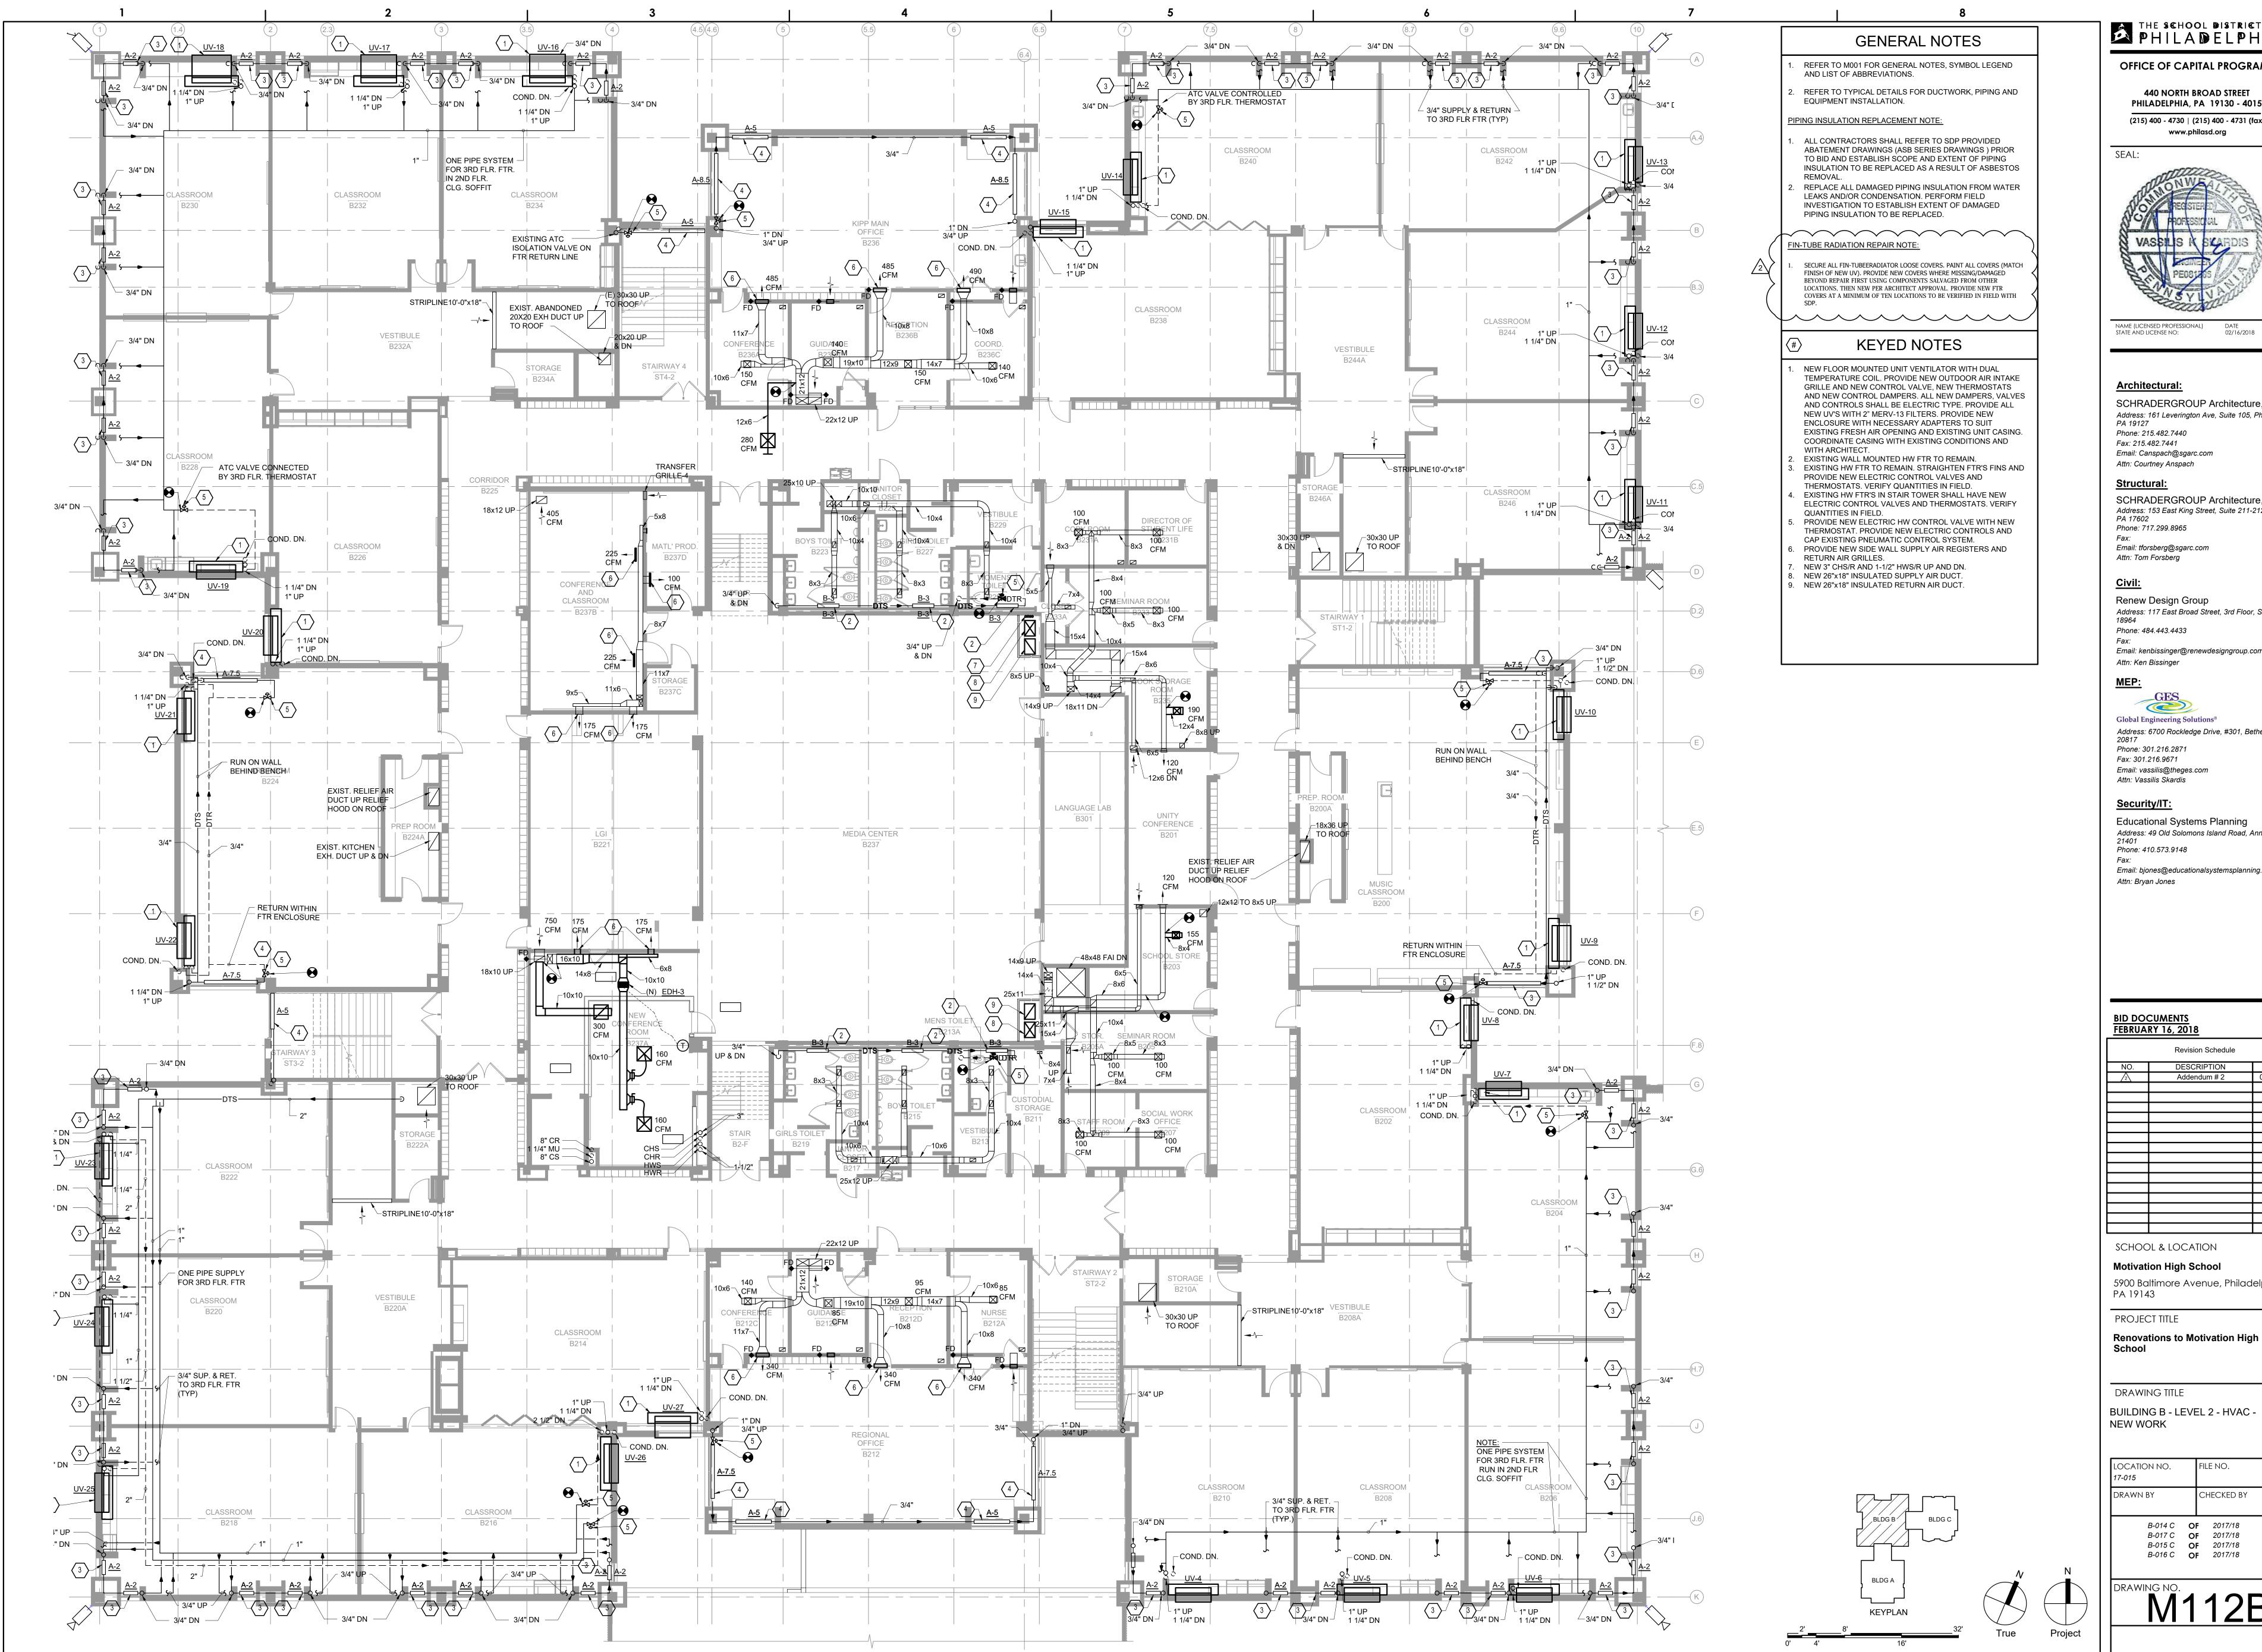

OFFICE OF CAPITAL PROGRAMS

www.philasd.org

440 NORTH BROAD STREET PHILADELPHIA, PA 19130 - 4015 (215) 400 - 4730 | (215) 400 - 4731 (fax)



NAME (LICENSED PROFESSIONAL) STATE AND LICENSE NO:

**Architectural:** 

SCHRADERGROUP Architecture, LLC Address: 161 Leverington Ave, Suite 105, Philadelphia,

Fax: 215.482.7441 Email: Canspach@sgarc.com

Attn: Courtney Anspach

SCHRADERGROUP Architecture, LLC Address: 153 East King Street, Suite 211-212, Lancaster,

Email: tforsberg@sgarc.com Attn: Tom Forsberg

Address: 117 East Broad Street, 3rd Floor, Souderton, PA

Phone: 484.443.4433

Email: kenbissinger@renewdesigngroup.com

Attn: Ken Bissinger

Global Engineering Solutions® Address: 6700 Rockledge Drive, #301, Bethesda, MD

Fax: 301.216.9671 Email: vassilis@theges.com

Educational Systems Planning Address: 49 Old Solomons Island Road, Annapolis, MD

Phone: 410.573.9148

Email: bjones@educationalsystemsplanning.com Attn: Bryan Jones

Revision Schedule NO. DESCRIPTION DATE Addendum # 2

SCHOOL & LOCATION

**Motivation High School** 


5900 Baltimore Avenue, Philadelphia

PROJECT TITLE

DRAWING TITLE

BUILDING B - LEVEL 2 - HVAC -NEW WORK

CATION NO. 015		FILE NO.
AWN BY		CHECKED BY
B-014 C B-017 C B-015 C B-016 C	OI OI OI	2017/18 2017/18

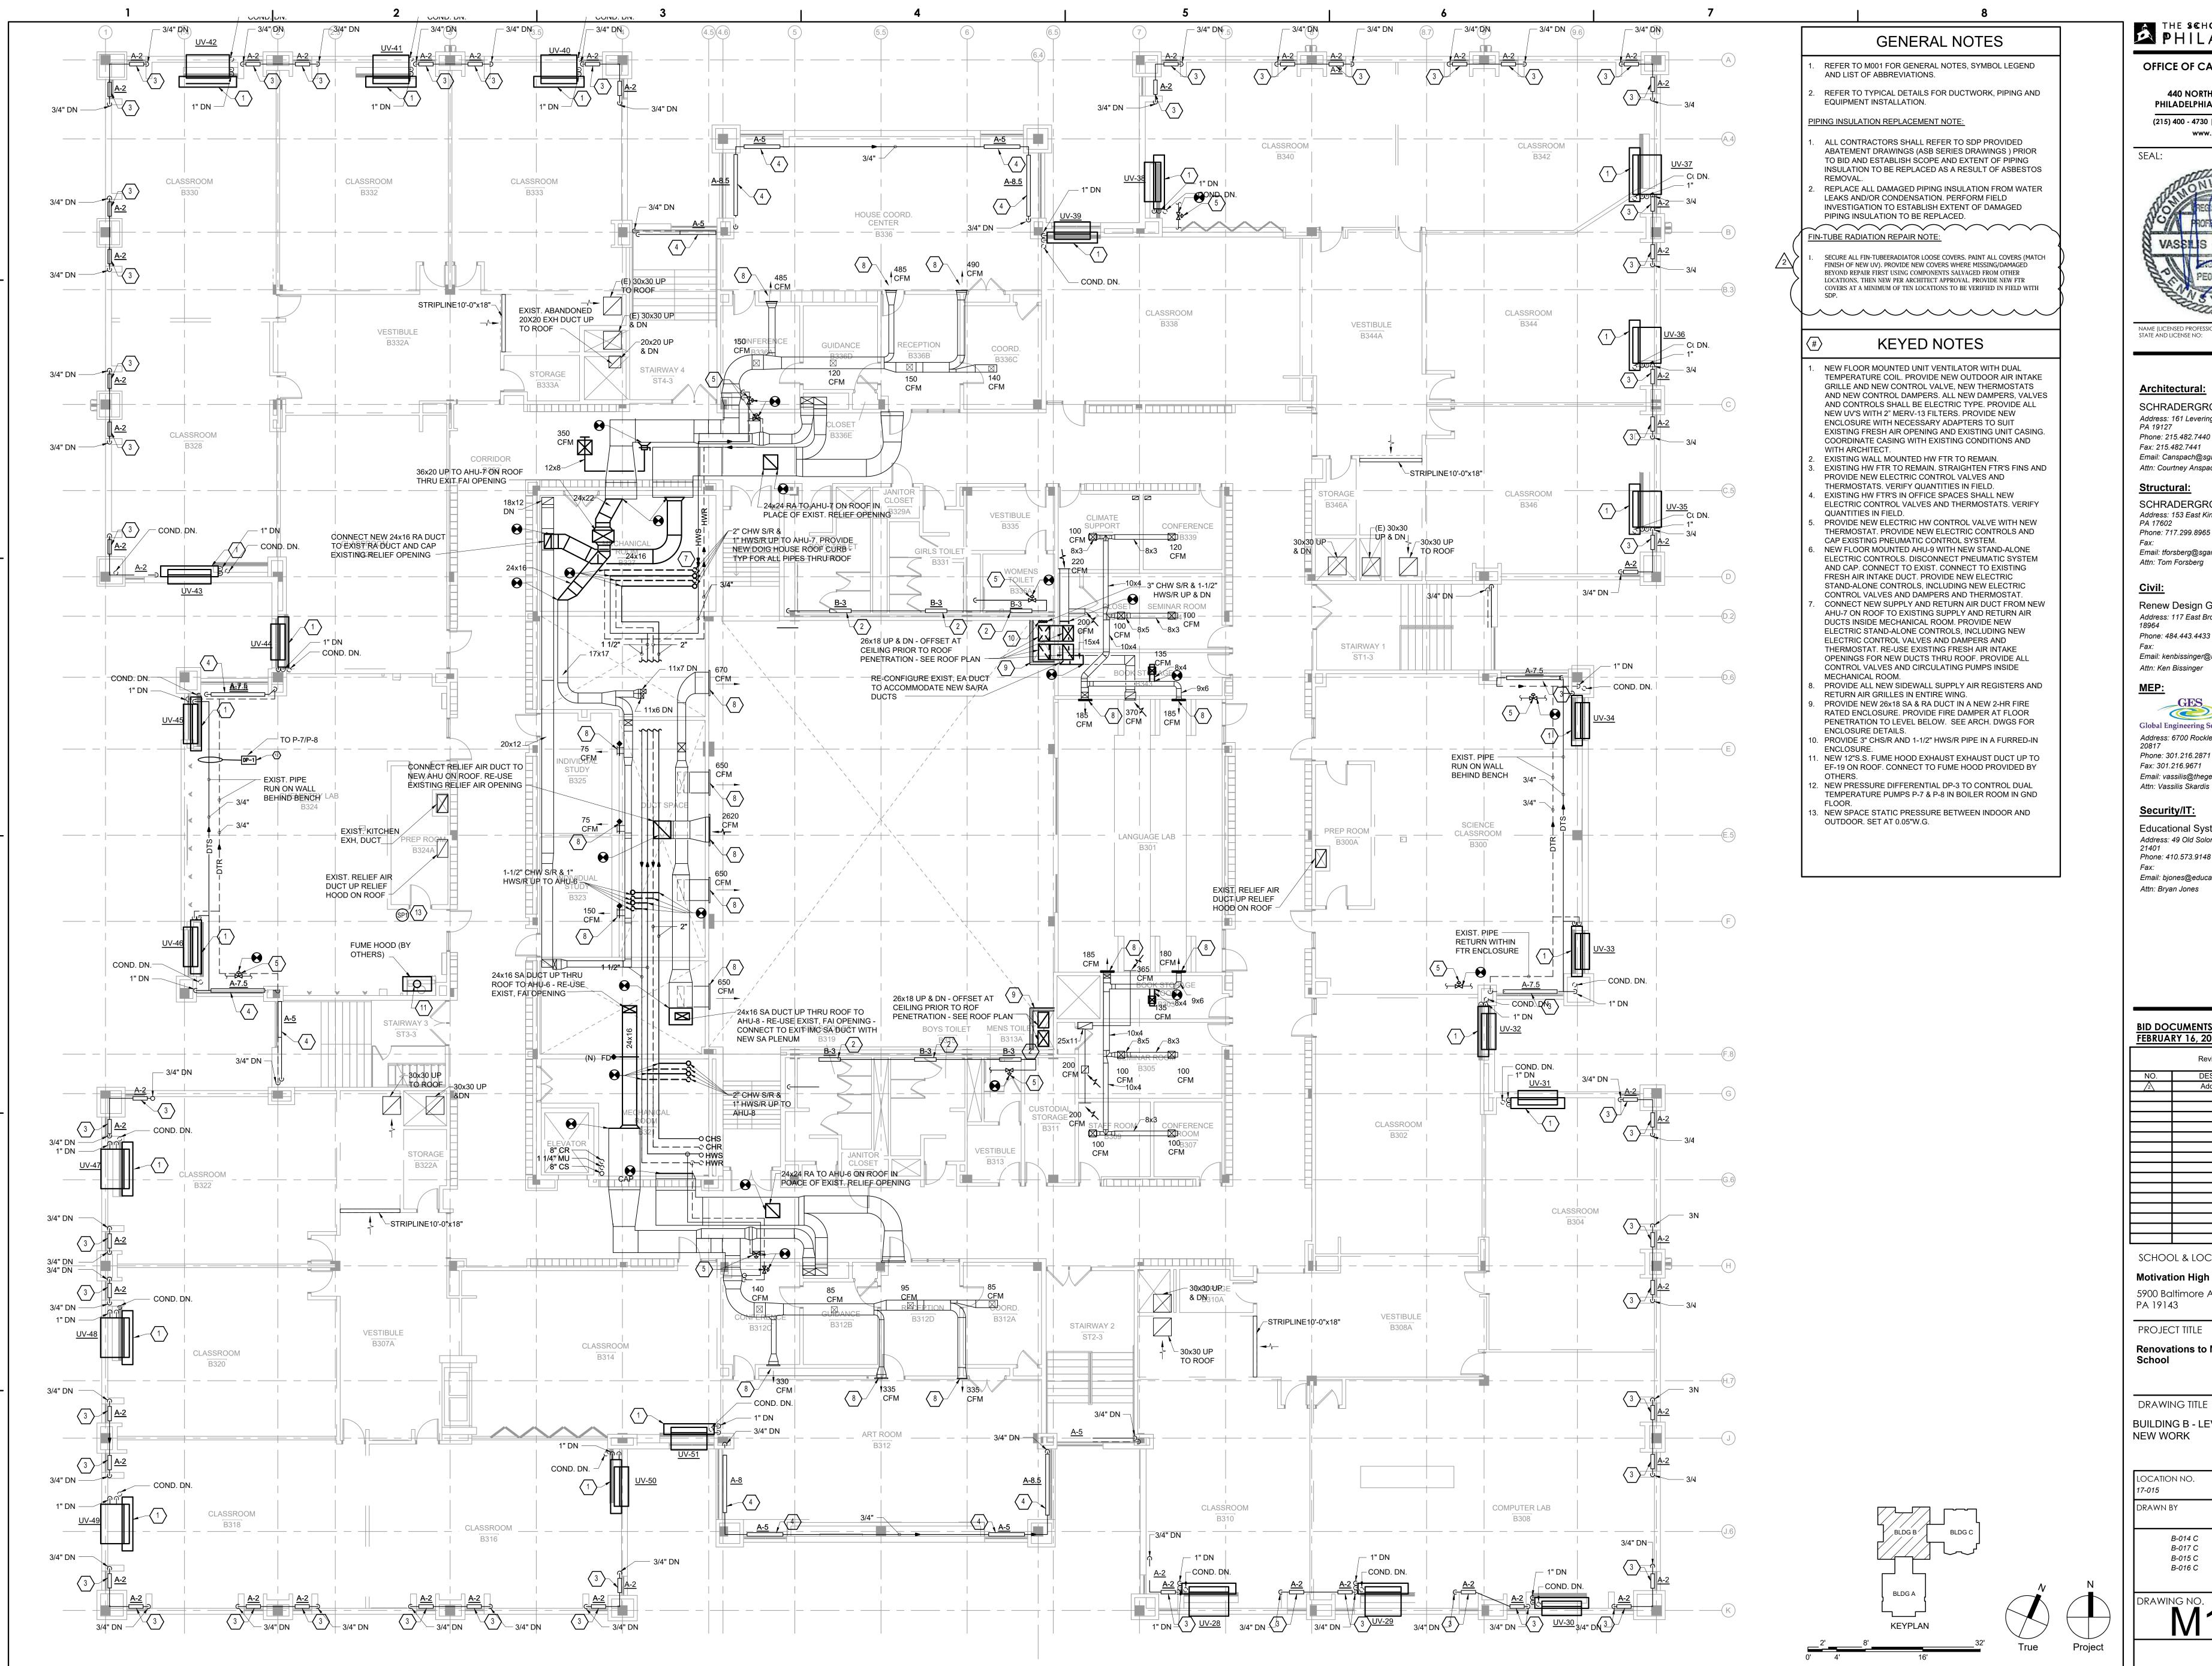

OFFICE OF CAPITAL PROGRAMS

www.philasd.org

440 NORTH BROAD STREET PHILADELPHIA, PA 19130 - 4015 (215) 400 - 4730 | (215) 400 - 4731 (fax)



NAME (LICENSED PROFESSIONAL) STATE AND LICENSE NO:

**Architectural:** SCHRADERGROUP Architecture, LLC

Address: 161 Leverington Ave, Suite 105, Philadelphia, Phone: 215.482.7440

Email: Canspach@sgarc.com Attn: Courtney Anspach

Structural: SCHRADERGROUP Architecture, LLC Address: 153 East King Street, Suite 211-212, Lancaster,

Email: tforsberg@sgarc.com Attn: Tom Forsberg

Renew Design Group Address: 117 East Broad Street, 3rd Floor, Souderton, PA Phone: 484.443.4433

Email: kenbissinger@renewdesigngroup.com Attn: Ken Bissinger

**Global Engineering Solutions®** Address: 6700 Rockledge Drive, #301, Bethesda, MD Phone: 301.216.2871

Email: vassilis@theges.com Attn: Vassilis Skardis

Security/IT:

Educational Systems Planning Address: 49 Old Solomons Island Road, Annapolis, MD Phone: 410.573.9148

Email: bjones@educationalsystemsplanning.com Attn: Bryan Jones

BID DOCUMENTS FEBRUARY 16, 2018

Revision Schedule					
NO.	DESCRIPTION	DATE			
2	Addendum # 2	03/22/2018			
·					
	· ·	,			

SCHOOL & LOCATION

**Motivation High School** 

5900 Baltimore Avenue, Philadelphia PA 19143


**Renovations to Motivation High** 

DRAWING TITLE

BUILDING B - LEVEL 3 - HVAC -NEW WORK

OCATION NO. 7-015		FILE NO.
RAWN BY		CHECKED BY
B-014 C B-017 C B-015 C B-016 C	01 01 01	F 2017/18 F 2017/18

M113B

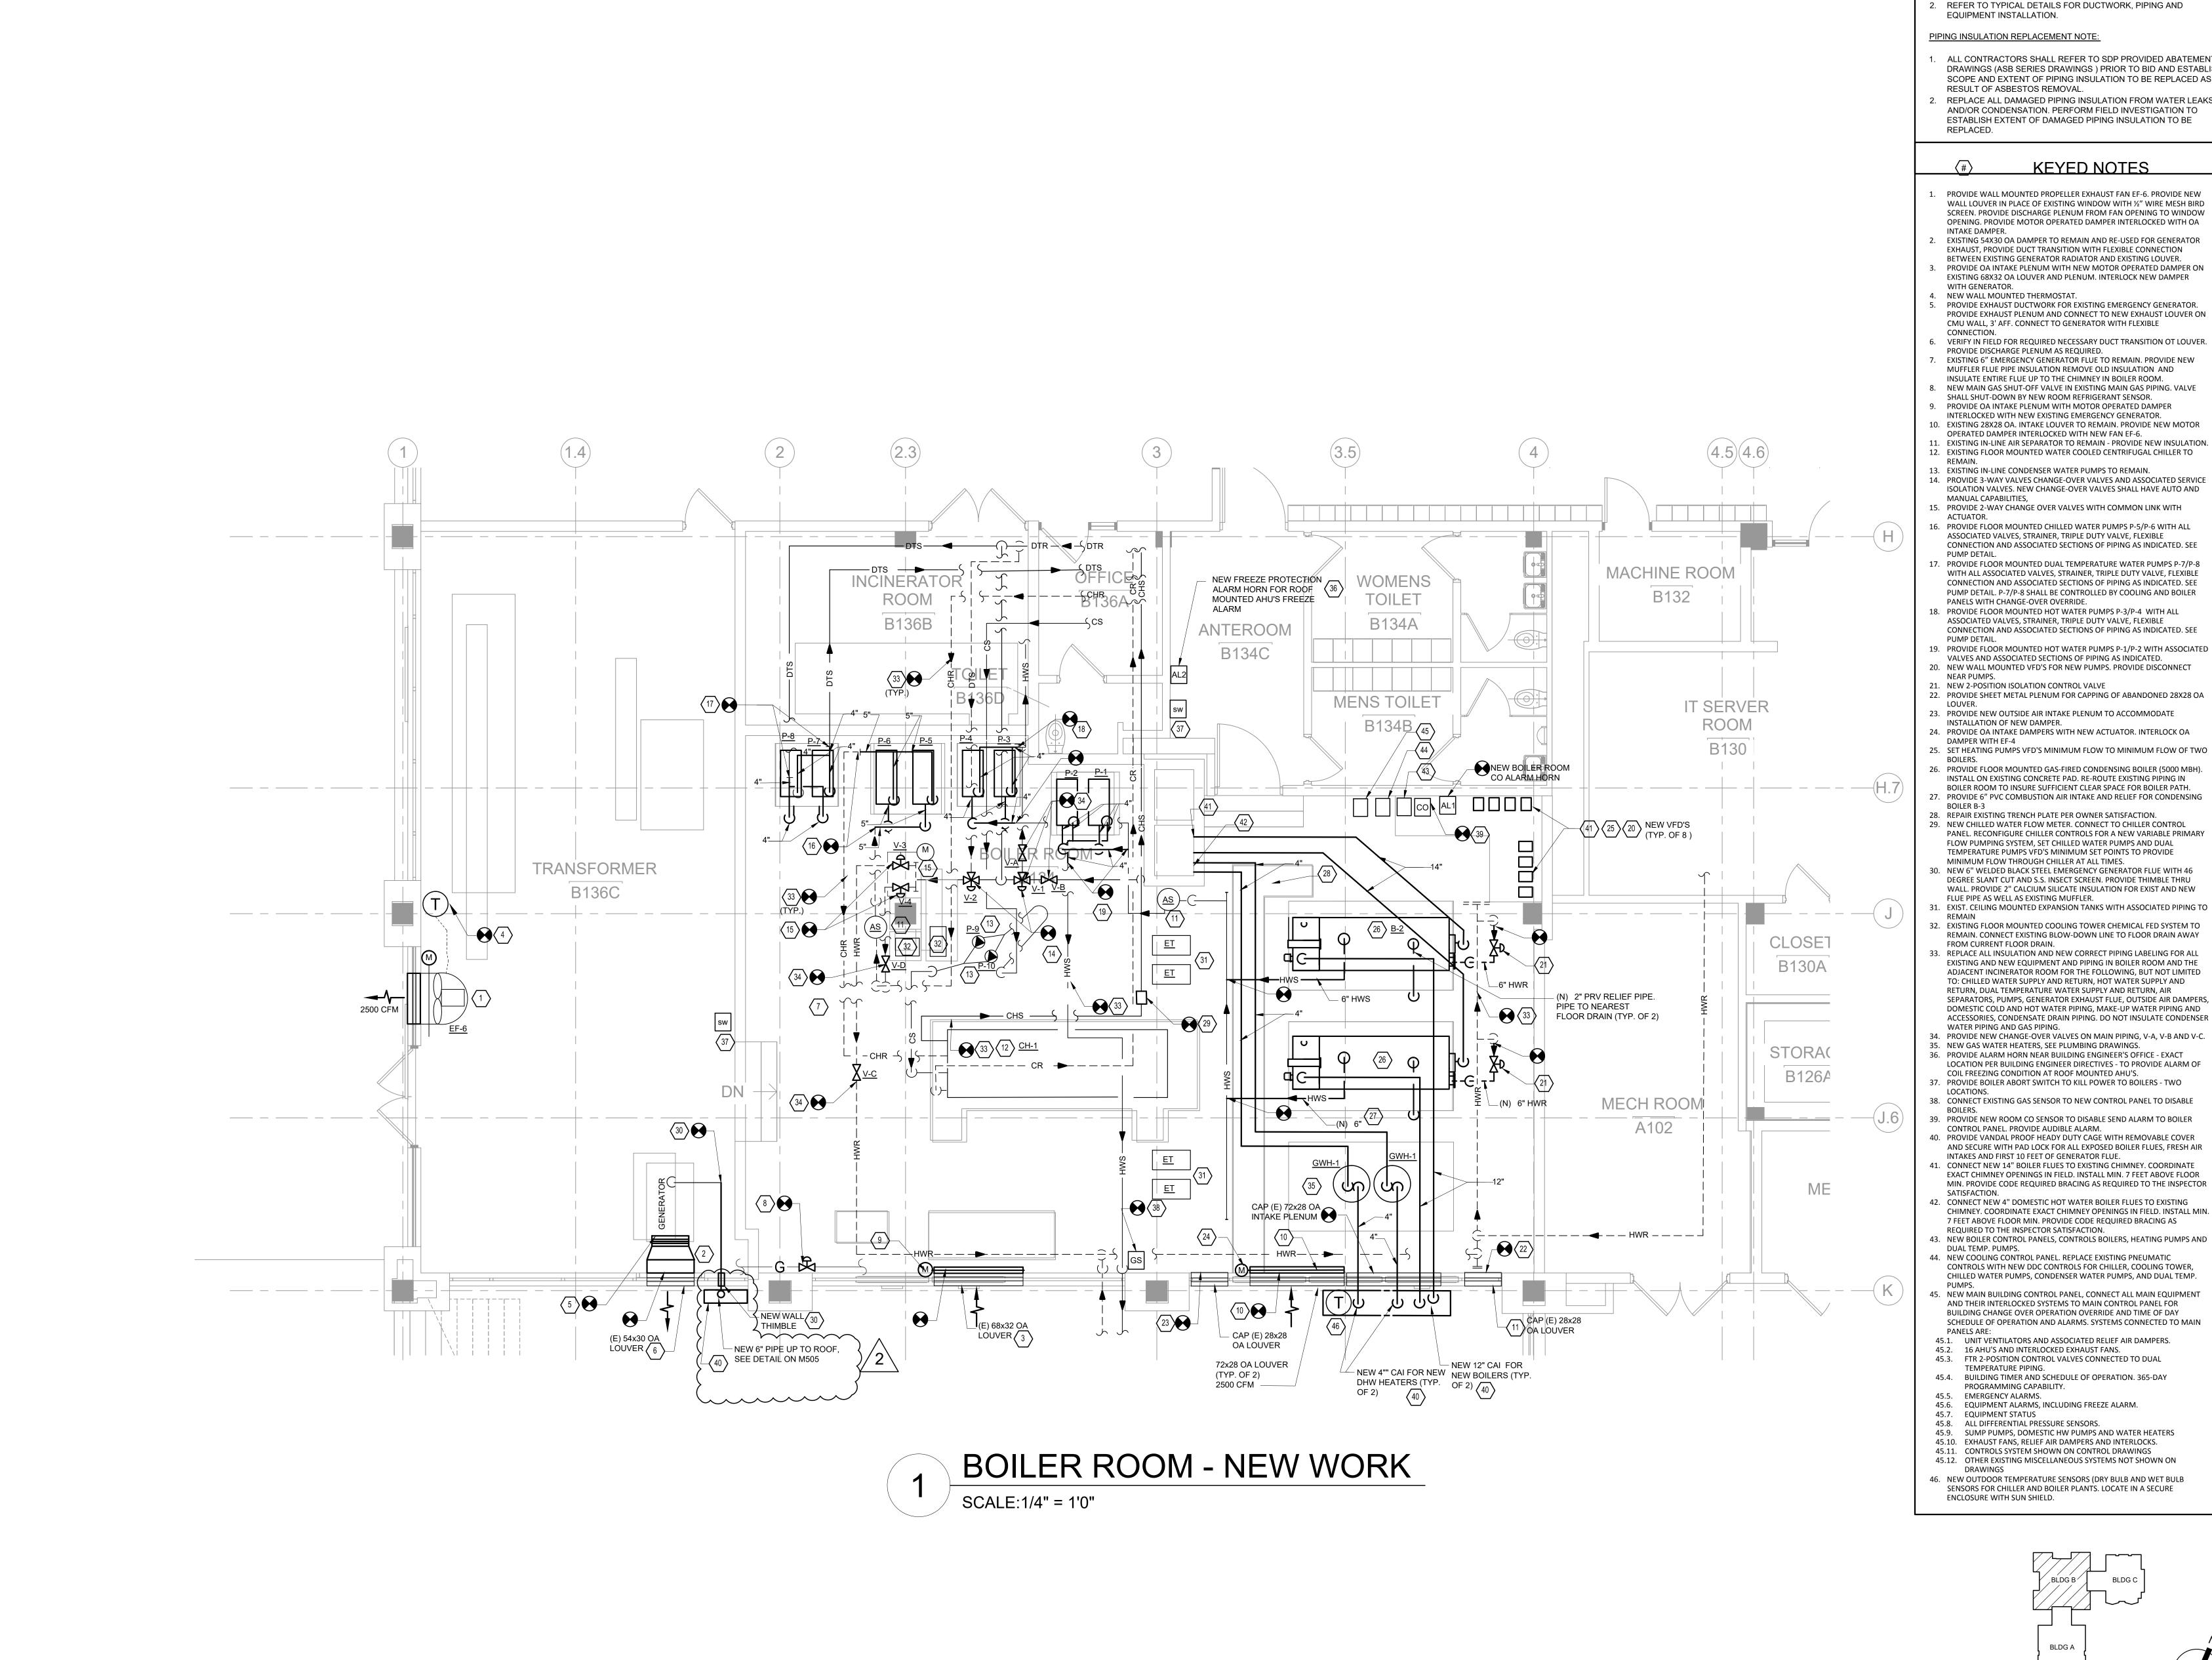

### **GENERAL NOTES**

1. REFER TO M001 FOR GENERAL NOTES, SYMBOL LEGEND AND LIST OF ABBREVIATIONS.

2. REFER TO TYPICAL DETAILS FOR DUCTWORK, PIPING AND


. ALL CONTRACTORS SHALL REFER TO SDP PROVIDED ABATEMENT DRAWINGS (ASB SERIES DRAWINGS ) PRIOR TO BID AND ESTABLISH SCOPE AND EXTENT OF PIPING INSULATION TO BE REPLACED AS A RESULT OF ASBESTOS REMOVAL. 2. REPLACE ALL DAMAGED PIPING INSULATION FROM WATER LEAKS


AND/OR CONDENSATION. PERFORM FIELD INVESTIGATION TO ESTABLISH EXTENT OF DAMAGED PIPING INSULATION TO BE

### **KEYED NOTES**

1. PROVIDE WALL MOUNTED PROPELLER EXHAUST FAN EF-6. PROVIDE NEW WALL LOUVER IN PLACE OF EXISTING WINDOW WITH ½" WIRE MESH BIRD SCREEN. PROVIDE DISCHARGE PLENUM FROM FAN OPENING TO WINDOW OPENING. PROVIDE MOTOR OPERATED DAMPER INTERLOCKED WITH OA

- EXHAUST, PROVIDE DUCT TRANSITION WITH FLEXIBLE CONNECTION BETWEEN EXISTING GENERATOR RADIATOR AND EXISTING LOUVER. 3. PROVIDE OA INTAKE PLENUM WITH NEW MOTOR OPERATED DAMPER ON EXISTING 68X32 OA LOUVER AND PLENUM. INTERLOCK NEW DAMPER
- 4. NEW WALL MOUNTED THERMOSTAT. 5. PROVIDE EXHAUST DUCTWORK FOR EXISTING EMERGENCY GENERATOR. PROVIDE EXHAUST PLENUM AND CONNECT TO NEW EXHAUST LOUVER ON
- CMU WALL, 3' AFF. CONNECT TO GENERATOR WITH FLEXIBLE 6. VERIFY IN FIELD FOR REQUIRED NECESSARY DUCT TRANSITION OT LOUVER.
- EXISTING 6" EMERGENCY GENERATOR FLUE TO REMAIN. PROVIDE NEW MUFFLER FLUE PIPE INSULATION REMOVE OLD INSULATION AND INSULATE ENTIRE FLUE UP TO THE CHIMNEY IN BOILER ROOM.
- 8. NEW MAIN GAS SHUT-OFF VALVE IN EXISTING MAIN GAS PIPING. VALVE SHALL SHUT-DOWN BY NEW ROOM REFRIGERANT SENSOR. 9. PROVIDE OA INTAKE PLENUM WITH MOTOR OPERATED DAMPER INTERLOCKED WITH NEW EXISTING EMERGENCY GENERATOR.
- OPERATED DAMPER INTERLOCKED WITH NEW FAN EF-6. 11. EXISTING IN-LINE AIR SEPARATOR TO REMAIN - PROVIDE NEW INSULATION. 12. EXISTING FLOOR MOUNTED WATER COOLED CENTRIFUGAL CHILLER TO
- 13. EXISTING IN-LINE CONDENSER WATER PUMPS TO REMAIN. 14. PROVIDE 3-WAY VALVES CHANGE-OVER VALVES AND ASSOCIATED SERVICE ISOLATION VALVES. NEW CHANGE-OVER VALVES SHALL HAVE AUTO AND
- 15. PROVIDE 2-WAY CHANGE OVER VALVES WITH COMMON LINK WITH
- 16. PROVIDE FLOOR MOUNTED CHILLED WATER PUMPS P-5/P-6 WITH ALL ASSOCIATED VALVES, STRAINER, TRIPLE DUTY VALVE, FLEXIBLE
- PROVIDE FLOOR MOUNTED DUAL TEMPERATURE WATER PUMPS P-7/P-8 WITH ALL ASSOCIATED VALVES, STRAINER, TRIPLE DUTY VALVE, FLEXIBLE CONNECTION AND ASSOCIATED SECTIONS OF PIPING AS INDICATED. SEE
- PUMP DETAIL. P-7/P-8 SHALL BE CONTROLLED BY COOLING AND BOILER PANELS WITH CHANGE-OVER OVERRIDE. 18. PROVIDE FLOOR MOUNTED HOT WATER PUMPS P-3/P-4 WITH ALL ASSOCIATED VALVES, STRAINER, TRIPLE DUTY VALVE, FLEXIBLE
- CONNECTION AND ASSOCIATED SECTIONS OF PIPING AS INDICATED. SEE 19. PROVIDE FLOOR MOUNTED HOT WATER PUMPS P-1/P-2 WITH ASSOCIATED
- VALVES AND ASSOCIATED SECTIONS OF PIPING AS INDICATED. 20. NEW WALL MOUNTED VFD'S FOR NEW PUMPS. PROVIDE DISCONNECT
- 21. NEW 2-POSITION ISOLATION CONTROL VALVE 22. PROVIDE SHEET METAL PLENUM FOR CAPPING OF ABANDONED 28X28 OA
- 23. PROVIDE NEW OUTSIDE AIR INTAKE PLENUM TO ACCOMMODATE
- 24. PROVIDE OA INTAKE DAMPERS WITH NEW ACTUATOR. INTERLOCK OA 25. SET HEATING PUMPS VFD'S MINIMUM FLOW TO MINIMUM FLOW OF TWO
- 26. PROVIDE FLOOR MOUNTED GAS-FIRED CONDENSING BOILER (5000 MBH). INSTALL ON EXISTING CONCRETE PAD. RE-ROUTE EXISTING PIPING IN
- BOILER ROOM TO INSURE SUFFICIENT CLEAR SPACE FOR BOILER PATH. PROVIDE 6" PVC COMBUSTION AIR INTAKE AND RELIEF FOR CONDENSING 28. REPAIR EXISTING TRENCH PLATE PER OWNER SATISFACTION.
- 29. NEW CHILLED WATER FLOW METER. CONNECT TO CHILLER CONTROL PANEL. RECONFIGURE CHILLER CONTROLS FOR A NEW VARIABLE PRIMARY FLOW PUMPING SYSTEM, SET CHILLED WATER PUMPS AND DUAL TEMPERATURE PUMPS VFD'S MINIMUM SET POINTS TO PROVIDE
- MINIMUM FLOW THROUGH CHILLER AT ALL TIMES. 30. NEW 6" WELDED BLACK STEEL EMERGENCY GENERATOR FLUE WITH 46 DEGREE SLANT CUT AND S.S. INSECT SCREEN. PROVIDE THIMBLE THRU WALL. PROVIDE 2" CALCIUM SILICATE INSULATION FOR EXIST AND NEW FLUE PIPE AS WELL AS EXISTING MUFFLER.
- 32. EXISTING FLOOR MOUNTED COOLING TOWER CHEMICAL FED SYSTEM TO REMAIN. CONNECT EXISTING BLOW-DOWN LINE TO FLOOR DRAIN AWAY 33. REPLACE ALL INSULATION AND NEW CORRECT PIPING LABELING FOR ALL
- EXISTING AND NEW EQUIPMENT AND PIPING IN BOILER ROOM AND THE ADJACENT INCINERATOR ROOM FOR THE FOLLOWING, BUT NOT LIMITED TO: CHILLED WATER SUPPLY AND RETURN, HOT WATER SUPPLY AND RETURN, DUAL TEMPERATURE WATER SUPPLY AND RETURN, AIR SEPARATORS, PUMPS, GENERATOR EXHAUST FLUE, OUTSIDE AIR DAMPERS, DOMESTIC COLD AND HOT WATER PIPING, MAKE-UP WATER PIPING AND ACCESSORIES, CONDENSATE DRAIN PIPING. DO NOT INSULATE CONDENSER
- 34. PROVIDE NEW CHANGE-OVER VALVES ON MAIN PIPING, V-A, V-B AND V-C. 35. NEW GAS WATER HEATERS, SEE PLUMBING DRAWINGS. 36. PROVIDE ALARM HORN NEAR BUILDING ENGINEER'S OFFICE - EXACT LOCATION PER BUILDING ENGINEER DIRECTIVES - TO PROVIDE ALARM OF
- COIL FREEZING CONDITION AT ROOF MOUNTED AHU'S. 37. PROVIDE BOILER ABORT SWITCH TO KILL POWER TO BOILERS - TWO
- 38. CONNECT EXISTING GAS SENSOR TO NEW CONTROL PANEL TO DISABLE 39. PROVIDE NEW ROOM CO SENSOR TO DISABLE SEND ALARM TO BOILER
- CONTROL PANEL. PROVIDE AUDIBLE ALARM. 40. PROVIDE VANDAL PROOF HEADY DUTY CAGE WITH REMOVABLE COVER AND SECURE WITH PAD LOCK FOR ALL EXPOSED BOILER FLUES, FRESH AIR INTAKES AND FIRST 10 FEET OF GENERATOR FLUE.
- 41. CONNECT NEW 14" BOILER FLUES TO EXISTING CHIMNEY. COORDINATE EXACT CHIMNEY OPENINGS IN FIELD. INSTALL MIN. 7 FEET ABOVE FLOOR MIN. PROVIDE CODE REQUIRED BRACING AS REQUIRED TO THE INSPECTOR
- 42. CONNECT NEW 4" DOMESTIC HOT WATER BOILER FLUES TO EXISTING CHIMNEY. COORDINATE EXACT CHIMNEY OPENINGS IN FIELD. INSTALL MIN. 7 FEET ABOVE FLOOR MIN. PROVIDE CODE REQUIRED BRACING AS
- 43. NEW BOILER CONTROL PANELS, CONTROLS BOILERS, HEATING PUMPS AND 44. NEW COOLING CONTROL PANEL. REPLACE EXISTING PNEUMATIC CONTROLS WITH NEW DDC CONTROLS FOR CHILLER, COOLING TOWER, CHILLED WATER PUMPS, CONDENSER WATER PUMPS, AND DUAL TEMP.
- 45. NEW MAIN BUILDING CONTROL PANEL, CONNECT ALL MAIN EQUIPMENT AND THEIR INTERLOCKED SYSTEMS TO MAIN CONTROL PANEL FOR BUILDING CHANGE OVER OPERATION OVERRIDE AND TIME OF DAY SCHEDULE OF OPERATION AND ALARMS. SYSTEMS CONNECTED TO MAIN
- 45.1. UNIT VENTILATORS AND ASSOCIATED RELIEF AIR DAMPERS. 45.2. 16 AHU'S AND INTERLOCKED EXHAUST FANS.
- 45.3. FTR 2-POSITION CONTROL VALVES CONNECTED TO DUAL 45.4. BUILDING TIMER AND SCHEDULE OF OPERATION. 365-DAY
- PROGRAMMING CAPABILITY.
- 45.6. EQUIPMENT ALARMS, INCLUDING FREEZE ALARM.
- 45.8. ALL DIFFERENTIAL PRESSURE SENSORS. 45.9. SUMP PUMPS, DOMESTIC HW PUMPS AND WATER HEATERS
- 45.10. EXHAUST FANS, RELIEF AIR DAMPERS AND INTERLOCKS. 45.11. CONTROLS SYSTEM SHOWN ON CONTROL DRAWINGS
- 46. NEW OUTDOOR TEMPERATURE SENSORS (DRY BULB AND WET BULB SENSORS FOR CHILLER AND BOILER PLANTS. LOCATE IN A SECURE

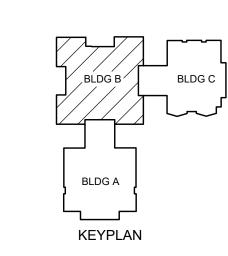

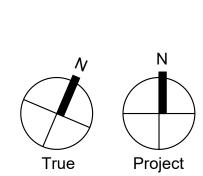

THE SCHOOL DISTRICT OF PHILADELPHIA

OFFICE OF CAPITAL PROGRAMS

440 NORTH BROAD STREET PHILADELPHIA, PA 19130 - 4015

(215) 400 - 4730 | (215) 400 - 4731 (fax) www.philasd.org

SEAL:



NAME (LICENSED PROFESSIONAL) STATE AND LICENSE NO:

**Architectural:** 

SCHRADERGROUP Architecture, LLC

Address: 161 Leverington Ave, Suite 105, Philadelphia, PA 19127 Phone: 215.482.7440

Fax: 215.482.7441 Email: Canspach@sgarc.com Attn: Courtney Anspach

Structural: SCHRADERGROUP Architecture, LLC Address: 153 East King Street, Suite 211-212, Lancaster,

Email: tforsberg@sgarc.com Attn: Tom Forsberg

Phone: 717.299.8965

PA 17602

Renew Design Group Address: 117 East Broad Street, 3rd Floor, Souderton, PA

Phone: 484.443.4433 Email: kenbissinger@renewdesigngroup.com

Attn: Ken Bissinger

MEP: Global Engineering Solutions®

Phone: 301.216.2871 Fax: 301.216.9671 Email: vassilis@theges.com Attn: Vassilis Skardis

Address: 6700 Rockledge Drive, #301, Bethesda, MD

Security/IT:

Educational Systems Planning Address: 49 Old Solomons Island Road, Annapolis, MD Phone: 410.573.9148

Email: bjones@educationalsystemsplanning.com Attn: Bryan Jones

FEBRUARY 16, 2018 Revision Schedule DESCRIPTION DATE Addendum # 2

SCHOOL & LOCATION

**Motivation High School** 


5900 Baltimore Avenue, Philadelphia PA 19143

PROJECT TITLE Renovations to Motivation High School

DRAWING TITLE

BUILDING B - BOILER ROOM -**ENLARGED PLANS - NEW WORK** 

LOCATION NO. DRAWN BY CHECKED BY *B-014 C* **OF** 2017/18 *B-017 C* **OF** *2017/18* B-015 C **OF** 2017/18 B-016 C **OF** 2017/18

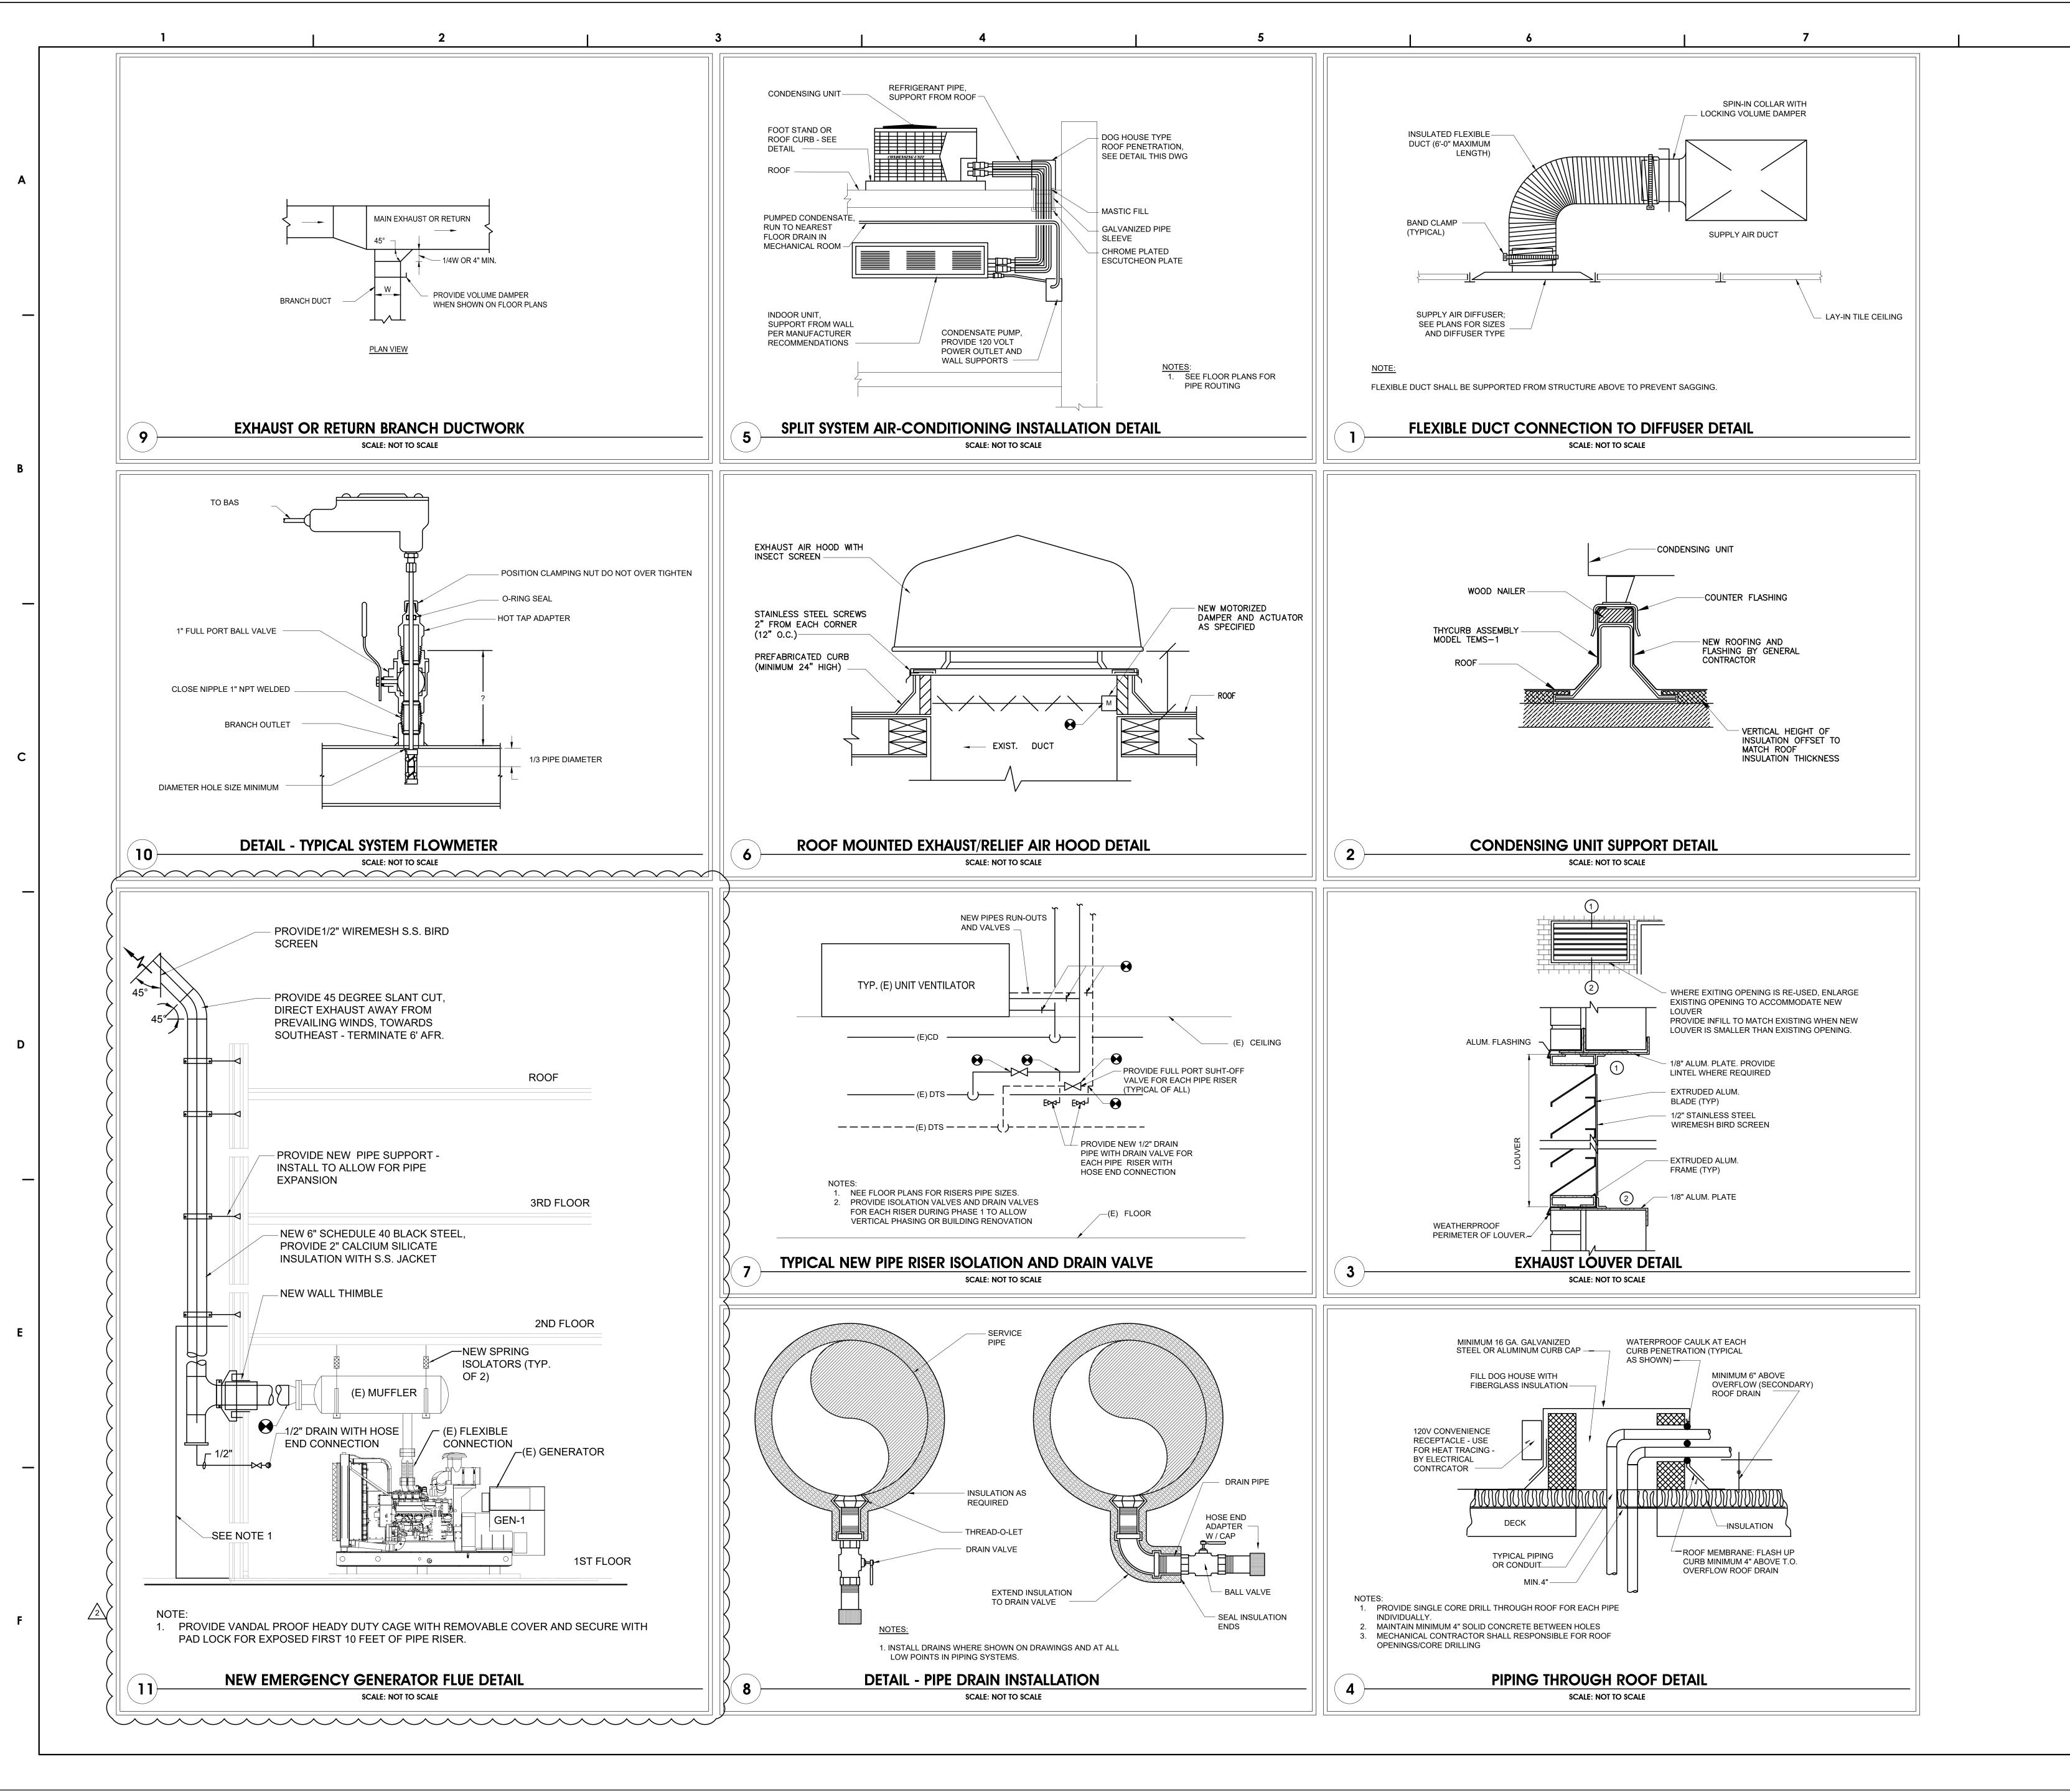

www.philasd.org

OFFICE OF CAPITAL PROGRAMS

**440 NORTH BROAD STREET** PHILADELPHIA, PA 19130 - 4015 (215) 400 - 4730 | (215) 400 - 4731 (fax)

SEAL:



NAME (LICENSED PROFESSIONAL) STATE AND LICENSE NO:

**Architectural:** 

SCHRADERGROUP Architecture, LLC Address: 161 Leverington Ave, Suite 105, Philadelphia,

PA 19127 Phone: 215.482.7440 Fax: 215.482.7441

Email: Canspach@sgarc.com Attn: Courtney Anspach

Structural: SCHRADERGROUP Architecture, LLC Address: 153 East King Street, Suite 211-212, Lancaster,

Phone: 717.299.8965 Email: tforsberg@sgarc.com

Attn: Tom Forsberg

<u>Civil:</u> Renew Design Group

PA 17602

Address: 117 East Broad Street, 3rd Floor, Souderton, P. 18964

Phone: 484.443.4433

Email: kenbissinger@renewdesigngroup.com Attn: Ken Bissinger

MEP:

Global Engineering Solutions®

Address: 6700 Rockledge Drive, #301, Bethesda, MD Phone: 301.216.2871

Fax: 301.216.9671 Email: vassilis@theges.com Attn: Vassilis Skardis

Security/IT:

Educational Systems Planning Address: 49 Old Solomons Island Road, Annapolis, MD Phone: 410.573.9148

Email: bjones@educationalsystemsplanning.com

Attn: Bryan Jones

BID DOCUMENTS FEBRUARY 16, 2018 Revision Schedule NO. DESCRIPTION DATE Addendum # 2

SCHOOL & LOCATION

**Motivation High School** 

5900 Baltimore Avenue, Philadelphia PA 19143

PROJECT TITLE

LOCATION NO.

School

Renovations to Motivation High

DRAWING TITLE

MECHANICAL DETAILS

17-015	
DRAWN BY	CHECKED BY
B-014 C O B-017 C O B-015 C O B-016 C O	F 2017/18 F 2017/18

DRAWING NO.\_ M505