


AS-BUILT

9/19/97

NO.	ADD. SLEEVE INFO	DATE	BY	SCALE	DATE	DRAWN	D.G.
1		9/19/96	L.W.	3/8"=1'-0"			
REVISION							
DRAWING NO. W-4							

TRACEY MECHANICAL, INC.
401 CITY LINE AVE.
SUITE 212
BALA CYNWYD, PA. 19004
6TH AND DUNCANNON
PARTIAL 1ST FLOOR
WATER & GAS PIPING

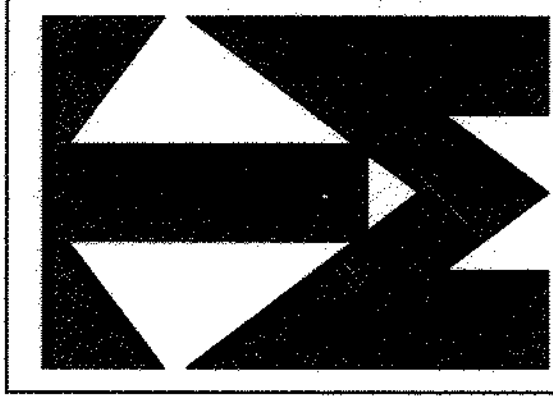

REVIEWED

DATE: 9/19/96 BY: L.W.

