
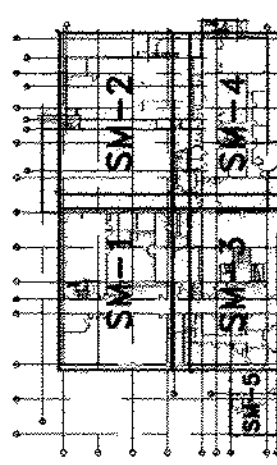
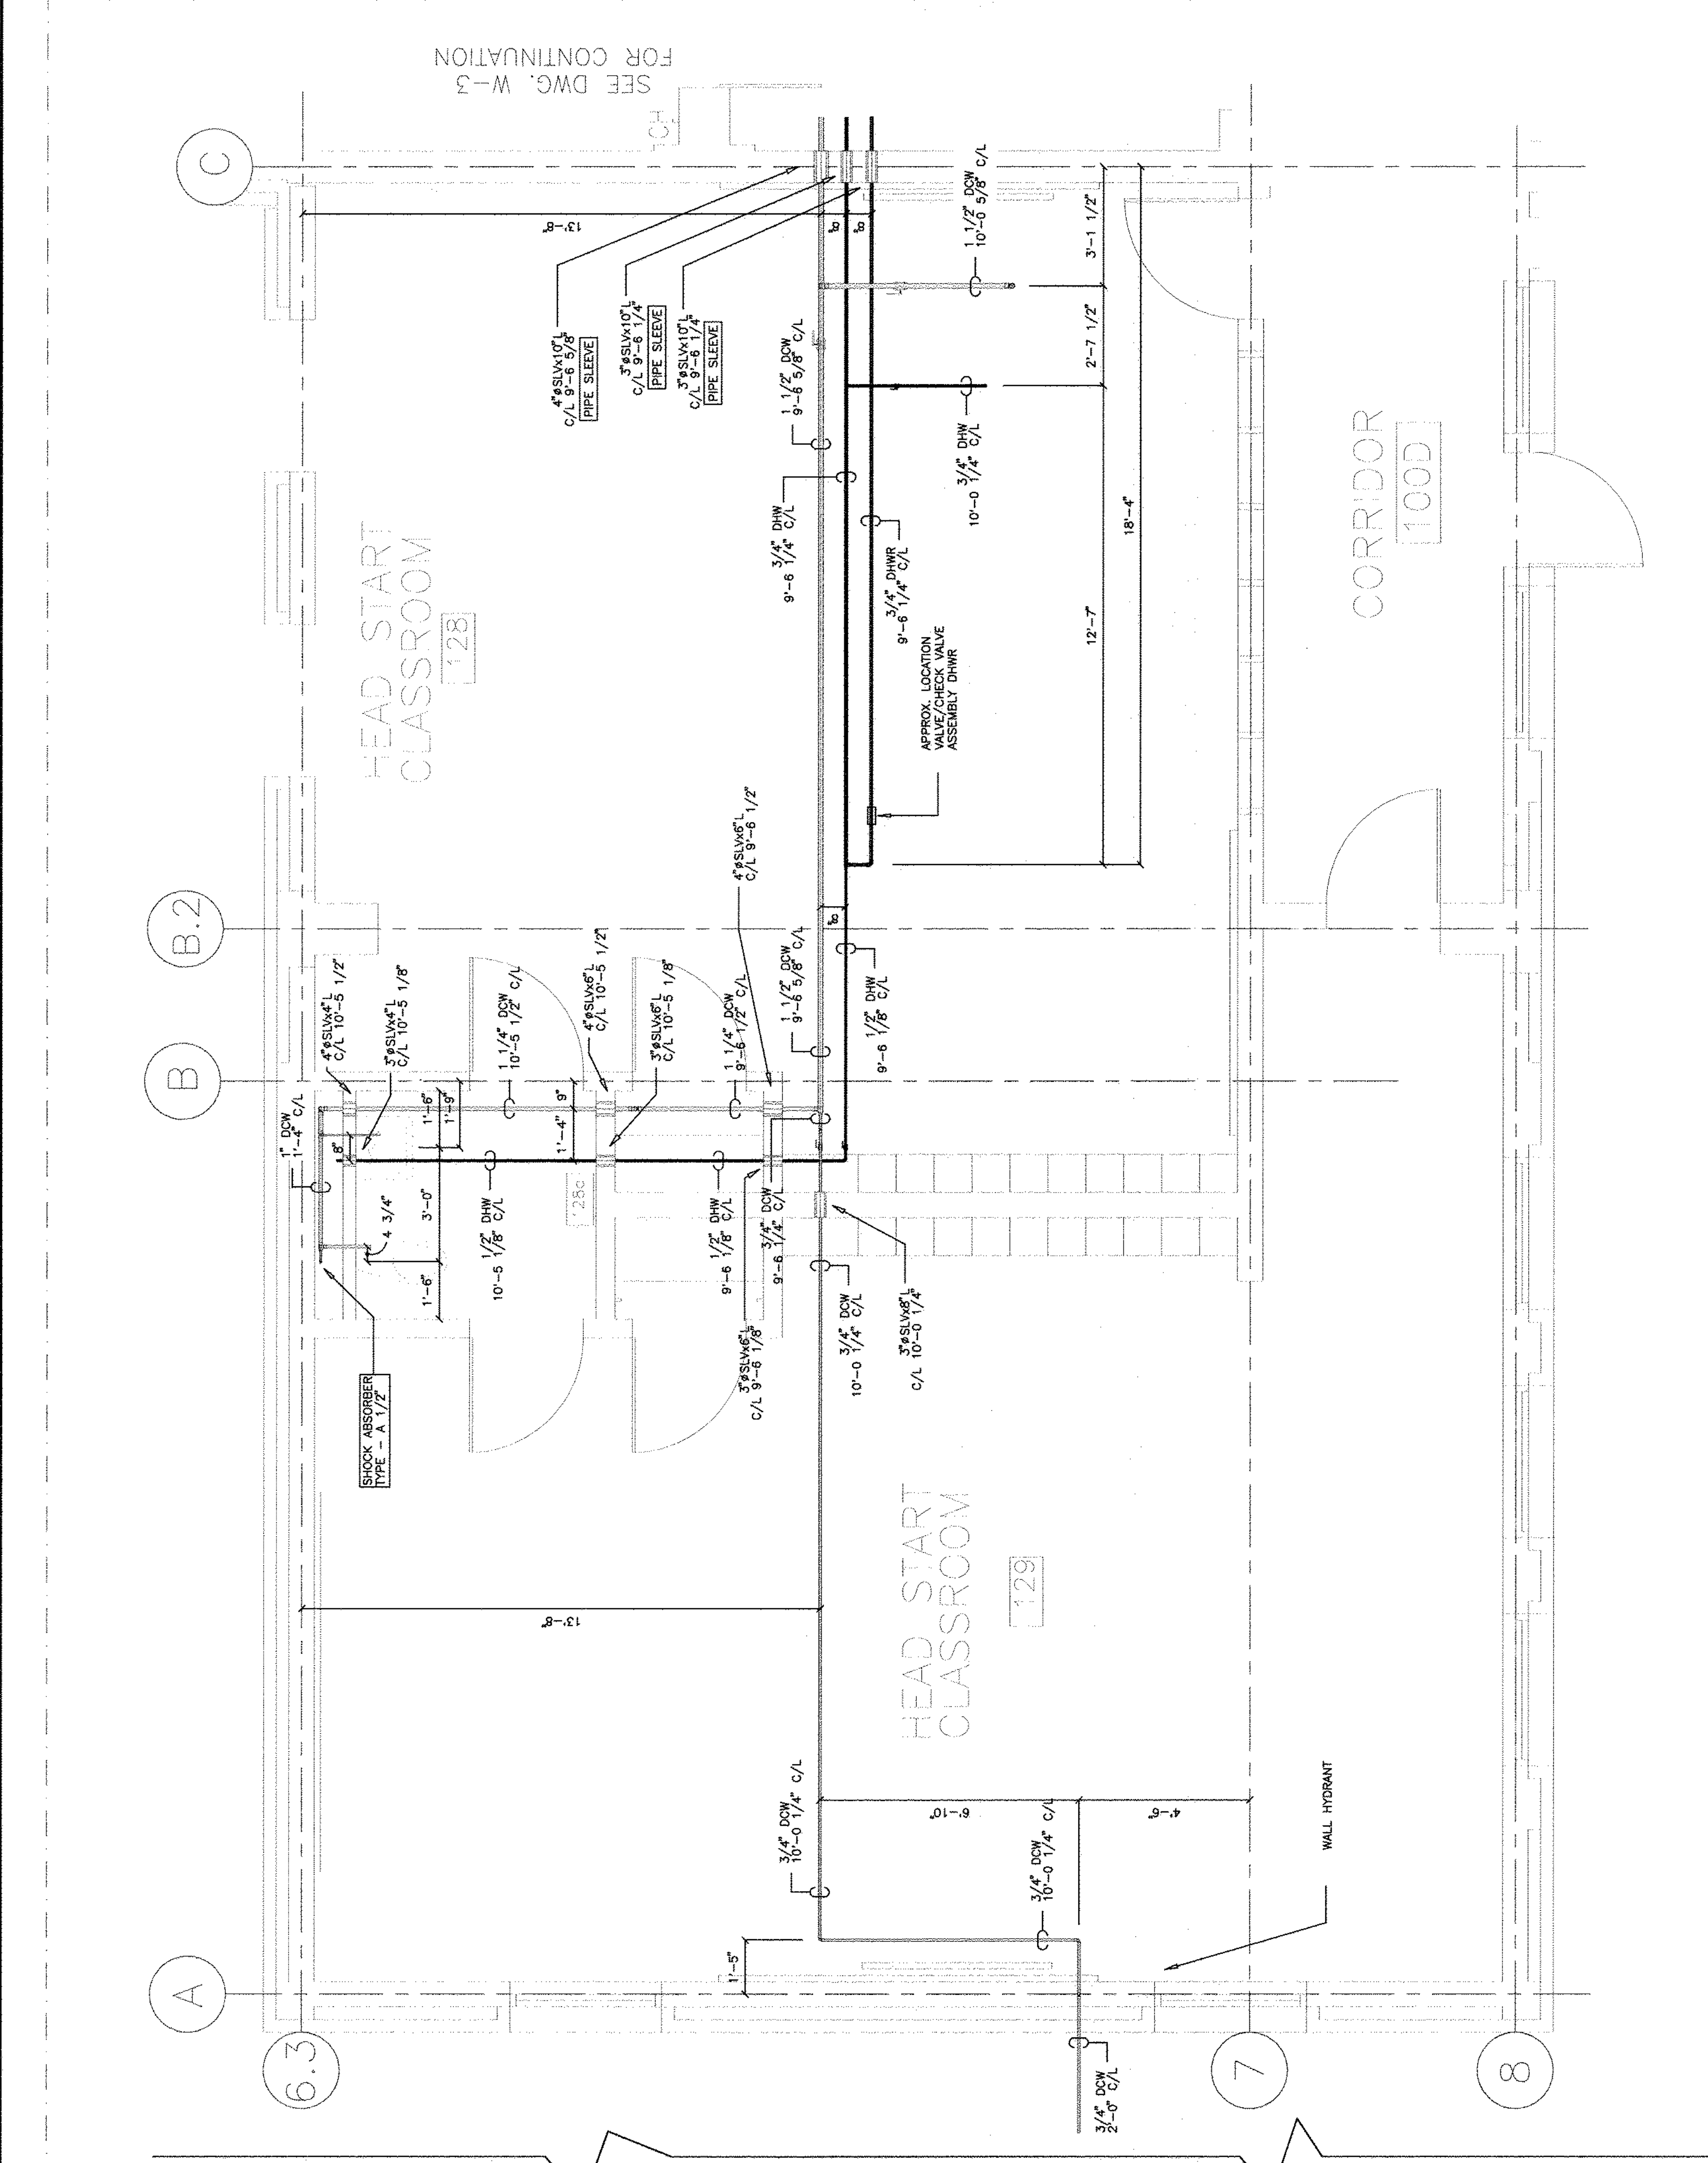


SEE DWG. W-3 FOR CONTINUATION

MATCHLINE


NOTE: C/L OF PIPE TO FINISH FLOOR
DECREASES AT THE TOP OF RAMP 1'-4"

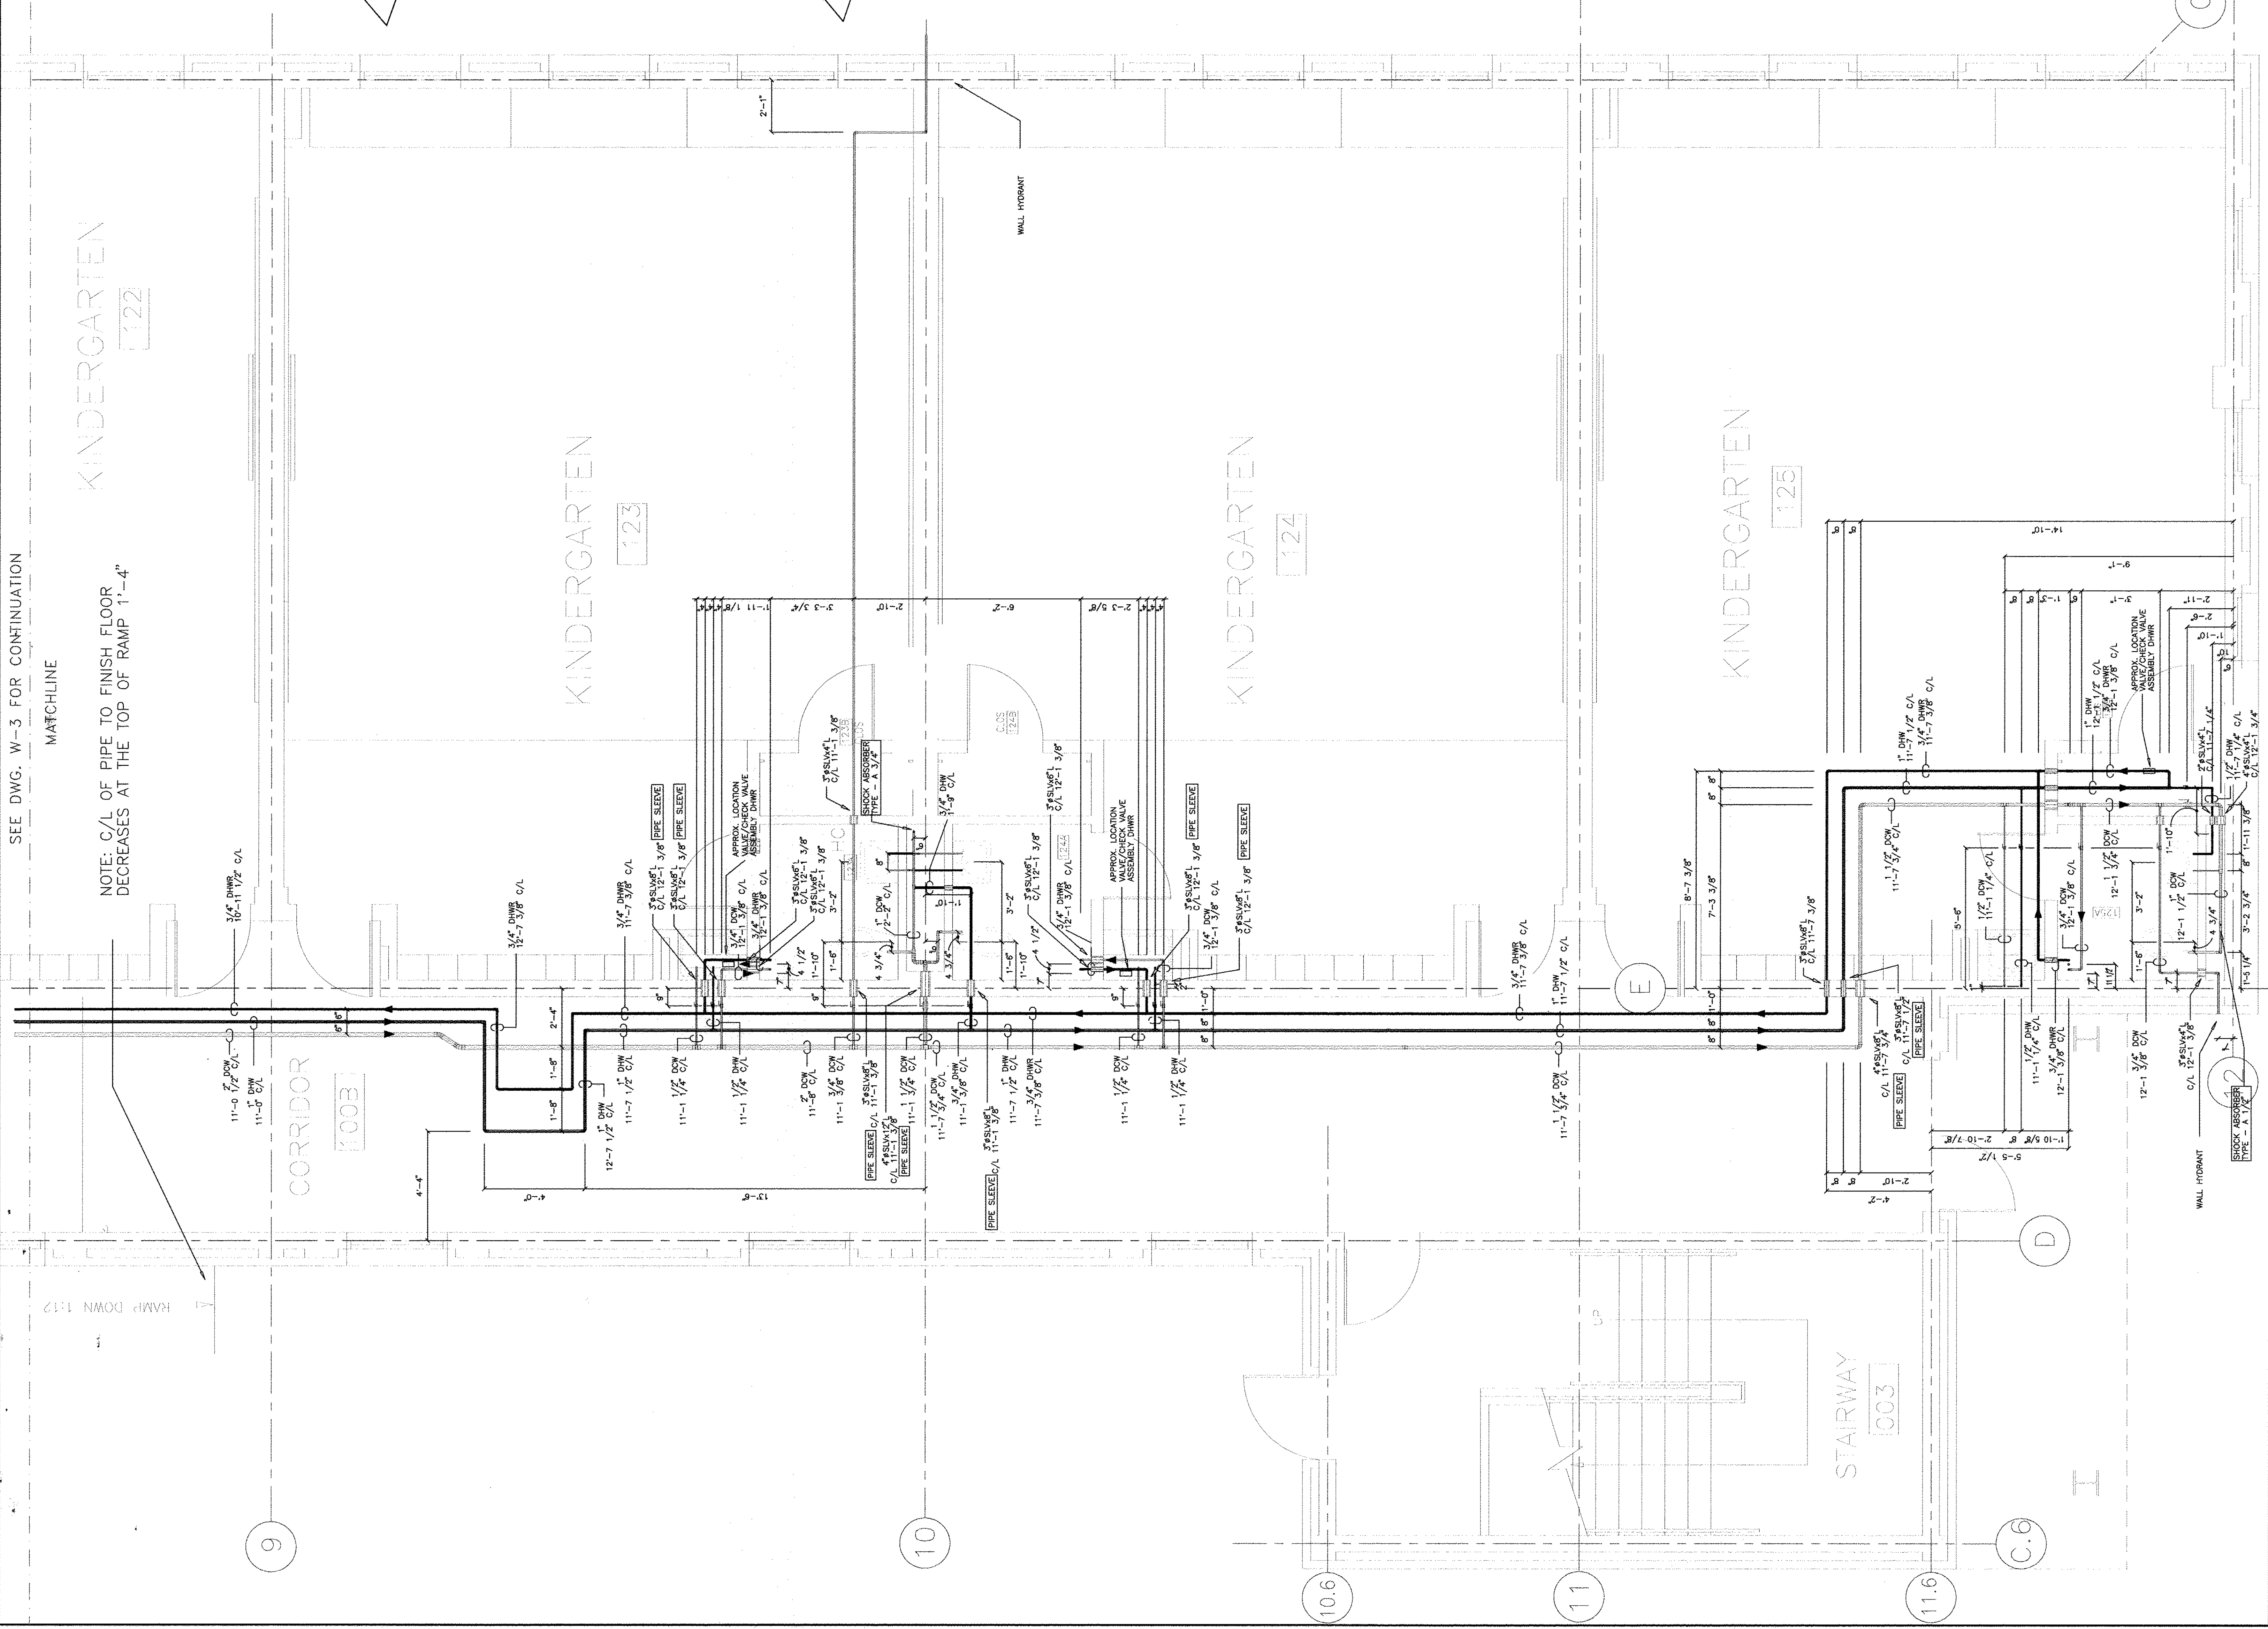

AS-BUILT

9/19/97

REVIEWED
DATE: 9/24/96
BY: JMD

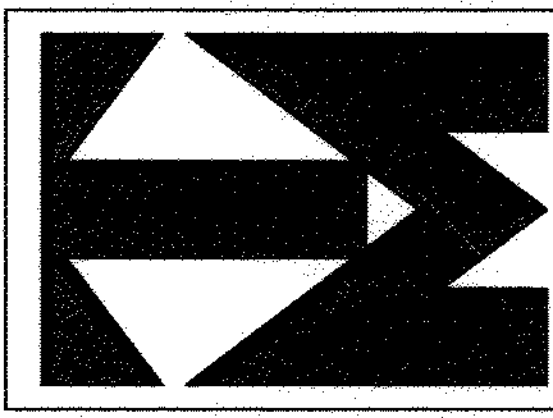

TRACEY MECHANICAL, INC.
401 CITY LINE AVE.
SUITE 212
BALA CYNWYD, PA. 19004
6TH AND DUNCANNON

PARTIAL 1ST FLOOR
WATER & GAS SERVICES
DRAWING NO. W-5

NO.	DATE	BY	D.G.	SCALE	1'-0"
1	9/16/96			3/8" = 1'-0"	
	FIELD ISSUE				
	REVISION				