



SEE DWG. W-8 FOR CONTINUATION
MATCHLINE

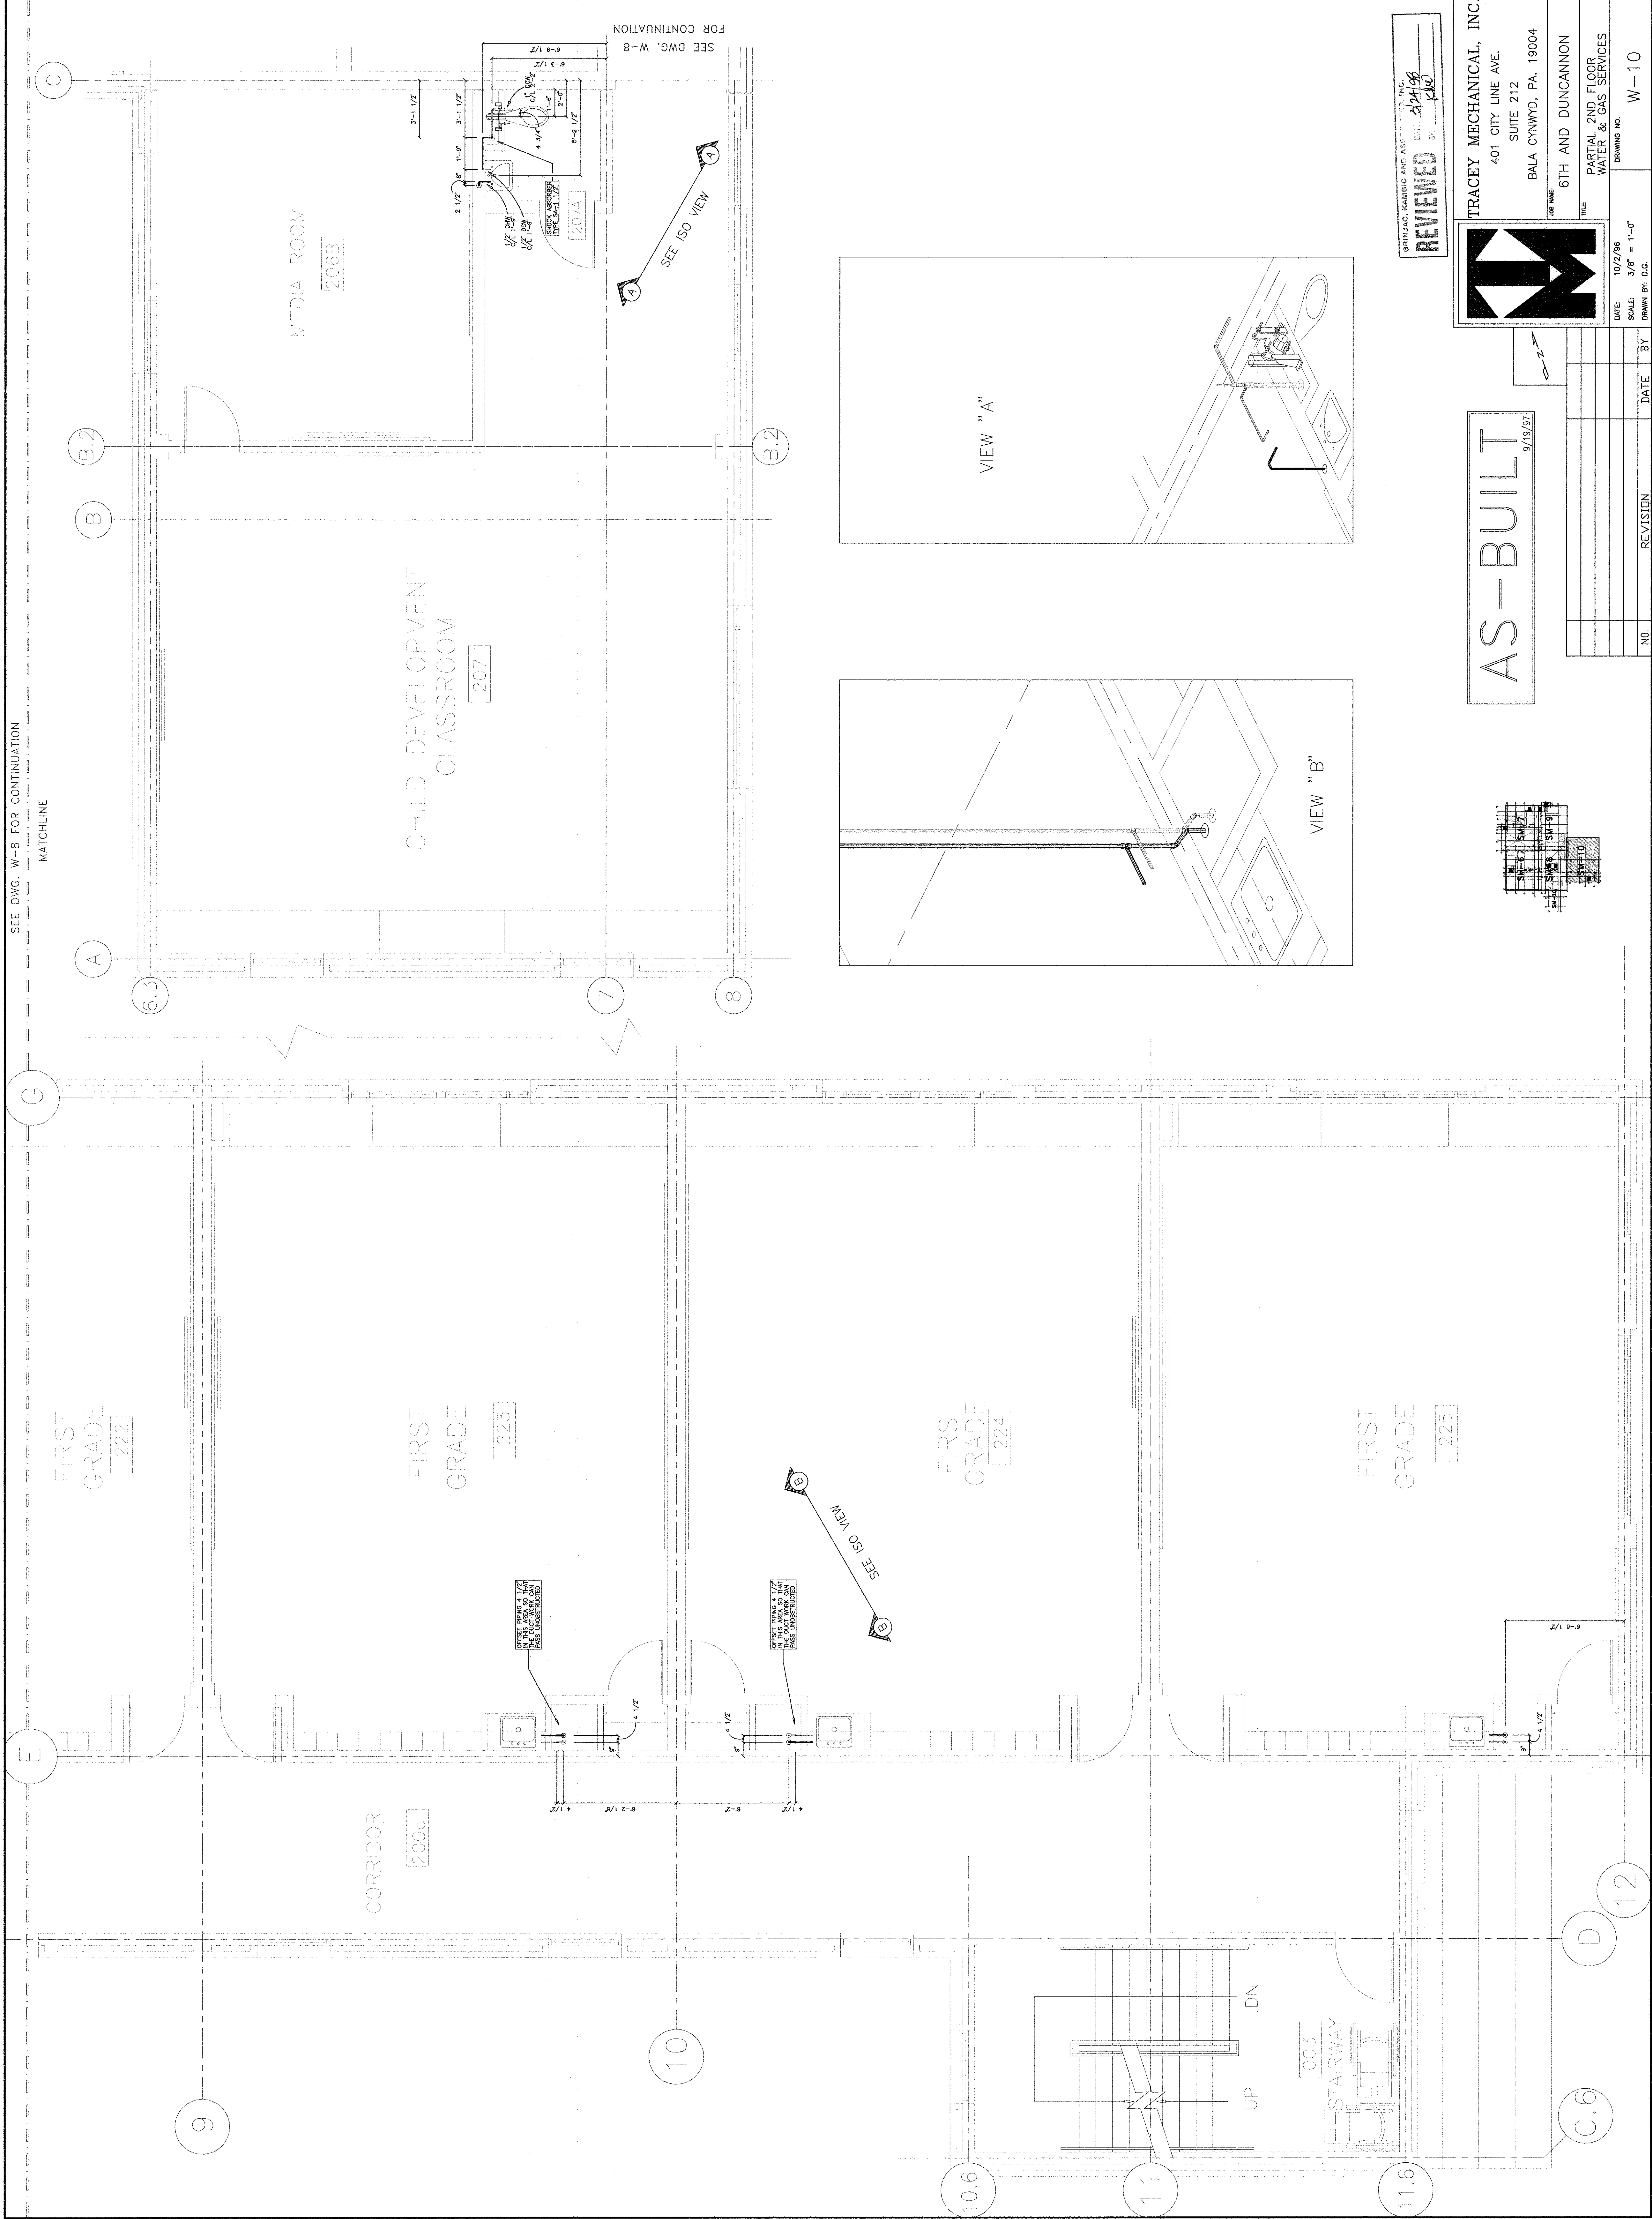

BRINJAC, KAMBIC AND ASSOCIATES, INC.
DATE: 2/24/98
BY: KMD
REVIEWED

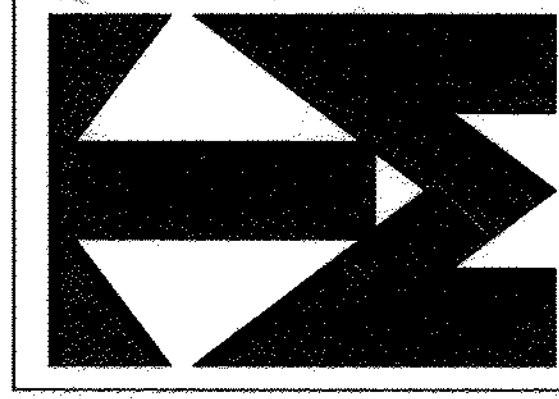

AS-BUILT
9/19/97

TRACEY MECHANICAL, INC.
401 CITY LINE AVE.
SUITE 212
BALA CYNWYD, PA. 19004
COP NAME: 6TH AND DUNCANNON
TITLE: PARTIAL 2ND FLOOR
WATER & GAS SERVICES
DRAWING NO.: W-10

NO.	REVISION	DATE	BY

