


AS-BUILT
9/19/97

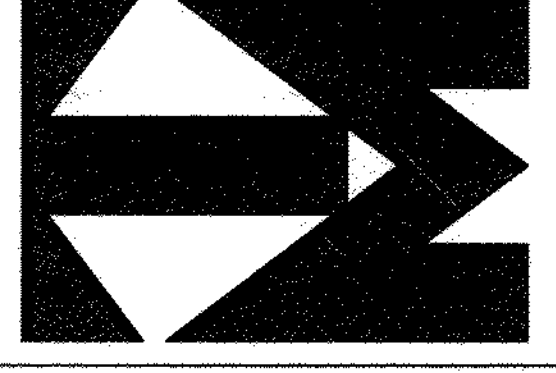

REVIEWED
DATE: 9/24/96
BY: [Signature]
TRACEY MECHANICAL, INC.
401 CITY LINE AVE.
BALA CYNWYD, PA. 19004
6TH AND DUNCANNON
PARTIAL 3RD FLOOR
WATER & GAS SERVICES
DRAWING NO. W-11

NO.	REVISION	DATE	BY	DRAWN	D.G.