


AS-BUILT

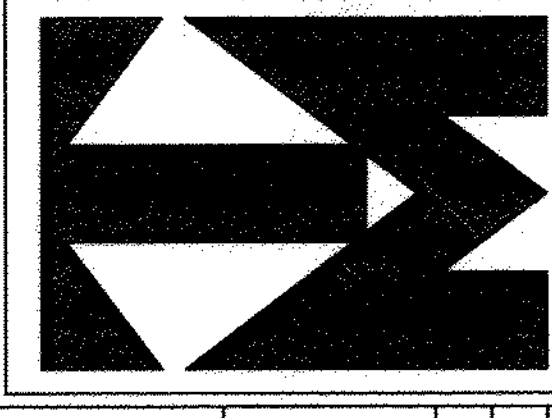

REVIEWED
DATE: 11/4/98
BY: KNO

TRACEY MECHANICAL, INC.
401 CITY LINE AVE.
SUITE 212
BALA CYNWYD, PA. 19004
JOB NAME: 6TH AND DUNCANNON
TITLE: PARTIAL 3RD FLOOR
WATER & GAS SERVICES
DRAWING NO.: W-14

NO.	REVISION	DATE	BY	D.G.
1	PIPING RELOCATED INTO SOFFIT	12-24-96		
2				
3				
4				