


MATCHLINE  
SEE DWG. H-3 FOR CONTINUATION

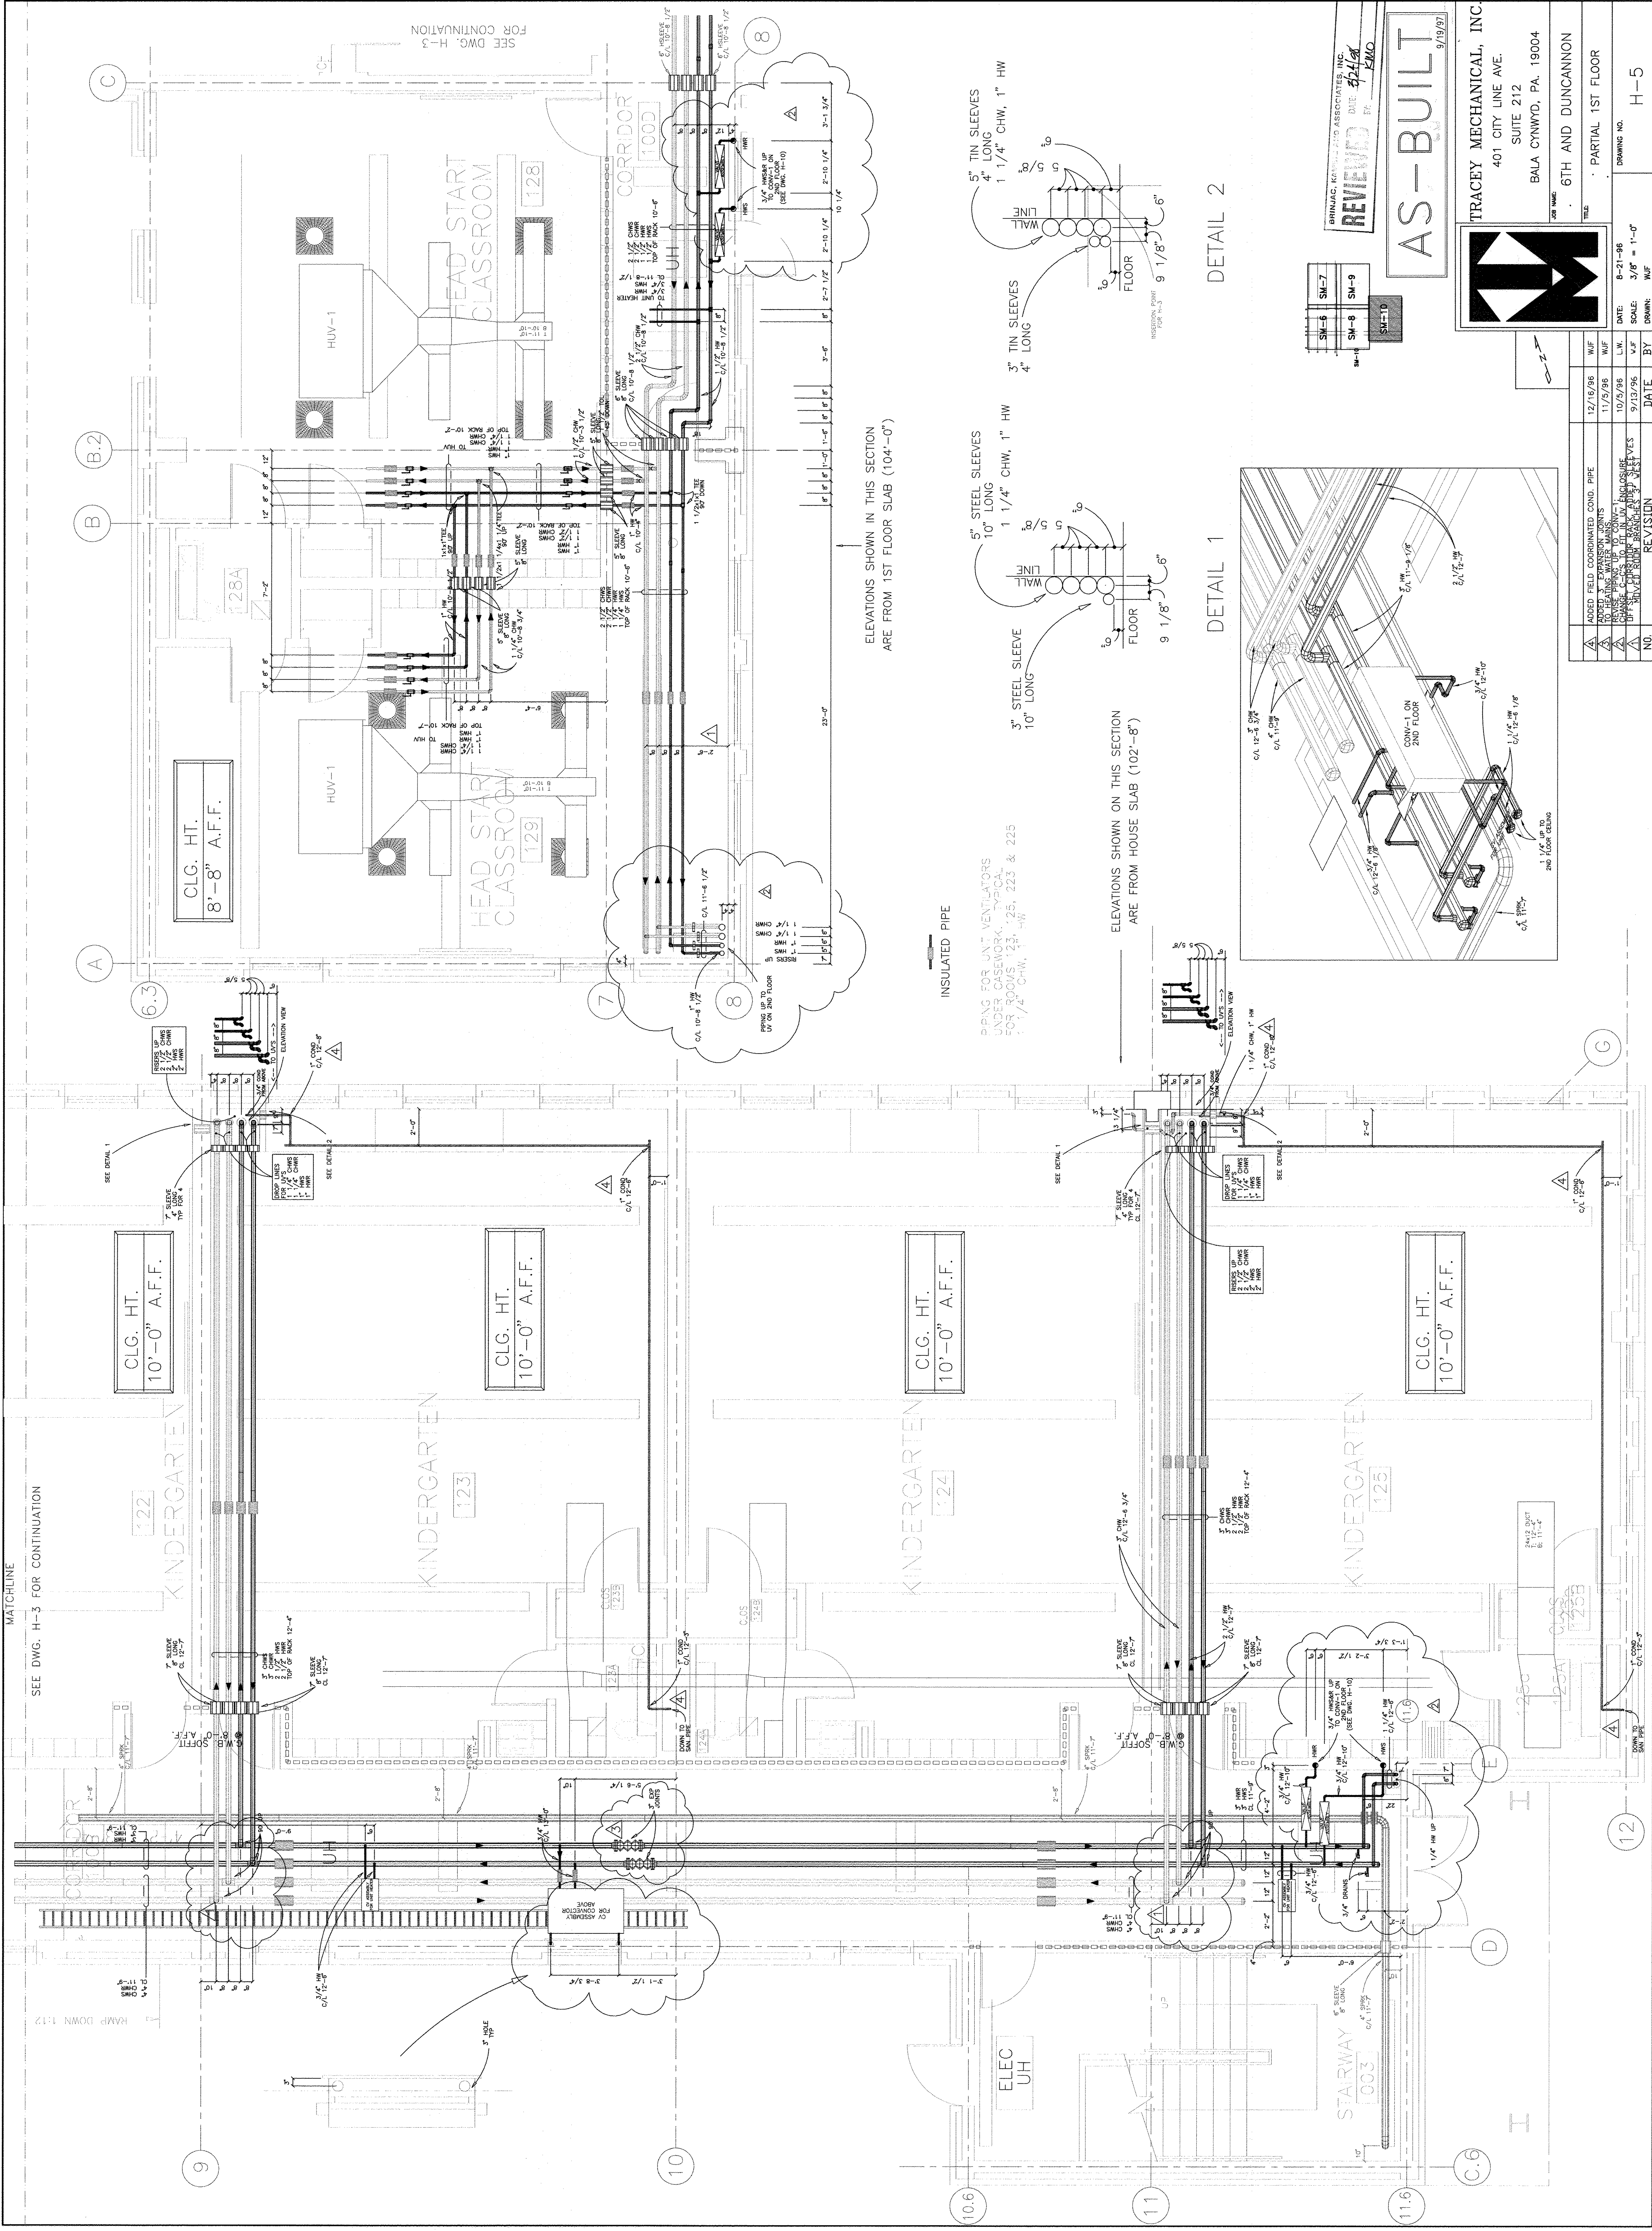



INSULATED PIPE  
PIPING FOR UNIT VENTILATORS  
UNDER CASEWORK, TYPICAL  
FOR ROOMS 123, 125, 223 & 225  
1 1/4" CHW, 1" HW

ELEVATIONS SHOWN IN THIS SECTION  
ARE FROM 1ST FLOOR SLAB (104'-0")

ELEVATIONS SHOWN ON THIS SECTION  
ARE FROM HOUSE SLAB (102'-8")

DETAIL 1


DETAIL 2

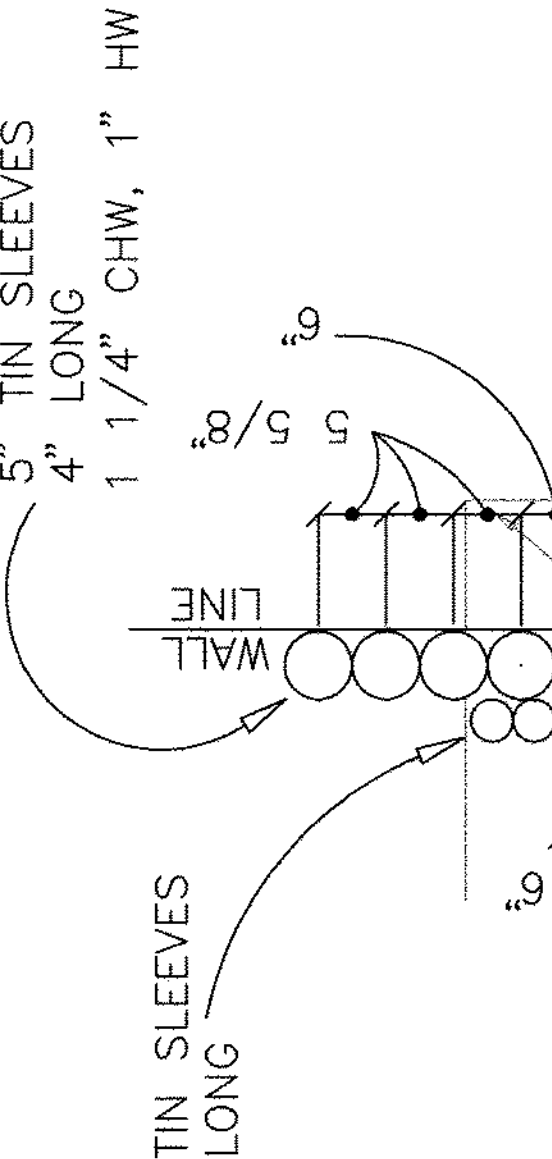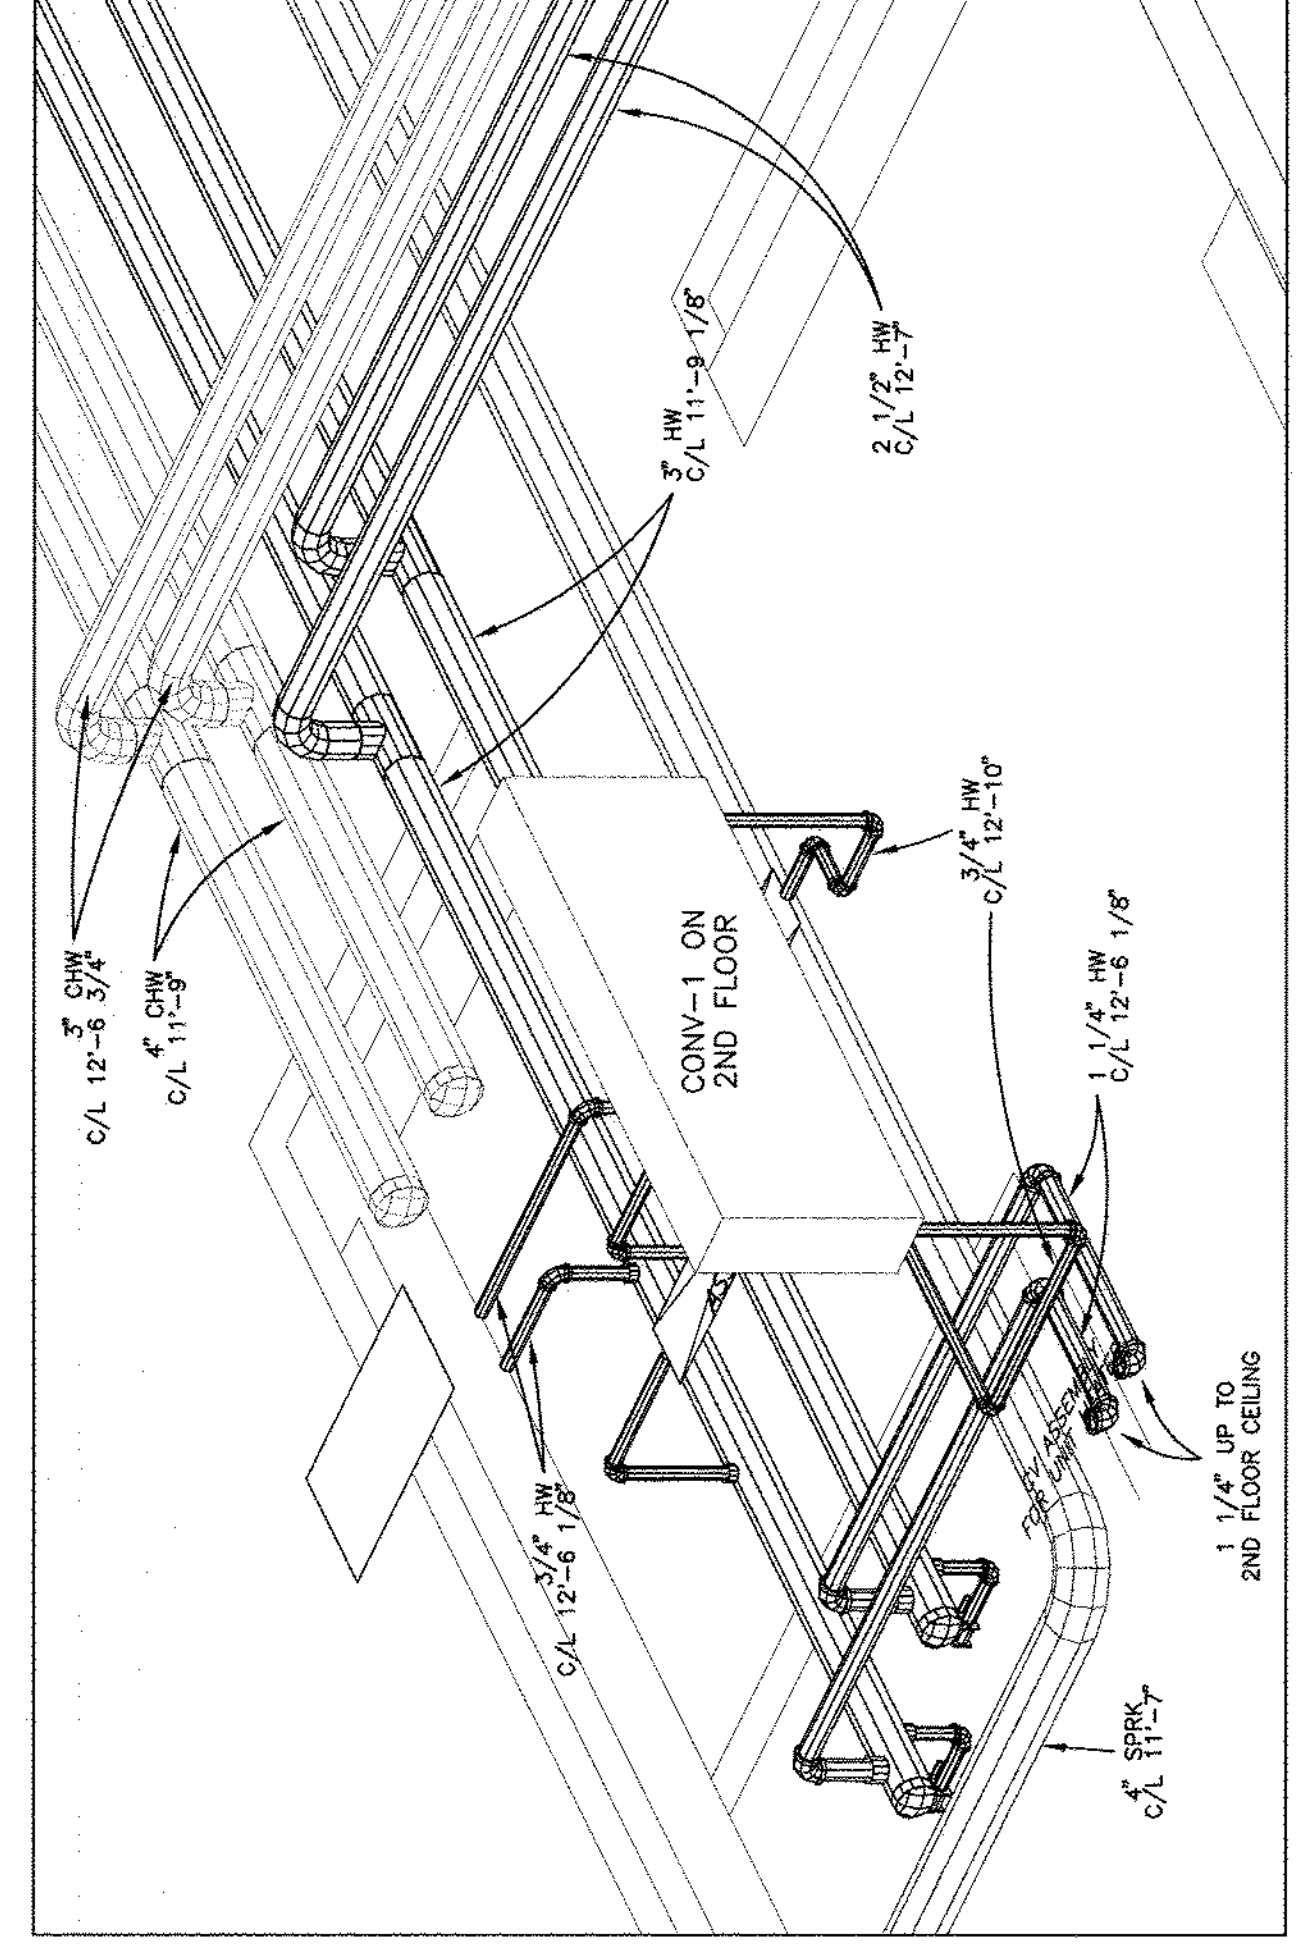

SN-6	SN-7
SN-8	SN-9
SN-10	SN-11

BRINJAC, KENTON & ASSOCIATES, INC.  
REVIEWED BY: KMO  
DATE: 9/19/97

AS-BUILT

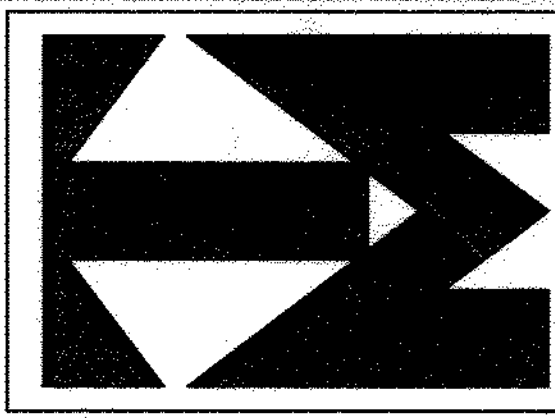

TRACEY MECHANICAL, INC.  
401 CITY LINE AVE.  
SUITE 212  
BALA CYNWYD, PA. 19004  
6TH AND DUNCANNON  
PARTIAL 1ST FLOOR  
DRAWING NO. H-5  
DATE: 8-21-86  
SCALE: 3/8" = 1'-0"  
BY: WUF  
DOWN: WUF

NO.	REVISION	DATE	BY
1	ADDED FIELD COORDINATED COND. PIPE	12/18/96	WUF
2	ADDED 3" EXPANSION JOINTS	11/5/96	WUF
3	ADDED 3" EXPANSION JOINTS	10/5/96	L.W.
4	ADDED 3" EXPANSION JOINTS	9/13/96	WUF