

SEE DWG. H-6 FOR CONTINUATION

MATCHLINE

SEE DWG. H-9 FOR CONTINUATION

CORRIDOR MATCHLINE

200a

STOR. 227


H.C.

H.C.

M. LKR. 228

AS-BUILT

9/19/97

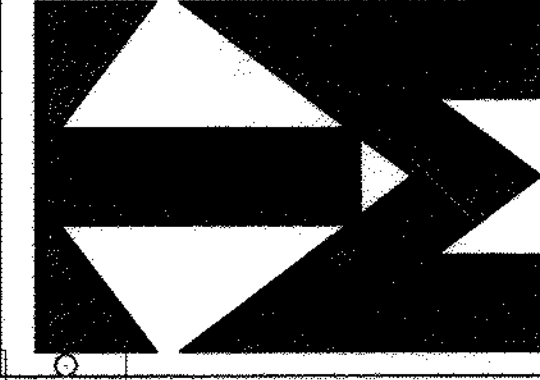

TRACEY MECHANICAL, INC.  
401 CITY LINE AVE.  
SUITE 212  
BALA CYNWYD, PA. 19004

6TH AND DUNCANNON  
PARTIAL 2ND FLOOR

DATE: 10/14/96  
SCALE: 3/8" = 1'-0"  
DRAWN: WUF  
BY: H-7

REVISION

REVISED  
DATE: 9/24/98  
BY: KMD

