

SEE DWG. H-7 FOR CONTINUATION

MATCHLINE

DN

PLATFORM 203

ELEV 114.17

AS-BUILT 9/19/97



AUDITORIUM 202

SLOPE DOWN

13 ROWS

SEE DWG. H-8 FOR CONTINUATION

MATCHLINE

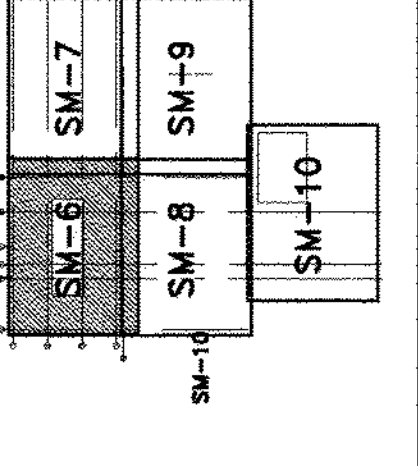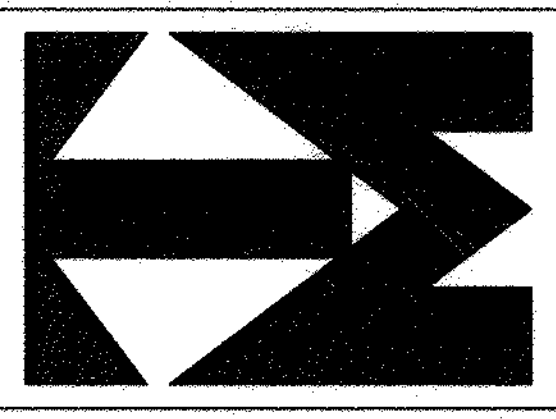

- HVAC PIPING NOTES
1. ALL DRAINS ARE 3/4" UNLESS NOTED OTHERWISE
  2. ALL VENTS ARE 1/2" UNLESS NOTED OTHERWISE
  3. PIPE ELEVATIONS ARE TAKEN FROM 2ND FLOOR FIN. FL.

SLEEVE COUNT			
NO.	QTY.	SIZE	LENGTH
1	1	4"	0'-0"
2	1	4"	0'-0"
3	1	4"	0'-0"
4	1	4"	0'-0"

REVISION			
NO.	DATE	BY	REVISION
2	12/7/96	WF	ADDED COND. DRAIN
1	10/28/96	LW	ADD SLEEVES

TRACEY MECHANICAL, INC.  
401 CITY LINE AVE.  
SUITE 212  
BALA CYNWYD, PA. 19004

6TH AND DUNCANNON  
PARTIAL 2ND FLOOR  
HVAC PIPING

DATE: 10/7/96  
SCALE: 3/8" = 1'-0"  
DRAWN: LW  
H-6