


SM-15

SM-16

SM-17

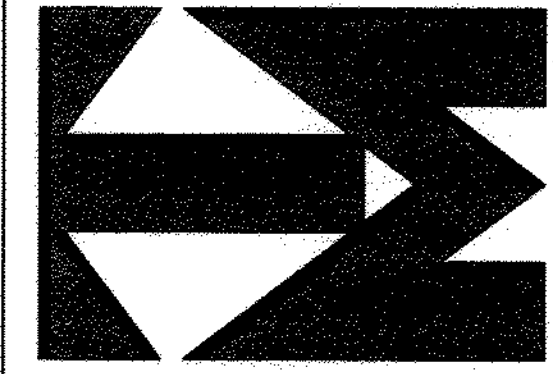

TRACEY MECHANICAL, INC.
401 CITY LINE AVE.
SUITE 212
BALA CYNWYD, PA. 19004

JOB NAME
6TH AND DUNCANNON

TITLE
PARTIAL 4TH FLOOR

DATE: 11/11/96
SCALE: 3/8"=1'-0"

DRAWING NO.
H-16

DATE: 11/11/96
SCALE: 3/8"=1'-0"

DRAWING NO.
H-16

DATE: 11/11/96
SCALE: 3/8"=1'-0"

DRAWING NO.
H-16

REVIEWED
DATE: 3/24/98
BY: KMD

AS-BUILT
9/19/97

H:\CAD\DWG\H-16 P13.dwg 19 14 06 37 1997