





TRACEY MECHANICAL, INC.
401 CITY LINE AVE.
SUITE 212
BALA CYNWYD, PA. 19004

6TH AND DUNCANNON

PARTIAL 1ST FLOOR MECHANICAL PIPING

DRAWING NO. H-4

DATE: 9/7/96
SCALE: 3/8"=1'-0"
DRAWN: BILL FINN

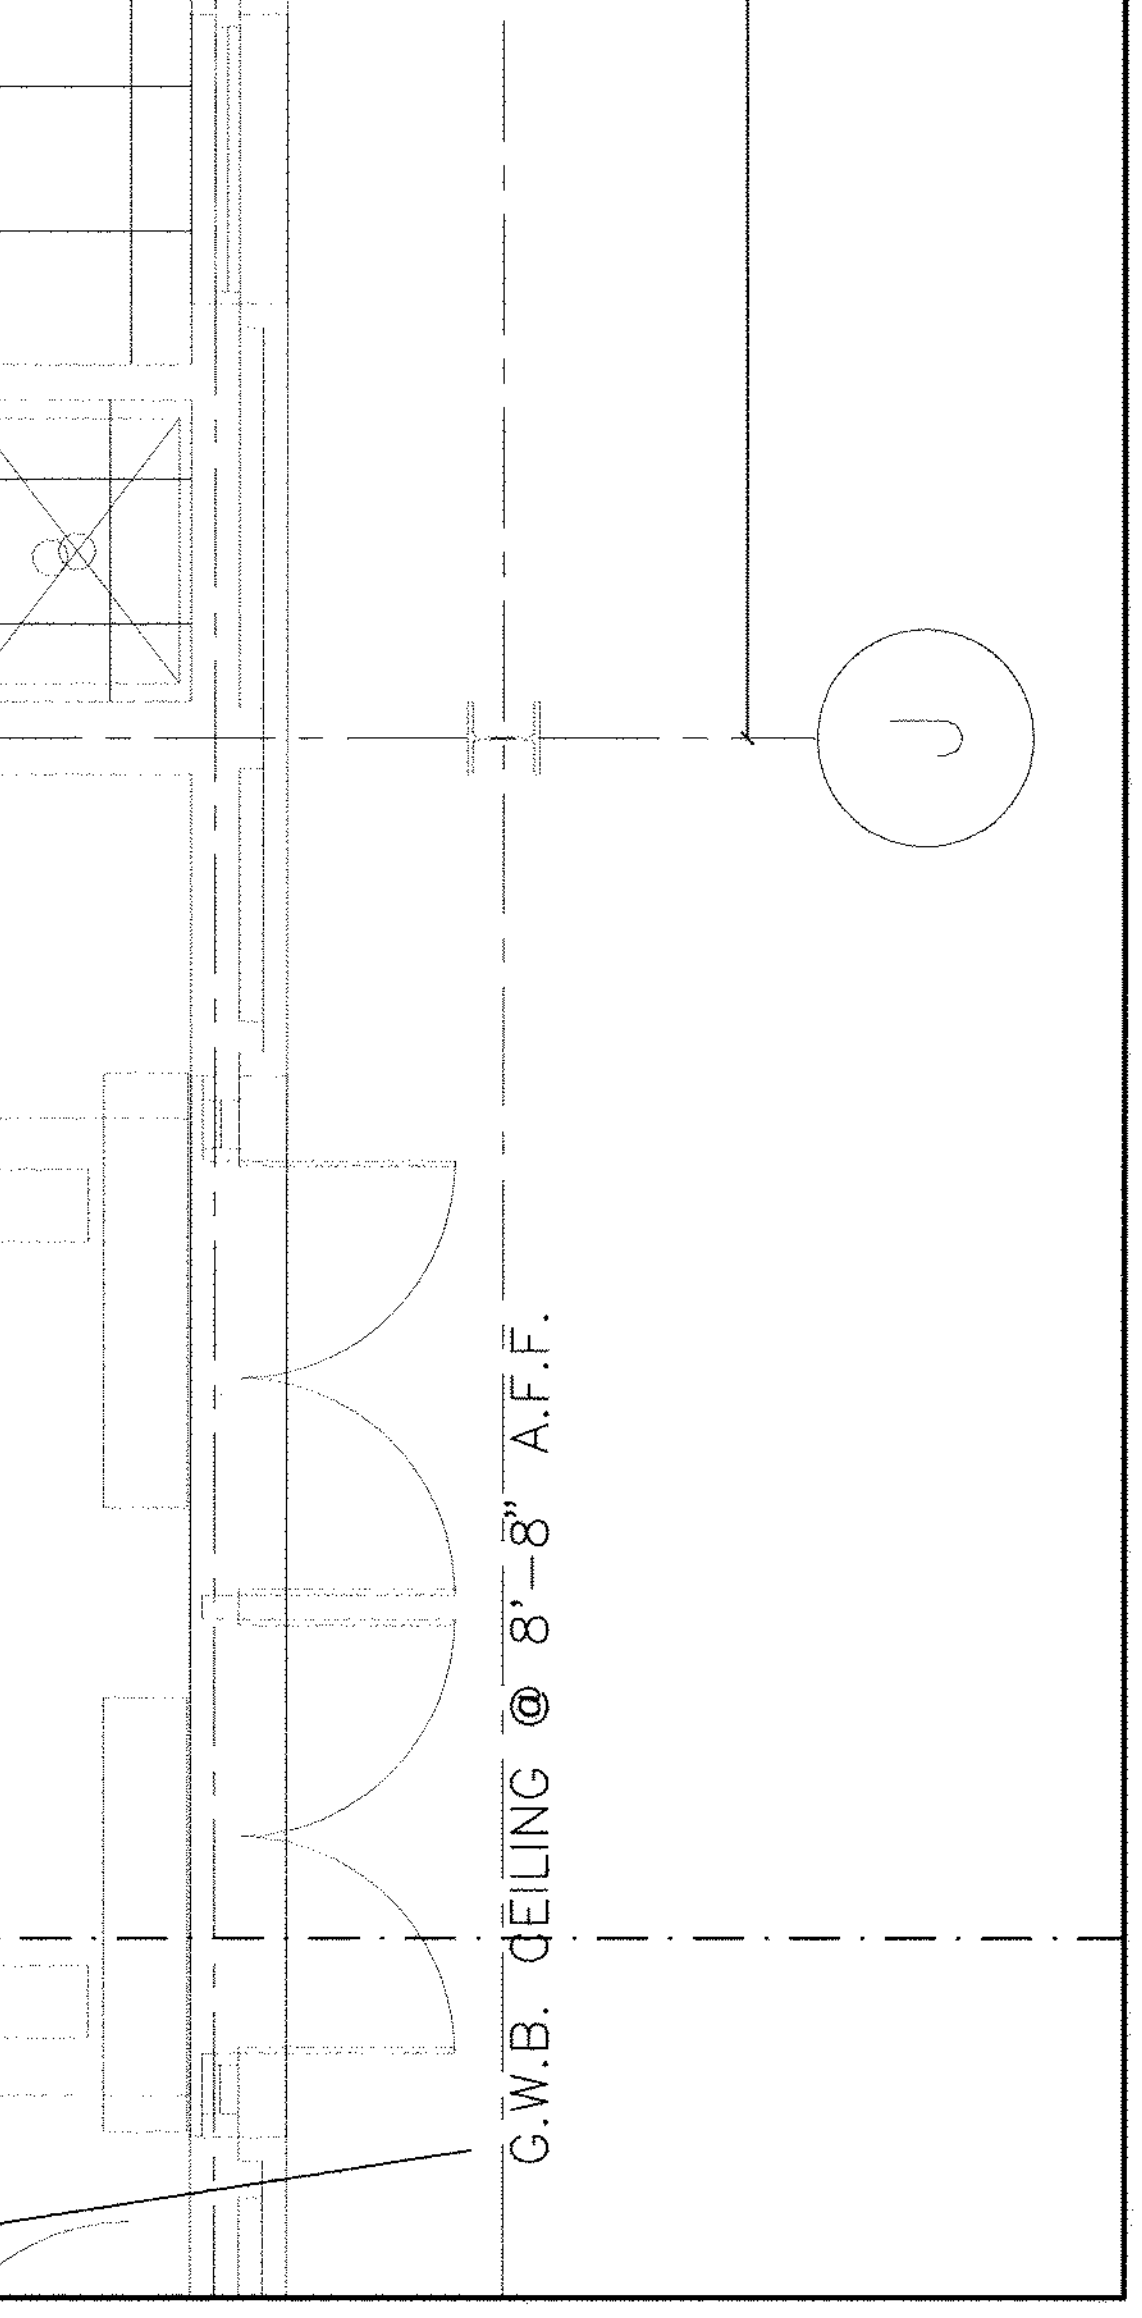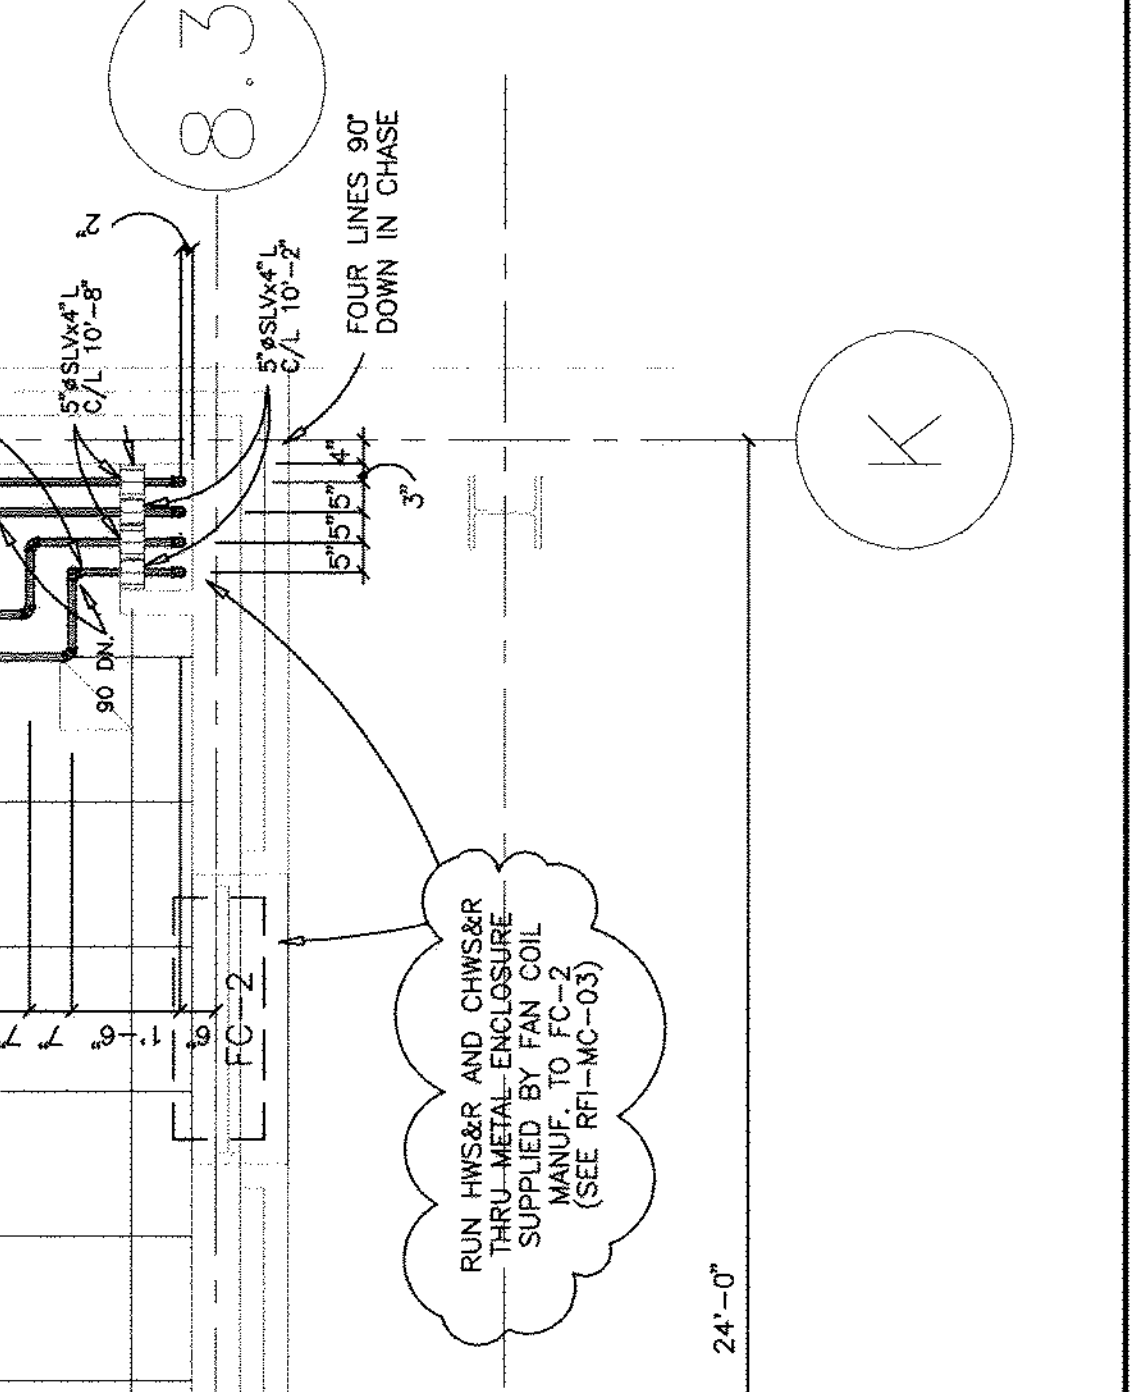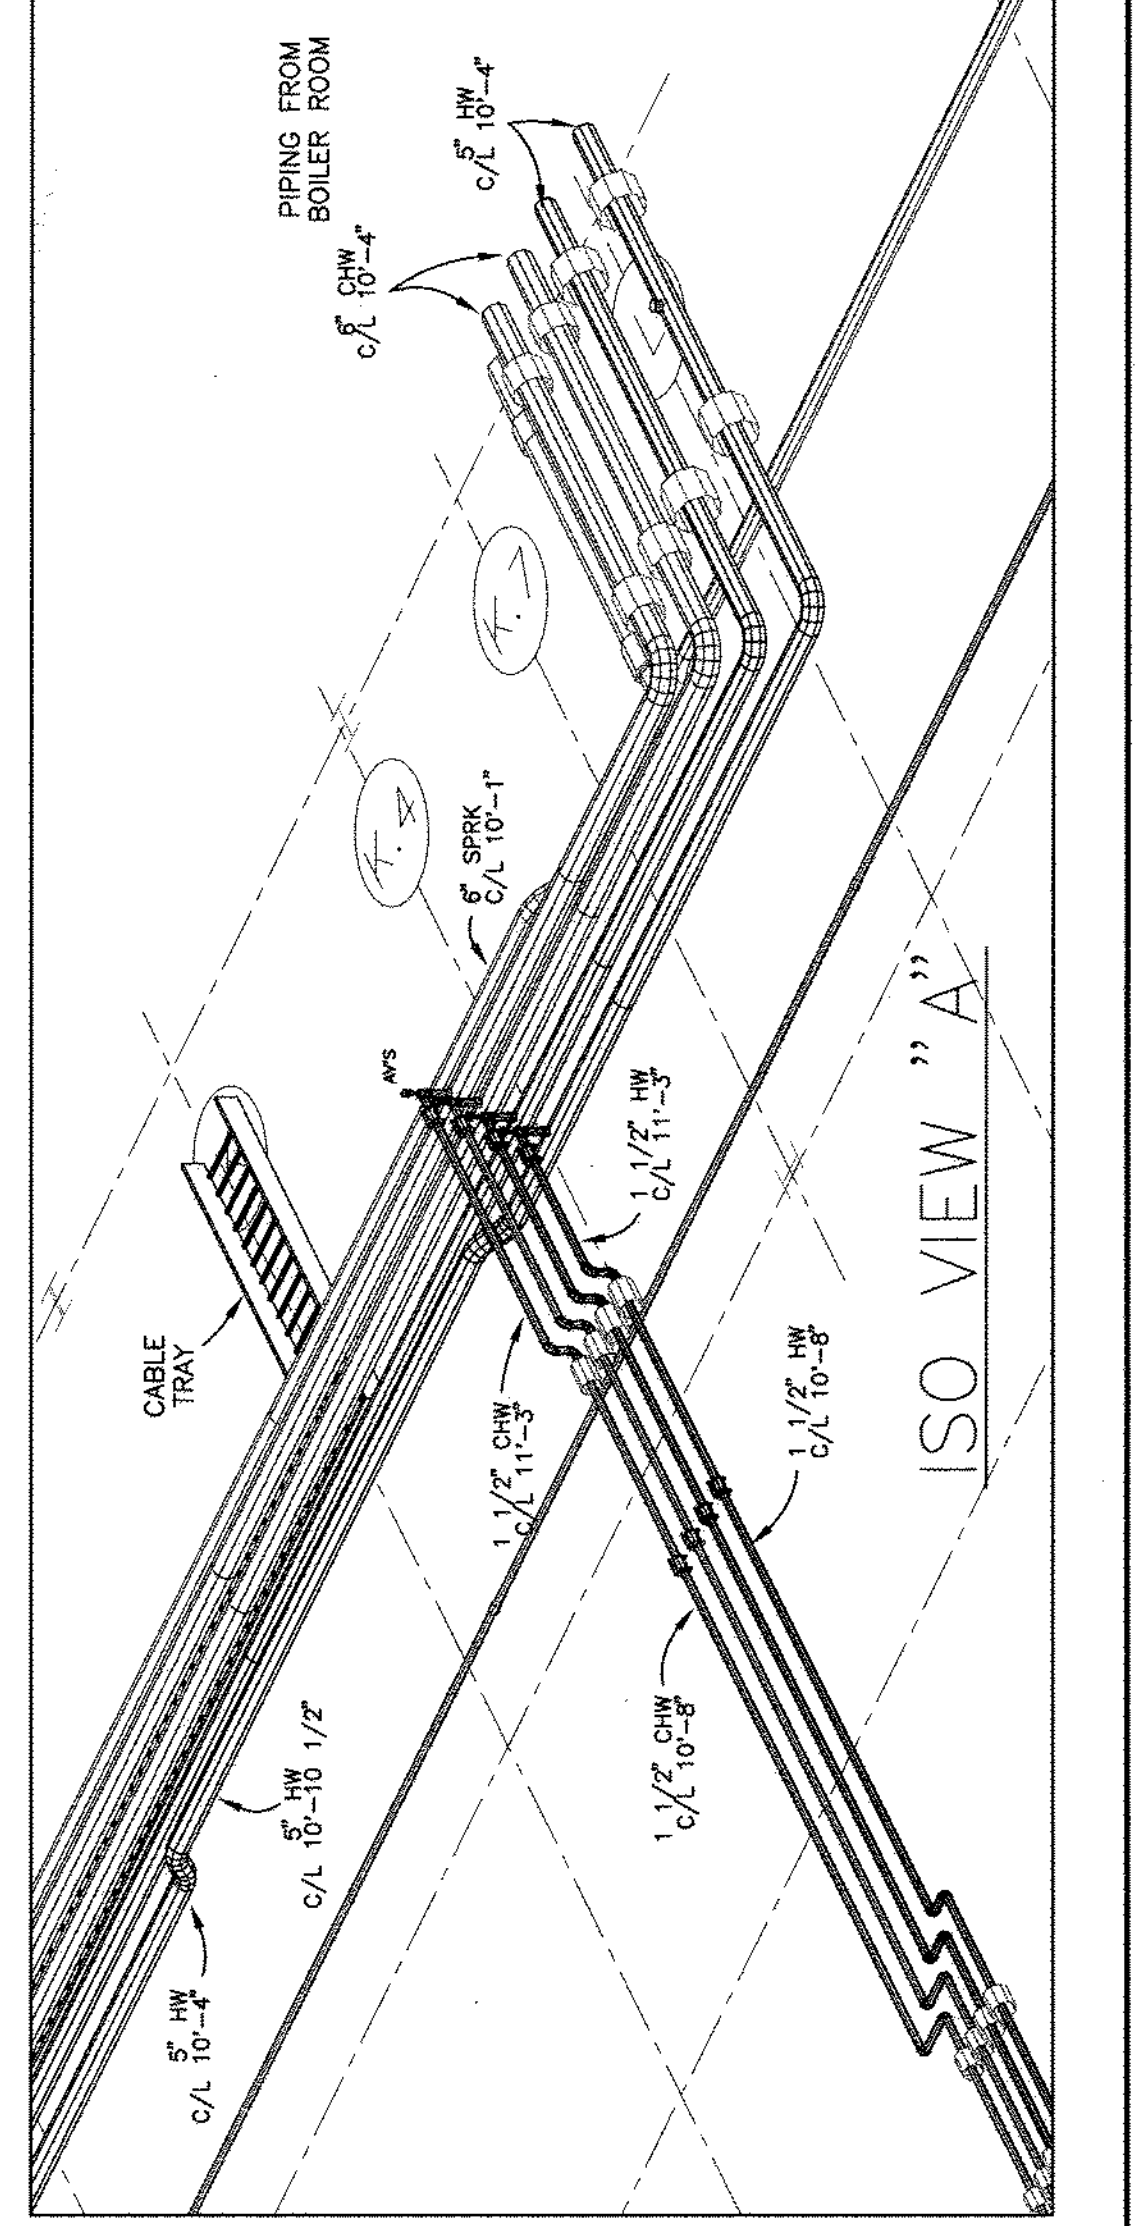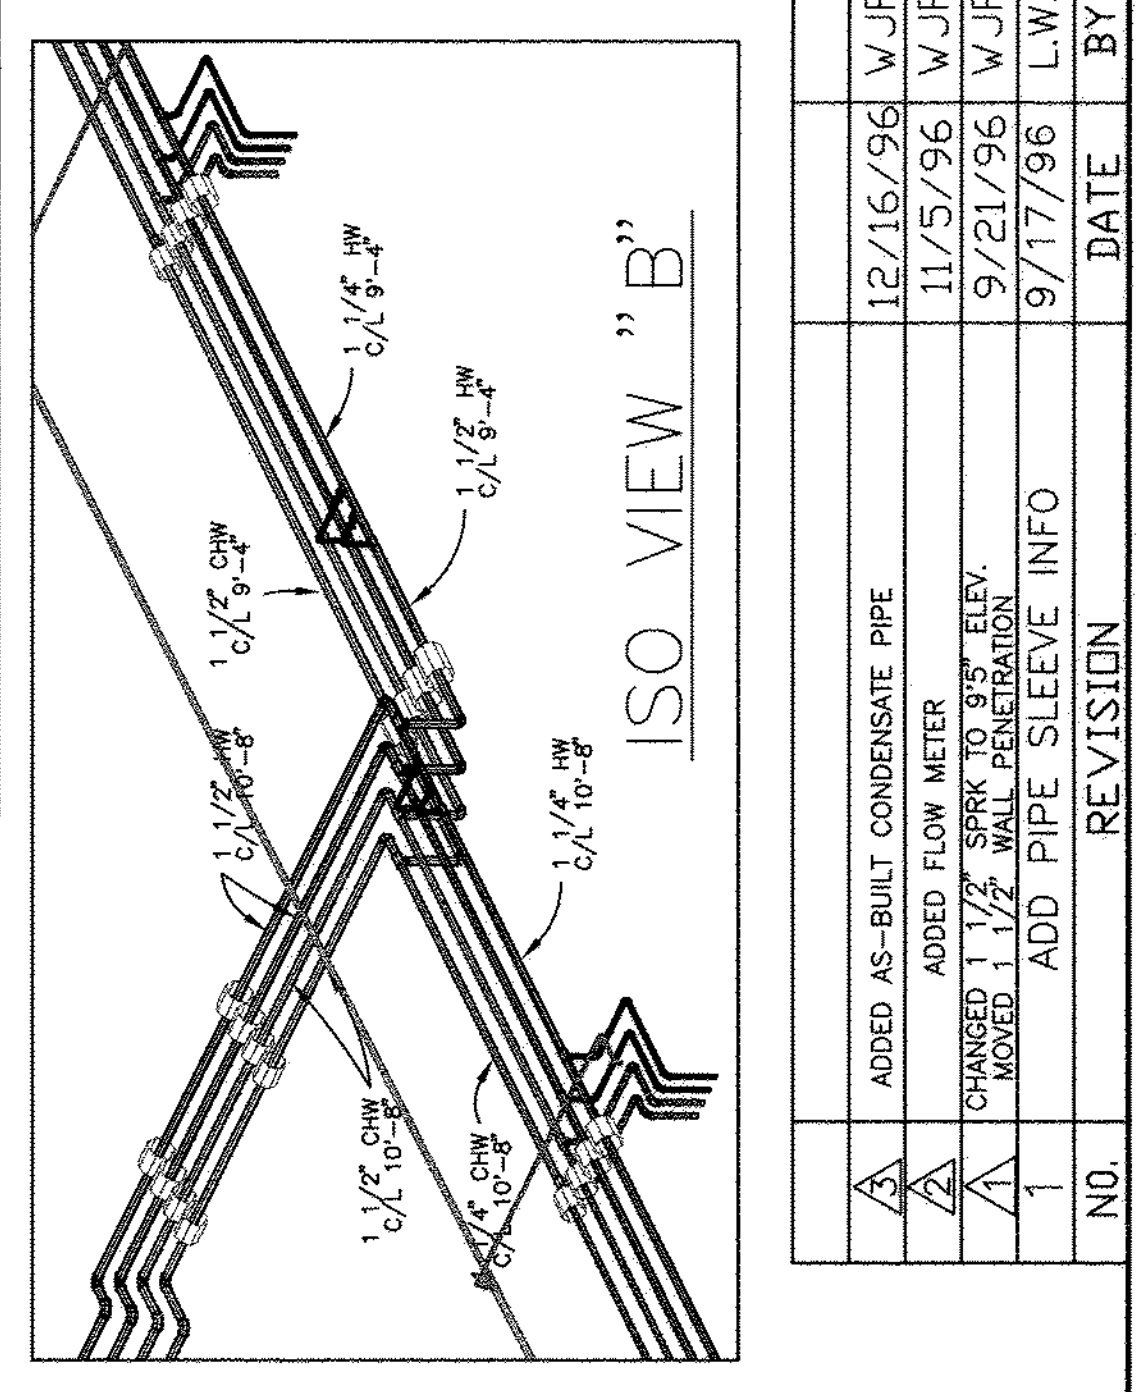

NO.	REVISION	DATE	BY
1	ADDED AS-BUILT CONDENSATE PIPE	12/16/96	VJF
2	ADDED FLOW METER	11/5/96	VJF
3	CHANGED 1 1/2"		
4	ADDED PIPE SLEEVE INFO	9/17/96	LW