


REVIEWED
BRINAC, KARBIG AND ASSOCIATES
DATE: 8/24/96
BY: JNO

NO.	REVISION	DATE	BY
1	ADDED COND. DRAIN.	12/3/96	W.F.
2	FIELD ISSUE FOR SLEEVES	9/10/96	W.F.

TRACEY MECHANICAL, INC.
401 CITY LINE AVE.
SUITE 212
BALA CYNWYD, PA. 19004

6TH AND DUNCANNON
PARTIAL 1ST FLOOR

DATE: 8-22-96
SCALE: 3/8" = 1'-0"
DRAWN: BILL FINN
DRAWING NO. H-1

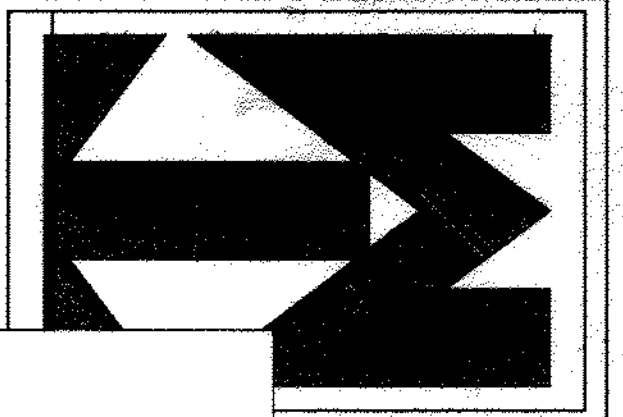

AS-BUILT
9/19/97

SEE DWG. H-3
FOR CONTINUATION

SEE DWG. H-3
FOR CONTINUATION

SEE DWG. H-3
FOR CONTINUATION

SEE DWG. H-3
FOR CONTINUATION