


ISOMETRIC VIEW


COMPUTER LAB

205

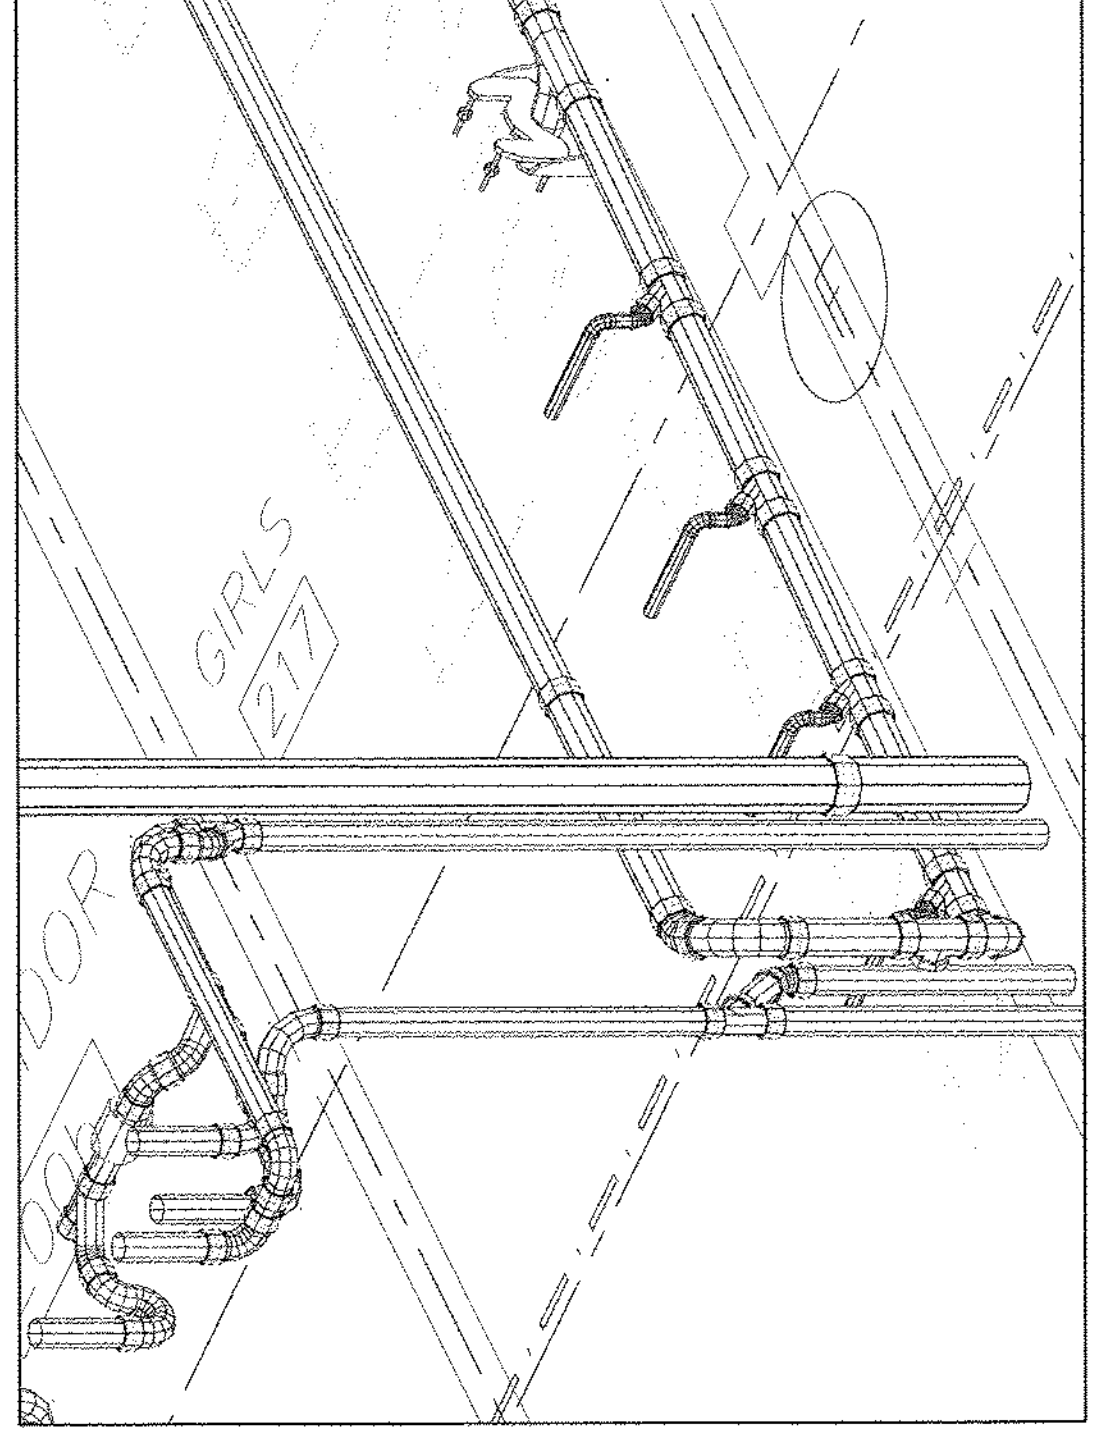

ISOMETRIC VIEW

203

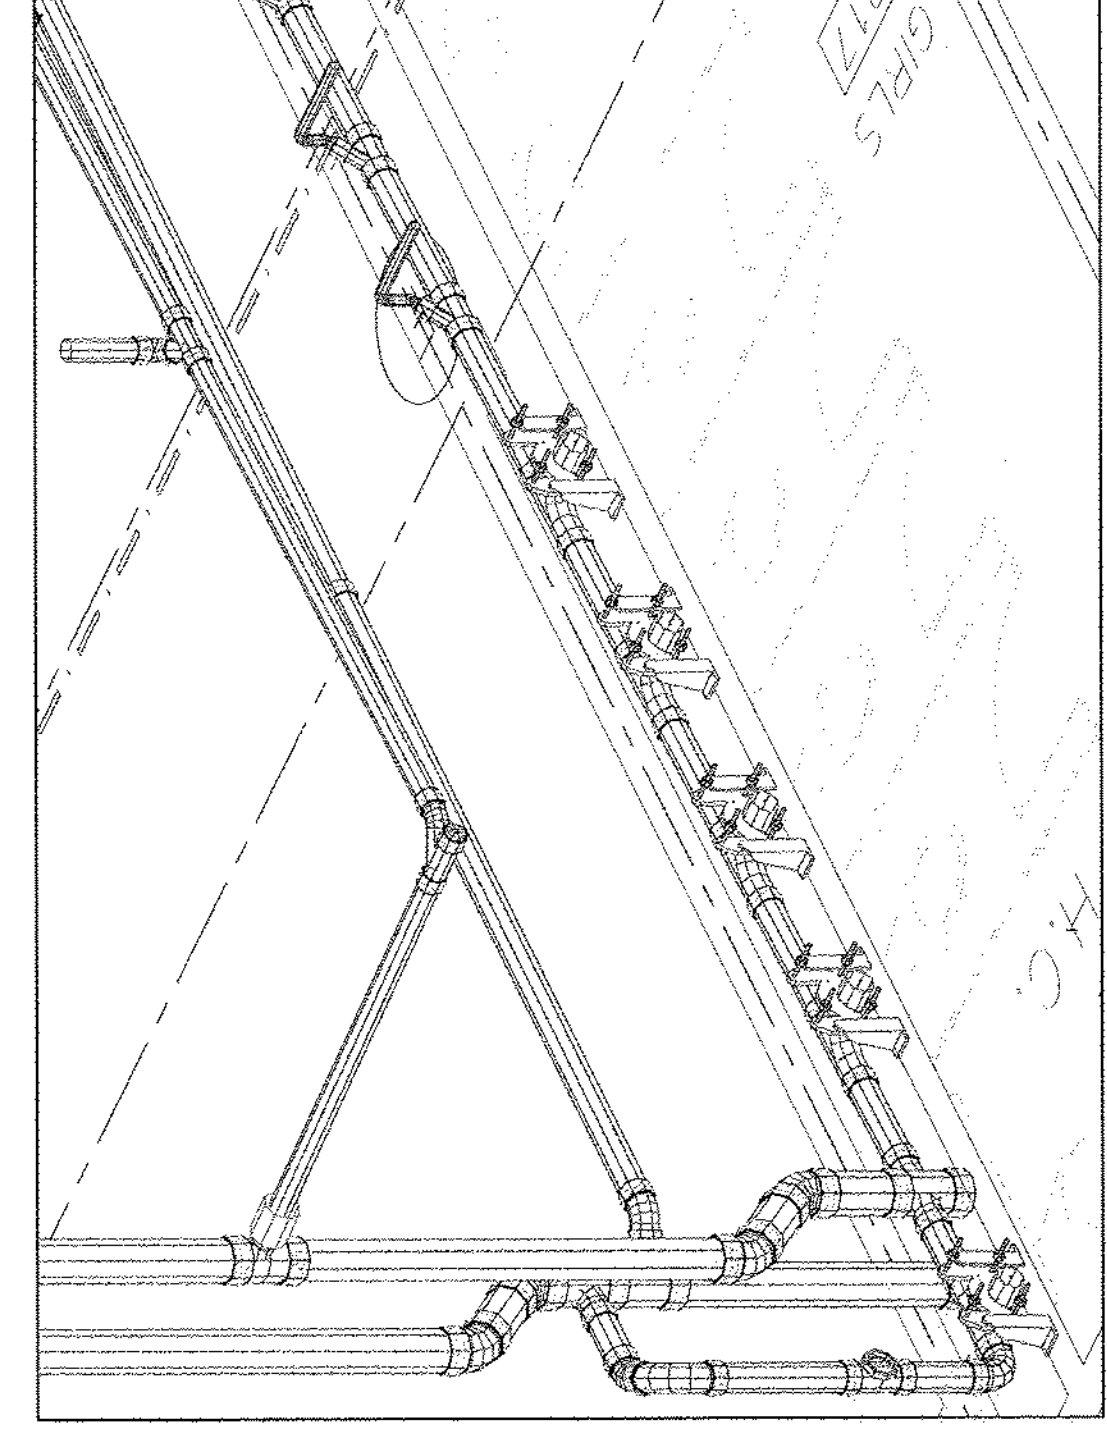


ISOMETRIC VIEW

202

SEE DWG. P-8 FOR CONTINUATION

MATCHLINE

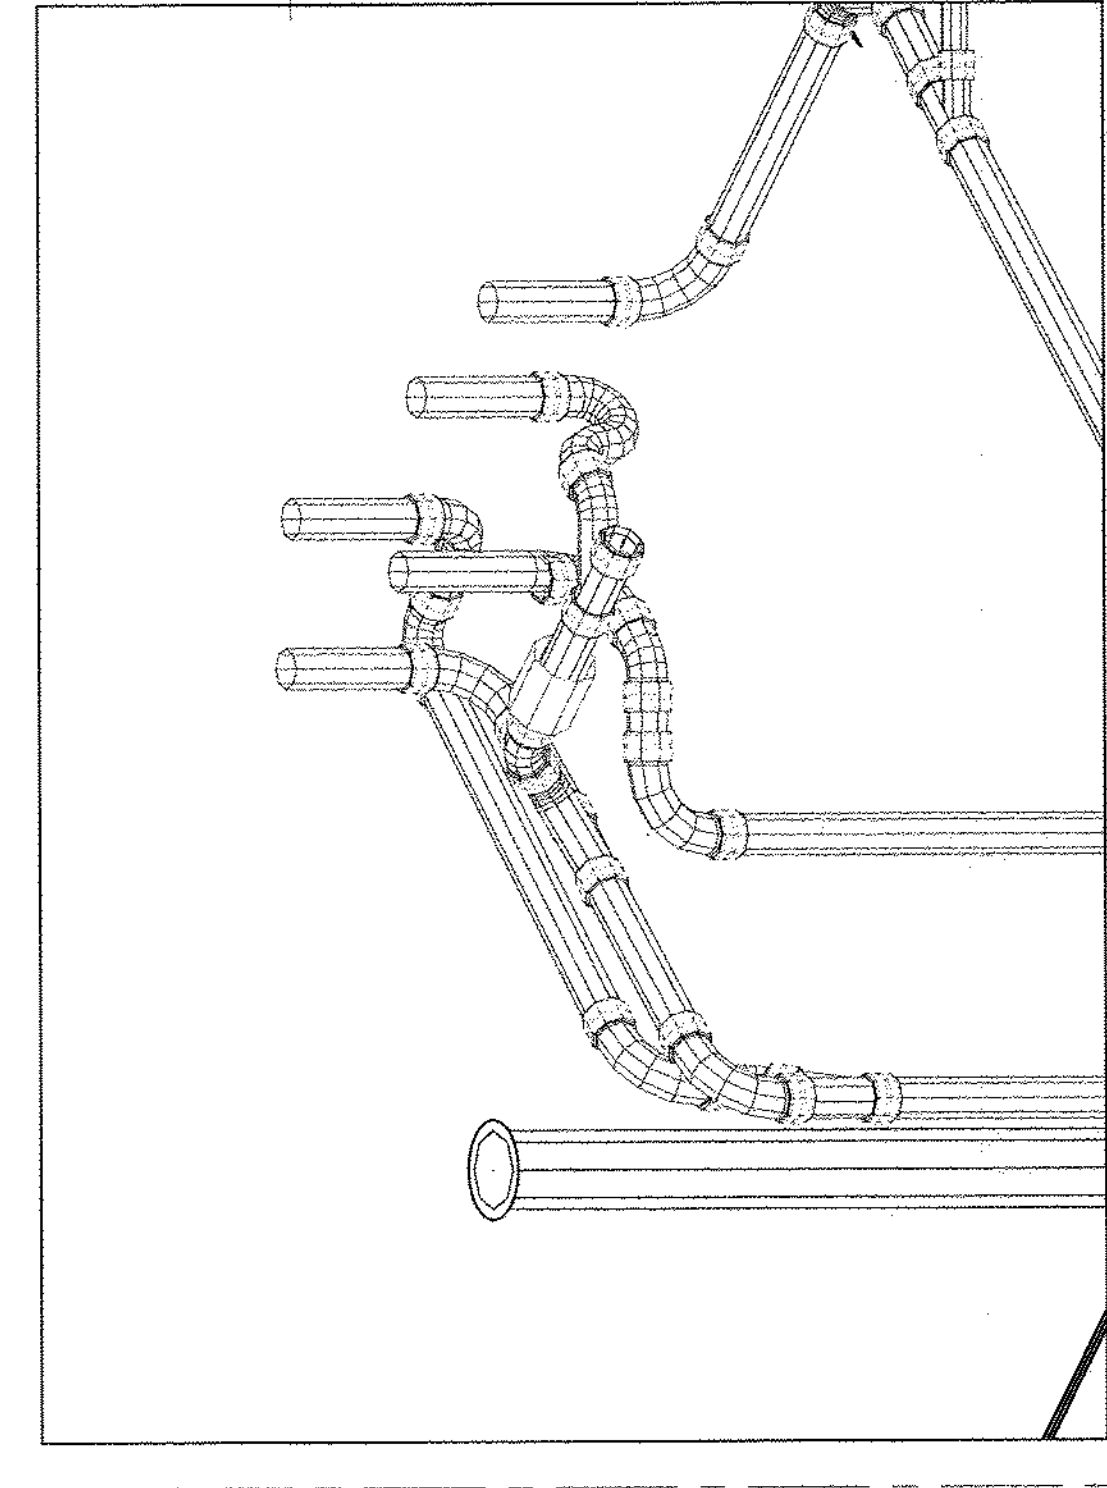



ISOMETRIC VIEW

AS-BUILT

REVIEWED

DATE: 3/24/98

BY: LMO

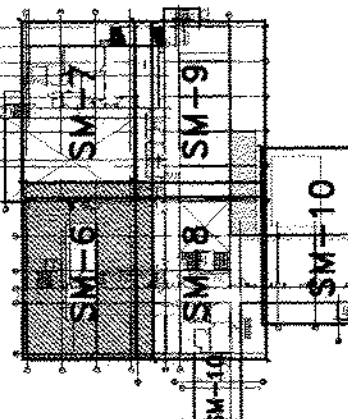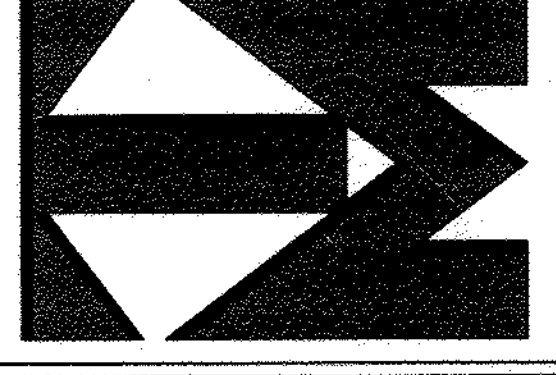

TRACEY MECHANICAL, INC.			
401 CITY LINE AVE.			
SUITE 212			
BALA CYNWYD, PA. 19004			
6TH AND DUNCANNON			
PARTIAL 2ND FLOOR			
SANITARY & VENTING			
DRAWING NO.			
P-6			
DATE: 9/17/96			
SCALE: 3/8" = 1'-0"			
DRAWN: D.G.			
DATE: 4/7/97			
D.G.			
11/21/96			
D.G.			
10/18/96			
D.G.			
10/2/96			
D.G.			
11-0"			
REVISION			
DATE			
BY			
NO.			