THE SCHOOL DISTRICT OF PHILADELPHIA Office of Capital Programs 440 North Broad Street, 3rd Floor – Suite 371 Philadelphia, PA 19130

TELEPHONE: (215) 400-4730

Addendum No. 001

Subject: Edward T. Steel School – Classroom Modifications SDP Contract Nos. B-0673C, B-070C of 2017/18

Location: Edward T. Steel School 4301 Wayne Avenue Philadelphia, Pennsylvania 19140

This Addendum, dated May 9, 2018, shall modify and become part of the Contract Documents for the work of this project. Any items not mentioned herein, or affected by, shall be performed strictly in accordance with the original documents.

The following items, clarifications and/or revisions are to be included in the Contract Documents:

DRAWINGS

Drawing: A001

Revisions:

- a. General Notes: Add note 38 to read as follows:
 - 38. PROVIDE AN ALLOWANCE OF 100 SQUARE FEET OF NEW GLASS/WOOD TRIM REPLACEMENT IN EXISTING CLASSROOM DOORS AND SIDELIGHTS. AREAS REQUIRING REPLACEMENT WILL BE DETERMINED AND COORDINATED IN THE FIELD WITH THE SCHOOL DISTRICT CONSTRUCTION REPRESENTATIVE.

Drawing: A101

- Revisions:
 - a. Renovation Notes: Revise note A34 to read as follows (typical for all drawings):
 - A34 INSTALL NEW COAT HOOKS (30 HOOKS) AND PLASTIC LAMINATE SHELVES WHERE INDICATED.

Drawing: A101.2

Revisions:

- a. Interior Elevation 3/A101.2: Add the dimension 3'-3" from the new markerboard/tackboard to the adjacent wall on the right side.
- b. Interior Elevation 4/A101.2: Revise the new tackboard to be 36" wide instead of 48" wide.

Drawing: A102

Revisions:

- a. Partial Second Floor Demolition Plan Area B, 1/A102: Add demolition tag D07 to Classroom 202, Classroom 204 and Classroom 206.
- b. Partial Second Floor Plan Area B, 2/A102: Remove the A02 tag in the Classroom 202 storage alcove and change it to an A12 tag.
- c. Partial Second Floor Plan Area B, 2/A102: The A12 tag should also extend to all three walls in the corridor alcove area outside the classrooms.

Edward T. Steel School – Classroom Modifications SDP CONTRACT NOS. B-0673C, B-070C of 2017/18 d. Partial Second Reflected Ceiling Plan Area B, 4/A102: See attached revised drawing A102 for revised ceiling grid layout.

Drawing: A102.1

Revisions:

a. Interior Elevation 4/A102.1: Change the 2'-0" dimension for the tackboard to 1'-0".

Drawing: A103

Revisions:

- a. Second Floor Plan Area C, 2/A103: The A12 tag should also extend to all three walls in the corridor alcove area outside the classrooms.
- b. Second Reflected Ceiling Plan Area C, 3/A103: See attached revised drawing A103 for revised ceiling grid layout.

Drawing: A103.1

Revisions:

- a. Interior Elevation 3/A103.1: Change the 2'-0" dimension for the tackboard to 1'-0".
- b. Interior Elevation 16/A103.1: Change the 2'-0" dimension for the tackboard to 1'-0".

Drawing: A501

Revisions:

- a. Typical Locker Section Detail 2/A501: See attached revised drawing A501 for revised detail.
- b. New Partition Detail 4/A501: Add the following note to the wall detail: PROVIDE FRAMING SUPPORT FOR INSTRUCTIONAL BOARDS.

Drawing: A601

- Revisions:
- a. Door and Frame Schedule: See attached revised drawing A601 for added "Hardware Type" column.

Drawing: All Mechanical Drawings

Revisions:

a. ADD key plan and seal information on all mechanical sheets.

Drawing: All Mechanical and Electrical Drawings

Revisions:

- a. Revised B-numbers on titleblock
- b. Revised Project title on titleblock

Drawing: E001

- Revisions:
- a. Added Light fixture type B to lighting fixture schedule.

Drawing: ED111

- Revisions:
- a. Added existing lighting in toilets and storage rooms and key plan.

Drawing: ED112:

Revisions:

a. Added Key plan.

Drawing: ED121

Revisions:

a. Added Key plan

Drawing: ED122

Revisions:

a. Added Key plan.

Drawing: E111

Revisions:

- a. Added switch control designation on lighting floor plan.
- b. Added Key plan and graphic scale.

Drawing: E112

Revisions:

- a. Added switch control designation on lighting floor plan.
- b. Added Key plan and graphic scale.

Drawing: E121

Revisions:

- a. Added receptacles in classrooms 105, 107, 109, 111 and 113.
- b. Revised and added key notes.
- c. Added wiring schedule.
- d. Added Key plan and graphic scale.

Drawing: E122

Revisions:

- a. Added receptacles and completed wiring in classrooms 201, 202, 203, 204, 205, 206, 207, 209 and 211.
- b. Revised and added key notes.
- c. Added wiring schedule.
- d. Added Key plan and graphic scale.

BIDDER'S QUESTIONS

1. <u>Question</u>: Due to the scope of work for all projects, the substantial completion date is unachievable. Along with lost time for moving of furniture and equipment before start of project. Can the date for substantial completion be extended?

Response: No

2. <u>Question:</u> Visual Display Surfaces - in spec there is a note if new boards are not installed in time, to use temporary boards as necessary, how many temporary boards are we to provide per classroom?

<u>Response:</u> Temporary boards do not need to be provided.

3. <u>Question:</u> Do we need to provide temporary window shades, if new ones are not installed before start of school?

<u>Response:</u> No. Existing shades are to be removed and salvaged/protected and reinstalled until new shades can be installed.

4. <u>Question:</u> Wood Floor Refinishing- some projects call for 2 coats of stain, can we forgo the stain and just use 2 coats of sealer and 2 coats of finish for all projects. You are adding on time to an already accelerated schedule.

<u>Response:</u> Sand, seal, and finish the wood floors in accordance with the specifications. Omit staining of the floor.

5. <u>Question:</u> Have you checks on the choices of accent colors for the VCT tile? The colors may be a stock color, but do they have enough on hand, if not they may not be readily available for the substantial completion date.

<u>Response:</u> Armstrong has been made aware of this project and its approximate square footage needs. Contractor to provide updated information on each color's availability immediately after NTP.


6. <u>Question:</u> Can you please include and spec for electrostatic painting.


<u>Response:</u> See Electrostatic Paint spec in Addendum #2.

ATTACHMENTS


Drawing A102 Drawing A103 Drawing A501 Drawing A601 Drawing E001 Drawing ED111 Drawing ED112 Drawing ED121 Drawing ED122 Drawing E111 Drawing E112 Drawing E121 Drawing E122 Drawing E401 Drawing E501 Drawing M001 Drawing MD111 Drawing MD112 Drawing M111 Drawing M112

End of Addendum No. 001

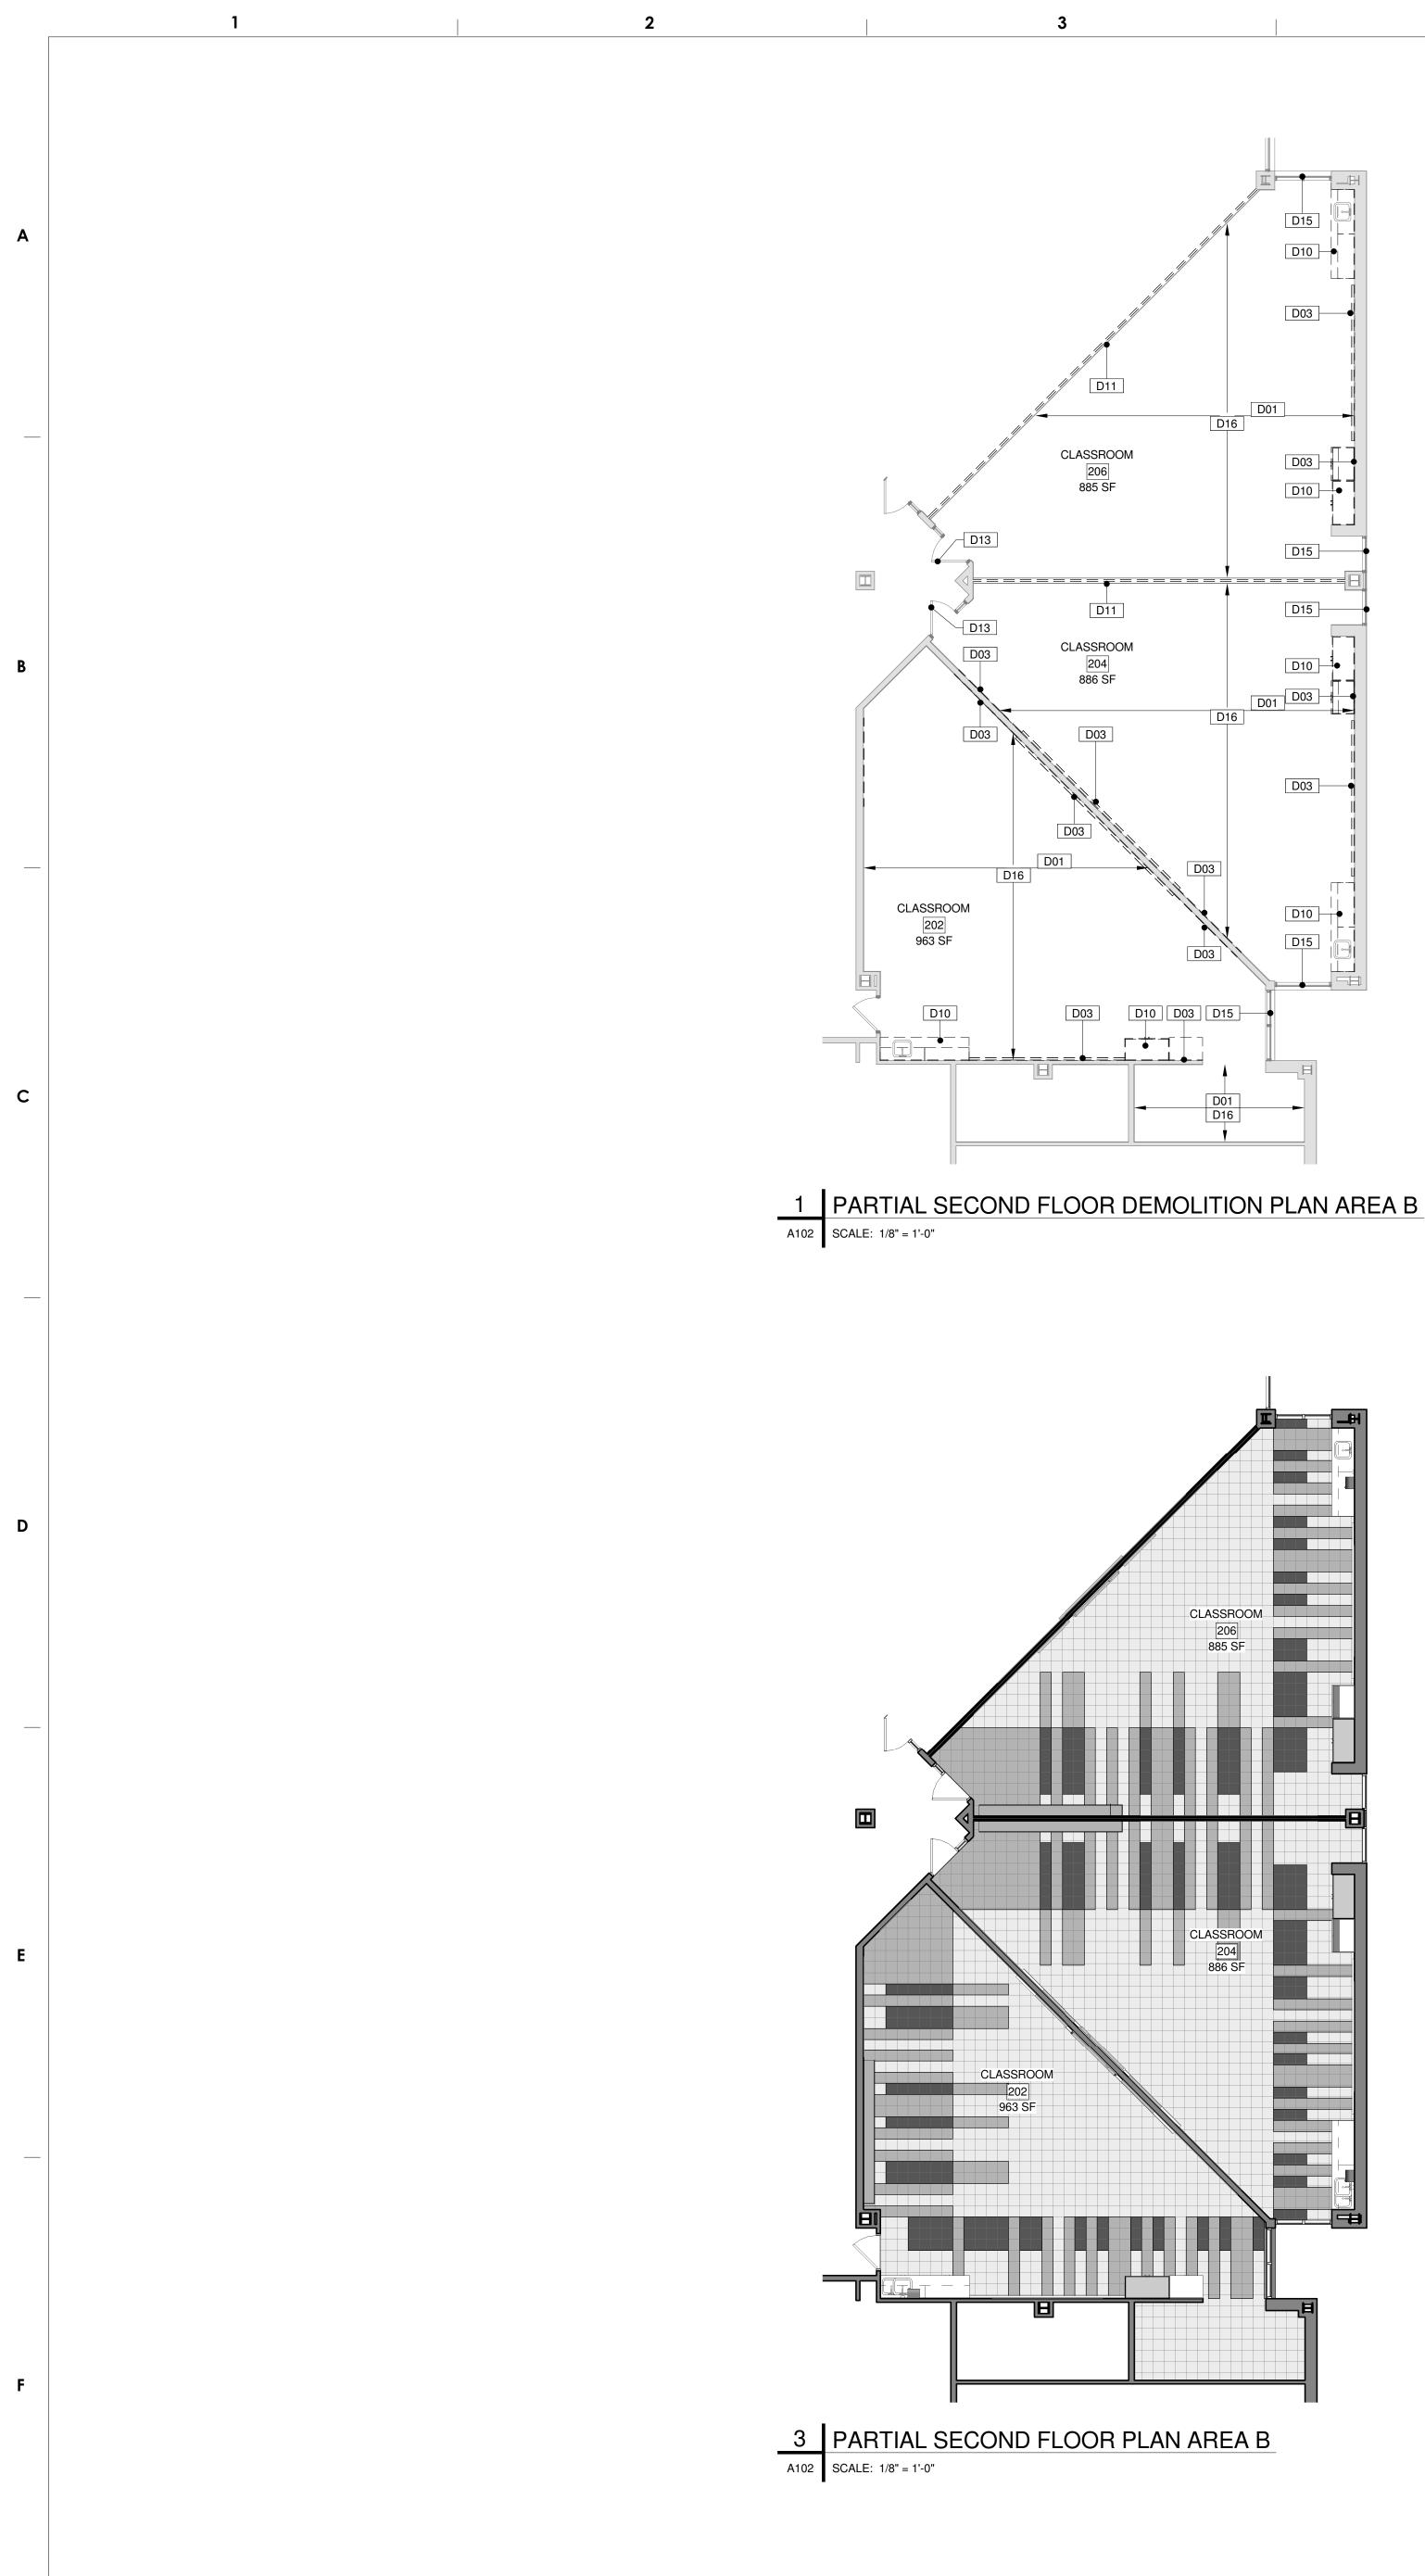


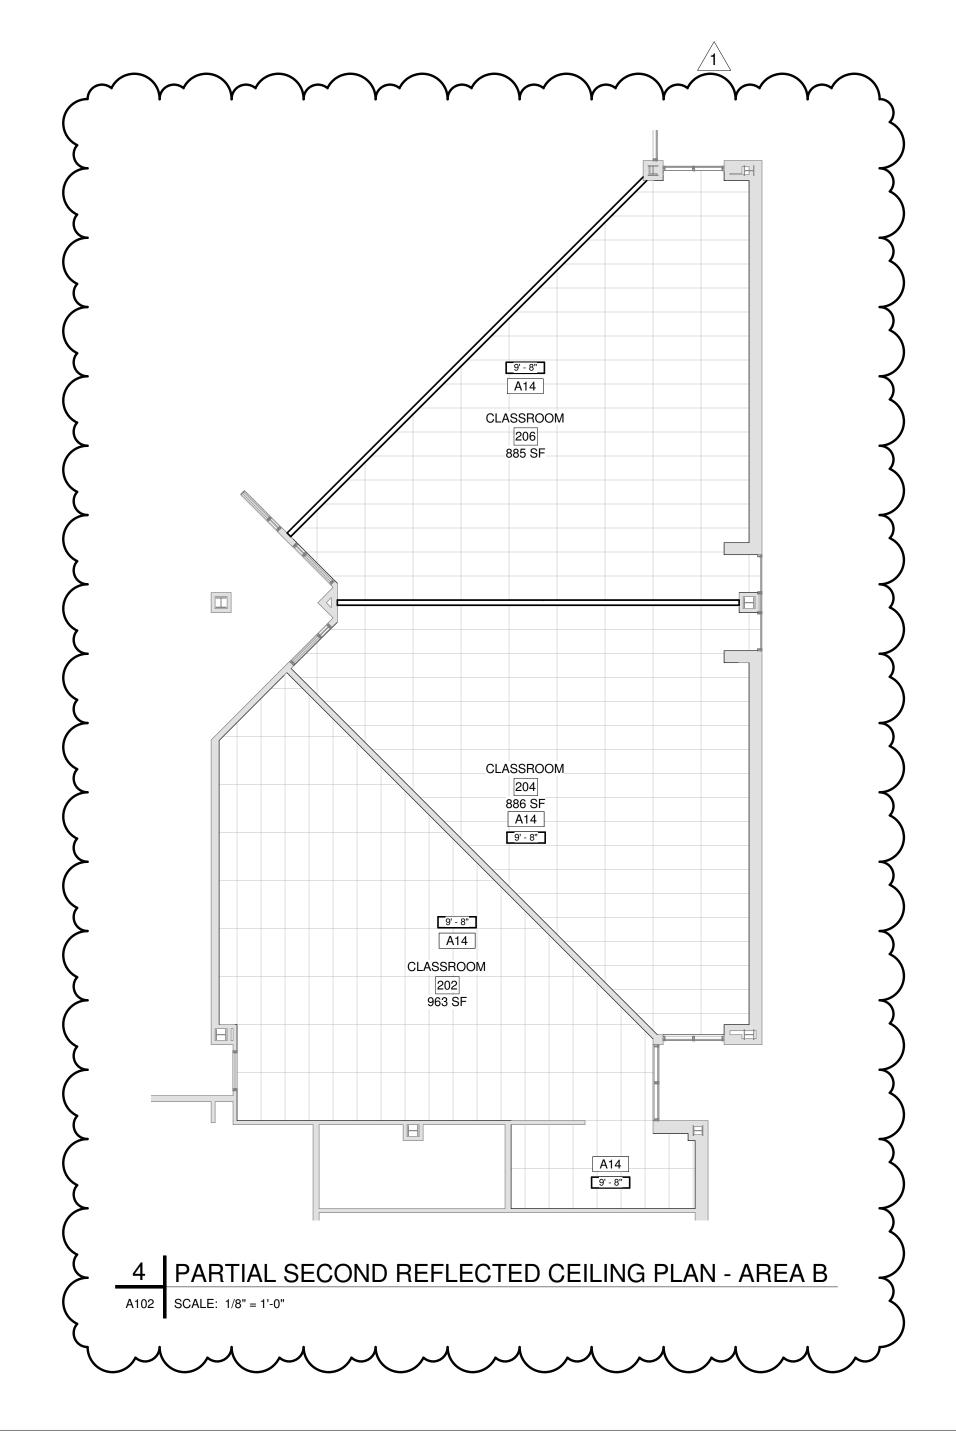


2 PARTIAL SECOND FLOOR PLAN AREA B A102 SCALE: 1/8" = 1'-0"

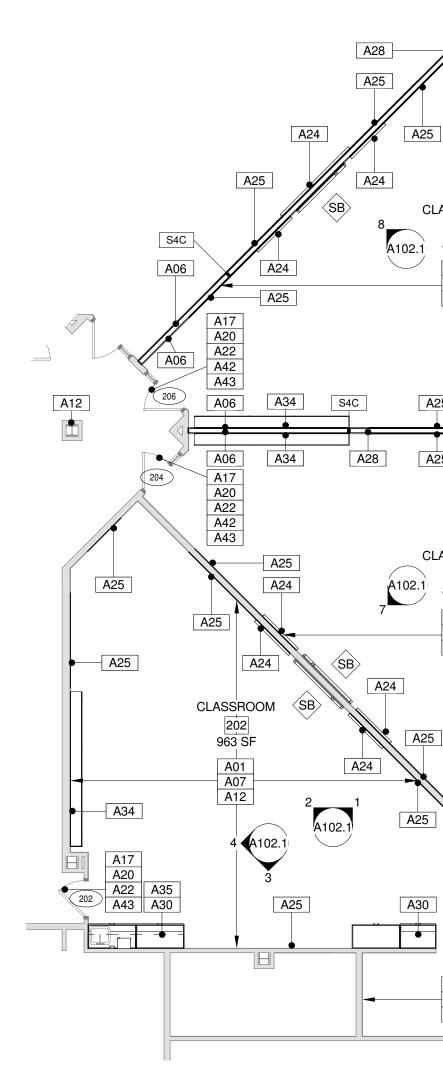

4

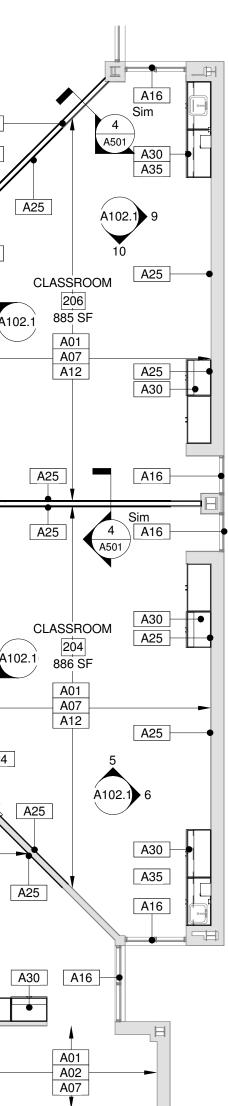

6

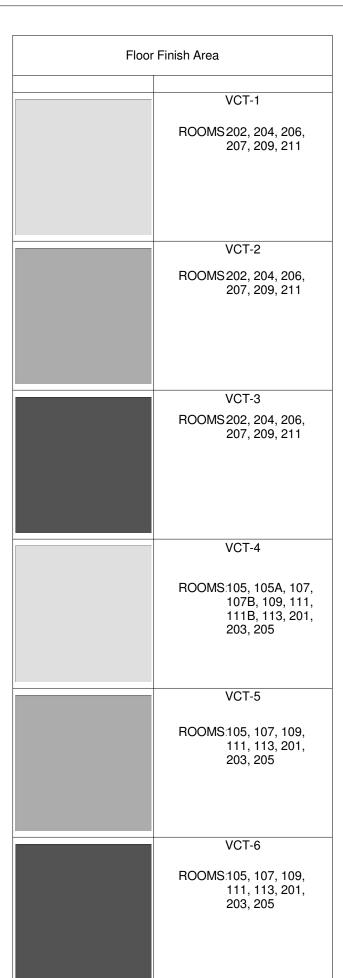

	REFER TO ENVIRONMENTAL COORDINATION SPECIFICATION. WHERE THE CASEWORK IN MOUNTED ON EXISTING STRUCTURAL GLAZED BLOCK BASE, THE STRUCTURAL GLAZED BLOCK BASE SHALL REMAIN AND BE PREPAIRED FOR NE CASEWORK.
D11	REMOVE EXISTING FOLDING PARTITION, TRACK AND ASSOCIATED HARDWARE. PATCH AND REPA EXISTING WALL/TRIM AS REQUIRED TO MATCH ADJACENT SURFACES AND TO ACCEPT NEW FINISHES.
D13	REMOVE EXISTING DOOR KNOB, LATCH SET AND DOOR CLOSER. DOOR TO REMAIN
D15	REMOVE EXISTING WINDOW TREATMENT AND ASSOCIATED HARDWARE FROM ALL WINDOWS. PATCH AND REPAIR EXISTING WALL/TRIM AS REQUIRED TO MATCH ADJACENT SURFACES AND TO ACCEPT NEW SPECIFIED WINDOW TREATMEN
D16	REMOVE EXISTING ACOUSTICAL CEILING TILE AN GRID.
D19	REMOVE EXISTING FREE-STANDING WOOD CUBBIES. COORDINATE WITH THE OWNER IF THE CUBBIES SHOULD BE DISPOSED OF OR SALVAGE AND DELIVERED TO THEM.
D28	REMOVE EXISTING KITCHENETTE UNIT IN ITS ENTIRETY. INCLUDING ALL ASSOCIATED APPLIANCES ACCESSORIES, MOUNTING BRACKE AND EXPOSED BLOCKING. PATCH AND REPAIR EXISTING WALL AS REQUIRED TO MATCH ADJACENT SURFACES AND/OR TO ACCEPT NEW FINISH AND/OR EQUIPMENT. REFER TO ENVIRONMENTAL COORDINATION SPECIFICATION
	RENOVATION NOTES
Key Value	Keynote Text
A01	INSTALL NEW VCT FLOORING. CLEAN, FLASH PATCH AND LEVEL FLOOR AS REQUIRED. PREP FLOOR TO RECEIVE NEW FINISH. REFER TO ENVIRONMENTAL COORDINATIONS SPECIFICATION.
A02	STRIP AND SAND, PATCH, CLEAN AND PREP EXISTING WOOD FLOORING AND PROVIDE A NEW CLEAR COAT FINISH. REPAIR ANY DAMAGED FLOORING AS REQUIRED, NEW FLOORING TO MATCH EXISTING ADJACENT FLOORING. COORDINATE LOCATIONS OF NEW FLOORING IN THE FIELD WITH THE OWNER.
A04	CLEAN EXISTING CERAMIC TILE FLOORING, BASE AND MARBLE THRESHOLD.
A06	INSTALL NEW RUBBER WALL BASE. CLEAN AND PREP EXISTING SURFACE FOR NEW FINISH.
A07 A12	CLEAN EXISTING STRUCTURAL GLAZED BLOCK WALL BASE. PAINT EXISTING CMU/PLASTER/GWB AND EXPOSI
	PIPES. SCRAPE EXISTING LOOSE PAINT, SAND, (INCLUDING THE REMOVAL OF ALL STAPLES, ETC CLEAN AND PREP SURFACE FOR NEW FINISH.
A14	INSTALL NEW 2X4 SUSPENDED ACOUSTICAL TILE CEILING AND GRID.
A16	INSTALL NEW INTERIOR WINDOW SHADES AS SPECIFIED ON ALL EXTERIOR WINDOW UNITS IN
A17	CLASSROOM. INSTALL NEW HARDWARE AS SCHEDULED ON EXISTING DOOR.
A20	PATCH, LIGHTLY SAND, CLEAN (INCLUDING THE REMOVAL OF ALL STAPLES, ETC.) AND PREP EXISTING WOOD DOOR AND PROVIDE NEW CLEA COAT FINISH. REPAIR DAMAGED AREAS TO MATC ADJACENT PROFILE, INCLUDING WOOD GRILLES AND GLASS WHERE OCCURS. DAMAGED WOOD AND GLAZING AREAS SHOULD BE REVIEWED WIT THE OWNER IN THE FIELD.
A22	PAINT EXISTING HOLLOW METAL DOOR FRAME. LIGHTLY SAND, CLEAN AND PREP SURFACE FOR NEW FINISH. PAINT ENTIRE FRAME (BOTH SIDES) CORRIDOR SIDE COLOR TO MATCH OTHER EXISTING CORRIDOR DOOR FRAMES.
A24	INSTALL NEW MARKERBOARD AS SCHEDULED.
A25 A28	INSTALL NEW TACKBOARD AS SCHEDULED. INSTALL NEW STUD/GWB WALL AS SCHEDULED IN EXISTING FOLDING PARTITION OPENING.
A29	FINISH/PAINT AS SCHEDULED (BOTH SIDES). PATCH, LIGHTLY SAND, CLEAN (INCLUDING THE REMOVAL OF ALL STAPLES, ETC.) AND PREP EXISTING WOOD CASEWORK/COUNTER TOP/SHELVES AND PROVIDE NEW CLEAR COAT FINISH. REPAIR DAMAGED AREAS/HARDWARE TO
A30	MATCH EXISITNG ADJACENT. INSTALL NEW PLASTIC LAMINATE CASEWORK AS SCHEDULED.
A34	INSTALL NEW COAT HOOKS (30 HOOKS).
A35	RE-INSTALL SALVAGED PAPER TOWEL DISPENSER/TOILET PAPER DISPENSER/SOAP DISPENSER/HAND SANITIZER DISPENSER.
A42	PAINT EXISTING METAL LOUVER (BOTH SIDES). LIGHTLY SAND, CLEAN AND PREP SURFACE FOR NEW FINISH. MATCH DOOR FRAME COLOR.
A43	PATCH, LIGHTLY SAND, CLEAN (INCLUDING THE REMOVAL OF ALL STAPELS, ETC.) AND PREP

8

DEMOLITION NOTES

REMOVE EXISTING VCT FLOORING.

COORDINATION SPECIFICATION.

OF MOUNTING BRACKETS.

MOUNTING BRACKET.

REMOVE EXISTING BASE CABINETS/TALL

ASSOCIATED ACCESSORIES, MOUNTING

CABINETS/WALL CABINETS/COUNTER

WORK.

REMOVE EXISTING

Keynote Text

Key Value

D03

DO

1D09


D10

	1

REMOVAL OF ALL STAPELS, ETC.) AND PREP EXISTING WOOD TRANSOM PANEL AND PROVIDE NEW CLEAR COAT FINISH. REPAIR DAMAGED AREAS TO MATCH ADJACENT PROFILE.


Project



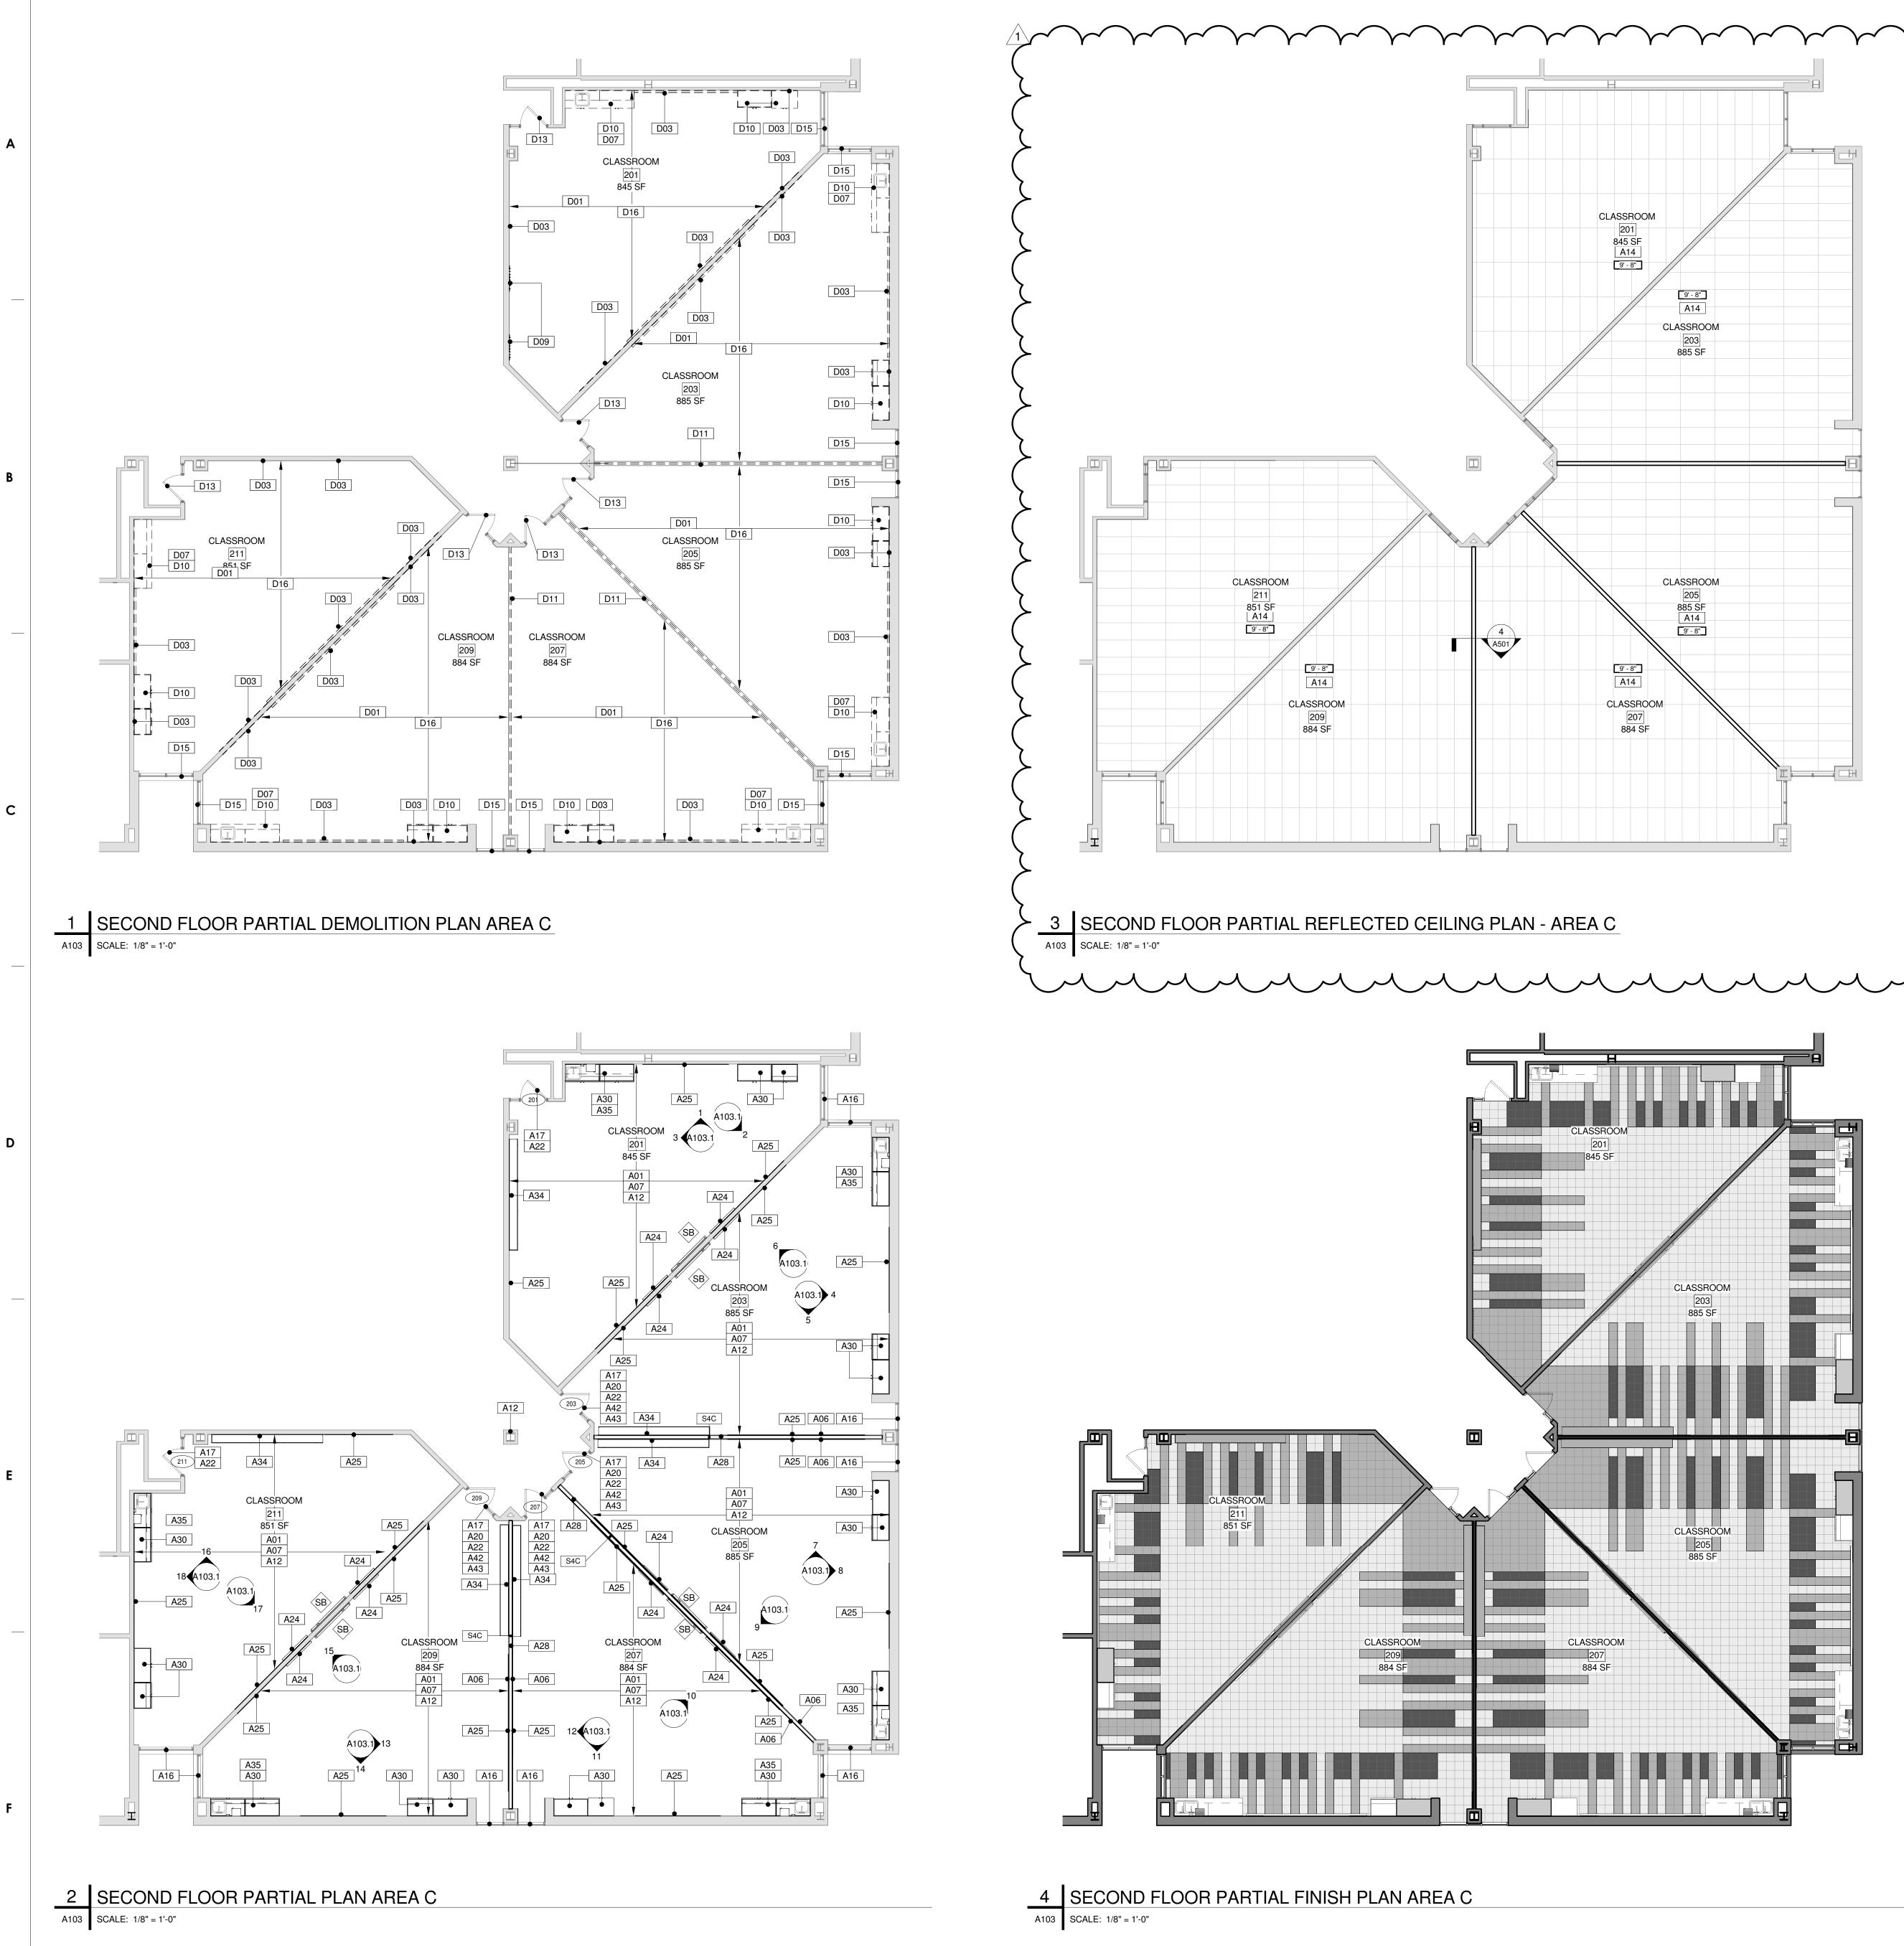


Floor	Finish Area
	VCT-1 ROOMS202, 204, 206, 207, 209, 211
	VCT-2 ROOMS202, 204, 206, 207, 209, 211
	VCT-3 ROOMS202, 204, 206, 207, 209, 211
	VCT-4 ROOMS:105, 105A, 107, 107B, 109, 111, 111B, 113, 201, 203, 205
	VCT-5 ROOMS:105, 107, 109, 111, 113, 201, 203, 205
	VCT-6 ROOMS:105, 107, 109, 111, 113, 201, 203, 205


Key Value	DEMOLITION NOTES Keynote Text			
D01	REMOVE EXISTING VCT FLOORING.			
D03	REMOVE EXISTING CHALKBOARD/MARKERBOARD/TACKBOAF TRIP/CHALKBOARD. INCLUDING ALL ASSO ACCESSORIES AND MASTIC/ADHESIVE. PA REPAIR EXISTING WALL AS REQUIRED TO ADJACENT EXPOSED SURFACES AND/OR ACCEPT NEW SPECIFIED DISPLAY SURFACE EQUIPMENT. REFER TO ENVIRONMENTAL			
D06	COORDINATION SPECIFICATION. REMOVE EXISTING PROJECTION SCREEN BRACKETS. SALVAGE PROJECTION SCREE DELIVER TO OWNER. CONTRACTOR TO D			
D07	OF MOUNTING BRACKETS. REMOVE EXISTING PAPER TOWEL DISPENSER/TOILET PAPER DISPENSER/SC DISPENSER/HAND SANITIZER DISPENSER SALVAGE FOR REINSTALLATION AS PART			
D09	WORK. REMOVE EXISTING COAT HOOKS AND WO			
D10	MOUNTING BRACKET. REMOVE EXISTING BASE CABINETS/TALL			
	CABINETS/WALL CABINETS/COUNTER TOP/BACKSPLASH/SHELVES. INCLUDING / ASSOCIATED ACCESSORIES, MOUNTING BRACKETS AND EXPOSED BLOCKING. PAT REPAIR EXISTING WALL AS REQUIRED TO ADJACENT SURFACES AND/OR TO ACCEP SPECIFIED DISPLAY SURFACE OR EQUIPM			
	REFER TO ENVIRONMENTAL COORDINATI SPECIFICATION. WHERE THE CASEWORK MOUNTED ON EXISTING STRUCTURAL GLI BLOCK BASE, THE STRUCTURAL GLAZED BASE SHALL REMAIN AND BE PREPAIRED CASEWORK.			
D11	REMOVE EXISTING FOLDING PARTITION, T AND ASSOCIATED HARDWARE. PATCH AN			
D13	AND ASSOCIATED HARDWARE. FATCH AN EXISTING WALL/TRIM AS REQUIRED TO M/ ADJACENT SURFACES AND TO ACCEPT NI FINISHES. REMOVE EXISTING DOOR KNOB, LATCH S			
D15	DOOR CLOSER. DOOR TO REMAIN REMOVE EXISTING WINDOW TREATMENT			
	ASSOCIATED HARDWARE FROM ALL WIND PATCH AND REPAIR EXISTING WALL/TRIM			
D16	REQUIRED TO MATCH ADJACENT SURFAC TO ACCEPT NEW SPECIFIED WINDOW TRE			
D16 D19	REMOVE EXISTING ACOUSTICAL CEILING GRID. REMOVE EXISTING FREE-STANDING WOO CUBBIES. COORDINATE WITH THE OWNER			
	CUBBIES SHOULD BE DISPOSED OF OR SA AND DELIVERED TO THEM.			
D28	REMOVE EXISTING KITCHENETTE UNIT IN ENTIRETY. INCLUDING ALL ASSOCIATED APPLIANCES ACCESSORIES, MOUNTING E			
	AND EXPOSED BLOCKING. PATCH AND RE EXISTING WALL AS REQUIRED TO MATCH			
	ADJACENT SURFACES AND/OR TO ACCEP FINISH AND/OR EQUIPMENT. REFER TO ENVIRONMENTAL COORDINATION SPECIF			
Key Value	RENOVATION NOTES Keynote Text			
A01	INSTALL NEW VCT FLOORING. CLEAN, FLA PATCH AND LEVEL FLOOR AS REQUIRED. FLOOR TO RECEIVE NEW FINISH. REFER ENVIRONMENTAL COORDINATIONS SPECIFICATION.			
A02	STRIP AND SAND, PATCH, CLEAN AND PRI EXISTING WOOD FLOORING AND PROVIDE CLEAR COAT FINISH. REPAIR ANY DAMAG FLOORING AS REQUIRED, NEW FLOORING			
	MATCH EXISTING ADJACENT FLOORING. COORDINATE LOCATIONS OF NEW FLOOF THE FIELD WITH THE OWNER.			
A04	CLEAN EXISTING CERAMIC TILE FLOORING			
A06	INSTALL NEW RUBBER WALL BASE. CLEA PREP EXISTING SURFACE FOR NEW FINIS			
A07	CLEAN EXISTING STRUCTURAL GLAZED B WALL BASE.			
A12	PAINT EXISTING CMU/PLASTER/GWB AND PIPES. SCRAPE EXISTING LOOSE PAINT, S (INCLUDING THE REMOVAL OF ALL STAPL CLEAN AND PREP SURFACE FOR NEW FIN			
A14	INSTALL NEW 2X4 SUSPENDED ACOUSTIC CEILING AND GRID.			
A16	INSTALL NEW INTERIOR WINDOW SHADES SPECIFIED ON ALL EXTERIOR WINDOW UN			
A17	CLASSROOM. INSTALL NEW HARDWARE AS SCHEDULEE EXISTING DOOR.			
A20	PATCH, LIGHTLY SAND, CLEAN (INCLUDING REMOVAL OF ALL STAPLES, ETC.) AND PR			
	EXISTING WOOD DOOR AND PROVIDE NEW COAT FINISH. REPAIR DAMAGED AREAS T ADJACENT PROFILE, INCLUDING WOOD G AND GLASS WHERE OCCURS. DAMAGED V			
A22	AND GLAZING AREAS SHOULD BE REVIEW THE OWNER IN THE FIELD. PAINT EXISTING HOLLOW METAL DOOR FI			
	PAINT EXISTING HOLLOW METAL DOOR FI LIGHTLY SAND, CLEAN AND PREP SURFAC NEW FINISH. PAINT ENTIRE FRAME (BOTH CORRIDOR SIDE COLOR TO MATCH OTHE EXISTING CORRIDOR DOOR FRAMES.			
A24 A25	INSTALL NEW MARKERBOARD AS SCHEDULE			
A25 A28	INSTALL NEW TACKBOARD AS SCHEDULE INSTALL NEW STUD/GWB WALL AS SCHED EXISTING FOLDING PARTITION OPENING.			
A29	FINISH/PAINT AS SCHEDULED (BOTH SIDE PATCH, LIGHTLY SAND, CLEAN (INCLUDIN REMOVAL OF ALL STAPLES, ETC.) AND PR EXISTING WOOD CASEWORK/COUNTER			
	TOP/SHELVES AND PROVIDE NEW CLEAR FINISH. REPAIR DAMAGED AREAS/HARDW			
A30	MATCH EXISITNG ADJACENT.			
A34	SCHEDULED. INSTALL NEW COAT HOOKS (30 HOOKS).			
A35	RE-INSTALL SALVAGED PAPER TOWEL DISPENSER/TOILET PAPER DISPENSER/SO DISPENSER/HAND SANITIZER DISPENSER			
A42	PAINT EXISTING METAL LOUVER (BOTH SI LIGHTLY SAND, CLEAN AND PREP SURFAC			
A43	NEW FINISH. MATCH DOOR FRAME COLOF PATCH, LIGHTLY SAND, CLEAN (INCLUDIN			
	REMOVAL OF ALL STAPELS, ETC.) AND PR EXISTING WOOD TRANSOM PANEL AND PI			
	NEW CLEAR COAT FINISH. REPAIR DAMAG AREAS TO MATCH ADJACENT PROFILE.			

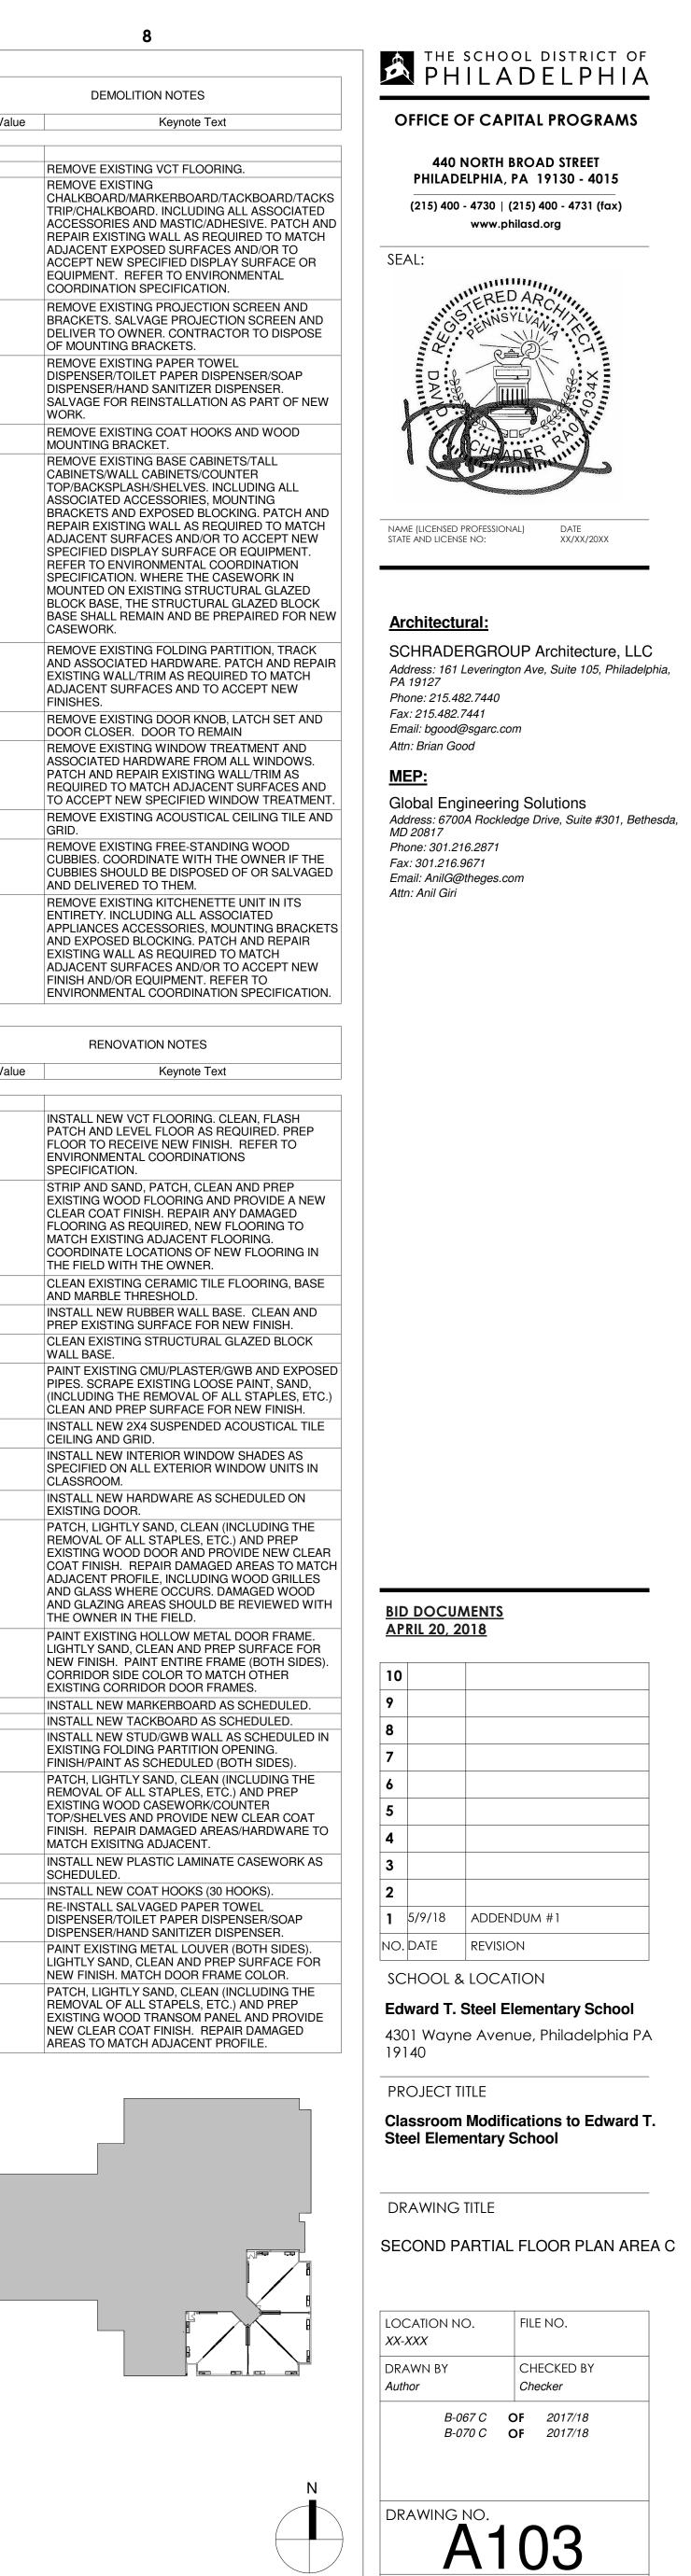

Project

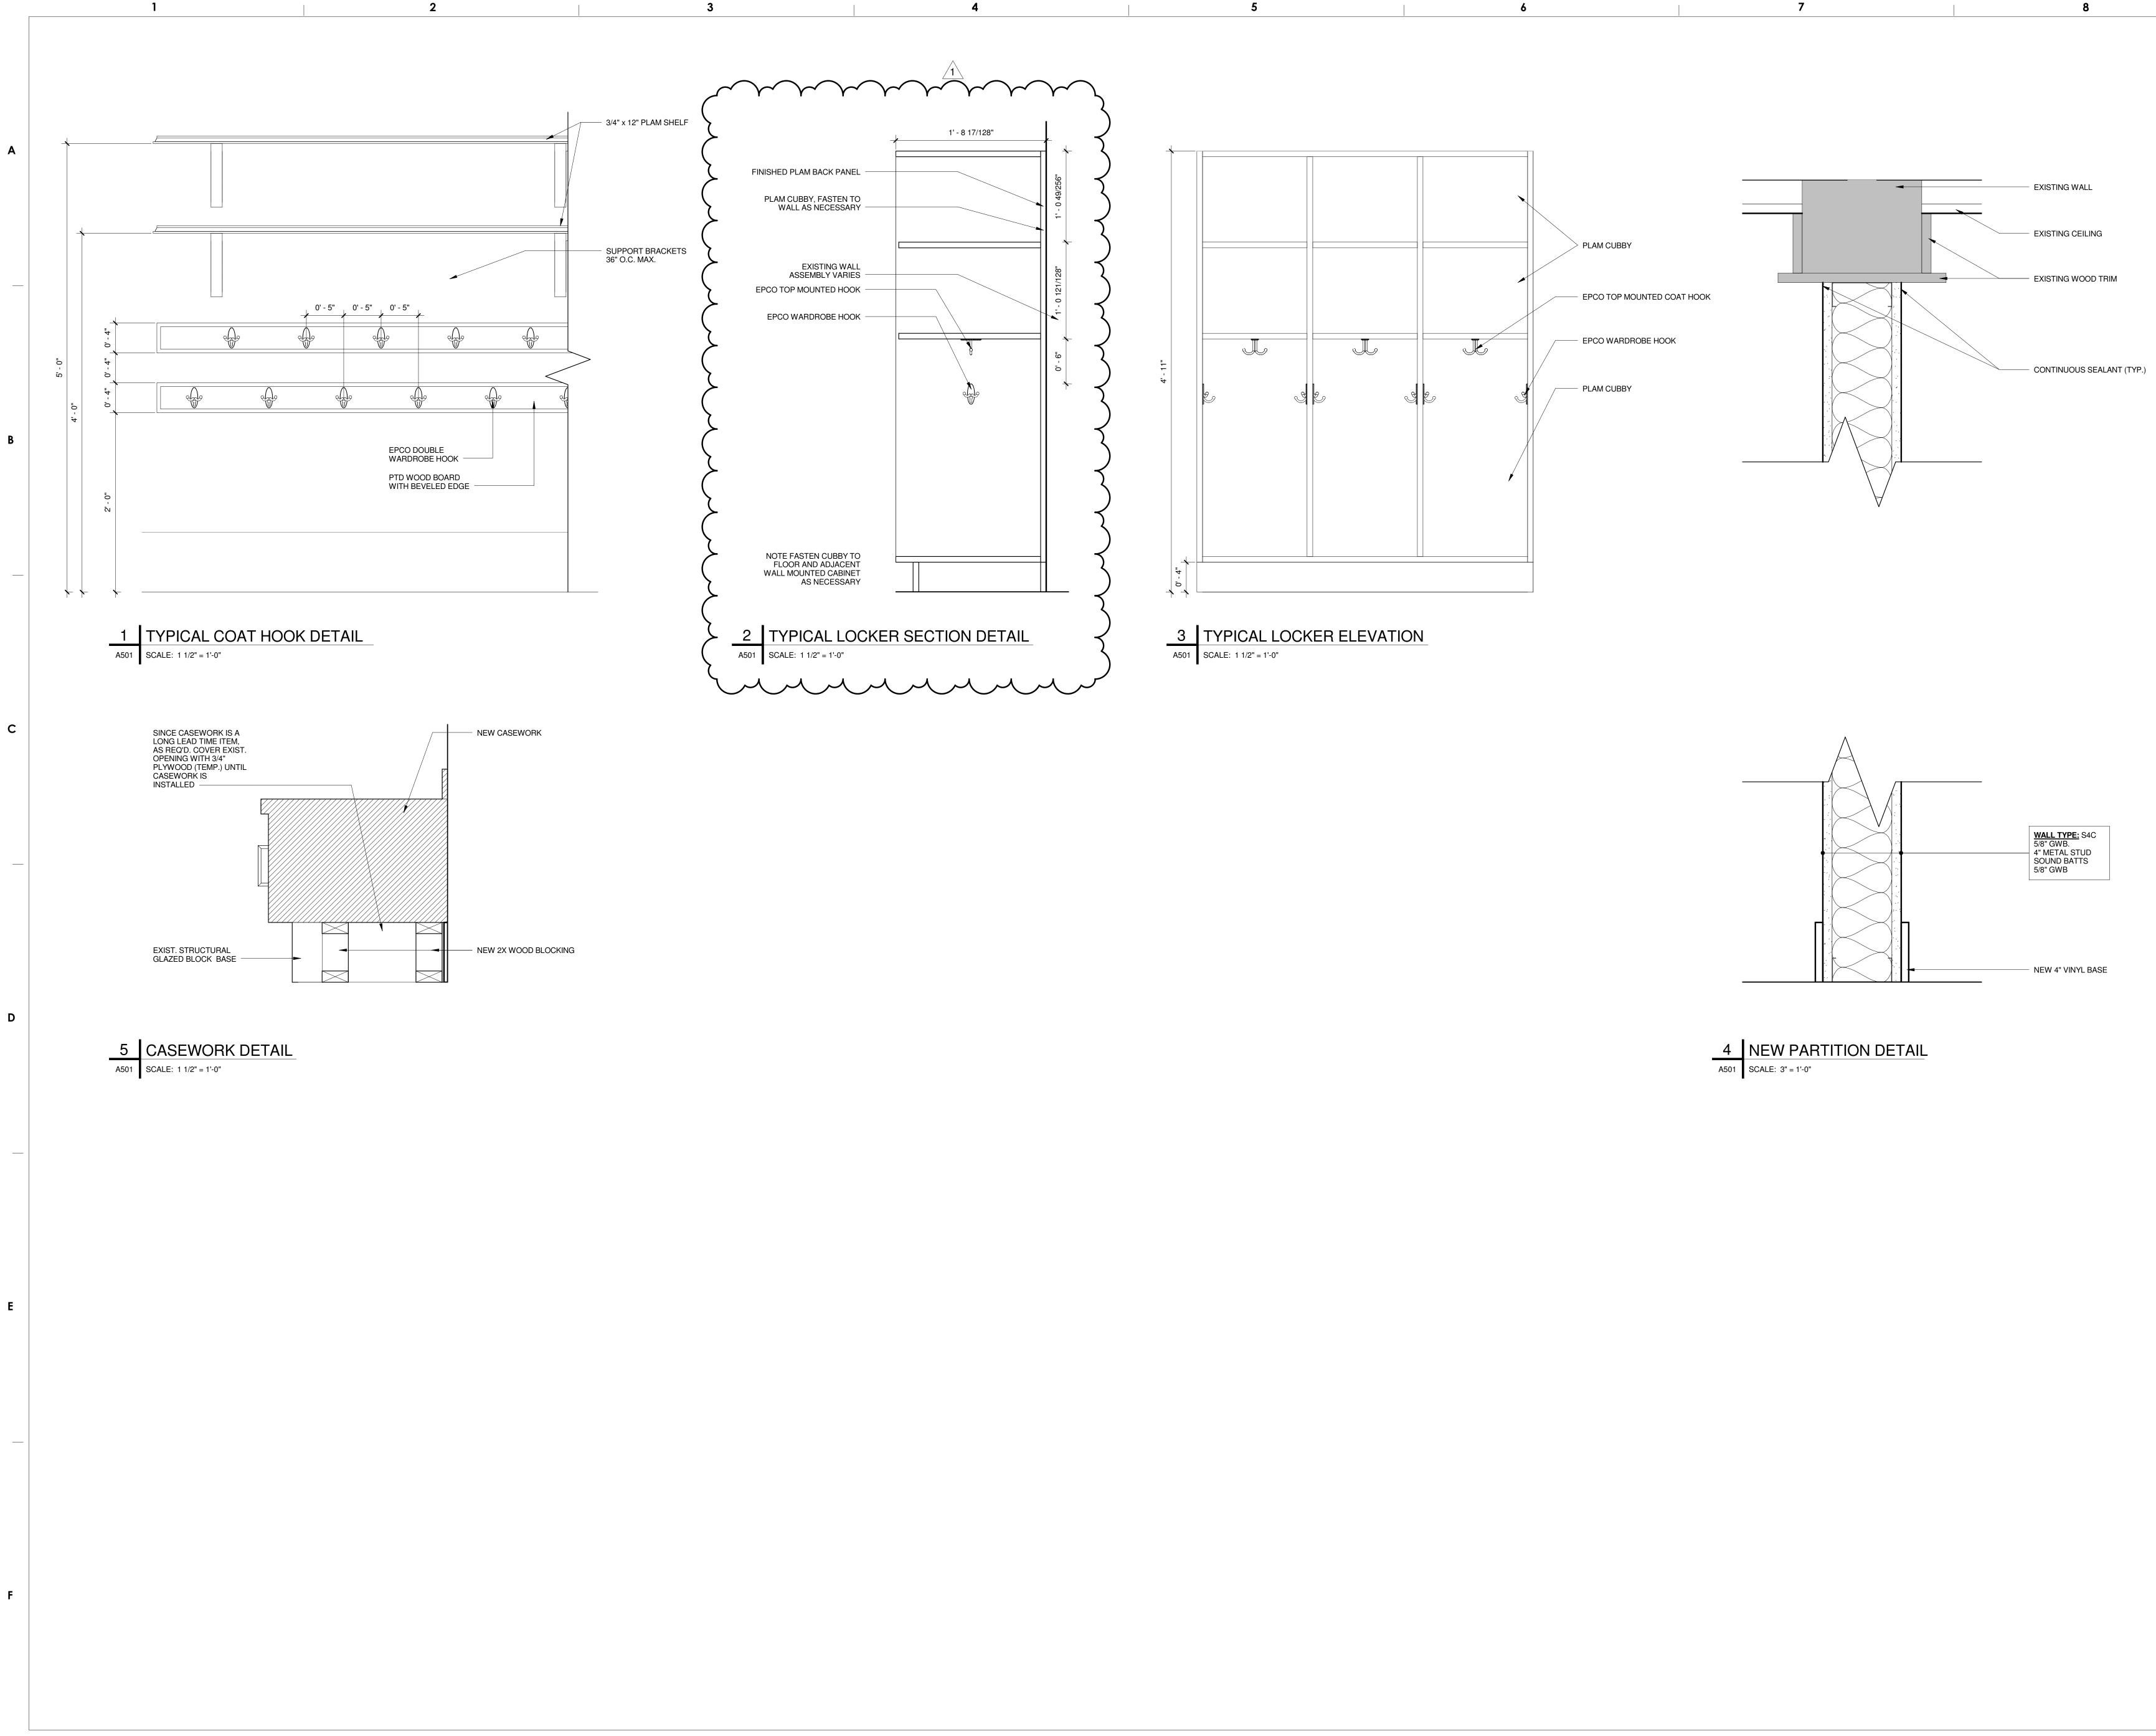



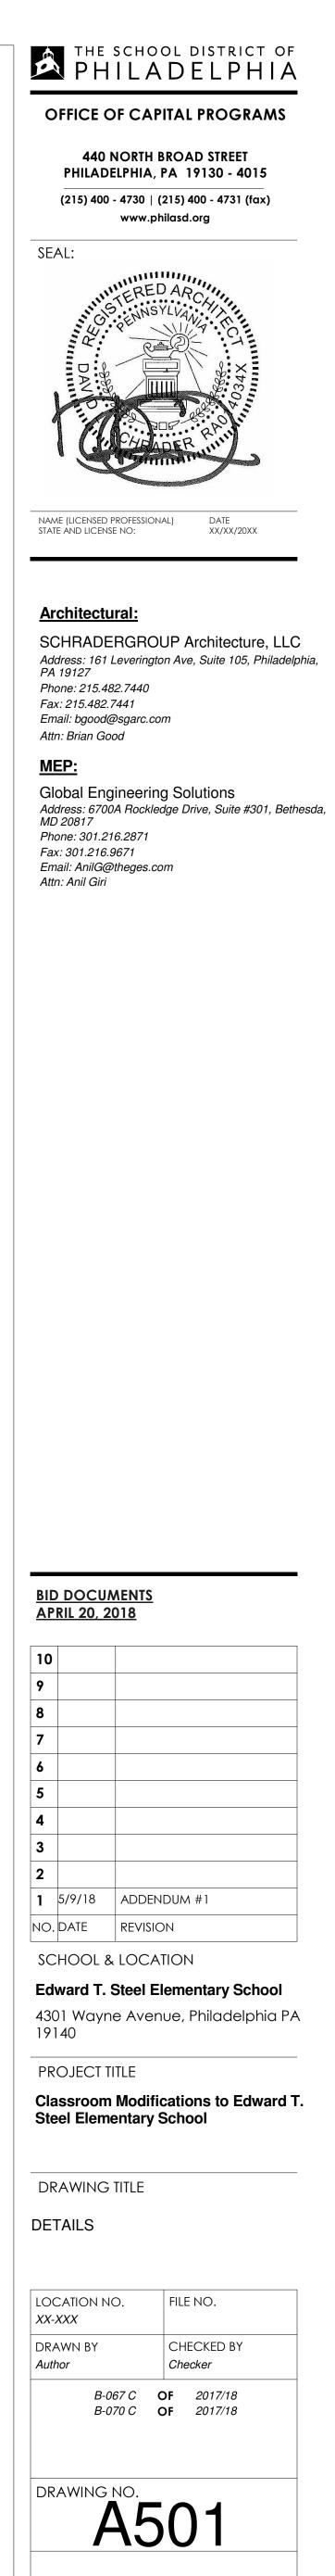



Α	

DOOR AND FRAME SCHEDULE

1

3

		DOOR						FRAME		GLAZING
NO.	TYPE	WIDTH	HEIGHT	THICKNESS	MATERIAL	FINISH	TYPE	MATERIAL	FINISH	TYPE
105	EX	3' - 0"	7' - 0"	0' - 1 3/4"	EX - Wood	EX	EX	EX - HM	Paint	EX
105A	EX	6' - 0"	7' - 0"	0' - 1 3/4"	EX - Wood	EX	EX	EX - HM	Paint	-
107	EX	3' - 0"	7' - 0"	0' - 1 3/4"	EX - Wood	EX	EX	EX - HM	Paint	EX
107A	EX	3' - 0"	7' - 0"	0' - 1 3/4"	EX - Wood	EX	EX	EX - HM	Paint	-
107B	EX	3' - 0"	7' - 0"	0' - 1 3/4"	EX - Wood	EX	EX	EX - HM	Paint	-
108	EX	3' - 0"	7' - 0"	0' - 1 3/4"	EX - HM	EX	EX	EX	EX	-
108A	EX	3' - 0"	7' - 0"	0' - 1 3/4"	EX - Wood	EX	EX	EX	EX	-
109	EX	3' - 0"	7' - 0"	0' - 1 3/4"	EX - Wood	EX	EX	EX - HM	Paint	EX
109A	EX	3' - 0"	7' - 0"	0' - 1 3/4"	EX - Wood	EX	EX	EX - HM	Paint	-
111	EX	3' - 0"	7' - 0"	0' - 1 3/4"	EX - Wood	EX	EX	EX - HM	Paint	EX
111A	EX	3' - 0"	7' - 0"	0' - 1 3/4"	EX - Wood	EX	EX	EX - HM	Paint	-
111B	EX	3' - 0"	7' - 0"	0' - 1 3/4"	EX - Wood	EX	EX	EX - HM	Paint	-
113	EX	3' - 0"	7' - 0"	0' - 1 3/4"	EX - Wood	EX	EX	EX - HM	Paint	EX
113A	EX	3' - 0"	7' - 0"	0' - 1 3/4"	EX - Wood	EX	EX	EX - HM	Paint	-
201	EX	3' - 0"	7' - 0"	0' - 1 3/4"	EX - Wood	EX	EX	EX - HM	Paint	EX
202	EX	3' - 0"	7' - 0"	0' - 1 3/4"	EX - Wood	EX	EX	EX - HM	Paint	EX
203	EX	3' - 0"	7' - 0"	0' - 1 3/4"	EX - Wood	EX	EX	EX - HM	Paint	EX
204	EX	3' - 0"	7' - 0"	0' - 1 3/4"	EX - Wood	EX	EX	EX - HM	Paint	EX
205	EX	3' - 0"	7' - 0"	0' - 1 3/4"	EX - Wood	EX	EX	EX - HM	Paint	EX
206	EX	3' - 1"	7' - 0"	0' - 1 3/4"	EX - Wood	EX	EX	EX - HM	Paint	EX
207	EX	3' - 0"	7' - 0"	0' - 1 3/4"	EX - Wood	EX	EX	EX - HM	Paint	EX
209	EX	3' - 0"	7' - 0"	0' - 1 3/4"	EX - Wood	EX	EX	EX - HM	Paint	EX
211	EX	3' - 0"	7' - 0"	0' - 1 3/4"	EX - Wood	EX	EX	EX - HM	Paint	EX

2


В

С

D

Ε

F

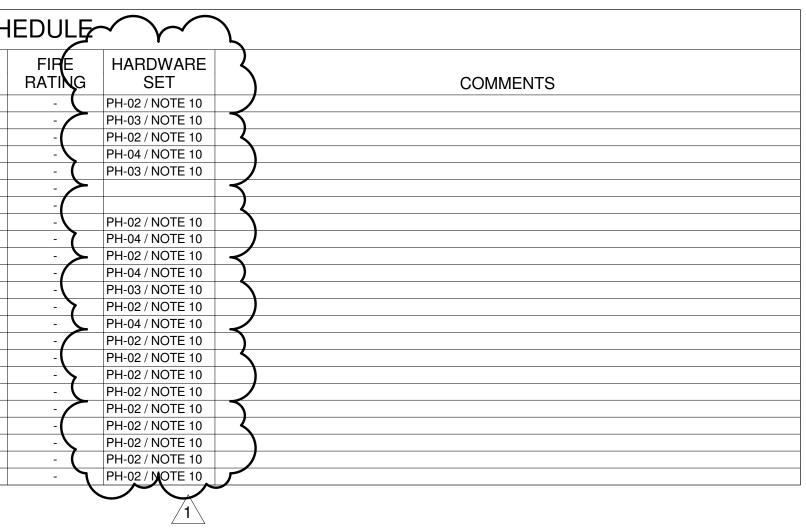


4

5

DOOR NOTES

- 1.) ALL GLAZING IN FIRE RATED DOORS TO BE FIRE GLASS COMPLYING WITH ANSI IMPACT REQUIREMENTS.
- 2.) ALL CLOSERS TO HAVE CLOSING SPECS SET 90° 12°, 5 SECONDS MIN.
- 3.) ALL DOOR LOCKS, LATCHES, PANIC HARDWARE AND PULLS TO BET SET 34"-48" AFF.
- 4.) ALL DOOR OPERATING DEVICES (OTHER THAN PANIC HARDWARE) TO BE LEVER OPERATED.
- 5.) ALL THRESHOLDS TO BE 1/2" MAX. HEIGHT, BEVELED TO 1:2 SLOPE.
- 6.) ALL GLASS IN DOORS AND WITHIN 24" OF A DOOR TO BE SAFETY TEMPERED GLASS (T).
- 7.) *SEE DOOR TYPES* DIMENSION NOTED IS FROM FINISHES FLOOR TO BOTTOM OF GLAZING.
- 8.) ALL DOOR HARDWARE TO BE MOUNTED A MINIMUM OF 34 INCHES ABOVE FINISHED FLOOR AND A MAXIMUM OF 48 INCHES ABOVE FINISHED FLOOR.
- 9.) ALL EXISTING DOOR/FRAME SIZED TO BE FIELD VERIFIED.
- 10.) EXISTING DOOR HINGES TO REMAIN.


N

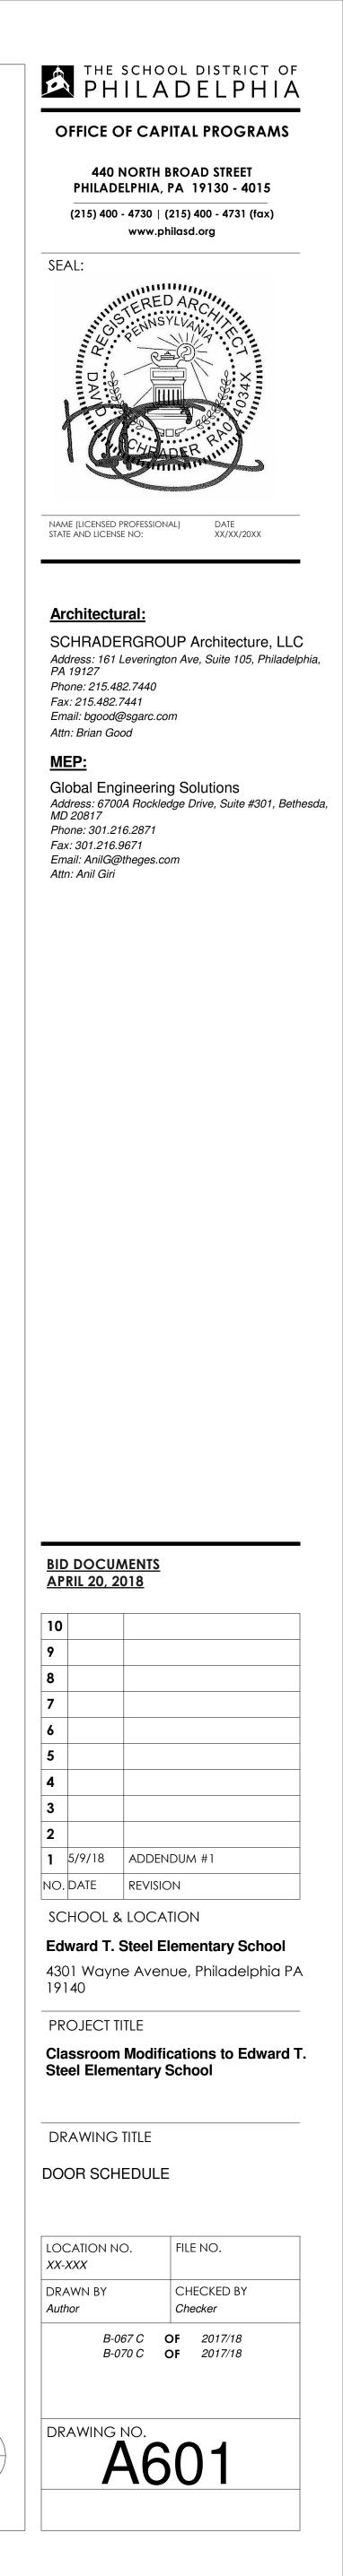


	ELECTRICAL NOTES	ELECTRICAL LEGEND	ELECTRICAL LEGEND
	DEMOLITION NOTES	DEMOLITION	LIGHTING
Α	 WHERE EXISTING FACILITIES ARE BEING ALTERED, DISCONNECT AND REMOVE OR RELOCATE AND EXTEND ALL EXISTING ELECTRICAL WORK THAT INTERFERES WITH OR IS NECESSARY DUE TO SCOPE OF RENOVATION AS SPECIFIED, SHOWN OR REQUIRED. CONTRACTOR TO RELOACTE ANY CONDUIT IN THE WAY OF NEW CONSTRUCTION. WHERE SPECIFIED OR REQUIRED, EXTEND EXISTING SYSTEMS OR TIE INTO SAME TO PROVIDE A COMPLETE COORDINATED ELECTRICAL SYSTEM TO SATISFACTION OF OWNER AND ENGINEER. ALL EXISTING WORK TO REMAIN ACTIVE, BUT DITURBED OR DISCONNECT DUE TO ALTERATIONS PER THIS RENOVATION SHALL BE REPLACED AND PUT IN OPERATING CONDITION AS REQUIRED TO MAINTAIN CONTINUITY UNLESS INSTRUCTED OTHERWISE IN WRITING BY OWNER OR ENGINEER. ALL DISCONNECTED OR ABANDONED WIRE, CABLE AND SURFACE CONDUIT OR RACEWAYS WITHIN THIS CONTRACT SHALL BE REMOVED. ALL EXISTING BUILDING MATERIALS DAMAGED DURING RENOVATIONS 	NOTE: REFER TO DEMOLITION DRAWINGS & NOTES FOR REQUIREMENTS. R: EXISTING TO BE REMOVED. E: EXISTING TO REMAIN. ER: EXISTING TO BE RELOCATED. RE: RELOCATED EXISTING DEVICE IN NEW LOCATION.	NOTE: REFER TO LIGHTING FIXTURE SCHEDULE FOR FIXTURE TYPES. A: CAPITAL LETTER ADJACENT TO FIXTURE INDICATES TYPE. a: LOWER CASE LETTER INDICATES SWITCHING. NL: INDICATES NIGHT LIGHTING - UNSWITCHED FIXTURE. • SHADED CIRCLE INDICATES FIXTURE ON EMERGENCY CIRCUIT. • SHADED CIRCLE INDICATES FIXTURE ON EMERGENCY CIRCUIT. • 2'X4' FLUORESCENT/LED LIGHT FIXTURE - SURFACE OR RECESSED. • 1'X4' FLUORESCENT/LED LIGHT FIXTURE - SURFACE/RECESSED/PENDANT. _ SQUARE DOWNLIGHT FIXTURE - SURFACE OR RECESSED.
Β	 SHALL BE REPAIRED AND REPLACED BY THE CONTRACTOR. THIS SHALL INCLUDE, BUT IS NOT LIMITED TO CEILING TILES, GRIDS, FLOORING, PARTITIONS AND SIMILAR BUILDING ELEMENTS. ALL DAMAGES TO EXISTING ELEMENTS SHALL BE REPAIRED TO A QUALITY AND FINISH LEVEL OF ADJACENT AREAS/SURFACES AND SUBJECT TO THE APPROVAL OF OWNER AND ENGINEER. PROVIDE PHYSICAL AND DUST PROTECTION OF OWNER'S EQUIPMENT, FURNITURE AND FLOORING DURING RENOVATION. EQUIPMENT PROTECTION SHALL BE INSTALLED AND REMOVED ON A DAILY BASIS AS DIRECTED BY OWNER. ALL ELECTRICAL WORK DAMAGED DURING RENOVATION SHALL BE REPAIRED AND REPLACED BY THE CONTRACTOR. THIS SHALL INCLUDE, BUT NOT LIMITED TO; RACEWAYS, WIREWAYS, BACKBOXES, LIGHTING FIXTURES, LAMPS, WIRING DEVICES AND SIMILAR ELECTRICAL EQUIPMENT. ALL DAMAGE SHALL BE REPAIRED TO A QUALITY LEVEL SUBJECT TO APPLICABLE CODE AND APPROVAL OF OWNER AND ENGINEER. PROVIDE A FINISH GRADE COVERPLATE FOR ALL WALL AND FLOOR BOX DEVICES TO BE REMOVED. EXISTING CONDUIT WIREWAYS AND BACKBOXES (IF IT IS AT CODE APPROVED HEIGHT) MAY BE REUSED, WHERE NOTED. THE CONTRACTOR SHALL FIELD VERIFY CONDUIT WIREWAYS AND BACKBOXES (IF IT IS AT CODE APPROVED HEIGHT) MAY BE REUSED, WHERE NOTED. THE CONTRACTOR SHALL FIELD VERIFY CONDUIT WIREWAYS AND BACKBOXES (IF IT IS AT CODE APPROVED HEIGHT) MAY BE REUSED, WHERE NOTED. THE CONTRACTOR SHALL FIELD VERIFY CONDUIT WIREWAYS AND BACKBOXES (IF IT IS AT CODE APPROVED HEIGHT) MAY BE REUSED, WHERE NOTED. THE CONTRACTOR SHALL FIELD VERIFY CONDUIT AND BOX SUITABILITY. PROVIDE NEW AS REQUIRED BY ACTUAL FIELD CONDITIONS. PROVIDE TOUCH-UP PAINT AND FINISH PAINTING AS REQUIRED IN AREAS AFFECTED BY REMOVAL OF EXISTING EQUIPMENT OR INSTALLTION OF NEW, FINISH AND QUALITY LEVEL SHALL MATCH ADJACENT AREAS AND BE SUBJECT TO APPROVAL OF OWNER AND ENGINEER. 	A.AMP AMPERES G, GND GROUND AB ABOVE GC GENERAL CONTRACTOR AC ALTERNATE CURRENT GFI GROUND FAULT INRERRUPTER AFF ABOVE FINISHED FLOOR IG ISOLATED GROUND ARCH ARCHITECTURAL, ARCHITECT INCAND INCANDESCENT BEL BELOW KAIC KILOAMP INTERRUPTING CURRENT BKR BREAKER KVA KILOVOLT AMPERES C CONDUIT KW KILOWATTS CEIL CEILING LT(S) LIGHT(S) CKT CIRCUIT M METER CM CENTIMETER MECH MECHAINCAL DC DISCONNECT SWITCH MLO MAIN LUGS ONLY DISC DISCONNECT SWITCH MLO MAIN LUGS ONLY DISC DISCONNECT SWITCH MLO MOUNTED EC ELECTRICAL CONTRACTOR NCE NATIONAL ELECTRICAL CODE EF EXHAUST FAN NO.# NUMBER ELEC ELECTRICAL CONTRACTOR NCE NATIONAL ELECTRICAL CODE EF EXHAUST FAN NO.# <td> CIRCULAR DOWN LIGHT FIXTURE - RECESSED. EMERGENCY BATTERY PACK LIGHT FIXTURE. CEILING/WALL MOUNTED EXIT SIGN - SINGLE FACE. PROVIDE DIRECTIONAL ARROWS PER PLANS. CEILING/WALL MOUNTED EXIT SIGN - DOUBLE FACE. PROVIDE DIRECTIONAL ARROWS PER PLANS. CEILING/WALL MOUNTED EXIT SIGN - DOUBLE FACE. PROVIDE DIRECTIONAL ARROWS PER PLANS. 20A, 1P, 120/277V TOGGLE TYPE LIGHT SWITCH. S 20A, 3-WAY, 120/277V TOGGLE TYPE LIGHT SWITCH. DIMMER SWITCH. NUMBER INDICATES WATTAGE. CEILING MOUNTED DUAL TECHNOLOGY OCCUPANCY SENSOR. SIMILAR TO LUTRON MODEL # LOS-CDT-1000-WH OR APPROVED EQUAL. PP POWER PACK SIMILAR TO LUTRON MODEL #PP-DV OR AN APPROVED EQUAL </td>	 CIRCULAR DOWN LIGHT FIXTURE - RECESSED. EMERGENCY BATTERY PACK LIGHT FIXTURE. CEILING/WALL MOUNTED EXIT SIGN - SINGLE FACE. PROVIDE DIRECTIONAL ARROWS PER PLANS. CEILING/WALL MOUNTED EXIT SIGN - DOUBLE FACE. PROVIDE DIRECTIONAL ARROWS PER PLANS. CEILING/WALL MOUNTED EXIT SIGN - DOUBLE FACE. PROVIDE DIRECTIONAL ARROWS PER PLANS. 20A, 1P, 120/277V TOGGLE TYPE LIGHT SWITCH. S 20A, 3-WAY, 120/277V TOGGLE TYPE LIGHT SWITCH. DIMMER SWITCH. NUMBER INDICATES WATTAGE. CEILING MOUNTED DUAL TECHNOLOGY OCCUPANCY SENSOR. SIMILAR TO LUTRON MODEL # LOS-CDT-1000-WH OR APPROVED EQUAL. PP POWER PACK SIMILAR TO LUTRON MODEL #PP-DV OR AN APPROVED EQUAL
C	 PERFORM ALTERATIONS AND CONNECTION TO EXISTING FACILITIES WITH A MINIMUM INTERRUPTION. WHERE INTERRUPTION IS REQUIRED, PREPARE A TIME SCHEDULE AND DURATION, COORDINATE AND OBTAIN WRITTEN APPROVAL FROM PRINCIPAL AND OWNER (SDP). PROVIDE AND PLACE NOTICES IN AFFECTED AREAS AND ON FIXTURES OR EQUIPMENT WHICH WILL BE TEMORARILY OUT OF USE. REMOVE NOTICES WHEN INTERRUPTION IS COMPLETE. DISCONNECT AND REMOVE ALL EXISTING SWITCHES AND LIGHT FIXTURES. REMOVE EXISTING LIGHT FIXTURE OR REUSE AND CONNECTION FOR NEW LIGHTING CIRCUITS FOR REUSE AND CONNECTION FOR NEW LIGHTING FIXTURES WRING. DURING RENOVATION PROVIDE ALL TEMPORARY LIGHTING AND POWER AS REQUIRED. COORDINATE WITH ALL OTHER TRADES FOR TEMPORARY POWER REQUIREMENTS. ALL DEMOLITION/REMOVAL SHALL BE PERFORMED IN A NEAT, WORKMANLIKE MANNER WITH GREAT EMPHASIS ON MINIMIZING COLLATERAL DAMAGE. THE CONTRACTOR SHALL BE RESPONSIBLE FOR THE REMOVAL OF ALL DEMOLISHED MATERIALS FROM THE SITE AND DISPOSAL THEREOF, UNLESS SPECIFICALLY NOTED OTHERWISE. IT IS INTENDED THAT ALL SURFACE BOXES, CONDUIT AND CABLES BE REMOVED. ALL WIRING TO BE REMOVED BOXES AND CONDUIT EMBEDDED IN CONCRETE OR WALLS MAY REMAIN, CONDUIT TO BE CUT AT WALL BOUNDARY, BOXES TO BE COVERED WITH A STAINLESS STEEL BLANK COVER. 	FAOP FIRE ALARM CONTROL PANEL NM ROUM FAAP FIRE ALARM ANNUNCIATOR PANEL TELE TELEPHONE FIXT FIXTURE TYP TYPICAL FLA FULL LOAD AMPERES UON UNLESS OTHERWISE NOTED FLUOR FLUORESCENT V VOLTS W WATTS W WATTS W/ WITH WP WEATHERPROOF GENERAL # INDICATES PLAN NOTE. # INDICATES REVISION. CLOUDED AREA CONTAINS THE REVISION. # INDICATES ROOM NUMBER. O CONDUIT HOMERUN	
			POWER
D	CODES 1. PENNSYLVANIA UNIFORM CONSTRUCTION CODE (PA UCC) 2. PHILADELPHIA EXISTING BUILDING CODE (2009) 3. INTERNATIONAL BUILDING CODE (IBC 2003) 4. PHILADELPHIA ENERGY CONSERVATION CODE 5. PHILADELPHIA FIRE CODE 6. PHILADELPHIA ELECTRICAL CODE 7. PHILADELPHIA PERFORMANCE CODE 8. PENNSYLVANIA DEPARTMENT OF EDUCATION REGULATION		NOTES: REFER TO ARCHITECTURAL DRAWINGS AND ELEVATIONS FOR EXACT LOCATION AND MOUNTING HEIGHTS. WP: WEATHER PROOF (NEMA 3R) IG: ISOLATED GROUND. GFI: GROUND FAULT INTERRUPTER. GFCI: GROUND FAULT CIRCUIT INTERRUPTER. O WALL MOUNTED 20A SINGLE RECEPTACLE (18" AFF UON). O WALL MOUNTED 20A DUPLEX RECEPTACLE. (18" AFF UON). Image: Transmission of the structure of t
Е			T FLOOR MOUNTED 20A DUPLEX TAMPER RESISTANT RECEPTACLE. ① CEILING MOUNTED 20A SIMPLEX RECEPTACLE. ① CEILING MOUNTED 20A DUPLEX RECEPTACLE. ① CEILING MOUNTED QUADRUPLEX RECEPTACLE. ① FLOOR MOUNTED 20A SIMPLEX RECEPTACLE. ① FLOOR MOUNTED 20A SIMPLEX RECEPTACLE. ① FLOOR MOUNTED 20A DUPLEX RECEPTACLE. ① FLOOR MOUNTED 20A DUPLEX RECEPTACLE. ① FLOOR MOUNTED 20A QUADRUPLEX RECEPTACLE. ① FLOOR MOUNTED 20A QUADRUPLEX RECEPTACLE. ① FLOOR MOUNTED 20A QUADRUPLEX RECEPTACLE. ① CEILING MOUNTED JUNCTION BOX. 〕 VALL MOUNTED JUNCTION BOX. 〕 VALL MOUNTED JUNCTION BOX. 〕 DISCONNECT SWITCH - NON-FUSED. ■ SURFACE MOUNTED PANEL. ■ RECESSED PANEL.
F			

2 3 4

1

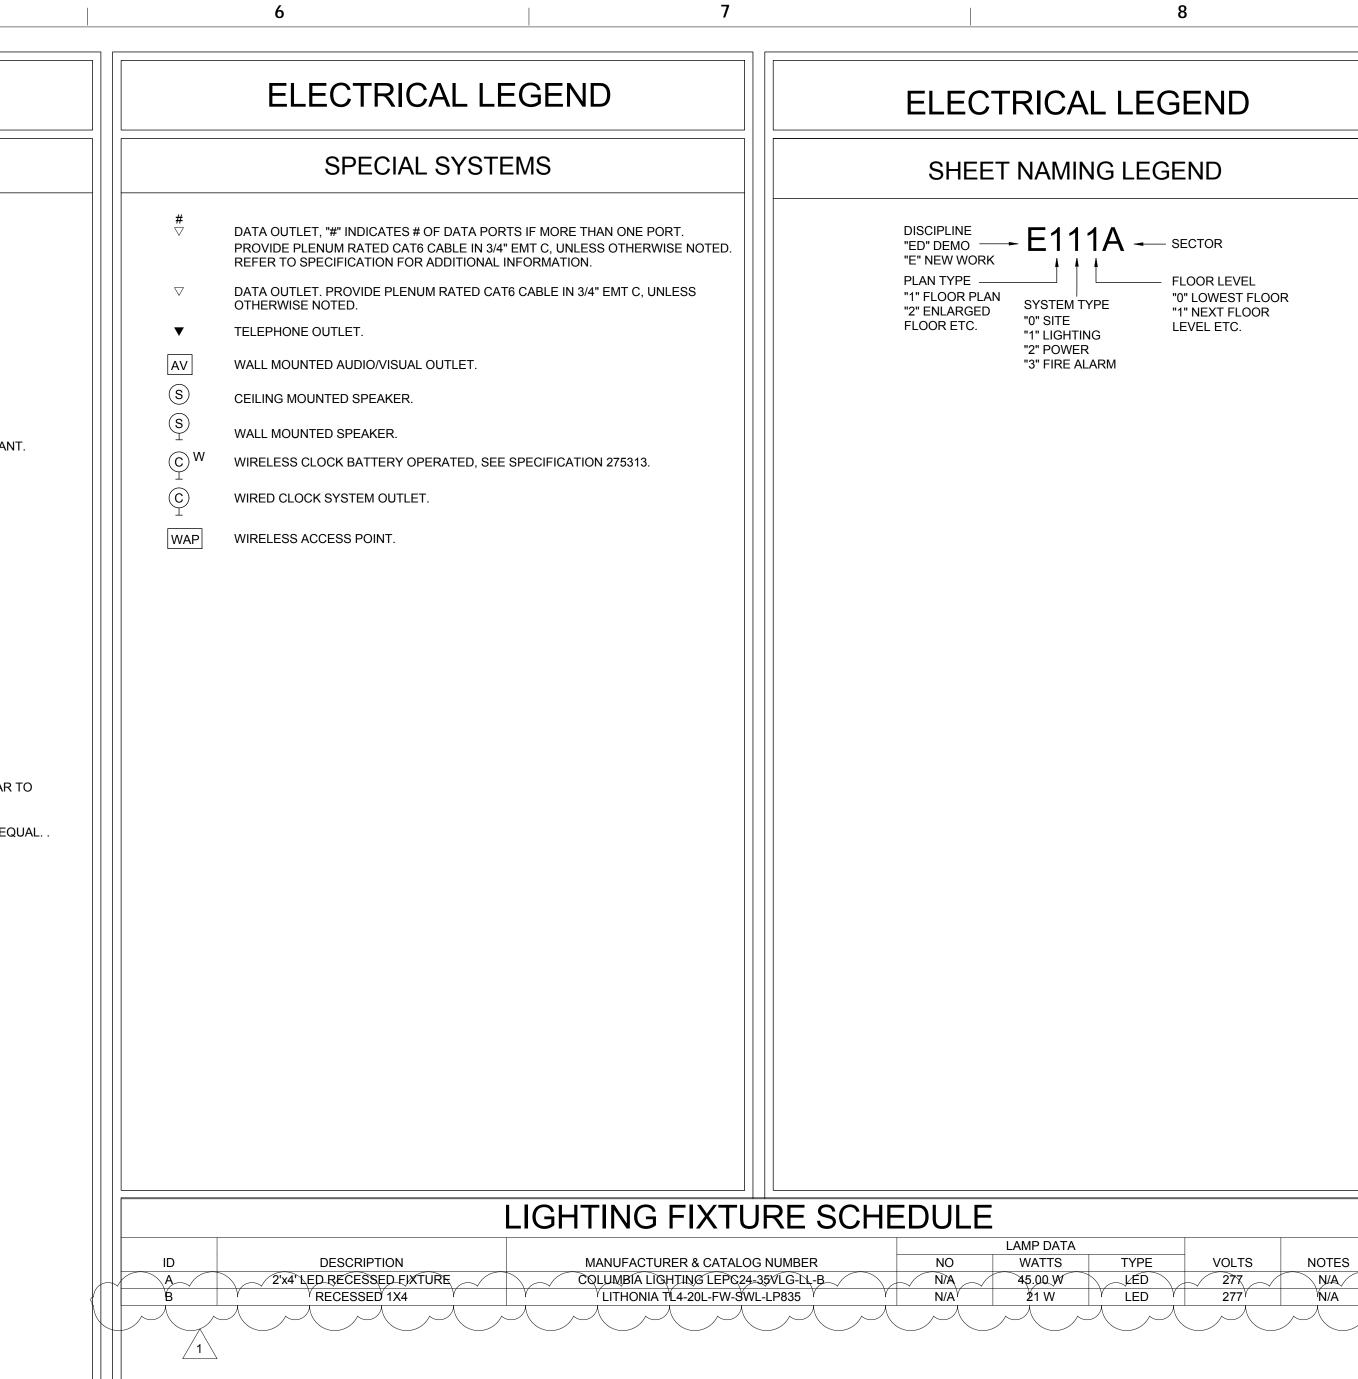


<section-header>EXAMPLADELPHIA DEFICICATION DECOMPLICATION DEFICICATION DECOMPLIA AGNORTH BROAD STREET Independent of the the the the the the the the the the</section-header>
<section-header><section-header><section-header><section-header><section-header><section-header><text><text><text><text><text><text><text><text><text><text></text></text></text></text></text></text></text></text></text></text></section-header></section-header></section-header></section-header></section-header></section-header>
BID DOCUMENTS APRIL 20, 2018
APRIL 20, 2018
APRIL 20, 2018
APRIL 20, 2018 Image: Constraint of the second state of the s
APRIL 20, 2018 April
APRIL 20, 2018 April 2018

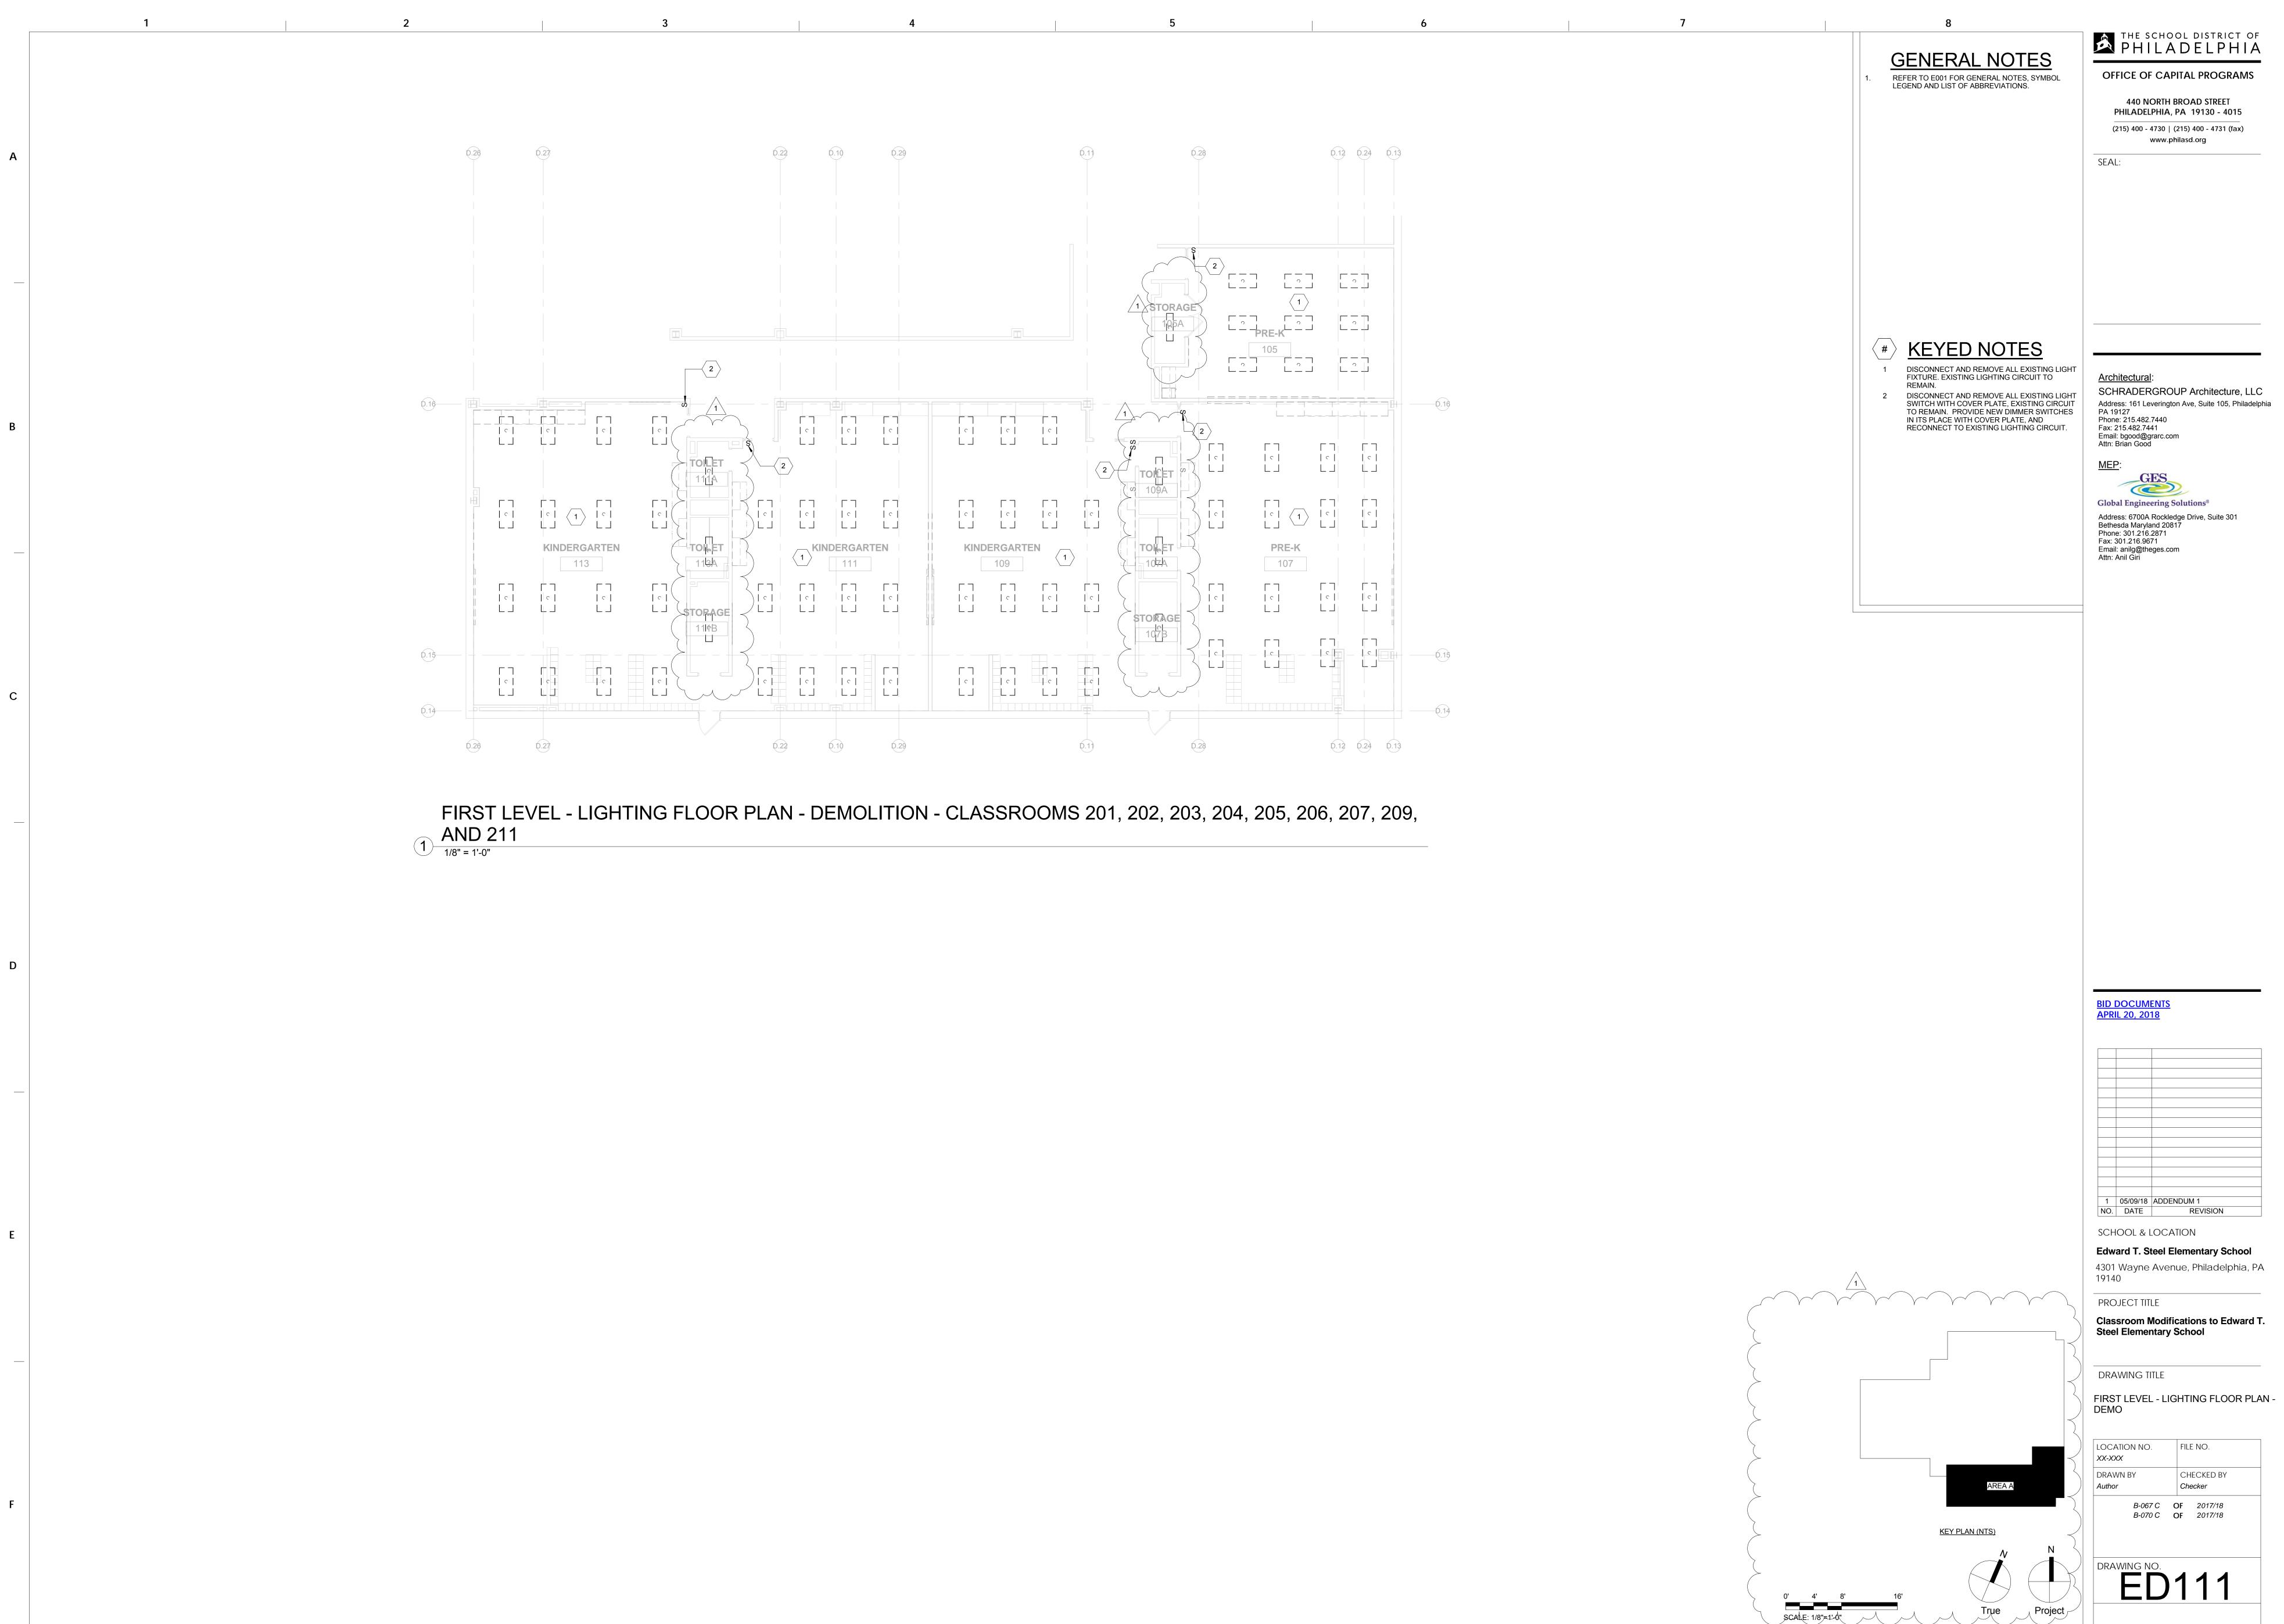


	1	2	
Α			
Β			
С			
D			
Ε			
F			



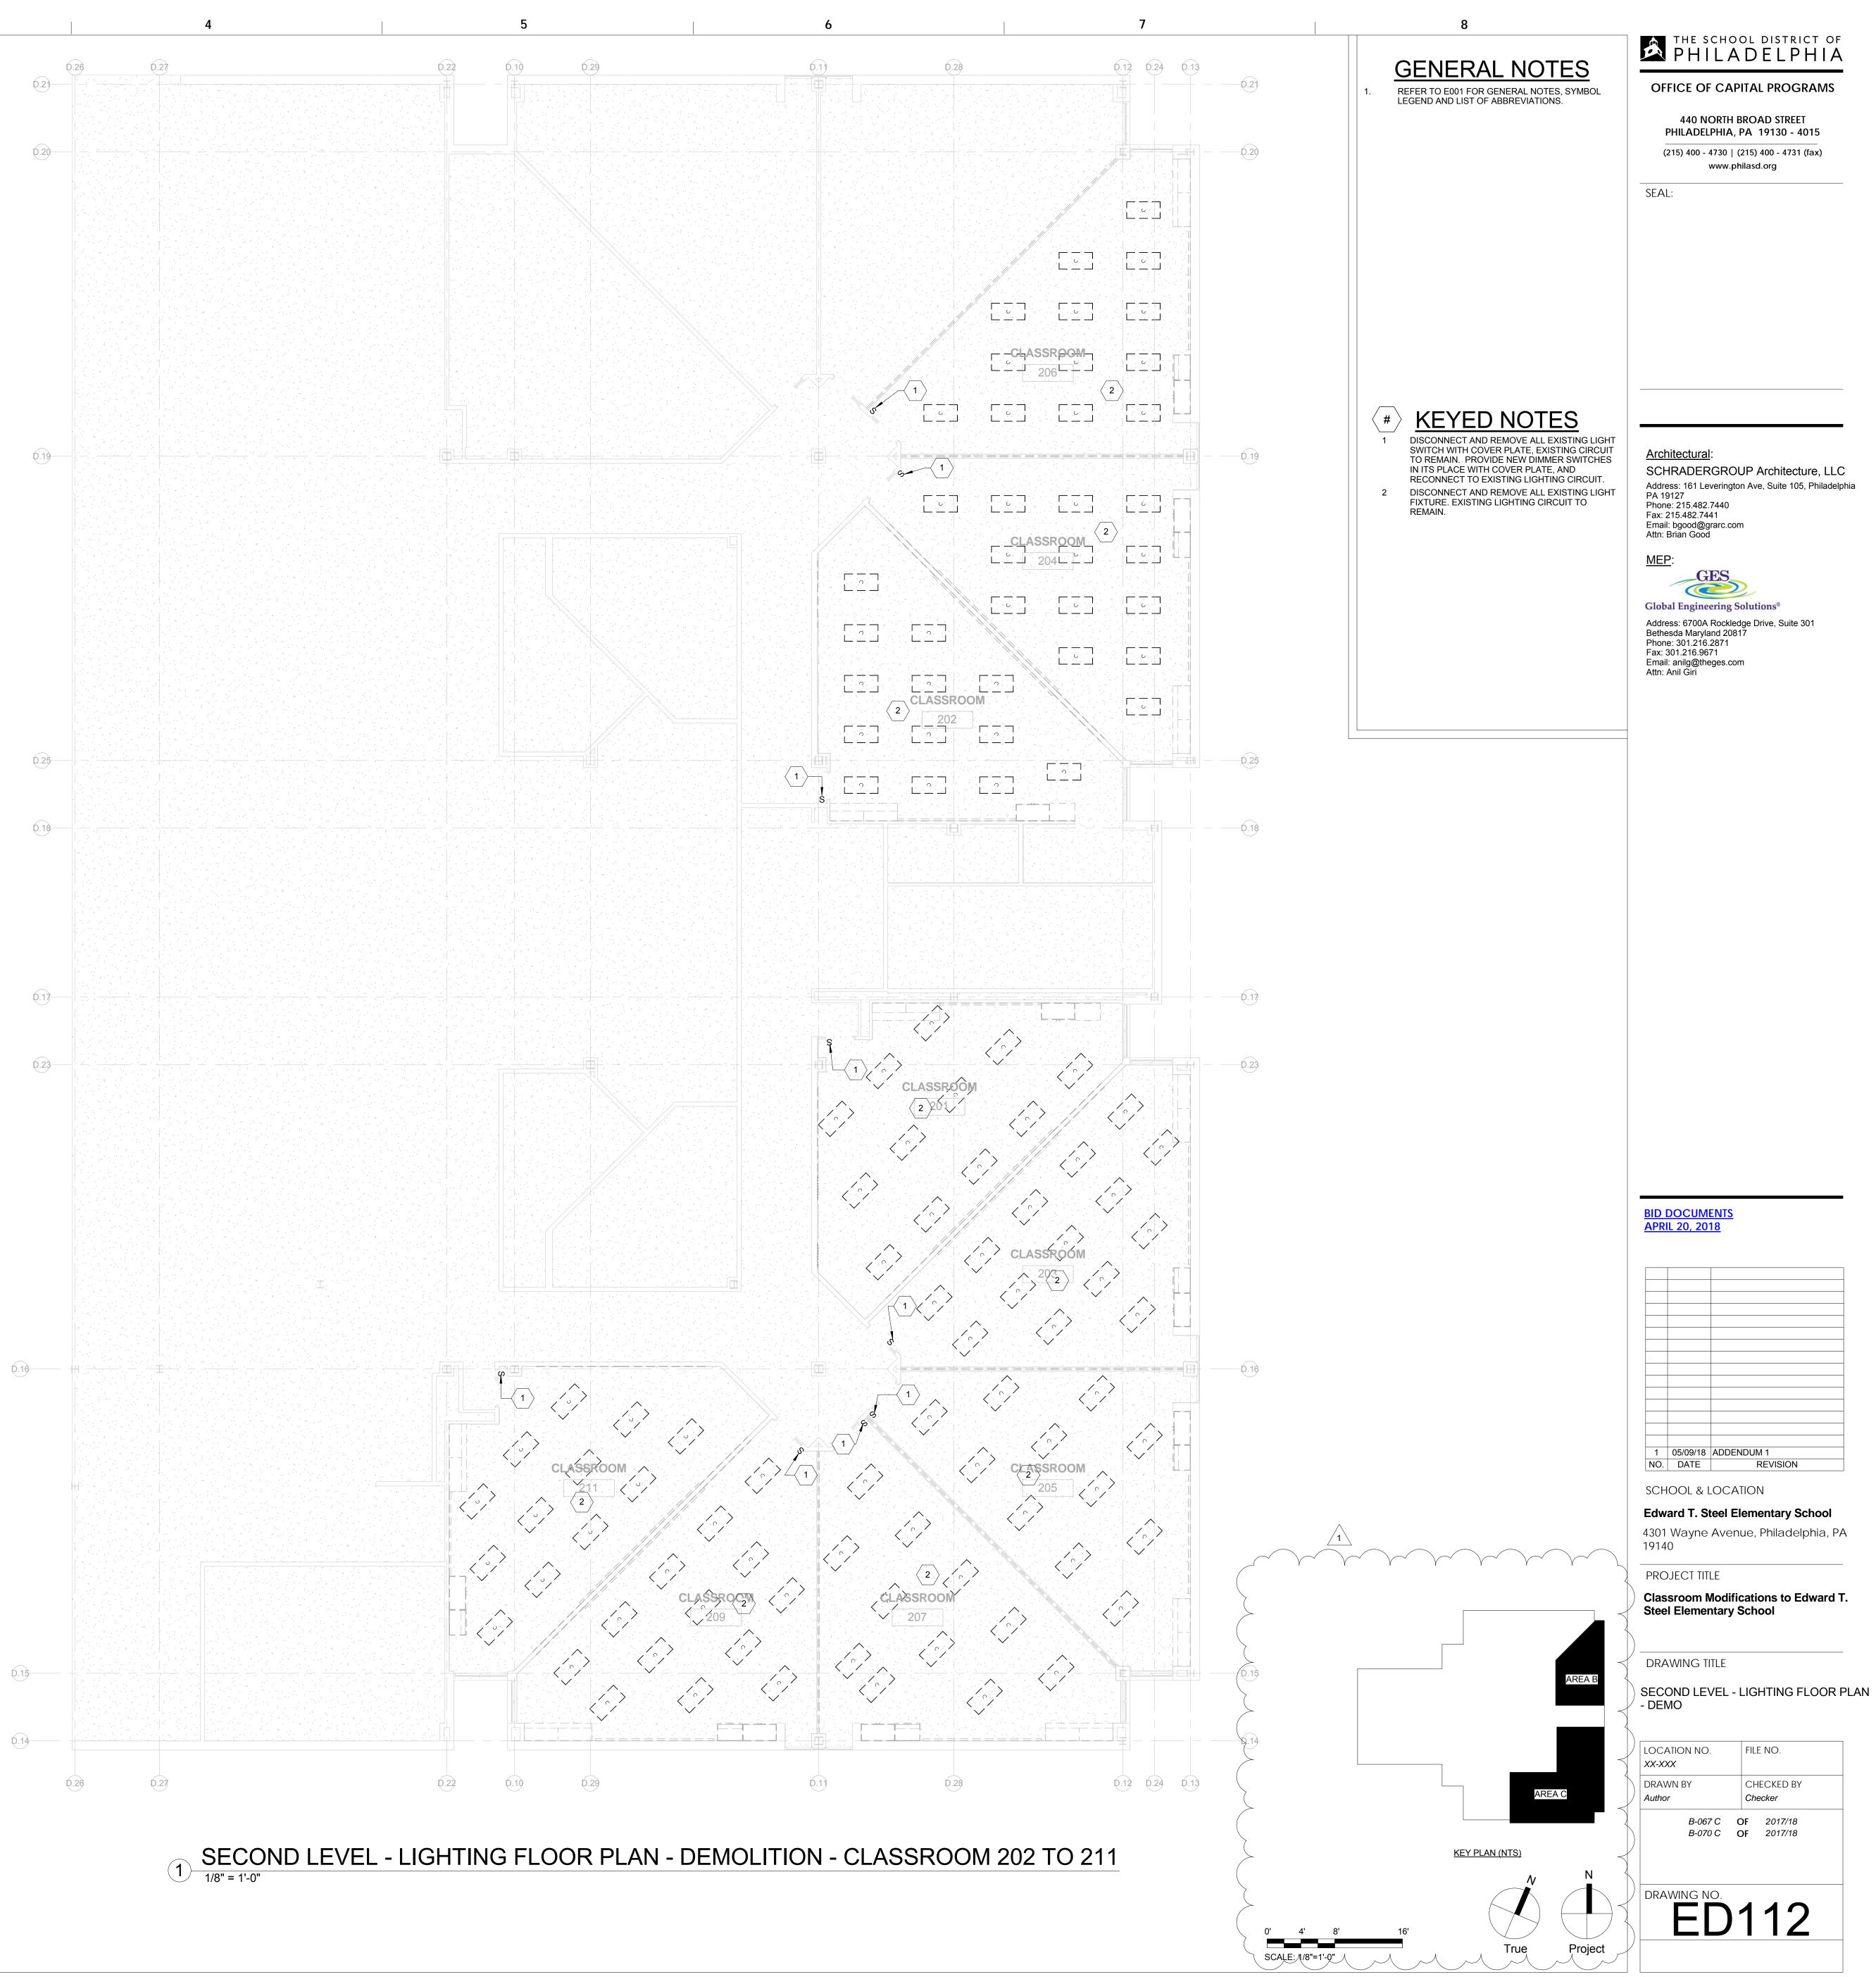

	1	2	
А			
			0.26
В			
			0.16
С			
			Q.15
			0.14
			0.26
D			
E			
F			

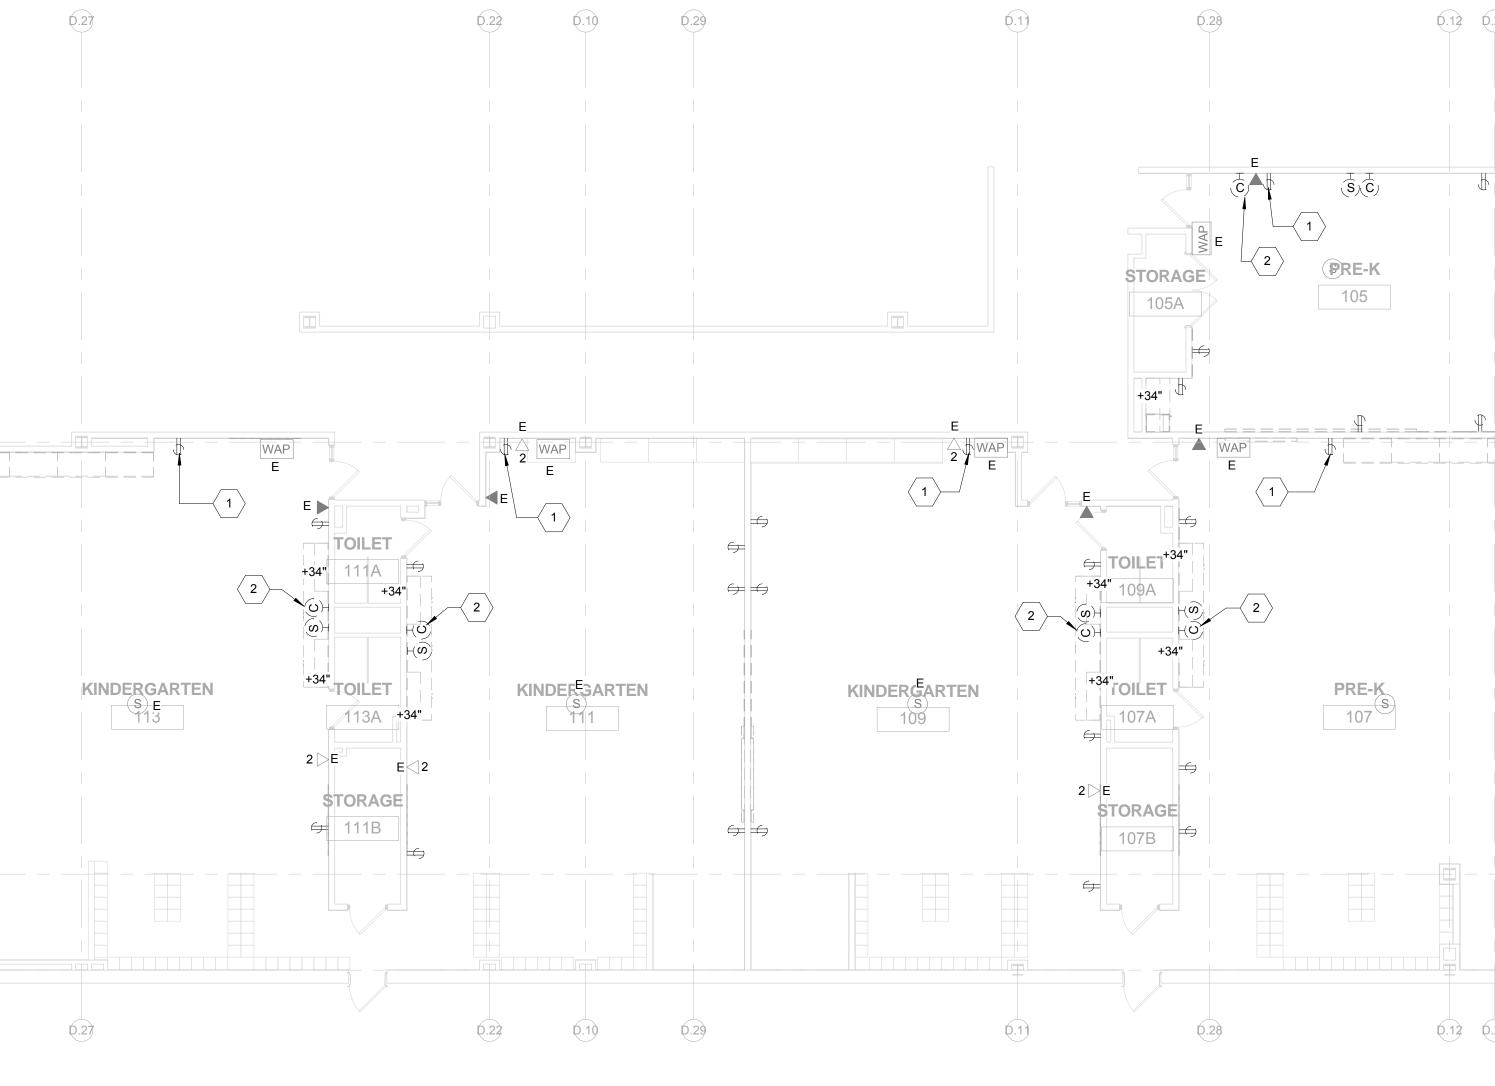

1 FIRST LEVEL - POWER FLOOR PLAN - DEMOLITION- CLASSROOM 105 TO 113

5

6

Z.▲H

~ 2

F

(S)(C)


PRE-K


105

_ ____

PRE-K

107^(S)

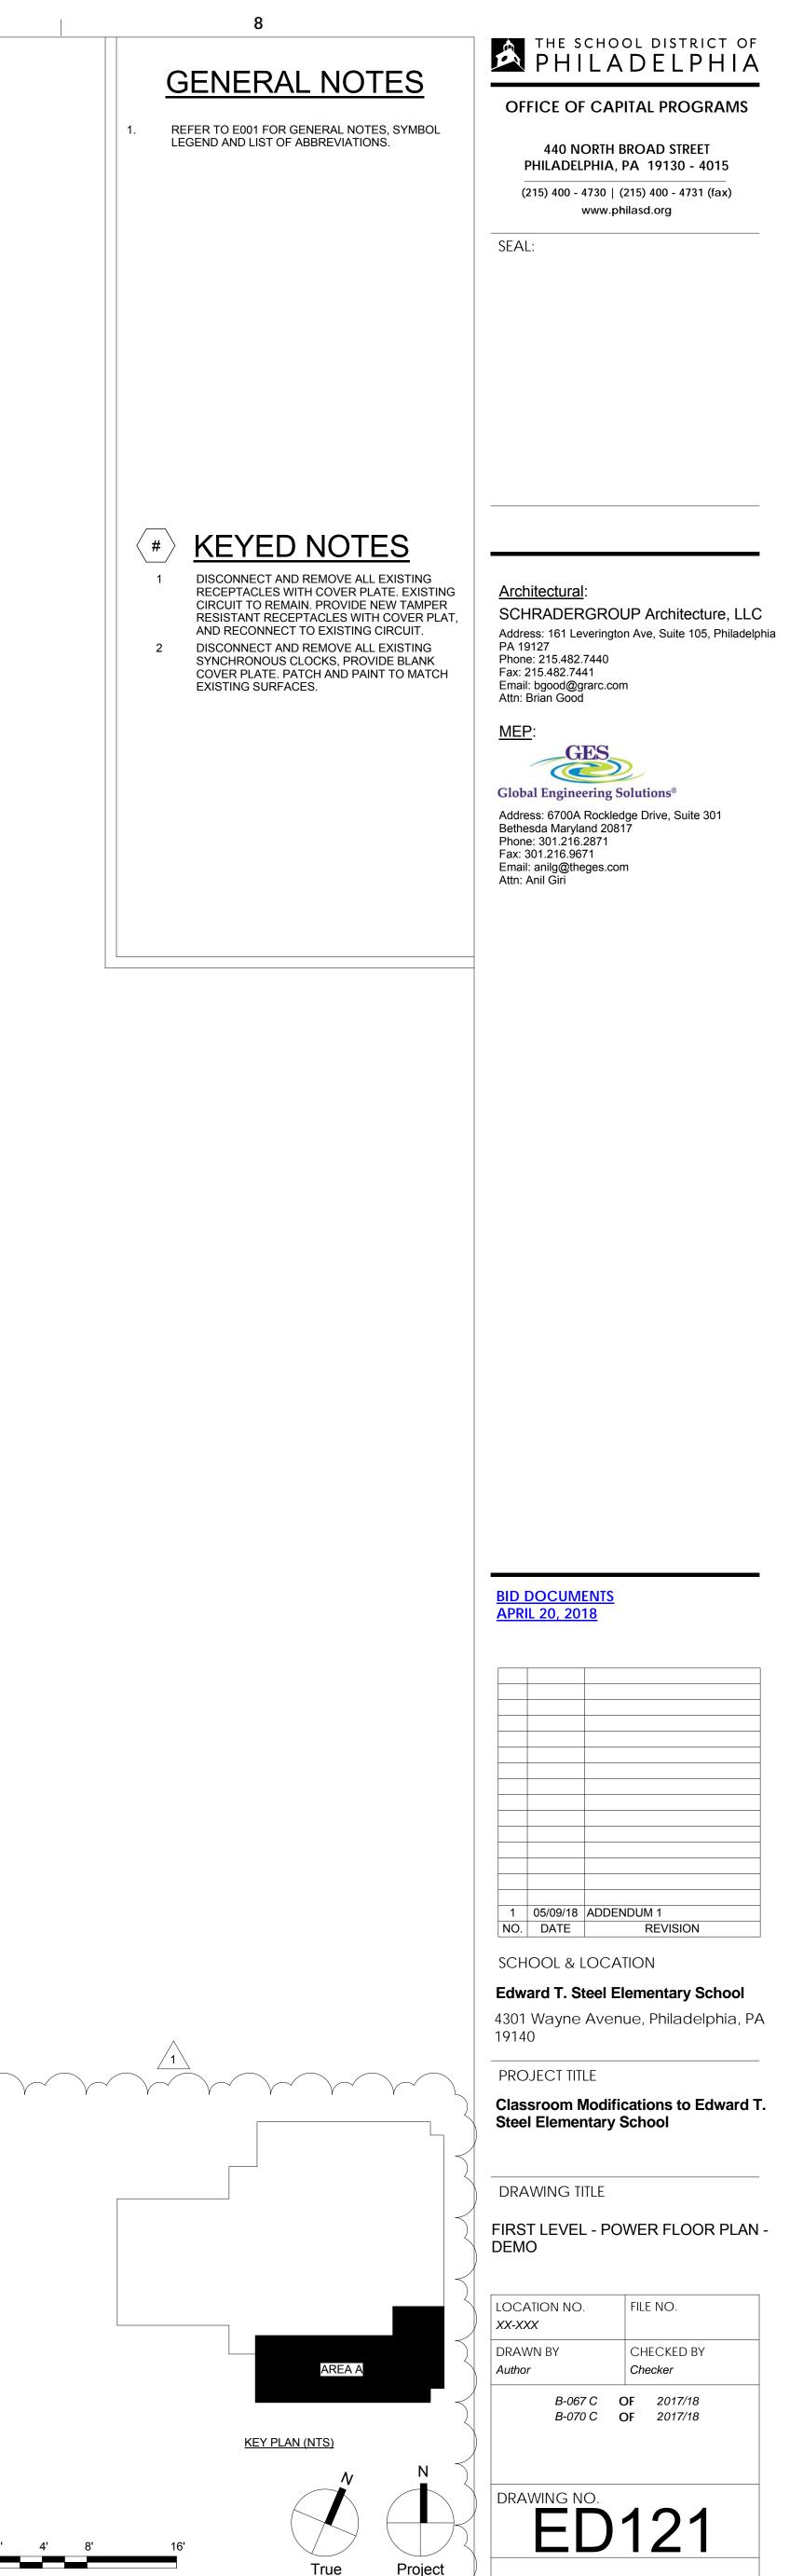

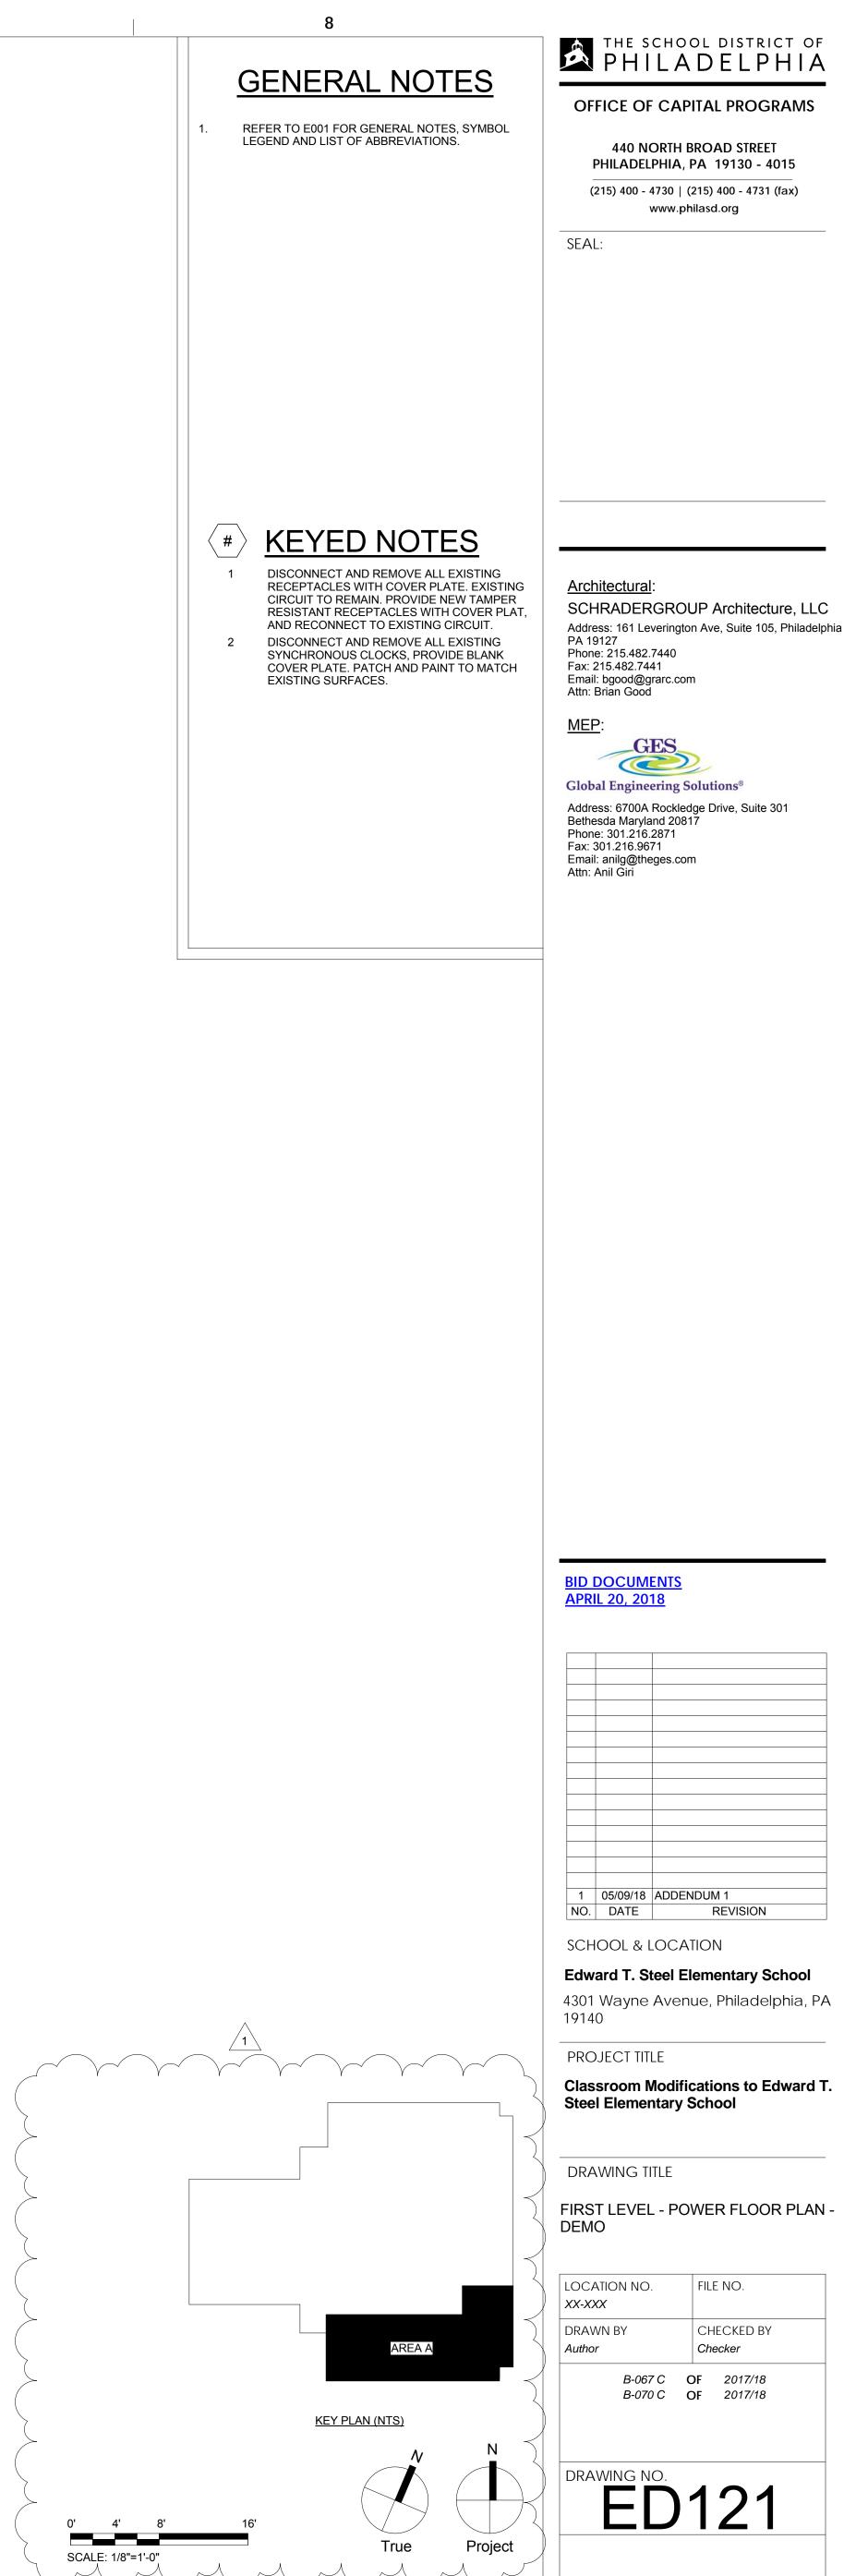

7

_____Ó.16

Q.12 Q.24 Q.13


 \ominus

D.12 D.24 D.13

_____D.14


	1	2	
Α			
Β			
С			
D			
Ε			
F			




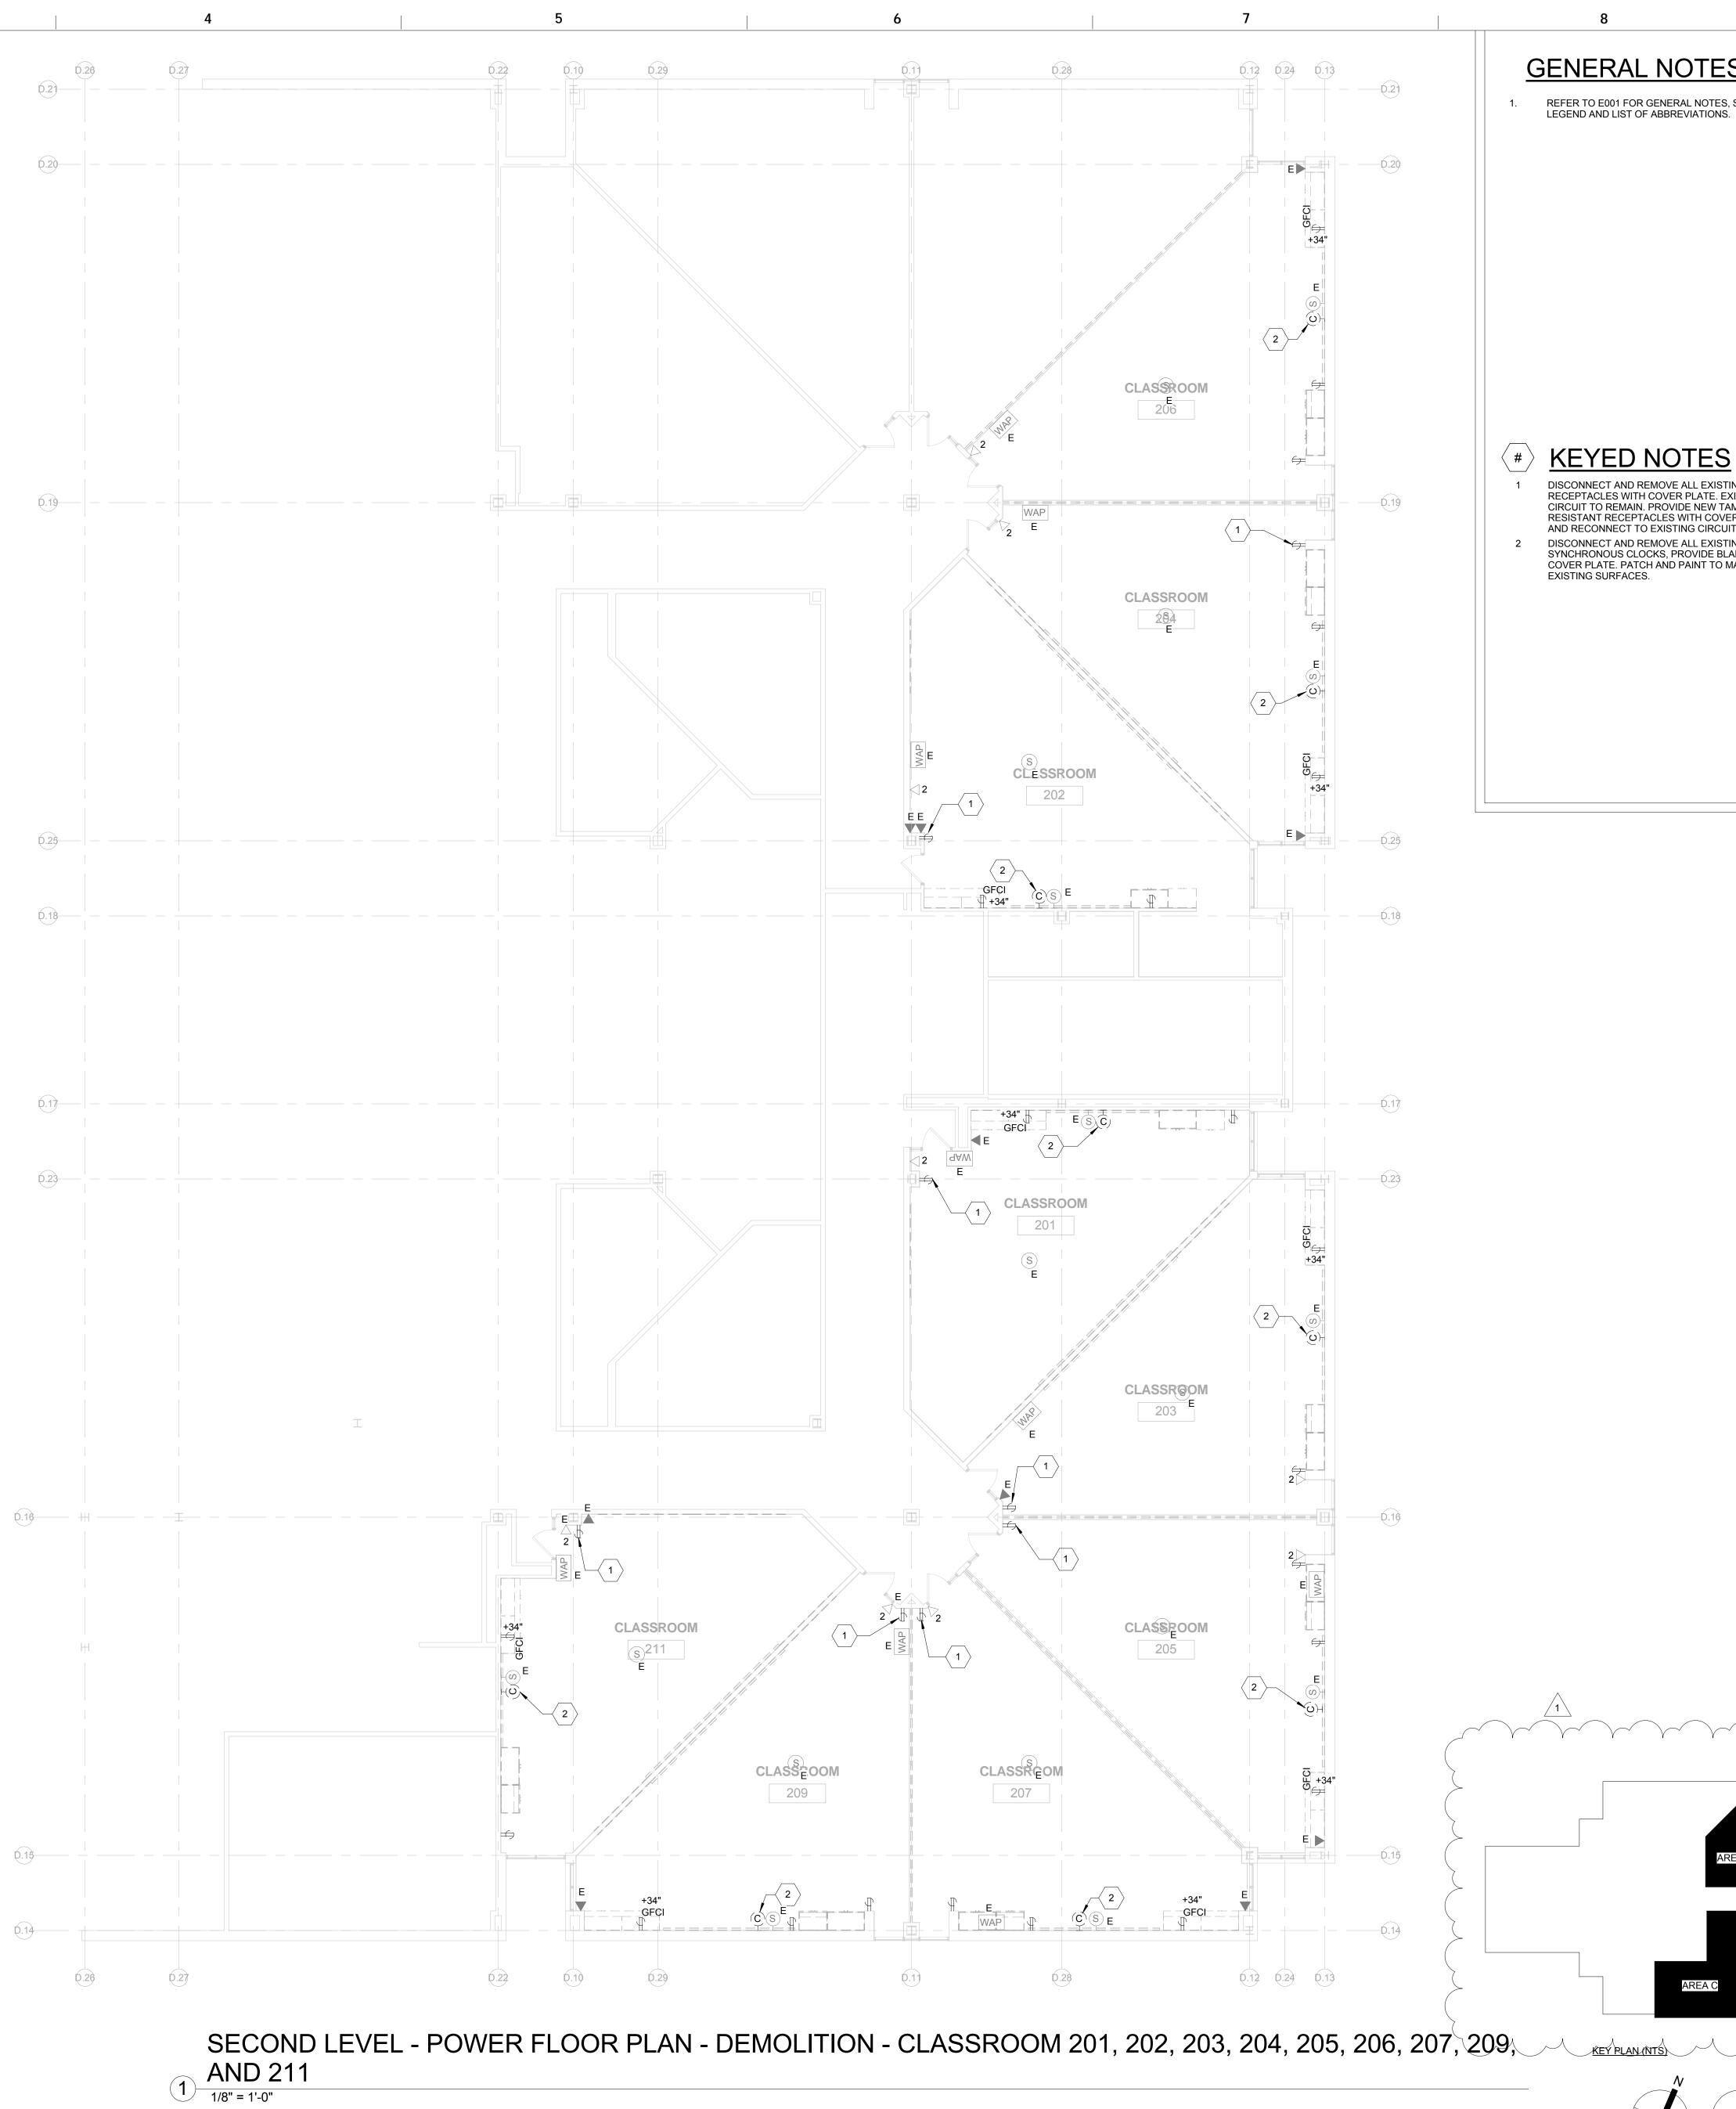



True


	THE SCHOOL DISTRICT OF
S	PHILADELPHIA
S, SYMBOL	OFFICE OF CAPITAL PROGRAMS
	440 NORTH BROAD STREET PHILADELPHIA, PA 19130 - 4015
	(215) 400 - 4730 (215) 400 - 4731 (fax) www.philasd.org
	SEAL:
<u>S</u>	
- FING EXISTING AMPER	Architectural:
ER PLAT, JIT. FING	SCHRADERGROUP Architecture, LLC Address: 161 Leverington Ave, Suite 105, Philadelphia PA 19127
_ANK MATCH	Phone: 215.482.7440 Fax: 215.482.7441 Email: bgood@grarc.com Attn: Brian Good
	MEP:
	Global Engineering Solutions®
	Address: 6700A Rockledge Drive, Suite 301 Bethesda Maryland 20817 Phone: 301.216.2871
	Fax: 301.216.9671 Email: anilg@theges.com Attn: Anil Giri
	BID DOCUMENTS APRIL 20, 2018
	105/09/18ADDENDUM 1NO.DATEREVISION
	SCHOOL & LOCATION Edward T. Steel Elementary School
	4301 Wayne Avenue, Philadelphia, PA 19140
	PROJECT TITLE
	Classroom Modifications to Edward T. Steel Elementary School
$\left \right\rangle$	SECOND LEVEL - LIGHTING FLOOR PLAN - NEW
	LOCATION NO. FILE NO.
	XX-XXX DRAWN BY CHECKED BY
	Author Checker B-067 C OF 2017/18
	B-070 C OF 2017/18
N	DRAWING NO.
	ED122
Project	

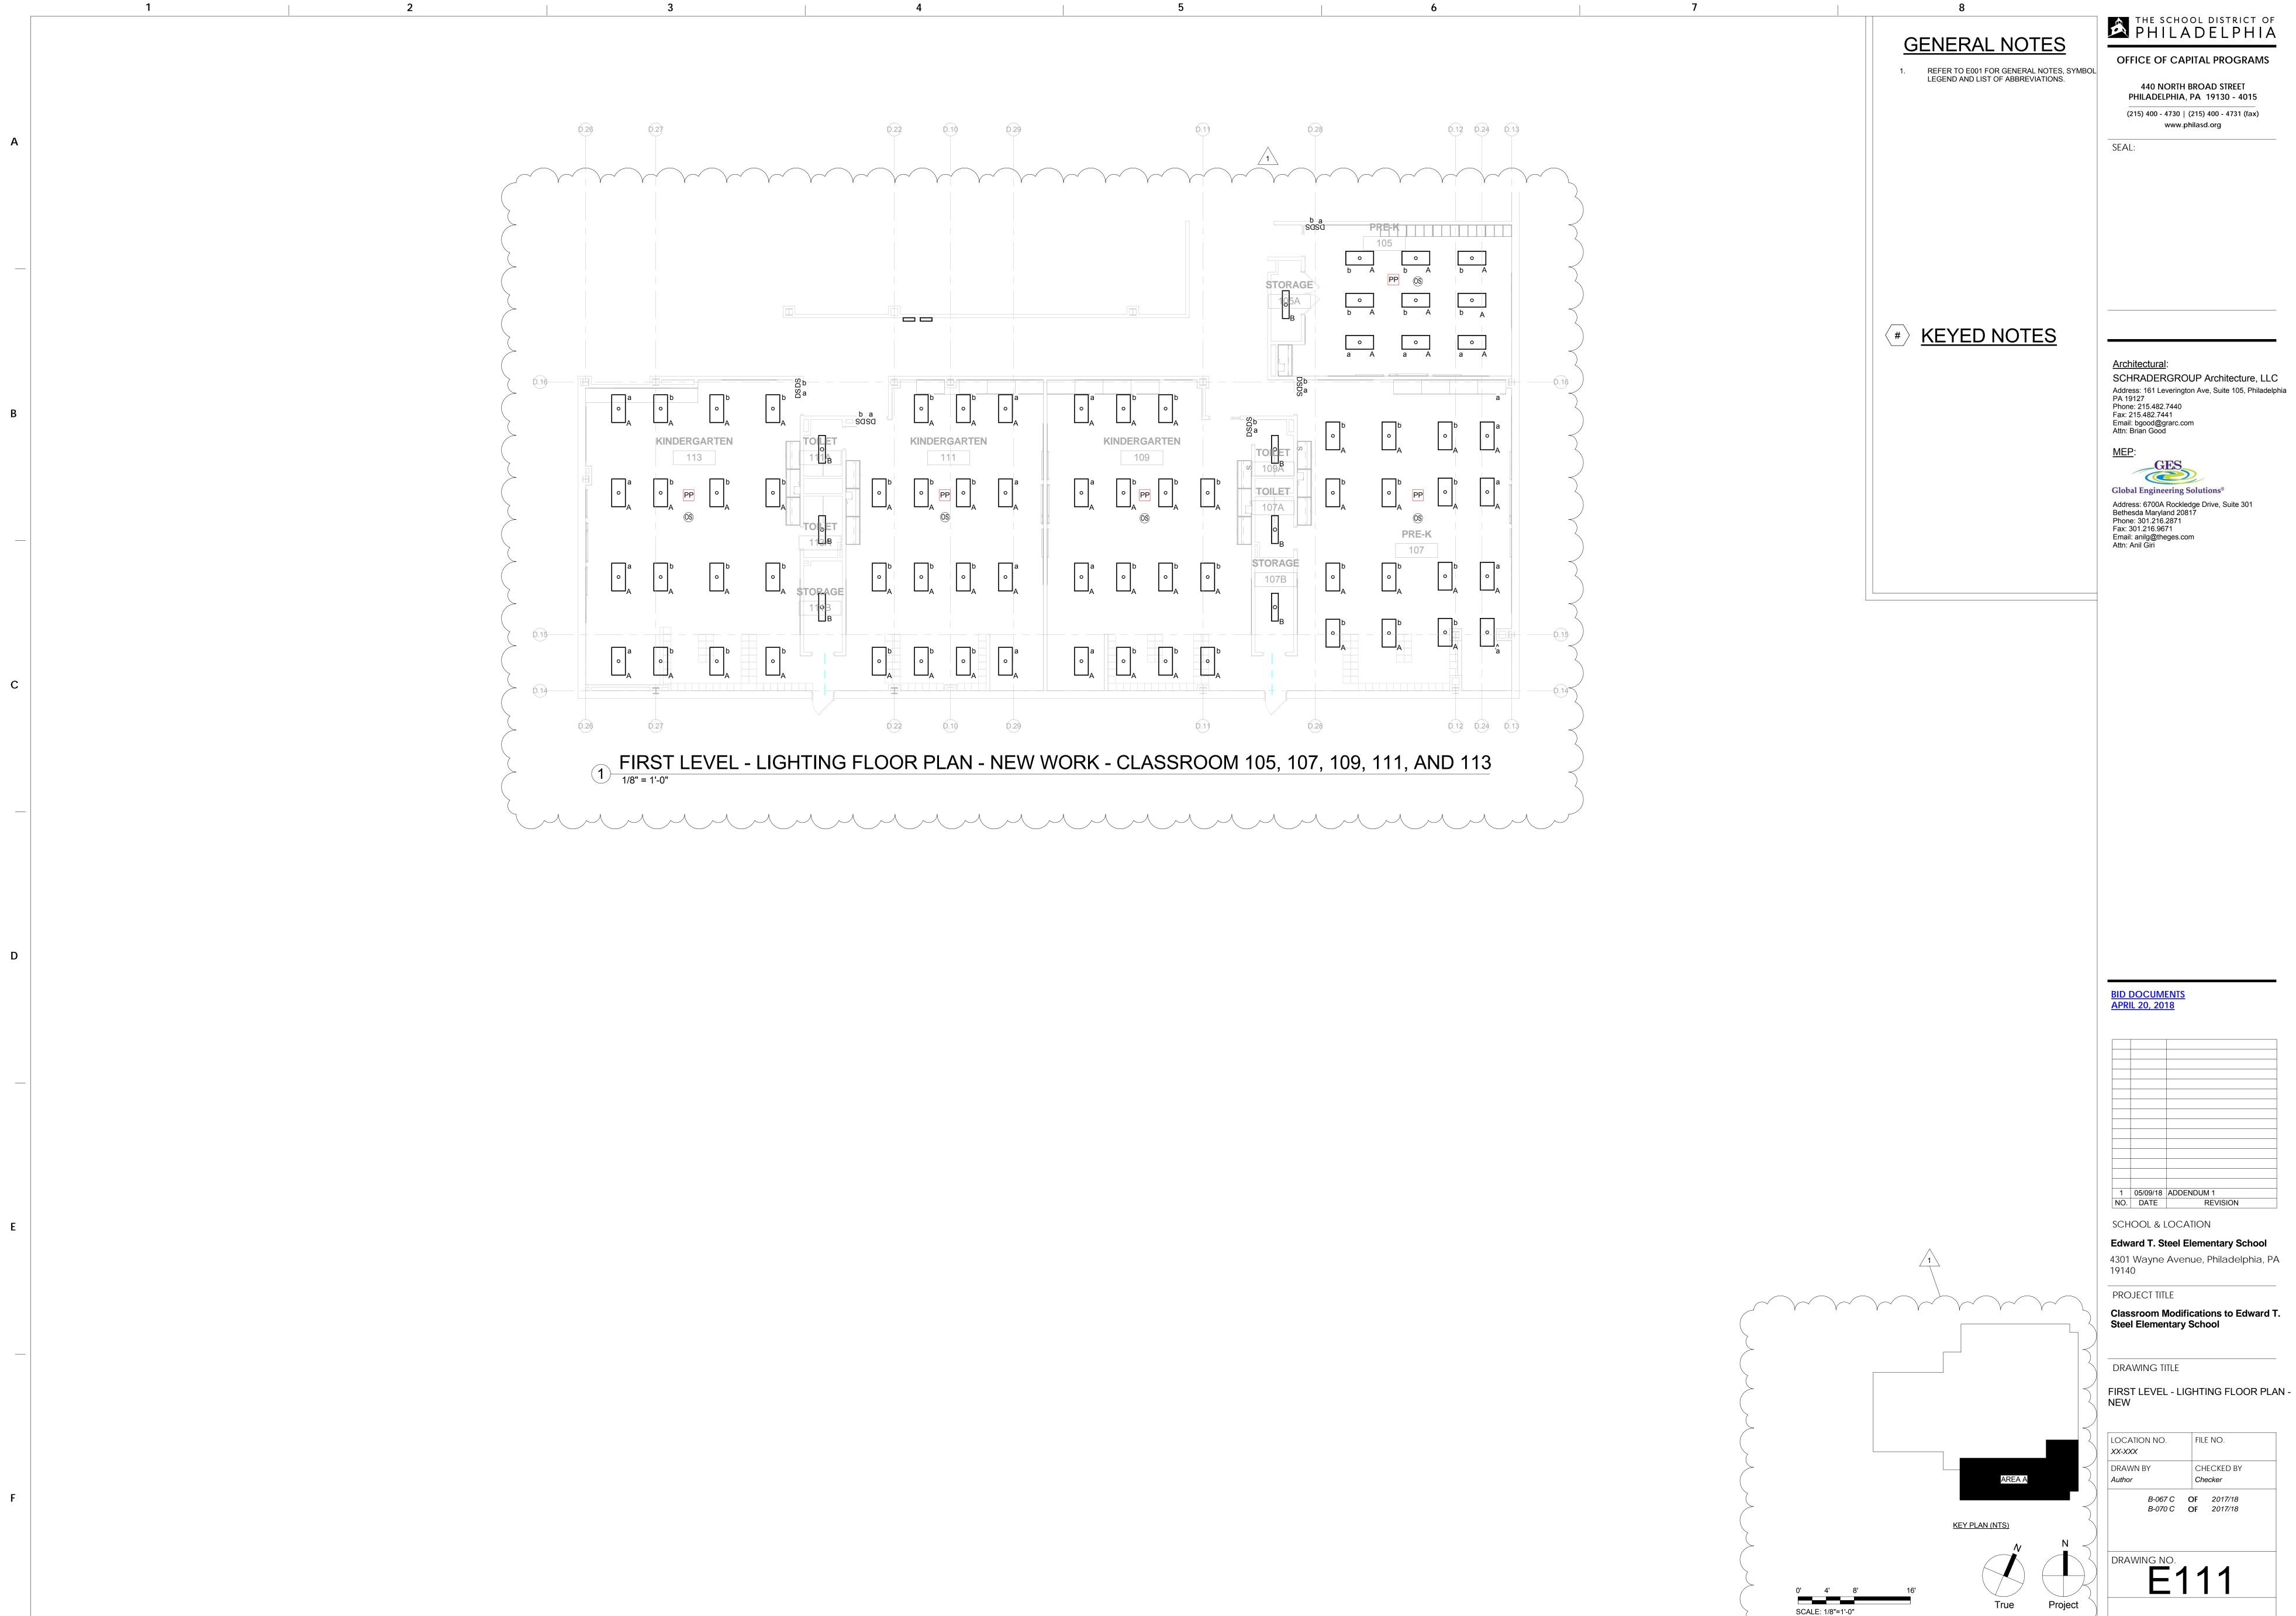

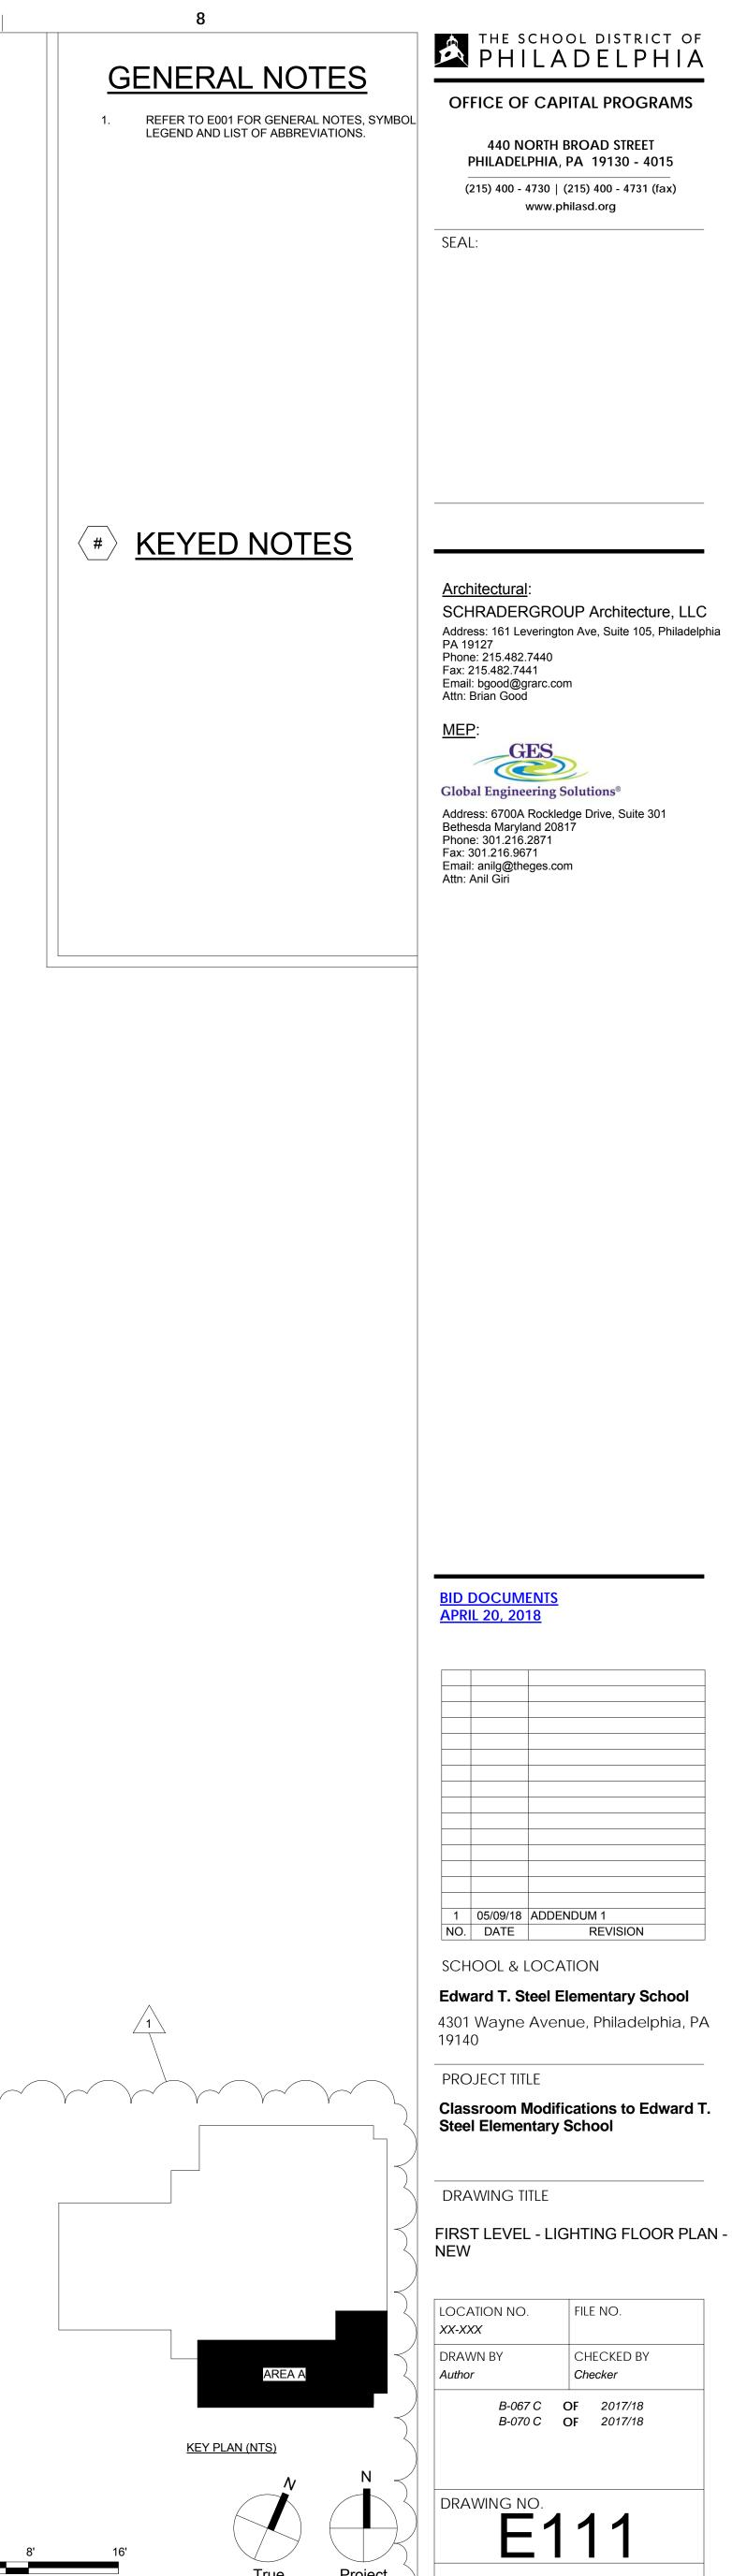


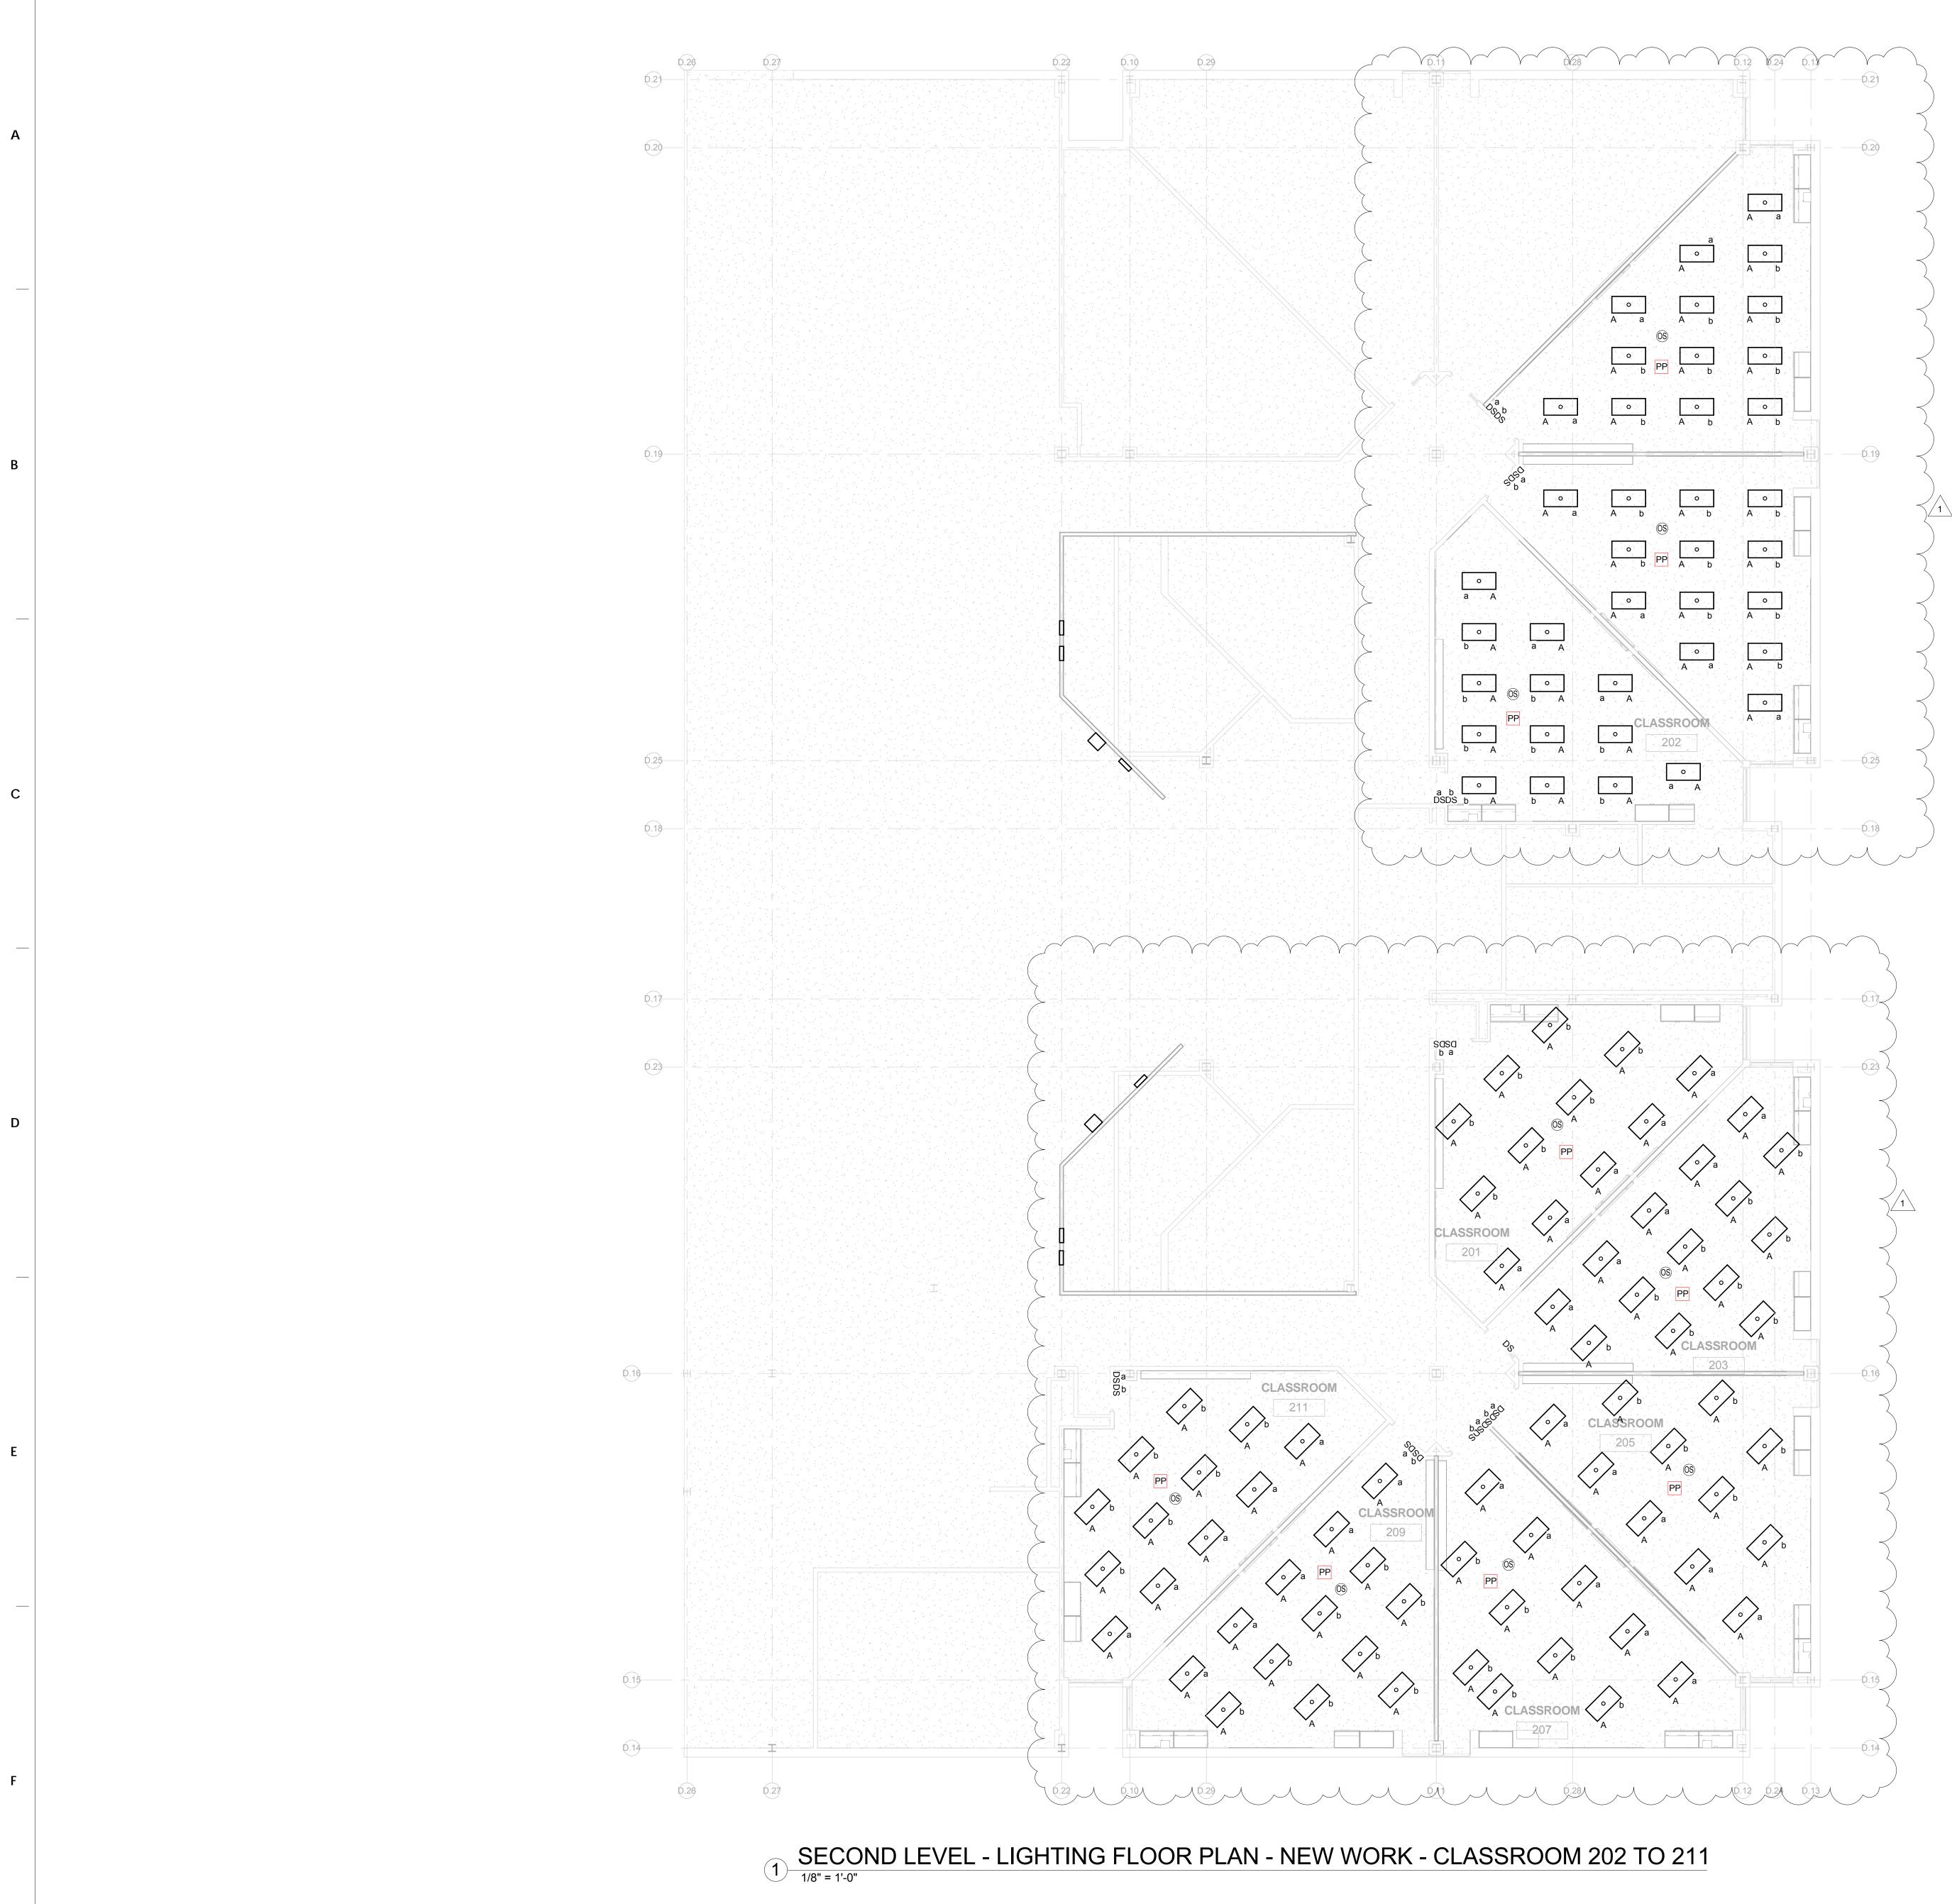


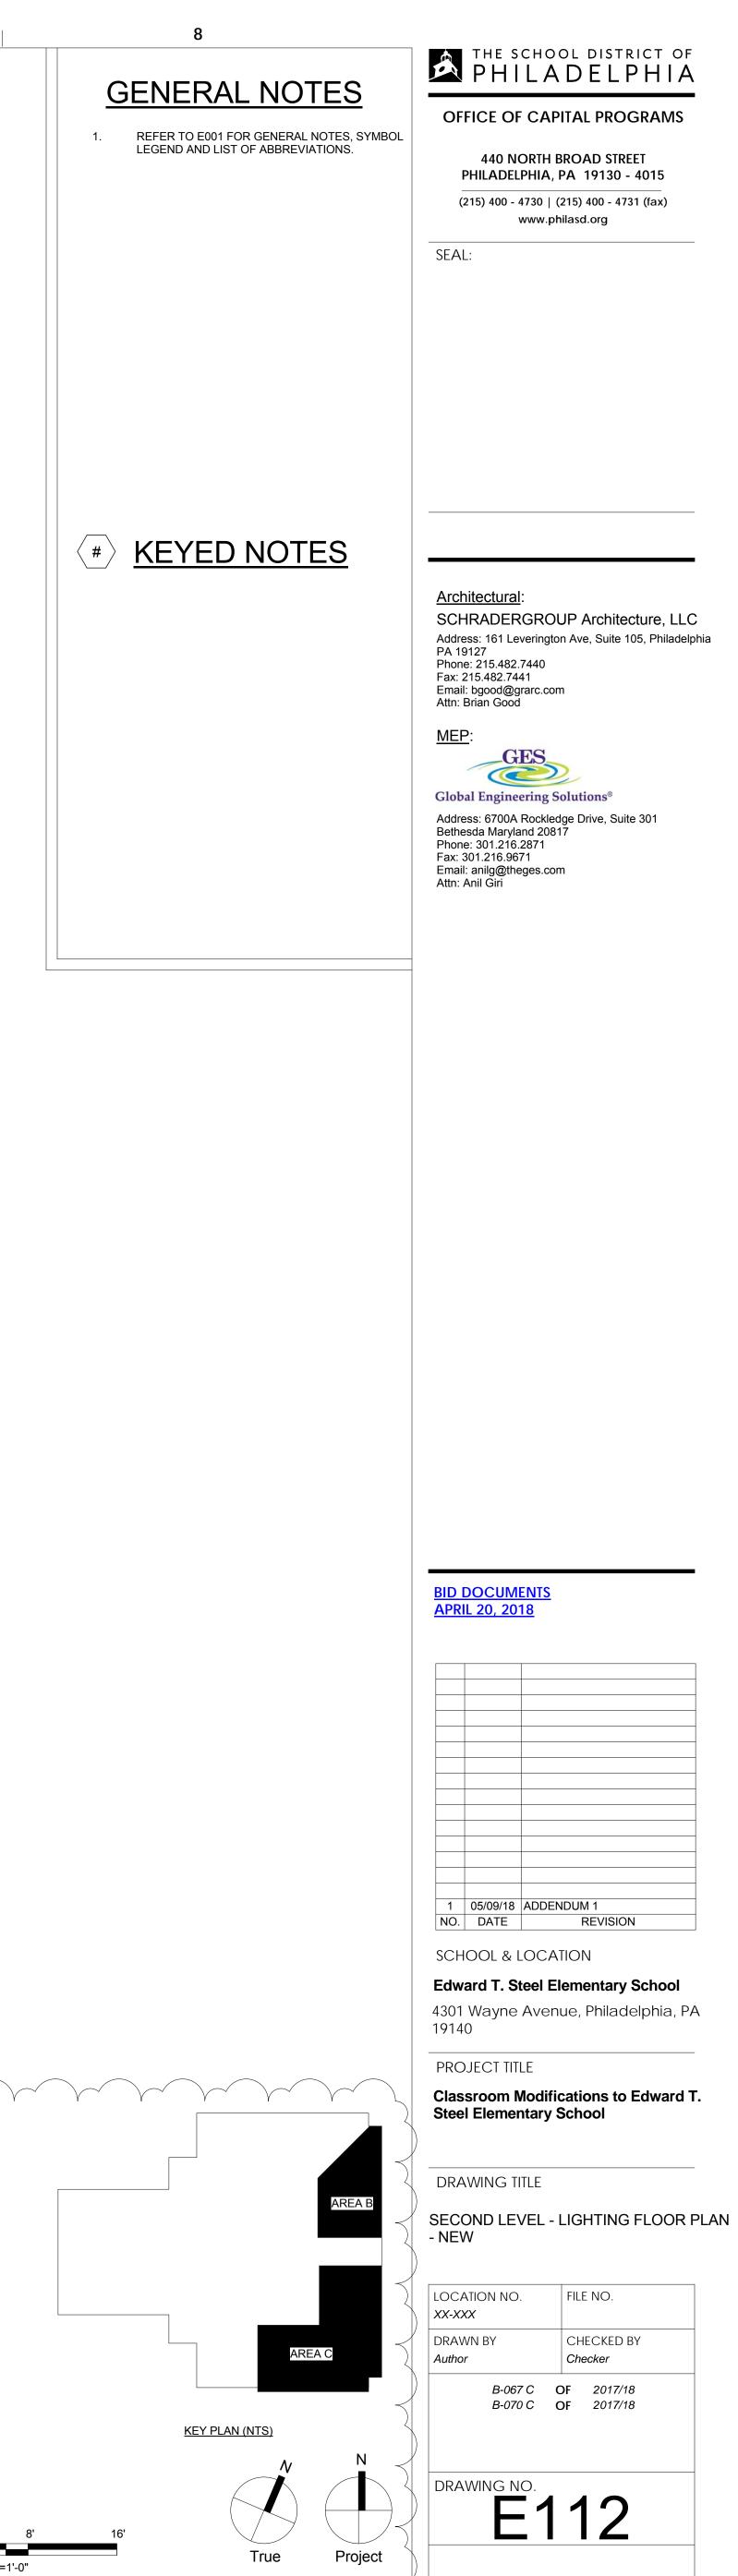

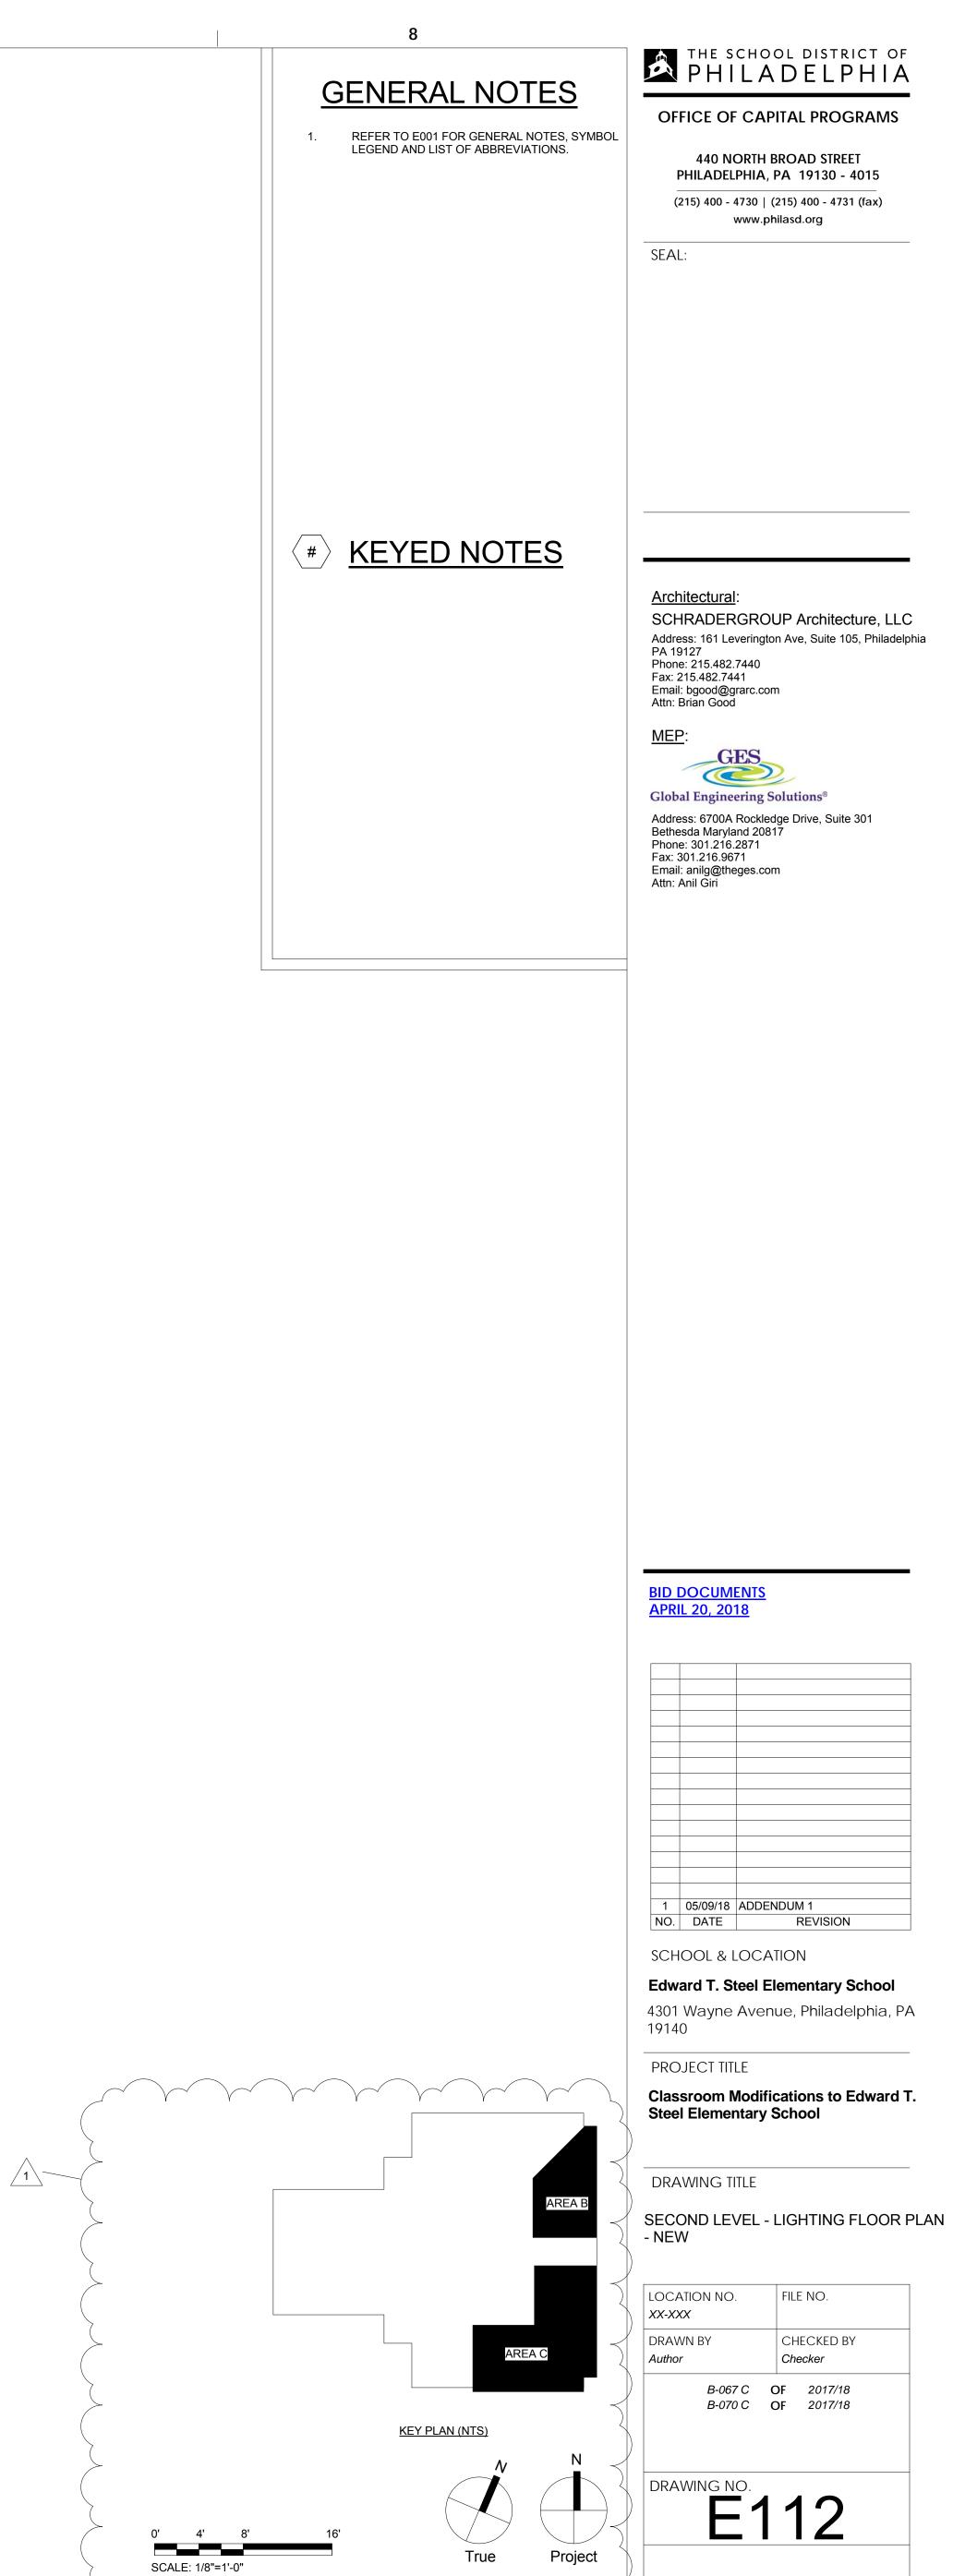

 \sim

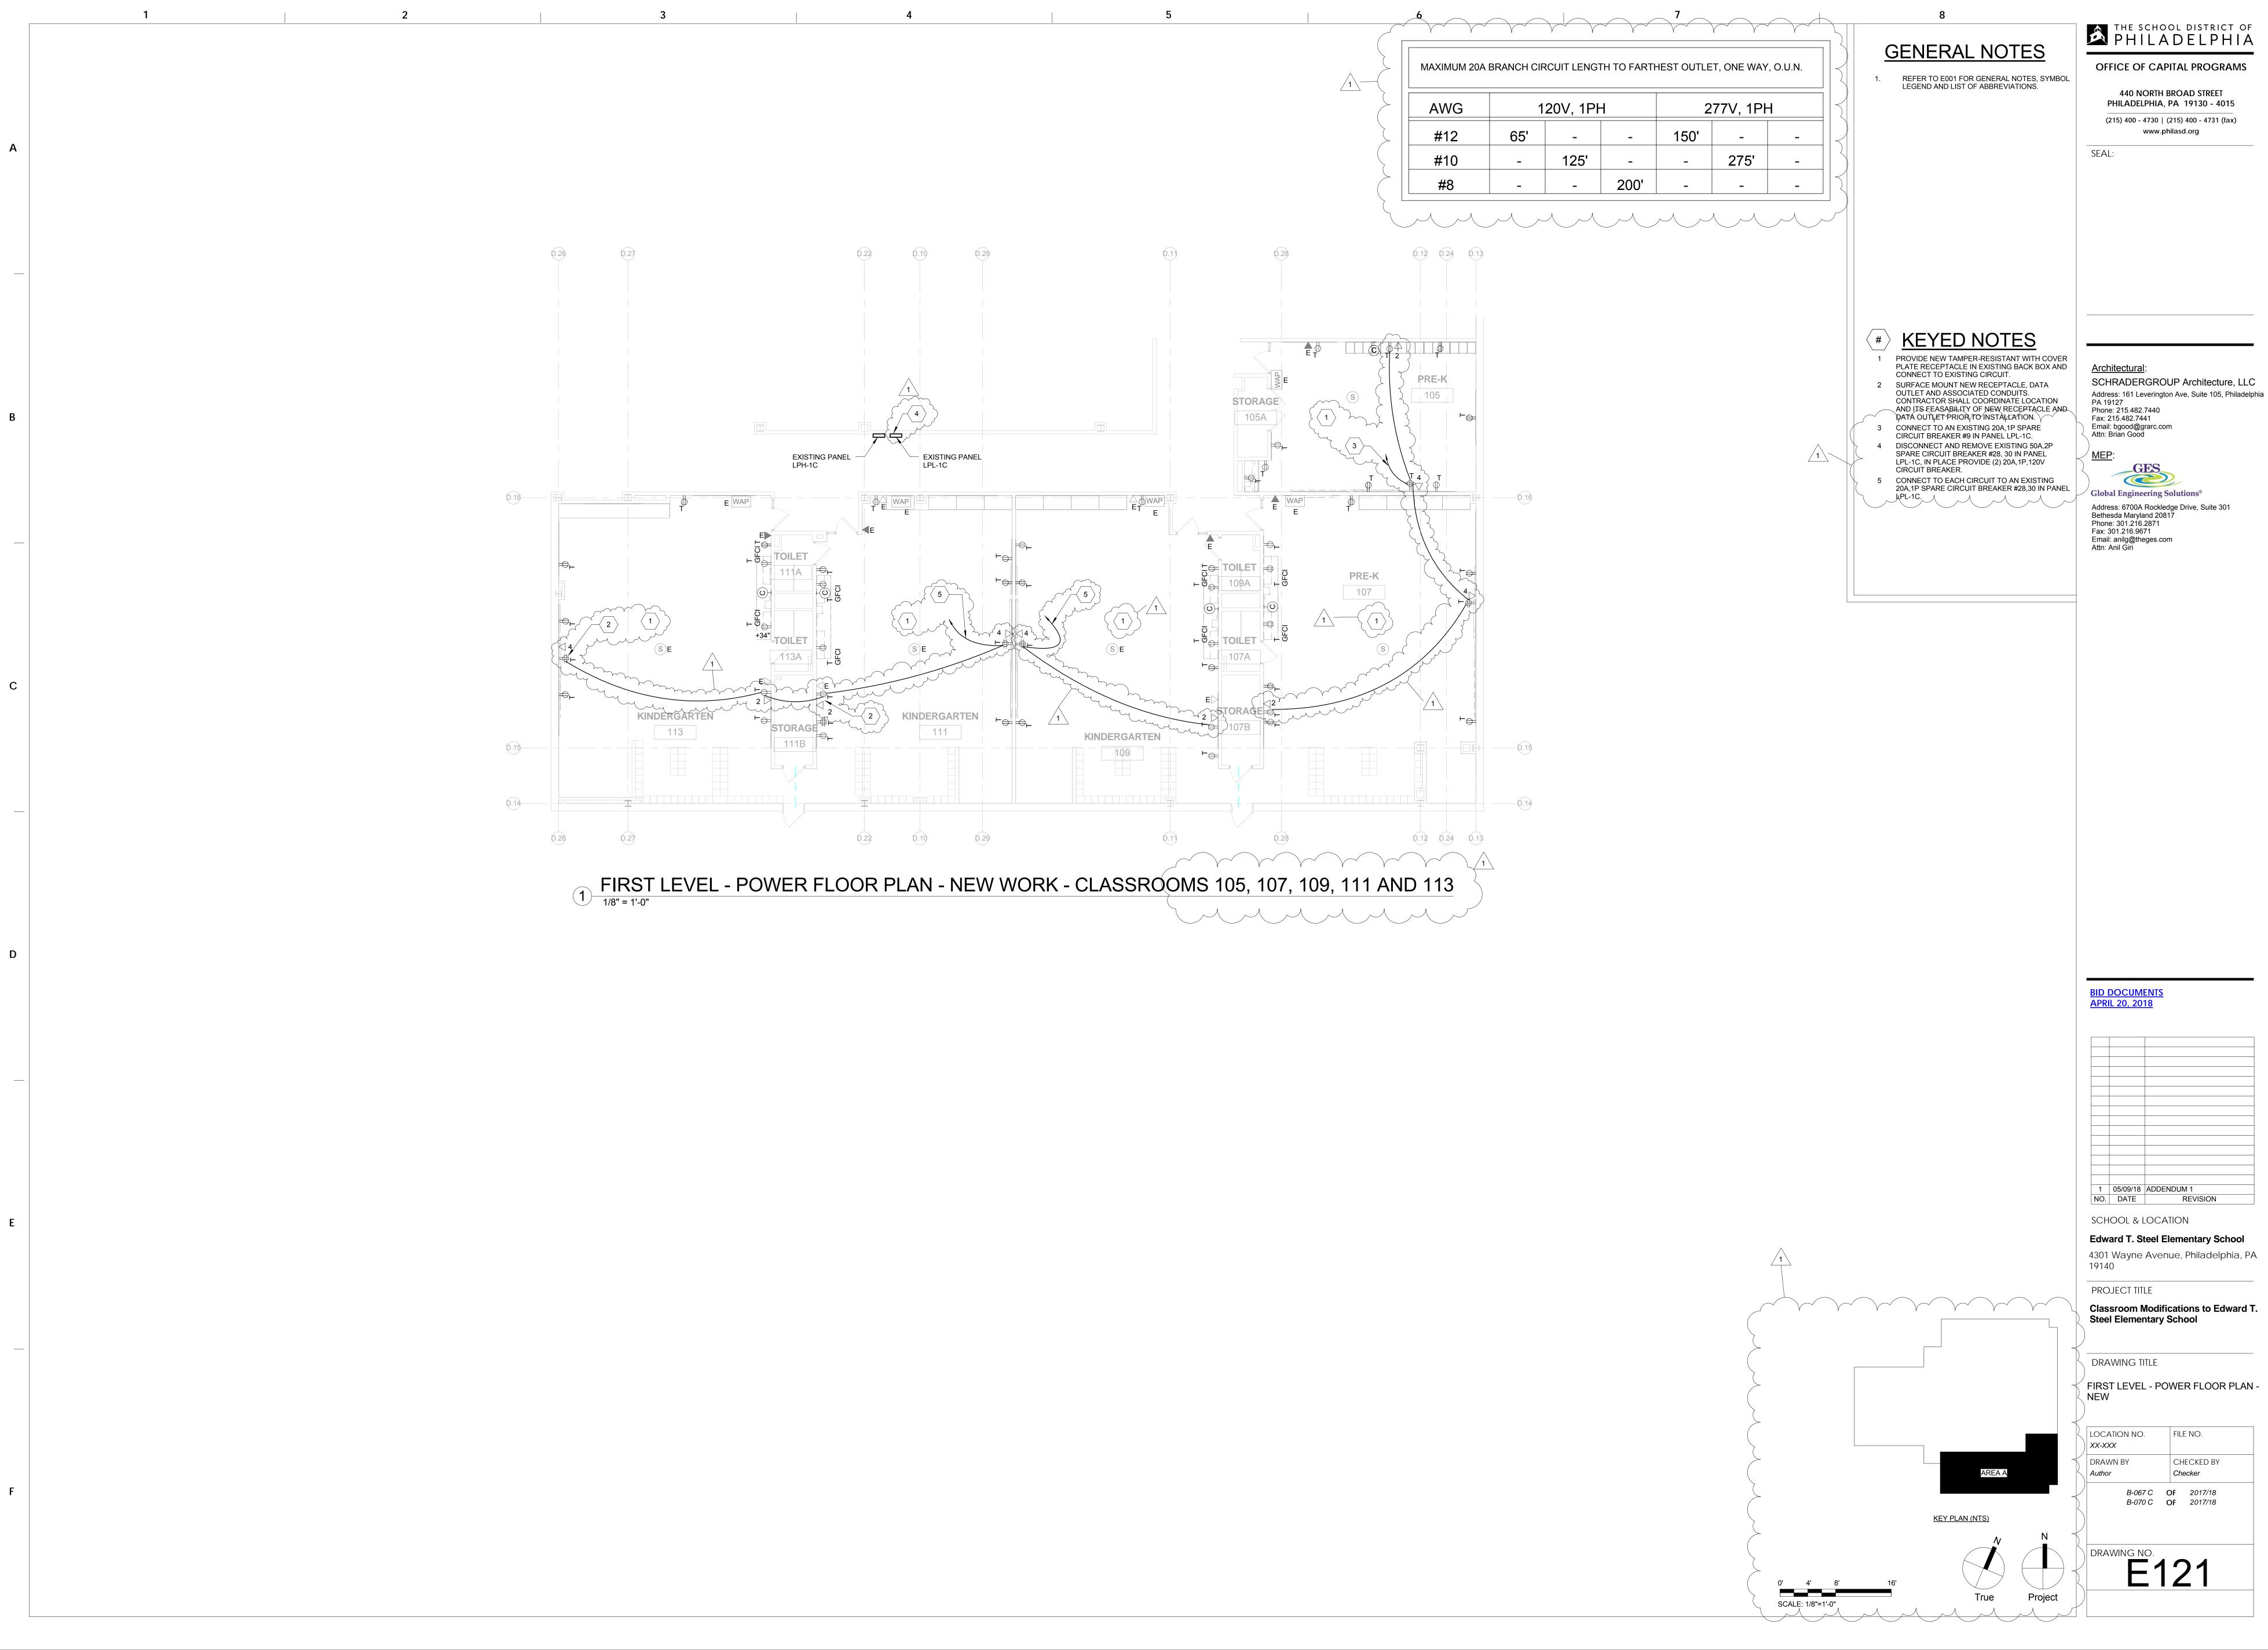

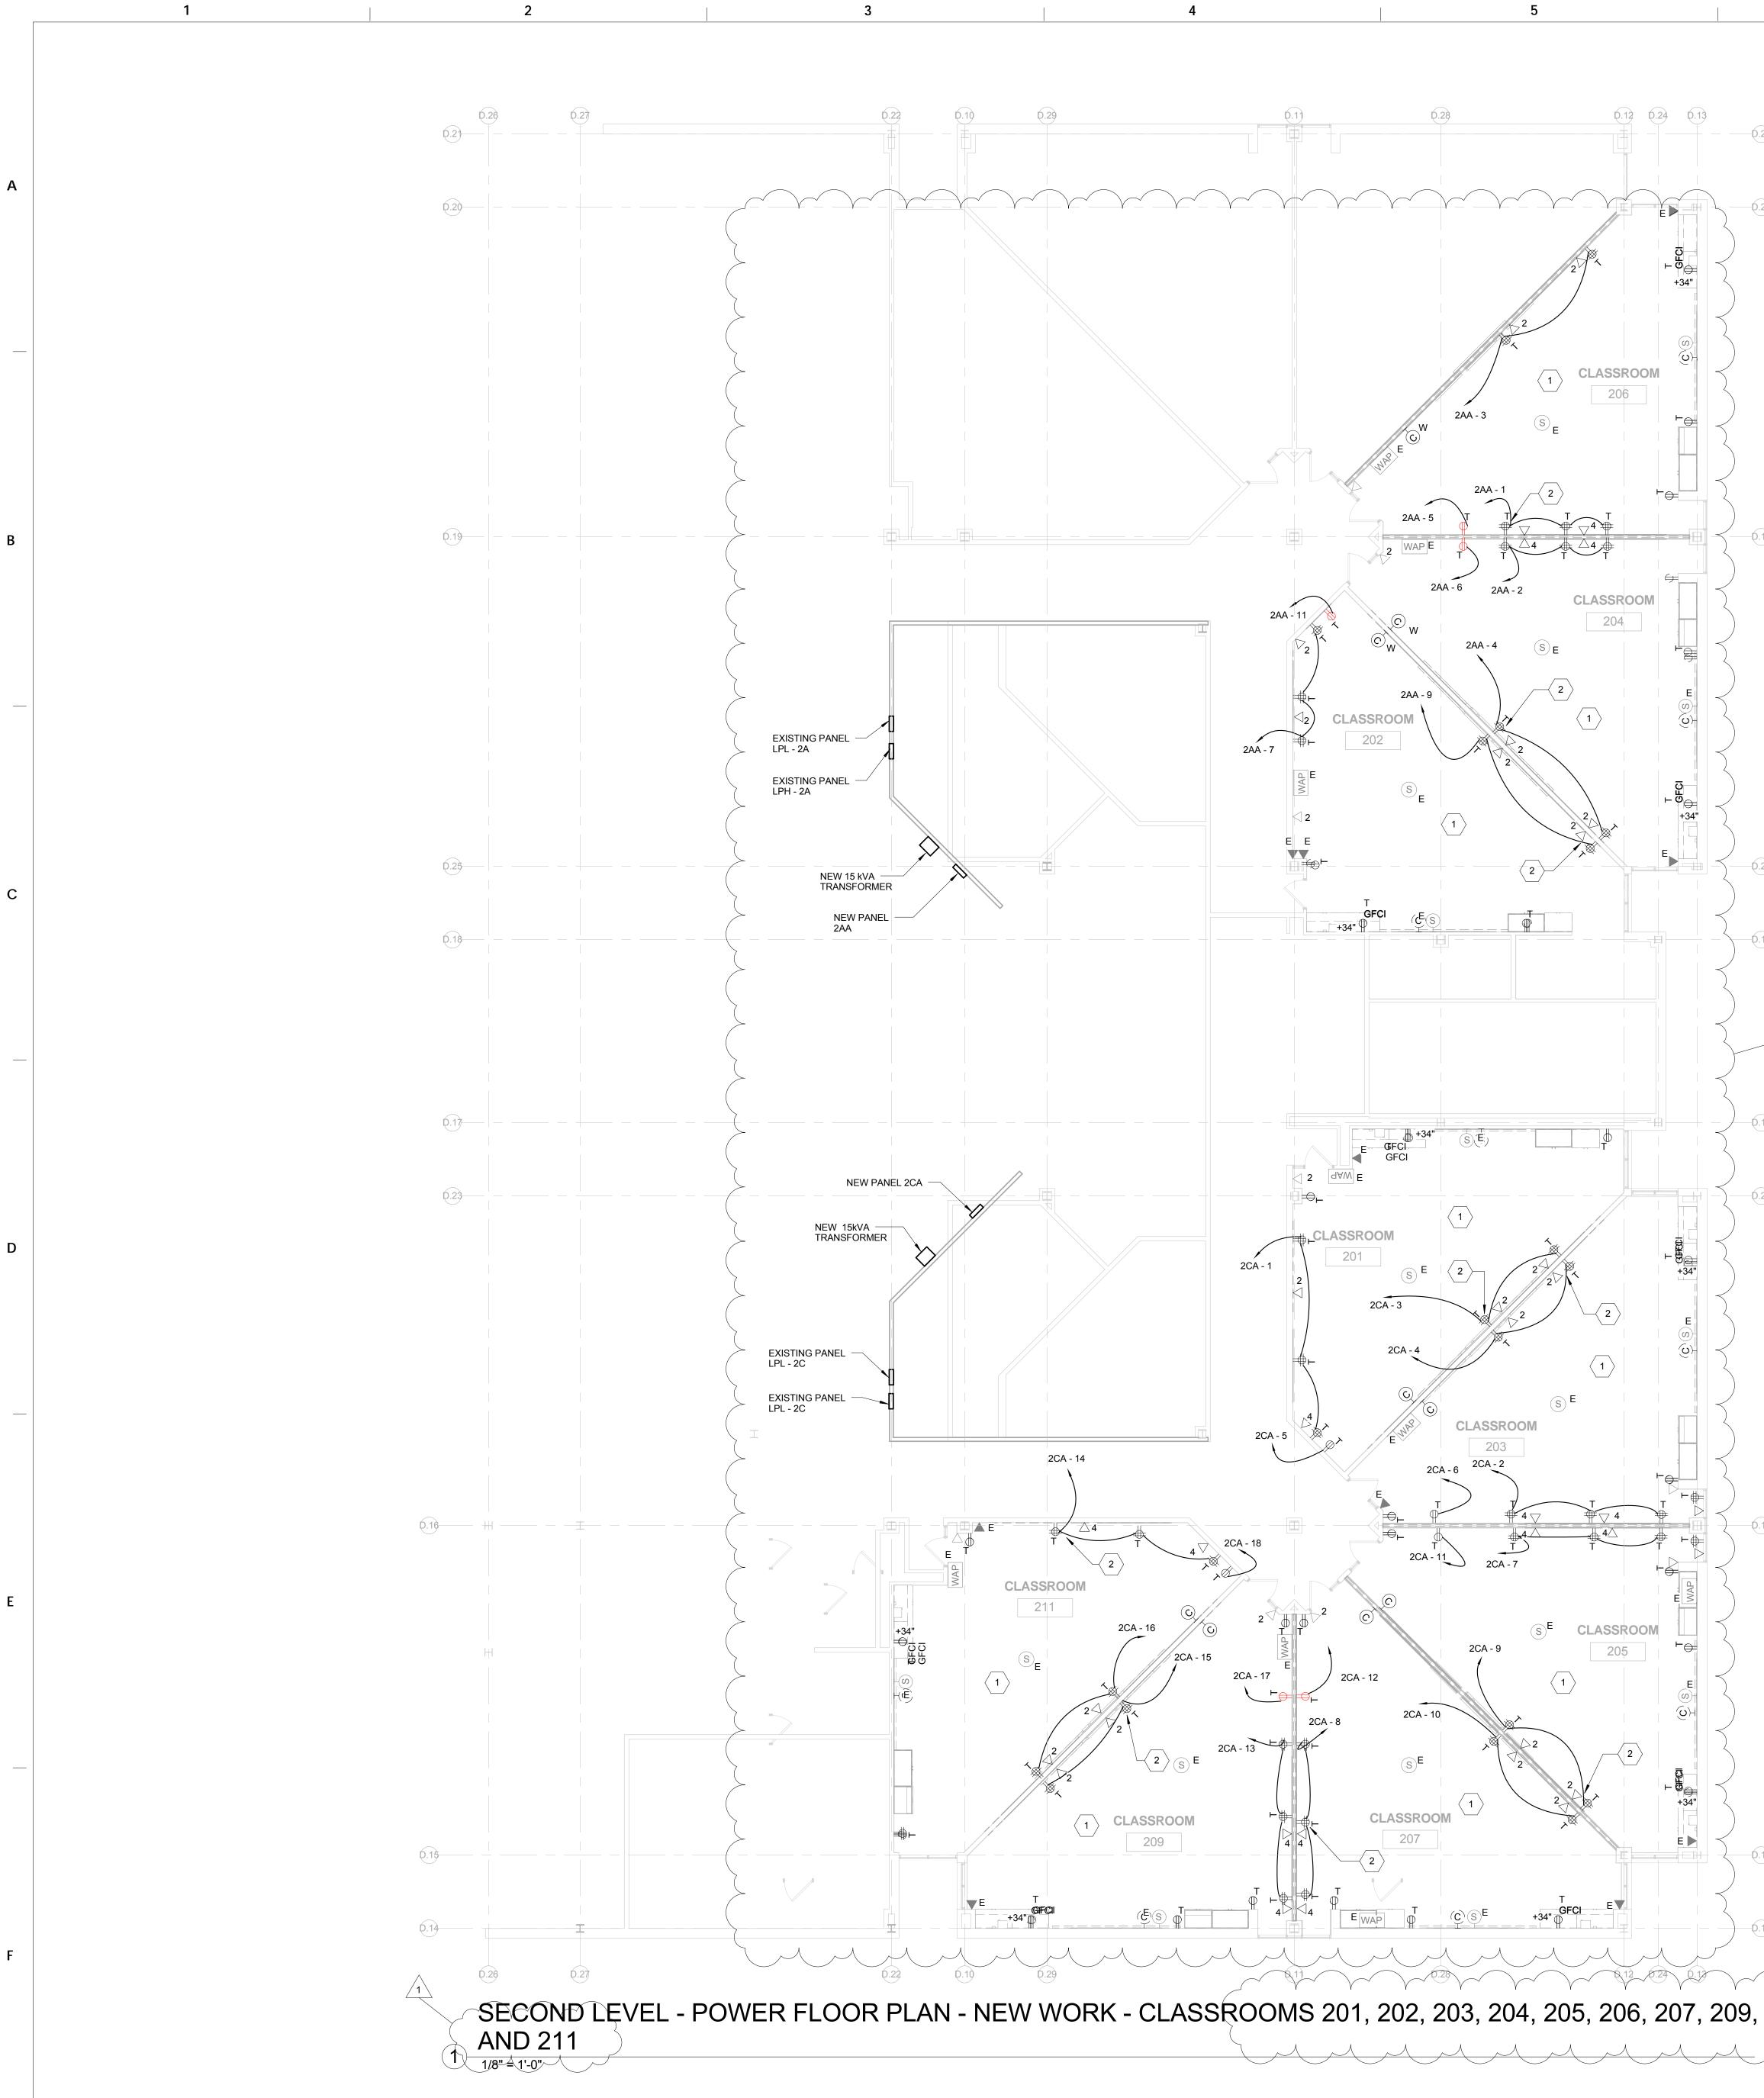


2

1


MAXIMUM 20A BRANCH CIRCUIT LENGTH TO FARTHEST OUTLET, ONE WAY, O.U.N.								GENERAL NOT 1. REFER TO E001 FOR GENERAL NOT LEGEND AND LIST OF ABBREVIATION		
AWG	120V, 1PH		2	277V, 1PH						
#12	65'	-	-	150'	-	-				
#10 #8	-	125'	- 200'	-	275'	-				
								(#) <u>KEYED NOT</u>		
								1 PROVIDE NEW TAMPER-RESISTAN PLATE RECEPTACLE IN EXISTING CONNECT TO EXISTING CIRCUIT.		
								2 SURFACE MOUNT NEW RECEPTAG OUTLET AND ASSOCIATED CONDU CONTRACTOR SHALL COORDINAT ITS FEASABILITY OF NEW RECEPT OUTLET PRIOR TO INSTALLATION		
								OUTLETT NOR TO INSTALLATION.		
						1				
							\sim			

5

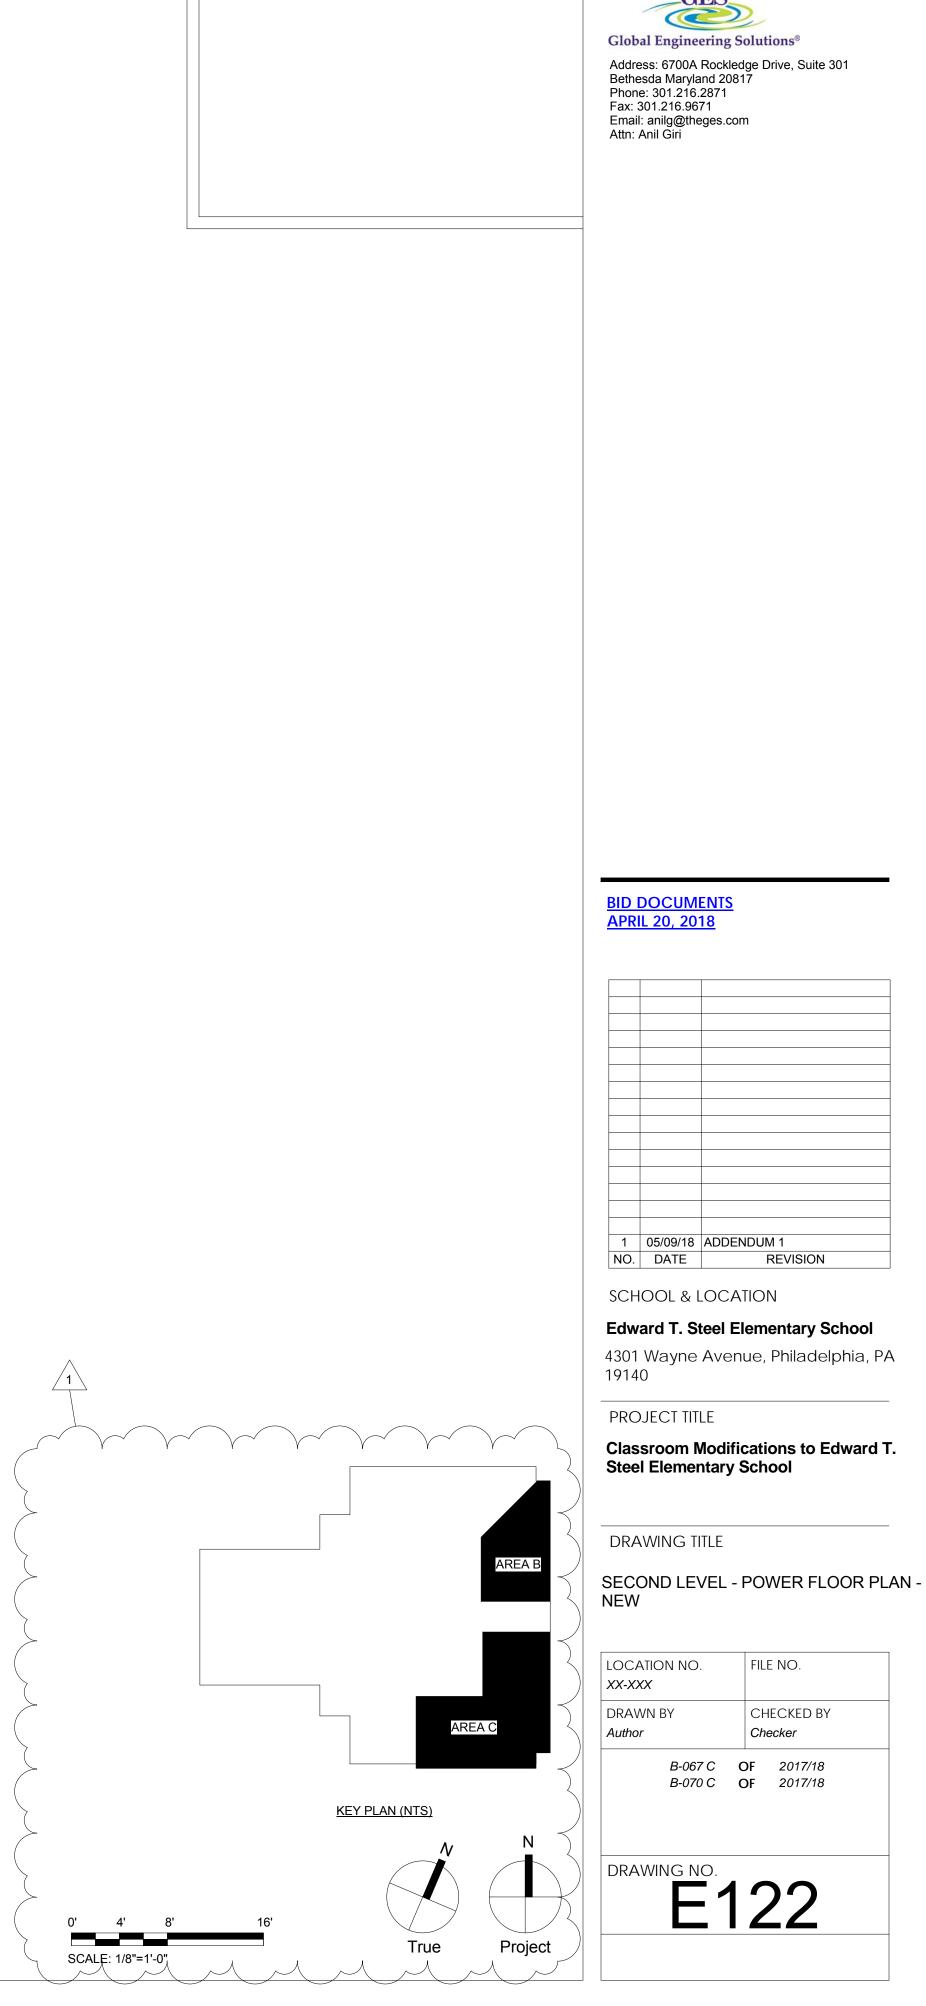

SCHRADERGROUP Architecture, LLC Address: 161 Leverington Ave, Suite 105, Philadelphia PA 19127 Phone: 215.482.7440 Fax: 215.482.7441 Email: bgood@grarc.com Attn: Brian Good MEP:


VITH COVER CK BOX AND Architectural: DATA OCATION AND

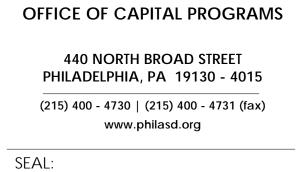

THE SCHOOL DISTRICT OF

	1	2		3	4
A			(E) PANEL LPH-2C-		
В			2 2ND FLOOR STORAGE 216	4 4 4 4 4 4 4 4 5 5 5 7 5 7 7 7 7 7 7 7	
					PARTIAL SCALE: N.T.S.
с —					
D		VOLTAGE: PH/WIRE: CKT LOAD NO. TYPE 1 R 3 R 5 R 7 R 9 R 11 R 13 R 13 R 15 R	208Y/120V BUS R/ 3 PHASE, 4 WIRE + GROUND LOAD DESCRIPTION BKR P TRIP CLASSROOM 201 REC. 1 20 CLASSROOM 205 REC. 1 20		(NEW) ● NEW ● 1 SEC ● 2 SEC 2 SEC 2 SEC ● 2 SEC 30 MINIMUM A.I.C. RATING (A): 14,000 S: SURFACE SERVICE: NORMAL LOAD BKR LOAD DESCRIPTION LOAD CKT (VA) P TRIP TYPE NO. 1080 1 20 CLASSROOM 203 REC. R 2 720 1 20 CLASSROOM 203 REC. R 6 1080 1 20 CLASSROOM 203 REC. R 6 1080 1 20 CLASSROOM 203 REC. R 6 1080 1 20 CLASSROOM 207 REC. R 10 180 1 20 CLASSROOM 207 REC. R 10 180 1 20 CLASSROOM 201 REC. R 12 1080 1 20 CLASSROOM 201 REC. R 14 720 1 20 CLASSROOM 201 REC. R 12 1080 1 20 CLASSROOM 211 REC. R 16
_		19 21 23 25 27 29 TOTAL 0 TOTAL 0 PROVI	SPARE 1 20 SPARE SPACE SPACE CONNECTED LOAD (A): 33.0 ONNECTED LOAD (VA): 11,80 DE ITEMS MARKED BELOW :	0 18.0 12.0 3.0 80 6,480 4,320 1,080 LOAD TYPE	1 20 SPARE 20 1 20 SPARE 22 1 20 SPARE 24 1 20 SPARE 24 1 20 SPARE 26 1 20 SPARE 26 1 20 SPARE 28 1 20 SPARE 30 (AMPS/PHASE) SPACE 30 (AMPS/PHASE) #BOLD INDICATES NEW (VA/PHASE) VA VA AMPS VA AMPS
Ε		□ SHUNT □ FEED □ SER VI □ ISOLAT □ 200% N □ NEMA 3 ☑ OTHEF	TRIP ON MAIN DEVICE F THRU LUGS M CE NEUTRAL F TED GROUND BUS M IEUTRAL S	CONTINUOUS LOADS AND LIGHTIN RECEPTS (1st 10kVA @100% + RE MECH.(LARGEST @ 125% + REST (ITCHEN EQUIP. (PER NEC TABLE NON-CONTINUOUS LOADS (@100 STANDBY LOADS TOTAL CONNECTED & I TOTAL CONNECTED & I	EST @ 50%) R 11,880 33 10,940 30 @ 100%) M
 F					

3	4	5	

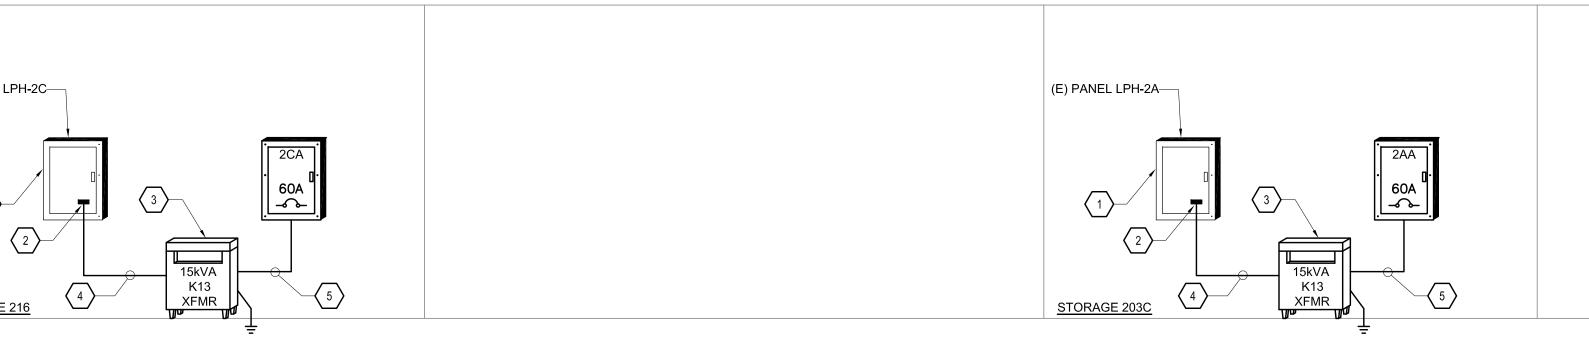

1 PARTIAL POWER RISER DIAGRAM SCALE: N.T.S.


P	ANEL	BOARD NAME:			2 A	A (N	EW)		(NEW)				 1 SEC 2 SEC 		ES	S®
VOL	TAGE:	208Y/120V	E	BUS F	RATING:	100A		POLES:	30		M	NIMUM A.	I.C. RA	TING (A):	14,000	
PH	WIRE:	3 PHASE, 4 WIRE + GR	OU	ND	MAIN:	60A MCB	MC	UNTING:	SURFA	CE			S	ERVICE:	NORM	AL
СКТ	LOAD	LOAD DESCRIPTION	В	KR	LOAD	PHA	SE LOAD	(VA)	LOAD	В	KR	LOAD	DESCR	IPTION	LOAD	СКТ
NO.	TYPE		Ρ	TRIP	(VA)	A	В	С	(VA)	Ρ	TRIF				TYPE	NO.
1	R	CLASSROOM 206 REC.	1	20	1080	2160			1080	1	20	CLASSR	COM 2	04 REC.	R	2
3	R	CLASSROOM 206 REC.	1	20	720		1440		720	1	20	CLASSR	COM 2	04 REC.	R	4
5	R	CLASSROOM 206 REC.	1	20	180			360	180	1	20	CLASSR	COM 2	04 REC.	R	6
7	R	CLASSROOM 202 REC.	1	20	1080	1080				1	20	SPARE				8
9	R	CLASSROOM 202 REC.	1	20	720		720			1	20	SPARE				10
11	R	CLASSROOM 202 REC.	1	20	180			180		1	20	SPARE				12
13		SPARE	1	20						1	20	SPARE				14
15		SPARE	1	20						1	20	SPARE				16
17		SPARE	1	20						1	20	SPARE				18
19		SPARE	1	20						1	20	SPARE				20
21		SPARE	1	20						1	20	SPARE				22
23		SPARE	1	20						1	20	SPARE				24
25		SPACE										SPACE				26
27		SPACE										SPACE				28
29		SPACE										SPACE				30
٦	TOTAL (CONNECTED LOAD (A):		16	6.5	9.0	6.0	1.5	(AMPS/	PHA	SE)		#BC	DLD IND	CATES	NEW
		ONNECTED LOAD (VA):		8592	940	3,240	2,160	540	(VA/PHA							
				-,-		-1](/					
												CONNE	CTED	DEM	AND	3
	PROVI	DE ITEMS MARKED BEL	ow	1:			LOAD	TYPE				VA	AMPS	VA	AMPS	
		-IN-DOOR CONSTRUCT			CONTIN	UOUS LC			G (@12	5%)	С					8
		TRIP ON MAIN DEVICE		•		TS (1st 10					R	5,940	16	5,940	16	8
	en ander see see						-					3,340	10	5,540	10	2
		THRU LUGS				LARGEST	NUMBER OF STREET, STREET, STREET, ST	and the second second second second)	M					5
1		CE NEUTRAL				N EQUIP.		The second bellow a local second			ĸ					5.
		TED GROUND BUS				ONTINUO		S (@100%	6)		N					8
	200%	NEUTRAL			STAND	BY LOADS	6				S					8
	NEMA	3R				TOTAL	CONNEC	TED & D	EMAND	LO	AD :	5.94	(kVA)	5.94	(kVA)	
✓	OTHEF	R: PROVIDE PANEL W/ IN	ITE	GRA		TOTAL	CONNEC	TED & D	EMAND	LO	AD :	16.49	(A)	16.49	(A)	
	SURG	E PROTECTION (SDP)														

7

	GENERAL NOTES
1.	SEE DRAWING E001 FOR ELECTRICAL SYMBOLS, GENERAL NOTES AND ABBREVIATIONS.
#	> SPECIFIC NOTES
1.	EXISTING 225A, 3Ø, 4W, 277/480V WITH 200A MCB.
2.	PROVIDE 25A, 3P, 480V CIRCUIT BREAKER IN EXISTING BLANK SPACES. ELECTRICAL CHARACTERISTICS (AIC AND TYPE) OF THE NEW CIRCUIT BREAKER SHALL MATCH EXISTING CIRCUIT BREAKER .
3.	15kVA, 480V DELTA PRIMARY/ 208Y/120 SECONDARY K13 COPPER WINDING TRANSFORMER.
4.	3#10+1#10G-3/4"C.
5.	4#6+1#10G-1"C.

	OFFICE OF CAPITAL PROGRAMS
	440 NORTH BROAD STREET PHILADELPHIA, PA 19130 - 4015
	(215) 400 - 4730 (215) 400 - 4731 (fax) www.philasd.org
SE.	AL:
	Farshad Majidian; PA PE Stamp.png
	ME (LICENSED PROFESSIONAL) DATE TE AND LICENSE NO: XX/XX/20XX
Ar	chitectural:
Ada PA Pha	CHRADERGROUP Architectue, LLC dress: 161 Leverington Ave, Suite 105, Philadel 19127 one: 215.482.7440
Em Atti	x: 215.482.7441 pail: bgood@grarc.com n: Brian Good = D-
	<u>EP:</u>
Ade Bet	bbal Engineering Solutions [®] dress: 6700A Rockledge Drive, Suite 301 thesda Maryland 20817 one: 301.216.2871
Fax Em	x: 301.216.9671 aail: anilg@theges.com n: Anil Giri
-	
	<u>) DOCUMENTS</u> RIL 20, 2018
<u>AP</u> 10 9 8	
AP 10 9 8 7 6	
<u>AP</u> 10 9 8 7	
AP 10 9 8 7 6 5 4 3	
AP 10 9 8 7 6 5 4 3 2 1	RIL 20, 2018
AP 10 9 8 7 6 5 4 3 2 1 NO.	RIL 20, 2018 Image: Constraint of the second seco
AP 10 9 8 7 6 5 4 3 2 1 NO. Edv	RIL 20, 2018 Image: Constraint of the second seco
AP 10 9 8 7 6 5 4 3 2 1 NO. Edv	RIL 20, 2018 Image: Constraint of the second state of the sec
AP 10 9 8 7 6 5 4 3 2 1 NO. SCC 430 191 PR	RIL 20, 2018 Image: Constraint of the second seco
AP 10 9 8 7 6 5 4 3 2 1 NO. SCC Edv 430 191 PR Classing	RIL 20, 2018 Image: Constraint of the second state of the sec
AP 10 9 8 7 6 5 4 3 2 1 NO. SCC Edv 430 191 PR Ster	RIL 20, 2018 Image: Constraint of the second state of the sec
AP 10 9 8 7 6 5 4 3 2 1 NO. SCC 430 191 PR Class DR PO	RIL 20, 2018 Image: Constraint of the second seco
AP 10 9 8 7 6 5 4 2 1 NO. SC 430 191 PR Class DR PO PA	RIL 20, 2018 Image: Construction of the second se
AP 10 9 8 7 6 5 4 3 2 1 NO. SCC 430 191 PR Class DR PO PA	RIL 20, 2018 Image: Constraint of the second seco
AP 10 9 8 7 6 5 4 3 2 1 NO. SCC 430 191 PR Class DR PO PA	RIL 20, 2018 RI 2018
AP 10 9 8 7 6 5 4 3 2 1 NO. SCC 430 191 PR Class DR PO PA	RIL 20, 2018 Image: Constraint of the second seco
AP 10 9 8 7 6 5 4 3 2 1 NO. SC 430 191 PR Class DR PO PA	RIL 20, 2018 Revision Revision Revision Revision Revision Rool & LOCATION Wayne Avenue, Philadelphia, P. 40 OJECT TITLE AWING TITLE RAWING TITLE WER RISER AND NELBOARD SCHEDULES CATION NO. FILE NO. AWN BY CHECKED BY B-067 C OF 2017/18
AP 10 9 8 7 6 5 4 2 1 NO. SC 430 191 PR Class DR PO PA	RIL 20, 2018 Image: Constraint of the second seco

	1	2	
Α			
Β			
С			
D			
Ε			
F			

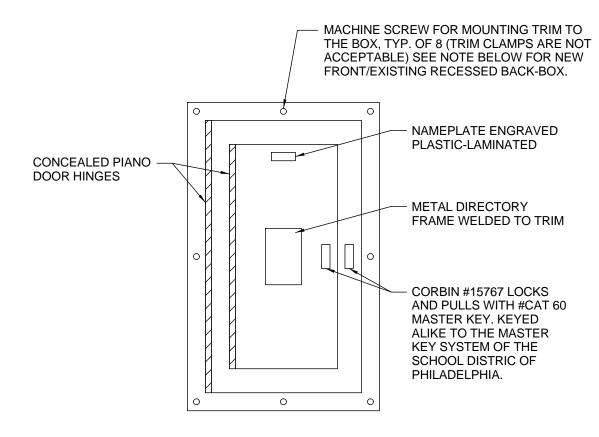

6

3 PANELBOARD FRONT STANDARD DETAIL


568B	
8	BROWN
9	GREEN
45	BLUE W/ WHITE
3	GREEN W/ WHITE
1	ORANGE

NOTE 1. ALL RJ45 TERMINATION POINTS SHALL BE

CONFIGURED TO THE EIA/TIA 568B STANDARD UNLESS SPECIFICALLY DIRECTED OTHERWISE BY SDP AUTHORIZED REPRESENTATIVE.

4 RJ45 TERMINATION DETAIL NTS

4

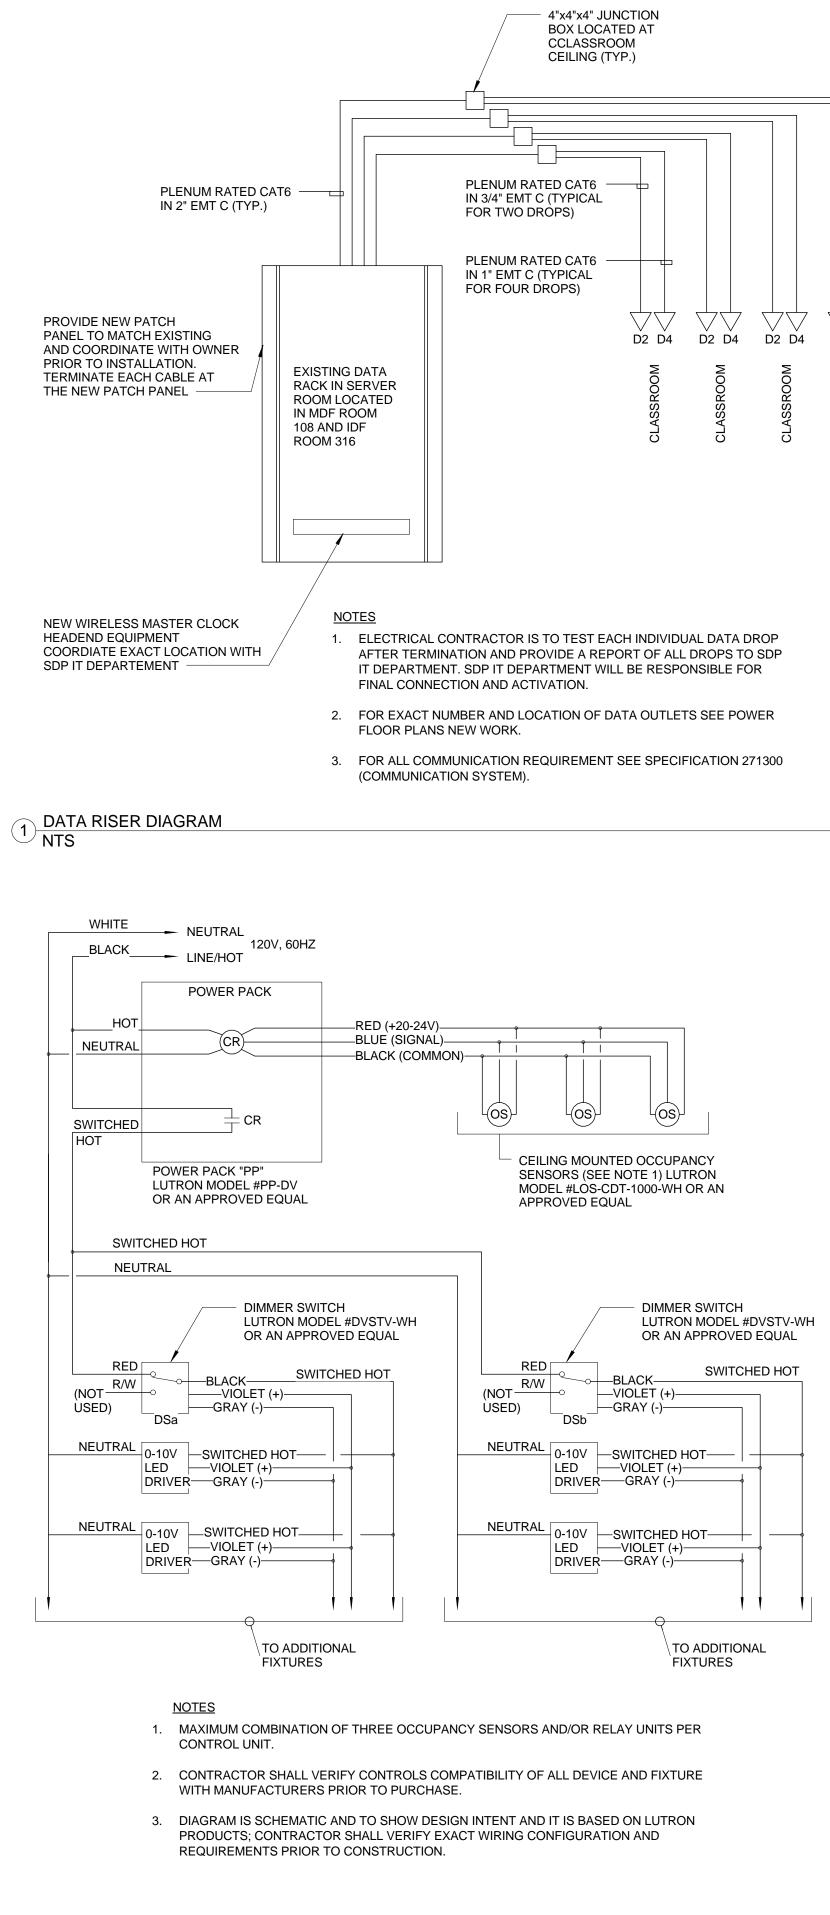

TYPICAL CLASSROOM LED LIGHTING CONTROL SCHEMATIC CEILING OCCUPANCY SENSOR WITH TWO

2 DIMMER SWITCHES NTS

	GENERAL		GENERAL
	 THE INTENT OF THESE DRAWINGS IS TO PROVIDE COMPLETE AND PROPERLY FUNCTIONING HVAC SYSTEMS. PROVIDE ALL LABOR AND MATERIAL NECESSARY TO ACHIEVE SUCH ENDS. CONTRACTOR IS OBLIGATED TO EXAMINE PLANS. ANY OBSERVED FAULTS OR AMBIGUITY IN THESE PLANS SHALL BE CALLED TO THE ATTENTION OF THE OWNER'S REPRESENTATIVE IMMEDIATELY, SO THAT THE MATTER MAY BE RESOLVED PRIOR TO SUBMISSION OF BIDS. BY SUBMISSION OF BID, THE CONTRACTOR SHALL ACKNOWLEDGE ACCEPTANCE OF THESE PLANS AS AN ADEQUATE DEFINITION OF THE SCOPE OF WORK 	1.	THE INTENT OF THESE DRAWINGS IS TO PROVIDE COMP FUNCTIONING PLUMBING SYSTEMS. PROVIDE ALL LABOR ACHIEVE SUCH ENDS. CONTRACTOR IS OBLIGATED TO E FAULTS OR AMBIGUITY IN THESE PLANS SHALL BE CALL OWNER'S REPRESENTATIVE IMMEDIATELY, SO THAT THE PRIOR TO SUBMISSION OF BIDS. BY SUBMISSION OF BID
	AND EXTRA COST CLAIMS BASED ON INADEQUACY OF PLANS WILL NOT BE CONSIDERED. 2. ALL WORK ON THIS PROJECT SHALL BE INSTALLED IN ACCORDANCE WITH THE LATEST		ACKNOWLEDGE ACCEPTANCE OF THESE PLANS AS AN A SCOPE OF WORK AND EXTRA COST CLAIMS BASED ON IN BE CONSIDERED.
	APPLICABLE CODES AND REGULATIONS. 3. THESE DRAWINGS ARE DIAGRAMMATIC AND INTENDED TO DEPICT THE GENERAL LOCATION OF HVAC SYSTEM COMPONENTS. CONSULT THE ARCHITECTURAL PLANS FOR PROPER	2.	ALL WORK ON THIS PROJECT SHALL BE INSTALLED IN ACCODES AND REGULATIONS.
	DIMENSIONS AND LOCATION OF EQUIPMENT. 4. THE CONTRACTOR SHALL COORDINATE THE INSTALLATION OF HVAC WORK WITH EXISTING CONDITIONS AND THE WORK OF OTHER TRADES. MINOR DEVIATIONS FROM THE PLANS MAY BE MADE TO AVOID MINOR CONFLICTS. WHEN MAJOR CONFLICTS ARE APPARENT, THE	3.	THE PLUMBING CONTRACTOR SHALL COORDINATE THE WITH OTHER TRADES. MINOR DEVIATIONS FROM THE PL MINOR CONFLICTS. WHEN MAJOR CONFLICTS ARE APPA ADVISED IMMEDIATELY, AND AFFECTED WORK SHALL NO CONFLICT HAS BEEN RESOLVED.
	ARCHITECT SHALL BE ADVISED IMMEDIATELY, AND AFFECTED WORK SHALL NOT BE INSTALLED UNTIL THE CONFLICT HAS BEEN RESOLVED. 5. THE CONTRACTOR SHALL OBTAIN AND PAY FOR PERMITS AND ARRANGE FOR INSPECTIONS	4.	CONTRACTOR SHALL OBTAIN AND PAY FOR PERMITS AN LOCAL AUTHORITIES HAVING JURISDICTION.
	BY LOCAL AUTHORITIES HAVING JURISDICTION. 6. ALL NECESSARY ALLOWANCES AND PROVISIONS SHALL BE MADE BY THIS CONTRACTOR	5.	PROVIDE OPENINGS IN BUILDING CONSTRUCTION FOR P PENETRATE STRUCTURAL MEMBERS WITHOUT PRIOR AF STRUCTURAL ENGINEER. VERIFY SLAB PENETRATION LC
	FOR BEAMS, COLUMNS OR OTHER OBSTRUCTIONS OF THE BUILDING OR THE WORK OF OTHER CONTRACTORS, WHETHER OR NOT SAME IS INDICATED. WHERE NECESSARY TO AVOID OBSTRUCTIONS THE DUCTS SHALL BE TRANSFORMED, DIVIDED, OFFSET, RAISED OR LOWERED WITH THE REQUIRED FREE AREA BEING MAINTAINED WHILE MAINTAINING DESIGNED CEILING HEIGHTS.	6.	WITH WORK IN ORDER TO LOCATE OBSTRUCTIONS EMBI ALL ROTATING PLUMBING EQUIPMENT SHALL BE MOUNT ACCORDANCE WITH MANUFACTURER'S RECOMMENDATI
	7. INSTALL ALL EQUIPMENT IN ACCORDANCE WITH THE MANUFACTURER'S RECOMMENDATIONS.		INSTALL ALL EQUIPMENT IN ACCORDANCE WITH THE MA RECOMMENDATIONS.
	8. MECHANICAL CONTRACTOR SHALL THOROUGHLY CLEAN HIS WORK AREA DAILY. MECHANICAL CONTRACTOR SHALL ALSO REMOVE ALL TRASH AFTER WORK COMPLETION.		CONTROLS AND ACCESSORIES FOR EQUIPMENT SHALL MANUFACTURER.
	 WHERE EXISTING FIELD CONDITIONS ARE DIFFERENT THAN SHOWN, THE CONTRACTOR SHALL ADVISE THE ENGINEER OF DISCREPANCIES WHICH WILL AFFECT THE PROPOSED WORK PRIOR TO BEGINNING WORK. 		PLUMBING CONTRACTOR SHALL THOROUGHLY CLEAN H ALSO REMOVE ALL TRASH AFTER WORK COMPLETION. THE WORK DETAILED ON THESE PLANS IS BASED ON PR
	10. SYMBOLS SHOWN ON SCHEDULES DEFINE TYPE OF EQUIPMENT ONLY. CONTRACTOR IS RESPONSIBLE FOR RESEARCHING DRAWINGS FOR EXACT QUANTITIES REQUIRED OF EACH TYPE.		BUILDING DRAWINGS. IF EXISTING FIELD CONDITIONS AN CONTRACTOR SHALL ADVISE THE ENGINEER OF DISCRE PROPOSED WORK PRIOR TO BEGINNING WORK.
	11. PRIOR TO INSTALLATION OF NEW WORK, CONTRACTOR SHALL VERIFY THAT ALL DUCTWORK, EQUIPMENT, PIPING, ETC., SHALL BE FREE FROM INTERFERENCE WITH EXISTING CONDITIONS. WHERE CONFLICTS OCCUR, CONTRACTOR SHALL IMMEDIATELY CONTACT THE	11.	CONTRACTOR SHALL VERIFY THAT ALL EQUIPMENT, PIPI INTERFERENCE WITH OTHER DISCIPLINES. WHERE CONF IMMEDIATELY CONTACT THE CONSTRUCTION MANAGER TRADES WILL BE INSTALLED IN CLOSE PROXIMITY TO ON
	OWNER. WHERE THE WORK OF VARIOUS TRADES WILL BE INSTALLED IN CLOSE PROXIMITY TO ONE ANOTHER, OR WHERE THERE IS EVIDENCE THAT THE WORK OF ONE TRADE WILL INTERFERE WITH WORK OF OTHER TRADES, THE CONTRACTOR SHALL ASSIST IN WORKING OUT SPACE CONDITIONS TO MAKE A SATISFACTORY ADJUSTMENT. IF THE CONTRACTOR ALLOWS ONE TRADE TO INSTALL HIS WORK BEFORE COORDINATING WITH WORK OF OTHER TRADES, THE CONTRACTOR SHALL MAKE NECESSARY CHANGES TO CORRECT THE		EVIDENCE THAT THE WORK OF ONE TRADE WILL INTERF TRADES, THE CONTRACTOR SHALL ASSIST IN WORKING A SATISFACTORY ADJUSTMENT. IF THE CONTRACTOR AL WORK BEFORE COORDINATING WITH WORK OF OTHER T MAKE NECESSARY CHANGES TO CORRECT THE CONDIT
	CONDITION WITHOUT EXTRA CHARGE. 12. ALL WORK TO BE GUARANTEED FOR TWO YEAR AGAINST LABOR AND MATERIALS. ANY DEFECTIVE MATERIALS OR WORKMANSHIP, AS WELL AS DAMAGE TO THE WORK OF ALL TRADES RESULTING FROM SAME, SHALL BE REPLACED OR REPAIRED AS DIRECTED FOR THE DURATION OF THE GUARANTEE PERIOD. TIME FOR THIS GUARANTEE SHALL BEGIN	12	. THE CONTRACTOR SHALL LOCATE ALL EQUIPMENT WHIC MAINTAINED IN FULLY ACCESSIBLE POSITION. EQUIPMENT LIMITED TO, VALVES, TRAPS, CLEANOUTS, DRAIN POINTS ACCESSIBILITY, FURNISH ACCESS DOORS FOR THIS PUR DRAWINGS MAY BE MADE. ALLOW FOR BETTER ACCESS THAT PURPOSE SHALL BE APPROVED.
1	FROM THE DATE OF ACCEPTANCE OF THE COMPLETE WORK BY THE OWNER OR HIS APPOINTED REPRESENTATIVE. NOTE: THESE GUARANTEES SHALL BE SUBMITTED TO THE TENANT AND/OR BUILDING OWNER FOR RECORD PURPOSES. 13. AS USED IN DRAWINGS AND SPECIFICATIONS FOR MECHANICAL WORK, CERTAIN NON-	13	. ALL WORK TO BE GUARANTEED FOR ONE YEAR AGAINST DEFECTIVE MATERIALS OR WORKMANSHIP, AS WELL AS TRADES RESULTING FROM SAME, SHALL BE REPLACE OI DURATION OF THE GUARANTEE PERIOD. TIME FOR THIS
	TECHNICAL WORDS SHALL BE UNDERSTOOD TO HAVE SPECIFIC MEANINGS AS FOLLOWS REGARDLESS OF INDICATIONS TO THE CONTRARY IN THE GENERAL CONDITION OR OTHER DOCUMENTS GOVERNING THE MECHANICAL WORK. "FURNISH" - PURCHASE AND DELIVER TO THE PROJECT SITE COMPLETE WITH EVERY NECESSARY APPURTENANCE AND SUPPORT, ALL AS PART OF THE MECHANICAL WORK.	14	THE DATE OF ACCEPTANCE OF THE COMPLETE WORK B' REPRESENTATIVE. NOTE: THESE GUARANTEES SHALL B RECORD PURPOSES. . PROVIDE CUTTING, PATCHING, AND/OR CORE DRILLING FOR THE INSTALLATION OF NEW WORK. CONTRACTOR S
	PURCHASING SHALL INCLUDE PAYMENT OF ALL SALES TAXES AND OTHER SURCHARGES AS MAY BE REQUIRED TO ASSURE THAT PURCHASED ITEMS ARE FREE OF ALL LIENS, CLAIMS OR ENCUMBRANCES. "INSTALL" - UNLOAD AT THE DELIVERY POINT AT THE SITE AND PERFORM EVERY OPERATION		OBTAINING STRUCTURAL ENGINEER'S REVIEW AND APP OR OWNER'S REPRESENTATIVE PRIOR TO PERFORMING DRILLING, THE CONTRACTOR SHALL PERFORM X-RAY OF VERIFY PENETRATIONS ARE FREE OF OBSTRUCTIONS IN
	NECESSARY TO ESTABLISH SECURE MOUNTING AND CORRECT OPERATION AT THE PROPER LOCATION IN THE PROJECT, ALL AS PART OF THE MECHANICAL WORK. "PROVIDE" - "FURNISH" AND "INSTALL".	1.	DEMOLITION EXISTING CONDITIONS WERE TAKEN FROM ORIGINAL DF MAY NOT REFLECT EXACT AS-BUILT CONDITIONS. FIELD
	"NEW" - MANUFACTURED WITHIN THE PAST TWO YEARS AND NEVER BEFORE USED.		PRIOR TO SUBMITTING FINAL BID. COORDINATE NEW WO DISCIPLINES AND EXISTING CONDITIONS PRIOR TO CONS
1	4. ALL MATERIAL, EQUIPMENT AND ACCESSORIES, FURNISHED AND INSTALLED SHALL BE NEW AND EQUAL TO OR SURPASS THE QUALITY OF SIMILAR MATERIALS AS SCHEDULES. ALL MATERIALS, EQUIPMENT AND METHODS SHALL BE AS SPECIFIED IN THE BASE BUILDING CONTRACT DOCUMENTS UNLESS NOTED OTHERWISE. DEMOLITION	2.	OWNER RETAINS THE RIGHTS OF SALVAGE FOR EQUIPM REMOVED. COORDIANTE WITH OWNER THE EQUIPMENT AND THE LOCATION FOR STORAGE. AVOID DAMAGE TO E DEVICES DURING DEMOLITION WORK AND DURING TRAN STORAGE LOCATION.
	ANY DISCOVERED DISCREPANCY BETWEEN THE CONTRACT DOCUMENTS AND ACTUAL SITE CONDITIONS MAY BE BROUGHT TO THE ARCHITECT/ENGINEER'S ATTENTION PRIOR TO BID FOR CLARIFICATION. AFTER A CONTRACT IS EXECUTED CONTRACTOR SHALL SUBMIT A	3.	VERIFY THAT EXISTING EQUIPMENT TO REMAIN IS OPER. ARCHITECT, ENGINEER AND/OR OWNER OF ANY DAMAGE COMPONENTS.
	 REQUEST FOR INFORMATION. 2. THE REQUIRED DEMOLITION SHALL NOT BE LIMITED TO THAT PORTION SHOWN ON THE PLANS ALONE, BUT SHALL INCLUDE ALL NECESSARY WORK COINCIDENTAL THERETO AND/OR WORK INDICATED ELSEWHERE ON THE DRAWINGS OR IN THE SPECIFICATIONS. 		ALL EXISTING INSTALLATIONS THAT ARE TO BE REMOVE AND/OR CAPPED SHALL BE EXECUTED BEHIND FINISHED BE EXECUTED IN A PERMANENT MANNER. NO EXISTING I WITHOUT WRITTEN AUTHORIZATION FROM THE OWNER.
	3. CONTRACTOR SHALL NOT VIOLATE THE PHYSICAL SECURITY OF THE BUILDING DURING DEMOLITION OR ASSOCIATED OPERATIONS. SECURITY SHALL BE CLOSELY COORDINATED		IN ALL AREAS WHERE DEMOLITION WORK OCCUR, PATCH FINISH OR EXISTING FINISHES WHICH ARE TO REMAIN.
	 WITH THE OWNER'S REPRESENTATIVE. 4. CONTRACTOR SHALL SCHEDULE ALL WORK, INCLUDING INTERRUPTION OF EXISTING UTILITIES, WITH THE OWNER, PRIOR TO STARTING WORK. CONTRACTOR SHALL NOTE THAT THE BUILDING SHALL BE OCCUPIED AND IN USE DURING THE PERIOD OF TIME THIS 		AVOID DAMAGING EXISTING SURFACES AND EQUIPMENT INSTALLATION. REPAIR ANY DAMAGE CAUSED DURING W OWNER.
	 5. DEMOLITION SHALL GENERALLY BE ARRANGED TO AGREE WITH THE ACCOMPLISHMENT OF 		ALL DEMOLITION WORK SHALL BE COORDINATED WITH T SECTIONS OF THE CONTRACT DOCUMENTS. THE CONTRACTOR SHALL NOTIFY THE ENGINEER IN WRI
	 WORK UNDER THE VARIOUS PHASES AND IN COORDINATION WITH THE REQUIRED MODIFICATIONS. 6. DO NOT ALTER THE EXISTING SYSTEMS WHICH ARE LOCATED IN AREAS NOT IN SCOPE OF MODIFICATION AND ADDRESS AND		CONFLICTS BETWEEN EXISTING INSTALLATIONS WHICH DEMOLITION AND THE NEW WORK INDICATED WITHIN TH NOTIFICATION SHALL BE ACCOMPANIED WITH A DRAWIN SOLUTION PRIOR TO STARTING ANY WORK IN THE AFFE
	WORK UNLESS SPECIFICALLY INDICATED. PROTECT EXISTING SYSTEMS WITHIN THE LIMITS OF WORK WHICH ARE TO BE RETAINED. ANY DAMAGE TO THE EXISTING SYSTEMS DUE TO CONTRACTOR NEGLIGENCE SHALL BE REPAIRED AND/OR REPLACED TO ITS ORIGINAL CONDITION TO THE COMPLETE SATISFACTION OF THE OWNER, AND AT NO COST TO THE	9.	THE CONTRACTOR SHALL PROVIDE A PROPOSED SCHEE REVIEW BY THE OWNER.
	OWNER. 7. UNLESS OTHERWISE INDICATED, ALL FIXTURES, EQUIPMENT, PIPING, AND ACCESSORIES WHICH HAVE TO BE REMOVED SHALL BECOME THE PROPERTY OF THE CONTRACTOR AND		ANY ADDITIONAL DEMOLITION WORK DEEMED NECESSA SCOPE OF THE CONTRACT DOCUMENTS SHALL BE EXEC WRITTEN AUTHORIZATION FROM THE OWNER.
	 SHALL BE REMOVED FROM THE PROJECT SITE AS SOON AS POSSIBLE. 8. "CONCEALED LOCATION" IS DEFINED AS BEING ABOVE FINISHED CEILING, BELOW FINISHED 		UNLESS OTHERWISE NOTED ALL EXISTING EQUIPMENT, REMAIN.
	FLOOR, OR WITHIN FINISHED WALL OR PARTITION. SEE ARCHITECTURAL PLANS FOR FINISH INFORMATION.	12.	WHERE EXISTING EQUIPMENT IS TO BE REMOVED CONT ASSOCIATED PIPING, CONDUIT, POWER, CONTROLS, INS SUPPORTS, HOUSEKEEPING PADS, ETC. PATCH AND REF MATCH EXISTING AND/OR NEW FINISHES.
		13.	. THE CONTRACTOR SHALL PROVIDE NECESSARY PIPING, FEEDS, DRIPS, ETC. AS REQUIRED. DRAIN AND REFIL NECESSARY TO ACCOMMODATE PHASING AND TO MININ
		14.	THE CONTRACTOR SHALL BE RESPONSIBLE FOR VISITIN THE EXISTING CONDITIONS IN WHICH THE WORK IS TO B
		15.	. WHERE ANY ABANDONED PIPES IN EXISTING FLOORS, W ETC. CONFLICT WITH NEW WORK, THE CONTRACTOR SH AS NECESSARY TO ACCOMMODATE NEW WORK.
		16.	THE LOCATION OF ALL EXISTING EQUIPMENT, PIPING, DU APPROXIMATE ONLY AND SHALL BE CHECKED AND VERI ALL NEW MECHANICAL/PLUMBING/FIRE PROTECTION WC EXISTING WORK AS APPLICABLE.
		17.	EXISTING WORK AS APPLICABLE. . CONTRACTOR SHALL COORDINATE WITH OTHER TRADES FACILITY AT ALL TIMES.
		18.	. MAINTAIN EGRESS AT ALL TIMES. COORDINATE EGRESS FIRE MARSHAL, THE OWNER AND THE AUTHORITIES HAV

3

1

. NOTES	DOUBLE LIN	IE DUCTWORK	GENEF	RAL PIPING
	RECTANGULAR DUCT (FIRST FIGURE IS	90° ELBOW, RECTANGULAR WITHOUT	☆	AUTOMATIC AIR VENT
TE AND PROPERLY	300x150 FOR SIDE SHOWN, SECOND FIGURE IS FOR SIDE NOT SHOWN)	TURING VANES		DIRECTION OF PIPE PITCH
ND MATERIAL NECESSARY TO AMINE PLANS. ANY OBSERVED		45° ELBOW, RECTANGULAR	⊘ FD	FLOOR DRAIN
TO THE ATTENTION OF THE IATTER MAY BE RESOLVED THE CONTRACTOR SHALL				FLOW DIRECTION
HE CONTRACTOR SHALL EQUATE DEFINITION OF THE DEQUACY OF PLANS WILL NOT	FLAT OVAL DUCT (FIRST FIGURE IS FOR 300x150 ↔ SIDE SHOWN, SECOND FIGURE IS FOR SIDE NOT SHOWN)	90° ELBOW, ROUND OR FLAT OVAL (SMOOTH OR 5 PIECE ELBOWS)	<u> </u>	MANUAL AIR VENT
	FLOW DIRECTION ARROW	MITERED 90° ELBOW, ROUND OR FLAT OVAL		PIPE CONTINUES
ORDANCE WITH APPLICABLE			BFW	BOILER FEEDWATER
STALLATION OF PLUMBING WORK		90° ELBOW, RECTANGULAR WITH	CA	COMPRESSED AIR
ENT, THE ENGINEER SHALL BE BE INSTALLED UNTIL THE		TURING VANES	CD	CONDENSATE DRAIN
		45° ELBOW, ROUND OR FLAT OVAL	– — – – CHR – — –	CHILLED WATER RETURN
ARRANGE FOR INSPECTIONS BY		(SMOOTH OR 3 PIECE ELBOWS)	CHS	CHILLED WATER SUPPLY
SSAGE OF PIPING. DO NOT ROVAL OF ARCHITECT AND			CR	
ATIONS PRIOR TO PROCEEDING DED IN SLAB.	B		CS	CONDENSER WATER SUPPLY
ON VIBRATION ISOLATION IN	BACK DRAFT DAMPER	TAP-IN BRANCH, RECTANGULAR	D	DRAIN
IS. IFACTURER'S			DTR	DUAL TEMPERATURE RETURN
FACTURER 5	▼FSD	BRANCH DUCT, CONICAL LATERAL FITTING,	DTS	DUAL TEMPERATURE SUPPLY
PROVIDED BY EQUIPMENT	COMBINATION FIRE/SMOKE DAMPER	ROUND OR FLAT OVAL	– — — – HWR– — – –	HOT WATER RETURN
WORK AREA DAILY AND SHALL	▼ SD	BRANCH DUCT, CONICAL TEE FITTING, ROUND	HWS	HOT WATER SUPPLY
		OR FLAT OVAL BRANCH DUCT, "Y" FITTING, DOLIND OD FLAT		
IOUSLY PREPARED BASE DIFFERENT THAN SHOWN, THE NCIES WHICH WILL AFFECT THE	DUCT TRANSITION, ROUND OR	ROUND OR FLAT OVAL		
	FLAT OVAL TO RECTANGULAR	90° ELBOW TURNED UP, RECTANGULAR [SUPPLY]		
G, ETC., SHALL BE FREE FROM CTS OCCUR, CONTRACTOR SHALL	RECTANGULAR TO ROUND OR FLAT OVAL	90° ELBOW TURNED DOWN,		
/HERE THE WORK OF VARIOUS ANOTHER, OR WHERE THERE IS	DUCT TRANSITION, RECTANGULAR, ROUND, OR			
RE WITH WORK OF OTHER JT SPACE CONDITIONS TO MAKE DWS ONE TRADE TO INSTALL HIS		90° ELBOW TURNED UP, RECTANGULAR RETURN		
ADES, THE CONTRACTOR SHALL HIS	R-+ INCLINED RISE W/RESPECT TO AIR FLOW, RECTANGULAR	90° ELBOW TURNED DOWN, RECTANGULAR RETURN		
MUST BE SERVICED, OPERATED,		90° ELBOW TURNED UP,		
SHALL INCLUDE, BUT NOT BE	TO AIR FLOW, RECTANGULAR			
DSE. MINOR DEVIATIONS FROM LITY, AND ANY CHANGE FOR	R+ INCLINED RISE W/RESPECT TO AIR FLOW, ROUND OR FLAT OVAL	90° ELBOW TURNED DOWN, RECTANGULAR EXHAUST		
ABOR AND MATERIALS. ANY	INCLINED DROP W/RESPECT TO AIR FLOW, ROUND OR FLAT OVAL	90° ELBOW TURNED UP ROUND, FLAT OVAL SIMILAR SUPPLY / RETURN / EXHAUST		
MAGE TO THE WORK OF ALL		90° ELBOW TURNED DOWN ROUND, FLAT OVAL SIMILAR SUPPLY / RETURN / EXHAUST		
JARANTEE SHALL BEGIN FROM HE OWNER OR HIS APPOINTED	STATIC PRESSURE SENSOR			
SUBMITTED TO THE CO FOR		CEILING DIFFUSER (CD) OR GRILLE (CG) [SUPPLY]		
EXISTING WALLS AS REQUIRED ALL BE RESPONSIBLE FOR		CEILING REGISTER (CR) OR GRILLE		
OVAL AND INFORMING OWNER HIS WORK. PRIOR TO CORE		(CG) [RETURN OR EXHAUST]		
		CEILING DIFFUSER (ARROWS INDICATE		
		THROW DIRECTIONS)		
		CEILING DIFFUSER (ARROWS INDICATE		
_AB. VINGS AND SITE VISITS AND RIFY EXISTING CONDITIONS				
AB. VINGS AND SITE VISITS AND RIFY EXISTING CONDITIONS AND DEMOLITION WITH OTHER	ACCESSORIES	CEILING DIFFUSER (ARROWS INDICATE	PIPE FITT	INGS/VALVES
AB. VINGS AND SITE VISITS AND RIFY EXISTING CONDITIONS AND DEMOLITION WITH OTHER RUCTION. IT AND FIXTURES TO BE	ACCESSORIES	CEILING DIFFUSER (ARROWS INDICATE THROW DIRECTIONS)	PIPE FITT	INGS/VALVES
AB. VINGS AND SITE VISITS AND RIFY EXISTING CONDITIONS AND DEMOLITION WITH OTHER RUCTION. T AND FIXTURES TO BE D FIXTURES TO BE SALVAGED JIPMENT. FIXTURES AND		CEILING DIFFUSER (ARROWS INDICATE THROW DIRECTIONS)		FLANGE CONNECTION
AB. /INGS AND SITE VISITS AND RIFY EXISTING CONDITIONS AND DEMOLITION WITH OTHER RUCTION. T AND FIXTURES TO BE D FIXTURES TO BE SALVAGED JIPMENT. FIXTURES AND ORT TO OWNER'S DESIGNATED	BDD BACKDRAFT DAMPER	CEILING DIFFUSER (ARROWS INDICATE THROW DIRECTIONS)		
AB. VINGS AND SITE VISITS AND RIFY EXISTING CONDITIONS AND DEMOLITION WITH OTHER SUCTION. T AND FIXTURES TO BE D FIXTURES TO BE SALVAGED VIPMENT. FIXTURES AND ORT TO OWNER'S DESIGNATED	BDD BACKDRAFT DAMPER	CEILING DIFFUSER (ARROWS INDICATE THROW DIRECTIONS) SYMBOLS EXISTING TO REMAIN EXISTING TO BE REMOVED		FLANGE CONNECTION
AB. VINGS AND SITE VISITS AND RIFY EXISTING CONDITIONS AND DEMOLITION WITH OTHER UCTION. T AND FIXTURES TO BE D FIXTURES TO BE SALVAGED VIPMENT. FIXTURES AND ORT TO OWNER'S DESIGNATED NG PROPERLY. NOTIFY THE AND/OR MALFUNCTIONING	BDD BACKDRAFT DAMPER VOLUME DAMPER FD FIRE DAMPER	CEILING DIFFUSER (ARROWS INDICATE THROW DIRECTIONS)		FLANGE CONNECTION FLEXIBLE CONNECTOR
AB. INGS AND SITE VISITS AND RIFY EXISTING CONDITIONS AND DEMOLITION WITH OTHER UCTION. I AND FIXTURES TO BE D FIXTURES TO BE SALVAGED IPMENT. FIXTURES AND DRT TO OWNER'S DESIGNATED NG PROPERLY. NOTIFY THE AND/OR MALFUNCTIONING ABANDONED, RELOCATED, RFACES. ALL SUCH WORK SHALL	BDD BACKDRAFT DAMPER VOLUME DAMPER FD FIRE DAMPER FSD FIRE/SMOKE DAMPER	CEILING DIFFUSER (ARROWS INDICATE THROW DIRECTIONS) SYMBOLS EXISTING TO REMAIN EXISTING TO BE REMOVED		FLANGE CONNECTION FLEXIBLE CONNECTOR PIPE CONNECTION - BOTTOM
AB. /INGS AND SITE VISITS AND RIFY EXISTING CONDITIONS AND DEMOLITION WITH OTHER RUCTION. T AND FIXTURES TO BE D FIXTURES TO BE SALVAGED JIPMENT. FIXTURES AND ORT TO OWNER'S DESIGNATED NG PROPERLY. NOTIFY THE AND/OR MALFUNCTIONING ABANDONED, RELOCATED, JRFACES. ALL SUCH WORK SHALL ING TO BE ABANDONED	BDD BACKDRAFT DAMPER VOLUME DAMPER FD FIRE DAMPER FSD FIRE/SMOKE DAMPER SD SMOKE DAMPER	CEILING DIFFUSER (ARROWS INDICATE THROW DIRECTIONS)		FLANGE CONNECTION FLEXIBLE CONNECTOR PIPE CONNECTION - BOTTOM PIPE CONNECTION - TOP
AB. /INGS AND SITE VISITS AND RIFY EXISTING CONDITIONS AND DEMOLITION WITH OTHER RUCTION. T AND FIXTURES TO BE D FIXTURES TO BE SALVAGED JIPMENT. FIXTURES AND ORT TO OWNER'S DESIGNATED NG PROPERLY. NOTIFY THE AND/OR MALFUNCTIONING ABANDONED, RELOCATED, JRFACES. ALL SUCH WORK SHALL ING TO BE ABANDONED	BDD BACKDRAFT DAMPER VOLUME DAMPER FD FIRE DAMPER FSD FIRE/SMOKE DAMPER	CEILING DIFFUSER (ARROWS INDICATE THROW DIRECTIONS) CEILING TO REMAIN EXISTING TO REMAIN EXISTING TO BE REMOVED NEW WORK POINT OF CONNECTION NEW TO EXISTING LIMIT OF DEMOLITION		FLANGE CONNECTION FLEXIBLE CONNECTOR PIPE CONNECTION - BOTTOM PIPE CONNECTION - TOP PIPE DOWN
AB. VINGS AND SITE VISITS AND RIFY EXISTING CONDITIONS AND DEMOLITION WITH OTHER RUCTION. T AND FIXTURES TO BE D FIXTURES TO BE SALVAGED VIPMENT. FIXTURES AND ORT TO OWNER'S DESIGNATED NG PROPERLY. NOTIFY THE AND/OR MALFUNCTIONING ABANDONED, RELOCATED, VIRFACES. ALL SUCH WORK SHALL NG TO BE ABANDONED ND REPAIR TO MATCH NEW O REMAIN FOR NEW	BDD BACKDRAFT DAMPER VOLUME DAMPER FD FIRE DAMPER FSD FIRE/SMOKE DAMPER SD SMOKE DAMPER	CEILING DIFFUSER (ARROWS INDICATE THROW DIRECTIONS) CEILING DIFFUSER (ARROWS INDICATE THROW DIRECTIONS) CEILING DIFFUSER (ARROWS INDICATE THROW DIRECTIONS) EXISTING TO REMAIN EXISTING TO REMAIN EXISTING TO BE REMOVED NEW WORK POINT OF CONNECTION NEW TO EXISTING LIMIT OF DEMOLITION CO2 CARBON DIOXIDE SENSOR (MOUNT 48" AFF)		FLANGE CONNECTION FLEXIBLE CONNECTOR PIPE CONNECTION - BOTTOM PIPE CONNECTION - TOP PIPE DOWN PIPE END CAP
AB. VINGS AND SITE VISITS AND RIFY EXISTING CONDITIONS AND DEMOLITION WITH OTHER UCTION. T AND FIXTURES TO BE D FIXTURES TO BE SALVAGED VIPMENT. FIXTURES AND DRT TO OWNER'S DESIGNATED NG PROPERLY. NOTIFY THE AND/OR MALFUNCTIONING ABANDONED, RELOCATED, VRFACES. ALL SUCH WORK SHALL NG TO BE ABANDONED ND REPAIR TO MATCH NEW OR REMAIN FOR NEW OK AT NO EXTRA COST TO THE	BDD BACKDRAFT DAMPER VOLUME DAMPER FD FIRE DAMPER FSD FIRE/SMOKE DAMPER SD SMOKE DAMPER	CEILING DIFFUSER (ARROWS INDICATE THROW DIRECTIONS) CEILING TO REMAIN EXISTING TO REMAIN EXISTING TO BE REMOVED NEW WORK POINT OF CONNECTION NEW TO EXISTING LIMIT OF DEMOLITION		FLANGE CONNECTION FLEXIBLE CONNECTOR PIPE CONNECTION - BOTTOM PIPE CONNECTION - TOP PIPE DOWN PIPE END CAP PIPE REDUCER - CONCENTRIC
AB. VINGS AND SITE VISITS AND RIFY EXISTING CONDITIONS AND DEMOLITION WITH OTHER RUCTION. T AND FIXTURES TO BE D FIXTURES TO BE SALVAGED JIPMENT. FIXTURES AND ORT TO OWNER'S DESIGNATED NG PROPERLY. NOTIFY THE AND/OR MALFUNCTIONING ABANDONED, RELOCATED, JRFACES. ALL SUCH WORK SHALL ING TO BE ABANDONED ND REPAIR TO MATCH NEW O REMAIN FOR NEW RK AT NO EXTRA COST TO THE	BDD BACKDRAFT DAMPER VOLUME DAMPER FD FIRE DAMPER FSD FIRE/SMOKE DAMPER SD SMOKE DAMPER	CEILING DIFFUSER (ARROWS INDICATE THROW DIRECTIONS) CEILING DIFFUSER (ARROWS INDICATE THROW DIRECTIONS) CEILING DIFFUSER (ARROWS INDICATE THROW DIRECTIONS) EXISTING TO REMAIN EXISTING TO REMAIN EXISTING TO BE REMOVED NEW WORK POINT OF CONNECTION NEW TO EXISTING LIMIT OF DEMOLITION CO2 CARBON DIOXIDE SENSOR (MOUNT 48" AFF)		FLANGE CONNECTION FLEXIBLE CONNECTOR PIPE CONNECTION - BOTTOM PIPE CONNECTION - TOP PIPE DOWN PIPE END CAP PIPE REDUCER - CONCENTRIC PIPE REDUCER - ECCENTRIC
AB. VINGS AND SITE VISITS AND RIFY EXISTING CONDITIONS AND DEMOLITION WITH OTHER UCTION. T AND FIXTURES TO BE D FIXTURES TO BE SALVAGED VIPMENT. FIXTURES AND DRT TO OWNER'S DESIGNATED NG PROPERLY. NOTIFY THE AND/OR MALFUNCTIONING ABANDONED, RELOCATED, VRFACES. ALL SUCH WORK SHALL NG TO BE ABANDONED ND REPAIR TO MATCH NEW VK AT NO EXTRA COST TO THE ARCHITECTURAL AND OTHER G OF ANY DISCOVERED	BDD BACKDRAFT DAMPER VOLUME DAMPER FD FIRE DAMPER FSD FIRE/SMOKE DAMPER SD SMOKE DAMPER Image: Motorized Damper	CEILING DIFFUSER (ARROWS INDICATE THROW DIRECTIONS) CEILING DIFFUSER (ARROWS INDICATE SYMBOLS EXISTING TO REMAIN EXISTING TO REMAIN EXISTING TO BE REMOVED NEW WORK POINT OF CONNECTION NEW TO EXISTING LIMIT OF DEMOLITION CO2 CARBON DIOXIDE SENSOR (MOUNT 48" AFF) CO CARBON MONOXIDE SENSOR		FLANGE CONNECTION FLEXIBLE CONNECTOR PIPE CONNECTION - BOTTOM PIPE CONNECTION - TOP PIPE DOWN PIPE END CAP PIPE REDUCER - CONCENTRIC PIPE REDUCER - ECCENTRIC PIPE UP
AB. /INGS AND SITE VISITS AND RIFY EXISTING CONDITIONS AND DEMOLITION WITH OTHER RUCTION. T AND FIXTURES TO BE D FIXTURES TO BE SALVAGED JIPMENT. FIXTURES AND ORT TO OWNER'S DESIGNATED NG PROPERLY. NOTIFY THE AND/OR MALFUNCTIONING ABANDONED, RELOCATED, JRFACES. ALL SUCH WORK SHALL ING TO BE ABANDONED ND REPAIR TO MATCH NEW O REMAIN FOR NEW RK AT NO EXTRA COST TO THE ARCHITECTURAL AND OTHER IG OF ANY DISCOVERED E NOT SCHEDULED FOR CONTRACT DOCUMENTS. SUCH DELINEATING THE PROPOSED	BDD BACKDRAFT DAMPER VOLUME DAMPER FD FIRE DAMPER FSD FIRE/SMOKE DAMPER SD SMOKE DAMPER	CEILING DIFFUSER (ARROWS INDICATE THROW DIRECTIONS) CEILING DIFFUSER (ARROWS INDICATE THROW DIRECTIONS) CONSTRUCTION REMAIN EXISTING TO REMAIN EXISTING TO BE REMOVED NEW WORK POINT OF CONNECTION NEW TO EXISTING UNIT OF DEMOLITION CO2 CARBON DIOXIDE SENSOR (MOUNT 48" AFF) CO CARBON MONOXIDE SENSOR (H) HUMIDISTAT (MOUNT 48" AFF) T THERMOSTAT (MOUNT 48" AFF)		FLANGE CONNECTION FLEXIBLE CONNECTOR PIPE CONNECTION - BOTTOM PIPE CONNECTION - TOP PIPE DOWN PIPE END CAP PIPE REDUCER - CONCENTRIC PIPE REDUCER - ECCENTRIC PIPE UP UNION CONNECTION
AB. /INGS AND SITE VISITS AND RIFY EXISTING CONDITIONS AND DEMOLITION WITH OTHER RUCTION. T AND FIXTURES TO BE D FIXTURES TO BE SALVAGED JIPMENT. FIXTURES AND ORT TO OWNER'S DESIGNATED NG PROPERLY. NOTIFY THE AND/OR MALFUNCTIONING ABANDONED, RELOCATED, JRFACES. ALL SUCH WORK SHALL ING TO BE ABANDONED ND REPAIR TO MATCH NEW ARCHITECTURAL AND OTHER ARCHITECTURAL AND OTHER G OF ANY DISCOVERED E NOT SCHEDULED FOR CONTRACT DOCUMENTS. SUCH DELINEATING THE PROPOSED ED AREA.	BDD BACKDRAFT DAMPER VOLUME DAMPER FD FIRE DAMPER FSD FIRE/SMOKE DAMPER SD SMOKE DAMPER SD MOTORIZED DAMPER	CEILING DIFFUSER (ARROWS INDICATE THROW DIRECTIONS) CEILING DIFFUSER (ARROWS INDICATE THROW DIRECTIONS) CEILING DIFFUSER (ARROWS INDICATE THROW DIRECTIONS) EXISTING TO REMAIN EXISTING TO REMAIN EXISTING TO BE REMOVED NEW WORK POINT OF CONNECTION NEW TO EXISTING POINT OF CONNECTION NEW TO EXISTING LIMIT OF DEMOLITION CO2 CARBON DIOXIDE SENSOR (MOUNT 48" AFF) CO CARBON MONOXIDE SENSOR HUMIDISTAT (MOUNT 48" AFF)		FLANGE CONNECTION FLEXIBLE CONNECTOR PIPE CONNECTION - BOTTOM PIPE CONNECTION - TOP PIPE DOWN PIPE END CAP PIPE REDUCER - CONCENTRIC PIPE REDUCER - ECCENTRIC PIPE UP UNION CONNECTION BALL VALVE
AB. VINGS AND SITE VISITS AND RIFY EXISTING CONDITIONS AND DEMOLITION WITH OTHER OUCTION. T AND FIXTURES TO BE D FIXTURES TO BE SALVAGED VIPMENT. FIXTURES AND ORT TO OWNER'S DESIGNATED NG PROPERLY. NOTIFY THE AND/OR MALFUNCTIONING ABANDONED, RELOCATED, VRFACES. ALL SUCH WORK SHALL NG TO BE ABANDONED ND REPAIR TO MATCH NEW OREMAIN FOR NEW OREMAIN	BDD BACKDRAFT DAMPER VOLUME DAMPER FD FIRE DAMPER FSD FIRE/SMOKE DAMPER SD SMOKE DAMPER MOTORIZED DAMPER D MOTORIZED DAMPER D VAV TERMINAL UNIT WITH REHEAT COIL	CEILING DIFFUSER (ARROWS INDICATE THROW DIRECTIONS) CEILING DIFFUSER (ARROWS INDICATE THROW DIRECTIONS) CONSTRUCTION REMAIN EXISTING TO REMAIN EXISTING TO BE REMOVED NEW WORK POINT OF CONNECTION NEW TO EXISTING UNIT OF DEMOLITION CO2 CARBON DIOXIDE SENSOR (MOUNT 48" AFF) CO CARBON MONOXIDE SENSOR (H) HUMIDISTAT (MOUNT 48" AFF) T THERMOSTAT (MOUNT 48" AFF)		FLANGE CONNECTION FLEXIBLE CONNECTOR PIPE CONNECTION - BOTTOM PIPE CONNECTION - TOP PIPE DOWN PIPE END CAP PIPE REDUCER - CONCENTRIC PIPE REDUCER - ECCENTRIC PIPE UP UNION CONNECTION BALL VALVE BUTTERFLY VALVE
AB. VINGS AND SITE VISITS AND RIFY EXISTING CONDITIONS AND DEMOLITION WITH OTHER SUCTION. T AND FIXTURES TO BE D FIXTURES TO BE SALVAGED VIPMENT. FIXTURES AND ORT TO OWNER'S DESIGNATED NG PROPERLY. NOTIFY THE AND/OR MALFUNCTIONING ABANDONED, RELOCATED, VIRFACES. ALL SUCH WORK SHALL NG TO BE ABANDONED ND REPAIR TO MATCH NEW CREMAIN FOR NEW XK AT NO EXTRA COST TO THE ARCHITECTURAL AND OTHER G OF ANY DISCOVERED E NOT SCHEDULED FOR ONTRACT DOCUMENTS. SUCH VELINEATING THE PROPOSED D AREA. E OF DEMOLITION WORK FOR AND NOT INCLUDED WITHIN THE	BDD BACKDRAFT DAMPER VOLUME DAMPER FD FIRE DAMPER FSD FIRE/SMOKE DAMPER SD SMOKE DAMPER SD MOTORIZED DAMPER Image: Structure EQUIPMENT VAV TERMINAL UNIT WITH REHEAT COIL VAV TERMINAL UNIT - COOLING ONLY	CEILING DIFFUSER (ARROWS INDICATE THROW DIRECTIONS) CEILING TO REMAIN EXISTING TO REMAIN EXISTING TO BE REMOVED NEW WORK POINT OF CONNECTION NEW TO EXISTING LIMIT OF DEMOLITION CO2 CARBON DIOXIDE SENSOR (MOUNT 48" AFF) CO CARBON MONOXIDE SENSOR H HUMIDISTAT (MOUNT 48" AFF) CO T THERMOSTAT (MOUNT 48" AFF) CO DETAIL		FLANGE CONNECTION FLEXIBLE CONNECTOR PIPE CONNECTION - BOTTOM PIPE CONNECTION - TOP PIPE DOWN PIPE END CAP PIPE REDUCER - CONCENTRIC PIPE REDUCER - ECCENTRIC PIPE UP UNION CONNECTION BALL VALVE BUTTERFLY VALVE CHECK VALVE
AB. VINGS AND SITE VISITS AND RIFY EXISTING CONDITIONS AND DEMOLITION WITH OTHER RUCTION. T AND FIXTURES TO BE D FIXTURES TO BE SALVAGED JIPMENT. FIXTURES AND ORT TO OWNER'S DESIGNATED NG PROPERLY. NOTIFY THE AND/OR MALFUNCTIONING ABANDONED, RELOCATED, JRFACES. ALL SUCH WORK SHALL ING TO BE ABANDONED ND REPAIR TO MATCH NEW O REMAIN FOR NEW RK AT NO EXTRA COST TO THE ARCHITECTURAL AND OTHER IG OF ANY DISCOVERED E NOT SCHEDULED FOR CONTRACT DOCUMENTS. SUCH DELINEATING THE PROPOSED ED AREA. E OF DEMOLITION WORK FOR AND NOT INCLUDED WITHIN THE	BDD BACKDRAFT DAMPER VOLUME DAMPER FD FIRE DAMPER FSD FIRE/SMOKE DAMPER SD SMOKE DAMPER SD SMOKE DAMPER SD MOTORIZED DAMPER Image: Structure Image: Structure <	CEILING DIFFUSER (ARROWS INDICATE THROW DIRECTIONS) CEILING TO REMAIN EXISTING TO REMAIN EXISTING TO BE REMOVED NEW WORK POINT OF CONNECTION NEW TO EXISTING LIMIT OF DEMOLITION CO2 CARBON DIOXIDE SENSOR (MOUNT 48" AFF) CO CARBON MONOXIDE SENSOR H HUMIDISTAT (MOUNT 48" AFF) T THERMOSTAT (MOUNT 48" AFF) SMOKE DETECTOR		FLANGE CONNECTION FLEXIBLE CONNECTOR PIPE CONNECTION - BOTTOM PIPE CONNECTION - TOP PIPE DOWN PIPE DOWN PIPE REDUCER - CONCENTRIC PIPE REDUCER - ECCENTRIC PIPE UP UNION CONNECTION BALL VALVE BUTTERFLY VALVE CHECK VALVE GLOBE VALVE
AB. VINGS AND SITE VISITS AND RIFY EXISTING CONDITIONS AND DEMOLITION WITH OTHER SUCTION. T AND FIXTURES TO BE D FIXTURES TO BE SALVAGED VIPMENT. FIXTURES AND ORT TO OWNER'S DESIGNATED NG PROPERLY. NOTIFY THE AND/OR MALFUNCTIONING ABANDONED, RELOCATED, VIRFACES. ALL SUCH WORK SHALL NG TO BE ABANDONED ND REPAIR TO MATCH NEW CREMAIN FOR NEW SK AT NO EXTRA COST TO THE ARCHITECTURAL AND OTHER G OF ANY DISCOVERED E NOT SCHEDULED FOR ONTRACT DOCUMENTS. SUCH VELINEATING THE PROPOSED D AREA. E OF DEMOLITION WORK FOR AND NOT INCLUDED WITHIN THE ED ONLY UPON RECEIPT OF	BDD BACKDRAFT DAMPER VOLUME DAMPER FD FIRE DAMPER FSD FIRE/SMOKE DAMPER SD SMOKE DAMPER SD MOTORIZED DAMPER Image: Structure EQUIPMENT VAV TERMINAL UNIT WITH REHEAT COIL VAV TERMINAL UNIT - COOLING ONLY	CEILING DIFFUSER (ARROWS INDICATE THROW DIRECTIONS) CEILING TO REMAIN EXISTING TO REMAIN EXISTING TO BE REMOVED NEW WORK POINT OF CONNECTION NEW TO EXISTING LIMIT OF DEMOLITION CO2 CARBON DIOXIDE SENSOR (MOUNT 48" AFF) CO CARBON MONOXIDE SENSOR H HUMIDISTAT (MOUNT 48" AFF) CO T THERMOSTAT (MOUNT 48" AFF) CO DETAIL		FLANGE CONNECTION FLEXIBLE CONNECTOR PIPE CONNECTION - BOTTOM PIPE CONNECTION - TOP PIPE DOWN PIPE BOUCER - CONCENTRIC PIPE REDUCER - ECCENTRIC PIPE UP UNION CONNECTION BALL VALVE BUTTERFLY VALVE GLOBE VALVE SHUT-OFF VALVE PRESSURE REDUCING VALVE
AB. INGS AND SITE VISITS AND RIFY EXISTING CONDITIONS AND DEMOLITION WITH OTHER UCTION. TAND FIXTURES TO BE D FIXTURES TO BE SALVAGED IPMENT. FIXTURES AND DRT TO OWNER'S DESIGNATED NG PROPERLY. NOTIFY THE AND/OR MALFUNCTIONING BANDONED, RELOCATED, RFACES. ALL SUCH WORK SHALL NG TO BE ABANDONED ND REPAIR TO MATCH NEW AREMAIN FOR NEW K AT NO EXTRA COST TO THE ARCHITECTURAL AND OTHER G OF ANY DISCOVERED NOT SCHEDULED FOR ONTRACT DOCUMENTS. SUCH ELINEATING THE PROPOSED D AREA. E OF DEMOLITION WORK FOR AND NOT INCLUDED WITHIN THE ED ONLY UPON RECEIPT OF NG, DUCTWORK, ETC., SHALL CTOR SHALL REMOVE ALL	BDD BACKDRAFT DAMPER VOLUME DAMPER FD FIRE DAMPER FD FIRE/SMOKE DAMPER SD SMOKE DAMPER SD SMOKE DAMPER MOTORIZED DAMPER Image: State in the state in	CEILING DIFFUSER (ARROWS INDICATE THROW DIRECTIONS) CEILING TO REMAIN EXISTING TO REMAIN EXISTING TO BE REMOVED NEW WORK POINT OF CONNECTION NEW TO EXISTING V LIMIT OF DEMOLITION CO2 CARBON DIOXIDE SENSOR (MOUNT 48" AFF) CO CARBON MONOXIDE SENSOR (H) HUMIDISTAT (MOUNT 48" AFF) CO CARBON MONOXIDE SENSOR (H) HUMIDISTAT (MOUNT 48" AFF) CO CARBON DIOXIDE SENSOR (H) HUMIDISTAT (MOUNT 48" AFF) CO CO CARBON DIOXIDE SENSOR (H) HUMIDISTAT (MOUNT 48" AFF) CO CO CO CO CO CO CO CO CO CO		FLANGE CONNECTION FLEXIBLE CONNECTOR PIPE CONNECTION - BOTTOM PIPE CONNECTION - TOP PIPE DOWN PIPE DOWN PIPE REDUCER - CONCENTRIC PIPE REDUCER - ECCENTRIC PIPE UP UNION CONNECTION BALL VALVE BUTTERFLY VALVE CHECK VALVE GLOBE VALVE SHUT-OFF VALVE
AB. INGS AND SITE VISITS AND RIFY EXISTING CONDITIONS AND DEMOLITION WITH OTHER UCTION. AND FIXTURES TO BE OFIXTURES TO BE SALVAGED IPMENT. FIXTURES AND ORT TO OWNER'S DESIGNATED ING PROPERLY. NOTIFY THE ND/OR MALFUNCTIONING BANDONED, RELOCATED, RFACES. ALL SUCH WORK SHALL NG TO BE ABANDONED ND REPAIR TO MATCH NEW REMAIN FOR NEW K AT NO EXTRA COST TO THE ARCHITECTURAL AND OTHER G OF ANY DISCOVERED NOT SCHEDULED FOR ONTRACT DOCUMENTS. SUCH ELINEATING THE PROPOSED D AREA. E OF DEMOLITION WORK FOR AND NOT INCLUDED WITHIN THE ED ONLY UPON RECEIPT OF NG, DUCTWORK, ETC., SHALL TTOR SHALL REMOVE ALL TION, HANGERS, DUCTWORK,	BDD BACKDRAFT DAMPER VOLUME DAMPER FD FIRE DAMPER FSD FIRE/SMOKE DAMPER SD SMOKE DAMPER SD MOTORIZED DAMPER MOTORIZED DAMPER Image: Comparison of the second sec	CEILING DIFFUSER (ARROWS INDICATE THROW DIRECTIONS) CEILING TO REMAIN EXISTING TO REMAIN EXISTING TO BE REMOVED NEW WORK POINT OF CONNECTION NEW TO EXISTING V LIMIT OF DEMOLITION CO2 CARBON DIOXIDE SENSOR (MOUNT 48" AFF) CO CARBON MONOXIDE SENSOR (H) HUMIDISTAT (MOUNT 48" AFF) CO CARBON MONOXIDE SENSOR (H) HUMIDISTAT (MOUNT 48" AFF) CO CARBON DIOXIDE SENSOR (H) HUMIDISTAT (MOUNT 48" AFF) CO CO CARBON DIOXIDE SENSOR (H) HUMIDISTAT (MOUNT 48" AFF) CO CO CO CO CO CO CO CO CO CO		FLANGE CONNECTION FLEXIBLE CONNECTOR PIPE CONNECTION - BOTTOM PIPE CONNECTION - TOP PIPE DOWN PIPE BOUCER - CONCENTRIC PIPE REDUCER - ECCENTRIC PIPE UP UNION CONNECTION BALL VALVE BUTTERFLY VALVE GLOBE VALVE SHUT-OFF VALVE PRESSURE REDUCING VALVE
AB. INGS AND SITE VISITS AND RIFY EXISTING CONDITIONS AND DEMOLITION WITH OTHER UCTION. I AND FIXTURES TO BE D FIXTURES TO BE SALVAGED IPMENT. FIXTURES AND DRT TO OWNER'S DESIGNATED NG PROPERLY. NOTIFY THE AND/OR MALFUNCTIONING ABANDONED, RELOCATED, RFACES. ALL SUCH WORK SHALL NG TO BE ABANDONED ND REPAIR TO MATCH NEW REMAIN FOR NEW K AT NO EXTRA COST TO THE ARCHITECTURAL AND OTHER G OF ANY DISCOVERED E NOT SCHEDULED FOR ONTRACT DOCUMENTS. SUCH ELINEATING THE PROPOSED D AREA. E OF DEMOLITION WORK FOR AND NOT INCLUDED WITHIN THE ED ONLY UPON RECEIPT OF ING, DUCTWORK, ETC., SHALL CTOR SHALL REMOVE ALL TION, HANGERS, DUCTWORK, WALLS/ROOF/FLOOR TO	BDD BACKDRAFT DAMPER VOLUME DAMPER FD FIRE DAMPER FSD FIRE/SMOKE DAMPER SD SMOKE DAMPER SD SMOKE DAMPER MOTORIZED DAMPER	CEILING DIFFUSER (ARROWS INDICATE THROW DIRECTIONS) CEILING TO REMAIN EXISTING TO REMAIN EXISTING TO BE REMOVED NEW WORK POINT OF CONNECTION NEW TO EXISTING V LIMIT OF DEMOLITION CO2 CARBON DIOXIDE SENSOR (MOUNT 48" AFF) CO CARBON MONOXIDE SENSOR (H) HUMIDISTAT (MOUNT 48" AFF) CO CARBON MONOXIDE SENSOR (H) HUMIDISTAT (MOUNT 48" AFF) CO CARBON DIOXIDE SENSOR (H) HUMIDISTAT (MOUNT 48" AFF) CO CO CARBON DIOXIDE SENSOR (H) HUMIDISTAT (MOUNT 48" AFF) CO CO CO CO CO CO CO CO CO CO		FLANGE CONNECTION FLEXIBLE CONNECTOR PIPE CONNECTION - BOTTOM PIPE CONNECTION - TOP PIPE DOWN PIPE END CAP PIPE REDUCER - CONCENTRIC PIPE REDUCER - ECCENTRIC PIPE UP UNION CONNECTION BALL VALVE BUTTERFLY VALVE GLOBE VALVE GLOBE VALVE SHUT-OFF VALVE PRESSURE REDUCING VALVE RELIEF VALVE
AB. INGS AND SITE VISITS AND RIFY EXISTING CONDITIONS AND DEMOLITION WITH OTHER UCTION. AND FIXTURES TO BE O FIXTURES TO BE SALVAGED IPMENT. FIXTURES AND ORT TO OWNER'S DESIGNATED NG PROPERLY. NOTIFY THE ND/OR MALFUNCTIONING BANDONED, RELOCATED, RFACES. ALL SUCH WORK SHALL NG TO BE ABANDONED ND REPAIR TO MATCH NEW REMAIN FOR NEW K AT NO EXTRA COST TO THE ARCHITECTURAL AND OTHER G OF ANY DISCOVERED NOT SCHEDULED FOR ONTRACT DOCUMENTS. SUCH ELINEATING THE PROPOSED D AREA. E OF DEMOLITION WORK FOR AND NOT INCLUDED WITHIN THE ED ONLY UPON RECEIPT OF NG, DUCTWORK, ETC., SHALL CTOR SHALL REMOVE ALL TION, HANGERS, DUCTWORK, R WALLS/ROOF/FLOOR TO LVES, TRAPS, TEMPORARY IPING SYSTEMS AS OFTEN AS	BDD BACKDRAFT DAMPER VOLUME DAMPER FD FIRE DAMPER FSD FIRE/SMOKE DAMPER SD SMOKE DAMPER SD MOTORIZED DAMPER MOTORIZED DAMPER Image: Constraint of the second sec	CEILING DIFFUSER (ARROWS INDICATE THROW DIRECTIONS) CEILING TO REMAIN EXISTING TO REMAIN EXISTING TO BE REMOVED NEW WORK POINT OF CONNECTION NEW TO EXISTING V LIMIT OF DEMOLITION CO2 CARBON DIOXIDE SENSOR (MOUNT 48" AFF) CO CARBON MONOXIDE SENSOR (H) HUMIDISTAT (MOUNT 48" AFF) CO CARBON MONOXIDE SENSOR (H) HUMIDISTAT (MOUNT 48" AFF) CO CARBON DIOXIDE SENSOR (H) HUMIDISTAT (MOUNT 48" AFF) CO CO CARBON DIOXIDE SENSOR (H) HUMIDISTAT (MOUNT 48" AFF) CO CO CO CO CO CO CO CO CO CO		FLANGE CONNECTION FLEXIBLE CONNECTOR PIPE CONNECTION - BOTTOM PIPE CONNECTION - TOP PIPE DOWN PIPE END CAP PIPE REDUCER - CONCENTRIC PIPE REDUCER - ECCENTRIC PIPE UP UNION CONNECTION BALL VALVE BUTTERFLY VALVE GLOBE VALVE GLOBE VALVE SHUT-OFF VALVE PRESSURE REDUCING VALVE RELIEF VALVE SOLENOID VALVE
AB. INGS AND SITE VISITS AND RIFY EXISTING CONDITIONS AND DEMOLITION WITH OTHER UCTION. I AND FIXTURES TO BE D FIXTURES TO BE SALVAGED IPMENT. FIXTURES AND DRT TO OWNER'S DESIGNATED IPMENT. FIXTURES AND DRT TO OWNER'S DESIGNATED ING PROPERLY. NOTIFY THE AND/OR MALFUNCTIONING BANDONED, RELOCATED, RFACES. ALL SUCH WORK SHALL NG TO BE ABANDONED IND REPAIR TO MATCH NEW I REMAIN FOR NEW K AT NO EXTRA COST TO THE ARCHITECTURAL AND OTHER I G OF ANY DISCOVERED INOT SCHEDULED FOR ONTRACT DOCUMENTS. SUCH ELINEATING THE PROPOSED D AREA. I OF DEMOLITION WORK FOR AND NOT INCLUDED WITHIN THE ED ONLY UPON RECEIPT OF ING, DUCTWORK, ETC., SHALL CTOR SHALL REMOVE ALL TION, HANGERS, DUCTWORK, WALLS/ROOF/FLOOR TO LVES, TRAPS, TEMPORARY IPING SYSTEMS AS OFTEN AS TIME LENGTH OF OUTAGES. HE SITE AND DETERMINING	BDD BACKDRAFT DAMPER VOLUME DAMPER FD FIRE DAMPER FSD FIRE/SMOKE DAMPER SD SMOKE DAMPER SD SMOKE DAMPER MOTORIZED DAMPER	CEILING DIFFUSER (ARROWS INDICATE THROW DIRECTIONS) CEILING TO REMAIN EXISTING TO REMAIN EXISTING TO BE REMOVED NEW WORK POINT OF CONNECTION NEW TO EXISTING V LIMIT OF DEMOLITION CO2 CARBON DIOXIDE SENSOR (MOUNT 48" AFF) CO CARBON MONOXIDE SENSOR (H) HUMIDISTAT (MOUNT 48" AFF) CO CARBON MONOXIDE SENSOR (H) HUMIDISTAT (MOUNT 48" AFF) CO CARBON DIOXIDE SENSOR (H) HUMIDISTAT (MOUNT 48" AFF) CO CO CARBON DIOXIDE SENSOR (H) HUMIDISTAT (MOUNT 48" AFF) CO CO CO CO CO CO CO CO CO CO		FLANGE CONNECTION FLEXIBLE CONNECTOR PIPE CONNECTION - BOTTOM PIPE CONNECTION - TOP PIPE DOWN PIPE END CAP PIPE REDUCER - CONCENTRIC PIPE REDUCER - ECCENTRIC PIPE UP UNION CONNECTION BALL VALVE BUTTERFLY VALVE GLOBE VALVE GLOBE VALVE SHUT-OFF VALVE PRESSURE REDUCING VALVE RELIEF VALVE
AB. INGS AND SITE VISITS AND RIFY EXISTING CONDITIONS AND DEMOLITION WITH OTHER UCTION. I AND FIXTURES TO BE D FIXTURES TO BE SALVAGED IPMENT. FIXTURES AND DRT TO OWNER'S DESIGNATED NG PROPERLY. NOTIFY THE AND/OR MALFUNCTIONING ABANDONED, RELOCATED, RFACES. ALL SUCH WORK SHALL NG TO BE ABANDONED ND REPAIR TO MATCH NEW REMAIN FOR NEW K AT NO EXTRA COST TO THE ARCHITECTURAL AND OTHER G OF ANY DISCOVERED NOT SCHEDULED FOR ONTRACT DOCUMENTS. SUCH ELINEATING THE PROPOSED D AREA. E OF DEMOLITION WORK FOR AND NOT INCLUDED WITHIN THE ED ONLY UPON RECEIPT OF ING, DUCTWORK, ETC., SHALL CTOR SHALL REMOVE ALL TION, HANGERS, DUCTWORK, R WALLS/ROOF/FLOOR TO LVES, TRAPS, TEMPORARY IPING SYSTEMS AS OFTEN AS TIME LENGTH OF OUTAGES. HE SITE AND DETERMINING ERFORMED.	BDD BACKDRAFT DAMPER VOLUME DAMPER FD FIRE DAMPER FSD FIRE/SMOKE DAMPER SD SMOKE DAMPER SD SMOKE DAMPER MOTORIZED DAMPER	CEILING DIFFUSER (ARROWS INDICATE THROW DIRECTIONS) CEILING TO REMAIN EXISTING TO REMAIN EXISTING TO BE REMOVED NEW WORK POINT OF CONNECTION NEW TO EXISTING V LIMIT OF DEMOLITION CO2 CARBON DIOXIDE SENSOR (MOUNT 48" AFF) CO CARBON MONOXIDE SENSOR (H) HUMIDISTAT (MOUNT 48" AFF) CO CARBON MONOXIDE SENSOR (H) HUMIDISTAT (MOUNT 48" AFF) CO CARBON DIOXIDE SENSOR (H) HUMIDISTAT (MOUNT 48" AFF) CO CO CARBON DIOXIDE SENSOR (H) HUMIDISTAT (MOUNT 48" AFF) CO CO CO CO CO CO CO CO CO CO		FLANGE CONNECTION FLEXIBLE CONNECTOR PIPE CONNECTION - BOTTOM PIPE CONNECTION - TOP PIPE DOWN PIPE END CAP PIPE REDUCER - CONCENTRIC PIPE REDUCER - ECCENTRIC PIPE UP UNION CONNECTION BALL VALVE BUTTERFLY VALVE GLOBE VALVE GLOBE VALVE SHUT-OFF VALVE PRESSURE REDUCING VALVE RELIEF VALVE SOLENOID VALVE
AB. VINGS AND SITE VISITS AND RIFY EXISTING CONDITIONS AND DEMOLITION WITH OTHER RUCTION. T AND FIXTURES TO BE D FIXTURES TO BE SALVAGED JIPMENT. FIXTURES AND ORT TO OWNER'S DESIGNATED NG PROPERLY. NOTIFY THE AND/OR MALFUNCTIONING ABANDONED, RELOCATED, JRFACES. ALL SUCH WORK SHALL ING TO BE ABANDONED ND REPAIR TO MATCH NEW O REMAIN FOR NEW RK AT NO EXTRA COST TO THE E ARCHITECTURAL AND OTHER IG OF ANY DISCOVERED E NOT SCHEDULED FOR CONTRACT DOCUMENTS. SUCH DELINEATING THE PROPOSED ED ATEA. E OF DEMOLITION WORK FOR AND NOT INCLUDED WITHIN THE ED ONLY UPON RECEIPT OF PING, DUCTWORK, ETC., SHALL CTOR SHALL REMOVE ALL ATION, HANGERS, DUCTWORK, R WALLS/ROOF/FLOOR TO LVES, TRAPS, TEMPORARY PIPING SYSTEMS AS OFTEN AS E TIME LENGTH OF OUTAGES. THE SITE AND DETERMINING PEFORMED. LS, PIPE TUNNELS, CEILINGS,	BDD BACKDRAFT DAMPER VOLUME DAMPER FD FIRE DAMPER FSD FIRE/SMOKE DAMPER SD SMOKE DAMPER SD SMOKE DAMPER MOTORIZED DAMPER	CEILING DIFFUSER (ARROWS INDICATE THROW DIRECTIONS) CEILING TO REMAIN EXISTING TO REMAIN EXISTING TO BE REMOVED NEW WORK POINT OF CONNECTION NEW TO EXISTING V LIMIT OF DEMOLITION CO2 CARBON DIOXIDE SENSOR (MOUNT 48" AFF) CO CARBON MONOXIDE SENSOR (H) HUMIDISTAT (MOUNT 48" AFF) CO CARBON MONOXIDE SENSOR (H) HUMIDISTAT (MOUNT 48" AFF) CO CARBON DIOXIDE SENSOR (H) HUMIDISTAT (MOUNT 48" AFF) CO CO CARBON DIOXIDE SENSOR (H) HUMIDISTAT (MOUNT 48" AFF) CO CO CO CO CO CO CO CO CO CO		FLANGE CONNECTION FLEXIBLE CONNECTOR PIPE CONNECTION - BOTTOM PIPE CONNECTION - TOP PIPE DOWN PIPE DOWN PIPE REDUCER - CONCENTRIC PIPE REDUCER - CONCENTRIC PIPE REDUCER - ECCENTRIC PIPE UP UNION CONNECTION BALL VALVE BUTTERFLY VALVE GLOBE VALVE GLOBE VALVE SHUT-OFF VALVE PRESSURE REDUCING VALVE RELIEF VALVE SOLENOID VALVE VALVE IN RISER Y STRAINER
AB. VINGS AND SITE VISITS AND RIFY EXISTING CONDITIONS (AND DEMOLITION WITH OTHER RUCTION. T AND FIXTURES TO BE D FIXTURES TO BE SALVAGED JIPMENT. FIXTURES AND ORT TO OWNER'S DESIGNATED NG PROPERLY. NOTIFY THE AND/OR MALFUNCTIONING ABANDONED, RELOCATED, JRFACES. ALL SUCH WORK SHALL ING TO BE ABANDONED ND REPAIR TO MATCH NEW D REMAIN FOR NEW RK AT NO EXTRA COST TO THE E ARCHITECTURAL AND OTHER IG OF ANY DISCOVERED E NOT SCHEDULED FOR CONTRACT DOCUMENTS. SUCH DELINEATING THE PROPOSED ED AREA. .E OF DEMOLITION WORK FOR AND NOT INCLUDED WITHIN THE ED ONLY UPON RECEIPT OF PING, DUCTWORK, ETC., SHALL CTOR SHALL REMOVE ALL ATION, HANGERS, DUCTWORK, R WALLS/ROOF/FLOOR TO LVES, TRAPS, TEMPORARY PIPING SYSTEMS AS OFTEN AS E TIME LENGTH OF OUTAGES. THE SITE AND DETERMINING 'ERFORMED. LS, PIPE TUNNELS, CEILINGS, L REMOVE ABANDONED PIPES	BDD BACKDRAFT DAMPER VOLUME DAMPER FD FIRE DAMPER FSD FIRE/SMOKE DAMPER SD SMOKE DAMPER SD SMOKE DAMPER MOTORIZED DAMPER	CEILING DIFFUSER (ARROWS INDICATE THROW DIRECTIONS) CEILING TO REMAIN EXISTING TO REMAIN EXISTING TO BE REMOVED NEW WORK POINT OF CONNECTION NEW TO EXISTING V LIMIT OF DEMOLITION CO2 CARBON DIOXIDE SENSOR (MOUNT 48" AFF) CO CARBON MONOXIDE SENSOR (H) HUMIDISTAT (MOUNT 48" AFF) CO CARBON MONOXIDE SENSOR (H) HUMIDISTAT (MOUNT 48" AFF) CO CARBON DIOXIDE SENSOR (H) HUMIDISTAT (MOUNT 48" AFF) CO CO CARBON DIOXIDE SENSOR (H) HUMIDISTAT (MOUNT 48" AFF) CO CO CO CO CO CO CO CO CO CO		FLANGE CONNECTION FLEXIBLE CONNECTOR PIPE CONNECTION - BOTTOM PIPE CONNECTION - TOP PIPE DOWN PIPE BND CAP PIPE REDUCER - CONCENTRIC PIPE REDUCER - ECCENTRIC PIPE UP UNION CONNECTION BALL VALVE BUTTERFLY VALVE GLOBE VALVE GLOBE VALVE GLOBE VALVE SHUT-OFF VALVE PRESSURE REDUCING VALVE RELIEF VALVE SOLENOID VALVE VALVE IN RISER Y STRAINER Y STRAINER (WITH VALVE)
REA TO BE PENETRATED TO LAB. WINGS AND SITE VISITS AND ERIFY EXISTING CONDITIONS K AND DEMOLITION WITH OTHER RUCTION. WI AND FIXTURES TO BE ND FIXTURES TO BE SALVAGED UIPMENT. FIXTURES AND PORT TO OWNER'S DESIGNATED ING PROPERLY. NOTIFY THE AND/OR MALFUNCTIONING ABANDONED, RELOCATED, URFACES. ALL SUCH WORK SHALL PING TO BE ABANDONED AND REPAIR TO MATCH NEW O REMAIN FOR NEW RK AT NO EXTRA COST TO THE E ARCHITECTURAL AND OTHER NG OF ANY DISCOVERED WE NOT SCHEDULED FOR CONTRACT DOCUMENTS. SUCH DELINEATING THE PROPOSED ED AREA. LE OF DEMOLITION WORK FOR 'AND NOT INCLUDED WITHIN THE FED ONLY UPON RECEIPT OF PING, DUCTWORK, ETC., SHALL ACTOR SHALL REMOVE ALL ATION, HANGERS, DUCTWORK, IR WALLS/ROOF/FLOOR TO ALVES, TRAPS, TEMPORARY PIPING SYSTEMS AS OFTEN AS E TIME LENGTH OF OUTAGES. THE SITE AND DETERMINING PERFORMED. LS, PIPE TUNNELS, CEILINGS, L REMOVE ABANDONED PIPES TWORK, ETC. INDICATED IS ED BY THE CONTRACTOR. INSTALL (TO CONNECT TO OR CLEAR	BDD BACKDRAFT DAMPER VOLUME DAMPER FD FIRE DAMPER FSD FIRE/SMOKE DAMPER SD SMOKE DAMPER SD SMOKE DAMPER MOTORIZED DAMPER	CEILING DIFFUSER (ARROWS INDICATE THROW DIRECTIONS) CEILING TO REMAIN EXISTING TO REMAIN EXISTING TO BE REMOVED NEW WORK POINT OF CONNECTION NEW TO EXISTING V LIMIT OF DEMOLITION CO2 CARBON DIOXIDE SENSOR (MOUNT 48" AFF) CO CARBON MONOXIDE SENSOR (H) HUMIDISTAT (MOUNT 48" AFF) CO CARBON MONOXIDE SENSOR (H) HUMIDISTAT (MOUNT 48" AFF) CO CARBON DIOXIDE SENSOR (H) HUMIDISTAT (MOUNT 48" AFF) CO CO CARBON DIOXIDE SENSOR (H) HUMIDISTAT (MOUNT 48" AFF) CO CO CO CO CO CO CO CO CO CO		FLANGE CONNECTIONFLEXIBLE CONNECTORPIPE CONNECTION - BOTTOMPIPE CONNECTION - TOPPIPE DOWNPIPE DOWNPIPE REDUCER - CONCENTRICPIPE REDUCER - ECCENTRICPIPE UPUNION CONNECTIONBALL VALVEBUTTERFLY VALVECHECK VALVEGLOBE VALVESHUT-OFF VALVEPRESSURE REDUCING VALVERELIEF VALVESOLENOID VALVEVALVE IN RISERY STRAINERY STRAINER (WITH VALVE)2-WAY AUTOMATIC CONTROL VALVE
LAB. WINGS AND SITE VISITS AND ERIFY EXISTING CONDITIONS K AND DEMOLITION WITH OTHER RUCTION. NT AND FIXTURES TO BE SALVAGED UIPMENT. FIXTURES AND PORT TO OWNER'S DESIGNATED ING PROPERLY. NOTIFY THE AND/OR MALFUNCTIONING ABANDONED, RELOCATED, URFACES. ALL SUCH WORK SHALL PING TO BE ABANDONED AND REPAIR TO MATCH NEW O REMAIN FOR NEW RK AT NO EXTRA COST TO THE E ARCHITECTURAL AND OTHER NG OF ANY DISCOVERED RE NOT SCHEDULED FOR CONTRACT DOCUMENTS. SUCH DELINEATING THE PROPOSED ED AREA. LE OF DEMOLITION WORK FOR Y AND NOT INCLUDED WITHIN THE TED ONLY UPON RECEIPT OF PING, DUCTWORK, ETC., SHALL ACTOR SHALL REMOVE ALL ATION, HANGERS, DUCTWORK, IR WALLS/ROOF/FLOOR TO ALVES, TRAPS, TEMPORARY PIPING SYSTEMS AS OFTEN AS E TIME LENGTH OF OUTAGES. THE SITE AND DETERMINING PERFORMED. LS, PIPE TUNNELS, CEILINGS, L REMOVE ABANDONED PIPES TWORK, ETC. INDICATED IS ED BY THE CONTRACTOR INSTALL (TO CONNECT TO OR CLEAR	BDD BACKDRAFT DAMPER VOLUME DAMPER FD FIRE DAMPER FSD FIRE/SMOKE DAMPER SD SMOKE DAMPER SD SMOKE DAMPER MOTORIZED DAMPER	CEILING DIFFUSER (ARROWS INDICATE THROW DIRECTIONS) CEILING TO REMAIN EXISTING TO REMAIN EXISTING TO BE REMOVED NEW WORK POINT OF CONNECTION NEW TO EXISTING V LIMIT OF DEMOLITION CO2 CARBON DIOXIDE SENSOR (MOUNT 48" AFF) CO CARBON MONOXIDE SENSOR (H) HUMIDISTAT (MOUNT 48" AFF) CO CARBON MONOXIDE SENSOR (H) HUMIDISTAT (MOUNT 48" AFF) CO CARBON DIOXIDE SENSOR (H) HUMIDISTAT (MOUNT 48" AFF) CO CO CARBON DIOXIDE SENSOR (H) HUMIDISTAT (MOUNT 48" AFF) CO CO CO CO CO CO CO CO CO CO		FLANGE CONNECTIONFLEXIBLE CONNECTORPIPE CONNECTION - BOTTOMPIPE CONNECTION - TOPPIPE DOWNPIPE BOUCER - CONCENTRICPIPE REDUCER - ECCENTRICPIPE UPUNION CONNECTIONBALL VALVEBUTTERFLY VALVECHECK VALVEGLOBE VALVESHUT-OFF VALVEPRESSURE REDUCING VALVERELIEF VALVEVALVE IN RISERY STRAINER (WITH VALVE)2-WAY AUTOMATIC CONTROL VALVEPRESSURE GAUGE WITH GAUGE COCK
LAB. WINGS AND SITE VISITS AND ERIFY EXISTING CONDITIONS K AND DEMOLITION WITH OTHER RUCTION. WT AND FIXTURES TO BE SALVAGED UIPMENT. FIXTURES AND PORT TO OWNER'S DESIGNATED UNG PROPERLY. NOTIFY THE AND/OR MALFUNCTIONING ABANDONED, RELOCATED, URFACES. ALL SUCH WORK SHALL PING TO BE ABANDONED AND REPAIR TO MATCH NEW O REMAIN FOR NEW RK AT NO EXTRA COST TO THE E ARCHITECTURAL AND OTHER NG OF ANY DISCOVERED WE NOT SCHEDULED FOR CONTRACT DOCUMENTS. SUCH DELINEATING THE PROPOSED ED AREA. LE OF DEMOLITION WORK FOR Y AND NOT INCLUDED WITHIN THE FED ONLY UPON RECEIPT OF PING, DUCTWORK, ETC., SHALL ACTOR SHALL REMOVE ALL ATION, HANGERS, DUCTWORK, IR WALLS/ROOF/FLOOR TO ALVES, TRAPS, TEMPORARY PIPING SYSTEMS AS OFTEN AS E TIME LENGTH OF OUTAGES. THE SITE AND DETERMINING PERFORMED. LS, PIPE TUNNELS, CEILINGS, L REMOVE ABANDONED PIPES TWORK, ETC. INDICATED IS ED BY THE CONTRACTOR. INSTALL	BDD BACKDRAFT DAMPER VOLUME DAMPER FD FIRE DAMPER FSD FIRE/SMOKE DAMPER SD SMOKE DAMPER SD SMOKE DAMPER MOTORIZED DAMPER	CEILING DIFFUSER (ARROWS INDICATE THROW DIRECTIONS) CEILING TO REMAIN EXISTING TO REMAIN EXISTING TO BE REMOVED NEW WORK POINT OF CONNECTION NEW TO EXISTING V LIMIT OF DEMOLITION CO2 CARBON DIOXIDE SENSOR (MOUNT 48" AFF) CO CARBON MONOXIDE SENSOR (H) HUMIDISTAT (MOUNT 48" AFF) CO CARBON MONOXIDE SENSOR (H) HUMIDISTAT (MOUNT 48" AFF) CO CARBON DIOXIDE SENSOR (H) HUMIDISTAT (MOUNT 48" AFF) CO CO CARBON DIOXIDE SENSOR (H) HUMIDISTAT (MOUNT 48" AFF) CO CO CO CO CO CO CO CO CO CO		FLANGE CONNECTIONFLEXIBLE CONNECTORPIPE CONNECTION - BOTTOMPIPE CONNECTION - TOPPIPE DOWNPIPE END CAPPIPE REDUCER - CONCENTRICPIPE REDUCER - ECCENTRICPIPE UPUNION CONNECTIONBALL VALVEBUTTERFLY VALVECHECK VALVEGLOBE VALVESHUT-OFF VALVEPRESSURE REDUCING VALVERELIEF VALVESOLENOID VALVEVALVE IN RISERY STRAINER (WITH VALVE)2-WAY AUTOMATIC CONTROL VALVE3-WAY AUTOMATIC CONTROL VALVE

4

GENERAL PIPING

6

<u> </u>	AUTO
)	DIREC
ØFD	FLOO
►	FLOW
<u> </u>	MANU
S	PIPE (
—— BFW ———	BOILE
CA	COMP
CD	COND
— – CHR – — — –	CHILL
CHS	CHILL
— – CR – – – –	COND
CS	COND
CW	CITY
D	DRAIN
— – DTR – — — –	DUAL
DTS	DUAL
— – HWR– — — –	HOT V
—— HWS ———	HOT V

5

	AUTOMATIC AIR VENT
	DIRECTION OF PIPE PITCH
	FLOOR DRAIN
	FLOW DIRECTION
	MANUAL AIR VENT
S	PIPE CONTINUES
	BOILER FEEDWATER
	COMPRESSED AIR
	CONDENSATE DRAIN
	CHILLED WATER RETURN
	CHILLED WATER SUPPLY
	CONDENSER WATER RETURN
	CONDENSER WATER SUPPLY
	CITY WATER
	DRAIN
	DUAL TEMPERATURE RETURN
	DUAL TEMPERATURE SUPPLY
	HOT WATER RETURN
	HOT WATER SUPPLY

PIPE FITTINGS/VALVES

	FLANGE CONNECTION
	FLEXIBLE CONNECTOR
 کر	PIPE CONNECTION - BOTTOM
<u>}</u>	PIPE CONNECTION - TOP
C	PIPE DOWN
]	PIPE END CAP
>	PIPE REDUCER - CONCENTRIC
N	PIPE REDUCER - ECCENTRIC
0	PIPE UP
	UNION CONNECTION
ю	BALL VALVE
	BUTTERFLY VALVE
——————————————————————————————————————	CHECK VALVE
	GLOBE VALVE
——————————————————————————————————————	SHUT-OFF VALVE
R	PRESSURE REDUCING VALVE
F	RELIEF VALVE
	SOLENOID VALVE
<u> </u>	VALVE IN RISER
K,	Y STRAINER
	Y STRAINER (WITH VALVE)
	2-WAY AUTOMATIC CONTROL VALVE
	3-WAY AUTOMATIC CONTROL VALVE
	PRESSURE GAUGE WITH GAUGE COCK
Щ	THERMOMETER
	MOISTURE SEPARATOR

	ABBRE	VIATIO	NS
AABC AAV	ASSOCIATED AIR BALANCE AUTOMATIC AIR VENT	LB/HR LRA	POUNDS PER HOUR LOCKED ROTOR AMP
ABV AC ACT AD ADDT'L ADJ AFC AFCP	ABOVE AIR CONDITIONING UNIT ACOUSTICAL CEILING TILE ACCESS DOOR ADDITIONAL ADJUST ABOVE FINISHED CEILING AIR FLOW CONTROL PANEL	LWT M MA MAT MAX MBH MC	LEAVING WATER TEMPERATURE MOTORIZED DAMPER MIXED AIR MIXED AIR TEMPERATURE MAXIMUM ONE THOUSAND BTUH MECHANICAL CONTRACTOR
AFF AFM AHU AL AMB AMT APD ARCH	ABOVE FINISHED FLOOR AIR FLOW MEASURING STATION AIR HANDLING UNIT ALUMINUM AMBIENT AMOUNT AIR PRESSURE DROP ARCHITECT	MCC MD MECH MER MFGR MIN MUA MUA	MOTOR CONTROL CENTER MANUAL DAMPER MECHANICAL MECHANICAL EQUIPMENT ROOM MANUFACTURER MINIMUM MAKE-UP AIR MAKE-UP AIR UNIT
ARI AS ASHRAE ASTM ATU AUTO	AMERICAN REFRIGERATION AIR SEPARATOR AMERICAN SOCIETY OF AIR CONDITIONING ENGINEERS AMERICAN SOCIETY FOR TESTING AND MATERIALS AIR TERMINAL UNIT AUTOMATIC	N/A NC NEC NG NO NTS	NOT APPLICABLE NORMALLY CLOSED/NOISE CRITERIA NATIONAL ELECTRICAL CODE NATURAL GAS NUMBER/NORMALLY OPEN NOT TO SCALE
B BAL BCU BHP BOP BLDG BLW BOS BPD BTUH	BOILER BALANCE/ING BUILDING CONTROL UNIT BOILER HORSEPOWER/BRAKE BOTTOM OF PIPE BUILDING BELOW BOTTOM OF STEEL BACK PRESSURE DAMPER BRITISH THERMAL UNIT PER HOUR	OA OAF OAL OBD OC OCC OF OPP ORIG O&M	OUTSIDE AIR OUTSIDE AIR FAN OUTSIDE AIR LOUVER OPPOSED BLADE DAMPER ON CENTERPOWER OCCUPIED OVERFLOW OPPOSITE ORIGINAL OPERATION AND MAINTENANCE
CA CAD CAL CAP CAV CC CF CFM CLG CO CONC	COMBUSTION AIR CEILING AIR DIFFUSER COMBUSTION AIR LOUVER CAPACITY CONSTANT AIR VOLUME COOLING COIL CENTRIFUGAL FAN CUBIC FEET PER MINUTE CEILING CLEAN OUT CONCRETE	P PC PD PDCV PH PRV PPH PRESS PSI PSIG PVC	PUMP PLUMBING CONTRACTOR PRESSURE DROP PRESSURE DIFFERENTIAL CONTROL PHASE PRESSURE REDUCING VALVE POUNDS PER HOUR PRESSURE POUNDS PER SQUARE INCH POUNDS PER SQUARE INCH GAUGE POLYVINYL CHLORIDE
COND CONN CONT CP CSR CU CV CV CW DB dB	CONDITIONING CONNECT/CONNECTION CONTINUATION CIRCULATING PUMP CEILING SUPPLY REGISTER CONDENSING UNIT CONTROL VALVE COLD WATER DRY BULB DECIBEL	QTY RA RAG RAR REF REG RF RLA RLAD RM	QUANTITY RETURN AIR RETURN AIR GRILLE RETURN AIR REGISTER REFER/REFERENCE REGISTER RETURN/RELIEF FAN RATED LOAD AMP RETURN LINEAR AIR DIFFUSER ROOM
DDC ΔP DIA DIFF DISC SW DN DP DTL DWG DX	DIRECT DIGITAL CONTROL PRESSURE DROP DIAMETER DIFFERENCE DISCONNECT SWITCH DOWN DEW POINT DETAIL DRAWING DIRECT EXPANSION	RPM SA SAG SAN SAR SC SD SDC SEER SF	REVOLUTIONS PER MINUTE SUPPLY AIR SUPPLY AIR GRILLE SANITARY SUPPLY AIR REGISTER SHADING COEFFICIENT SMOKE DAMPER/SPLITTER DAMPER SOUND DIGITAL CONTROLLER SEASONAL ENERGY EFFICIENCY SUPPLY FAN
EA EAL EAR EAT EC ECON EER EFF ELEV ELL ENT EQUIP	EXHAUST AIR/EACH EXHAUST AIR LOUVER EXHAUST AIR REGISTER ENTERING AIR TEMPERATURE ELECTRICAL CONTRACTOR ECONOMIZER ENERGY EFFICIENCY RATIO EXHAUST FAN EFFICIENCY ELEVATION ELBOW ENTERING EQUIPMENT	SF SIM SLAD SMACNA SO SP SPEC SQ FT SQ IN SRV SS STL STN SUSP	SUFFLITEAN SIMILIAR SLOT LINEAR AIR DIFFUSER SHEET METAL AND AIR SCREENED OPENING STATIC PRESSURE SPECIFICATION SQUARE FEET SQUARE INCHES STEAM RELIEF VENT STAINLESS STEEL STEEL SECTION SUSPENSION
EQUIV ESP EST EWH EWT EXH EXIST	EQUIVALENT EXTERNAL STATIC PRESSURE ESTIMATED ELECTRIC WALL HEATER ENTERING WATER EXHAUST EXISTING	SWR SYM T TCC TD TEMP TG	SIDE WALL REGISTER SYMBOL THERMOSTAT TEMPERATURE CONTROLIPERATURE TEMPERATURE DIFFERENCE TEMPERATURE TRANSFER GRILLE
°F FC FD FFE FLA FLEX FLEX	DEGREES FAHRENHEIT FLEXIBLE CONNECTION FIRE DAMPER FINISHED FLOOR ELEVATION FULL LOAD AMP FLEXIBLE FLANGE	TOS TOT TSP TV TXV TYP	TOP OF STEEL TOTAL TOTAL STATIC PRESSURE TURNING VANE THERMAL EXPANSION VALVE TYPICAL
FLR FM FPM FT FT WG	FLOOR FACTORY MUTUAL FEET PER MINUTE FEET FEET OF WATER GAUGE	U UG UL UNOCC	UNDERCUT UNDERGROUND UNDERWRITERS LABORATORY UNOCCUPIED VOLTS
GA GAL GC GPM	GAUGE GALLONS GENERAL CONTRACTOR GALLONS PER MINUTE	VAV VD VDR VFD VOL	VARIABLE AIR VOLUME VOLUME DAMPER VANED RETURN REGISTER VARIABLE FREQUENCY DRIVE VOLUME
H HD HP HVAC HZ	HEIGHT HEAD HORSEPOWER HEATING, VENTILATION & AIR HERTZ	VTR W W/ WB WG	VENT THROUGH ROOF WATT WITH WET BULB WATER GAUGE
IN INSUL IWG KW	INCHES INSULATE/INSULATION INCHES WATER GAUGE KILOWATT	WG WPD W/O	WATER GAUGE WATER PRESSURE DROP WITHOUT
LAT LB LBG	LEAVING AIR TEMPERATURE POUND LINEAR BAR GRILLE		AN FLOOR LEVEL "0" LOWEST FLOOR "1" NEXT FLOOR

8

OF	PHILADELPHIA
	FICE OF CAPITAL PROGRAMS
	PHILADELPHIA, PA 19130 - 4015 215) 400 - 4730 (215) 400 - 4731 (fax) www.philasd.org
SEA	L:
	VASSELS A STARDIS PEOSITICS PEOSITICS
	S K. Skardis AND LICENSE NO: PA PE081586 DATE 09/30/2019
	nitectural:
Addre PA 1	HRADERGROUP Architecture, LL ess: 161 Leverington Ave, Suite 105, Philadel 9127 ne: 215.482.7440
Fax: Emai	1: bgood@grarc.com Brian Good
<u>MEI</u>	GES
	val Engineering Solutions®
Bethe Phon	ess: 6700A Rockledge Drive, Suite 301 esda Maryland 20817 le: 301.216.2871 301.216.9671
Emai	I: anilg@theges.com Anil Giri
	DOCUMENTS
<u>APR</u>	<u>IL 20, 2018</u>
· ·	
1 NO.	05/09/18ADDENDUM 1DATEREVISION
NO. SCH	DATE REVISION
NO. SCH	DATE REVISION
NO. SCH	DATE REVISION HOOL & LOCATION Frand T. Steel Elementary School Wayne Avenue, Philadelphia, P
NO. SCH Edw 4301 1914 PRC	DATE REVISION HOOL & LOCATION Yard T. Steel Elementary School Wayne Avenue, Philadelphia, P 20
NO. SCF Edw 4301 1914 PRC Class	DATE REVISION HOOL & LOCATION Frand T. Steel Elementary School Wayne Avenue, Philadelphia, P
NO. SCF Edw 4301 1914 PRC Class	DATEREVISIONIOOL & LOCATIONward T. Steel Elementary SchoolWayne Avenue, Philadelphia, PODJECT TITLESTOOM Modifications to Edward
NO. SCH Edw 4301 1914 PRC Clas Stee	DATEREVISIONIOOL & LOCATIONward T. Steel Elementary SchoolWayne Avenue, Philadelphia, PODJECT TITLESTOOM Modifications to Edward
NO. SCH Edw 4301 1914 PRC Class Stee DRA	DATE REVISION IOOL & LOCATION vard T. Steel Elementary School Wayne Avenue, Philadelphia, P O DJECT TITLE Ssroom Modifications to Edward el Elementary School AWING TITLE AWING TITLE
NO. SCF Edw 4301 1914 PRC Class Stee DRA MEC	DATE REVISION IOOL & LOCATION vard T. Steel Elementary School Wayne Avenue, Philadelphia, P O DJECT TITLE Ssroom Modifications to Edward el Elementary School AWING TITLE AWING TITLE
NO. SCH Edw 4301 1914 PRC Clas Stee DRA MEC SHE	DATE REVISION IOOL & LOCATION vard T. Steel Elementary School Wayne Avenue, Philadelphia, P O DJECT TITLE ssroom Modifications to Edward Elementary School AWING TITLE AWING TITLE FILE NO.
NO. SCH Edw 4301 1914 PRC Class Stee DRA MEC SHEI	DATE REVISION IOOL & LOCATION vard T. Steel Elementary School Wayne Avenue, Philadelphia, P O DJECT TITLE ssroom Modifications to Edward Elementary School AWING TITLE AWING TITLE FILE NO.
NO. SCH Edw 4301 1914 PRC Class Stee DRA MEC SHEI LOCA XX-XX DRA	DATE REVISION IOOL & LOCATION vard T. Steel Elementary School Wayne Avenue, Philadelphia, P Wayne Avenue, Philadelphia, P O DJECT TITLE Ssroom Modifications to Edward P Elementary School WING TITLE AWING TITLE HANICAL AND PLUMBING COVE ET ATION NO. XX AN BY CHECKED BY AG
NO. SCH Edw 4301 1914 PRC Class Stee DRA MEC SHEI LOCA XX-XX DRA	DATE REVISION IOOL & LOCATION vard T. Steel Elementary School Wayne Avenue, Philadelphia, P O DJECT TITLE ssroom Modifications to Edward Elementary School AWING TITLE AWING TITLE ATION NO. FILE NO. XX ATION NO. FILE NO. ATION NO. FILE NO.
NO. SCH Edw 4301 1914 PRC Class Stee DRA MEC SHEI LOC/ XX-XX DRAN HS	DATE REVISION IOOL & LOCATION vard T. Steel Elementary School Wayne Avenue, Philadelphia, P O DJECT TITLE Ssroom Modifications to Edward Elementary School AWING TITLE HANICAL AND PLUMBING COVE ET ATION NO. XX MN BY CHECKED BY AG B-067 C OF 2017/18
NO. SCH Edw 4301 1914 PRC Class Stee DRA MEC SHEI LOC/ XX-XX DRAN HS	DATE REVISION IOOL & LOCATION vard T. Steel Elementary School Wayne Avenue, Philadelphia, P O DJECT TITLE esroom Modifications to Edward Telementary School DJECT TITLE AWING TITLE HANICAL AND PLUMBING COVE ET ATION NO. XX MN BY CHECKED BY AG B-067 C OF 2017/18 B-070 C OF AWING NO.
NO. SCH Edw 4301 1914 PRC Class Stee DRA MEC SHEI LOC/ XX-XX DRAN HS	DATE REVISION IOOL & LOCATION vard T. Steel Elementary School Wayne Avenue, Philadelphia, P O DJECT TITLE Ssroom Modifications to Edward Elementary School AWING TITLE HANICAL AND PLUMBING COVE ET ATION NO. XX MN BY CHECKED BY AG B-067 C OF 2017/18

