# THE SCHOOL DISTRICT OF PHILADELPHIA Office of Capital Programs 440 North Broad Street, 3<sup>rd</sup> Floor – Suite 371 Philadelphia, PA 19130

TELEPHONE: (215) 400-4730

#### Addendum No. 001

**Subject:** William Rowen School – Classroom Modifications

SDP Contract Nos. B-063C, B-066C of 2017/18

Location: William Rowen School

6841 North 19th Street

Philadelphia, Pennsylvania 19126

This Addendum, dated May 9, 2018, shall modify and become part of the Contract Documents for the work of this project. Any items not mentioned herein, or affected by, shall be performed strictly in accordance with the original documents.

The following items, clarifications and/or revisions are to be included in the Contract Documents:

#### **DRAWINGS**

#### Drawing: A101

#### Revisions:

- Renovation Notes: Delete the second sentence in this note (typical for all drawings). The note should read:
  - A12 PAINT EXISTING CMU/PLASTER/GWB WALL AND EXPOSED PIPES. SCRAPE EXISTING LOOSE PAINT, SAND, CLEAN (INCLUDING THE REMOVAL OF ALL STAPELS, ETC.) AND PREP SURFACE FOR NEW FINISH.
- b. Renovation Notes: Add notes A44 and A45 to read as follows (typical for all drawings):
  - A44 INSTALL NEW WOOD LOUVERS WHERE MISSING IN EXISTING DOOR. MATCH EXISTING ADJACENT.
  - A45 REMOVE EXISTING FIBERGLASS PANEL IN EXISTING DOOR AND REPLACE WITH WOOD GRILLES AND GLASS TO RESTORE DOOR TO ORIGINAL DESIGN. MATCH EXISTING ADJACENT PROFILES, ETC.
- c. Demolition First Floor Plan Area A, 1/A101: Delete the two interior elevation tags in Kindergarten 102
- d. Proposed First Floor Plan Area A, 2/A101: Add renovation tag A44 to doors 101-2, 101A, 102-2 and 102A.
- e. Proposed First Floor Plan Area A, 2/A101: Add renovation tag A45 to door 101-1.

#### Drawing: A101.2

#### Revisions:

- a. Proposed First Floor Plan Area B, 2/A101.2: Delete renovation tag A39 indicated at the south wall alcove area.
- b. Proposed First Floor Plan Area B, 2/A101.2: Add renovation tag A44 to doors 104-5, 106-3, 108-3 and 110-3.

Drawing: A101.4 Revisions:

a. Proposed First Floor Plan Area C, 2/A101.4: Add renovation tag A44 to doors 107-3, 109-3 and 111-3.

#### Drawing: A102

#### Revisions:

a. Proposed Second Floor Plan Area A, 2/A102: Add renovation tag A44 to door 201-2.

#### Drawing: A102.1

#### Revisions:

- a. Proposed Second Floor Plan Area B, 2/A102.1: Add renovation tag A44 to doors 205-3 and 209-3.
- b. Proposed Second Floor Plan Area B, 2/A102.1: Add renovation tag A45 to door 205-1.
- c. Interior Elevation 1/A102.1: The markerboard/tackboard unit should be centered on the wall.

### Drawing: A102.2

#### Revisions:

a. Proposed Second Floor Plan Area C, 2/A102.2: Add renovation tag A44 to door 210-3.

#### Drawing: A601

#### Revisions:

a. Door and Frame Schedule: See attached revised drawing A601 for added "Hardware Type" column.

#### Drawing: All mechanical drawings

#### Revisions:

a. ADD key plan and seal information on all mechanical sheets.

#### Drawing: All Mechanical and Electrical Drawings

#### Revisions:

- a. Revised B-numbers on titleblock
- b. Revised Project title on titleblock

#### Drawing: ED111

#### Revisions:

a. Add key plan.

#### Drawing: **ED112**

#### Revisions:

- a. Added MDF room 201.
- b. Add Key plan.

### Drawing: **ED121**

#### Revisions:

a. Add Key plan

### Drawing: **ED122**

#### Revisions:

- a. Added MDF room 201.
- b. Add Key plan.

#### Drawing: E111

#### Revisions:

a. Add key plan.

#### Drawing: **E112**

### Revisions:

- a. Added MDF room 201.
- b. Add Key plan

Drawing: **E121** 

Revisions:

a. Add Key plan.

Drawing: **E122** 

Revisions:

- a. Added MDF room 201.
- b. Add Key plan.

Drawing: E301

Revisions:

- a. Delete Panelboard detail.
- b. Add room name and number on Data riser diagram.

#### **BIDDER'S QUESTIONS**

1. <u>Question</u>: Due to the scope of work for all projects, the substantial completion date is unachievable. Along with lost time for moving of furniture and equipment before start of project. Can the date for substantial completion be extended?

Response: No

**2. Question:** Visual Display Surfaces - in spec there is a note if new boards are not installed in time, to use temporary boards as necessary, how many temporary boards are we to provide per classroom?

Response: Temporary boards do not need to be provided.

3. Question: Do we need to provide temporary window shades, if new ones are not installed before start of school?

Response: No. Existing shades are to be removed and salvaged/protected and reinstalled until new shades can be installed.

**Question:** Wood Floor Refinishing- some projects call for 2 coats of stain, can we forgo the stain and just use 2 coats of sealer and 2 coats of finish for all projects. You are adding on time to an already accelerated schedule.

<u>Response:</u> Sand, seal, and finish the wood floors in accordance with the specifications. Omit staining of the floor.

**5. Question:** Have you checks on the choices of accent colors for the VCT tile? The colors may be a stock color, but do they have enough on hand, if not they may not be readily available for the substantial completion date.

<u>Response:</u> Armstrong has been made aware of this project and its approximate square footage needs. Contractor to provide updated information on each color's availability immediately after NTP.

**6. Question:** Can you please include and spec for electrostatic painting.

Response: See Electrostatic Paint spec in Addendum #2.

#### **ATTACHMENTS**

Drawing A601

Drawing E001

Drawing ED111

Drawing ED112

Drawing ED121

Drawing ED122
Drawing E111
Drawing E112
Drawing E121
Drawing E122
Drawing E301
Drawing M001
Drawing M111
Drawing M112

End of Addendum No. 1

						DO	OR ANI	D FRAME	SCHED	ULE		<i>کسر</i>	~~~~	_
				DOOR				FF	RAME		GLAZING	FIRE	HARDWARE	_
NO.	TYPE	WIDTH	HEIGHT	THICKNESS	MATERIAL	FINISH	TYPE	MATERIAL	FINISH	DEPTH	TYPE	RATING	SET	COMMENTS
101-1	EX	6' - 0"	7' - 0"	0' - 1 3/4"	EX - Wood	Clear Coat	EX	EX - HM	Paint	0' - 4 3/4"	EX		PH-02 / NOTE 10	JOHNINEIVIO
101-2	EX	1' - 6"	7' - 0"	0' - 1 3/4"	EX - Wood	Clear Coat	EX	EX - Wood	Clear Coat	0' - 5 1/2"	-	- (	NOTE 11	
101-3	EX	5' - 0"	7' - 0"	0' - 1 3/4"	EX - Wood	Clear Coat	EX	EX - Wood	Clear Coat	0' - 5 1/2"	-	- (	NOTE 11	
101A	EX	2' - 8"	7' - 0"	0' - 1 3/4"	EX - Wood	Clear Coat	EX	EX - Wood	Clear Coat	0' - 5 1/2"	-	- }	NOTE 11	)
101B		2' - 8"	7' - 0"	0' - 1 3/4"	EX - Wood	Clear Coat	EX	EX - Wood	Clear Coat	0' - 5 1/2"	EX	- >	PH-04 / NOTE 10	7
101C		2' - 8"	7' - 0"	0' - 1 3/4"	EX - Wood	Clear Coat	EX	EX - Wood	Clear Coat	0' - 5 1/2"	EX	- (	PH-04 / NOTE 10	
102-1	EX	6' - 0"	7' - 0"	0' - 1 3/4"	EX - Wood	Clear Coat	EX	EX - HM	Paint	0' - 4 3/4"	EX	- (	PH-02 / NOTE 10	
102-2	EX	1' - 6" 5' - 0"	7' - 0"	0' - 1 3/4"	EX - Wood	Clear Coat	EX	EX - Wood	Clear Coat	0' - 4 3/4"	-	- (	NOTE 11	<del></del>
102-3 102A	EX EX	2' - 6"	7' - 0" 7' - 0"	0' - 1 3/4" 0' - 1 3/4"	EX - Wood EX - Wood	Clear Coat Clear Coat	EX EX	EX - Wood EX - Wood	Clear Coat Clear Coat	0' - 5 1/2" 0' - 4 3/4"	-		NOTE 11 NOTE 11	<b>~</b>
102A	EX	2' - 8"	7' - 0"	0' - 1 3/4"	EX - Wood	Clear Coat	EX	EX - Wood	Clear Coat	0' - 5 1/2"	EX	- (	NOTE 11	_
102C	EX	2' - 8"	7' - 0"	0' - 1 3/4"	EX - Wood	Clear Coat	EX	EX - Wood	Clear Coat	0' - 5 1/2"	EX	- \	NOTE 11	<b>)</b>
104-1	EX	6' - 0"	7' - 0"	0' - 1 3/4"	EX - Wood	Clear Coat	EX	EX - HM	Paint	0' - 4 3/4"	EX	- (	PH-02 / NOTE 10	
104-2		5' - 0"	7' - 0"	0' - 1 3/4"	EX - Wood	Clear Coat	EX	EX - Wood	Clear Coat	0' - 5 1/2"	-	- /	NOTE 11	7
104-3	EX	6' - 0"	7' - 0"	0' - 1 3/4"	EX - Wood	Clear Coat	EX	EX - Wood	Clear Coat	0' - 5 1/2"	-	- (	NOTE 11	4
104-4	EX	2' - 8"	7' - 0"	0' - 1 3/4"	EX - Wood	Clear Coat	EX	EX - Wood	Clear Coat	0' - 5 1/2"	-	- >	NOTE 11	
104-5	EX	1' - 6"	7' - 0"	0' - 1 3/4"	EX - Wood	Clear Coat	EX	EX - Wood	Clear Coat	0' - 5 1/2"	-	- (	NOTE 11	
106-1	EX	6' - 0"	7' - 0"	0' - 1 3/4"	EX - Wood	Clear Coat	EX	EX - HM	Paint	0' - 4 3/4"	EX	-	PH-02 / NOTE 10	
106-2	EX	5' - 0"	7' - 0"	0' - 1 3/4"	EX - Wood	Clear Coat	EX	EX - Wood	Clear Coat	0' - 5 1/2"	-	-	NOTE 11	_
106-3	EX	1' - 6"	7' - 0"	0' - 1 3/4"	EX - Wood	Clear Coat	EX	EX - Wood	Clear Coat	0' - 5 1/2"	-	- >	NOTE 11	
106-4	EX	6' - 0"	7' - 0"	0' - 1 3/4"	EX - Wood	Clear Coat	EX	EX - Wood	Clear Coat	0' - 5 1/2"	-		NOTE 11 NOTE 11	
106-5 107-1		2' - 8" 6' - 0"	7' - 0" 7' - 0"	0' - 1 3/4" 0' - 1 3/4"	EX - Wood EX - Wood	Clear Coat Clear Coat	EX EX	EX - Wood EX - HM	Clear Coat Paint	0' - 5 1/2" 0' - 4 3/4"	EX	- (	PH-02 / NOTE 10	
107-1		5' - 0"	7' - 0"	0' - 1 3/4"	EX - Wood	Clear Coat	EX	EX - Wood	Clear Coat	0' - 5 1/2"	-	- (	NOTE 11	
107-2	EX	1' - 6"	7' - 0"	0' - 1 3/4"	EX - Wood	Clear Coat	EX	EX - Wood	Clear Coat	0' - 5 1/2"	-		NOTE 11	<del>)</del>
107-4	EX	6' - 0"	7' - 0"	0' - 1 3/4"	EX - Wood	Clear Coat	EX	EX - Wood	Clear Coat	0' - 5 1/2"	-		NOTE 11	~
107-5		2' - 8"	7' - 0"	0' - 1 3/4"	EX - Wood	Clear Coat	EX	EX - Wood	Clear Coat	0' - 5 1/2"	-	- (	NOTE 11	)
108-1	EX	3' - 0"	7' - 0"	0' - 1 3/4"	EX - Wood	Clear Coat	EX	EX - HM	Paint	0' - 4 3/4"	EX	- (	PH-02 / NOTE 10	
108-2	EX	6' - 0"	7' - 0"	0' - 1 3/4"	EX - Wood	Clear Coat	EX	EX - Wood	Clear Coat	0' - 5 1/2"	-	- }	NOTE 11	)
108-3		1' - 6"	7' - 0"	0' - 1 3/4"	EX - Wood	Clear Coat	EX	EX - Wood	Clear Coat	0' - 5 1/2"	-	- >	NOTE 11	~
109-1		3' - 0"	7' - 0"	0' - 1 3/4"	EX - Wood	Clear Coat	EX	EX - HM	Paint	0' - 4 3/4"	EX	- (	PH-02 / NOTE 10	1
109-2		6' - 0"	7' - 0"	0' - 1 3/4"	EX - Wood	Clear Coat	EX	EX - Wood	Clear Coat	0' - 5 1/2"	-	- (	NOTE 11	
109-3	EX	1' - 6"	7' - 0"	0' - 1 3/4"	EX - Wood	Clear Coat	EX	EX - Wood	Clear Coat	0' - 5 1/2"	-	- (	NOTE 11	
110-1		3' - 0"	7' - 0"	0' - 1 3/4"	EX - Wood	Clear Coat	EX	EX - HM	Paint	0' - 4 3/4"	EX	- >	PH-02 / NOTE 10	<b>~</b>
110-2 110-3	EX EX	6' - 0" 1' - 6"	7' - 0" 7' - 0"	0' - 1 3/4" 0' - 1 3/4"	EX - Wood EX - Wood	Clear Coat Clear Coat	EX EX	EX - Wood EX - Wood	Clear Coat Clear Coat	0' - 5 1/2" 0' - 5 1/2"	-	- (	NOTE 11 NOTE 11	
111-1		3' - 0"	7' - 0"	0' - 1 3/4"	EX - Wood	Clear Coat	EX	EX - WOOd	Paint	0' - 4 3/4"	EX	- \	PH-02 / NOTE 10	<b>)</b>
111-2		6' - 0"	7' - 0"	0' - 1 3/4"	EX - Wood	Clear Coat	EX	EX - Wood	Clear Coat	0' - 5 1/2"	-		NOTE 11	
111-3		1' - 6"	7' - 0"	0' - 1 3/4"	EX - Wood	Clear Coat	EX	EX - Wood	Clear Coat	0' - 5 1/2"	-		NOTE 11	7
201-1		6' - 0"	7' - 0"	0' - 1 3/4"	EX - Wood	Clear Coat	EX	EX - HM	Paint	0' - 5 1/2"	EX	- (	PH-02 / NOTE 10	<u> </u>
201-2	EX	1' - 6"	7' - 0"	0' - 1 3/4"	EX - Wood	Clear Coat	EX	EX - Wood	Clear Coat	0' - 5 1/2"	-	- >	NOTE 11	
201-3	EX	5' - 0"	7' - 0"	0' - 1 3/4"	EX - Wood	Clear Coat	EX	EX - Wood	Clear Coat	0' - 5 1/2"	-	- (	NOTE 11	<u>ノ</u>
201A		3' - 0"	7' - 0"	0' - 1 3/4"	EX - Wood	Clear Coat	EX	EX - Wood	Clear Coat	0' - 5 1/2"	-	- (	NOTE 11	
201B		3' - 0"	7' - 0"	0' - 1 3/4"	EX - Wood	Clear Coat	EX	EX - Wood	Clear Coat	0' - 5 1/2"	EX	-	NOTE 11	
205-1		3' - 0"	7' - 0"	0' - 1 3/4"	EX - Wood	Clear Coat	EX	EX - HM	Paint	0' - 4 3/4"	EX	- >	PH-02 / NOTE 10	)
205-2		6' - 0"	7' - 0"	0' - 1 3/4"	EX - Wood	Clear Coat	EX	EX - Wood	Clear Coat	0' - 5 1/2"	-		NOTE 11	_
205-3	EX	1' - 6"	7' - 0"	0' - 1 3/4"	EX - Wood	Clear Coat	EX	EX - Wood	Clear Coat	0' - 5 1/2"	- EV	- (	NOTE 11	)
209-1		3' - 0"	7' - 0"	0' - 1 3/4"	EX - Wood	Clear Coat	EX	EX - HM	Paint Coat	0' - 4 3/4"	EX	- (	PH-02 / NOTE 10	<u> </u>
209-2	EX EX	6' - 0" 1' - 6"	7' - 0" 7' - 0"	0' - 1 3/4"	EX - Wood EX - Wood	Clear Coat	EX EX	EX - Wood EX - Wood	Clear Coat Clear Coat	0' - 5 1/2" 0' - 5 1/2"	-	- >	NOTE 11 NOTE 11	<del>)</del>
209-3 210-1		3' - 0"	7' - 0"	0' - 1 3/4" 0' - 1 3/4"	EX - Wood	Clear Coat Clear Coat	EX	EX - WOOd	Paint	0' - 4 3/4"	EX	<u> </u>	PH-02 / NOTE 10	<b>✓</b>
210-1		6' - 0"	7' - 0"	0' - 1 3/4"	EX - Wood	Clear Coat	EX	EX - Wood	Clear Coat	0' - 5 1/2"	-		NOTE 11	<del>)</del>
210-3		1' - 6"	7' - 0"	0' - 1 3/4"	EX - Wood	Clear Coat	EX	EX - Wood	Clear Coat	0' - 5 1/2"	-	- (	NOTE 11	
			1. 3	1		J. 2.2.					1	<b>\</b>		

## **DOOR NOTES**

- 1.) ALL GLAZING IN FIRE RATED DOORS TO BE FIRE GLASS COMPLYING WITH ANSI IMPACT REQUIREMENTS.
- 2.) ALL CLOSERS TO HAVE CLOSING SPECS SET  $90^{\circ}$   $12^{\circ}$ , 5 SECONDS MIN.
- 3.) ALL DOOR LOCKS, LATCHES, PANIC HARDWARE AND PULLS TO BET SET 34"-48" AFF.
- 4.) ALL DOOR OPERATING DEVICES (OTHER THAN PANIC HARDWARE) TO BE LEVER OPERATED.
- 5.) ALL THRESHOLDS TO BE 1/2" MAX. HEIGHT, BEVELED TO
- 6.) ALL GLASS IN DOORS AND WITHIN 24" OF A DOOR TO BE SAFETY TEMPERED GLASS (T).
- 7.) \*SEE DOOR TYPES\* DIMENSION NOTED IS FROM FINISHES FLOOR TO BOTTOM OF GLAZING.
- 8.) ALL DOOR HARDWARE TO BE MOUNTED A MINIMUM OF 34 INCHES ABOVE FINISHED FLOOR AND A MAXIMUM OF 48 INCHES ABOVE FINISHED FLOOR.

9.) ALL EXISTING DOOR/FRAME SIZES TO BE FIELD VERIFIED.

- 10.) EXISTING DOOR HINGES TO REMAIN.
- 11.) EXISTING HARDWARE TO REMAIN. INSTALL NEW DEADBOLT, KEYED TO MATCH EXISTING SYSTEM.


OFFICE OF CAPITAL PROGRAMS

THE SCHOOL DISTRICT OF PHILADELPHIA

**440 NORTH BROAD STREET** PHILADELPHIA, PA 19130 - 4015 (215) 400 - 4730 | (215) 400 - 4731 (fax)

www.philasd.org

SEAL:

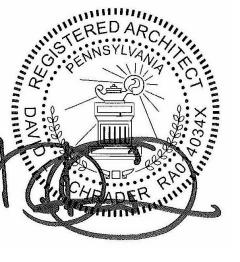

NAME (LICENSED PROFESSIONAL) STATE AND LICENSE NO:

### Architectural:

SCHRADERGROUP Architecture, LLC Address: 161 Leverington Ave, Suite 105, Philadelphia, PA 19127 Phone: 215.482.7440

Fax: 215.482.7440 Email: bgood@sgarc.com Attn: Brian Good

Global Engineering Solutions Address: 6700A Rockledge Drive, Suite 301, Bethesda, MD 20817 Phone: 301.216.2871 Fax: 301.216.9671

Email: AnilG@theges.com Attn: Anil Giri

# BID DOCUMENTS APRIL 20, 2018

10		
9		
8		
7		
6		
5		
4		
3		
2		
1	5/9/18	ADDENDUM #1
NO.	DATE	REVISION

## SCHOOL & LOCATION

William Rowen School 6841 N 19th St, Philadelphia, PA 19126

Classroom Modifications to William Rowen School


DRAWING TITLE

DOOR SCHEDULE

PROJECT TITLE

LOCATION NO. FILE NO. CHECKED BY DRAWN BY B-063 C **OF** 2017/18 B-066 C OF 2017/18

A601

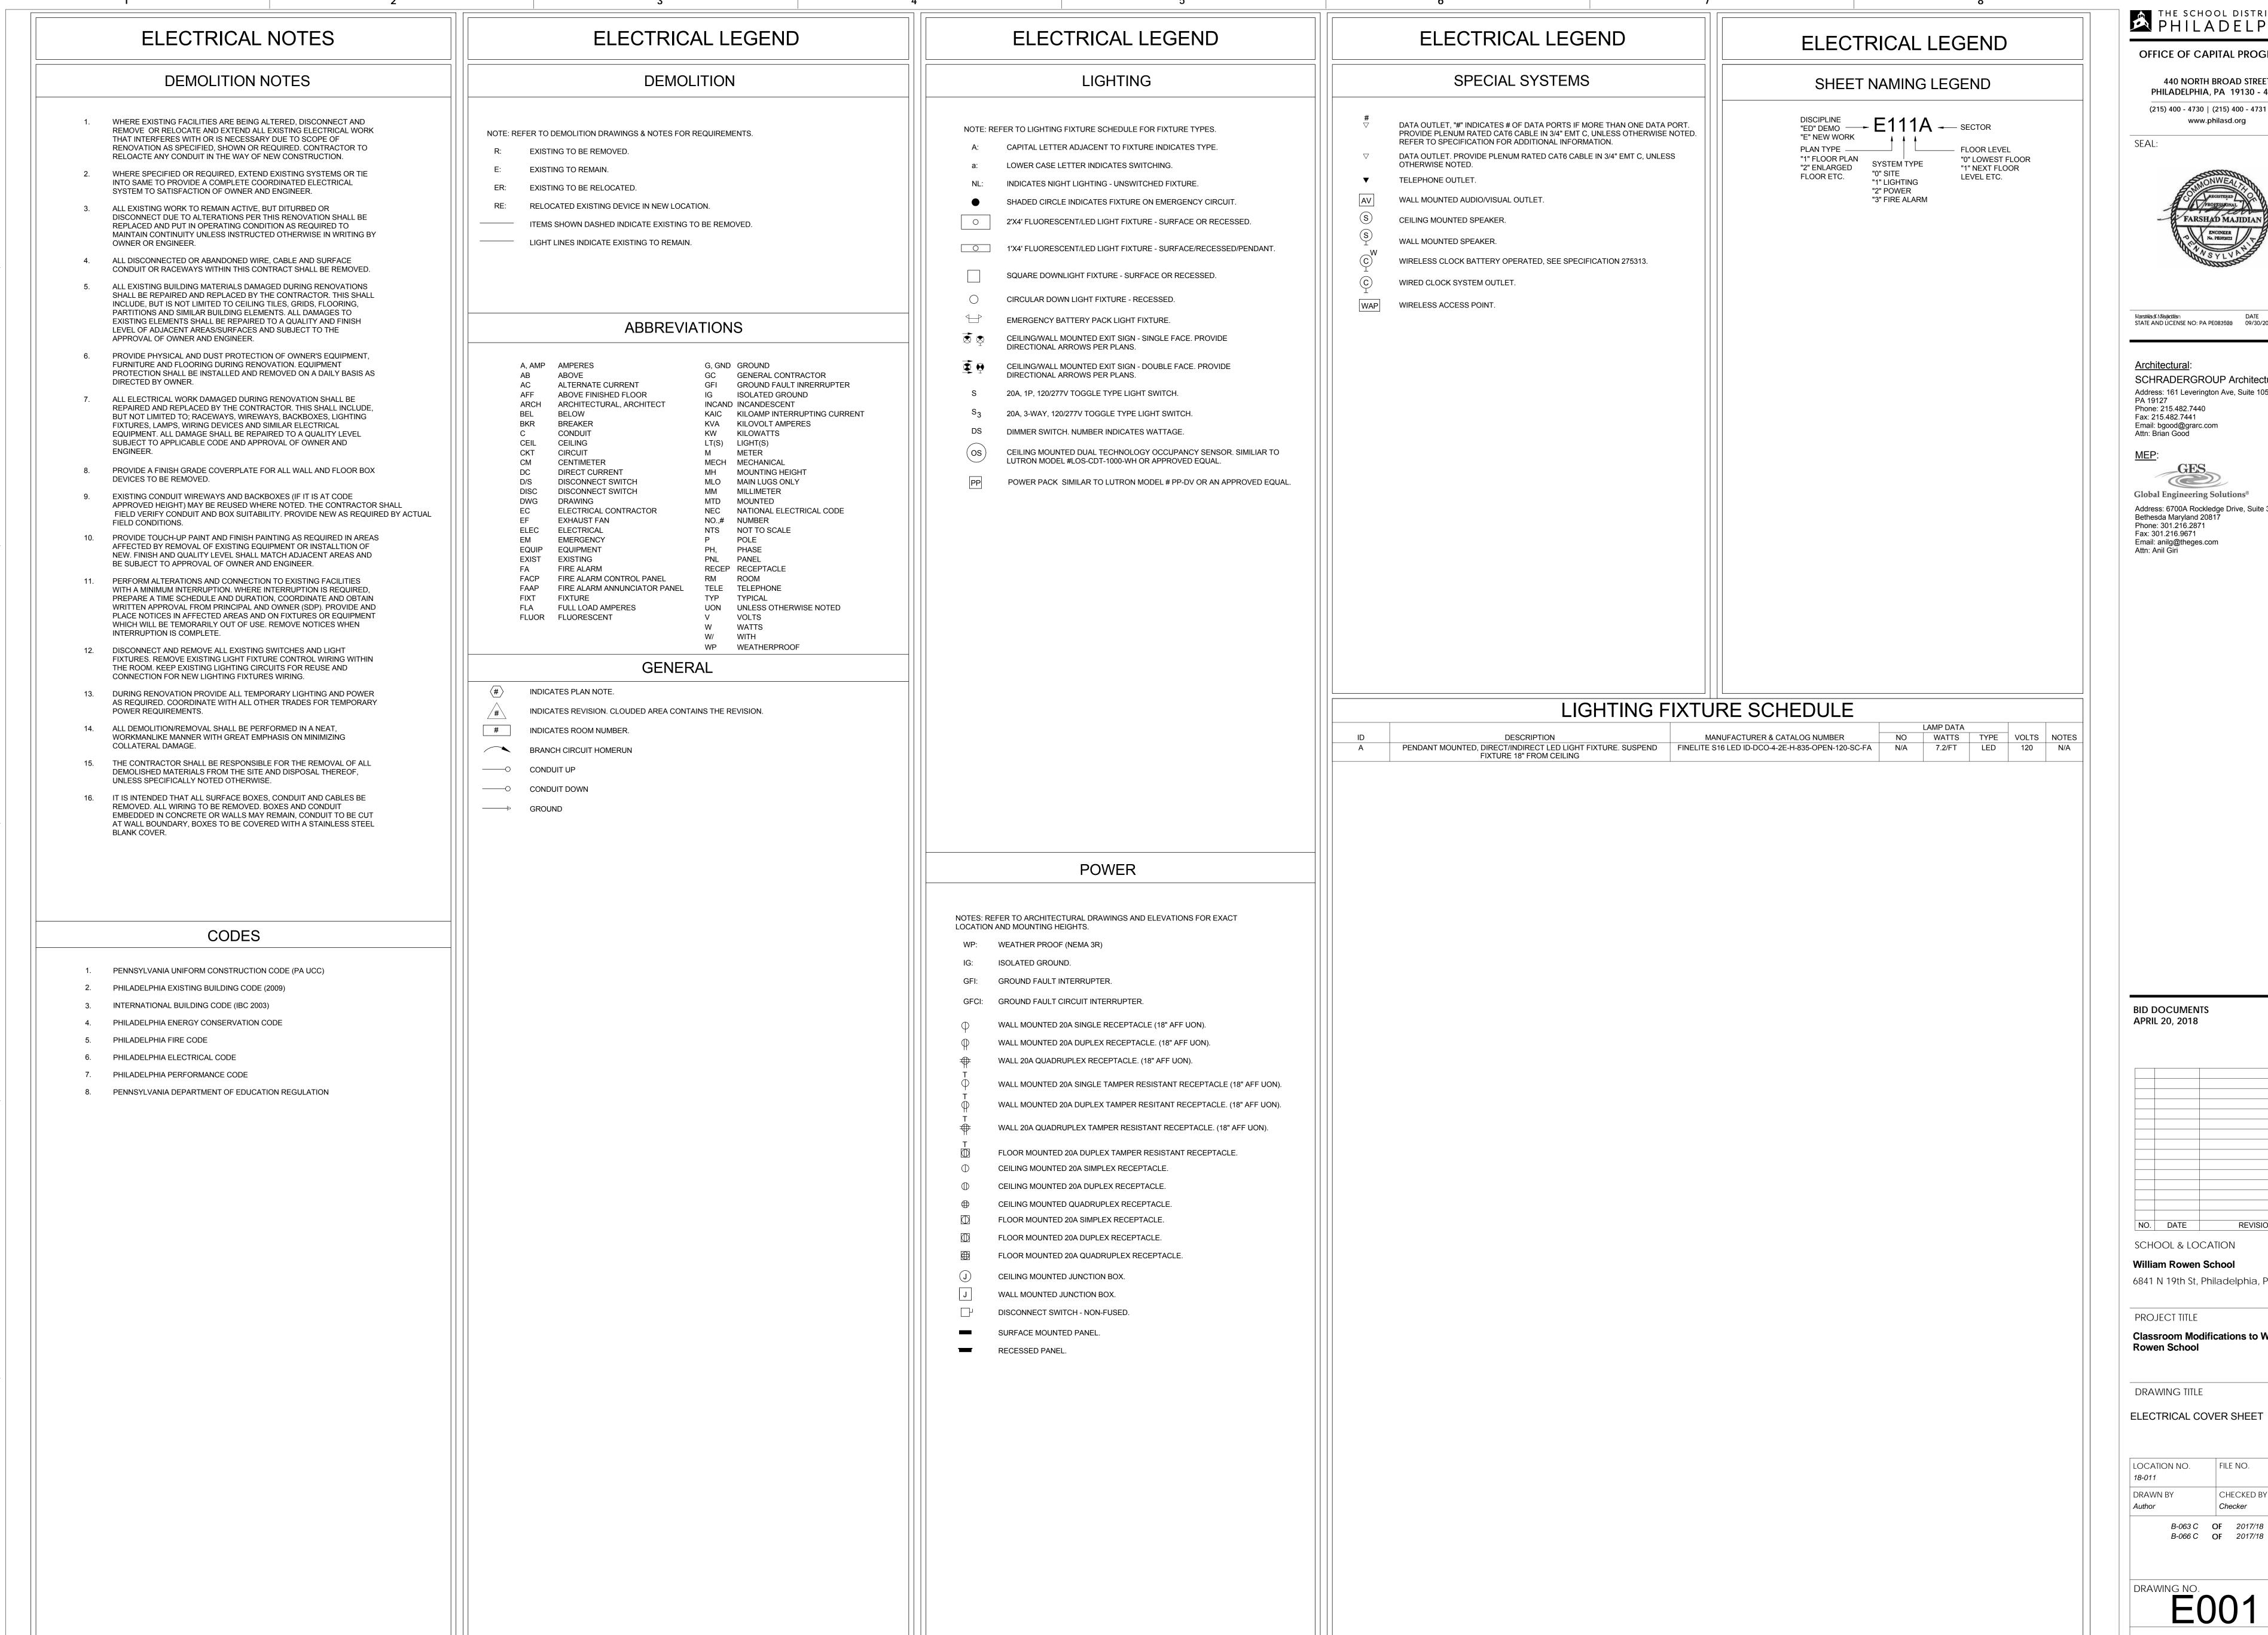

OFFICE OF CAPITAL PROGRAMS

440 NORTH BROAD STREET PHILADELPHIA, PA 19130 - 4015 (215) 400 - 4730 | (215) 400 - 4731 (fax) www.philasd.org




Marshiadk Nålsjadtism DATE STATE AND LICENSE NO: PA PE082526 09/30/2019

SCHRADERGROUP Architecture, LLC Address: 161 Leverington Ave, Suite 105, Philadelphia Phone: 215.482.7440 Fax: 215.482.7441 Email: bgood@grarc.com Attn: Brian Good

Global Engineering Solutions Address: 6700A Rockledge Drive, Suite 301 Bethesda Maryland 20817 Phone: 301.216.2871 Fax: 301.216.9671

BID DOCUMENTS APRIL 20, 2018

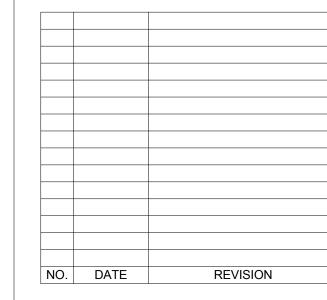


SCHOOL & LOCATION William Rowen School

6841 N 19th St, Philadelphia, PA 19126

PROJECT TITLE **Classroom Modifications to William** 

**ELECTRICAL COVER SHEET** 

LOCATION NO. FILE NO. DRAWN BY CHECKED BY

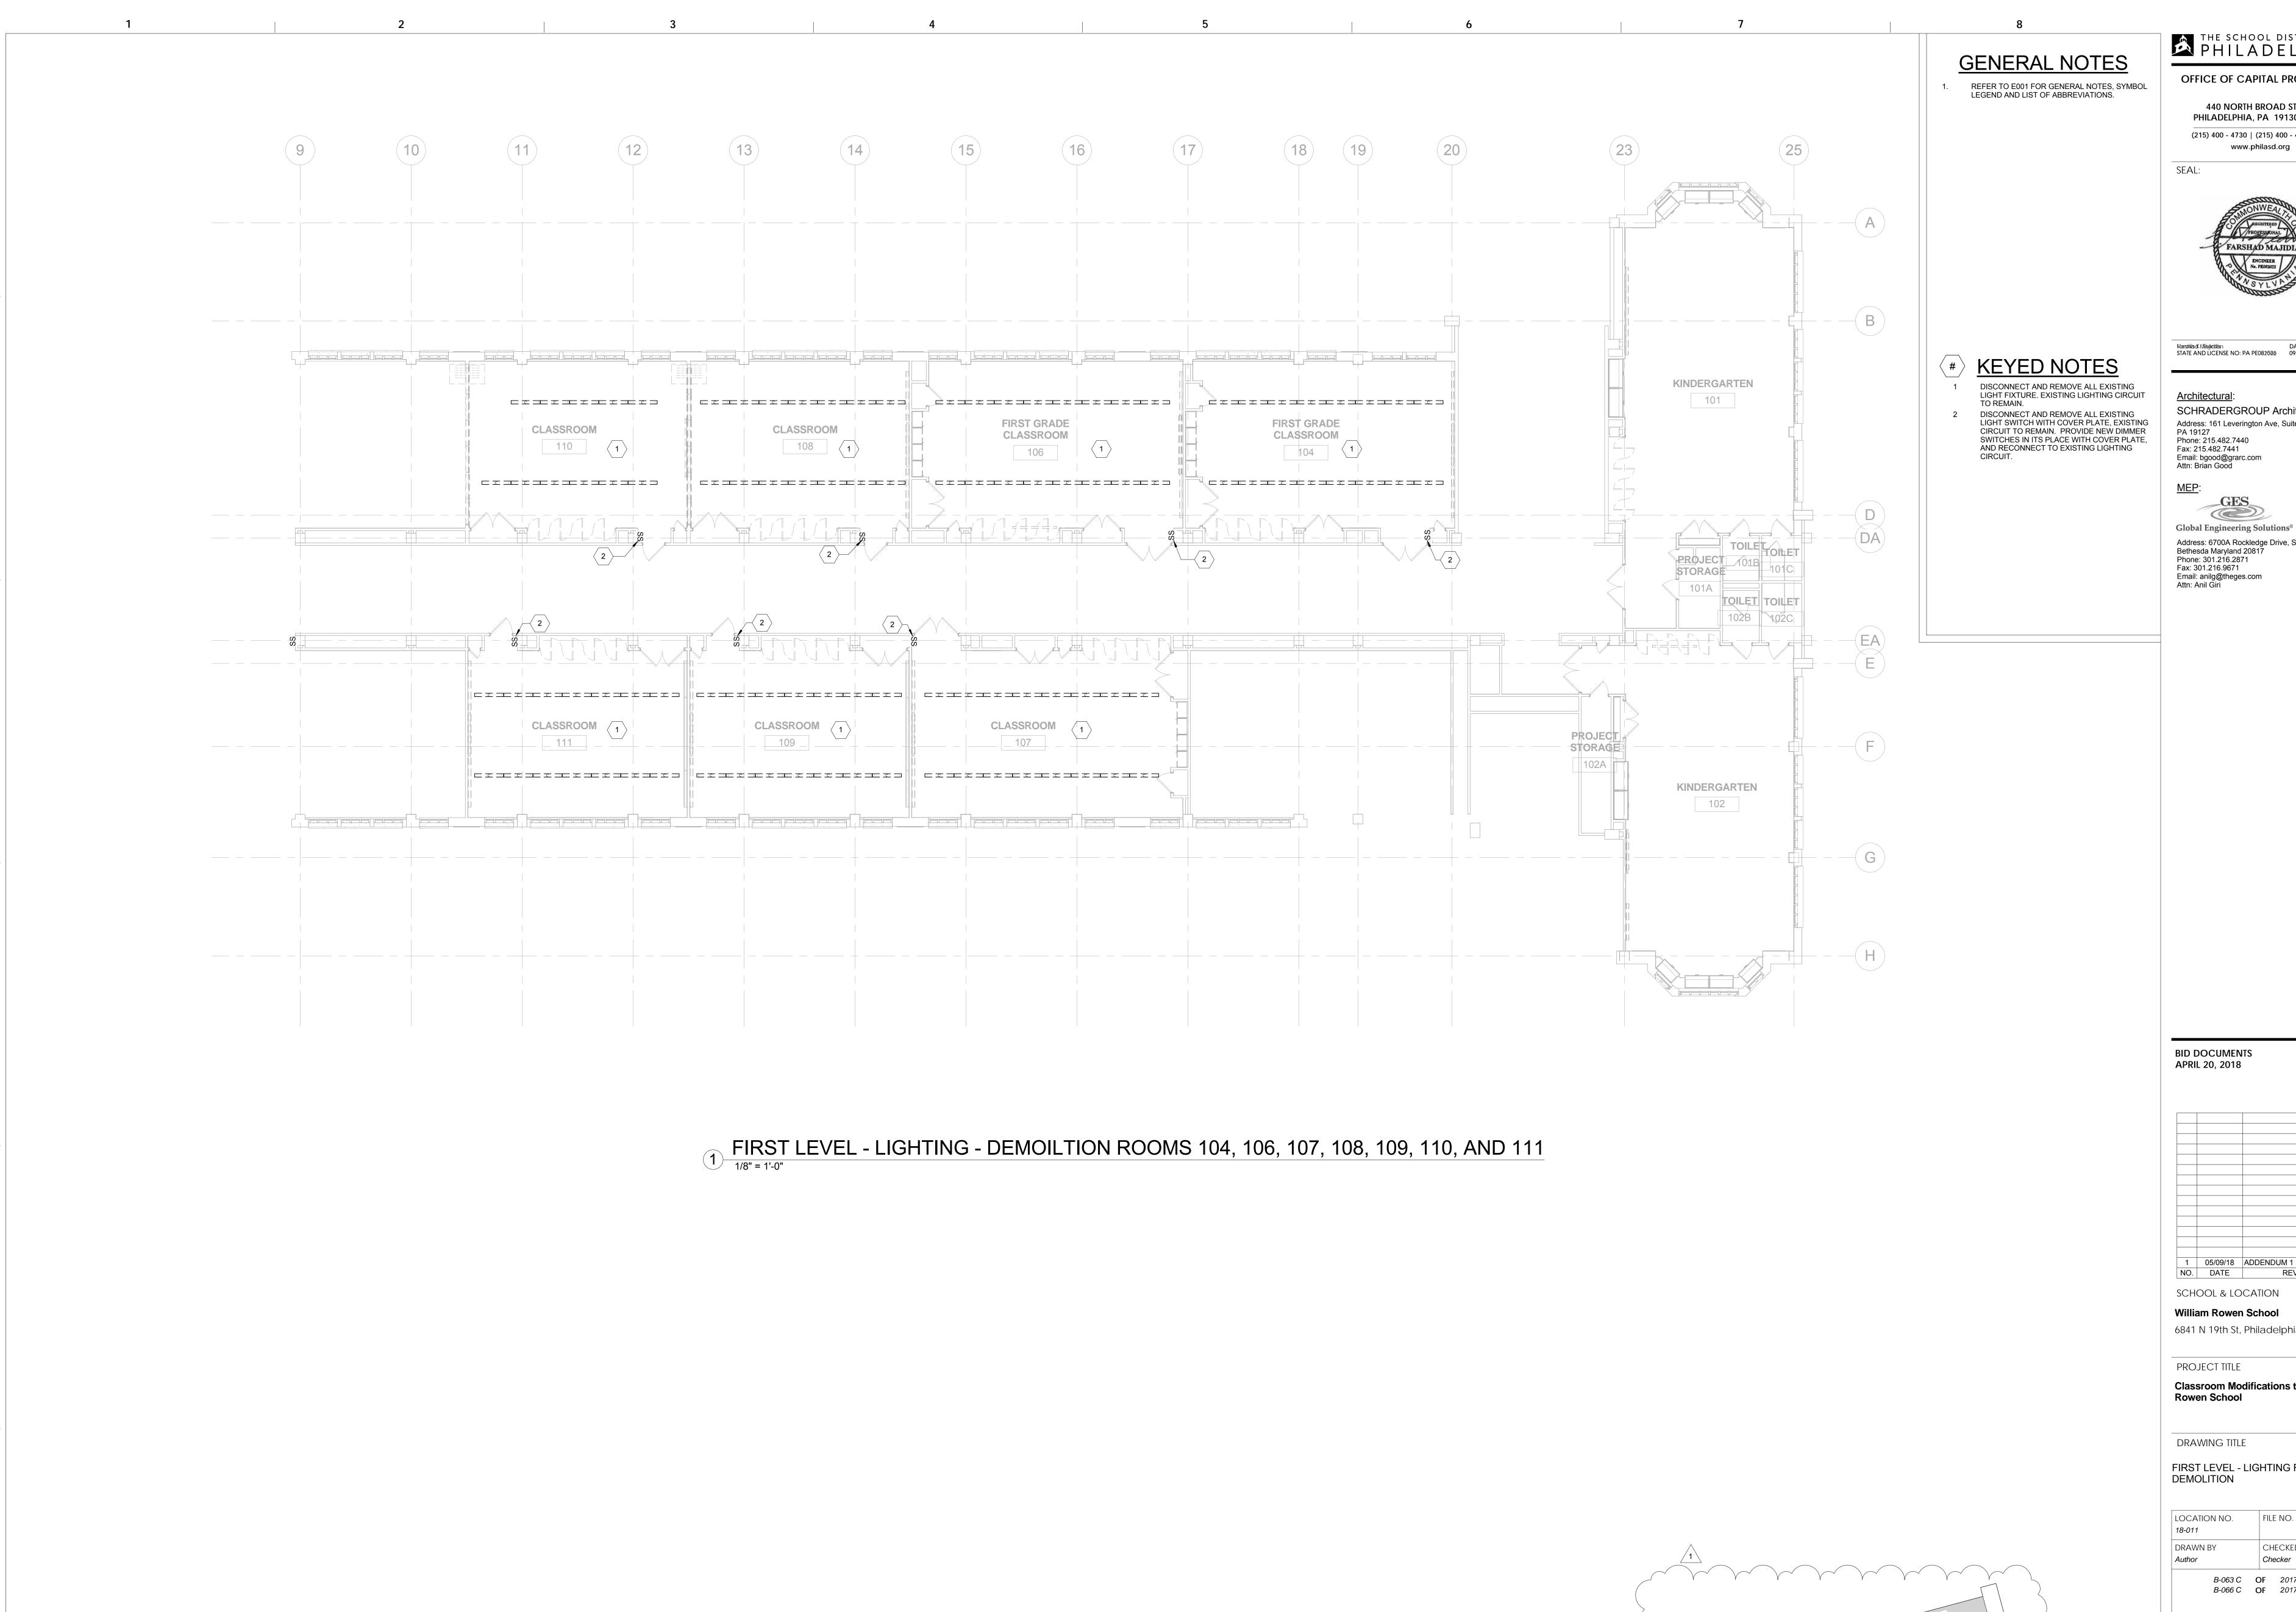

OFFICE OF CAPITAL PROGRAMS

440 NORTH BROAD STREET PHILADELPHIA, PA 19130 - 4015 (215) 400 - 4730 | (215) 400 - 4731 (fax)



Marshiladi Malajicitian DATE STATE AND LICENSE NO: PA PE082628 09/30/2019

SCHRADERGROUP Architecture, LLC Address: 161 Leverington Ave, Suite 105, Philadelphia PA 19127 Phone: 215.482.7440

Global Engineering Solutions® Address: 6700A Rockledge Drive, Suite 301 Bethesda Maryland 20817

BID DOCUMENTS

1 05/09/18 ADDENDUM 1
NO. DATE REV

SCHOOL & LOCATION


William Rowen School 6841 N 19th St, Philadelphia, PA 19126

PROJECT TITLE **Classroom Modifications to William** 

FIRST LEVEL - LIGHTING FLOOR PLAN - DEMOLITION

FILE NO. CHECKED BY

B-063 C OF 2017/18 B-066 C OF 2017/18

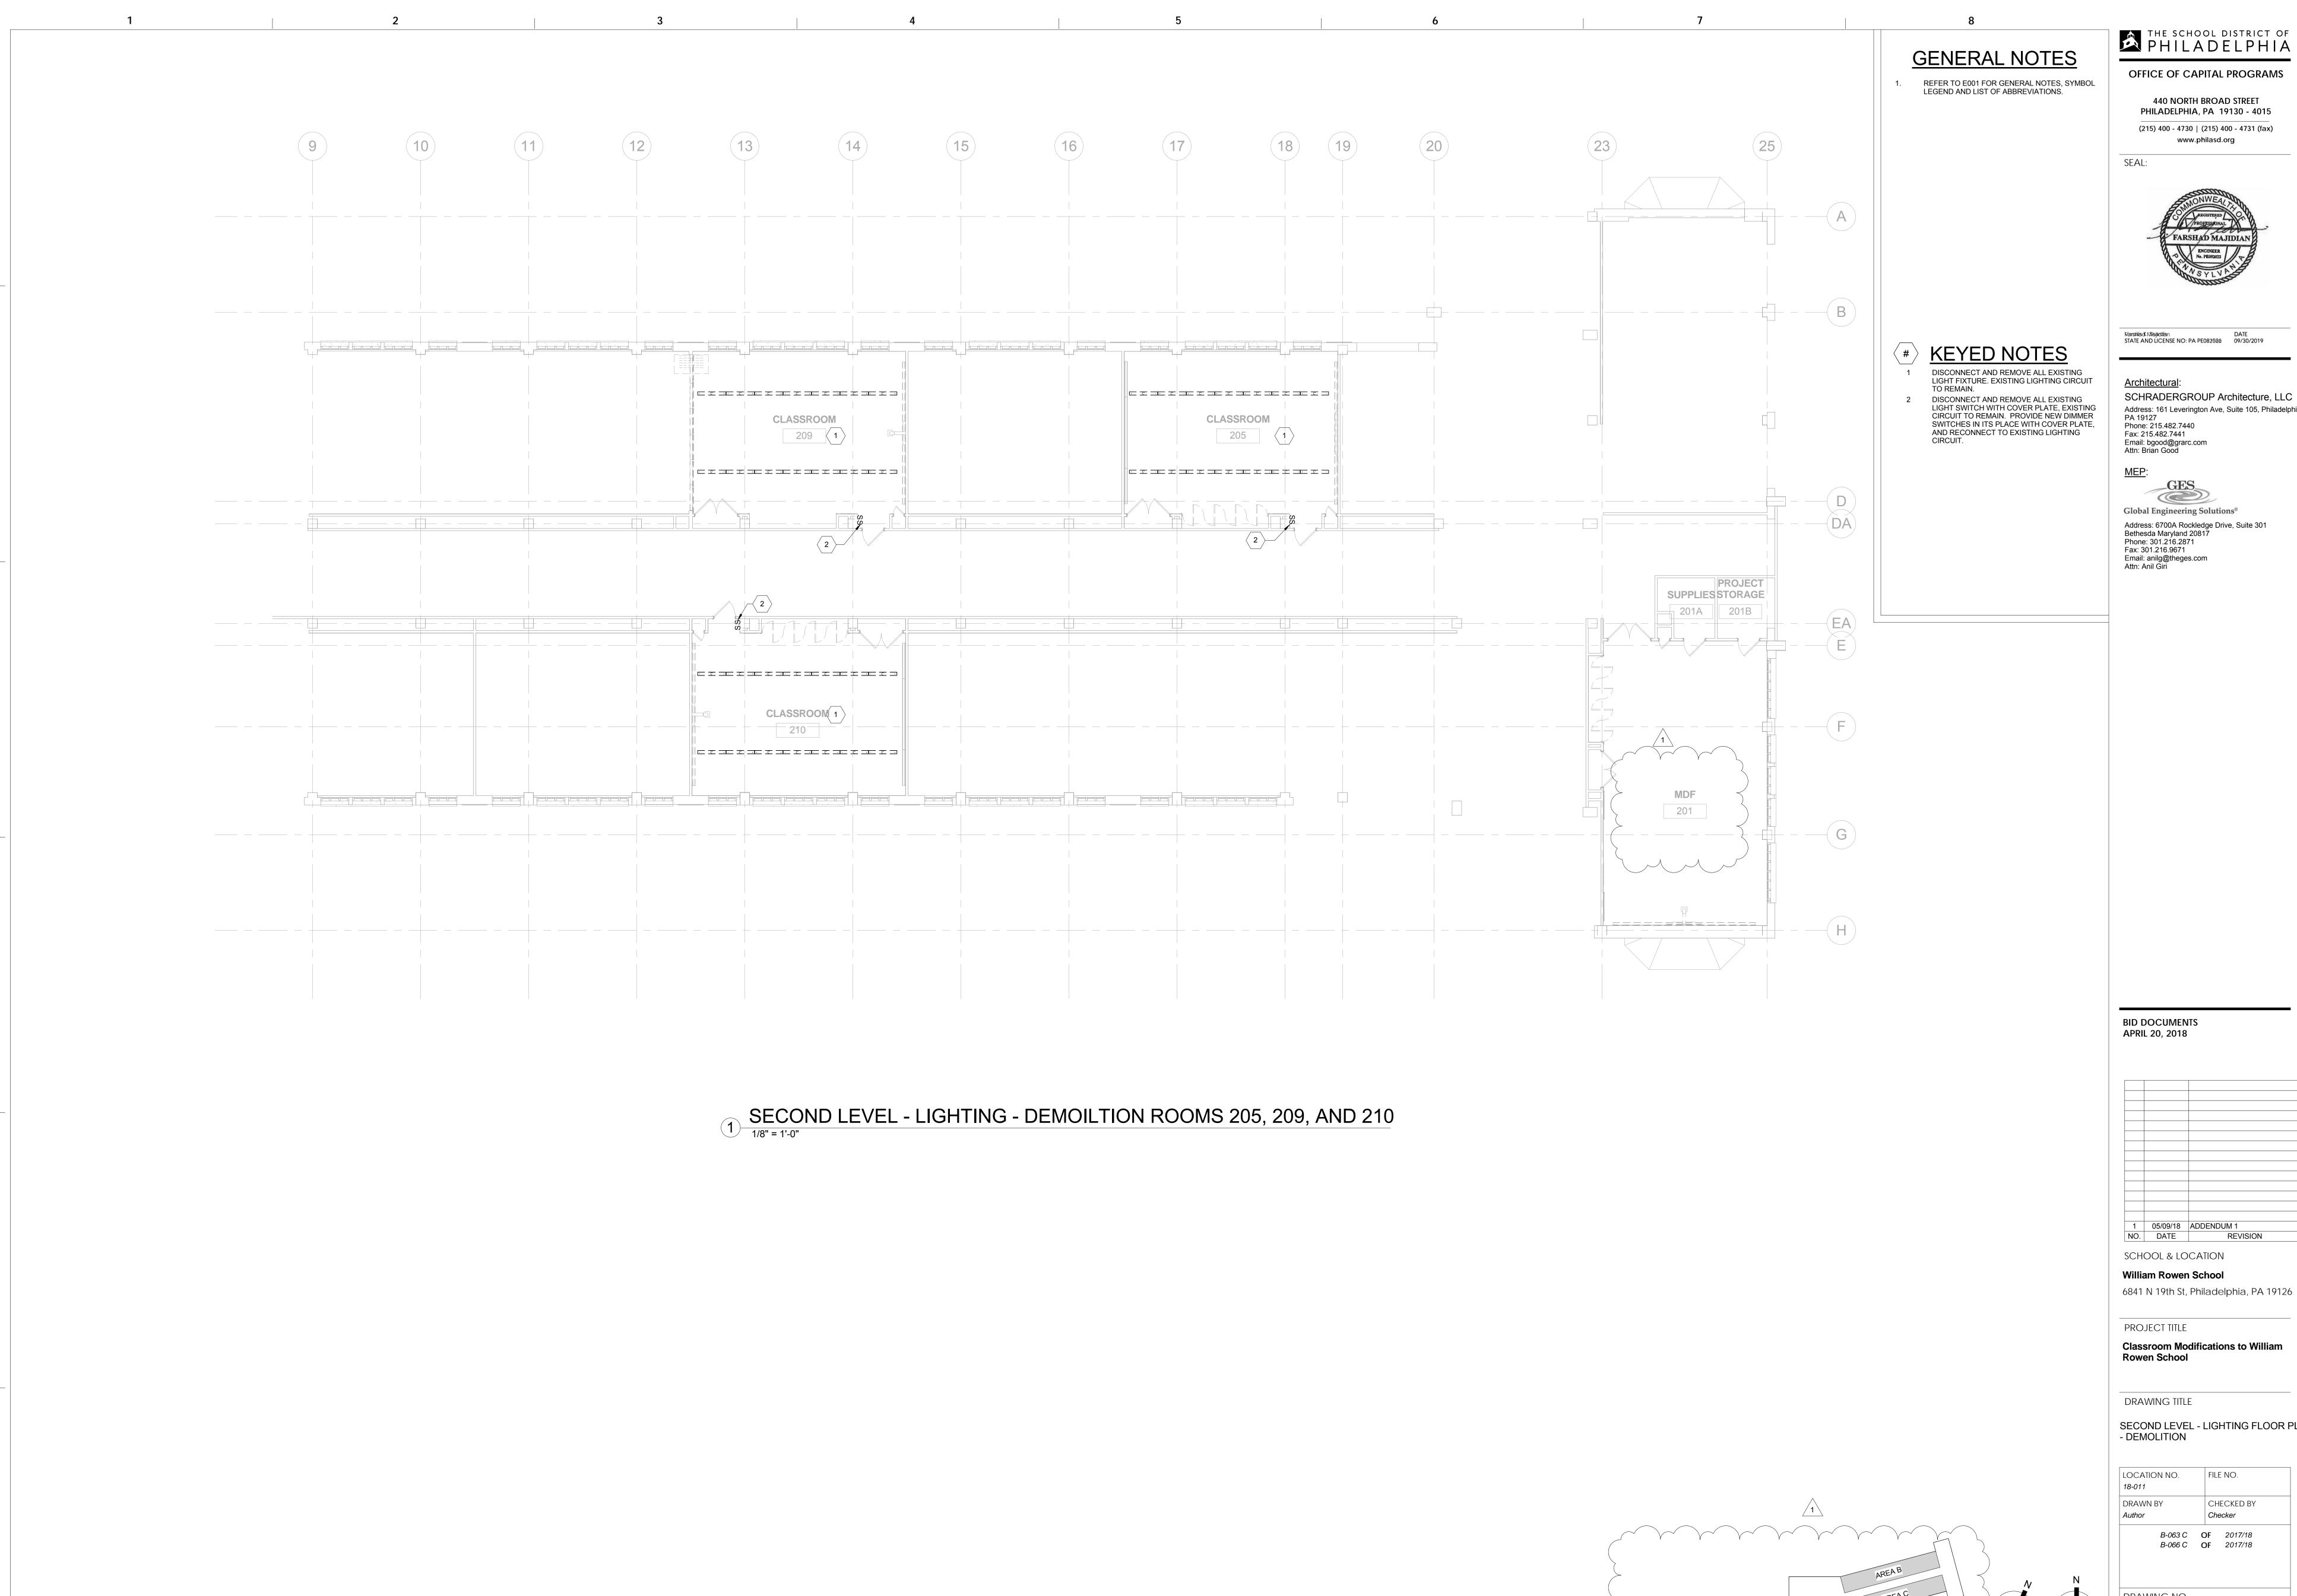

OFFICE OF CAPITAL PROGRAMS


440 NORTH BROAD STREET PHILADELPHIA, PA 19130 - 4015 (215) 400 - 4730 | (215) 400 - 4731 (fax)



Warsthladk Misspecitism DATE STATE AND LICENSE NO: PA PE082682 09/30/2019

Address: 161 Leverington Ave, Suite 105, Philadelphia

Global Engineering Solutions® Address: 6700A Rockledge Drive, Suite 301 Bethesda Maryland 20817

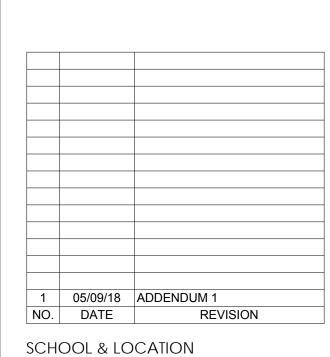


William Rowen School 6841 N 19th St, Philadelphia, PA 19126

**Classroom Modifications to William** 

SECOND LEVEL - LIGHTING FLOOR PLAN - DEMOLITION

LOCATION NO. 18-011	FILE NO.
DRAWN BY Author	CHECKED BY Checker
	OF 2017/18 OF 2017/18

KEY PLAN

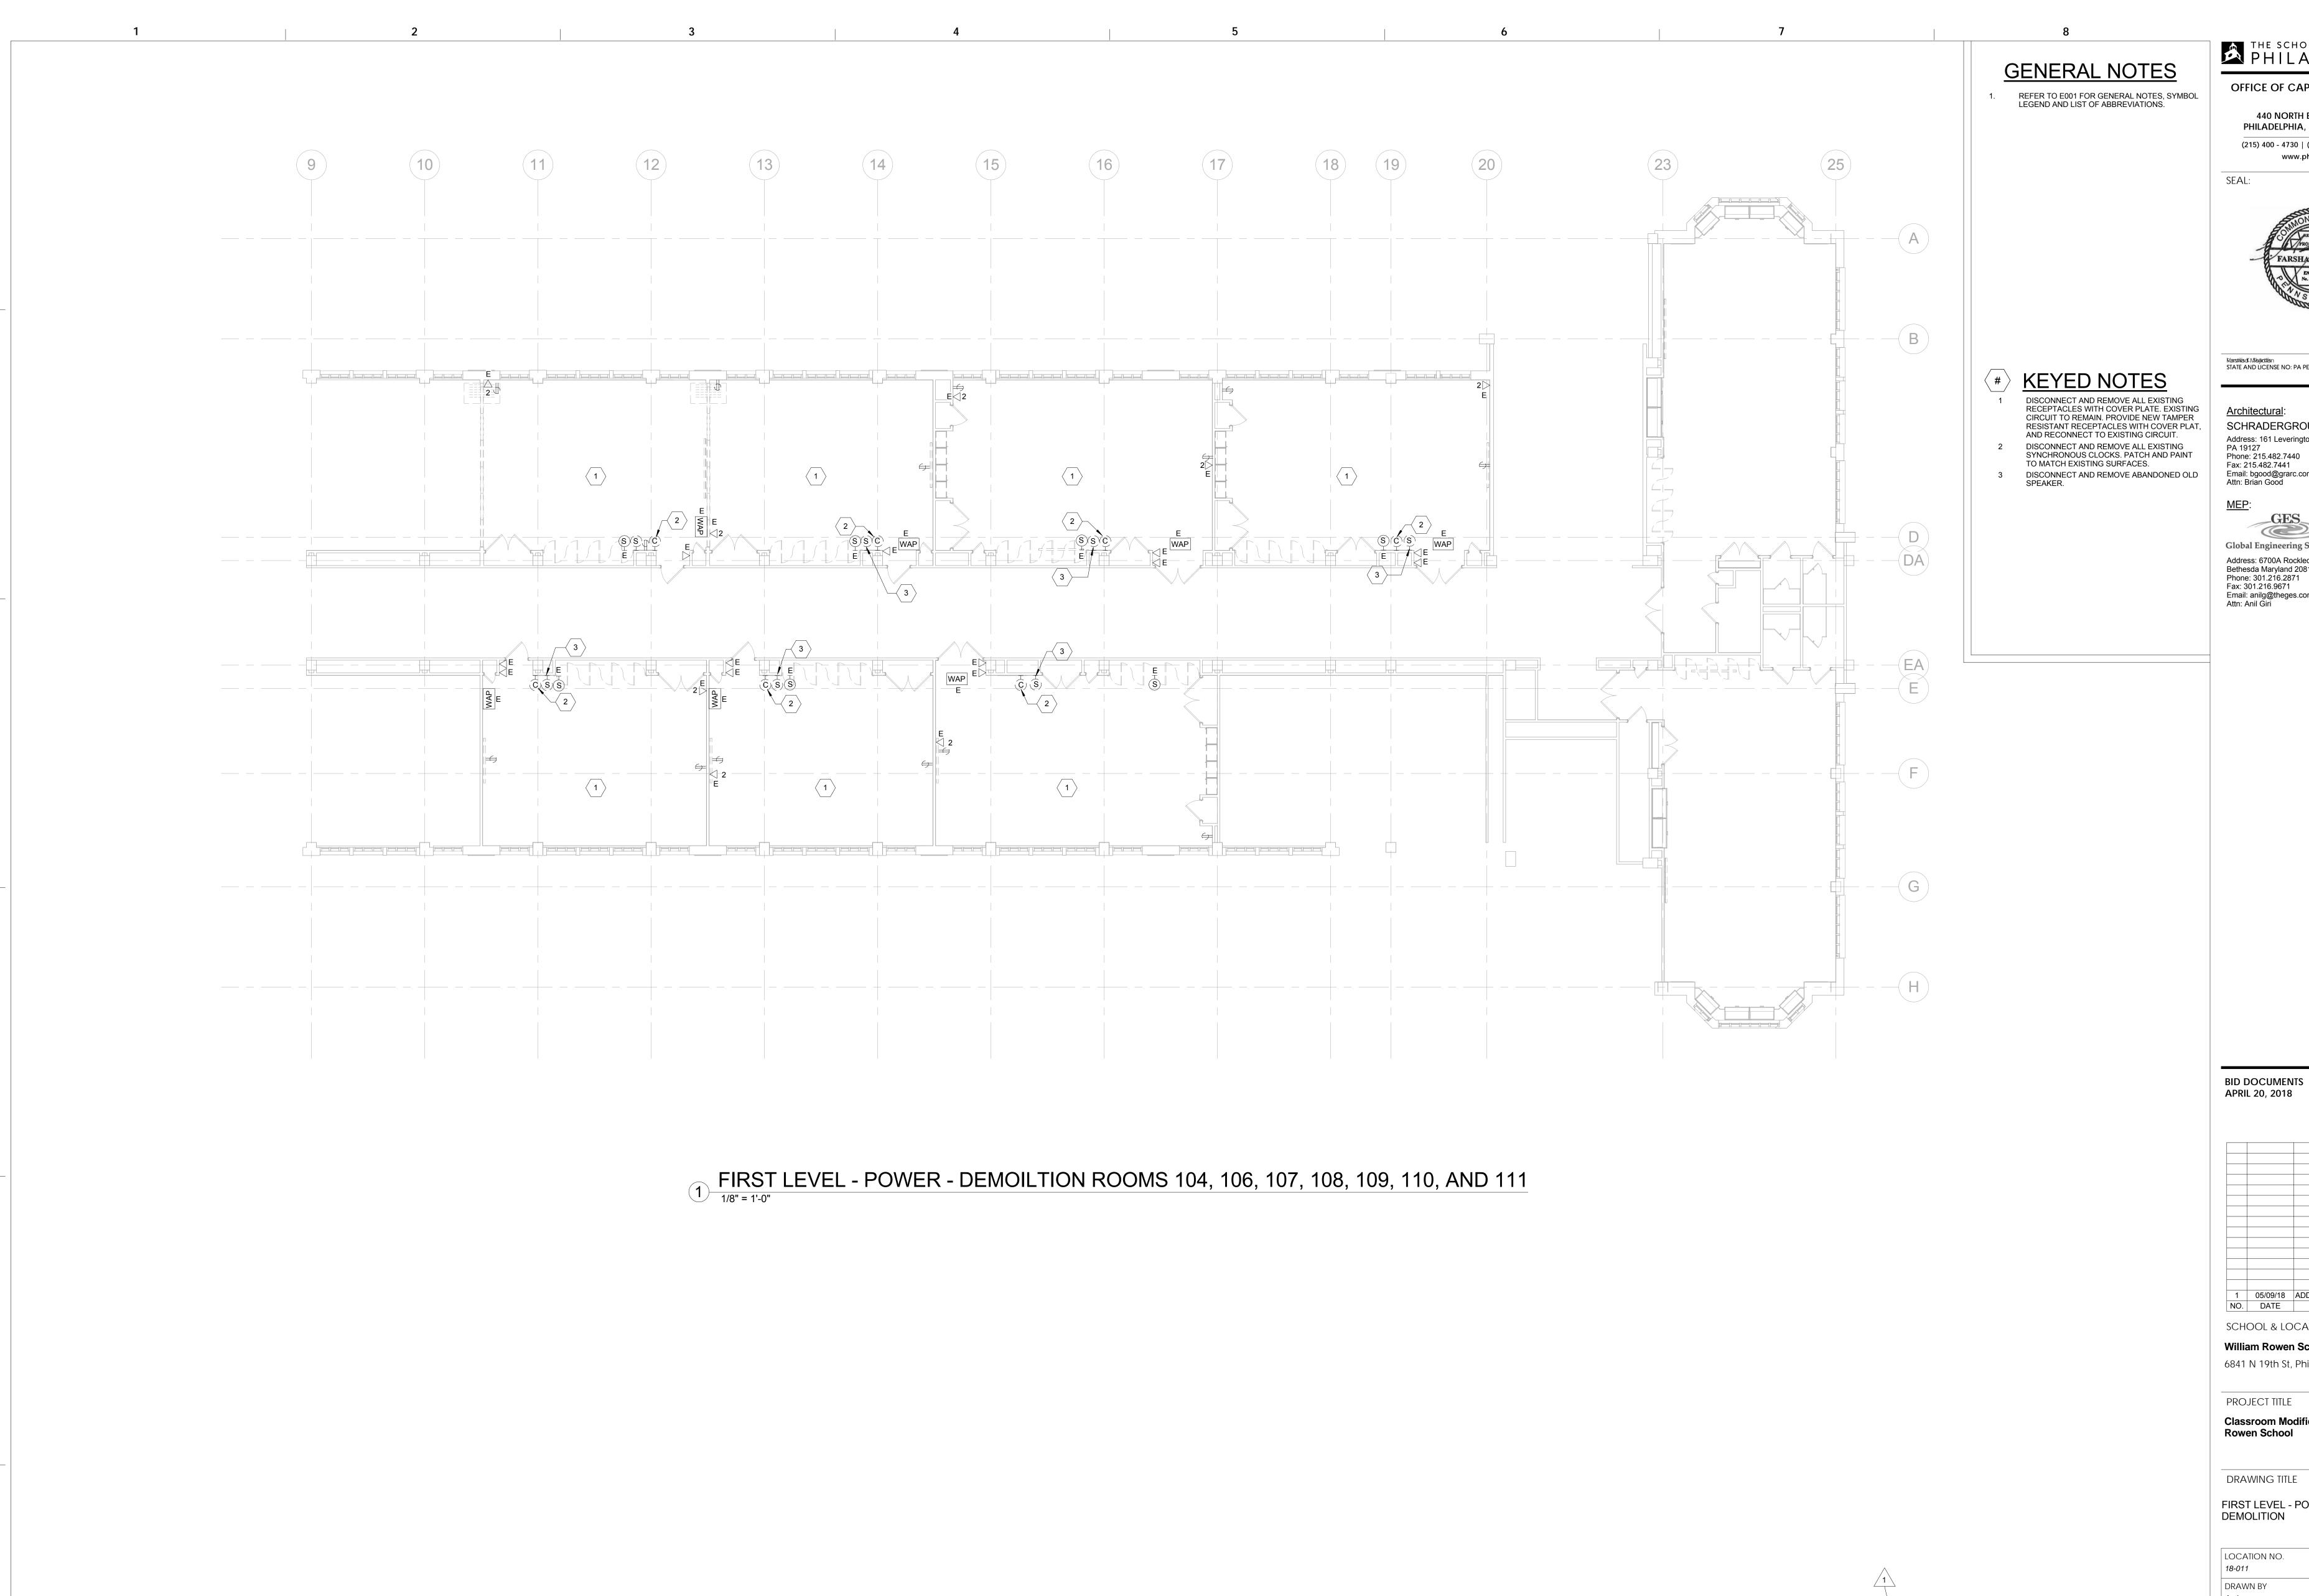

OFFICE OF CAPITAL PROGRAMS


440 NORTH BROAD STREET PHILADELPHIA, PA 19130 - 4015 (215) 400 - 4730 | (215) 400 - 4731 (fax) www.philasd.org



Warstkladt Nikspictlern DATE STATE AND LICENSE NO: PA PE082€22 09/30/2019

SCHRADERGROUP Architecture, LLC Address: 161 Leverington Ave, Suite 105, Philadelphia PA 19127
Phone: 215.482.7440
Fax: 215.482.7441
Email: bgood@grarc.com
Attn: Brian Good

Global Engineering Solutions® Address: 6700A Rockledge Drive, Suite 301 Bethesda Maryland 20817 Phone: 301.216.2871 Fax: 301.216.9671 Email: anilg@theges.com Attn: Anil Giri

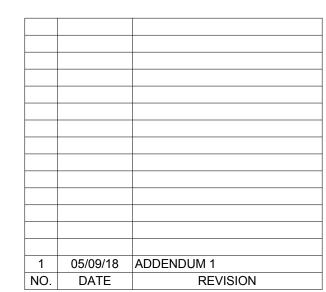


SCHOOL & LOCATION

William Rowen School 6841 N 19th St, Philadelphia, PA 19126

PROJECT TITLE **Classroom Modifications to William** 

FIRST LEVEL - POWER FLOOR PLAN - DEMOLITION

DRAWN BY Author  CHECKED BY Checker	LOCATION NO.	FILE NO.
	18-011	
Author Checker	DRAWN BY	CHECKED BY
	Author	Checker

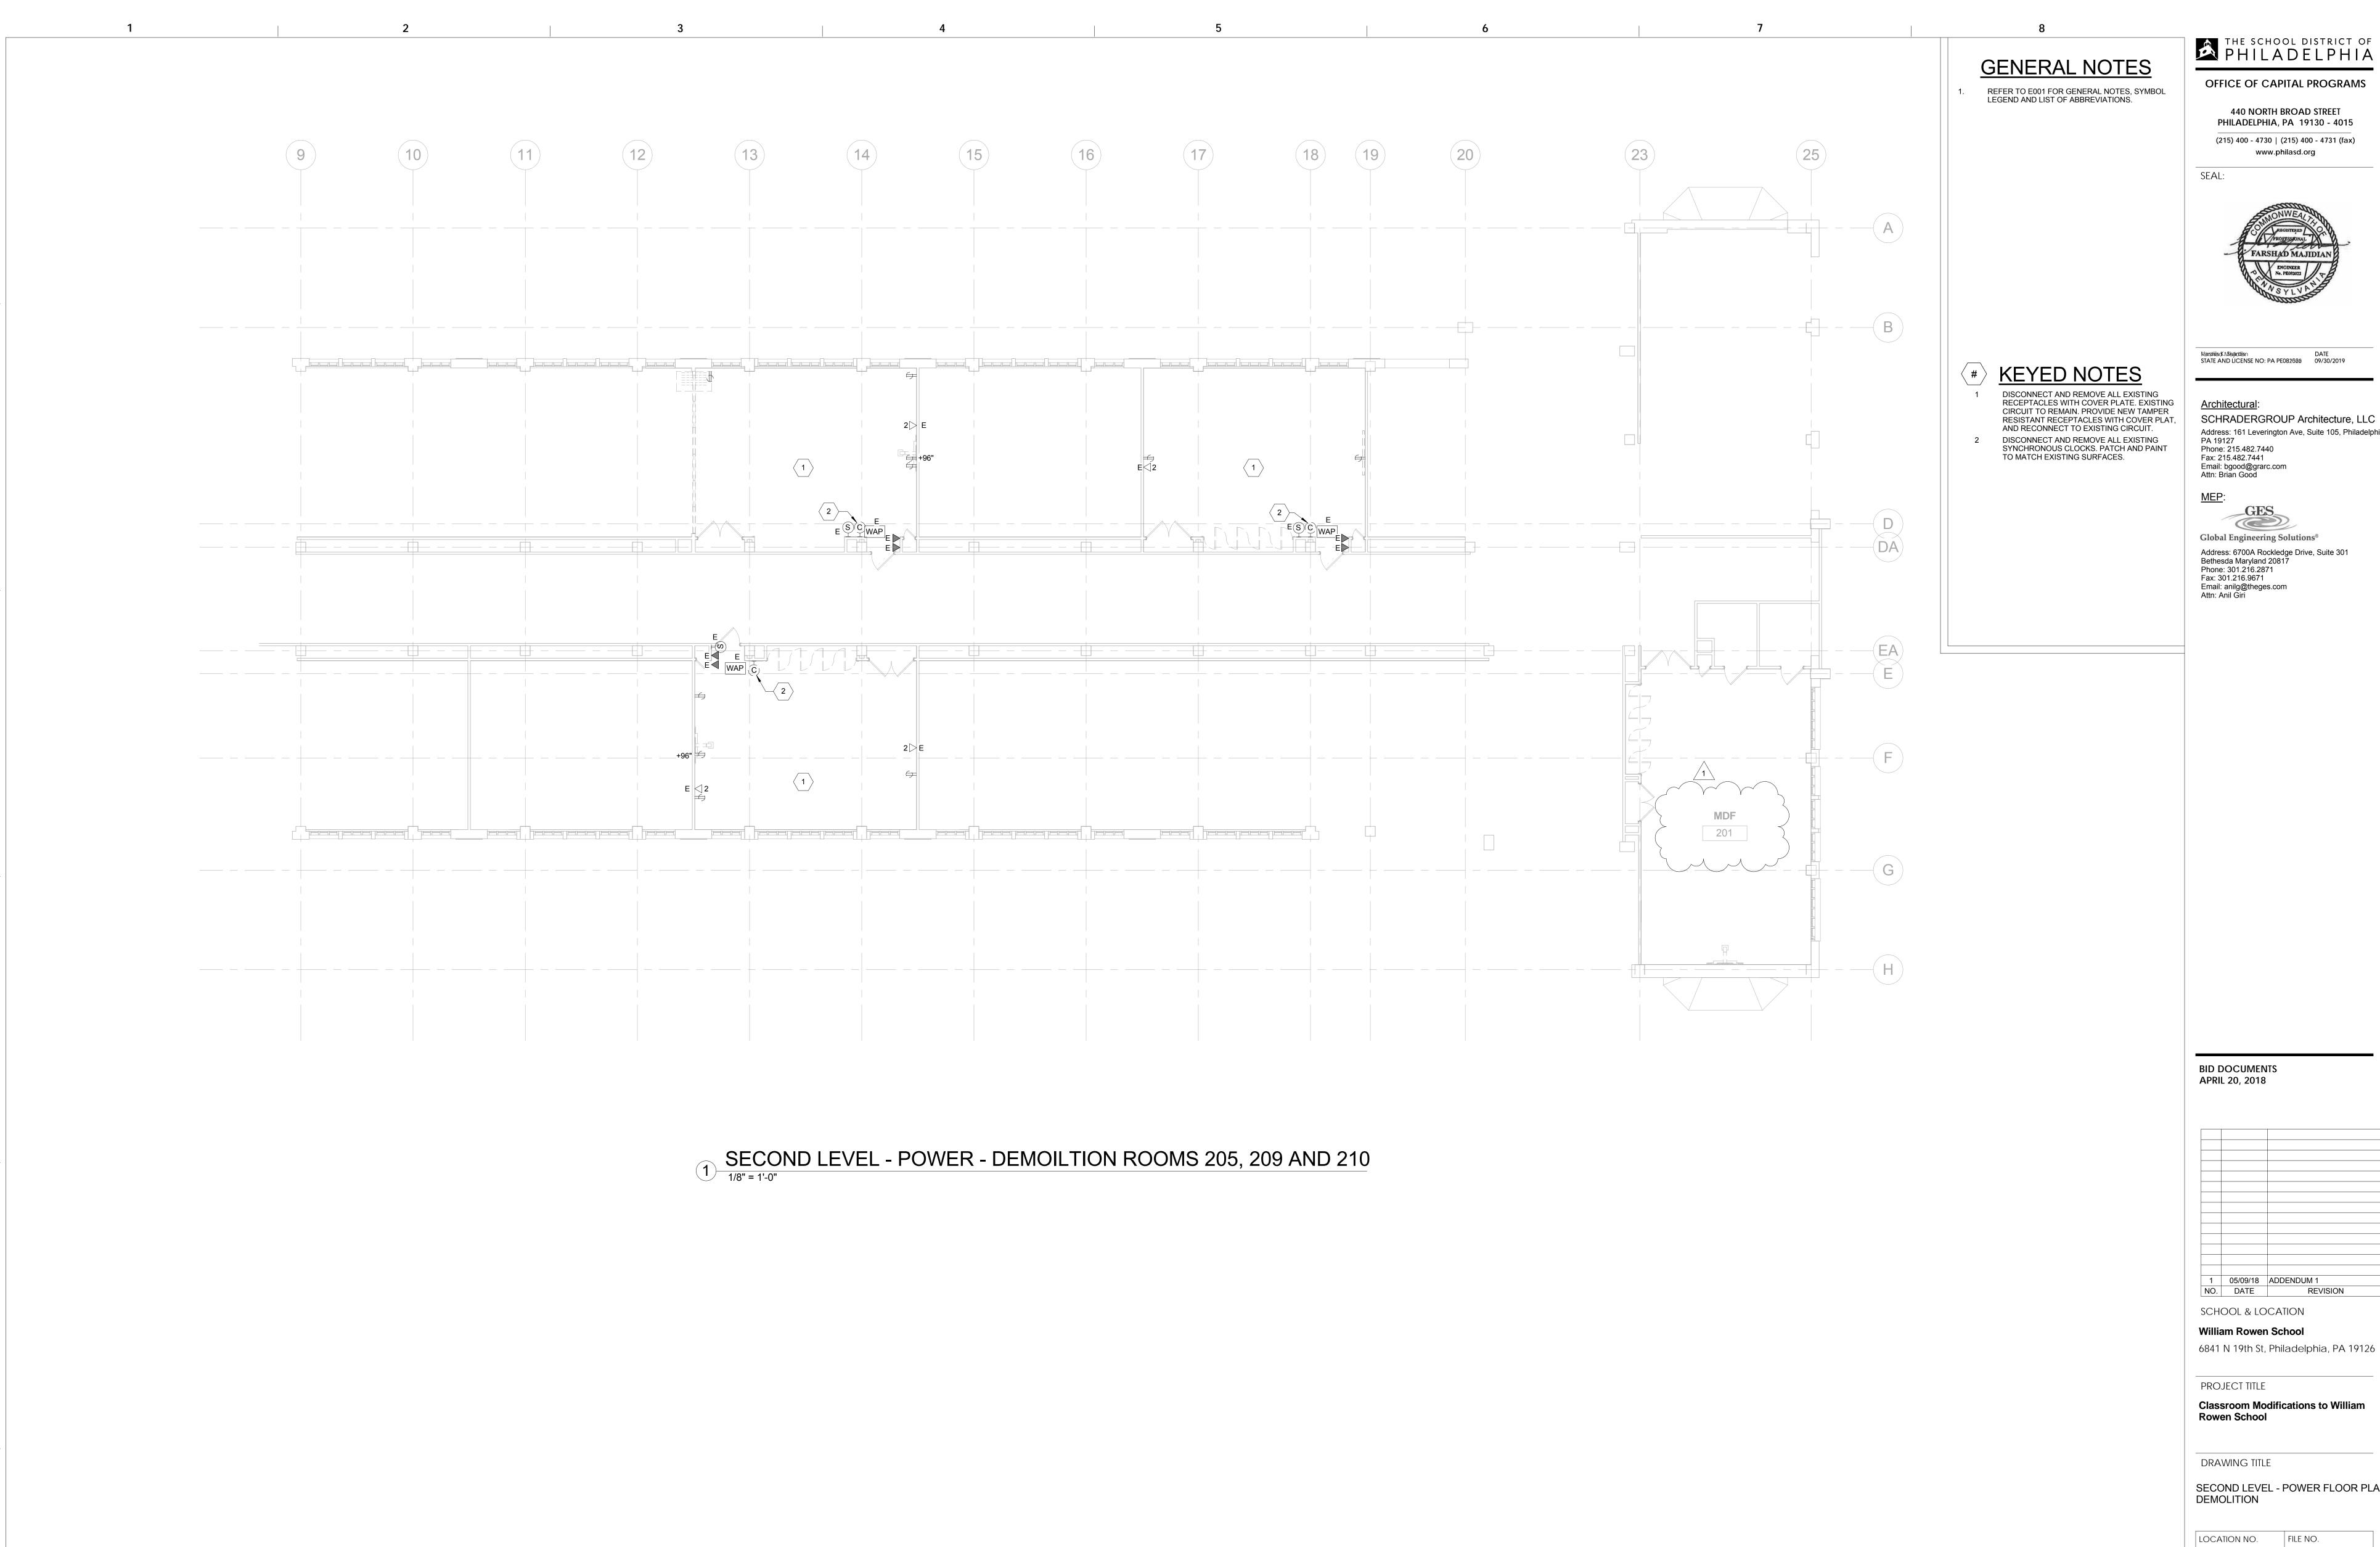

OFFICE OF CAPITAL PROGRAMS

440 NORTH BROAD STREET PHILADELPHIA, PA 19130 - 4015 (215) 400 - 4730 | (215) 400 - 4731 (fax)



www.philasd.org

Warstkladt Nikspictlern DATE STATE AND LICENSE NO: PA PE082€22 09/30/2019

SCHRADERGROUP Architecture, LLC Address: 161 Leverington Ave, Suite 105, Philadelphia PA 19127 Phone: 215.482.7440

Global Engineering Solutions® Address: 6700A Rockledge Drive, Suite 301 Bethesda Maryland 20817 Phone: 301.216.2871
Fax: 301.216.9671
Email: anilg@theges.com
Attn: Anil Giri

BID DOCUMENTS APRIL 20, 2018

1 05/09/18 ADDENDUM 1 NO. DATE REV SCHOOL & LOCATION

William Rowen School 6841 N 19th St, Philadelphia, PA 19126


PROJECT TITLE

**Classroom Modifications to William Rowen School** 

DRAWING TITLE

SECOND LEVEL - POWER FLOOR PLAN - DEMOLITION

LOCATION NO. FILE NO. CHECKED BY B-063 C OF 2017/18 B-066 C OF 2017/18

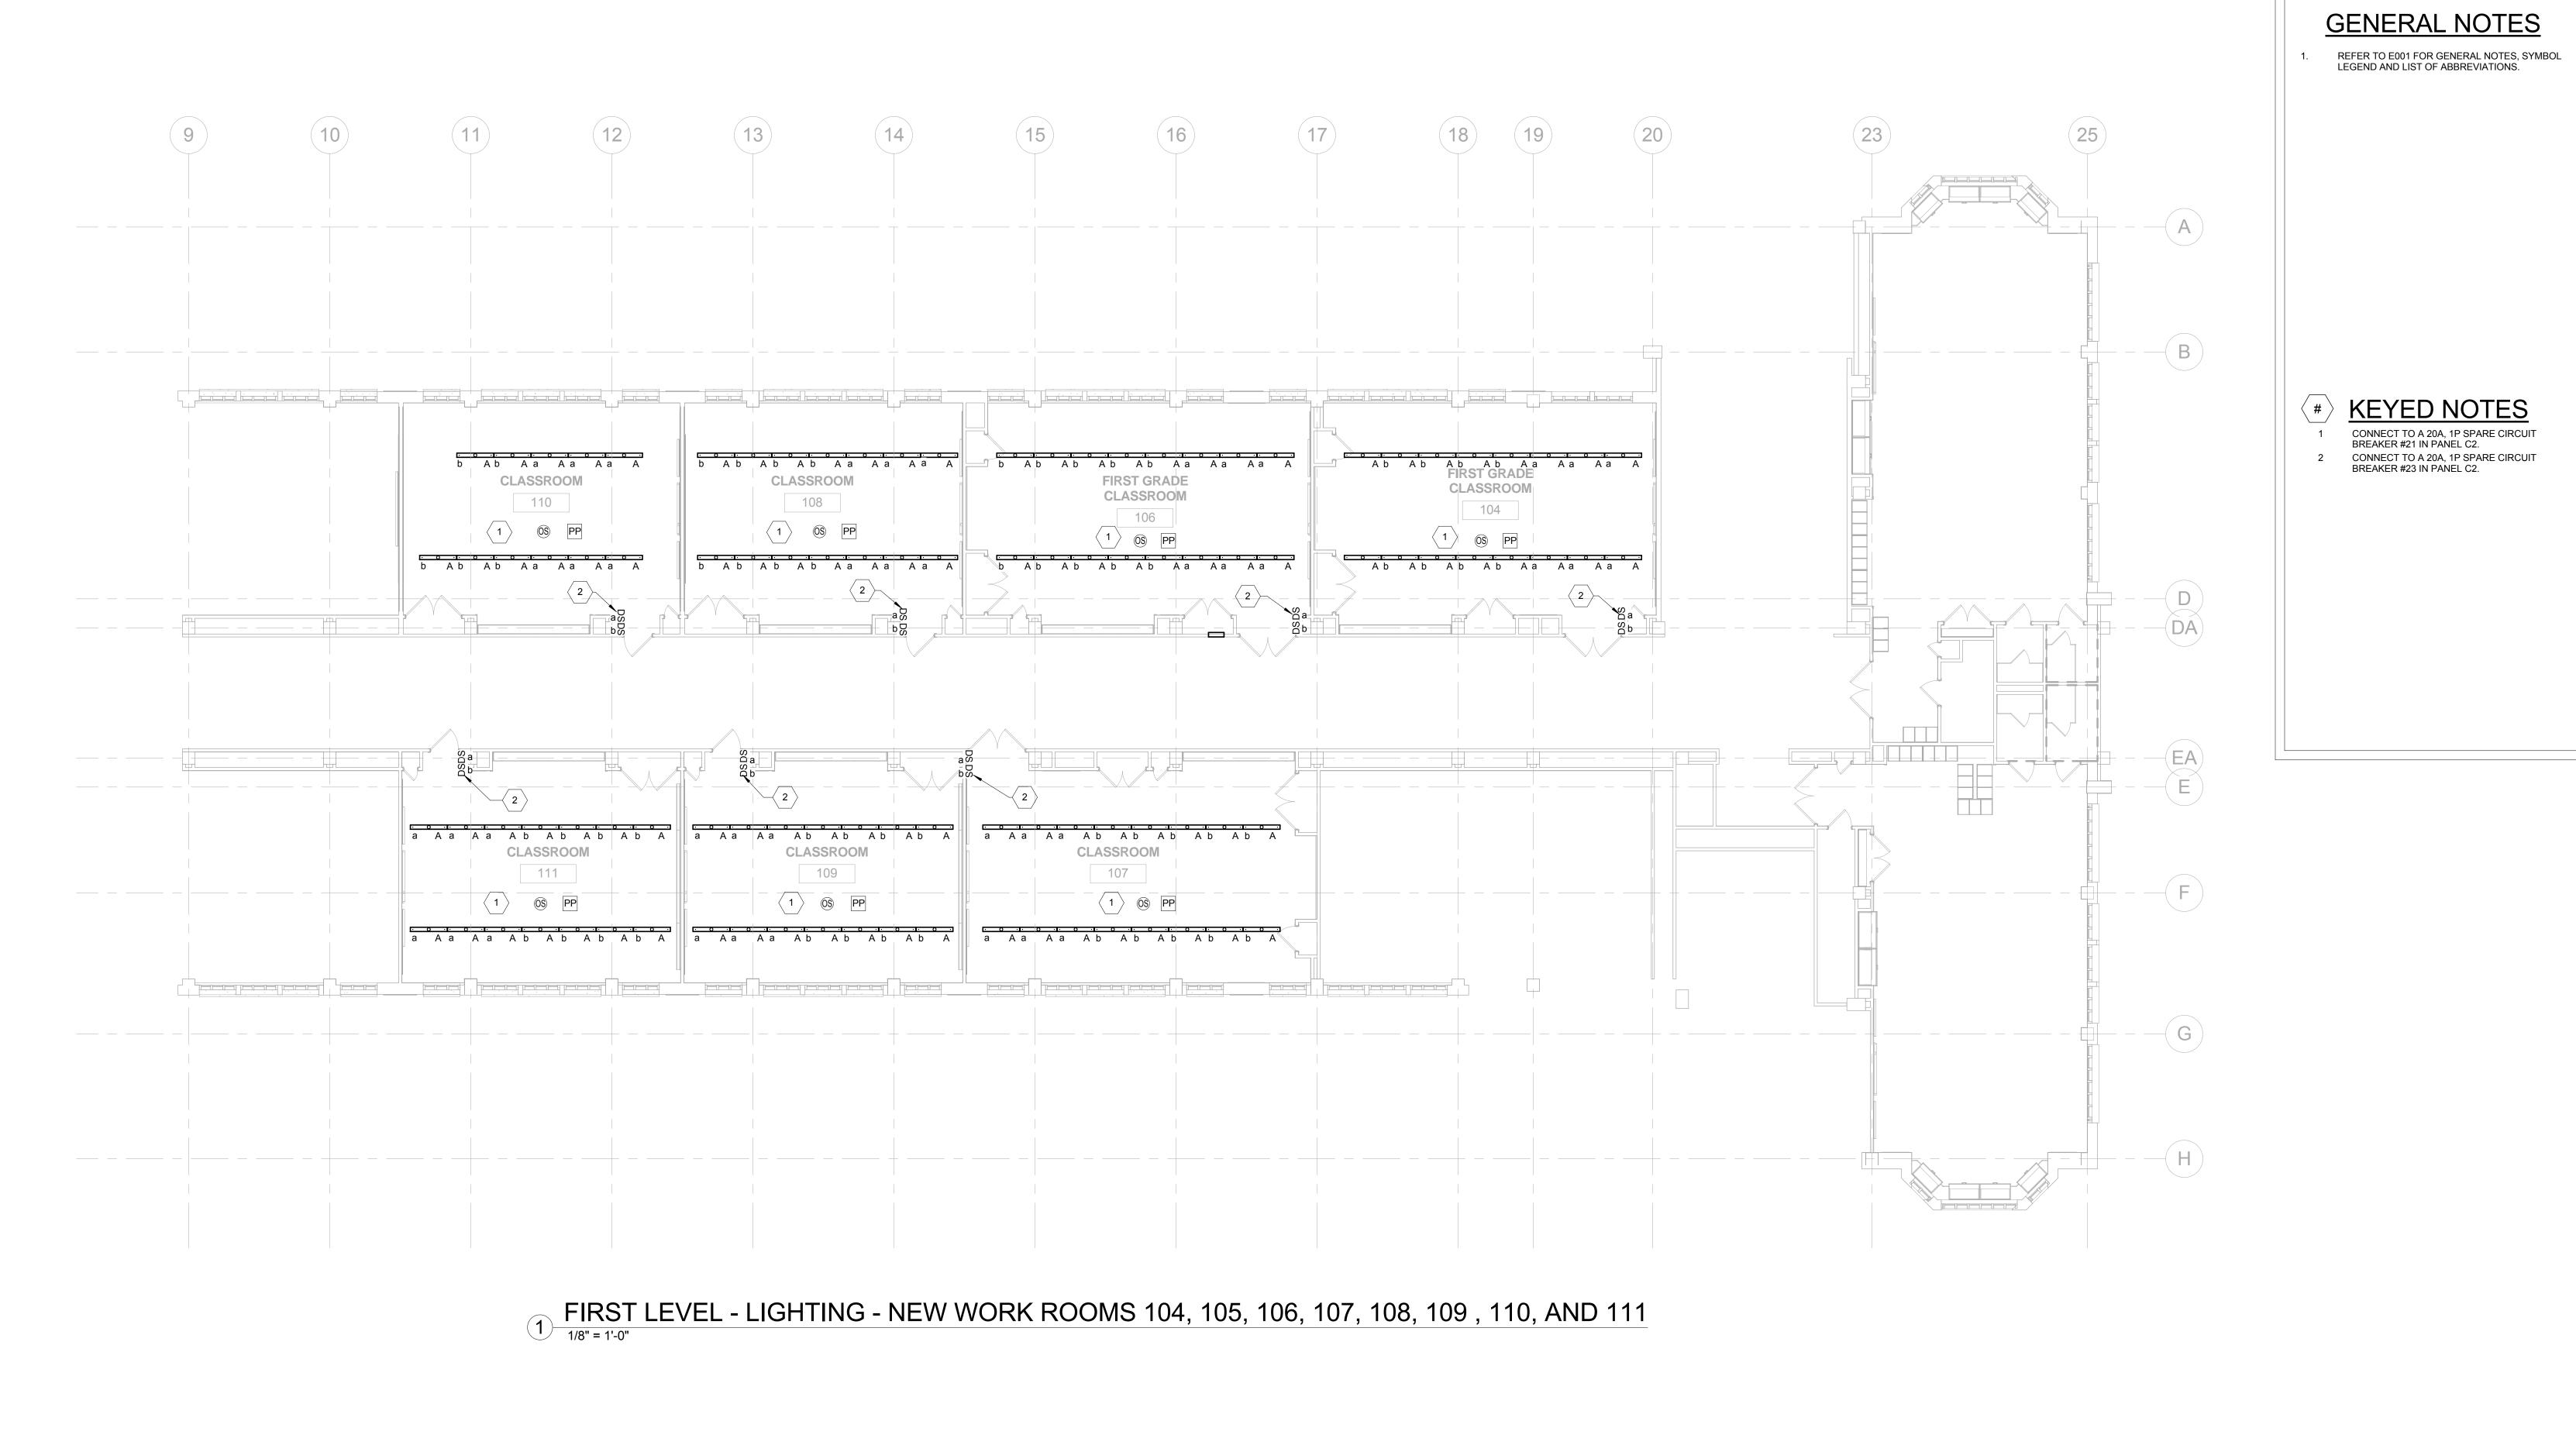

OFFICE OF CAPITAL PROGRAMS

THE SCHOOL DISTRICT OF PHILADELPHIA

www.philasd.org

440 NORTH BROAD STREET PHILADELPHIA, PA 19130 - 4015 (215) 400 - 4730 | (215) 400 - 4731 (fax)

SEAL:




Marshiladi Malajicitian DATE STATE AND LICENSE NO: PA PE082628 09/30/2019

SCHRADERGROUP Architecture, LLC Address: 161 Leverington Ave, Suite 105, Philadelphia PA 19127 Phone: 215.482.7440 Fax: 215.482.7441 Email: bgood@grarc.com Attn: Brian Good

Global Engineering Solutions® Address: 6700A Rockledge Drive, Suite 301 Bethesda Maryland 20817 Phone: 301.216.2871 Fax: 301.216.9671 Email: anilg@theges.com Attn: Anil Giri

BID DOCUMENTS **APRIL 20, 2018** 

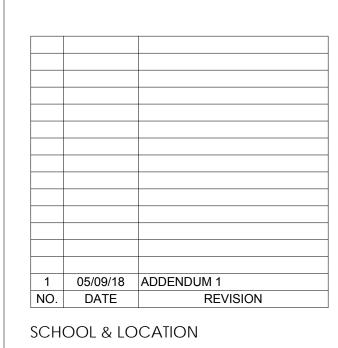

William Rowen School

6841 N 19th St, Philadelphia, PA 19126

PROJECT TITLE


**Classroom Modifications to William** Rowen School

DRAWING TITLE

FIRST LEVEL - LIGHTING FLOOR PLAN - NEW WORK

LOCATION NO. FILE NO. DRAWN BY CHECKED BY B-063 C OF 2017/18 B-066 C OF 2017/18

KEY PLAN

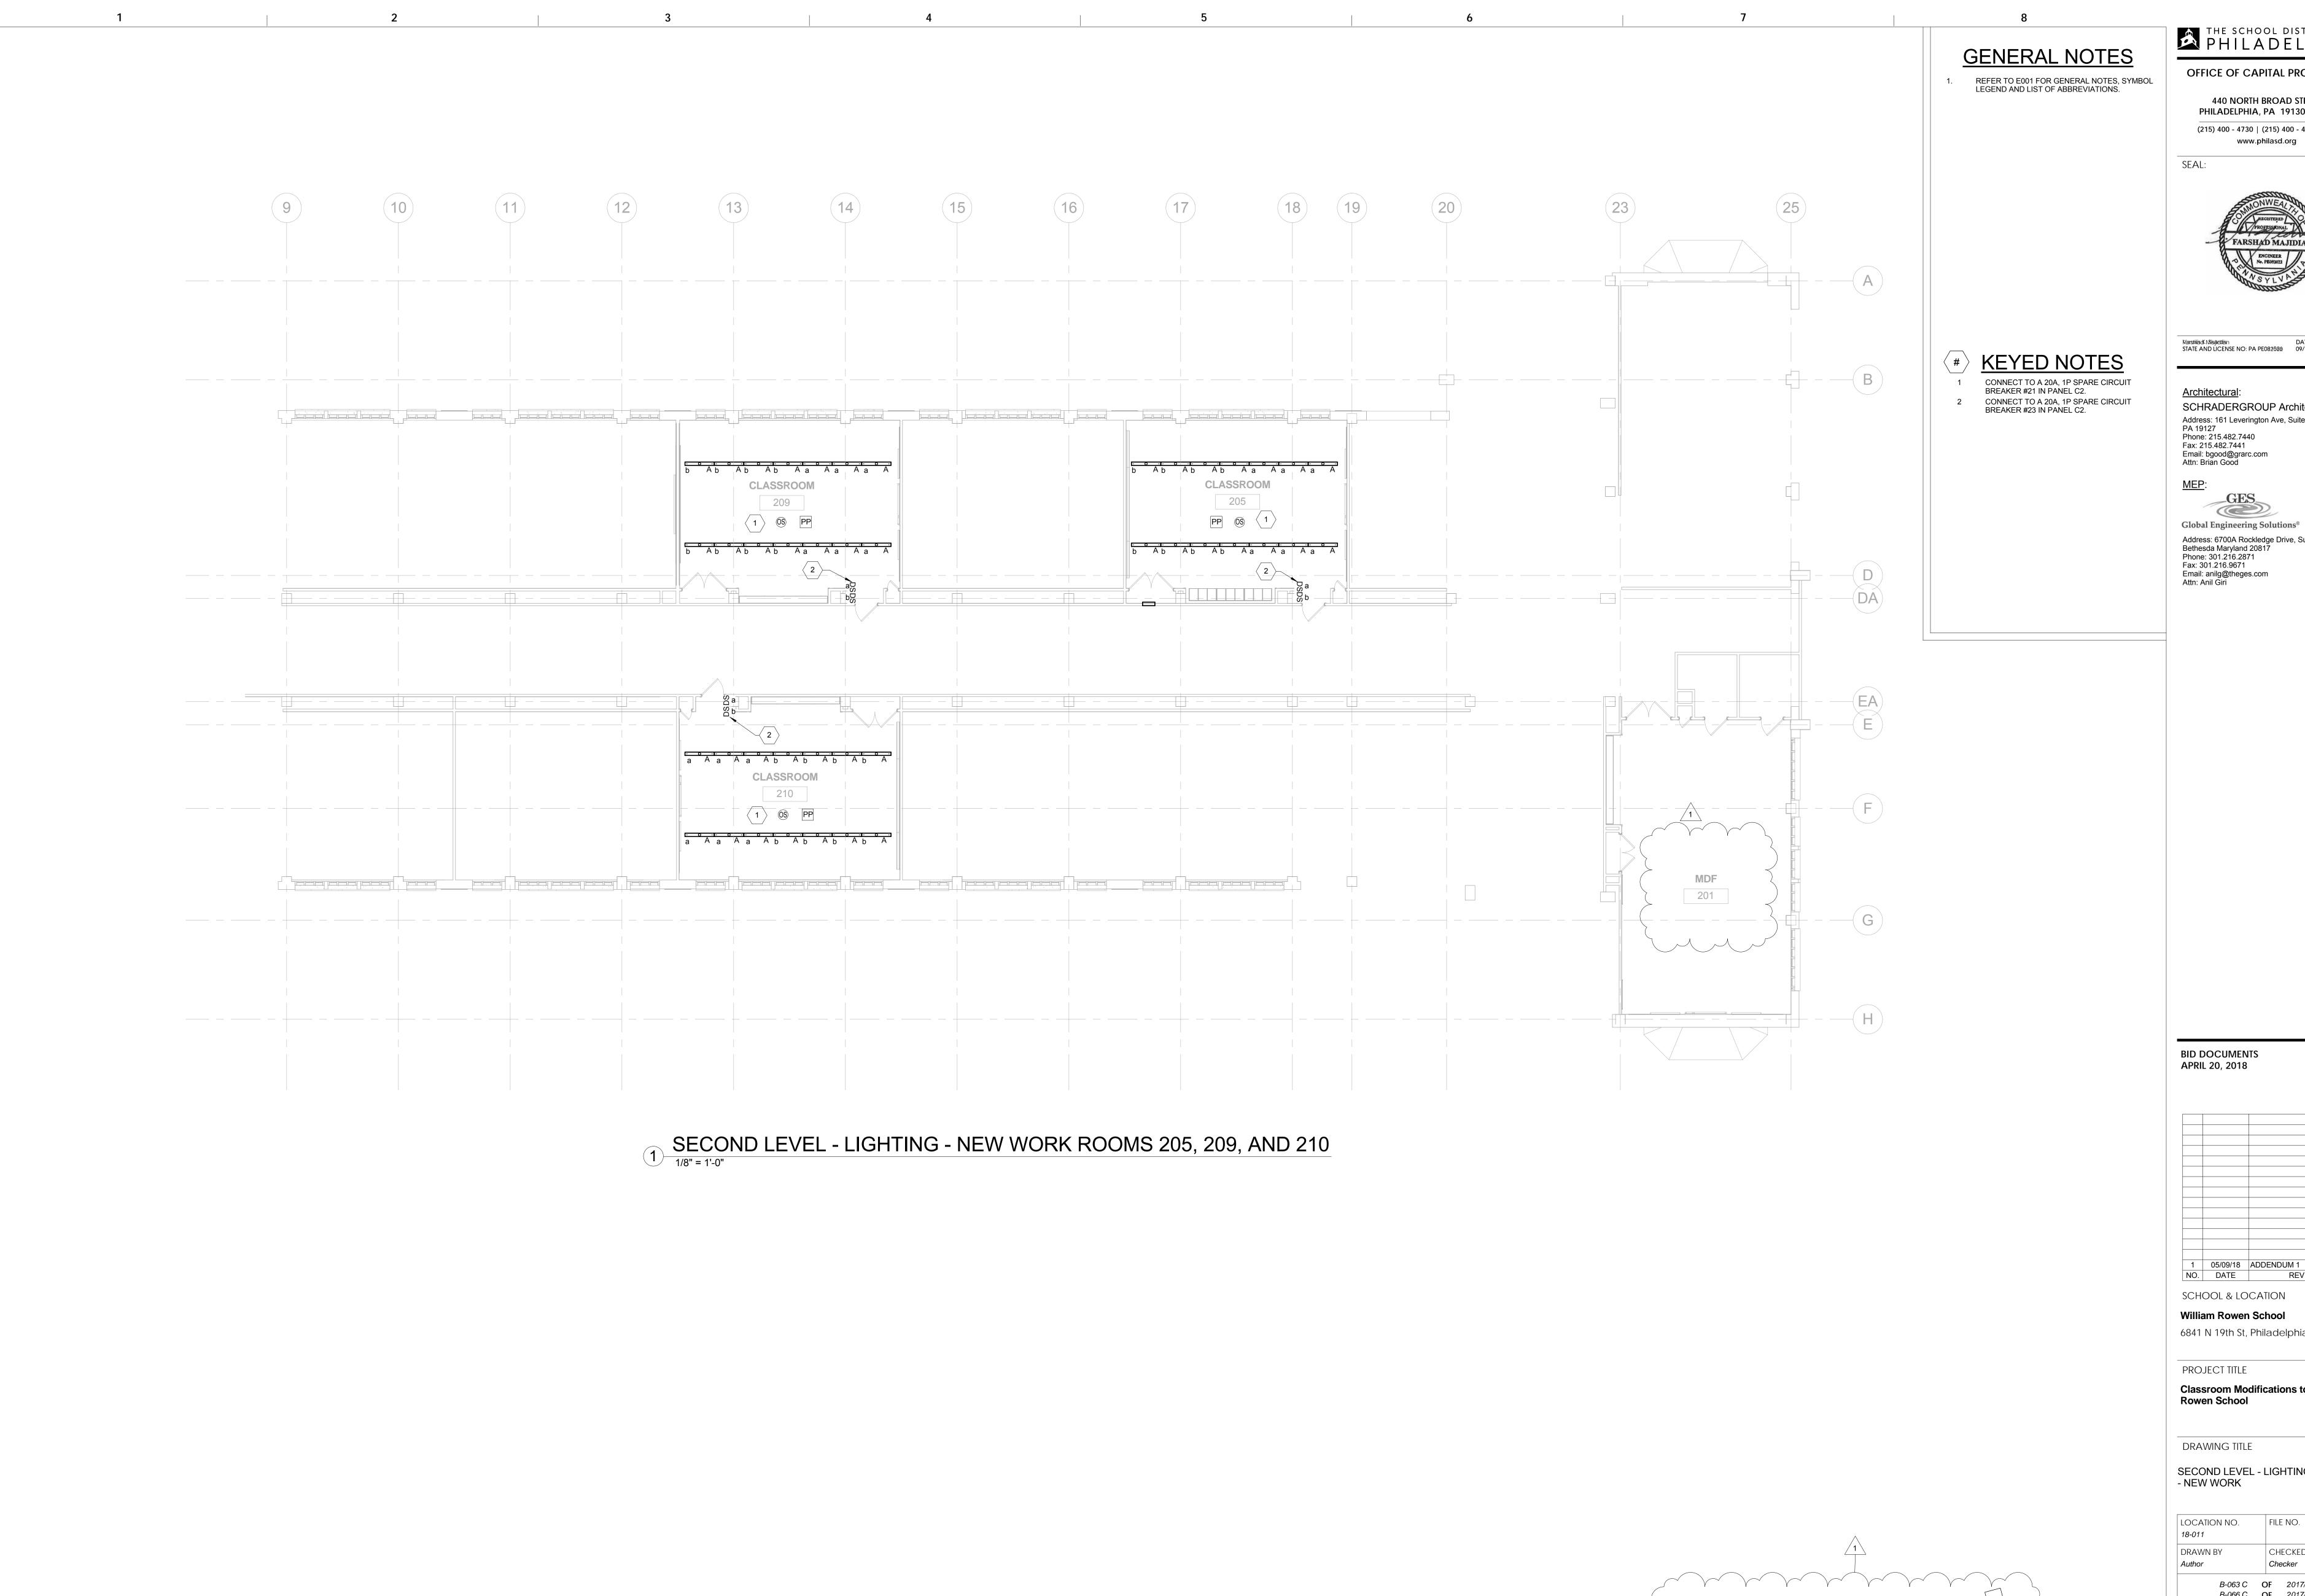

OFFICE OF CAPITAL PROGRAMS

440 NORTH BROAD STREET PHILADELPHIA, PA 19130 - 4015 (215) 400 - 4730 | (215) 400 - 4731 (fax)




Warstkladt Nikspictlern DATE STATE AND LICENSE NO: PA PE082€22 09/30/2019

SCHRADERGROUP Architecture, LLC Address: 161 Leverington Ave, Suite 105, Philadelphia PA 19127
Phone: 215.482.7440
Fax: 215.482.7441
Email: bgood@grarc.com
Attn: Brian Good

Global Engineering Solutions® Address: 6700A Rockledge Drive, Suite 301 Bethesda Maryland 20817 Phone: 301.216.2871 Fax: 301.216.9671

BID DOCUMENTS

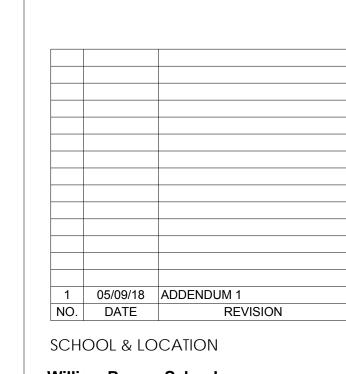

William Rowen School


6841 N 19th St, Philadelphia, PA 19126

**Classroom Modifications to William** 

KEY PLAN

SECOND LEVEL - LIGHTING FLOOR PLAN - NEW WORK

LOCATION NO. 18-011	FILE NO.
DRAWN BY Author	CHECKED BY Checker
B-063 C B-066 C	OF 2017/18 OF 2017/18

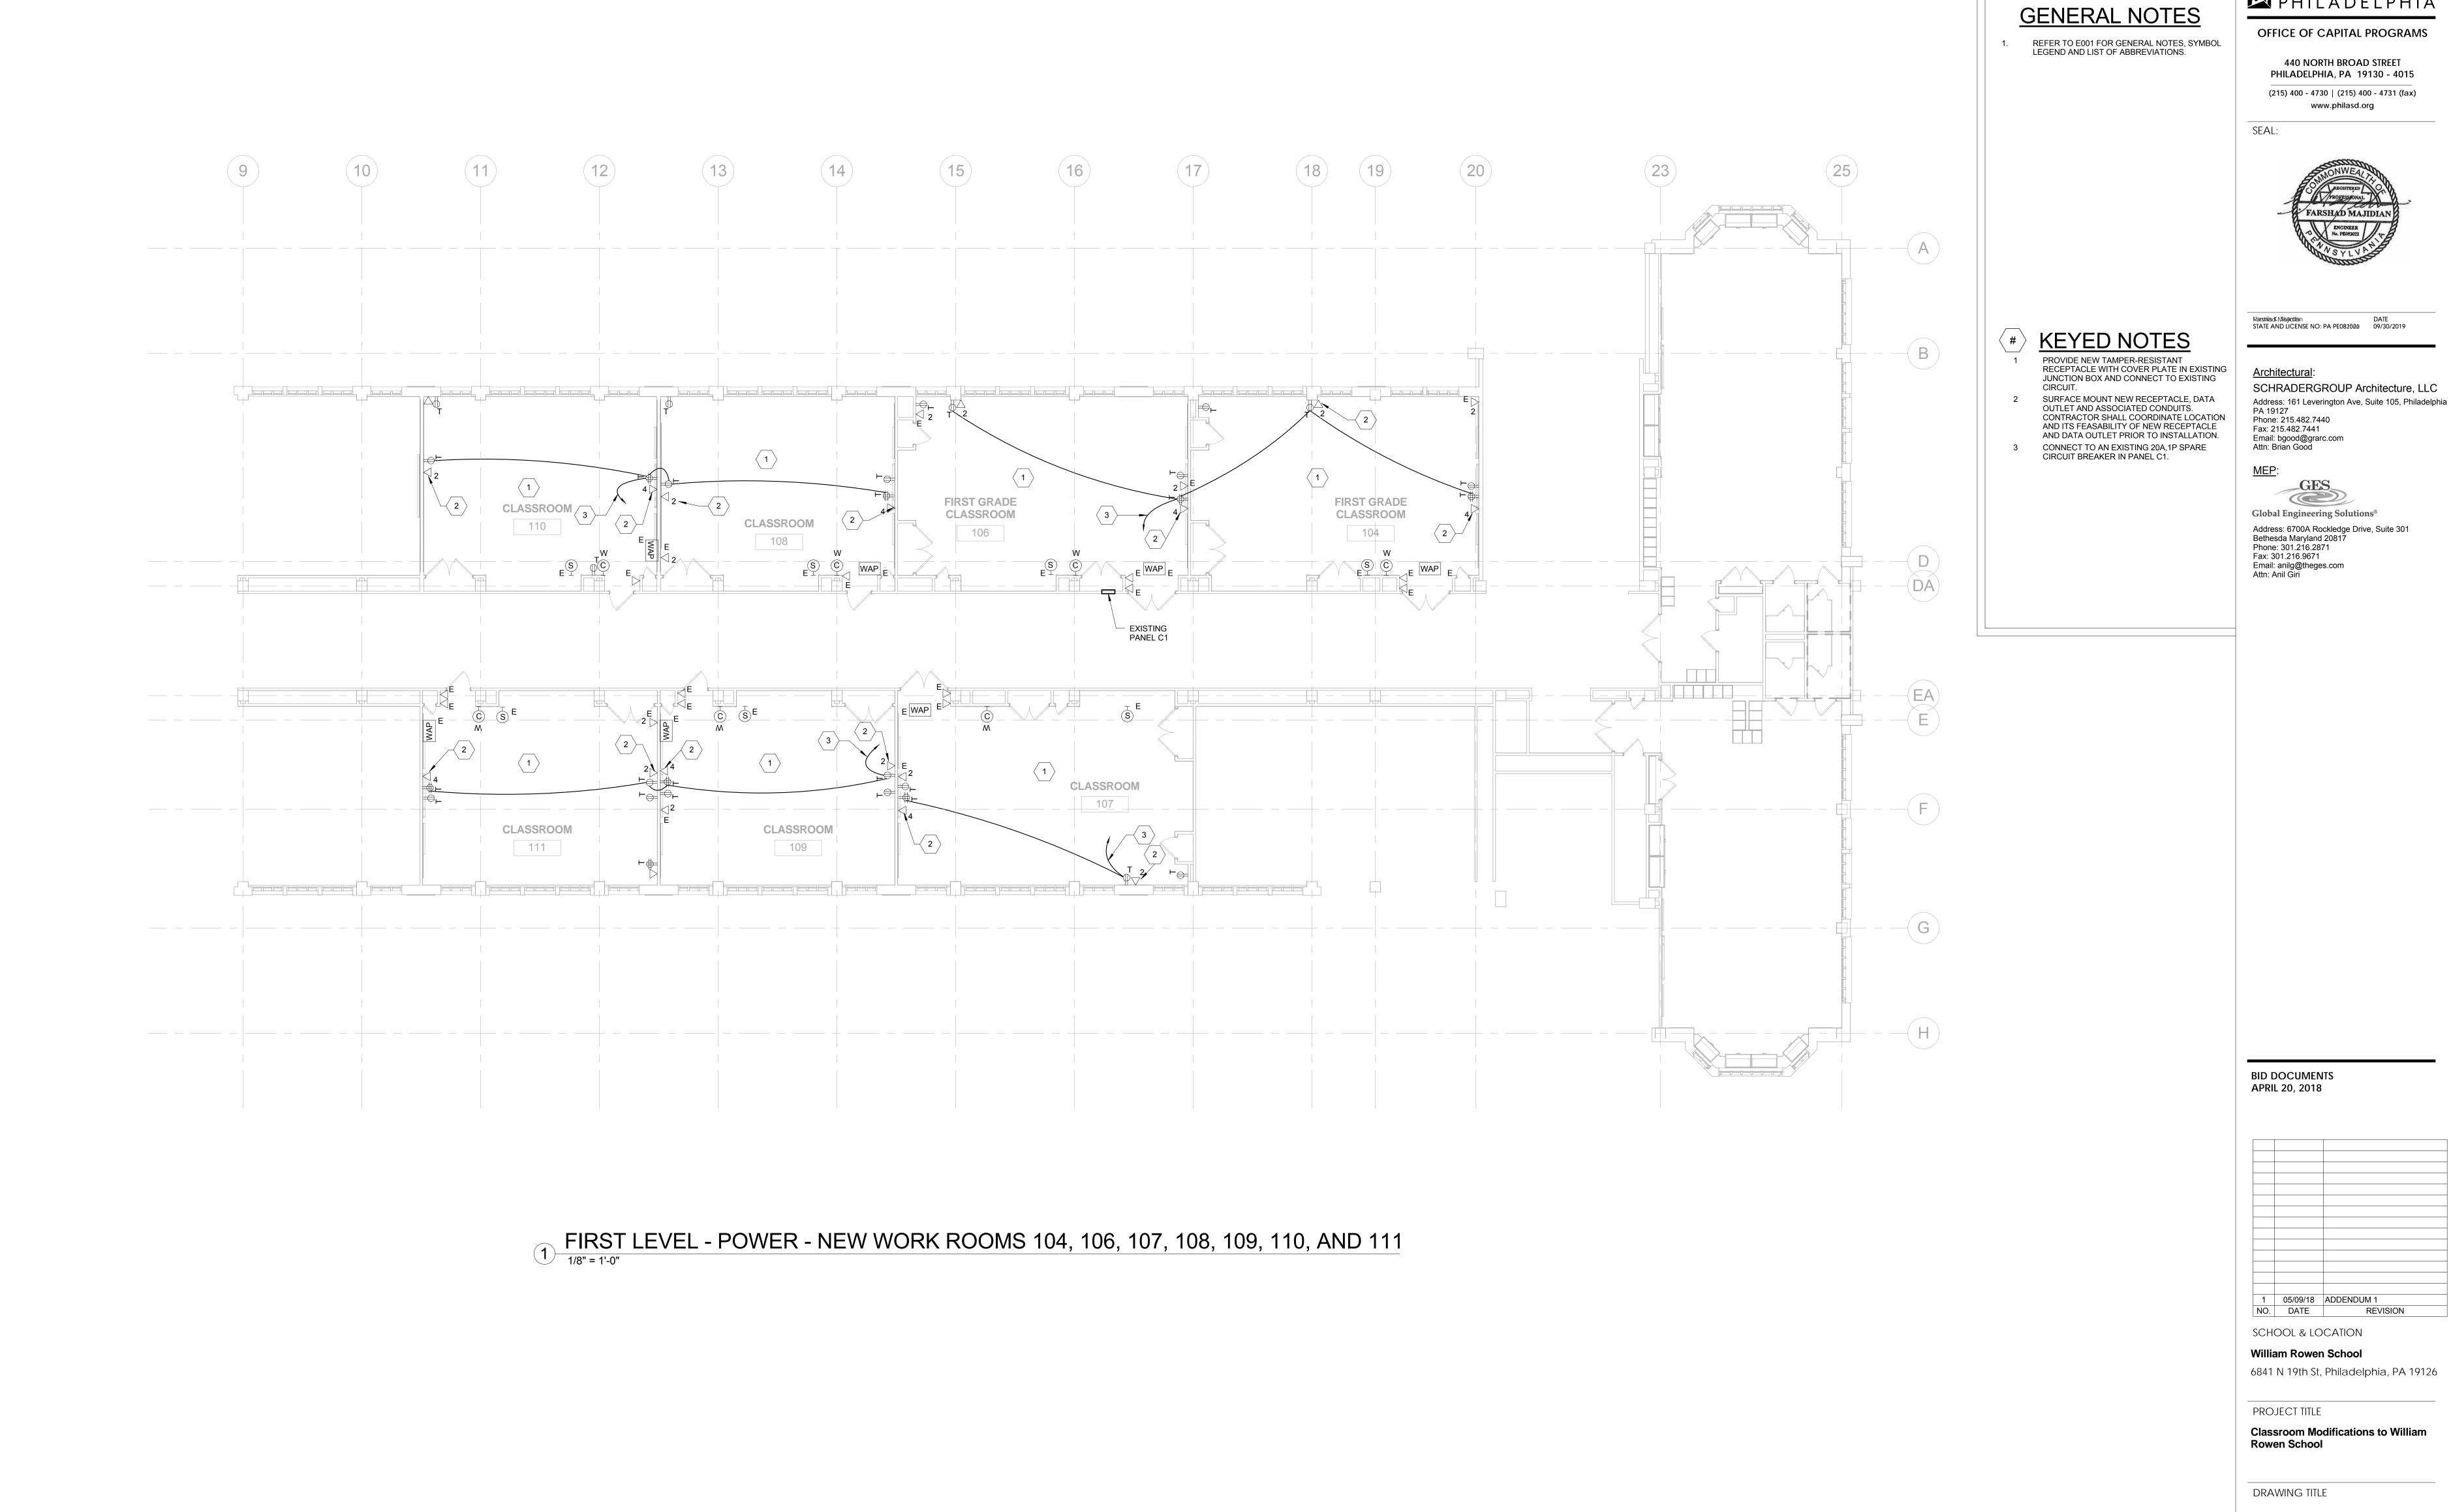


OFFICE OF CAPITAL PROGRAMS

440 NORTH BROAD STREET

DRAWING TITLE FIRST LEVEL - POWER FLOOR PLAN - NEW WORK

LOCATION NO. FILE NO. DRAWN BY CHECKED BY

B-063 C OF 2017/18 B-066 C OF 2017/18

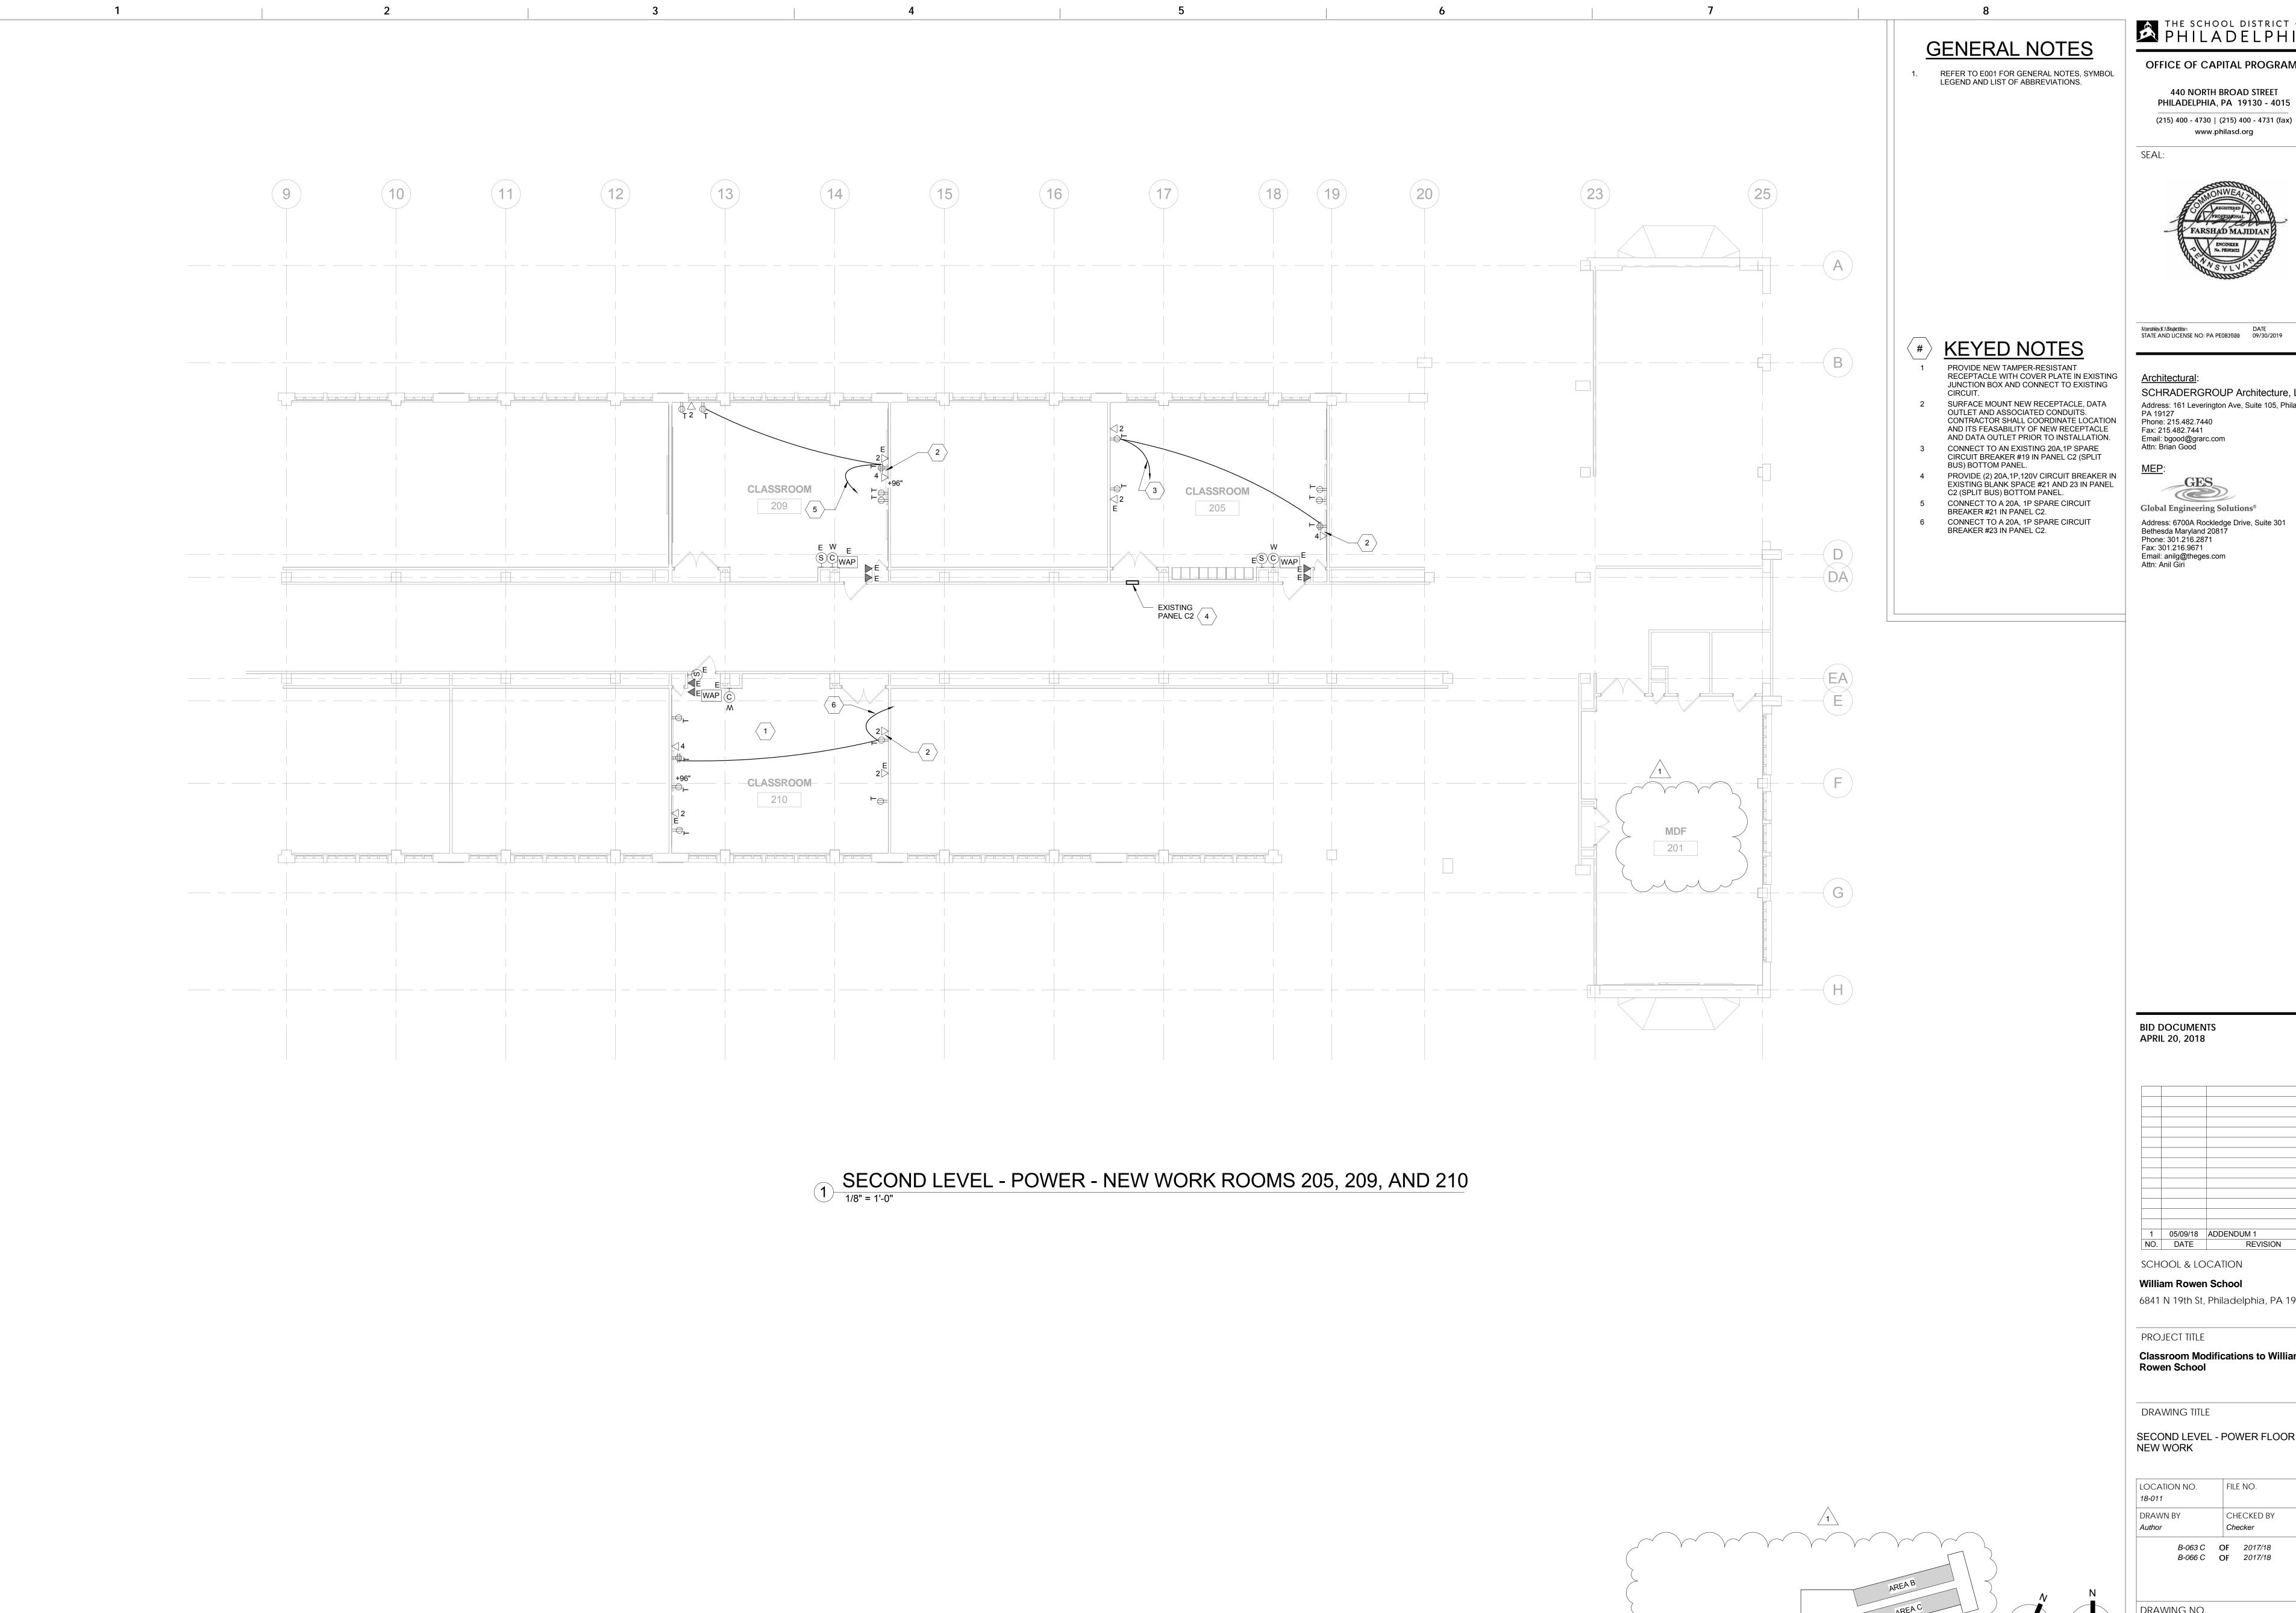

OFFICE OF CAPITAL PROGRAMS

440 NORTH BROAD STREET PHILADELPHIA, PA 19130 - 4015

www.philasd.org




Warstkladt Nikspictlern DATE STATE AND LICENSE NO: PA PE082€22 09/30/2019

SCHRADERGROUP Architecture, LLC Address: 161 Leverington Ave, Suite 105, Philadelphia PA 19127 Phone: 215.482.7440

Global Engineering Solutions®

Address: 6700A Rockledge Drive, Suite 301 Bethesda Maryland 20817 Phone: 301.216.2871
Fax: 301.216.9671
Email: anilg@theges.com
Attn: Anil Giri

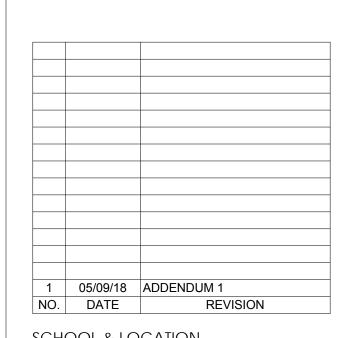

SCHOOL & LOCATION William Rowen School

6841 N 19th St, Philadelphia, PA 19126

**Classroom Modifications to William Rowen School** 

DRAWING TITLE


SECOND LEVEL - POWER FLOOR PLAN - NEW WORK

LOCATION NO. 18-011	FILE NO.
DRAWN BY Author	CHECKED BY Checker
B-063 C B-066 C	·

BROWN W/ WHITE BLUE W/ WHITE GREEN W/ WHITE ORANGE ORANGE W/ WHITE

<u>NOTE</u> 1. ALL RJ45 TERMINATION POINTS SHALL BE CONFIGURED TO THE EIA/TIA 568B STANDARD UNLESS SPECIFICALLY DIRECTED OTHERWISE BY SDP AUTHORIZED REPRESENTATIVE.


4 RJ45 TERMINATION DETAIL NTS

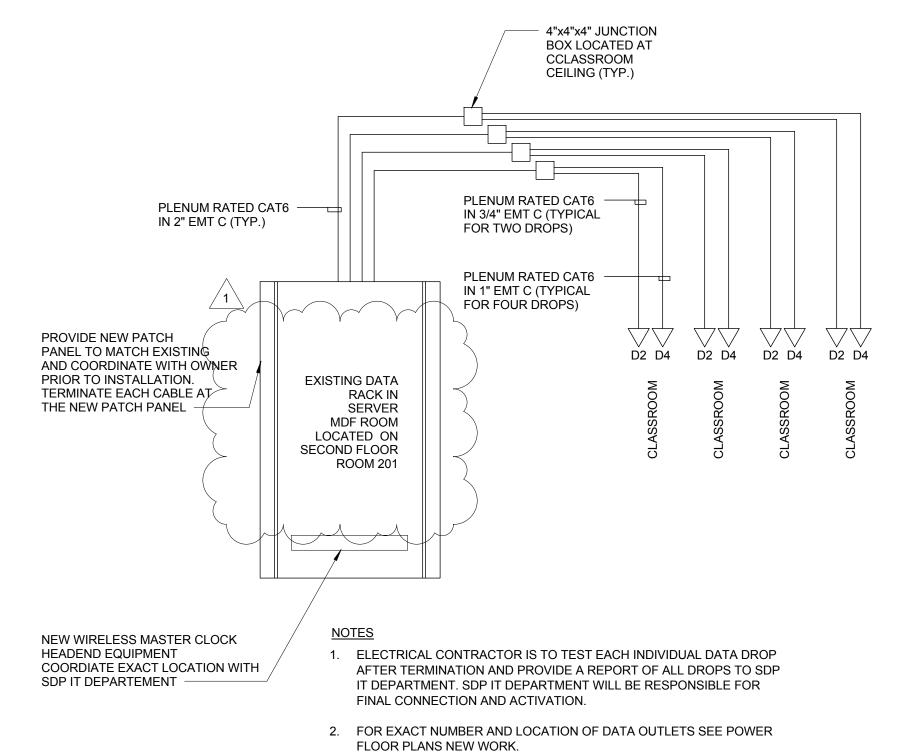

3. FOR ALL COMMUNICATION REQUIREMENT SEE SPECIFICATION 271300

1 DATA RISER DIAGRAM NTS

(COMMUNICATION SYSTEM).

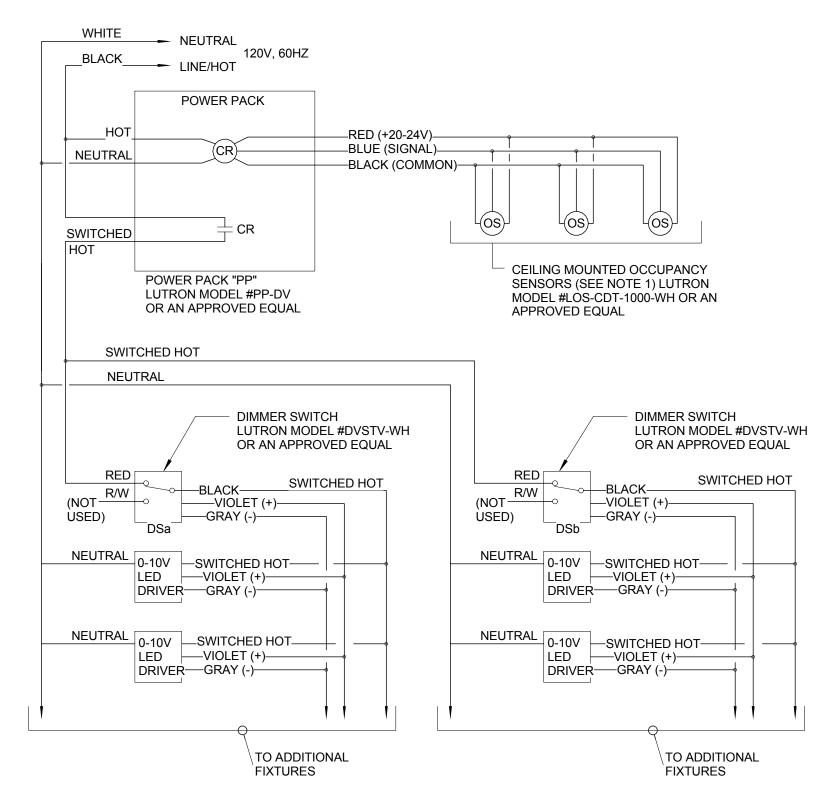

- 1. MAXIMUM COMBINATION OF THREE OCCUPANCY SENSORS AND/OR RELAY UNITS PER CONTROL UNIT.
- 2. CONTRACTOR SHALL VERIFY CONTROLS COMPATIBILITY OF ALL DEVICE AND FIXTURE WITH MANUFACTURERS PRIOR TO PURCHASE.
- 3. DIAGRAM IS SCHEMATIC AND TO SHOW DESIGN INTENT AND IT IS BASED ON LUTRON PRODUCTS; CONTRACTOR SHALL VERIFY EXACT WIRING CONFIGURATION AND REQUIREMENTS PRIOR TO CONSTRUCTION.

TYPICAL CLASSROOM LED LIGHTING CONTROL SCHEMATIC CEILING OCCUPANCY SENSOR WITH TWO 2 DIMMER SWITCHS
NTS

THE SCHOOL DISTRICT OF PHILADELPHIA

OFFICE OF CAPITAL PROGRAMS

440 NORTH BROAD STREET PHILADELPHIA, PA 19130 - 4015 (215) 400 - 4730 | (215) 400 - 4731 (fax) www.philasd.org

SEAL:



Marshiladi Malajicitian DATE STATE AND LICENSE NO: PA PE082628 09/30/2019

Architectural:


SCHRADERGROUP Architecture, LLC Address: 161 Leverington Ave, Suite 105, Philadelphia PA 19127 Phone: 215.482.7440 Fax: 215.482.7441 Email: bgood@grarc.com Attn: Brian Good

Global Engineering Solutions®

Bethesda Maryland 20817 Phone: 301.216.2871
Fax: 301.216.9671
Email: anilg@theges.com
Attn: Anil Giri

Address: 6700A Rockledge Drive, Suite 301

BID DOCUMENTS APRIL 20, 2018

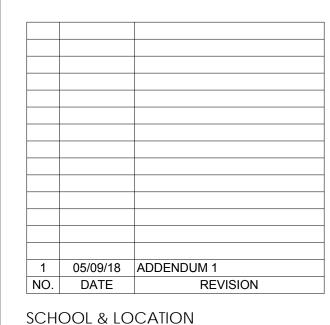

William Rowen School

Classroom Modifications to William

6841 N 19th St, Philadelphia, PA 19126

PROJECT TITLE

Rowen School

DRAWING TITLE

ELECTRICAL DETAILS

LOCATION NO. FILE NO. CHECKED BY DRAWN BY

B-066 C OF 2017/18

MECHANICAL GENERAL NOTES **GENERAL PIPING ABBREVIATIONS** DOUBLE LINE DUCTWORK ASSOCIATED AIR BALANCE POUNDS PER HOUR AUTOMATIC AIR VENT LOCKED ROTOR AMP AUTOMATIC AIR VENT LRA 90° ELBOW, RECTANGULAR WITHOUT RECTANGULAR DUCT (FIRST FIGURE IS LEAVING WATER TEMPERATURE **—** THE INTENT OF THESE DRAWINGS IS TO PROVIDE COMPLETE AND PROPERLY 300x150 

★ FOR SIDE SHOWN, SECOND FIGURE IS DIRECTION OF PIPE PITCH TURING VANES AIR CONDITIONING UNIT FUNCTIONING HVAC SYSTEMS. PROVIDE ALL LABOR AND MATERIAL NECESSARY TO FOR SIDE NOT SHOWN) ACOUSTICAL CEILING TILE ACHIEVE SUCH ENDS. CONTRACTOR IS OBLIGATED TO EXAMINE PLANS. ANY OBSERVED MOTORIZED DAMPER Ø FD FLOOR DRAIN √ 45° ELBOW, RECTANGULAR FAULTS OR AMBIGUITY IN THESE PLANS SHALL BE CALLED TO THE ATTENTION OF THE ACCESS DOOR MIXED AIR 300 ROUND DUCT OWNER'S REPRESENTATIVE IMMEDIATELY, SO THAT THE MATTER MAY BE RESOLVED ADDITIONAL ADDT'L MIXED AIR TEMPERATURE FLOW DIRECTION PRIOR TO SUBMISSION OF BIDS. BY SUBMISSION OF BID, THE CONTRACTOR SHALL ADJ MAXIMUM ACKNOWLEDGE ACCEPTANCE OF THESE PLANS AS AN ADEQUATE DEFINITION OF THE 90° ELBOW, ROUND OR FLAT OVAL FLAT OVAL DUCT (FIRST FIGURE IS FOR AFC ABOVE FINISHED CEILING ONE THOUSAND BTUH MANUAL AIR VENT SCOPE OF WORK AND EXTRA COST CLAIMS BASED ON INADEQUACY OF PLANS WILL 300x150 ↔ 〈 SIDE SHOWN, SECOND FIGURE IS FOR (SMOOTH OR 5 PIECE ELBOWS) AFCP AIR FLOW CONTROL PANEL MECHANICAL CONTRACTOR SIDE NOT SHOWN) MCC MOTOR CONTROL CENTER ABOVE FINISHED FLOOR PIPE CONTINUES AFM AIR FLOW MEASURING STATION MANUAL DAMPER ALL WORK ON THIS PROJECT SHALL BE INSTALLED IN ACCORDANCE WITH THE LATEST MITERED 90° ELBOW, ROUND OR FLAT OVAL FLOW DIRECTION ARROW AHU AIR HANDLING UNIT MECH MECHANICAL APPLICABLE CODES AND REGULATIONS. BOILER FEEDWATER ALUMINUM MER MECHANICAL EQUIPMENT ROOM THESE DRAWINGS ARE DIAGRAMMATIC AND INTENDED TO DEPICT THE GENERAL AMBIENT MFGR MANUFACTURER COMPRESSED AIR LOCATION OF HVAC SYSTEM COMPONENTS. CONSULT THE ARCHITECTURAL PLANS FOR AMT AMOUNT MIN MINIMUM FLEX DUCT CONNECTION √ 90° ELBOW. RECTANGULAR WITH PROPER DIMENSIONS AND LOCATION OF EQUIPMENT. APD AIR PRESSURE DROP MAKE-UP AIR CONDENSATE DRAIN TURING VANES ARCH ARCHITECT MAKE-UP AIR UNIT MUAU THE CONTRACTOR SHALL COORDINATE THE INSTALLATION OF HVAC WORK WITH AMERICAN REFRIGERATION CHILLED WATER RETURN EXISTING CONDITIONS AND THE WORK OF OTHER TRADES. MINOR DEVIATIONS FROM AIR SEPARATOR NOT APPLICABLE THE PLANS MAY BE MADE TO AVOID MINOR CONFLICTS. WHEN MAJOR CONFLICTS ARE 45° ELBOW, ROUND OR FLAT OVAL VOLUME DAMPER ASHRAE AMERICAN SOCIETY OF NORMALLY CLOSED/NOISE CRITERIA APPARENT, THE ARCHITECT SHALL BE ADVISED IMMEDIATELY, AND AFFECTED WORK (SMOOTH OR 3 PIECE ELBOWS) CHILLED WATER SUPPLY NATIONAL ELECTRICAL CODE AIR CONDITIONING ENGINEERS SHALL NOT BE INSTALLED UNTIL THE CONFLICT HAS BEEN RESOLVED. AMERICAN SOCIETY FOR TESTING **ASTM** NATURAL GAS CONDENSER WATER RETURN NUMBER/NORMALLY OPEN AND MATERIALS THE CONTRACTOR SHALL OBTAIN AND PAY FOR PERMITS AND ARRANGE FOR MOTORIZED DAMPER AIR TERMINAL UNIT NOT TO SCALE INSPECTIONS BY LOCAL AUTHORITIES HAVING JURISDICTION. DIVIDED FLOW FITTING CONDENSER WATER SUPPLY AUTO AUTOMATIC MECHANICAL CONTRACTOR SHALL THOROUGHLY CLEAN HIS WORK AREA DAILY. OUTSIDE AIR MECHANICAL CONTRACTOR SHALL ALSO REMOVE ALL TRASH AFTER WORK BOILER OUTSIDE AIR FAN BACK DRAFT DAMPER TAP-IN BRANCH, RECTANGULAR BALANCE/ING OUTSIDE AIR LOUVER BUILDING CONTROL UNIT BCU OPPOSED BLADE DAMPER WHERE EXISTING FIELD CONDITIONS ARE DIFFERENT THAN SHOWN, THE CONTRACTOR **BOILER HORSEPOWER/BRAKE** ON CENTERPOWER – — — – DTR – — – DUAL TEMPERATURE RETURN FIRE DAMPER SHALL ADVISE THE ENGINEER OF DISCREPANCIES WHICH WILL AFFECT THE PROPOSED BOP OCC BOTTOM OF PIPE OCCUPIED WORK PRIOR TO BEGINNING WORK. BRANCH DUCT, CONICAL BLDG OVERFLOW BUILDING DUAL TEMPERATURE SUPPLY LATERAL FITTING BLW OPP OPPOSITE BFI OW THE CONTRACTOR SHALL LOCATE ALL EQUIPMENT WHICH MUST BE SERVICED, ROUND OR FLAT OVAL COMBINATION FIRE/SMOKE DAMPER BOS ORIG OPERATED, MAINTAINED IN FULLY ACCESSIBLE POSITION. EQUIPMENT SHALL INCLUDE. **BOTTOM OF STEEL** ORIGINAL BRANCH DUCT, CONICAL TEE BUT NOT BE LIMITED TO, VALVES, TRAPS, CLEANOUTS, MOTORS, CONTROLLERS, DRAIN BPD BACK PRESSURE DAMPER O&M OPERATION AND MAINTENANCE FITTING, ROUND POINTS, ETC. IF REQUIRED FOR ACCESSIBILITY, FURNISH ACCESS DOORS FOR THIS BTUH BRITISH THERMAL UNIT PER HOUR HOT WATER SUPPLY OR FLAT OVAL PURPOSE. MINOR DEVIATIONS FROM DRAWINGS MAY BE MADE TO ALLOW FOR BETTER SMOKE DAMPER ACCESSIBILITY. BRANCH DUCT, "Y" FITTING, COMBUSTION AIR PLUMBING CONTRACTOR **ROUND OR FLAT** CAD **CEILING AIR DIFFUSER** PRESSURE DROP ALL WORK TO BE GUARANTEED FOR TWO YEAR AGAINST LABOR AND MATERIALS. ANY DUCT TRANSITION, ROUND OR CAL **COMBUSTION AIR LOUVER** PDCV PRESSURE DIFFERENTIAL CONTROL FLAT OVAL TO RECTANGULAR DEFECTIVE MATERIALS OR WORKMANSHIP, AS WELL AS DAMAGE TO THE WORK OF ALL CAP CAPACITY TRADES RESULTING FROM SAME, SHALL BE REPLACED OR REPAIRED AS DIRECTED FOR 90° ELBOW TURNED UP, PRESSURE REDUCING VALVE CAV CONSTANT AIR VOLUME THE DURATION OF THE GUARANTEE PERIOD. TIME FOR THIS GUARANTEE SHALL BEGIN DUCT TRANSITION, RECTANGULAR [SUPPLY] POUNDS PER HOUR COOLING COIL FROM THE DATE OF ACCEPTANCE OF THE COMPLETE WORK BY THE OWNER OR HIS RECTANGULAR TO ROUND 90° ELBOW TURNED DOWN, PRESS CENTRIFUGAL FAN PRESSURE APPOINTED REPRESENTATIVE. NOTE: THESE GUARANTEES SHALL BE SUBMITTED TO OR FLAT OVAL RECTANGULAR [SUPPLY] THE TENANT AND/OR BUILDING OWNER FOR RECORD PURPOSES. CFM **CUBIC FEET PER MINUTE** POUNDS PER SQUARE INCH DUCT TRANSITION, CLG CEILING POUNDS PER SQUARE INCH GAUGE RECTANGULAR, ROUND, OR 10. AS USED IN DRAWINGS AND SPECIFICATIONS FOR MECHANICAL WORK, CERTAIN NON-90° ELBOW TURNED UP. CO CLEAN OUT POLYVINYL CHLORIDE FLAT OVAL TECHNICAL WORDS SHALL BE UNDERSTOOD TO HAVE SPECIFIC MEANINGS AS FOLLOWS RECTANGULAR RETURN CONC CONCRETE REGARDLESS OF INDICATIONS TO THE CONTRARY IN THE GENERAL CONDITION OR INCLINED RISE W/RESPECT TO COND CONDITIONING QTY QUANTITY R→ OTHER DOCUMENTS GOVERNING THE MECHANICAL WORK. 90° ELBOW TURNED DOWN, AIR FLOW, RECTANGULAR CONN CONNECT/CONNECTION RECTANGULAR RETURN CONT CONTINUATION RETURN AIR "FURNISH" - PURCHASE AND DELIVER TO THE PROJECT SITE COMPLETE WITH EVERY RETURN AIR GRILLE CIRCULATING PUMP RAG NECESSARY APPURTENANCE AND SUPPORT, ALL AS PART OF THE MECHANICAL WORK. INCLINED DROP W/ RESPECT 90° ELBOW TURNED UP,  $\mathcal{N} \mid \neg \mathsf{D} \mid \mathcal{N}$ RETURN AIR REGISTER CSR RAR CEILING SUPPLY REGISTER PURCHASING SHALL INCLUDE PAYMENT OF ALL SALES TAXES AND OTHER SURCHARGES TO AIR FLOW, RECTANGULAR **RECTANGULAR EXHAUST CONDENSING UNIT** AS MAY BE REQUIRED TO ASSURE THAT PURCHASED ITEMS ARE FREE OF ALL LIENS. REFER/REFERENCE CLAIMS OR ENCUMBRANCES. CONTROL VALVE REG REGISTER INCLINED RISE W/RESPECT TO AIR 90° FLBOW TURNED DOWN. COLD WATER RETURN/RELIEF FAN FLOW, ROUND OR FLAT OVAL RECTANGULAR EXHAUST "INSTALL" - UNLOAD AT THE DELIVERY POINT AT THE SITE AND PERFORM EVERY RATED LOAD AMP DPERATION NECESSARY TO ESTABLISH SECURE MOUNTING AND CORRECT OPERATION INCLINED DROP W/RESPECT TO AIR FLOW, 90° ELBOW TURNED UP ROUND, FLAT OVAI DRY BULB RETURN LINEAR AIR DIFFUSER AT THE PROPER LOCATION IN THE PROJECT, ALL AS PART OF THE MECHANICAL WORK. SIMILAR SUPPLY / RETURN / EXHAUST ROUND OR FLAT OVAL ROOM DECIBEL 90° ELBOW TURNED DOWN ROUND, FLAT DDC DIRECT DIGITAL CONTROL **REVOLUTIONS PER MINUTE** "PROVIDE" - "FURNISH" AND "INSTALL". OVAL SIMILAR SUPPLY / RETURN / EXHAUST PRESSURE DROP STATIC PRESSURE SENSOR DIAMETER "NEW" - MANUFACTURED WITHIN THE PAST TWO YEARS AND NEVER BEFORE USED. DIFF SUPPLY AIR GRILLE DIFFERENCE CEILING DIFFUSER (CD) OR GRILLE DISC SW 1. ALL MATERIAL, EQUIPMENT AND ACCESSORIES, FURNISHED AND INSTALLED SHALL BE DISCONNECT SWITCH SANITARY NEW AND EQUAL TO OR SURPASS THE QUALITY OF SIMILAR MATERIALS AS SCHEDULES. → HUMIDIFIER SUPPLY AIR REGISTER ALL MATERIALS, EQUIPMENT AND METHODS SHALL BE AS SPECIFIED IN THE BASE **DEW POINT** SHADING COEFFICIENT CEILING REGISTER (CR) OR GRILLE BUILDING CONTRACT DOCUMENTS UNLESS NOTED OTHERWISE. SMOKE DAMPER/SPLITTER DAMPER (CG) [RETURN OR EXHAUST] **DRAWING** SOUND DIGITAL CONTROLLER ACCESS DOOR IN DUCT DIRECT EXPANSION SEER SEASONAL ENERGY EFFICIENCY CEILING DIFFUSER (ARROWS INDICATE SUPPLY FAN THROW DIRECTIONS) **EXHAUST AIR/EACH** SIMILIAR **EXHAUST AIR LOUVER** SLOT LINEAR AIR DIFFUSER CEILING DIFFUSER (ARROWS INDICATE EXHAUST AIR REGISTER SHEET METAL AND AIR ENTERING AIR TEMPERATURE SCREENED OPENING **ELECTRICAL CONTRACTOR** STATIC PRESSURE **ECON ECONOMIZER** SPEC SPECIFICATION SYMBOLS **ACCESSORIES** PIPE FITTINGS/VALVES EER SQUARE FEET ENERGY EFFICIENCY RATIO **EXHAUST FAN** SQUARE INCHES EFFICIENCY STEAM RELIEF VENT ELEV STAINLESS STEEL FI EVATION BDD BACKDRAFT DAMPER **EXISTING TO REMAIN** FLANGE CONNECTION FI BOW STEEL **ENTERING** STN SECTION FLEXIBLE CONNECTOR **VOLUME DAMPER EXISTING TO BE REMOVED EQUIPMENT** SUSPENSION EQUIVALENT SIDE WALL REGISTER PIPE CONNECTION - BOTTOM FIRE DAMPER EXTERNAL STATIC PRESSURE SYM SYMBOL **NEW WORK ESTIMATED** ELECTRIC WALL HEATER **EWH** PIPE CONNECTION - TOP THERMOSTAT POINT OF CONNECTION NEW EWT **ENTERING WATER** TEMPERATURE CONTROLIPERATURE TO EXISTING EXH **EXHAUST** TEMPERATURE DIFFERENCE PIPE DOWN EXIST TEMP **EXISTING** TEMPERATURE TRANSFER GRILLE LIMIT OF DEMOLITION PIPE END CAP MOTORIZED DAMPER **DEGREES FAHRENHEIT** TOP OF STEEL TOS FLEXIBLE CONNECTION PIPE REDUCER - CONCENTRIC (CO2) CARBON DIOXIDE SENSOR (MOUNT 48" AFF) FIRE DAMPER TOTAL STATIC PRESSURE FINISHED FLOOR ELEVATION TURNING VANE PIPE REDUCER - ECCENTRIC FULL LOAD AMP TXV THERMAL EXPANSION VALVE (CO) CARBON MONOXIDE SENSOR FLEX **FLEXIBLE** TYPICAL PIPE UP FLANGE UNION CONNECTION (H) HUMIDISTAT (MOUNT 48" AFF) **FACTORY MUTUAL** UNDERGROUND UNDERWRITERS LABORATORY FPM FEET PER MINUTE BALL VALVE (T) THERMOSTAT (MOUNT 48" AFF) UNIT VENTILATOR **EQUIPMENT** FT WG FEET OF WATER GAUGE **BUTTERFLY VALVE** ⟨ŚĎ⟩ SMOKE DETECTOR VARIABLE AIR VOLUME CHECK VALVE GALLONS VOLUME DAMPER VAV TERMINAL UNIT WITH REHEAT COIL VDR VANED RETURN REGISTER **GENERAL CONTRACTOR** DETAIL GLOBE VALVE GPM **GALLONS PER MINUTE** VFD VARIABLE FREQUENCY DRIVE VAV TERMINAL UNIT - COOLING ONLY VOL VOLUME SHUT-OFF VALVE VTR VENT THROUGH ROOF FPT TERMINAL UNIT WITH REHEAT HEAD PRESSURE REDUCING VALVE HORSEPOWER WATT ELECTRICAL VAV TERMINAL UNIT **HVAC HEATING, VENTILATION & AIR** WITH  $\square$   $\square$   $\square$  (WITH ANNOTATOR OPTIONAL) SECTION WET BULB **RELIEF VALVE** WATER GAUGE SUPPLY DIFFUSER WATER PRESSURE DROP INSULATE/INSULATION INSUL W/O WITHOUT SOLENOID VALVE IWG INCHES WATER GAUGE RETURN GRILLE KILOWATT EXHAUST REGISTER VALVE IN RISER SHEET NUMBERING LEGEND LEAVING AIR TEMPERATURE Y STRAINER POUND LINEAR BAR GRILLE LBG Y STRAINER (WITH VALVE) - M111A - SECTOR "MD" DEMO "M" NEW WORK 2-WAY AUTOMATIC CONTROL VALVE —— FLOOR LEVEL PLAN TYPE "0" LOWEST FLOOR 3-WAY AUTOMATIC CONTROL VALVE "1" FLOOR PLAN "1" NEXT FLOOR "2" ENLARGED LEVEL ETC. FLOOR ETC. PRESSURE GAUGE WITH GAUGE COCK SYSTEM TYPE "1" FOR DUCT THERMOMETER "2" FOR PIPING MOISTURE SEPARATOR


THE SCHOOL DISTRICT OF PHILADELPHIA

OFFICE OF CAPITAL PROGRAMS

440 NORTH BROAD STREET
PHILADELPHIA, PA 19130 - 4015
(215) 400 - 4730 | (215) 400 - 4731 (fax)
www.philasd.org

SEAL:



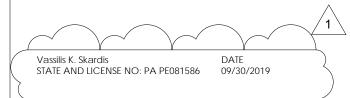

Architectural:
SCHRADERGROU

SCHRADERGROUP Architecture, LLC
Address: 161 Leverington Ave, Suite 105, Philadelphia PA 19127
Phone: 215.482.7440
Fax: 215.482.7441
Email: bgood@grarc.com
Attn: Brian Good




Phone: 301.216.2871

Email: anilg@theges.com

Fax: 301.216.9671

Attn: Anil Giri

BID DOCUMENTS APRIL 20, 2018

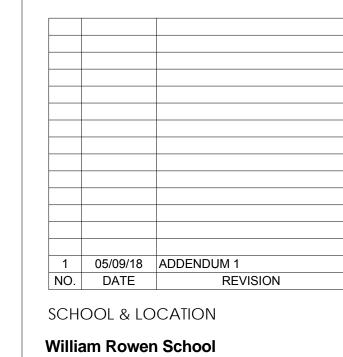

William Rowen School
6841 N 19th St, Philadelphia, PA 19126


PROJECT TITLE

Classroom Modifications to William Rowen School

DRAWING TITLE

MECHANICAL COVER SHEET

WING NO.

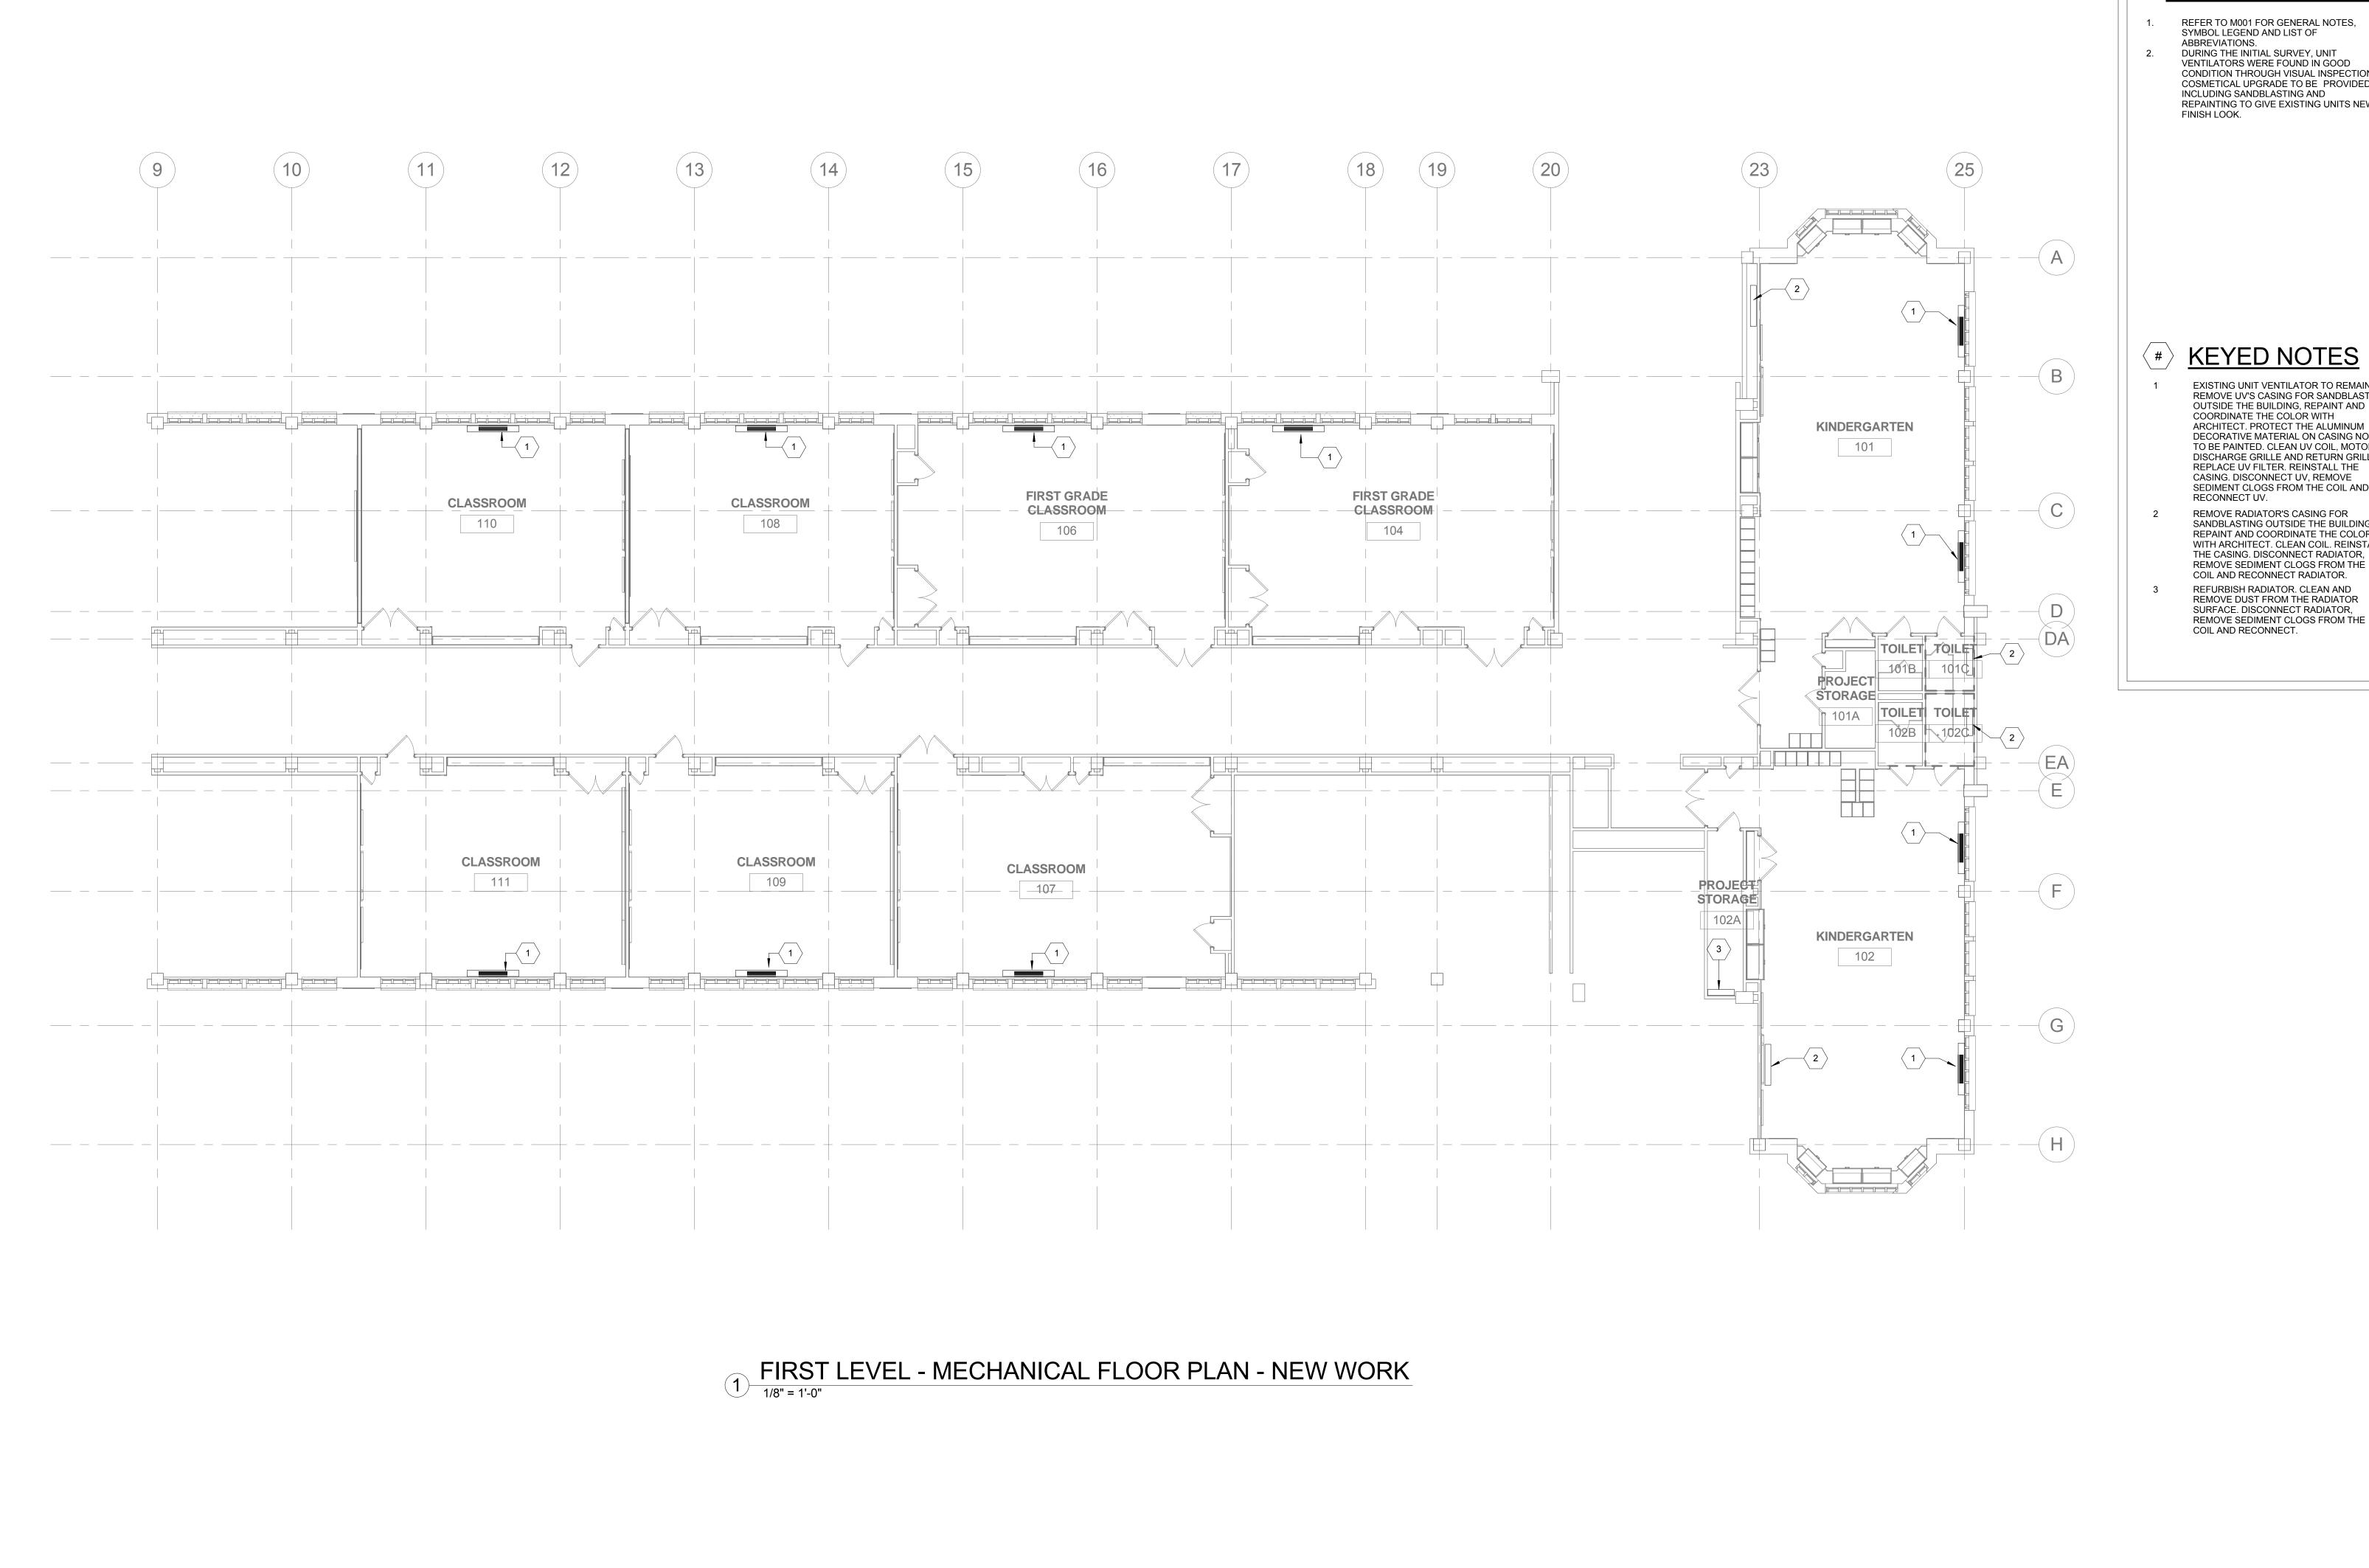

**GENERAL NOTES** 

REFER TO M001 FOR GENERAL NOTES, SYMBOL LEGEND AND LIST OF

ABBREVIATIONS.
DURING THE INITIAL SURVEY, UNIT VENTILATORS WERE FOUND IN GOOD CONDITION THROUGH VISUAL INSPECTION. COSMETICAL UPGRADE TO BE PROVIDED,

INCLUDING SANDBLASTING AND
REPAINTING TO GIVE EXISTING UNITS NEW

THE SCHOOL DISTRICT OF PHILADELPHIA

OFFICE OF CAPITAL PROGRAMS

440 NORTH BROAD STREET PHILADELPHIA, PA 19130 - 4015

(215) 400 - 4730 | (215) 400 - 4731 (fax)

www.philasd.org

**KEYED NOTES** 

EXISTING UNIT VENTILATOR TO REMAIN. REMOVE UV'S CASING FOR SANDBLASTING OUTSIDE THE BUILDING, REPAINT AND COORDINATE THE COLOR WITH ARCHITECT. PROTECT THE ALUMINUM DECORATIVE MATERIAL ON CASING NOT TO BE PAINTED. CLEAN UV COIL, MOTOR, DISCHARGE GRILLE AND RETURN GRILLE. REPLACE UV FILTER. REINSTALL THE CASING. DISCONNECT UV, REMOVE SEDIMENT CLOGS FROM THE COIL AND REMOVE RADIATOR'S CASING FOR SANDBLASTING OUTSIDE THE BUILDING, REPAINT AND COORDINATE THE COLOR

WITH ARCHITECT. CLEAN COIL. REINSTALL THE CASING. DISCONNECT RADIATOR, REMOVE SEDIMENT CLOGS FROM THE COIL AND RECONNECT RADIATOR. REFURBISH RADIATOR. CLEAN AND REMOVE DUST FROM THE RADIATOR SURFACE. DISCONNECT RADIATOR,

SEAL:


SCHRADERGROUP Architecture, LLC Address: 161 Leverington Ave, Suite 105, Philadelphia PA 19127 Phone: 215.482.7440

Vassilis K. Skardis DATE STATE AND LICENSE NO: PA PE081586 09/30/2019

Fax: 215.482.7441 Email: bgood@grarc.com Attn: Brian Good

Global Engineering Solutions® Address: 6700A Rockledge Drive, Suite 301 Bethesda Maryland 20817 Phone: 301.216.2871 Fax: 301.216.9671 Email: anilg@theges.com Attn: Anil Giri

**BID DOCUMENTS** APRIL 20, 2018

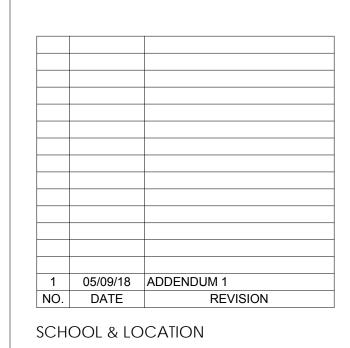

William Rowen School

6841 N 19th St, Philadelphia, PA 19126

PROJECT TITLE **Classroom Modifications to William Rowen School** 


DRAWING TITLE

FIRST LEVEL - MECHANICAL FLOOR PLAN - NEW WORK

LOCATION NO. FILE NO. DRAWN BY CHECKED BY B-066 C OF 2017/18

**KEY PLAN** 

SCALE: 1/8"=1'-0"

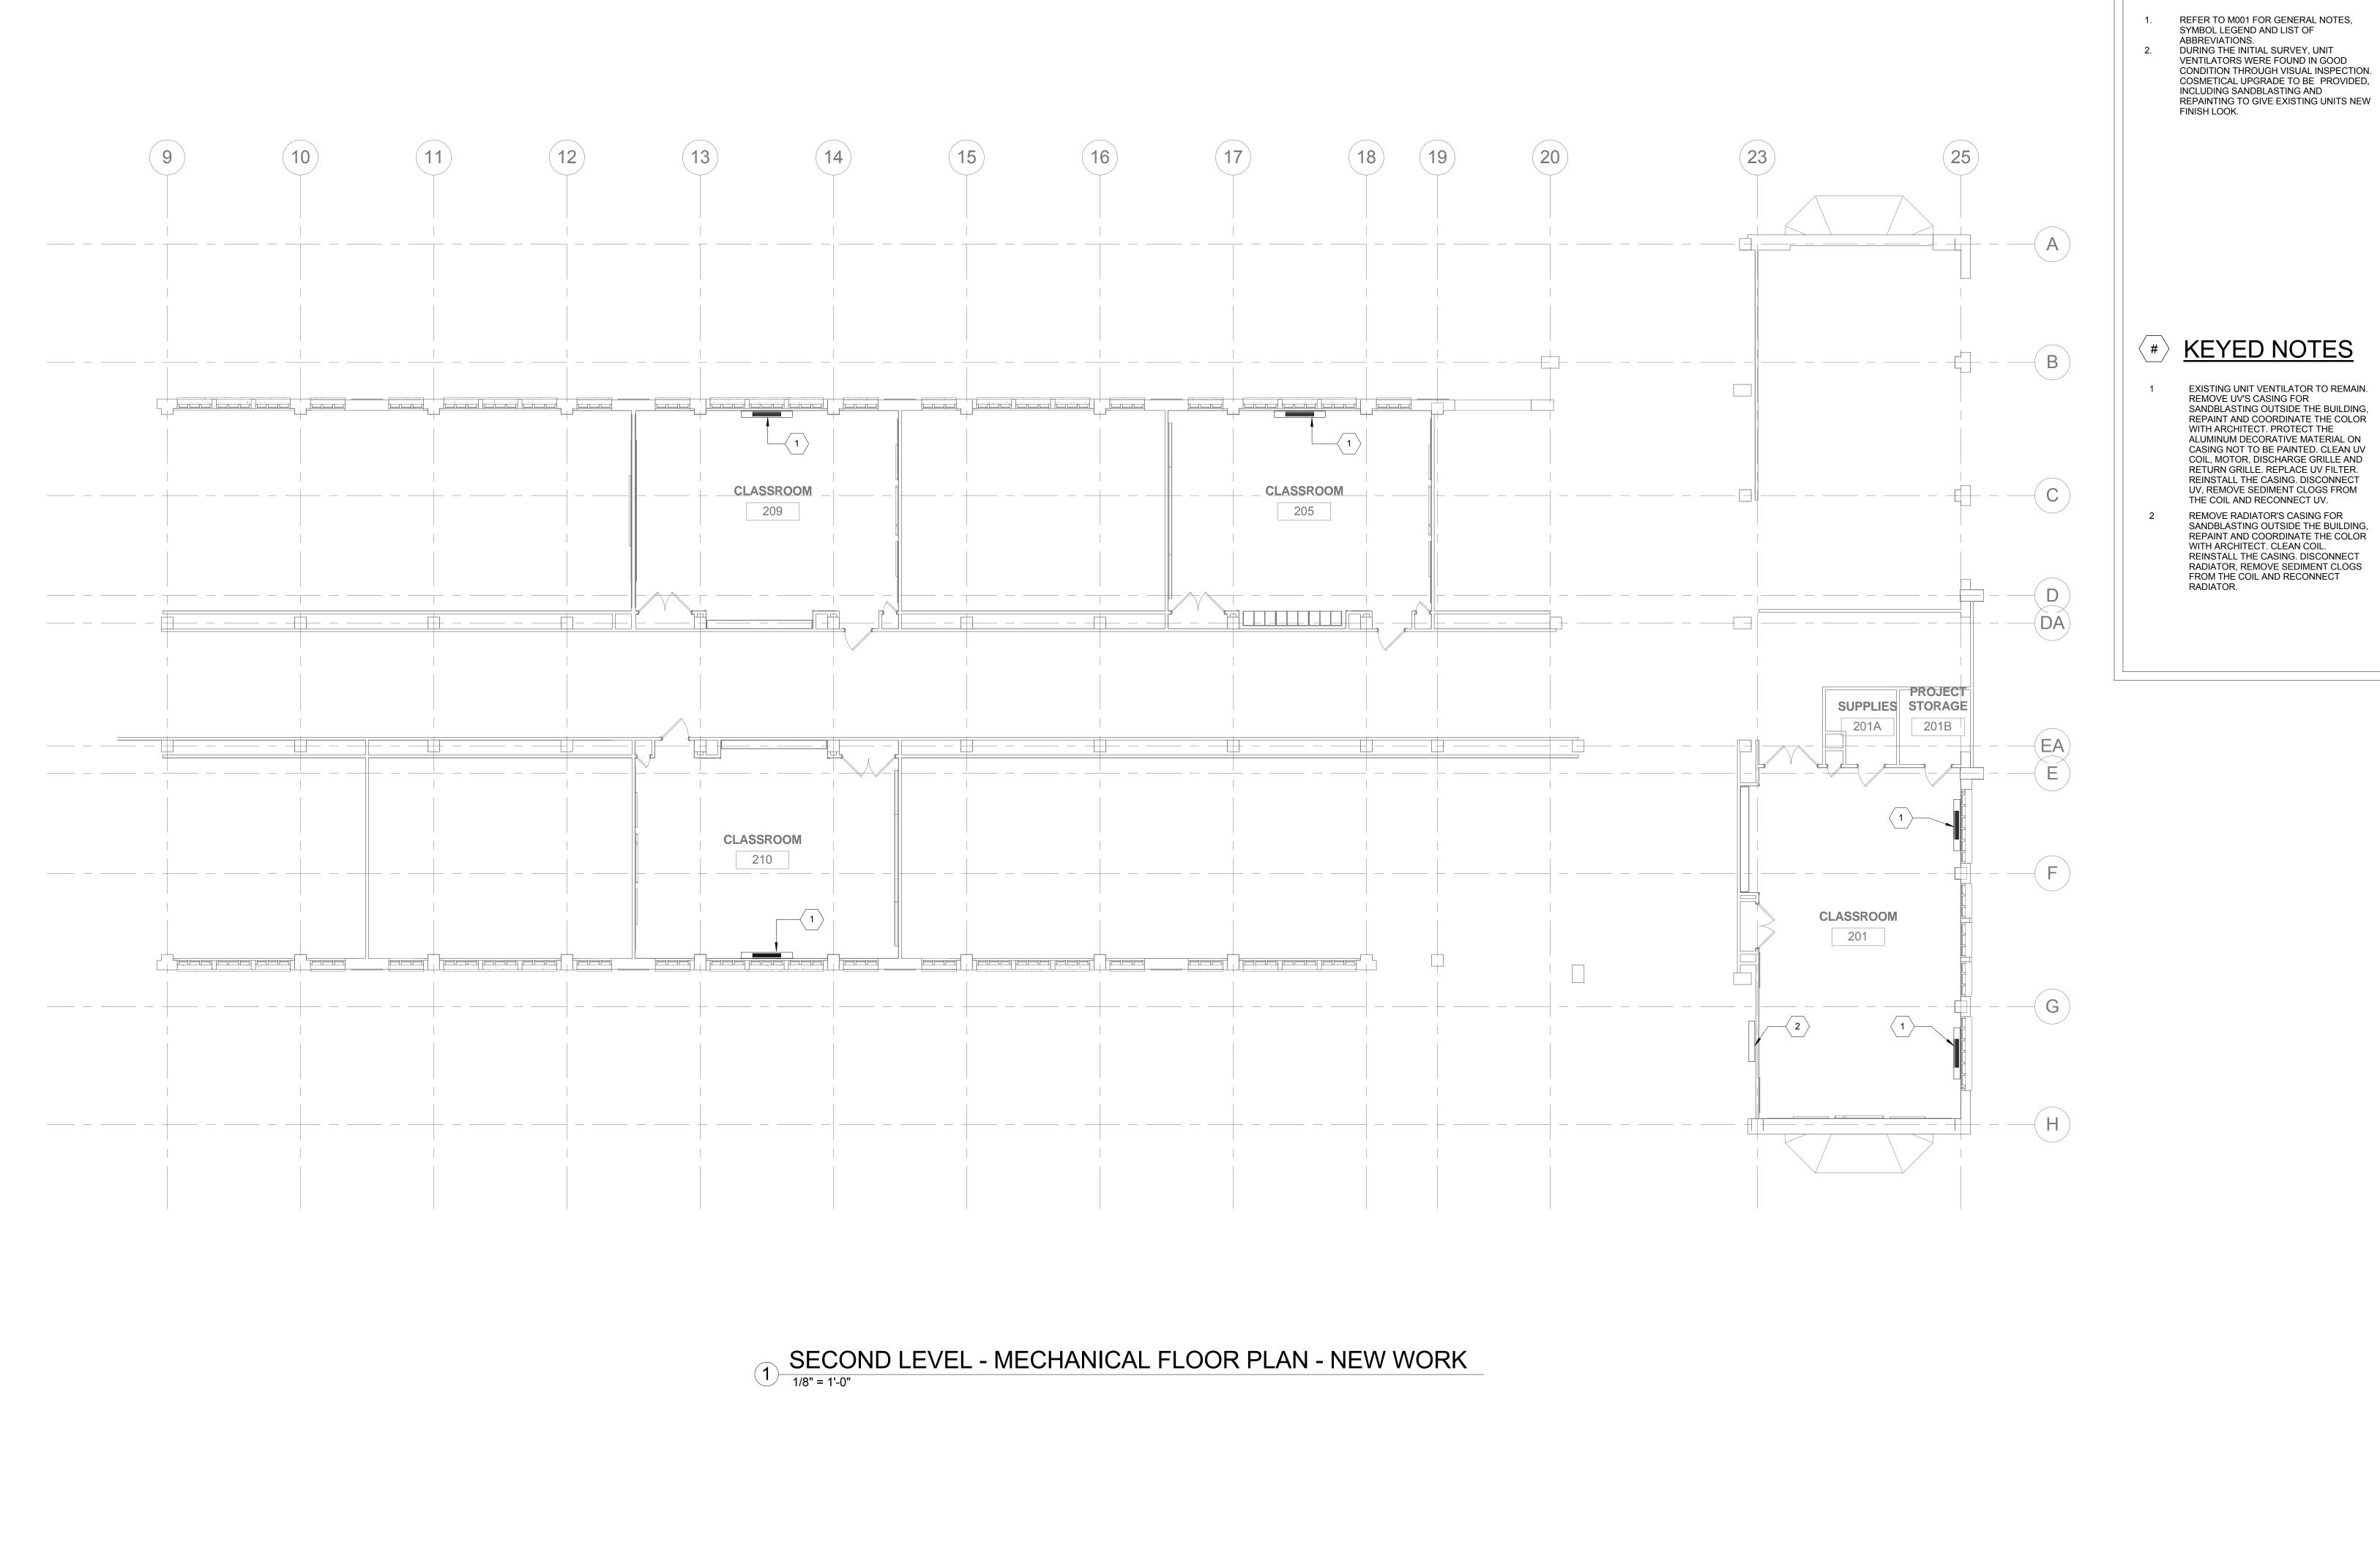

**GENERAL NOTES** 

THE SCHOOL DISTRICT OF PHILADELPHIA

OFFICE OF CAPITAL PROGRAMS

440 NORTH BROAD STREET PHILADELPHIA, PA 19130 - 4015 (215) 400 - 4730 | (215) 400 - 4731 (fax)

SEAL:



www.philasd.org

**#** KEYED NOTES


EXISTING UNIT VENTILATOR TO REMAIN. REMOVE UV'S CASING FOR SANDBLASTING OUTSIDE THE BUILDING, REPAINT AND COORDINATE THE COLOR WITH ARCHITECT. PROTECT THE ALUMINUM DECORATIVE MATERIAL ON CASING NOT TO BE PAINTED. CLEAN UV COIL, MOTOR, DISCHARGE GRILLE AND RETURN GRILLE. REPLACE UV FILTER. REINSTALL THE CASING. DISCONNECT UV, REMOVE SEDIMENT CLOGS FROM THE COIL AND RECONNECT UV. REMOVE RADIATOR'S CASING FOR SANDBLASTING OUTSIDE THE BUILDING,

SCHRADERGROUP Architecture, LLC Address: 161 Leverington Ave, Suite 105, Philadelphia PA 19127 Phone: 215.482.7440 Fax: 215.482.7441 Email: bgood@grarc.com Attn: Brian Good

Vassilis K. Skardis DATE STATE AND LICENSE NO: PA PE081586 09/30/2019

Global Engineering Solutions® Address: 6700A Rockledge Drive, Suite 301 Bethesda Maryland 20817 Phone: 301.216.2871 Fax: 301.216.9671 Email: anilg@theges.com Attn: Anil Giri

BID DOCUMENTS APRIL 20, 2018

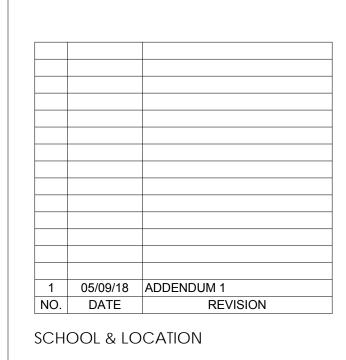

William Rowen School

6841 N 19th St, Philadelphia, PA 19126

PROJECT TITLE **Classroom Modifications to William Rowen School** 

DRAWING TITLE

SECOND LEVEL - MECHANICAL FLOOR PLAN - NEW WORK

LOCATION NO. 18-011	FILE NO.
DRAWN BY HS	CHECKED BY  AG
	OF 2017/18 OF 2017/18

**KEY PLAN**