THE SCHOOL DISTRICT OF PHILADELPHIA Office of Capital Programs 440 North Broad Street, 3rd Floor – Suite 371 Philadelphia, PA 19130

TELEPHONE: (215) 400-4730

Addendum No. 001

- Subject: 2020 Classroom Modernizations SDP Contract Numbers: B-019 C of 19/20 & B-021 C of 19/20
- Location: Ellwood School 6701 N. 13th St, Philadelphia PA 19126

This Addendum, dated February 28, 2020, shall modify and become part of the Contract Documents for the work of this project. Any items not mentioned herein, or affected by, shall be performed strictly in accordance with the original documents.

<u>GENERAL</u>

CLARIFICATION – Any/all scope dictated in the Asbestos Inspection Report specification and/or the Paint and Plaster specification (where applicable) shall utilize the proposed finishes as indicated on the Color Scheme Schedule within the Classroom Modernization drawings. All color selections and locations shall be approved by the architect.

SPECIFICATIONS

SPECIFICATION 262416 – PANELBOARDS

1. ADD specification in its entirety.

SPECIFICATION 275313 – WIRELESS CLOCK SYSTEM

1. REVISE 2.2.H. to read "H. Basis of Design: Sapling Inc. SMA 2000 **3000** Series Master Clock (V8.1), Wireless Clock System. [Addendum No. 1]."

SPECIFICATION 01 1135- Asbestos Abatement Technical Specifications

- 1. REMOVE Attachment A- Asbestos Location Drawings- and all references within
- REMOVE Attachment D- Lead Based Paint Stabilization Specification- All referrals shall direct to "Specification Part B- Technical Specifications and Scope of Work for Paint and Plaster Repairs.

Specification Part B- Technical Specifications and Scope of Work for Paint and Plaster Repairs

1. Remove and replace Scope of Work Detail (Lead Safe Certification Assessment Report)

COVER SHEETS

DRAWING CS.1 – COVER SHEET

1. REVISED cover to add Deed Address "1201-51 OAK LN, PHILADELPHIA, PA 19126-3225."

ARCHITECTURAL DRAWINGS

DRAWINGS D1.1 to D1.3 – DEMOLITION PLANS

- 1. ADD note adjacent to Storage Room 105B to read "METAL SHELVING TO BE REMOVED, STORED AND REINSTALLED IN PLACE FOR NEW WORK."
- 2. REVISE demolition note 1A to read "EXISTING WALLS SHALL BE SCRAPED; REMOVE ANY/ALL ABANDONED OR UNUSED BRACKETS, PROJECTORS AND MOUNTS, PROJECTOR SCREENS, TVS AND MOUNTS, BLOCKING AND ASSOCIATED ACCESSORIES IN THEIR ENTIRETY. PATCH ANY AND ALL PENETRATIONS AND CRACKING THROUGHOUT AND PREPARE WALLS, COLUMNS, REGISTERS, HEATERS, AND ASSOCIATED ACCESSORIES TO RECEIVE NEW FINISH MATCHING ADJACENT FINISHED SURFACE AS SCHEDULED."
- 3. REVISE demolition note 3A to read "EXISTING DOOR AND FRAME ASSEMBLY TO REMAIN. REMOVE ANY/ALL OBSOLETE EQUIPMENT, STAPLES AND ASSOCIATED ACCESSORIES AND FASTENERS IN THEIR ENTIRETY FROM DOOR AND FRAME ASSEMBLY. ANY/ALL PENETRATIONS IN EXISTING DOOR AND FRAME, INCLUDING OLD HARDWARE PENETRATIONS, SHALL BE PATCHED WITH SAME MATERIAL AS DOOR. SAND AND RETURN TO "LIKE NEW" CONDITION AND PREPARE FOR NEW FINISH AS SCHEDULED. ALL MISCELLANEOUS HARDWARE AND SECURITY GRILLES AND ASSOCIATED BRACKETING SHALL BE REMOVED IN ITS ENTIRETY (WHERE OCCURS). PREPARE DOOR AND/OR FRAME ASSEMBLIES TO RECEIVE NEW INFILL AS SCHEDULED (WHERE OCCURS). PREPARE DOOR FOR NEW HARDWARE AS SCHEDULED. CONTRACTOR SHALL VERIFY IN FIELD ALL DOOR, FRAME AND HARDWARE REQUIREMENTS. CONTRACTOR SHALL NOT REMOVE ANY COMPONENTS OF DOOR OR HARDWARE UNTIL ALL COMPONENTS OF NEW ASSEMBLY ARE PHYSICALLY ON SITE, INCLUDING CORES."
- 4. REVISE demolition note 5A to read "EXISTING HARD CEILING AND/OR METAL CEILINGS SHALL BE SCRAPED; REMOVE ANY/ALL ABANDONED OR UNUSED FASTENERS, BRACKETS, PROJECTORS AND MOUNTS AND ASSOCIATED ACCESSORIES IN THEIR ENTIRETY. PATCH ANY AND ALL PENETRATIONS AND CRACKING THROUGHOUT AND PREPARE CEILINGS, BEAMS, AND ASSOCIATED ACCESSORIES TO RECEIVE NEW FINISH MATCHING ADJACENT SURFACE AS SCHEDULED. WHERE CAPPING OF OLD OR ABANDONED SYSTEMS OCCURS, PROVIDE COVER PLATE AND PAINT TO MATCH EXISTING SURFACES. REFER TO ENGINEERING DRAWINGS FOR FURTHER INFORMATION WHERE OCCURS."
- 5. REVISE demolition note 7P to read "EXISTING UNIT VENTILATOR AND SHELVING SYSTEM AND/OR RADIATOR, RADIATOR COVER, AND ALL ASSOCIATED PIPING AND COMPONENTS TO BE REMOVED (AS APPLICABLE). SHELVING DOORS SHALL BE REMOVED IN THEIR ENTIRETY. REFINISH ASSEMBLY WITH ELECTROSTATIC PAINT AND REINSTALL AS SCHEDULED. CLEAN UNIT VENTILATOR AND/OR RADIATOR AND ALL ASSOCIATED COMPONENTS PRIOR TO REINSTALLATION OF COVER."
- 6. REVISE demolition note 8A to read "EXISTING WOOD TRIM THROUGHOUT ENTIRE ROOM INCLUDING, BUT NOT LIMITED TO BASE, DOOR, CROWN MOLDING, WINDOW TRIM AND INTERMITTENT WOOD MULLIONS, SHALL BE STRIPPED OF ANY NAILS, STAPLES, TAPE, AND ETC. SAND AND PATCH ANY PENETRATIONS AND PREPARE TO RECEIVE NEW FINISH AS SCHEDULED."

DRAWING A6.1 – ROOM FINISH SCHEDULE & DOOR SCHEDULE

- 1. REVISE Room Finish schedule as indicated:
 - a. REVISE column "COLOR SCHEME" at ROOMS 108, 211, 212 to correspond to Color Scheme "C".
 - b. REVISE column "COLOR SCHEME" at ROOMS 208, 210 to correspond to Color Scheme "D".
- 2. REVISE Color Scheme Schedule as indicated:
 - a. REVISE Color Scheme A to read as: "COLOR SCHEME A KINDERGARTEN".
 - b. REVISE item no. 6 to read as: "6. VINYL COMPOSITION TILE, ACCENT '2': ARMSTRONG, NO. 51947 BASIL GREEN"
 - c. ADD item no. 8 to read as: "8. VINYL BASE: JOHNSONITE, NO. 469 MYSTIFY".
 - d. REVISE Color Scheme B to read as: "COLOR SCHEME B FIRST GRADE AND SPECIAL EDUCATION".
 - e. REVISED item no. 3 to read as: "3. ACCENT PAINT 'B' TEACHING WALL: SHERWIN WILLIAMS, NO. SW6765 SPA"
 - f. REVISE item no. 5 to read as: "5. VINYL COMPOSITION TILE, ACCENT '1': ARMSTRONG, NO. 51927 FIELD GRAY"
 - g. REVISE item no. 6 to read as: "6. VINYL COMPOSITION TILE, ACCENT '2': ARMSTRONG, NO. 57509 LEMON LICK"
 - h. ADD item no. 8 to read as: "8. VINYL BASE: JOHNSONITE, NO. 469 MYSTIFY".
 - i. REVISE Color Scheme C to read as: "COLOR SCHEME C SECOND GRADE".
 - j. ADD Color Scheme Information for Color Scheme C.
 - k. REVISE Color Scheme D to read as: "COLOR SCHEME D THIRD GRADE".
 - I. ADD Color Scheme Information for Color Scheme D.
 - m. REVISE General Notes Item No. 7 to read as: "NOT USED".

ELECTRICAL DRAWINGS

DRAWING E0.1 – ELECTRICAL GENERAL NOTES, SYMBOLS & ABBREVIATIONS

1. REVISE room controller basis-of-design to read "GREENGATE – MODEL #RC3D-PL."

DRAWING ED1.1 - ELECTRICAL FIRST FLOOR DEMOLITION PLAN – UNIT A

1. CLARIFY general note in larger font to read "ELECTRICAL CONTRACTOR TO PROVIDE ALLOWANCE FOR REMOVAL OF 10'-0" OF SURFACE MOUNTED RACEWAY/CONDUIT AND CONDUCTORS IN EACH CLASSROOM."

DRAWING ED1.2 - ELECTRICAL FIRST FLOOR DEMOLITION PLAN – UNIT B

- ADD general note in larger font to read "ELECTRICAL CONTRACTOR TO PROVIDE ALLOWANCE FOR REMOVAL OF 10'-0" OF SURFACE MOUNTED RACEWAY/CONDUIT AND CONDUCTORS IN EACH CLASSROOM."
- 2. REVISE MDF/IT Room layout as indicated on the drawings.

DRAWING ED1.3 - ELECTRICAL SECOND FLOOR DEMOLITION PLAN – UNIT B

1. CLARIFY general note in larger font to read "ELECTRICAL CONTRACTOR TO PROVIDE ALLOWANCE FOR REMOVAL OF 10'-0" OF SURFACE MOUNTED RACEWAY/CONDUIT AND CONDUCTORS IN EACH CLASSROOM."

DRAWING E2.1 - ELECTRICAL FIRST FLOOR POWER AND TECHNOLOGY PLAN – UNIT A

1. ADD general sheet note #6 to read "ELECTRICAL CONTRACTOR TO RUN ALL NEW SURFACE MOUNTED CONDUITS AND RACEWAYS IN CORNERS OFF EACH

CLASSROOM TO AVOID CONFLICT WITH DISPLAY BOARDS AND OTHER CLASSROOM FURNISHINGS."

2. REVISE data outlet locations and scope as indicated on the drawings.

DRAWING E2.2 - ELECTRICAL FIRST FLOOR POWER AND TECHNOLOGY PLAN – UNIT B

- ADD general sheet note #6 to read "ELECTRICAL CONTRACTOR TO RUN ALL NEW SURFACE MOUNTED CONDUITS AND RACEWAYS IN CORNERS OFF EACH CLASSROOM TO AVOID CONFLICT WITH DISPLAY BOARDS AND OTHER CLASSROOM FURNISHINGS."
- 2. REVISE data outlet locations and scope as indicated on the drawings.
- 3. REVISE MDF/IT Room layout as indicated on the drawings.

DRAWING E2.3 -ELECTRICAL SECOND FLOOR POWER AND TECHNOLOGY PLAN–UNIT B

- 1. ADD general sheet note #6 to read "ELECTRICAL CONTRACTOR TO RUN ALL NEW SURFACE MOUNTED CONDUITS AND RACEWAYS IN CORNERS OFF EACH CLASSROOM TO AVOID CONFLICT WITH DISPLAY BOARDS AND OTHER CLASSROOM FURNISHINGS."
- 2. REVISE data outlet locations and scope as indicated on the drawings.

DRAWING E7.1 - ELECTRICAL DETAILS

1. REVISE 3/E7.1 Typical Classroom Lighting Controller diagram as indicated on the drawings.

BIDDER QUESTIONS SUBMITTED TO DATE & RESPONSES ARE AS FOLLOWS:

1. On the website, each school has an EC and GC bid. Who will be responsible for the HVAC and Plumbing work that is included?

Answer: See specification section 01 1000 Summary of Work, section 1.1, "Note: All work shown on the Plumbing or Mechanical Drawings or indicated as plumbing or mechanical work is the responsibility of the General Construction Contractor."

2. Specifications call for Sapling Master 2000 Clock. Sapling 3000 is normally the school district standard. Manufacturer comment "a 3000 can set up bell schedules where a 2000 cannot. Philly schools does not have intercom systems, so they have no way of ringing bells without the 3000." Should the specs be revised to install a 3000?

Answer: Specification 275313 has been revised in this addendum. Refer to specification addendum section, above.

3. The specifications do not contain a specification for the electrical panels. Can you provide?

Answer: Specification 262416 Panelboards has been added to the contract documents as part of this addendum.

4. The GC scope of work covers 19 classrooms and associated storage and toilet rooms. NOTE on page 3 of 5 says: "The General Construction Contractor is responsible for all Paint and Plaster Repairs IN ALL ROOMS OF THE BUILDING(S), in accordance with the attached Technical Specification and Scope of Work." Please confirm that "all rooms" refers to the 19 classrooms, storage and toilet rooms as defined in the scope of work.

Answer: ALL ROOMS OF THE BUILDING(S) are required to be <u>painted</u> in accordance with the Paint and Plaster Specification Requirements. The Lead Safe Certification document locates the specified scope for <u>stabilization</u>. This scope is NOT limited to the Classroom Modernization locations.

5. Drawing D1.1, Demolition Note 9A states "existing unit ventilator and/or radiator, radiator cover and all associated piping and components to be removed (as applicable) and refinished with electrostatic paint and reinstalled as scheduled. Clean unit ventilator and/or radiator and all associated components prior to reinstallation of cover." Is this the responsibility of the GC?

Answer: See question #1 above regarding HVAC and Plumbing responsibility. Drawing D1.1, Demolition Note 9A is amended to read:

"Existing unit ventilator cover and/or radiator cover to be removed (as applicable) and refinished with electrostatic paint and reinstalled as scheduled. Clean unit ventilator and/or radiator and all associated components prior to reinstallation of cover."

6. The contract drawings don't show any details regarding the scope of work. The notes on the drawings lead us to believe that the intent is to Paint the Ventilator Grilles and Radiator covers. Please clarify?

Answer: See Question #6, above. Also refer to Specification 105115 Electrostatic Painting for refinishing requirements for metal surfaces.

7. Drawings don't show S.S. Corner Guard locations. Please Clarify?

Answer: Per Specification 102600, Section 2.3.A.7, we have indicated corner guards to be received at three schools; John B. Kelly Elementary per drawings, Overbrook Educational Center per drawings, and Fox Chase Elementary per drawings.

8. Confirm that Unit Price No. 1 and Unit Price No. 2 work is only applicable to Pollock Part Part B Scope of Work. Provide breakdown by room, location, surface type (wall or ceiling) and size (in SF) for the respective patching and repairs.

Answer: Unit Pricing should be included as noted in the Bid Proposal form. This applies to all schools that include a "Part B- Scope of work and technical

specifications for paint and plaster repairs." See question 4 above, and see included revision to "Lead Safe Certification Assessment Report."

9. The part B Scope of Work Detail lists "Lead Safe Certification for Sayre High School." Provide the correct report and floor plans.

Answer: This document has been revised. There aren't floor plans for part B. Please see responses to questions 4 and 9 above.

10. Please provide Appendix A- Asbestos Location Drawings

Answer: For specification 01 1135 Asbestos Abatement Technical Specification, omit all references within this section referring to Appendix A- Asbestos Location Drawings. See section 1.2, Section E for the scope of work.

ATTACHMENTS

SPECIFICATIONS

SPECIFICATION 262416 PANELBOARDS Specification Part B- Technical Specifications and Scope of Work for Paint and Plaster Repairs

DRAWINGS

DRAWING A6.1	ROOM FINISH SCHEDULE & DOOR SCHEDULE
DRAWING ED1.2	ELECTRICAL FIRST FLOOR DEMOLITION PLAN – UNIT B
DRAWING E2.1	ELECTRICAL FIRST FLOOR POWER AND TECHNOLOGY PLAN–UNIT A
DRAWING E2.2	ELECTRICAL FIRST FLOOR POWER AND TECHNOLOGY PLAN–UNIT B
DRAWING E2.3	ELECTRICAL SECOND FLOOR POWER AND TECHNOLOGY PLAN –
	UNIT B
DRAWING E7.1	ELECTRICAL DETAILS

END OF ADDENDUM #001

SECTION 262416 - PANELBOARDS [Addendum No. 1]

PART 1 - GENERAL

- 1.1 RELATED DOCUMENTS
 - A. Drawings and general provisions of the Contract, including General and Supplementary Conditions and Division 01 Specification Sections, apply to this Section.
- 1.2 SUMMARY
 - A. Section Includes:
 - 1. Lighting and appliance branch-circuit panelboards.
- 1.3 DEFINITIONS
 - A. ATS: Acceptance testing specification.
 - B. GFCI: Ground-fault circuit interrupter.
 - C. GFEP: Ground-fault equipment protection.
 - D. MCCB: Molded-case circuit breaker.
 - E. VPR: Voltage protection rating.
- 1.4 ACTION SUBMITTALS
 - A. Product Data: For each type of panelboard.
 - 1. Include materials, switching and overcurrent protective devices, SPDs, accessories, and components indicated.
 - 2. Include dimensions and manufacturers' technical data on features, performance, electrical characteristics, ratings, and finishes.
 - B. Shop Drawings: For each panelboard and related equipment.
 - 1. Include dimensioned plans, elevations, sections, and details.
 - 2. Show tabulations of installed devices with nameplates, conductor termination sizes, equipment features, and ratings.
 - 3. Detail enclosure types including mounting and anchorage, environmental protection, knockouts, corner treatments, covers and doors, gaskets, hinges, and locks.
 - 4. Detail bus configuration, current, and voltage ratings.
 - 5. Short-circuit current rating of panelboards and overcurrent protective devices.
 - 6. Detail features, characteristics, ratings, and factory settings of individual overcurrent protective devices and auxiliary components.
 - 7. Include wiring diagrams for power, signal, and control wiring.

- 8. Key interlock scheme drawing and sequence of operations.
- 9. Include time-current coordination curves for each type and rating of overcurrent protective device included in panelboards. Submit on translucent log-log graft paper; include selectable ranges for each type of overcurrent protective device. Include an Internet link for electronic access to downloadable PDF of the coordination curves.
- C. Contractor shall submit a "specifications compliance statement" for each manufactured piece of equipment. Contractor/Supplier shall add "redlined" line-by-line notations to a PDF of the Specifications Section indicating the product or actions required "complies". Contractor/Supplier shall itemize all deviations from the specified requirement on a line-by-line basis. List of exceptions to product specification shall include proposed materials, methods and cost difference where substitutions are allowed. If product does not comply with the specification the Contractor/Supplier shall state what modifications and actions are being implemented to ensure the product shall comply per the substitution section of the contract documents.

1.5 STATEMENT OF COMPLIANCE

A. Contractor shall submit a "specifications compliance statement" for each manufactured piece of equipment. Contractor/Supplier shall add "redlined" notations to a PDF of the Specifications Section indicating the product or actions required "complies". If product does not comply the Contractor/Supplier shall state what modifications and actions are being implemented to ensure the product shall comply per the substitution section of the contract documents.

1.6 INFORMATIONAL SUBMITTALS

- A. Qualification Data: For testing agency.
- B. Panelboard Schedules: For installation in panelboards. Submit final versions after load balancing.

1.7 CLOSEOUT SUBMITTALS

- A. Operation and Maintenance Data: For panelboards and components to include in emergency, operation, and maintenance manuals. In addition to items specified in other section for "Operation and Maintenance Data," include the following:
 - 1. Manufacturer's written instructions for testing and adjusting overcurrent protective devices.
 - 2. Time-current curves, including selectable ranges for each type of overcurrent protective device that allows adjustments.

1.8 QUALITY ASSURANCE

A. Manufacturer Qualifications: ISO 9001 or 9002 certified.

- 1.9 DELIVERY, STORAGE, AND HANDLING
 - A. Remove loose packing and flammable materials from inside panelboards; install temporary electric heating (250 W per panelboard) to prevent condensation.
 - B. Handle and prepare panelboards for installation according to NECA 407.
- 1.10 FIELD CONDITIONS
 - A. Environmental Limitations:
 - 1. Do not deliver or install panelboards until spaces are enclosed and weathertight, wet work in spaces is complete and dry, work above panelboards is complete, and temporary HVAC system is operating and maintaining ambient temperature and humidity conditions at occupancy levels during the remainder of the construction period.
 - 2. Rate equipment for continuous operation under the following conditions unless otherwise indicated:
 - a. Ambient Temperature: Not exceeding 23 deg F (minus 5 deg C) to plus 104 deg F (plus 40 deg C).
 - b. Altitude: Not exceeding 6600 feet (2000 m).
 - B. Service Conditions: NEMA PB 1, usual service conditions, as follows:
 - 1. Ambient temperatures within limits specified.
 - 2. Altitude not exceeding 6600 feet (2000 m).
 - C. Interruption of Existing Electric Service: Do not interrupt electric service to facilities occupied by Owner or others unless permitted under the following conditions and then only after arranging to provide temporary electric service according to requirements indicated:
 - 1. Notify Construction Manager no fewer than two days in advance of proposed interruption of electric service.
 - 2. Do not proceed with interruption of electric service without Construction Manager's written permission.
 - 3. Comply with NFPA 70E.

1.11 WARRANTY

- A. Manufacturer's Warranty: Manufacturer agrees to repair or replace panelboards that fail in materials or workmanship within specified warranty period.
 - 1. Panelboard Warranty Period: 18 months from date of Substantial Completion.

PART 2 - PRODUCTS

- 2.1 PANELBOARDS COMMON REQUIREMENTS
 - A. Fabricate and test panelboards according to IEEE 344 to withstand seismic forces defined in other section for "Seismic Controls for Electrical Systems."

- B. Product Selection for Restricted Space: Drawings indicate maximum dimensions for panelboards including clearances between panelboards and adjacent surfaces and other items. Comply with indicated maximum dimensions.
- C. Electrical Components, Devices, and Accessories: Listed and labeled as defined in NFPA 70, by a qualified testing agency, and marked for intended location and application.
- D. Comply with NEMA PB 1.
- E. Comply with NFPA 70.
- F. Enclosures: Flush and Surface-mounted, dead-front cabinets.
 - 1. Rated for environmental conditions at installed location.
 - a. Indoor Dry and Clean Locations: NEMA 250, Type 1.
 - b. Indoor Locations Subject to Dust, Falling Dirt, and Dripping Noncorrosive Liquids: NEMA 250, Type 5.
 - 2. Height: 84 inches (2.13 m) maximum.
 - 3. Hinged Front Cover: Entire front trim hinged to box and with standard door within hinged trim cover. Trims shall cover all live parts and shall have no exposed hardware.
 - 4. Gutter Extension and Barrier: Same gage and finish as panelboard enclosure; integral with enclosure body. Arrange to isolate individual panel sections.
 - 5. Finishes:
 - a. Panels and Trim: Steel, factory finished immediately after cleaning and pretreating with manufacturer's standard two-coat, baked-on finish consisting of prime coat and thermosetting topcoat.
 - b. Back Boxes: Same finish as panels and trim.
- G. Incoming Mains:
 - 1. Location: Top and Bottom.
 - 2. Main Breaker: Main lug interiors up to 400 amperes shall be field convertible to main breaker.
- H. Phase, Neutral, and Ground Buses:
 - 1. Material: Hard-drawn copper, 98 percent conductivity.
 - a. Plating shall run entire length of bus.
 - b. Bus shall be fully rated the entire length.
 - 2. Interiors shall be factory assembled into a unit. Replacing switching and protective devices shall not disturb adjacent units or require removing the main bus connectors.
 - 3. Equipment Ground Bus: Adequate for feeder and branch-circuit equipment grounding conductors; bonded to box.
 - 4. Full-Sized Neutral: Equipped with full-capacity bonding strap for service entrance applications. Mount electrically isolated from enclosure. Do not mount neutral bus in gutter.
- I. Conductor Connectors: Suitable for use with conductor material and sizes.

- 1. Material: Hard-drawn copper, 98 percent conductivity.
- 2. Terminations shall allow use of 75 deg C rated conductors without derating.
- 3. Size: Lugs suitable for indicated conductor sizes, with additional gutter space, if required, for larger conductors.
- 4. Main and Neutral Lugs: Mechanical type, with a lug on the neutral bar for each pole in the panelboard.
- 5. Ground Lugs and Bus-Configured Terminators: Mechanical type, with a lug on the bar for each pole in the panelboard.
- 6. Feed-Through Lugs: Mechanical type, suitable for use with conductor material. Locate at opposite end of bus from incoming lugs or main device.
- 7. Subfeed (Double) Lugs: Mechanical type suitable for use with conductor material. Locate at same end of bus as incoming lugs or main device.
- 8. Gutter-Tap Lugs: Mechanical type suitable for use with conductor material and with matching insulating covers. Locate at same end of bus as incoming lugs or main device.
- J. Future Devices: Panelboards or load centers shall have mounting brackets, bus connections, filler plates, and necessary appurtenances required for future installation of devices.
 - 1. Percentage of Future Space Capacity: 20 percent.
- K. Panelboard Short-Circuit Current Rating: Match existing condition Ratings (Field coordinate).
- L. Panelboard Short-Circuit Current Rating: Fully rated to interrupt symmetrical short-circuit current available at terminals. Assembly listed by an NRTL for 100 percent interrupting capacity. However, if the short-circuit & coordination study requires higher AIC rating, then the contractor shall provide higher rated panels without any additional cost to the owners. It is highly recommended that short-circuit & coordination study be prepared prior to ordering the panels.
 - 1. Panelboards and overcurrent protective devices rated 240 V or less shall have shortcircuit ratings as shown on Drawings, but not less than 10,000 A rms symmetrical.
 - 2. Panelboards and overcurrent protective devices rated above 240 V and less than 600 V shall have short-circuit ratings as shown on Drawings, but not less than 14,000 A rms symmetrical.

2.2 PERFORMANCE REQUIREMENTS

- A. Seismic Performance: Panelboards shall withstand the effects of earthquake motions determined according to ASCE/SEI 7.
 - 1. The term "withstand" means "the unit will remain in place without separation of any parts from the device when subjected to the seismic forces specified."

2.3 LIGHTING AND APPLIANCE BRANCH-CIRCUIT PANELBOARDS

- A. <u>Manufacturers:</u> Subject to compliance with requirements, provide products by one of the following:
 - 1. <u>Eaton</u>.
 - 2. East coast Panelboard Inc.
 - 3. <u>Square D; by Schneider Electric</u>.

- B. Panelboards: NEMA PB 1, lighting and appliance branch-circuit type.
- C. Mains: Circuit breaker or lugs only.
- D. Branch Overcurrent Protective Devices: Bolt-on circuit breakers, replaceable without disturbing adjacent units.
- E. Doors: Door-in-door construction with concealed hinges; secured with multipoint latch with tumbler lock; keyed alike. Outer door shall permit full access to the panel interior. Inner door shall permit access to breaker operating handles and labeling, but current carrying terminals and bus shall remain concealed.

2.4 DISCONNECTING AND OVERCURRENT PROTECTIVE DEVICES

- A. <u>Manufacturers:</u> Subject to compliance with requirements, provide products by one of the following:
 - 1. <u>Eaton</u>.
 - 2. East coast Panelboard Inc.
 - 3. Square D; by Schneider Electric.
- B. MCCB: Comply with UL 489, with interrupting capacity to meet available fault currents.
 - 1. Thermal-Magnetic Circuit Breakers:
 - a. Inverse time-current element for low-level overloads.
 - b. Instantaneous magnetic trip element for short circuits.
 - c. Adjustable magnetic trip setting for circuit-breaker frame sizes 250 A and larger.
 - 2. GFCI Circuit Breakers: Single- and double-pole configurations with Class A ground-fault protection (6-mA trip).
 - 3. Subfeed Circuit Breakers: Vertically mounted.
 - 4. MCCB Features and Accessories:
 - a. Standard frame sizes, trip ratings, and number of poles.
 - b. Breaker handle indicates tripped status.
 - c. UL listed for reverse connection without restrictive line or load ratings.
 - d. Lugs: Mechanical style, suitable for number, size, trip ratings, and conductor materials.
 - e. Application Listing: Appropriate for application; Type SWD for switching fluorescent lighting loads.
 - f. Communication Capability: Circuit-breaker-mounted communication module with functions and features compatible with power monitoring and control system specified in other section for "Electrical Power Monitoring and Control."
 - g. Shunt Trip: 120-V trip coil energized from separate circuit, set to trip at 55 percent of rated voltage.
 - h. Undervoltage Trip: Set to operate at 35 to 75 percent of rated voltage without intentional time delay.
 - i. Auxiliary Contacts: One, SPDT switch with "a" and "b" contacts; "a" contacts mimic circuit-breaker contacts and "b" contacts operate in reverse of circuit-breaker contacts.
 - j. Alarm Switch: Single-pole, normally open contact that actuates only when circuit breaker trips.

- k. Multipole units enclosed in a single housing with a single handle or factory assembled to operate as a single unit.
- I. Handle Padlocking Device: Fixed attachment, for locking circuit-breaker handle in on or off position.
- m. Handle Clamp: Loose attachment, for holding circuit-breaker handle in on position.

2.5 IDENTIFICATION

- A. Panelboard Label: Manufacturer's name and trademark, voltage, amperage, number of phases, and number of poles shall be located on the interior of the panelboard door.
- B. Breaker Labels: Faceplate shall list current rating, UL and IEC certification standards, and AIC rating.
- C. Circuit Directory: Computer-generated circuit directory mounted inside panelboard door with transparent plastic protective cover.
 - 1. Circuit directory shall identify specific purpose with detail sufficient to distinguish it from all other circuits.

2.6 ACCESSORY COMPONENTS AND FEATURES

A. Accessory Set: Include tools and miscellaneous items required for overcurrent protective device test, inspection, maintenance, and operation.

PART 3 - EXECUTION

3.1 EXAMINATION

- A. Verify actual conditions with field measurements prior to ordering panelboards to verify that equipment fits in allocated space in, and comply with, minimum required clearances specified in NFPA 70.
- B. Receive, inspect, handle, and store panelboards according to NECA 407.
- C. Examine panelboards before installation. Reject panelboards that are damaged, rusted, or have been subjected to water saturation.
- D. Examine elements and surfaces to receive panelboards for compliance with installation tolerances and other conditions affecting performance of the Work.
- E. Proceed with installation only after unsatisfactory conditions have been corrected.

3.2 INSTALLATION

A. Coordinate layout and installation of panelboards and components with other construction that penetrates walls or is supported by them, including electrical and other types of equipment, raceways, piping, encumbrances to workspace clearance requirements, and adjacent

surfaces. Maintain required workspace clearances and required clearances for equipment access doors and panels.

- B. Comply with NECA 1.
- C. Install panelboards and accessories according to NECA 407.
- D. Equipment Mounting:
 - 1. Attach panelboard to the vertical finished or structural surface behind the panelboard.
 - 2. Comply with requirements for seismic control devices specified in other section for "Seismic Controls for Electrical Systems."
- E. Comply with mounting and anchoring requirements specified in other section for "Seismic Controls for Electrical Systems."
- F. Mount top of trim 90 inches (2286 mm) above finished floor unless otherwise indicated.
- G. Mount panelboard cabinet plumb and rigid without distortion of box.
- H. Mount recessed panelboards with fronts uniformly flush with wall finish and mating with back box.
- I. Mount surface-mounted panelboards to steel slotted supports 5/8 inch (16 mm) in depth. Orient steel slotted supports vertically.
- J. Install overcurrent protective devices and controllers not already factory installed.
 - 1. Set field-adjustable, circuit-breaker trip ranges.
 - 2. Tighten bolted connections and circuit breaker connections using calibrated torque wrench or torque screwdriver per manufacturer's written instructions.
- K. Install filler plates in unused spaces.
- L. Arrange conductors in gutters into groups and bundle and wrap with wire ties after completing load balancing.

3.3 IDENTIFICATION

- A. Identify field-installed conductors, interconnecting wiring, and components; install warning signs complying with requirements in other section for "Identification for Electrical Systems."
- B. Create a directory to indicate installed circuit loads after balancing panelboard loads; incorporate Owner's final room designations. Obtain approval before installing. Handwritten directories are not acceptable. Install directory inside panelboard door.
- C. Panelboard Nameplates: Label each panelboard with a nameplate complying with requirements for identification specified in other section for "Identification for Electrical Systems."
- D. Device Nameplates: Label each branch circuit device in power panelboards with a nameplate complying with requirements for identification specified in other section for "Identification for Electrical Systems."

E. Install warning signs complying with requirements in other section for "Identification for Electrical Systems" identifying source of remote circuit.

3.4 FIELD QUALITY CONTROL

- A. Manufacturer's Field Service: Engage a factory-authorized service representative to inspect, test, and adjust components, assemblies, and equipment installations, including connections.
- B. Perform tests and inspections.
 - 1. Manufacturer's Field Service: Engage a factory-authorized service representative to inspect components, assemblies, and equipment installations, including connections, and to assist in testing.
- C. Acceptance Testing Preparation:
 - 1. Test insulation resistance for each panelboard bus, component, connecting supply, feeder, and control circuit.
 - 2. Test continuity of each circuit.
- D. Tests and Inspections:
 - 1. Perform each visual and mechanical inspection and electrical test for low-voltage air circuit breakers stated in NETA ATS, Paragraph 7.6 Circuit Breakers. Perform optional tests. Certify compliance with test parameters.
 - 2. Correct malfunctioning units on-site, where possible, and retest to demonstrate compliance; otherwise, replace with new units and retest.
 - 3. Perform the following infrared scan tests and inspections and prepare reports:
 - a. Infrared Scanning: After Substantial Completion, but not more than 60 days after Final Acceptance, perform an infrared scan of each panelboard. Remove front panels so joints and connections are accessible to portable scanner.
 - b. Instruments and Equipment:
 - 1) Use an infrared scanning device designed to measure temperature or to detect significant deviations from normal values. Provide calibration record for device.
- E. Panelboards will be considered defective if they do not pass tests and inspections.
- F. Prepare test and inspection reports, including a certified report that identifies panelboards included and that describes scanning results, with comparisons of the two scans. Include notation of deficiencies detected, remedial action taken, and observations after remedial action.

3.5 ADJUSTING

- A. Adjust moving parts and operable components to function smoothly, and lubricate as recommended by manufacturer.
- B. Set field-adjustable circuit-breaker trip ranges as specified in other section for "Coordination Studies."

- C. Load Balancing: After Substantial Completion, but not more than 60 days after Final Acceptance, measure load balancing and make circuit changes. Prior to making circuit changes to achieve load balancing, inform Architect of effect on phase color coding.
 - 1. Measure loads during period of normal facility operations.
 - 2. Perform circuit changes to achieve load balancing outside normal facility operation schedule or at times directed by the Architect. Avoid disrupting services such as fax machines and on-line data processing, computing, transmitting, and receiving equipment.
 - 3. After changing circuits to achieve load balancing, recheck loads during normal facility operations. Record load readings before and after changing circuits to achieve load balancing.
 - 4. Tolerance: Maximum difference between phase loads, within a panelboard, shall not exceed 20 percent.

3.6 PROTECTION

A. Temporary Heating: Prior to energizing panelboards, apply temporary heat to maintain temperature according to manufacturer's written instructions.

END OF SECTION 262416

Lead Safe Certification for Ellwood Elementary School

		Name of Inspector: Charles Rhodes					Inspection Date	s: through											
ULCS#	Space #		Teacher Component	Material N/A	Color N/A	Primary Damage	ULCS# 7260 Component	(mg/cm2)	Component XRF	Component (see	Substrate Material N/A	Color N/A	Damage (see terms)	Component N/A	(mg/cm2) N/A	Quantity (sf)	Need to	Moisture ng	Comments/ Description/ Notes
7260 7260	111	Attic - None Auditorium	N/A N/A	N/A N/A	N/A N/A	N/A N/A	N/A N/A	N/A N/A	N/A N/A	N/A N/A	N/A N/A	N/A N/A	N/A N/A	N/A N/A	N/A N/A				
7260	111	Auditorium	N/A	N/A	N/A	N/A	N/A	N/A	N/A	N/A	N/A	N/A	N/A	N/A	N/A				
7260 7260	111	Auditorium	N/A N/A	N/A N/A	N/A N/A	N/A N/A	N/A N/A	N/A N/A	N/A N/A	N/A N/A	N/A N/A	N/A N/A	N/A N/A	N/A N/A	N/A N/A				
7260	111	Auditorium	N/A	N/A	N/A	N/A	N/A	N/A	N/A	N/A	N/A	N/A	N/A	N/A	N/A				
7260 7260	H2 H2	Auditorium Hallway Left Auditorium Hallway Left	N/A N/A	N/A N/A	N/A N/A	N/A N/A	N/A N/A	N/A N/A	N/A N/A	N/A N/A	N/A N/A	N/A N/A	N/A N/A	N/A N/A	N/A N/A				
7260	H2	Auditorium Hallway Left	N/A	N/A	N/A	N/A	N/A	N/A	N/A	N/A	N/A	N/A	N/A	N/A	N/A				
7260	H3	Auditorium Hallway Right	N/A	N/A	N/A	N/A	N/A	N/A	N/A	N/A	N/A	N/A	N/A	N/A	N/A				
7260 7260	H3 H3	Auditorium Hallway Right Auditorium Hallway Right	N/A N/A	N/A N/A	N/A N/A	N/A N/A	N/A N/A	N/A N/A	N/A N/A	N/A N/A	N/A N/A	N/A N/A	N/A N/A	N/A N/A	N/A N/A				
7260	001B	Boiler Room	W1							Door Frame	Metal	Blue	None		0	6SF			
7260 7260	001B 001B	Boiler Room Boiler Room	W1 W1							Columns Door Frame	Concrete Metal	Grey Grey	Chipping Chipping		0.2	15SF 6SF			
7260	001B	Boiler Room	W2	Concrete	Grey	Chipping		0											
7260 7260	001B 001B	Boiler Room Boiler Room	W3 W4	Concrete Concrete	Grey Grey	Chipping Chipping		-0.1		Columns	Concrete	Grey	Chipping		0.1	15SF			
7260	001B	Boiler Room	N/A	N/A	N/A	N/A	N/A	N/A	N/A	N/A	N/A	N/A	N/A	N/A	N/A				
7260		Boiler Room	N/A	N/A	N/A	N/A	N/A	N/A	N/A	N/A	N/A	N/A	N/A	N/A	N/A				
7260 7260	001B 004C	Boiler Room Boiler Room Restroom	N/A N/A	N/A N/A	N/A N/A	N/A N/A	N/A N/A	N/A N/A	N/A N/A	N/A N/A	N/A N/A	N/A N/A	N/A N/A	N/A N/A	N/A N/A				
7260	004C	Boiler Room Restroom	N/A	N/A	N/A	N/A	N/A	N/A	N/A	N/A	N/A	N/A	N/A	N/A	N/A				
7260 7260	004C 004C	Boiler Room Restroom Boiler Room Restroom	N/A N/A	N/A N/A	N/A N/A	N/A N/A	N/A N/A	N/A N/A	N/A N/A	N/A N/A	N/A N/A	N/A N/A	N/A N/A	N/A N/A	N/A N/A			<u> </u>	
7260	004C	Boiler Room Restroom	N/A	N/A	N/A	N/A	N/A	N/A	N/A	N/A	N/A	N/A	N/A	N/A	N/A				
7260	112B 112B	Boy's Restroom in Gymnasium Boy's Restroom in Gymnasium	N/A N/A	N/A N/A	N/A N/A	N/A N/A	N/A N/A	N/A N/A	N/A N/A	N/A N/A	N/A N/A	N/A N/A	N/A N/A	N/A N/A	N/A N/A				
7260	112B	Boy's Restroom in Gymnasium	N/A	N/A	N/A	N/A	N/A	N/A	N/A	N/A	N/A	N/A	N/A	N/A	N/A				
7260 7260	004B 004B	Building Engineer's Office Building Engineer's Office	N/A N/A	N/A N/A	N/A N/A	N/A N/A	N/A N/A	N/A N/A	N/A N/A	N/A N/A	N/A N/A	N/A N/A	N/A N/A	N/A N/A	N/A N/A				
7260	004B	Building Engineer's Office	N/A	N/A	N/A	N/A	N/A	N/A	N/A	N/A	N/A	N/A	N/A	N/A	N/A				
7260	004B	Building Engineer's Office	N/A N/A	N/A N/A	N/A N/A	N/A N/A	N/A N/A	N/A N/A	N/A N/A	N/A N/A	N/A N/A	N/A N/A	N/A N/A	N/A N/A	N/A N/A				
7260	110	Building Engineer's Office Classroom 100	W1	Sheetrock	Tan	None	N/A	0	N/A	Door Frame	Metal	Brown	None	N/A	0	6SF			
7260	110	Classroom 100	W2	Sheetrock	Tan	None		-0.1								25SF			
7260 7260	110	Classroom 100 Classroom 100	W3 W4	Sheetrock Sheetrock	Tan Tan	None None		-0.2								20SF 25SF			
7260	110	Classroom 100	Ceiling	Sheetrock	White	None		0.1								25SF			
7260 7260	110B 110A	Classroom 100 Boy's Restroom Classroom 100 Girl's Restroom	N/A N/A	N/A N/A	N/A N/A	N/A N/A	N/A N/A	N/A N/A	N/A N/A	N/A N/A	N/A N/A	N/A N/A	N/A N/A	N/A N/A	N/A N/A				
7260	109	Classroom 102	W1	Sheetrock	Tan	Chipping	N/A	-0.1	N/A	Door Frame	Metal	Brown	Chipping	N/A	0.1	6SF			
7260	109	Classroom 102	W2	Wood	Orange	None		-0.2		Room Divider Trim	Wood	Orange	None		0.1	12SF			
7260 7260	109 109	Classroom 102 Classroom 102	W3 W4	Sheetrock Sheetrock	Tan Tan	Chipping None		0.2								25SF 25SF			
7260 7260	109 109	Classroom 102	Ceiling	Sheetrock	White Tan	None		0.2		Door Frame	Metal	Brou	Chinaiaa		0	25SF 6SF			
7260	109	Classroom 103 Classroom 103	W1 W2	Sheetrock Sheetrock	Tan Tan	Chipping None		0.1	+	Door Frame	metal	Brown	Chipping		0	6SF 25SF		<u> </u>	
7260	109	Classroom 103	W3	Sheetrock	Tan	Chipping		-0.2								25SF			
7260 7260	109 109	Classroom 103 Classroom 103	W4 Ceiling	Wood Sheetrock	Orange White	None None		0.3		Room Divider Trim	Wood	Orange	None		0	12SF 25SF			
7260	104	Classroom 104	W1	Concrete	Tan	None		-0.2		Door Frame	Metal	Brown	Chipping		0.3	6SF			
7260		Classroom 104	W2	Concrete	Tan	None		-0.3								25SF			
7260 7260	104 104	Classroom 104 Classroom 104	W3 W4	Concrete Concrete	Tan Tan	None None		-0.3								20SF 20SF			
7260	104	Classroom 104	Ceiling	Concrete	White	None		0							. ·	30SF			
7260 7260	104	Classroom 104 Room 104-2	W1 W1	Concrete	Tan	None		-0.1	+	Door Frame Door Frame	Metal Metal	Brown Brown	Chipping Chipping		-0.1 0.2	6SF 6SF	<u> </u>		
7260	100	Classroom 105	W2	Concrete	Tan	None		-0.2								25SF			
7260 7260	100 100	Classroom 105 Classroom 105	W3 W4	Concrete Concrete	Tan Tan	None None		-0.3	+	Radiator	Metal	Tan	Chipping		0	10SF 25SF	-		
7260	100	Classroom 105 Classroom 105	Ceiling	Concrete	White	None		-0.1								25SF 25SF			
7260	100 105B	Classroom 105	N/A	N/A	N/A	N/A	N/A	N/A	N/A	N/A	N/A	N/A	N/A	N/A	N/A	2005			
7260 7260	105B 105B	Classroom 105 Coat Closet Classroom 105 Coat Closet	W2 W4	Concrete Concrete	Tan Tan	None None		-0.1	+							20SF 25SF			
7260	105B	Classroom 105 Coat Closet	N/A	N/A	N/A	N/A	N/A	N/A	N/A	N/A	N/A	N/A	N/A	N/A	N/A				
7260 7260		Classroom 105 Entryway Classroom 105 Entryway	W2 W4	Concrete	Tan Tan	None		-0.3	+	Radiator	Metal	Brown	None		0	10SF 25SF	<u> </u>		
7260		Classroom 105 Restroom	N/A	N/A	N/A	N/A	N/A	N/A	N/A	N/A	N/A	N/A	N/A	N/A	N/A				

															1 1	 1
7260 105C Classroom 105 Restroom 7260 105C Classroom 105 Restroom	N/A N/A	N/A	N/A N/A	N/A N/A	N/A N/A	N/A N/A	N/A N/A	N/A N/A	N/A N/A	N/A N/A	N/A N/A	N/A N/A	N/A N/A			
		N/A			N/A		N/A	N/A	N/A	N/A	N/A	N/A	N/A	25SF		
	W2 W4	Concrete	Tan	None		0.3										
7260 105A Classroom 105 Storage Room		Concrete N/A	Tan	None	NI / A	-0.1	NI/A	NI/A	NI / A	N1/A	N/A	N/A	NI / A	25SF		
7260 105A Classroom 105 Storage Room 7260 102 Classroom 107	N/A W1	Concrete	N/A Tan	N/A None	N/A	N/A -0.3	N/A	N/A Door Frame	N/A Metal	N/A Brown	N/A Chipping	IN/A	N/A 0.2	6SF		
	W1 W2		Tan			-0.3		Door Frame	metal	DIOWII	Chipping		0.2	25SF		
	W2 W3	Concrete Concrete	Tan	None None		0.2		Columns	Concrete	Brown	None		0.2			
7260 102 Classroom 107 7260 102 Classroom 107	W3 W4	Concrete	Tan	None		0.2		Columns	Concrete	DIOWII	None		0.2	15SF 25SF		
7260 102 Classroom 107 7260 102 Classroom 107	Ceiling	Concrete	White	None		0.2								255F		
7260 102 Classroom 107	N/A	N/A	N/A	N/A	N/A	N/A	N/A	N/A	N/A	N/A	N/A	N/A	N/A	2551		
7260 102 Classroom 107 7260 102 Classroom 107	N/A N/A	N/A N/A	N/A N/A	N/A N/A	N/A N/A	N/A N/A	N/A N/A	N/A N/A	N/A	N/A N/A	N/A N/A	N/A N/A	N/A			
7260 102 Classroom 108	W1	Concrete	Tan		N/A	0	IN/A	Door Frame	Metal	Brown		IN/A	0.3	6SF		
7260 104 Classroom 108	W1 W2	Concrete	Tan	Chipping Chipping		-0.3		Door France	Hetai	DIOWII	Chipping		0.5	25SF		
7260 104 Classroom 108	W2 W3	CONCIERE	Tan	Chipping		-0.5		Columns	Concrete	Tan	Chipping		-0.3	15SF		
7260 104 Classroom 108	W3 W4	Concrete	Tan	Chipping		-0.3		Columns	Concrete	Tan	Chipping		-0.5	25SF		
7260 104 Classroom 108	Ceiling	Concrete	White	None		0.5								255F		
7260 104 Classroom 108	N/A	N/A	N/A	N/A	N/A	N/A	N/A	N/A	N/A	N/A	N/A	N/A	N/A	2331		
7260 104 Classroom 108	N/A N/A	N/A	N/A N/A	N/A N/A	N/A N/A	N/A	N/A N/A	N/A N/A	N/A N/A	N/A	N/A N/A	N/A N/A	N/A			
7260 106 Classroom 109	W1				N/A	-0.2	IN/A		Metal	Brown		IN/A	0.2	6SF		
7260 106 Classroom 109	W1 W2	Concrete Concrete	Tan Tan	Chipping		-0.2		Door Frame	rietai	DIOWII	Chipping		0.2	25SF		
7260 106 Classroom 109 7260 106 Classroom 109	W2 W3	Concrete	Tan	Chipping		-0.2		Columns	Concrete	Tan	Chipping		0.3	15SF		
7260 106 Classroom 109	W3 W4	Concrete	Tan	Chinning		-0.3		Columns	Concrete	Tan	Chipping		0.5	25SF		
7260 106 Classroom 109 7260 106 Classroom 109	Ceiling	Concrete Concrete	White	Chipping None	1	-0.5								25SF		
7260 106 Classroom 109 7260 106 Classroom 109	N/A	N/A	N/A	N/A	N/A	N/A	N/A	N/A	N/A	N/A	N/A	N/A	N/A	2331		
7260 106 Classroom 109 7260 106 Classroom 109	N/A N/A	N/A N/A	N/A N/A	N/A N/A	N/A N/A	N/A N/A	N/A N/A	N/A N/A	N/A N/A	N/A N/A	N/A N/A	N/A N/A	N/A			
7260 108 Classroom 109 7260 108 Classroom 110	W1	Concrete	Tan	None	17/74	-0.2	11/14	Door Frame	Metal	Brown	Chipping	11/M	0.1	6SF		
7260 108 Classroom 110	W1 W2	Concrete	Tan	None	1	-0.2		Doorrand	neur	DIOWII	Chipping		0.1	25SF		
7260 108 Classroom 110	W2 W3	Controlo	1011	None	1	0.5		Columns	Concrete	Tan	Chipping		0.1	15SF		
7260 108 Classroom 110	W3 W4	Concrete	Tan	None	1	0		Quiunna	Concrete	- Turi	Chipping		0.1	25SF		
7260 108 Classroom 110	Ceiling	Concrete	White	None	1	0.3								25SF		
7260 108 Classroom 110 Coat Closet	Ceiling	Sheetrock	White	Flaking	1	0.1		Pipe	Metal	Tan	Flaking		0.2	9SF		
7260 108 Classroom 110 Coat Closet	N/A	N/A	N/A	N/A	N/A	N/A	N/A	N/A	N/A	N/A	N/A	N/A	N/A	201		
7260 105 Classroom 111	W1	Concrete	Tan	None	11/5	-0.3	11/5	Door Frame	Metal	Tan	Chipping	19/5	0.2	6SF		
7260 105 Classroom 111	W1 W2	Concrete	Tan	None	1	-0.1		Door Frame			Chipping		0.2	25SF		
7260 105 Classroom 111	W2 W3	Concrete	Tan	None	1	-0.1								255F		
7260 105 Classroom 111	W3 W4	Concrete	Tan	None		-0.1								25SF		
7260 105 Classroom 111	Ceiling	Concrete	White	None		0.2								255F		
7260 105 Classroom 111	N/A	N/A	N/A	N/A	N/A	N/A	N/A	N/A	N/A	N/A	N/A	N/A	N/A	2551		
7260 105 Classroom 111	N/A	N/A	N/A	N/A	N/A	N/A	N/A	N/A	N/A	N/A	N/A	N/A	N/A			
7260 217 Classroom 200A	N/A	N/A	N/A	N/A	N/A	N/A	N/A	N/A	N/A	N/A	N/A	N/A	N/A			
	19/75		19/75	19/75												
	NI/A	NI/A	NI/A	NI/A			NI/A				NI/A	NI/A				
7260 217 Classroom 200A	N/A N/A	N/A	N/A	N/A N/A	N/A	N/A	N/A	N/A	N/A	N/A	N/A N/A	N/A N/A	N/A			
7260 217 Classroom 200A 7260 217 Classroom 200A	N/A	N/A N/A	N/A N/A	N/A N/A			N/A N/A	N/A N/A	N/A N/A	N/A N/A	N/A	N/A N/A	N/A N/A	6SE		
7260 217 Classroom 200A 7260 217 Classroom 200A 7260 201 Classroom 201	N/A W1	N/A	N/A	N/A	N/A N/A	N/A N/A	N/A	N/A N/A Door Frame	N/A N/A Metal	N/A N/A Brown	N/A Chipping	N/A	N/A N/A 0.3	6SF		
7260 217 Classroom 200A 7260 217 Classroom 200A 7260 201 Classroom 201 7260 201 Classroom 201	N/A W1 N/A	N/A N/A	N/A N/A	N/A N/A	N/A N/A N/A	N/A N/A N/A	N/A N/A	N/A N/A Door Frame N/A	N/A N/A Metal N/A	N/A N/A Brown N/A	N/A Chipping N/A	N/A N/A	N/A N/A 0.3 N/A	6SF		
7260 217 Classroom 200A 7260 217 Classroom 200A 7260 201 Classroom 201 7260 201 Classroom 201 7260 201 Classroom 201 7260 201 Classroom 201	N/A W1 N/A N/A	Door Frame N/A N/A	N/A N/A Metal N/A N/A	N/A N/A Brown N/A N/A	N/A Chipping N/A N/A	N/A N/A N/A	N/A N/A 0.3 N/A N/A	6SF		
7260 217 Classroom 200A 7260 217 Classroom 200A 7260 201 Classroom 201	N/A W1 N/A N/A Door Frame N/A N/A N/A	N/A N/A Metal N/A N/A N/A	N/A N/A Brown N/A N/A N/A	N/A Chipping N/A N/A N/A	N/A N/A N/A N/A	N/A N/A 0.3 N/A N/A N/A	6SF		
7260 217 Classroom 200A 7260 217 Classroom 200A 7280 201 Classroom 201 7260 201 Classroom 201	N/A W1 N/A N/A Door Frame N/A N/A N/A N/A	N/A N/A Metal N/A N/A N/A N/A	N/A N/A Brown N/A N/A N/A N/A	N/A Chipping N/A N/A N/A N/A	N/A N/A N/A	N/A N/A 0.3 N/A N/A N/A N/A			
7260 217 Classroom 200A 7260 217 Classroom 200A 7260 201 Classroom 201	N/A W1 N/A N/A Door Frame N/A N/A N/A N/A Columns	N/A N/A Metal N/A N/A N/A	N/A N/A Brown N/A N/A N/A N/A Tan	N/A Chipping N/A N/A N/A N/A N/A Chipping	N/A N/A N/A N/A	N/A N/A 0.3 N/A N/A N/A N/A 0	65F		
7260 217 Classroom 200A 7260 217 Classroom 200A 7260 201 Classroom 201 7260 200 Classroom 202 7260 200 Classroom 202	N/A W1 N/A N/A N/A W1 W1	N/A N/A Door Frame N/A N/A N/A Columns Door Frame	N/A N/A N/A N/A N/A N/A Concrete Metal	N/A N/A Brown N/A N/A N/A Tan Brown	NA Chipping NA NA NA NA Chipping Chipping	N/A N/A N/A N/A	N/A N/A 0.3 N/A N/A N/A N/A 0 0.2	15SF 6SF		
7260 217 Classroom 200A 7260 217 Classroom 200A 7260 201 Classroom 201	N/A W1 N/A N/A N/A W/A W1	N/A N/A Door Frame N/A N/A N/A N/A Columns	N/A N/A Metal N/A N/A N/A N/A Concrete	N/A N/A Brown N/A N/A N/A N/A Tan	N/A Chipping N/A N/A N/A N/A Chipping Chipping Chipping	N/A N/A N/A N/A	N/A N/A 0.3 N/A N/A N/A N/A 0 0.2 0	15SF 6SF 15SF		
7260 217 Classroom 200A 7260 217 Classroom 200A 7260 201 Classroom 201 7260 200 Classroom 202	N/A W1 N/A N/A N/A W1 W1 W1 W1 W3	N/A N/A NA Door Frame N/A N/A N/A Columns Columns Radiator	N/A NIA Metal NIA N/A N/A Concrete Metal Concrete Metal	N/A N/A Brown N/A N/A N/A N/A Tan Brown Tan Brown	NA Chipping N/A N/A N/A Chipping Chipping Chipping Chipping	N/A N/A N/A N/A N/A	N/A N/A 0.3 N/A N/A N/A N/A 0 0.2 0 0 -0.1	15SF 6SF		
7260 217 Classroom 200A 7260 201 Classroom 200A 7260 201 Classroom 201 7260 200 Classroom 202	N/A W1 N/A N/A N/A W1 W2 W1 W3	N/A N/A Door Frame N/A N/A N/A Columns Door Frame Columns Radiator N/A	N/A N/A N/A N/A N/A N/A Concrete Metal Concrete	N/A N/A Brown N/A N/A N/A Tan Brown Tan Brown N/A	NA Chipping NA NA NA Chipping Chipping Chipping Chipping N/A	N/A N/A N/A N/A	N/A N/A 0.3 N/A N/A N/A N/A 0 0.2 0	15SF 6SF 15SF		
7260 217 Classroom 200A 7260 217 Classroom 200A 7260 201 Classroom 201 7260 201 Classroom 202 7260 200 Classroom 202 7260 203 Classroom 203	N/A W1 N/A N/A N/A W1 W3 W3 N/A W1	N/A N/A Door Frame N/A N/A N/A Columns Columns Radiator N/A Door Frame	N/A N/A Metal N/A N/A Concrete Metal Concrete Metal N/A Metal	N/A N/A Brown N/A N/A N/A Tan Brown Tan Brown N/A Brown	NA Chipping N/A N/A N/A Chipping Chipping Chipping Chipping N/A Chipping	N/A N/A N/A N/A N/A	N/A N/A 0.3 N/A N/A N/A 0.2 0 -0.1 N/A 0	15SF 6SF 15SF 9SF 6SF		
7260 217 Classroom 200A 7260 201 Classroom 200A 7260 201 Classroom 201 7260 200 Classroom 202	N/A W1 N/A N/A N/A W1 W1 W3 W3 N/A	N/A Door Frame N/A N/A N/A Columns Door Frame Columns Radiator N/A	N/A N/A Metal N/A N/A N/A Concrete Metal Concrete Metal N/A	N/A N/A Brown N/A N/A N/A Tan Brown Tan Brown N/A	NA Chipping NA NA NA Chipping Chipping Chipping Chipping N/A Chipping	N/A N/A N/A N/A N/A	N/A N/A 0.3 N/A N/A N/A 0 0.2 0 0.2 0 0.1 N/A	15SF 6SF 15SF 9SF		
7260 217 Classroom 200A 7260 217 Classroom 200A 7260 201 Classroom 201 7260 200 Classroom 202 7260 203 Classroom 203	N/A W1 N/A N/A N/A N/A W3 W3 W1 W3 W3	N/A N/A NA NA NA NA NA NA NA NA	N/A N/A N/A N/A N/A	NIA NIA Door Frame NIA NIA NIA Columns Columns Radiator N/A Door Frame Columns Radiator Radiator	NIA NIA Metal NIA NIA NIA NIA Concrete Metal Concrete Metal Concrete Metal Concrete Metal	N/A N/A Brown N/A N/A N/A N/A Brown Tan Brown N/A Brown Tan Brown Tan	NA Chipping N/A N/A N/A N/A Chipping Chipping Chipping Chipping Chipping Chipping Chipping Chipping	N/A N/A N/A N/A N/A	NA N/A 0.3 N/A N/A N/A 0 0.2 0 -0.1 N/A 0 0.1 0 0	155F 6SF 155F 9SF 6SF 155F		
7260 217 Classroom 200A 7260 217 Classroom 200A 7260 201 Classroom 201 7260 200 Classroom 202 7260 203 Classroom 203 7260 203 Classroom 203	N/A W1 N/A N/A N/A W1 W3 N/A W1	N/A N/A Door Frame N/A N/A N/A N/A Columns Columns Radiator N/A Door Frame Columns	N/A N/A Metal N/A N/A N/A Concrete Metal Concrete Metal N/A Metal Concrete	N/A N/A Brown N/A N/A N/A N/A Tan Brown Tan Brown N/A Brown Tan	NA Chipping NA NA NA Chipping Chipping Chipping Chipping N/A Chipping	N/A N/A N/A N/A N/A	N/A N/A 0.3 N/A N/A N/A 0 0.2 0 -0.1 N/A 0 0.1	155F 6SF 155F 9SF 6SF 155F		
7260 217 Classroom 200A 7260 217 Classroom 200A 7260 201 Classroom 201 7260 201 Classroom 202 7260 200 Classroom 203 7260 203 Classroom 203 </td <td>N/A W1 N/A N/A N/A W4 W1 W1 W3 W4 W1 W3 W4 W3 W4</td> <td>N/A N/A N/A N/A N/A N/A</td> <td>N/A N/A N/A N/A N/A</td> <td>N/A N/A N/A N/A N/A</td> <td>N/A N/A N/A N/A N/A N/A N/A</td> <td>N/A N/A N/A N/A N/A N/A</td> <td>N/A N/A N/A N/A N/A</td> <td>NA NA Door Frame NA NA NA Columns Columns Radiator N/A Door Frame Columns Radiator N/A N/A</td> <td>N/A N/A Metal N/A N/A N/A Concrete Metal Concrete Metal Concrete Metal Concrete Metal N/A</td> <td>N/A N/A Brown N/A N/A N/A Tan Brown Tan Brown N/A Brown Tan Brown M/A</td> <td>NA Chipping N/A N/A N/A Chipping Chipping Chipping Chipping N/A Chipping Chipping N/A Chipping Chipping Chipping Chipping Chipping</td> <td>N/A N/A N/A N/A N/A</td> <td>N/A N/A 0.3 N/A N/A N/A N/A 0 0.2 0 -0.1 N/A 0 -0.1 N/A 0 0.1 0 0.1 0 0.1 0 0.1 0</td> <td>155F 6SF 155F 9SF 6SF 155F</td> <td></td> <td></td>	N/A W1 N/A N/A N/A W4 W1 W1 W3 W4 W1 W3 W4 W3 W4	N/A N/A NA NA Door Frame NA NA NA Columns Columns Radiator N/A Door Frame Columns Radiator N/A N/A	N/A N/A Metal N/A N/A N/A Concrete Metal Concrete Metal Concrete Metal Concrete Metal N/A	N/A N/A Brown N/A N/A N/A Tan Brown Tan Brown N/A Brown Tan Brown M/A	NA Chipping N/A N/A N/A Chipping Chipping Chipping Chipping N/A Chipping Chipping N/A Chipping Chipping Chipping Chipping Chipping	N/A N/A N/A N/A N/A	N/A N/A 0.3 N/A N/A N/A N/A 0 0.2 0 -0.1 N/A 0 -0.1 N/A 0 0.1 0 0.1 0 0.1 0 0.1 0	155F 6SF 155F 9SF 6SF 155F		
7260 217 Classroom 200A 7260 217 Classroom 200A 7260 201 Classroom 201 7260 200 Classroom 202 7260 200 Classroom 203 7260 203 Classroom 203 </td <td>N/A W1 N/A N/A N/A W1 W3 N/A W1 W3 N/A W1 W3 N/A N/A N/A N/A N/A N/A</td> <td>N/A N/A N/A N/A N/A N/A</td> <td>N/A N/A N/A N/A N/A</td> <td>N/A N/A N/A N/A N/A</td> <td>N/A N/A N/A N/A N/A N/A N/A</td> <td>N/A N/A N/A N/A N/A N/A</td> <td>N/A N/A N/A N/A N/A</td> <td>NA NA Door Frame NA NA NA NA Columns Columns Radiator NA Door Frame Columns Radiator NA NA</td> <td>NIA NIA Metal NIA NIA NIA Concrete Metal Concrete Metal Concrete Metal N/A Metal N/A N/A</td> <td>N/A N/A Brown N/A N/A N/A N/A Tan Brown Tan Brown Tan Brown Tan Brown N/A N/A</td> <td>NA Chipping NA NA NA NA Chipping Chipping Chipping Chipping Chipping N/A Chipping N/A Chipping Chipping Chipping Chipping Chipping Chipping Chipping</td> <td>N/A N/A N/A N/A N/A</td> <td>N/A N/A 0.3 N/A N/A N/A N/A 0 0.2 0 -0.1 N/A 0 0.1 0 0 N/A</td> <td>15SF 6SF 15SF 9SF 6SF 15SF 9SF 9SF</td> <td></td> <td></td>	N/A W1 N/A N/A N/A W1 W3 N/A W1 W3 N/A W1 W3 N/A N/A NA NA Door Frame NA NA NA NA Columns Columns Radiator NA Door Frame Columns Radiator NA NA	NIA NIA Metal NIA NIA NIA Concrete Metal Concrete Metal Concrete Metal N/A Metal N/A N/A	N/A N/A Brown N/A N/A N/A N/A Tan Brown Tan Brown Tan Brown Tan Brown N/A N/A	NA Chipping NA NA NA NA Chipping Chipping Chipping Chipping Chipping N/A Chipping N/A Chipping Chipping Chipping Chipping Chipping Chipping Chipping	N/A N/A N/A N/A N/A	N/A N/A 0.3 N/A N/A N/A N/A 0 0.2 0 -0.1 N/A 0 0.1 0 0 N/A	15SF 6SF 15SF 9SF 6SF 15SF 9SF 9SF		
7260 217 Classroom 200A 7260 217 Classroom 200A 7280 201 Classroom 201 7280 200 Classroom 202 7280 200 Classroom 203 7280 203 Classroom 203 7280 204 Classroom 204 7280 204 Classroom 204 </td <td>N/A W1 N/A N/A N/A N/A W1 W3 W3 W1 W3 N/A W1 W3 N/A W1 W3 W1 W3 W4 W1 W3 W4 W1</td> <td>N/A N/A N/A N/A N/A N/A</td> <td>N/A N/A N/A N/A N/A</td> <td>N/A N/A N/A N/A N/A N/A N/A</td> <td>N/A N/A N/A N/A N/A N/A N/A N/A</td> <td>N/A N/A N/A N/A N/A N/A N/A</td> <td>N/A N/A N/A N/A N/A N/A N/A</td> <td>NA NA Door Frame NA NA NA NA Columns Columns Radiator N/A Door Frame Columns Radiator N/A N/A N/A N/A N/A N/A N/A</td> <td>N/A N/A Metal N/A N/A Concrete Metal Concrete Metal N/A Metal N/A Metal N/A N/A N/A Metal</td> <td>N/A N/A Brown N/A N/A N/A Tan Brown Tan Brown Tan Brown Tan Brown N/A Brown N/A N/A N/A Brown</td> <td>NA Chipping N/A N/A N/A N/A Chipping Chipping Chipping Chipping N/A Chipping Chipping Chipping Chipping Chipping Chipping Chipping Chipping Chipping Chipping N/A</td> <td>N/A N/A N/A N/A N/A N/A N/A N/A</td> <td>N/A N/A 0.3 N/A N/A N/A 0 0 0 0 0 0 0 0 0 0 0 0 0 0 0 N/A 0 N/A N/A 0 N/A 0</td> <td>15SF 6SF 9SF 6SF 15SF 9SF 9SF 6SF 15SF 6SF 15SF</td> <td></td> <td></td>	N/A W1 N/A N/A N/A N/A W1 W3 W3 W1 W3 N/A W1 W3 N/A W1 W3 W1 W3 W4 W1 W3 W4 W1	N/A N/A NA NA Door Frame NA NA NA NA Columns Columns Radiator N/A Door Frame Columns Radiator N/A N/A N/A N/A N/A N/A N/A	N/A N/A Metal N/A N/A Concrete Metal Concrete Metal N/A Metal N/A Metal N/A N/A N/A Metal	N/A N/A Brown N/A N/A N/A Tan Brown Tan Brown Tan Brown Tan Brown N/A Brown N/A N/A N/A Brown	NA Chipping N/A N/A N/A N/A Chipping Chipping Chipping Chipping N/A Chipping Chipping Chipping Chipping Chipping Chipping Chipping Chipping Chipping Chipping N/A	N/A N/A N/A N/A N/A N/A N/A N/A	N/A N/A 0.3 N/A N/A N/A 0 0 0 0 0 0 0 0 0 0 0 0 0 0 0 N/A 0 N/A N/A 0 N/A 0	15SF 6SF 9SF 6SF 15SF 9SF 9SF 6SF 15SF 6SF 15SF		
7260 217 Classroom 200A 7260 217 Classroom 200A 7280 201 Classroom 201 7280 200 Classroom 202 7280 200 Classroom 203 7280 203 Classroom 203 7280 203 Classroom 203 7280 203 Classroom 203 7280 203 Classroom 203 7280 204 Classroom 204 7280 204 Classroom 204 </td <td>N/A W1 N/A N/A N/A W1 W1 W3 N/A W1 W3 N/A W1 W3 W1 W3 W1 W3 W1 W3 W1 W3 W1 W3 N/A W1 W3</td> <td>N/A N/A N/A N/A N/A N/A</td> <td>N/A N/A N/A N/A N/A</td> <td>N/A N/A N/A N/A N/A</td> <td>N/A N/A N/A N/A N/A N/A N/A</td> <td>N/A N/A N/A N/A N/A N/A</td> <td>N/A N/A N/A N/A N/A</td> <td>NA NA Door Frame N/A N/A N/A N/A Columns Radiator N/A Door Frame Columns Radiator N/A N/A N/A N/A Columns</td> <td>NIA NIA Metal NIA NIA NIA NIA Concrete Metal Concrete Metal NIA Metal NIA Metal NIA NIA Metal Concrete</td> <td>NIA NIA Brown NIA NIA NIA NIA Tan Brown Tan Brown Tan Brown Tan Brown N/A Brown N/A Brown Tan Brown Tan</td> <td>NA Chipping NA NA NA NA Chipping Chipping Chipping Chipping Chipping N/A Chipping N/A Chipping Chipping Chipping Chipping Chipping Chipping Chipping</td> <td>N/A N/A N/A N/A N/A</td> <td>N/A N/A N/A N/A N/A N/A N/A N/A 0 0.2 0 -0.1 N/A 0 0.1 0.1 0.1 0.1 0.1</td> <td>15SF 6SF 15SF 9SF 6SF 15SF 9SF 9SF 6SF</td> <td></td> <td></td>	N/A W1 N/A N/A N/A W1 W1 W3 N/A W1 W3 N/A W1 W3 W1 W3 W1 W3 W1 W3 W1 W3 W1 W3 N/A W1 W3	N/A N/A NA NA Door Frame N/A N/A N/A N/A Columns Radiator N/A Door Frame Columns Radiator N/A N/A N/A N/A Columns	NIA NIA Metal NIA NIA NIA NIA Concrete Metal Concrete Metal NIA Metal NIA Metal NIA NIA Metal Concrete	NIA NIA Brown NIA NIA NIA NIA Tan Brown Tan Brown Tan Brown Tan Brown N/A Brown N/A Brown Tan Brown Tan	NA Chipping NA NA NA NA Chipping Chipping Chipping Chipping Chipping N/A Chipping N/A Chipping Chipping Chipping Chipping Chipping Chipping Chipping	N/A N/A N/A N/A N/A	N/A N/A N/A N/A N/A N/A N/A N/A 0 0.2 0 -0.1 N/A 0 0.1 0.1 0.1 0.1 0.1	15SF 6SF 15SF 9SF 6SF 15SF 9SF 9SF 6SF		
7260 217 Classroom 200A 7260 217 Classroom 200A 7280 201 Classroom 201 7280 200 Classroom 202 7280 200 Classroom 203 7280 203 Classroom 203 7280 203 Classroom 203 7280 203 Classroom 203 7280 203 Classroom 203 7280 204 Classroom 204 7280 204 Classroom 204 7280 204 Classroom 204 </td <td>N/A W1 N/A N/A N/A W1 W3 W3 W3 N/A W1 W3 W3 N/A N/A W1 W3 W3 N/A W1 W3 W3 W4 W1 W3 W3 W3</td> <td>N/A N/A N/A N/A N/A N/A N/A N/A N/A N/A</td> <td>N/A N/A N/A N/A N/A N/A N/A</td> <td>N/A N/A N/A N/A N/A N/A N/A N/A</td> <td>N/A N/A N/A N/A N/A N/A N/A N/A</td> <td>N/A N/A N/A N/A N/A N/A N/A</td> <td>N/A N/A N/A N/A N/A N/A N/A N/A</td> <td>NA NA NA Door Frame NA NA NA Columns Radiator N/A Door Frame Columns Radiator N/A Door Frame Columns Radiator N/A Door Frame Columns Radiator Radiator</td> <td>NIA NIA Metal NIA NIA NIA Concrete Metal Concrete Metal Concrete Metal N/A Metal Concrete Metal N/A Metal Concrete Metal N/A</td> <td>N/A N/A Brown N/A N/A N/A Tan Brown Tan Brown Tan Brown Tan Brown Tan Brown Tan Brown Tan Brown Tan Brown Tan Brown</td> <td>NA Chipping N/A N/A N/A N/A Chipping Chipping Chipping Chipping Chipping Chipping Chipping Chipping N/A N/A N/A N/A Chipping Chipping Chipping Chipping Chipping Chipping Chipping</td> <td>N/A N/A N/A N/A N/A N/A N/A N/A</td> <td>N/A N/A 0.3 N/A N/A N/A N/A N/A 0 0.2 0 -0.1 N/A 0 0.1 0 N/A N/A 0.1 0.1 0.1 0.1 0.1 0</td> <td>15SF 6SF 9SF 6SF 15SF 9SF 9SF 6SF 15SF 6SF 15SF</td> <td></td> <td></td>	N/A W1 N/A N/A N/A W1 W3 W3 W3 N/A W1 W3 W3 N/A N/A W1 W3 W3 N/A W1 W3 W3 W4 W1 W3 W3 W3	N/A	N/A NA NA NA Door Frame NA NA NA Columns Radiator N/A Door Frame Columns Radiator N/A Door Frame Columns Radiator N/A Door Frame Columns Radiator Radiator	NIA NIA Metal NIA NIA NIA Concrete Metal Concrete Metal Concrete Metal N/A Metal Concrete Metal N/A Metal Concrete Metal N/A	N/A N/A Brown N/A N/A N/A Tan Brown Tan Brown Tan Brown Tan Brown Tan Brown Tan Brown Tan Brown Tan Brown Tan Brown	NA Chipping N/A N/A N/A N/A Chipping Chipping Chipping Chipping Chipping Chipping Chipping Chipping N/A N/A N/A N/A Chipping Chipping Chipping Chipping Chipping Chipping Chipping	N/A N/A N/A N/A N/A N/A N/A N/A	N/A N/A 0.3 N/A N/A N/A N/A N/A 0 0.2 0 -0.1 N/A 0 0.1 0 N/A N/A 0.1 0.1 0.1 0.1 0.1 0	15SF 6SF 9SF 6SF 15SF 9SF 9SF 6SF 15SF 6SF 15SF		
7260 217 Classroom 200A 7260 217 Classroom 200A 7260 201 Classroom 201 7260 200 Classroom 202 7260 200 Classroom 203 7260 203 Classroom 203 7260 203 Classroom 203 7260 203 Classroom 203 7260 204 Classroom 204 7260 204 Classroom 204 7260 204 Classroom 204 7260 204 Classroom 204 </td <td>N/A W1 N/A N/A N/A W1 W3 W3 W1 W3 N/A W1 W3 W3 W3 W4 W1</td> <td>N/A N/A N/A N/A N/A N/A N/A N/A</td> <td>N/A N/A N/A N/A N/A N/A N/A N/A</td> <td>N/A N/A N/A N/A N/A N/A N/A</td> <td>N/A N/A N/A N/A N/A N/A N/A N/A</td> <td>N/A N/A N/A N/A N/A N/A N/A N/A N/A</td> <td>N/A N/A N/A N/A N/A N/A N/A</td> <td>NA NA NA Door Frame NA NA NA Columns Columns Radiator N/A Door Frame Columns Radiator N/A Door Frame Columns Radiator N/A Door Frame</td> <td>NIA NIA Metal NIA NIA NIA NIA Concrete Metal Concrete Metal N/A Metal Concrete Metal N/A Metal Concrete Metal N/A Metal Concrete Metal N/A</td> <td>N/A N/A Brown N/A N/A N/A Tan Brown Tan Brown Tan Brown N/A Brown N/A Brown Tan Brown N/A Brown Tan Brown N/A Brown X/A Brown</td> <td>NA Chipping N/A N/A N/A N/A N/A Chipping Chipping Chipping Chipping Chipping Chipping Chipping Chipping Chipping Chipping N/A N/A Chipping Chipping Chipping Chipping Chipping Chipping Chipping Chipping Chipping Chipping Chipping Chipping Chipping Chipping Chipping Chipping</td> <td>N/A N/A N/A N/A N/A N/A N/A N/A</td> <td>N/A N/A 0.3 N/A N/A N/A N/A N/A 0 0.2 0 -0.1 N/A 0 0.1 0 N/A 0.1 0.1 0.1 0.1 0.1 0 N/A 0.1 0 N/A</td> <td>15SF 6SF 9SF 6SF 15SF 9SF 9SF 9SF 6SF 15SF 10SF 10SF 6SF</td> <td></td> <td></td>	N/A W1 N/A N/A N/A W1 W3 W3 W1 W3 N/A W1 W3 W3 W3 W4 W1	N/A N/A NA NA NA Door Frame NA NA NA Columns Columns Radiator N/A Door Frame Columns Radiator N/A Door Frame Columns Radiator N/A Door Frame	NIA NIA Metal NIA NIA NIA NIA Concrete Metal Concrete Metal N/A Metal Concrete Metal N/A Metal Concrete Metal N/A Metal Concrete Metal N/A	N/A N/A Brown N/A N/A N/A Tan Brown Tan Brown Tan Brown N/A Brown N/A Brown Tan Brown N/A Brown Tan Brown N/A Brown X/A Brown	NA Chipping N/A N/A N/A N/A N/A Chipping Chipping Chipping Chipping Chipping Chipping Chipping Chipping Chipping Chipping N/A N/A Chipping Chipping Chipping Chipping Chipping Chipping Chipping Chipping Chipping Chipping Chipping Chipping Chipping Chipping Chipping Chipping	N/A N/A N/A N/A N/A N/A N/A N/A	N/A N/A 0.3 N/A N/A N/A N/A N/A 0 0.2 0 -0.1 N/A 0 0.1 0 N/A 0.1 0.1 0.1 0.1 0.1 0 N/A 0.1 0 N/A	15SF 6SF 9SF 6SF 15SF 9SF 9SF 9SF 6SF 15SF 10SF 10SF 6SF		
7260 217 Classroom 200A 7260 217 Classroom 200A 7280 201 Classroom 201 7280 200 Classroom 202 7280 200 Classroom 203 7280 203 Classroom 203 7280 203 Classroom 203 7280 203 Classroom 203 7280 203 Classroom 203 7280 204 Classroom 204 7280 204 Classroom 204 7280 204 Classroom 204 </td <td>N/A W1 N/A N/A N/A W1 W1 W1 W3 N/A W1 W3 W3 W3 W3 W3</td> <td>N/A N/A N/A N/A N/A N/A Chipping Chipping Chipping Chipping Chipping Chipping Chipping</td> <td>N/A N/A N/A N/A N/A N/A N/A</td> <td>N/A N/A N/A N/A N/A N/A N/A N/A 0 0.2 0 -0.1 N/A 0 0.1 0 N/A N/A 0.1 0.1 0.1 0.1 0.1 0 N/A</td> <td>15SF 6SF 15SF 9SF 6SF 15SF 9SF 9SF 6SF 15SF 10SF</td> <td></td> <td></td>	N/A W1 N/A N/A N/A W1 W1 W1 W3 N/A W1 W3 W3 W3 W3 W3	N/A	N/A N/A N/A N/A N/A N/A N/A N/A Tan N/A	N/A N/A N/A N/A N/A N/A N/A N/A Chipping N/A	N/A NA NA NA Door Frame NIA NA NA Columns Radiator N/A Door Frame Columns Radiator N/A Door Frame Columns Radiator N/A Door Frame Columns Radiator N/A	NIA NIA Metal NIA NIA NIA NIA Concrete Metal Concrete Metal N/A Metal Concrete Metal N/A Metal Concrete Metal N/A Metal Concrete Metal N/A	NIA NIA Brown NIA NIA NIA NIA Tan Brown Tan Brown Tan Brown NIA Brown Tan Brown Tan Brown Tan Brown NIA Brown NIA	NA Chipping N/A N/A N/A N/A Chipping Chipping Chipping Chipping Chipping Chipping Chipping Chipping N/A N/A N/A N/A Chipping Chipping Chipping Chipping Chipping Chipping Chipping	N/A N/A N/A N/A N/A N/A N/A	N/A N/A N/A N/A N/A N/A N/A N/A 0 0.2 0 -0.1 N/A 0 0.1 0 N/A N/A 0.1 0.1 0.1 0.1 0.1 0 N/A	15SF 6SF 15SF 9SF 6SF 15SF 9SF 9SF 6SF 15SF 10SF		
7260 217 Classroom 200A 7260 217 Classroom 200A 7260 201 Classroom 201 7260 200 Classroom 202 7260 200 Classroom 203 7260 203 Classroom 204 7260 204 Classroom 204 7260 204 Classroom 204 7260 204 Classroom 204 </td <td>N/A W1 N/A N/A N/A N/A W1 W3 W3 W4 W1 W3 W3 W1 W3 W4 W3 W3 W3 W3 W3 W3</td> <td>N/A N/A N/A N/A N/A N/A N/A N/A N/A N/A</td> <td>N/A N/A N/A N/A N/A N/A N/A N/A N/A Tan</td> <td>N/A N/A N/A N/A N/A N/A N/A N/A N/A Chipping</td> <td>N/A N/A N/A N/A N/A N/A N/A N/A</td> <td>N/A N/A N/A N/A N/A N/A N/A N/A N/A -0.1</td> <td>N/A N/A N/A N/A N/A N/A N/A N/A N/A N/A</td> <td>NA NA NA Door Frame NA NA NA NA Door Frame Columns Radiator NA Door Frame Columns Radiator NA NA Door Frame Columns Radiator NA NA NA NA NA NA NA NA NA NA NA NA NA</td> <td>NIA NIA Metal NIA NIA NIA NIA Concrete Metal Concrete Metal Concrete Metal N/A N/A Metal Concrete Metal N/A Metal Concrete Metal Concrete</td> <td>NIA NIA Brown NIA NIA NIA NIA Tan Brown Tan Brown N/A Brown Tan Tan Brown N/A Brown Tan Tan Tan Tan Brown Tan Tan</td> <td>NA Chipping N/A N/A N/A N/A N/A Chipping Chipping Chipping Chipping Chipping Chipping N/A Chipping Chipping Chipping Chipping Chipping Chipping N/A N/A N/A Chipping Chipping Chipping N/A Chipping Chipping Chipping N/A Chipping</td> <td>N/A N/A N/A N/A N/A N/A N/A N/A</td> <td>N/A N/A N/A N/A N/A N/A N/A N/A N/A 0 0.2 0 -0.1 N/A 0 0.1 0 N/A N/A 0.1 0.1 0.1 0.1 0.1 0.1 0.1 0.1 0.1 0.1 0.1 0.1 0.1 0.1 0.1 0.1 0.1 0.1</td> <td>15SF 6SF 9SF 6SF 15SF 9SF 9SF 9SF 6SF 15SF 10SF 10SF 6SF</td> <td></td> <td></td>	N/A W1 N/A N/A N/A N/A W1 W3 W3 W4 W1 W3 W3 W1 W3 W4 W3 W3 W3 W3 W3 W3	N/A N/A N/A N/A N/A N/A N/A N/A N/A N/A	N/A N/A N/A N/A N/A N/A N/A N/A N/A Tan	N/A N/A N/A N/A N/A N/A N/A N/A N/A Chipping	N/A N/A N/A N/A N/A N/A N/A N/A	N/A N/A N/A N/A N/A N/A N/A N/A N/A -0.1	N/A N/A N/A N/A N/A N/A N/A N/A N/A N/A	NA NA NA Door Frame NA NA NA NA Door Frame Columns Radiator NA Door Frame Columns Radiator NA NA Door Frame Columns Radiator NA NA NA NA NA NA NA NA NA NA NA NA NA	NIA NIA Metal NIA NIA NIA NIA Concrete Metal Concrete Metal Concrete Metal N/A N/A Metal Concrete Metal N/A Metal Concrete Metal Concrete	NIA NIA Brown NIA NIA NIA NIA Tan Brown Tan Brown N/A Brown Tan Tan Brown N/A Brown Tan Tan Tan Tan Brown Tan Tan	NA Chipping N/A N/A N/A N/A N/A Chipping Chipping Chipping Chipping Chipping Chipping N/A Chipping Chipping Chipping Chipping Chipping Chipping N/A N/A N/A Chipping Chipping Chipping N/A Chipping Chipping Chipping N/A Chipping	N/A N/A N/A N/A N/A N/A N/A N/A	N/A N/A N/A N/A N/A N/A N/A N/A N/A 0 0.2 0 -0.1 N/A 0 0.1 0 N/A N/A 0.1 0.1 0.1 0.1 0.1 0.1 0.1 0.1 0.1 0.1 0.1 0.1 0.1 0.1 0.1 0.1 0.1 0.1	15SF 6SF 9SF 6SF 15SF 9SF 9SF 9SF 6SF 15SF 10SF 10SF 6SF		
7260 217 Classroom 200A 7260 217 Classroom 200A 7260 201 Classroom 201 7260 200 Classroom 202 7260 200 Classroom 203 7260 203 Classroom 203 7260 203 Classroom 203 7260 203 Classroom 203 7260 204 Classroom 204 7260 204 Classroom 204 7260 204 Classroom 204 7260 204 Classroom 204 7260 204 Classroom 204 </td <td>N/A W1 N/A N/A N/A N/A W1 W3 W3 W1 W3 W1 W3 N/A W1 W3 N/A N/A W1 W3 N/A W1 W3 N/A W1 W3 N/A W1 W3 N/A W1</td> <td>N/A N/A N/A N/A N/A N/A N/A N/A N/A N/A</td> <td>N/A N/A N/A N/A N/A N/A N/A N/A Tan N/A</td> <td>N/A N/A N/A N/A N/A N/A N/A N/A N/A Chipping N/A N/A</td> <td>N/A N/A N/A N/A N/A N/A N/A N/A N/A N/A</td> <td>N/A N/A N/A N/A N/A N/A N/A N/A N/A N/A</td> <td>N/A N/A N/A N/A N/A N/A N/A N/A N/A N/A</td> <td>NA NA NA Door Frame NA NA NA Columns Radiator N/A Door Frame Columns Radiator N/A Door Frame Columns Radiator N/A Door Frame Columns Radiator N/A</td> <td>NIA N/A Metal N/A N/A N/A Concrete N/A N/A	N/A N/A N/A N/A N/A N/A N/A N/A Tan N/A	N/A N/A N/A N/A N/A N/A N/A N/A N/A Chipping N/A N/A	NA NA NA Door Frame NA NA NA Columns Radiator N/A Door Frame Columns Radiator N/A Door Frame Columns Radiator N/A Door Frame Columns Radiator N/A	NIA N/A Metal N/A N/A N/A Concrete Metal Concrete Metal Concrete Metal N/A Metal Concrete Metal N/A Metal Concrete Metal Concrete Metal N/A N/A Metal Concrete N/A N/A N/A N/A N/A N/A	N/A N/A Brown N/A N/A N/A Tan Brown Tan Brown N/A Brown Tan Brown N/A Brown Tan Brown N/A Brown Tan Tan Brown N/A N/A N/A	NA Chipping N/A N/A N/A N/A N/A Chipping Chipping Chipping Chipping Chipping Chipping Chipping N/A Chipping N/A N/A	N/A N/A N/A N/A N/A N/A N/A N/A N/A N/A	N/A N/A N/A N/A N/A N/A N/A N/A 0 0.2 0 -0.1 N/A 0 -0.1 N/A 0 0.1 0 N/A N/A 0.1 0.1 0 N/A 0.1 0 N/A 0 N/A 0 N/A	15SF 6SF 9SF 6SF 15SF 9SF 9SF 9SF 6SF 15SF 10SF 10SF 6SF		
7260 217 Classroom 200A 7260 217 Classroom 200A 7260 201 Classroom 201 7260 200 Classroom 202 7260 200 Classroom 203 7260 203 Classroom 204 7260 204 Classroom 204 7260 204 Classroom 204 7260 204 Classroom 204 </td <td>N/A W1 N/A N/A N/A N/A W1 W3 W3 W1 W3 N/A W1 W3 N/A</td> <td>N/A N/A N/A N/A N/A N/A N/A N/A N/A</td> <td>N/A N/A N/A N/A N/A N/A N/A N/A Tan N/A</td> <td>N/A N/A N/A N/A N/A N/A N/A N/A Chipping N/A</td> <td>N/A N/A N/A N/A N/A N/A N/A N/A N/A</td> <td>N/A N/A N/A N/A N/A N/A N/A N/A N/A N/A</td> <td>N/A N/A N/A N/A N/A N/A N/A N/A N/A N/A</td> <td>NA NA NA Door Frame NIA NA NA Columns Radiator N/A Door Frame Columns Radiator N/A Door Frame Columns Radiator N/A Door Frame Columns Radiator N/A</td> <td>NIA NIA Metal NIA NIA NIA NIA Concrete Metal Concrete Metal N/A Metal Concrete Metal N/A Metal Concrete Metal N/A Metal Concrete Metal N/A</td> <td>NIA NIA Brown NIA NIA NIA NIA NIA Tan Brown Tan Brown NIA Brown Tan Brown Tan Brown Tan Brown Tan NIA Brown Tan NIA Brown Tan NIA</td> <td>NA Chipping N/A N/A N/A N/A Chipping Chipping Chipping Chipping Chipping Chipping Chipping Chipping Chipping Chipping N/A N/A Chipping Chipping Chipping Chipping Chipping Chipping Chipping Chipping N/A N/A</td> <td>N/A N/A N/A N/A N/A N/A N/A</td> <td>N/A N/A N/A N/A N/A N/A N/A N/A N/A 0 0.2 0 -0.1 N/A 0 0.1 0 N/A N/A 0.1 0 N/A 0.1 0 N/A 0.1 0 N/A 0.1 0 N/A</td> <td>15SF 6SF 9SF 6SF 15SF 9SF 9SF 9SF 6SF 15SF 10SF 10SF 6SF</td> <td></td> <td></td>	N/A W1 N/A N/A N/A N/A W1 W3 W3 W1 W3 N/A	N/A N/A N/A N/A N/A N/A N/A N/A N/A	N/A N/A N/A N/A N/A N/A N/A N/A Tan N/A	N/A N/A N/A N/A N/A N/A N/A N/A Chipping N/A	N/A NA NA NA Door Frame NIA NA NA Columns Radiator N/A Door Frame Columns Radiator N/A Door Frame Columns Radiator N/A Door Frame Columns Radiator N/A	NIA NIA Metal NIA NIA NIA NIA Concrete Metal Concrete Metal N/A Metal Concrete Metal N/A Metal Concrete Metal N/A Metal Concrete Metal N/A	NIA NIA Brown NIA NIA NIA NIA NIA Tan Brown Tan Brown NIA Brown Tan Brown Tan Brown Tan Brown Tan NIA Brown Tan NIA Brown Tan NIA	NA Chipping N/A N/A N/A N/A Chipping Chipping Chipping Chipping Chipping Chipping Chipping Chipping Chipping Chipping N/A N/A Chipping Chipping Chipping Chipping Chipping Chipping Chipping Chipping N/A N/A	N/A N/A N/A N/A N/A N/A N/A	N/A N/A N/A N/A N/A N/A N/A N/A N/A 0 0.2 0 -0.1 N/A 0 0.1 0 N/A N/A 0.1 0 N/A 0.1 0 N/A 0.1 0 N/A 0.1 0 N/A	15SF 6SF 9SF 6SF 15SF 9SF 9SF 9SF 6SF 15SF 10SF 10SF 6SF		
7260 217 Classroom 200A 7260 217 Classroom 200A 7260 201 Classroom 201 7260 200 Classroom 202 7260 200 Classroom 203 7260 203 Classroom 203 7260 203 Classroom 203 7260 203 Classroom 203 7260 204 Classroom 204 7260 204 Classroom 204 7260 204 Classroom 204 7260 204 Classroom 204 7260 204 Classroom 204 </td <td>N/A W1 N/A N/A N/A W1 W1 W1 W1 W3 N/A W1 W3 W3 N/A W1 W3 N/A W1 W3 N/A N/A N/A N/A N/A N/A N/A</td> <td>N/A N/A N/A N/A N/A N/A N/A N/A N/A N/A</td> <td>N/A N/A N/A N/A N/A N/A N/A N/A Tan N/A N/A N/A N/A N/A N/A</td> <td>N/A N/A N/A N/A N/A N/A N/A Chipping N/A N/A N/A N/A N/A</td> <td>N/A N/A N/A N/A N/A N/A N/A N/A N/A N/A</td> <td>N/A N/A N/A N/A N/A N/A N/A N/A N/A N/A</td> <td>N/A N/A N/A N/A N/A N/A N/A N/A N/A N/A</td> <td>NA NA NA Door Frame N/A N/A N/A Columns Columns Radiator 9SF 9SF 9SF 6SF 15SF 10SF 10SF 6SF</td> <td></td> <td></td>	N/A W1 N/A N/A N/A W1 W1 W1 W1 W3 N/A W1 W3 W3 N/A W1 W3 N/A W1 W3 N/A N/A Tan N/A N/A N/A N/A N/A N/A	N/A N/A N/A N/A N/A N/A N/A Chipping N/A N/A NA NA NA Door Frame N/A N/A N/A Columns Columns Radiator N/A Door Frame Columns Radiator N/A Door Frame Columns Radiator N/A N/A N/A N/A N/A N/A N/A	NIA NIA Metal NIA NIA NIA NIA Concrete Metal Concrete Metal N/A Metal Concrete Metal N/A Metal Concrete Metal N/A Metal Concrete Metal N/A N/A Metal Concrete Metal N/A N/A	N/A N/A Brown N/A N/A N/A Tan Brown Tan Brown N/A Brown Tan Brown N/A Brown Tan Brown N/A Brown Tan Brown N/A Brown N/A N/A N/A N/A	NA Chipping N/A N/A N/A N/A N/A Chipping Chipping Chipping Chipping Chipping Chipping Chipping N/A Chipping Chipping Chipping Chipping N/A N/A N/A Chipping Chipping Chipping Chipping Chipping N/A N/A N/A N/A N/A N/A N/A	N/A N/A N/A N/A N/A N/A N/A N/A N/A N/A	N/A N/A 0.3 N/A N/A N/A N/A N/A 0 0.2 0 -0.1 N/A 0 0.1 0 0.1 0 N/A	15SF 6SF 9SF 6SF 15SF 9SF 9SF 9SF 6SF 15SF 10SF 10SF 6SF		
7260 217 Classroom 200A 7260 217 Classroom 200A 7280 201 Classroom 201 7280 200 Classroom 202 7280 200 Classroom 203 7280 203 Classroom 203 7280 203 Classroom 203 7280 203 Classroom 204 7280 204 Classroom 204 7280 204 Classroom 204 7280 204 Classroom 204 7280 204 Classroom 204 </td <td>N/A W1 N/A N/A N/A N/A W1 W1 W1 W1 W1 W3 W3 N/A W1 W3 N/A W1 W3 N/A W1 W3 N/A W1 W3 N/A N/A N/A N/A N/A N/A</td> <td>N/A N/A N/A N/A N/A N/A N/A N/A N/A N/A</td> <td>N/A N/A N/A</td> <td>N/A N/A N/A N/A N/A N/A N/A N/A N/A N/A</td> <td>N/A N/A N/A N/A N/A N/A N/A N/A N/A 0.1 0 N/A 0.1 0 N/A N/A N/A N/A</td> <td>15SF 6SF 15SF 9SF 6SF 15SF 9SF 9SF 6SF 15SF 10SF 6SF 15SF</td> <td></td> <td></td>	N/A W1 N/A N/A N/A N/A W1 W1 W1 W1 W1 W3 W3 N/A W1 W3 N/A W1 W3 N/A W1 W3 N/A W1 W3 N/A N/A NA NA NA Door Frame NA NA NA Columns Columns Radiator N/A Door Frame Columns Radiator N/A Door Frame Columns Radiator N/A N/A N/A N/A N/A N/A N/A	NIA NIA Metal NIA NIA NIA NIA Concrete Metal Concrete Metal Concrete Metal N/A Metal Concrete Metal N/A Metal Concrete Metal N/A Metal Concrete Metal N/A N/A N/A N/A	NIA NIA NIA Brown NIA NIA NIA NIA Tan Brown Tan Brown Tan NIA Brown Tan Brown Tan Brown Tan Brown Tan Brown Tan NIA Brown Tan NIA NIA NIA NIA NIA NIA NIA NIA NIA NIA	NA Chipping N/A N/A N/A N/A N/A Chipping N/A	N/A N/A N/A N/A N/A N/A N/A N/A N/A N/A	N/A N/A N/A N/A N/A N/A N/A N/A N/A 0 0.2 0 -0.1 N/A 0 0.1 0 N/A N/A 0.1 0 N/A 0.1 0 N/A 0.1 0 N/A N/A N/A N/A	15SF 6SF 15SF 9SF 6SF 15SF 9SF 9SF 6SF 15SF 10SF 6SF 15SF		
7280 217 Classroom 200A 7280 217 Classroom 200A 7280 201 Classroom 201 7280 200 Classroom 202 7280 200 Classroom 203 7280 203 Classroom 203 7280 203 Classroom 203 7280 203 Classroom 203 7280 203 Classroom 203 7280 204 Classroom 204 7280 204 Classroom 204 7280 204 Classroom 204 7280 204 Classroom 204 </td <td>N/A W1 N/A N/A N/A N/A W1 W3 N/A W1 W3 N/A N/A N/A N/A N/A N/A N/A N/A N/A</td> <td>N/A N/A N/A N/A N/A N/A N/A N/A N/A N/A</td> <td>N/A N/A N/A N/A N/A N/A N/A N/A Tan N/A N/A N/A N/A N/A N/A</td> <td>N/A N/A N/A N/A N/A N/A N/A Chipping N/A N/A N/A N/A N/A</td> <td>N/A N/A N/A N/A N/A N/A N/A N/A N/A N/A</td> <td>N/A N/A N/A N/A N/A N/A N/A N/A N/A N/A</td> <td>N/A N/A N/A N/A N/A N/A N/A N/A N/A N/A</td> <td>NA NA NA Door Frame NA NA NA Columns Columns Radiator N/A Door Frame Columns Radiator NA Door Frame Columns Radiator NA NA Door Frame Columns Radiator NA NA Door Frame Columns Radiator NA NA Door Frame</td> <td>NIA NIA Metal NIA NIA NIA NIA Concrete Metal Concrete Metal N/A Metal Concrete Metal N/A Metal Concrete Metal N/A Metal Concrete Metal N/A Metal N/A Metal Concrete Metal N/A Metal</td> <td>N/A N/A Brown N/A N/A N/A N/A Brown Tan Brown Tan Brown N/A Brown Tan Brown N/A Brown Tan Brown N/A Brown N/A Brown N/A Brown N/A Brown N/A Brown</td> <td>NA Chipping N/A N/A N/A N/A N/A N/A Chipping N/A Chipping Chipping Chipping Chipping Chipping Chipping N/A Chipping N/A N/A</td> <td>N/A N/A N/A N/A N/A N/A N/A N/A N/A N/A</td> <td>N/A N/A 0 0.2 0 -0.1 N/A 0 0.1 0 N/A 0.1 0 N/A 0.2 0 N/A N/A N/A N/A</td> <td>15SF 6SF 9SF 6SF 15SF 9SF 9SF 9SF 6SF 15SF 10SF 10SF 6SF 15SF 15SF 15SF</td> <td></td> <td></td>	N/A W1 N/A N/A N/A N/A W1 W1 W3 W3 W3 W3 W3 N/A W1 W3 N/A W1 W3 N/A W1 W3 N/A W1 W3 N/A N/A N/A W1 W3 N/A W1 W3 N/A W1 W3 N/A N/A NA NA NA Door Frame NA NA NA Columns Radiator NA Door Frame Columns Radiator NA Door Frame Columns Radiator NA NA Door Frame Columns Radiator NA NA Door Frame Columns Radiator NA NA Door Frame	NIA NIA Metal NIA NIA NIA NIA Concrete Metal Concrete Metal N/A Metal Concrete Metal N/A Metal Concrete Metal N/A Metal Concrete Metal N/A Metal N/A Metal Concrete Metal N/A Metal	N/A N/A Brown N/A N/A N/A N/A Brown Tan Brown Tan Brown N/A Brown Tan Brown N/A Brown Tan Brown N/A Brown N/A Brown N/A Brown N/A Brown N/A Brown	NA Chipping N/A N/A N/A N/A N/A N/A Chipping N/A Chipping Chipping Chipping Chipping Chipping Chipping N/A Chipping N/A	N/A N/A N/A N/A N/A N/A N/A N/A N/A N/A	N/A 0 0.2 0 -0.1 N/A 0 0.1 0 N/A 0.1 0 N/A 0.2 0 N/A N/A N/A N/A	15SF 6SF 9SF 6SF 15SF 9SF 9SF 9SF 6SF 15SF 10SF 10SF 6SF 15SF 15SF 15SF		
7260 217 Classroom 200A 7260 217 Classroom 200A 7260 201 Classroom 201 7260 200 Classroom 202 7260 200 Classroom 203 7260 203 Classroom 203 7260 203 Classroom 203 7260 203 Classroom 203 7260 204 Classroom 204 7260 204 Classroom 204 7260 204 Classroom 204 7260 204 Classroom 204 7260 204 Classroom 204 </td <td>N/A W1 N/A N/A N/A N/A W1 W3 W3 W3 W3 W1 W3 N/A W1 W2 W3 W4</td> <td>N/A N/A N/A N/A N/A N/A N/A N/A N/A N/A</td> <td>N/A N/A N/A</td> <td>N/A N/A N/A N/A N/A N/A N/A N/A N/A N/A</td> <td>N/A N/A N/A N/A N/A N/A N/A N/A N/A N/A</td> <td>N/A N/A N/A N/A N/A N/A N/A N/A N/A N/A</td> <td>N/A N/A N/A N/A N/A N/A N/A N/A N/A N/A</td> <td>NA NA NA Door Frame NA NA NA Columns Radiator NA Door Frame Columns Radiator NA Door Frame Columns Radiator NA NA Door Frame Columns Radiator NA NA Door Frame Columns Radiator NA NA Door Frame</td> <td>NIA NIA Metal NIA NIA NIA NIA Concrete Metal Concrete Metal N/A Metal Concrete Metal N/A Metal Concrete Metal N/A Metal Concrete Metal N/A Metal N/A Metal Concrete Metal N/A Metal</td> <td>N/A N/A Brown N/A N/A N/A N/A Brown Tan Brown Tan Brown N/A Brown Tan Brown N/A Brown Tan Brown N/A Brown N/A Brown N/A Brown N/A Brown N/A Brown</td> <td>NA Chipping N/A N/A N/A N/A N/A N/A Chipping N/A Chipping Chipping Chipping Chipping Chipping Chipping N/A Chipping N/A N/A</td> <td>N/A N/A N/A N/A N/A N/A N/A N/A N/A N/A</td> <td>N/A N/A 0 0.2 0 -0.1 N/A 0 0.1 0 N/A 0.1 0 N/A 0.2 0 N/A N/A N/A N/A</td> <td>15SF 6SF 9SF 9SF 9SF 9SF 9SF 15SF 10SF 10SF 15SF 10SF 6SF 15SF 15SF 15SF 15SF 15SF</td> <td></td> <td></td>	N/A W1 N/A N/A N/A N/A W1 W3 W3 W3 W3 W1 W3 N/A W1 W2 W3 W4	N/A N/A NA NA NA Door Frame NA NA NA Columns Radiator NA Door Frame Columns Radiator NA Door Frame Columns Radiator NA NA Door Frame Columns Radiator NA NA Door Frame Columns Radiator NA NA Door Frame	NIA NIA Metal NIA NIA NIA NIA Concrete Metal Concrete Metal N/A Metal Concrete Metal N/A Metal Concrete Metal N/A Metal Concrete Metal N/A Metal N/A Metal Concrete Metal N/A Metal	N/A N/A Brown N/A N/A N/A N/A Brown Tan Brown Tan Brown N/A Brown Tan Brown N/A Brown Tan Brown N/A Brown N/A Brown N/A Brown N/A Brown N/A Brown	NA Chipping N/A N/A N/A N/A N/A N/A Chipping N/A Chipping Chipping Chipping Chipping Chipping Chipping N/A Chipping N/A	N/A N/A N/A N/A N/A N/A N/A N/A N/A N/A	N/A 0 0.2 0 -0.1 N/A 0 0.1 0 N/A 0.1 0 N/A 0.2 0 N/A N/A N/A N/A	15SF 6SF 9SF 9SF 9SF 9SF 9SF 15SF 10SF 10SF 15SF 10SF 6SF 15SF 15SF 15SF 15SF 15SF		
7260 217 Classroom 200A 7260 217 Classroom 200A 7260 201 Classroom 201 7260 200 Classroom 202 7260 200 Classroom 203 7260 203 Classroom 203 7260 203 Classroom 203 7260 204 Classroom 204 7260 204 Classroom 204 </td <td>N/A W1 N/A N/A N/A N/A N/A W1 W3 W3 W3 W3 W1 W3 W1 W3 W1 W3 N/A N/A W1 W3 N/A W1 W3 N/A W1 W2 W3</td> <td>N/A N/A N/A N/A N/A N/A N/A N/A N/A N/A</td> <td>N/A N/A N/A N/A N/A N/A N/A N/A Tan N/A N/A N/A N/A Tan Tan Tan</td> <td>N/A N/A N/A N/A N/A N/A N/A N/A N/A N/A</td> <td>N/A N/A N/A N/A N/A N/A N/A N/A N/A N/A</td> <td>N/A N/A N/A N/A N/A N/A N/A N/A N/A N/A</td> <td>N/A N/A N/A N/A N/A N/A N/A N/A N/A N/A</td> <td>NA NA NA Door Frame NA NA NA Columns Radiator NA Door Frame Columns Radiator NA Door Frame Columns Radiator NA NA Door Frame Columns Radiator NA NA Door Frame Columns Radiator NA NA Door Frame</td> <td>NIA NIA Metal NIA NIA NIA NIA Concrete Metal Concrete Metal N/A Metal Concrete Metal N/A Metal Concrete Metal N/A Metal Concrete Metal N/A Metal N/A Metal Concrete Metal N/A Metal</td> <td>N/A N/A Brown N/A N/A N/A N/A Brown Tan Brown Tan Brown N/A Brown Tan Brown N/A Brown Tan Brown N/A Brown N/A Brown N/A Brown N/A Brown N/A Brown</td> <td>NA Chipping N/A N/A N/A N/A N/A N/A Chipping N/A Chipping Chipping Chipping Chipping Chipping Chipping N/A Chipping N/A N/A</td> <td>N/A N/A N/A N/A N/A N/A N/A N/A N/A N/A</td> <td>N/A N/A 0 0.2 0 -0.1 N/A 0 0.1 0 N/A 0.1 0 N/A 0.2 0 N/A N/A N/A N/A</td> <td>15SF 6SF 9SF 9SF 6SF 15SF 9SF 9SF 15SF 10SF 15SF 10SF 6SF 6SF 25SF 25SF 25SF 25SF 25SF 6SF</td> <td></td> <td></td>	N/A W1 N/A N/A N/A N/A N/A W1 W3 W3 W3 W3 W1 W3 W1 W3 W1 W3 N/A N/A W1 W3 N/A W1 W3 N/A W1 W2 W3	N/A N/A N/A N/A N/A N/A N/A N/A N/A N/A	N/A N/A N/A N/A N/A N/A N/A N/A Tan N/A N/A N/A N/A Tan Tan Tan	N/A	N/A NA NA NA Door Frame NA NA NA Columns Radiator NA Door Frame Columns Radiator NA Door Frame Columns Radiator NA NA Door Frame Columns Radiator NA NA Door Frame Columns Radiator NA NA Door Frame	NIA NIA Metal NIA NIA NIA NIA Concrete Metal Concrete Metal N/A Metal Concrete Metal N/A Metal Concrete Metal N/A Metal Concrete Metal N/A Metal N/A Metal Concrete Metal N/A Metal	N/A N/A Brown N/A N/A N/A N/A Brown Tan Brown Tan Brown N/A Brown Tan Brown N/A Brown Tan Brown N/A Brown N/A Brown N/A Brown N/A Brown N/A Brown	NA Chipping N/A N/A N/A N/A N/A N/A Chipping N/A Chipping Chipping Chipping Chipping Chipping Chipping N/A Chipping Ta</td> <td>NA Chipping N/A N/A N/A N/A N/A Chipping Chipping Chipping Chipping Chipping Chipping Chipping N/A Chipping N/A N/A N/A N/A N/A N/A N/A N/A Chipping Chipping N/A Chipping Chipping Chipping Chipping Chipping</td> <td>N/A N/A N/A N/A N/A N/A N/A N/A N/A N/A</td> <td>N/A N/A N/A N/A N/A N/A N/A N/A N/A 0 0.2 0 -0.1 N/A 0 0.1 0.1 0.1 0.1 0.1 0.1 0.1 0.1 0.1 0.1 0.1 0.1 0.1 0.1 0.1 0.2 0 N/A N/A N/A N/A N/A N/A N/A N/A N/A</td> <td>15SF 6SF 9SF 6SF 15SF 9SF 9SF 9SF 9SF 6SF 15SF 10SF 6SF 15SF 15SF 2SSF 15SF 2SSF 2SSF</td> <td></td> <td></td>	N/A W1 N/A N/A N/A N/A N/A W1 W3 W3 W4 W1 W3 W3 N/A W1 W3 N/A N/A N/A N/A N/A W1 W2 W3 W4 Celling	N/A	N/A NA NA NA Door Frame NA NA NA NA Door Frame Columns Radiator NA Door Frame Columns Radiator NA NA Door Frame Columns Radiator NA NA Door Frame Columns Radiator NA NA Door Frame Columns Radiator NA NA Door Frame Columns Columns	NIA NIA Metal NIA NIA NIA NIA Concrete Metal Concrete Metal Concrete Metal Concrete Metal N/A N/A Metal Concrete Metal N/A N/A Metal Concrete N/A Metal Concrete N/A Metal Concrete N/A Metal Concrete N/A Metal Concrete N/A Metal Concrete Concrete Concrete Concrete Concrete Concrete Concrete N/A	N/A N/A Brown N/A N/A N/A N/A Tan Brown Tan Brown N/A Brown Tan Brown N/A Brown Tan Tan Brown N/A Brown Tan Tan Brown N/A Brown Tan Tan Tan Tan Tan Tan Brown Tan Tan Tan Tan Tan Brown Tan Tan Tan Tan Tan Brown Tan Tan Tan Tan Tan Tan Tan Tan Tan Ta	NA Chipping N/A N/A N/A N/A N/A Chipping Chipping Chipping Chipping Chipping Chipping Chipping N/A Chipping N/A N/A N/A N/A N/A N/A N/A N/A Chipping Chipping N/A Chipping Chipping Brown N/A Brown Tan Brown N/A Brown Tan Brown N/A Brown Tan Brown Tan Brown Tan Brown Tan Brown Tan Brown Tan Brown Tan Brown</td> <td>NA Chipping N/A N/A N/A N/A N/A N/A Chipping N/A N/A N/A N/A N/A N/A N/A N/A Chipping Chipping Chipping Chipping Chipping Chipping Chipping Chipping Chipping</td> <td>N/A N/A N/A N/A N/A N/A N/A N/A N/A N/A</td> <td>N/A N/A 0 0.2 0 0.1 0 N/A N/A 0.1 0 N/A 0.2 0 N/A N/A</td> <td>15SF 6SF 9SF 9SF 6SF 15SF 9SF 9SF 6SF 15SF 10SF 10SF 6SF 15SF 10SF 15SF 15SF 15SF 25SF 25SF 25SF 25SF 25SF</td> <td></td> <td></td>	N/A W1 N/A N/A N/A N/A W1 W1 W1 W1 W1 W3 W3 N/A W1 W3 N/A N/A N/A N/A N/A N/A W1 W2 W3	N/A	N/A NA NA NA Door Frame NA NA NA NA Columns Radiator N/A Door Frame Columns Radiator N/A Door Frame Columns Radiator N/A N/A Door Frame Columns Radiator N/A Door Frame Columns N/A N/A Door Frame Columns N/A Door Frame	NIA NIA Metal NIA NIA NIA NIA Concrete Metal Concrete Metal N/A Metal Concrete Metal N/A Metal Concrete Metal N/A Metal Concrete Metal N/A Metal Concrete Metal N/A Metal Concrete Metal N/A Metal Concrete Metal N/A Metal Concrete Metal M/A Metal Concrete Metal M/A Metal M/A Metal M/A Metal M/A Metal Metal	N/A N/A Brown N/A N/A N/A N/A Tan Brown Tan Brown Tan Brown N/A Brown Tan Brown N/A Brown Tan Brown N/A Brown Tan Brown Tan Brown Tan Brown Tan Brown Tan Brown Tan Brown Tan Brown	NA Chipping N/A N/A N/A N/A N/A N/A Chipping N/A N/A N/A N/A N/A N/A N/A N/A Chipping Chipping Chipping Chipping Chipping Chipping Chipping Chipping Chipping	N/A N/A N/A N/A N/A N/A N/A N/A N/A N/A	N/A 0 0.2 0 0.1 0 N/A N/A 0.1 0 N/A 0.2 0 N/A	15SF 6SF 9SF 9SF 6SF 15SF 9SF 9SF 6SF 15SF 10SF 10SF 6SF 15SF 10SF 15SF 15SF 15SF 25SF 25SF 25SF 25SF 25SF		
Chipping Chipping</td> <td>N/A N/A N/A N/A N/A N/A N/A N/A N/A N/A</td> <td>N/A N/A 0 0.2 0 0.1 0 N/A N/A</td> <td>155F 65F 95F 95F 95F 95F 95F 155F 95F 155F 105F 155F 155F 255F 255F 255F 255F 255F</td> <td></td> <td></td>	N/A W1 N/A N/A N/A N/A N/A N/A W1 W3 W3 W3 W1 W3 W1 W3 N/A N/A N/A W1 W3 N/A W1 W3 N/A W1 W3 N/A W1 W3 W1 W3 W1 W2 W3 W4 Celling W1 W2 W3 W3 W3	N/A	N/A	NA NA NA Door Frame NA NA NA NA Door Frame Columns Radiator N/A Door Frame Columns Radiator N/A N/A Door Frame Columns Radiator N/A N/A N/A N/A N/A N/A N/A N/A N/A N/A	NIA NIA Metal NIA NIA NIA NIA Concrete Metal Concrete Metal N/A Metal Concrete Metal N/A Metal Concrete Metal N/A Metal Concrete Metal N/A Metal Concrete Metal N/A Metal Concrete Metal N/A Metal Concrete Metal N/A Metal N/A Metal N/A Metal N/A Metal N/A Metal N/A Metal N/A Metal N/A Metal	NIA NIA NIA Brown NIA NIA NIA NIA Tan Brown Tan Brown Tan Brown Tan Brown Tan Brown Tan NIA NIA Brown Tan Tan Tan Tan Tan Brown Tan Tan Tan Tan Tan Brown Tan Tan Tan Tan Brown Tan Tan Tan Tan Tan Brown Tan Tan Tan Tan Tan Tan Tan Tan Tan Ta	NA Chipping N/A N/A N/A N/A N/A Chipping Chipping Chipping Chipping Chipping Chipping Chipping N/A Chipping Chipping Chipping Chipping Chipping Chipping Chipping Chipping Chipping N/A N/A N/A N/A N/A N/A N/A N/A Chipping	N/A N/A N/A N/A N/A N/A N/A N/A N/A N/A	N/A 0 0.2 0 0.1 0 N/A	155F 65F 95F 95F 95F 95F 95F 155F 95F 155F 105F 155F 155F 255F 255F 255F 255F 255F		
7260 217 Classroom 200A 7260 217 Classroom 200A 7260 201 Classroom 201 7260 200 Classroom 202 7260 200 Classroom 202 7260 200 Classroom 202 7260 200 Classroom 202 N/A N/A N/A N/A N/A N/A N/A</td> <td>N/A N/A 0 0.2 0 0.1 0 N/A N/A</td> <td>155F 65F 95F 95F 95F 95F 95F 155F 95F 155F 105F 155F 155F 255F 255F 255F 255F 255F</td> <td></td> <td></td>	N/A W1 N/A N/A N/A N/A N/A N/A W1 W3 W3 W3 W1 W3 N/A N/A W1 W3 W4 Ceiling W3 W3 W3 W3 W3 W4 Ceiling W3 W3 W3 W4	N/A	N/A	NA NA NA Door Frame NA NA NA NA Door Frame Columns Radiator N/A Door Frame Columns Radiator N/A N/A Door Frame Columns Radiator N/A N/A N/A N/A N/A N/A N/A N/A N/A N/A	NIA NIA Metal NIA NIA NIA NIA Concrete Metal Concrete Metal N/A Metal Concrete Metal N/A Metal Concrete Metal N/A Metal Concrete Metal N/A Metal Concrete Metal N/A Metal Concrete Metal N/A Metal Concrete Metal N/A Metal N/A Metal N/A Metal N/A Metal N/A Metal N/A Metal N/A Metal N/A Metal	NIA NIA NIA Brown NIA NIA NIA NIA Tan Brown Tan Brown Tan Brown Tan Brown Tan Brown Tan NIA NIA Brown Tan Tan Tan Tan Tan Brown Tan Tan Tan Tan Tan Brown Tan Tan Tan Tan Brown Tan Tan Tan Tan Tan Brown Tan Tan Tan Tan Tan Tan Tan Tan Tan Ta	NA Chipping N/A N/A N/A N/A N/A Chipping Chipping Chipping Chipping Chipping Chipping Chipping N/A Chipping Chipping Chipping Chipping Chipping Chipping Chipping Chipping Chipping N/A N/A N/A N/A N/A N/A N/A N/A Chipping	N/A N/A N/A N/A N/A N/A N/A N/A N/A N/A	N/A 0 0.2 0 0.1 0 N/A	155F 65F 95F 95F 95F 95F 95F 155F 95F 155F 105F 155F 155F 255F 255F 255F 255F 255F		
7260 217 Classroom 200A 7260 217 Classroom 200A 7260 201 Classroom 201 7260 200 Classroom 202 7260 200 Classroom 203 7260 203 Classroom 203 7260 203 Classroom 203 7260 203 Classroom 203 7260 204 Classroom 204 7260 204 Classroom 204 7260 Metal Concrete Metal N/A Metal Concrete N/A N/A Metal Concrete Metal N/A Metal Concrete Metal N/A Metal Concrete Metal N/A Metal Concrete Metal</td> <td>NIA NIA NIA Brown NIA NIA NIA NIA NIA Brown Tan Brown Tan Brown Tan Brown Tan Brown Tan Tan Brown Tan Tan Brown Tan Tan Brown Tan Tan Brown Tan Tan Brown Tan Tan Brown Tan Tan Brown Tan Brown Tan Brown Tan Brown Brown</td> <td>NA Chipping N/A N/A N/A N/A N/A Chipping</td> <td>N/A N/A N/A N/A N/A N/A N/A N/A N/A N/A</td> <td>N/A N/A 0 0.2 0 0.1 0 N/A N/A</td> <td>155F 65F 95F 95F 65F 155F 95F 155F 105F 105F 105F 65F 155F 155F 155F 255F</td> <td></td> <td></td>	N/A W1 N/A N/A N/A N/A N/A W1 W3 W3 W3 W3 W3 N/A W1 W2 W3 N/A W1 W2 W3 W4 Ceiling W4 Ceiling W1 W2	N/A	N/A N/A N/A N/A N/A N/A N/A N/A Tan N/A N/A N/A Tan Tan Tan Tan Tan Tan Tan	N/A	N/A NA NA NA Door Frame NA NA NA NA Columns Columns Radiator N/A Door Frame Columns Radiator N/A N/A Door Frame Columns Radiator N/A Door Frame Columns Radiator N/A N/A N/A N/A N/A N/A N/A N/A N/A N/A	N/A N/A Metal N/A N/A N/A Concrete Metal Concrete Metal N/A Metal Concrete Metal N/A Metal Concrete Metal N/A Metal Concrete N/A N/A Metal Concrete Metal N/A Metal Concrete Metal N/A Metal Concrete Metal N/A Metal Concrete Metal	NIA NIA NIA Brown NIA NIA NIA NIA NIA Brown Tan Brown Tan Brown Tan Brown Tan Brown Tan Tan Brown Tan Tan Brown Tan Tan Brown Tan Tan Brown Tan Tan Brown Tan Tan Brown Tan Tan Brown Tan Brown Tan Brown Tan Brown Brown	NA Chipping N/A N/A N/A N/A N/A Chipping	N/A N/A N/A N/A N/A N/A N/A N/A N/A N/A	N/A 0 0.2 0 0.1 0 N/A	155F 65F 95F 95F 65F 155F 95F 155F 105F 105F 105F 65F 155F 155F 155F 255F		
<td>N/A N/A 0 0 0 0 0 0 0 0.1 0 N/A <td< td=""><td>15SF 6SF 9SF 9SF 6SF 15SF 9SF 9SF 6SF 15SF 10SF 10SF 6SF 15SF 10SF 15SF 25SF 25SF 25SF 25SF 25SF 15SF 25SF 25SF 25SF 25SF 25SF 25SF 25SF 2</td><td></td><td></td></td<></td>	N/A W1 N/A N/A N/A N/A W1 W3 W3 W3 W3 W3 N/A W1 W3 N/A W1 W3 N/A W1 W3 N/A N/A N/A W1 W3 W4 Celling W1 W2 W3 W4 Celling W1 W2 W3 W4 Celling W1 W2 W3	N/A	N/A	NA NA NA Door Frame Columns Radiator NA Door Frame Columns Radiator NA Door Frame Columns Radiator NA NA Door Frame Columns Radiator NA NA Door Frame Columns Radiator NA NA Door Frame Columns NA Door Frame Columns	NIA NIA Metal NIA NIA NIA NIA Concrete Metal Concrete Metal NIA Metal Concrete Metal NIA Metal Concrete Metal NIA Metal Concrete Metal NIA Metal Concrete Metal NIA Metal Concrete Metal NIA Metal Concrete Metal NIA Metal Concrete Metal MIA Metal Concrete Metal Metal	N/A N/A Brown N/A N/A N/A N/A Tan Brown Tan Brown Tan Brown N/A Brown Tan Brown N/A Brown Tan Brown N/A Brown Tan Brown Tan Brown Tan Brown Tan Tan Brown Tan Tan Brown Tan Tan Brown Tan Tan Brown Tan Tan Tan Brown	NA Chipping N/A N/A N/A N/A N/A N/A Chipping Chipping	N/A N/A N/A N/A N/A N/A N/A N/A N/A N/A	N/A 0 0 0 0 0 0 0 0.1 0 N/A N/A <td< td=""><td>15SF 6SF 9SF 9SF 6SF 15SF 9SF 9SF 6SF 15SF 10SF 10SF 6SF 15SF 10SF 15SF 25SF 25SF 25SF 25SF 25SF 15SF 25SF 25SF 25SF 25SF 25SF 25SF 25SF 2</td><td></td><td></td></td<>	15SF 6SF 9SF 9SF 6SF 15SF 9SF 9SF 6SF 15SF 10SF 10SF 6SF 15SF 10SF 15SF 25SF 25SF 25SF 25SF 25SF 15SF 25SF 25SF 25SF 25SF 25SF 25SF 25SF 2		
7260 217 Classroom 200A 7260 217 Classroom 200A 7260 201 Classroom 201 7260 201 Classroom 202 7260 200 Classroom 203 7260 203 Classroom 203 7260 203 Classroom 203 7260 203 Classroom 203 7260 204 Classroom 204 7260 204 Classroom 204 7260 204 Classroom 204 7260 204 Classroom 206 7260 206 Classroom 206 </td <td>N/A W1 N/A N/A N/A N/A N/A W1 W3 W3 W3 W3 W3 N/A W1 W2 W3 N/A W1 W2 W3 W4 Ceiling W4 Ceiling W1 W2</td> <td>N/A N/A N/A N/A N/A N/A N/A N/A N/A N/A</td> <td>N/A N/A N/A N/A N/A N/A N/A N/A N/A N/A</td> <td>N/A N/A N/A N/A N/A N/A N/A N/A N/A N/A</td> <td>N/A N/A N/A N/A N/A N/A N/A N/A N/A N/A</td> <td>N/A N/A N/A N/A N/A N/A N/A N/A N/A N/A</td> <td>N/A N/A N/A N/A N/A N/A N/A N/A N/A N/A</td> <td>NA NA NA Door Frame NA NA NA NA Columns Columns Radiator N/A Door Frame Columns Radiator N/A N/A Door Frame Columns Radiator N/A Door Frame Columns Radiator N/A N/A N/A N/A N/A N/A W4 Ceiling W1 W2	N/A	N/A	NA NA NA Door Frame NA NA NA NA Columns Columns Radiator N/A Door Frame Columns Radiator N/A N/A Door Frame Columns Radiator N/A Door Frame Columns Radiator N/A N/A N/A N/A N/A N/A N/A N/A N/A N/A	NIA NIA Metal NIA NIA NIA NIA Metal Concrete Metal N/A Metal Concrete Metal N/A Metal Concrete Metal N/A Metal Concrete N/A N/A Metal Concrete Metal N/A Metal Concrete Metal N/A Metal Concrete Metal N/A Metal Concrete Metal	NIA NIA NIA Brown NIA NIA NIA NIA NIA Brown Tan Brown Tan Brown Tan Brown Tan Brown Tan Tan Brown Tan Tan Brown Tan Tan Brown Tan Tan Brown Tan Tan Brown Tan Tan Brown Tan Tan Brown Tan Brown Tan Brown Tan Brown Brown	NA Chipping N/A N/A N/A N/A N/A Chipping	N/A N/A N/A N/A N/A N/A N/A N/A N/A N/A	N/A 0 0.2 0 0.1 0 N/A	155F 65F 95F 95F 65F 155F 95F 155F 105F 105F 105F 65F 155F 155F 155F 255F		
7260 217 Classroom 200A 7260 217 Classroom 200A 7260 201 Classroom 201 7260 201 Classroom 202 7260 200 Classroom 203 7260 203 Classroom 203 7260 203 Classroom 203 7260 204 Classroom 204 7260 204 Classroom 204 7260 204 Classroom 204 7260 204 Classroom 204 7260 204 Classroom 206 7260 206 Classroom 206 </td <td>N/A W1 N/A N/A N/A N/A N/A W1 W3 W3 W3 W3 W3 W1 W3 W3 W1 W3 W3 N/A N/A W1 W3 N/A N/A N/A N/A N/A W1 W3 N/A N/A N/A N/A N/A N/A W1 W2 W3 W4 Ceiling W1 W2 W3 W4 Ceiling W1 W2 W3</td> <td>N/A N/A N/A N/A N/A N/A N/A N/A N/A N/A</td> <td>N/A N/A N/A N/A N/A N/A N/A N/A N/A N/A</td> <td>N/A N/A N/A N/A N/A N/A N/A N/A N/A N/A</td> <td>N/A N/A N/A N/A N/A N/A N/A N/A N/A N/A</td> <td>N/A N/A N/A N/A N/A N/A N/A N/A N/A N/A</td> <td>N/A N/A N/A N/A N/A N/A N/A N/A N/A N/A</td> <td>NA NA NA Door N/A N/A</td> <td>N/A N/A 0 0 0 0 0 0 0 0.1 0 N/A <td< td=""><td>15SF 6SF 9SF 9SF 6SF 15SF 9SF 9SF 6SF 15SF 10SF 10SF 6SF 15SF 10SF 15SF 25SF 25SF 25SF 25SF 25SF 15SF 25SF 25SF 25SF 25SF 25SF 25SF 25SF 2</td><td></td><td></td></td<></td>	N/A W1 N/A N/A N/A N/A N/A W1 W3 W3 W3 W3 W3 W1 W3 W3 W1 W3 W3 N/A N/A W1 W3 N/A N/A N/A N/A N/A W1 W3 N/A N/A N/A N/A N/A N/A W1 W2 W3 W4 Ceiling W1 W2 W3 W4 Ceiling W1 W2 W3	N/A	N/A	NA NA NA Door Frame Columns Radiator NA Door Frame Columns Radiator NA Door Frame Columns Radiator NA NA Door Frame Columns Radiator NA NA Door Frame Columns Radiator NA NA Door Frame Columns NA Door Frame Columns	NIA NIA Metal NIA NIA NIA NIA Concrete Metal Concrete Metal NIA Metal Concrete Metal NIA Metal Concrete Metal NIA Metal Concrete Metal NIA Metal Concrete Metal NIA Metal Concrete Metal NIA Metal Concrete Metal NIA Metal Concrete Metal MIA Metal Concrete Metal Metal	N/A N/A Brown N/A N/A N/A N/A Tan Brown Tan Brown Tan Brown N/A Brown Tan Brown N/A Brown Tan Brown N/A Brown Tan Brown Tan Brown Tan Brown Tan Tan Brown Tan Tan Brown Tan Tan Brown Tan Tan Brown Tan Tan Tan Brown	NA Chipping N/A N/A N/A N/A N/A N/A Chipping Chipping	N/A N/A N/A N/A N/A N/A N/A N/A N/A N/A	N/A 0 0 0 0 0 0 0 0.1 0 N/A N/A <td< td=""><td>15SF 6SF 9SF 9SF 6SF 15SF 9SF 9SF 6SF 15SF 10SF 10SF 6SF 15SF 10SF 15SF 25SF 25SF 25SF 25SF 25SF 15SF 25SF 25SF 25SF 25SF 25SF 25SF 25SF 2</td><td></td><td></td></td<>	15SF 6SF 9SF 9SF 6SF 15SF 9SF 9SF 6SF 15SF 10SF 10SF 6SF 15SF 10SF 15SF 25SF 25SF 25SF 25SF 25SF 15SF 25SF 25SF 25SF 25SF 25SF 25SF 25SF 2		

B B																
1 1 </td <td>7260 203 Classroom 211 Coat Closet</td> <td>Ceiling</td> <td>Sheetrock</td> <td>White</td> <td>None</td> <td>1</td> <td>0.1</td> <td></td> <td>1 1</td> <td></td> <td></td> <td></td> <td></td> <td></td> <td>25SF</td> <td></td>	7260 203 Classroom 211 Coat Closet	Ceiling	Sheetrock	White	None	1	0.1		1 1						25SF	
DAM DAM <thdam< th=""> <thdam< th=""> <thdam< th=""></thdam<></thdam<></thdam<>	7260 214 Classroom 212	W1	Concrete	Tan	None				Door Frame	Metal	Brown	Chipping		0	6SF	
1 1 0	7260 214 Classroom 212	W2	Concrete	Tan	None		-0.1								25SF	
		W3							Columns	Concrete	Tan	Chipping		-0.3	15SF	
PAC PAC PAC PAC PAC <td></td> <td></td> <td>Concrete</td> <td>Tan</td> <td>None</td> <td></td> <td>-0.3</td> <td></td> <td></td> <td></td> <td></td> <td></td> <td></td> <td></td> <td></td> <td></td>			Concrete	Tan	None		-0.3									
No. No. <td></td> <td>25SF</td> <td></td>															25SF	
No. No. <td></td> <td></td> <td></td> <td></td> <td>Chipping</td> <td></td> <td></td> <td></td> <td>Door Frame</td> <td>Metal</td> <td></td> <td></td> <td></td> <td></td> <td></td> <td></td>					Chipping				Door Frame	Metal						
Cont Cont Cont Cont C					Chipping				Door maine	Fictur						
No. No. <td></td> <td></td> <td>CONCIECE</td> <td>Tall</td> <td>Chipping</td> <td></td> <td>-0.2</td> <td></td> <td>Columns</td> <td>Concroto</td> <td></td> <td></td> <td></td> <td></td> <td>1505</td> <td></td>			CONCIECE	Tall	Chipping		-0.2		Columns	Concroto					1505	
No. No. <td></td> <td></td> <td>O</td> <td>Tere</td> <td>Chinaina</td> <td></td> <td>0.1</td> <td></td> <td>Columns</td> <td>concrete</td> <td></td> <td></td> <td></td> <td></td> <td></td> <td></td>			O	Tere	Chinaina		0.1		Columns	concrete						
No. No. </td <td></td> <td>Ceiling</td> <td></td> <td></td> <td>None</td> <td></td> <td>0.1</td> <td></td> <td></td> <td></td> <td></td> <td></td> <td></td> <td></td> <td>25SF</td> <td></td>		Ceiling			None		0.1								25SF	
Desc Desc <thdesc< th=""> Desc Desc De</thdesc<>								N/A					N/A			
Des Des <td>7260 100A Counselor's Office 106</td> <td>N/A</td> <td></td> <td></td>	7260 100A Counselor's Office 106	N/A	N/A	N/A	N/A	N/A	N/A	N/A	N/A	N/A	N/A	N/A	N/A	N/A		
Desc Desc Desc Desc D		N/A	N/A	N/A	N/A	N/A	N/A	N/A	N/A	N/A	N/A	N/A	N/A	N/A		
DDD CDD CDD CDD CDD CDD <td>7260 100A Counselor's Office 106</td> <td>N/A</td> <td></td> <td></td>	7260 100A Counselor's Office 106	N/A	N/A	N/A	N/A	N/A	N/A	N/A	N/A	N/A	N/A	N/A	N/A	N/A		
Dia Dia <thdia< th=""> <thdia< th=""> <thdia< th=""></thdia<></thdia<></thdia<>											1					
Control Control <t< td=""><td></td><td></td><td></td><td></td><td></td><td></td><td></td><td></td><td></td><td></td><td></td><td></td><td></td><td></td><td></td><td></td></t<>																
		N/A	N/A		N/A	N/A	N/A		N/A	N/A	N/A		N/A			
B C <thc< th=""> C <thc< th=""> <thc< th=""></thc<></thc<></thc<>	7260 C2 Crawl Space under Auditorium	N/A	N/A	N/A	N/A	N/A	N/A	N/A	N/A	N/A	N/A	N/A	N/A	N/A		
1 00 0 00 <th< td=""><td>7260 C2 Crawl Space under Auditorium</td><td>N/A</td><td>N/A</td><td>N/A</td><td>N/A</td><td>N/A</td><td>N/A</td><td>N/A</td><td>N/A</td><td>N/A</td><td>N/A</td><td>N/A</td><td>N/A</td><td>N/A</td><td></td><td></td></th<>	7260 C2 Crawl Space under Auditorium	N/A	N/A	N/A	N/A	N/A	N/A	N/A	N/A	N/A	N/A	N/A	N/A	N/A		
Dial Origo Dial Dial <thdia< th=""> Dial Dial <thd< td=""><td>7260 C2 Crawl Space under Auditorium</td><td>N/A</td><td>N/A</td><td>N/A</td><td>N/A</td><td>N/A</td><td>N/A</td><td></td><td>N/A</td><td>N/A</td><td>N/A</td><td>N/A</td><td>N/A</td><td></td><td></td><td></td></thd<></thdia<>	7260 C2 Crawl Space under Auditorium	N/A	N/A	N/A	N/A	N/A	N/A		N/A	N/A	N/A	N/A	N/A			
Del Operation of the sector of control operation of the sector of the sect	7260 C2 Crawl Space under Auditorium	N/A	N/A	N/A	N/A	N/A	N/A	N/A	N/A	N/A	N/A		N/A			
DB Col Dec decomposition decomposition NA													N/A			
DB Col Dec decomposition decomposition NA		N/A	N/A	N/A	N/A	N/A	N/A	N/A	N/A	N/A	N/A		N/A			
100 101 <td></td>																
Physe Norw No. No.<																
Physe Norw No. No.<										N/A			N/A			
100 100 <td></td> <td></td> <td></td> <td></td> <td></td> <td></td> <td></td> <td></td> <td></td> <td>N/A</td> <td></td> <td></td> <td></td> <td></td> <td></td> <td></td>										N/A						
Proc Proc <th< td=""><td></td><td></td><td></td><td></td><td></td><td></td><td></td><td></td><td></td><td>N/A</td><td></td><td></td><td></td><td></td><td></td><td></td></th<>										N/A						
Proc Proc <th< td=""><td></td><td>N/A</td><td>N/A</td><td>N/A</td><td>N/A</td><td>N/A</td><td></td><td>N/A</td><td>N/A</td><td>N/A</td><td>N/A</td><td></td><td>N/A</td><td>N/A</td><td></td><td></td></th<>		N/A	N/A	N/A	N/A	N/A		N/A	N/A	N/A	N/A		N/A	N/A		
Theory State of theory NA NA <td>7260 112D Equipment Storage for Gymnasium</td> <td>N/A</td> <td>N/A</td> <td>N/A</td> <td>N/A</td> <td>N/A</td> <td></td> <td>N/A</td> <td>N/A</td> <td>N/A</td> <td>N/A</td> <td></td> <td>N/A</td> <td>N/A</td> <td></td> <td></td>	7260 112D Equipment Storage for Gymnasium	N/A	N/A	N/A	N/A	N/A		N/A	N/A	N/A	N/A		N/A	N/A		
1/20 203 0 below data we have have have have have have have hav	7260 112D Equipment Storage for Gymnasium	N/A	N/A	N/A	N/A	N/A	N/A	N/A	N/A	N/A	N/A	N/A	N/A	N/A		
1/10 203 Path how American Suber 301 004	7260 205 Fan Room Across from Room 203		N/A	N/A	N/A	N/A	N/A	N/A	N/A	N/A	N/A	N/A	N/A	N/A		
198 0.8 1.8 NA NA NA NA NA	7260 205 Fan Room Across from Room 203			N/A	N/A	N/A	N/A		N/A	N/A		N/A	N/A	N/A		
100 200 <td></td>																
Physic Sinterplane Sinterplane <t< td=""><td></td><td></td><td></td><td></td><td></td><td></td><td></td><td></td><td></td><td></td><td></td><td></td><td></td><td></td><td></td><td></td></t<>																
128 28 1 best best best best best best best best																
Dist Openant No.4 No.4 <																
1990 990 <td></td>																
158 0154																
Tool USA Greasan N/A N/	7260 105A Gymnasium															
1700 1710 <th< td=""><td>7260 105A Gymnasium</td><td>N/A</td><td>N/A</td><td>N/A</td><td>N/A</td><td>N/A</td><td>N/A</td><td>N/A</td><td>N/A</td><td>N/A</td><td>N/A</td><td>N/A</td><td>N/A</td><td>N/A</td><td></td><td></td></th<>	7260 105A Gymnasium	N/A	N/A	N/A	N/A	N/A	N/A	N/A	N/A	N/A	N/A	N/A	N/A	N/A		
P20 P13 Grin Betome MA	7260 105A Gymnasium	N/A	N/A	N/A	N/A	N/A	N/A	N/A	N/A	N/A	N/A	N/A	N/A	N/A		
1790 1791 Carlo Salonya NA	7260 215 Girl's Restroom											N/A				
1750 1751 1751 1751 1752 1751 1752 1751 1752 1751 1752 1751 1752 1751 1752 1751 <th< td=""><td></td><td></td><td></td><td></td><td></td><td></td><td></td><td></td><td>N/A</td><td>N/A</td><td></td><td></td><td>N/A</td><td></td><td></td><td></td></th<>									N/A	N/A			N/A			
120 210 216 <td></td> <td>N/A</td> <td></td> <td>N/A</td> <td></td> <td>N/A</td> <td></td> <td>N/A</td> <td></td> <td></td> <td>N/A</td> <td>N/A</td> <td></td> <td>N/A</td> <td></td> <td></td>		N/A		N/A		N/A		N/A			N/A	N/A		N/A		
Print Unit NiA NiA<													N/A			
1250 1936 One-Section NA NA NA NA NA	7260 215 Girls Restroom															
1700 1908 Oris Restorm N/A N/A N/A N/A </td <td></td>																
Prior UNA NA NA <th< td=""><td></td><td></td><td></td><td></td><td></td><td></td><td></td><td></td><td></td><td></td><td></td><td></td><td></td><td></td><td></td><td></td></th<>																
1290 217A 017A 01A NA NA NA </td <td></td> <td></td> <td></td> <td></td> <td>N/A</td> <td></td> <td></td> <td></td> <td>N/A</td> <td>N/A</td> <td></td> <td></td> <td>N/A</td> <td></td> <td></td> <td></td>					N/A				N/A	N/A			N/A			
1200 217A Girl Retorm NA		N/A	N/A					N/A			N/A	N/A		N/A		
1720 1713 0174 0174 N/A								N/A			N/A	N/A		N/A		
1780 113. Girb Restorm in Gymasian Oeing Concet With Nice 0.1 Image: Concet State		N/A	N/A	N/A	N/A	N/A	N/A	N/A	N/A	N/A	N/A	N/A	N/A	N/A		
128 112 0rb Baskoon in Ormakum NA NA NA NA NA<	7260 217A Girl's Restroom	N/A	N/A	N/A	N/A	N/A	N/A	N/A	N/A	N/A	N/A	N/A	N/A	N/A		
128 112 0rb Baskoon in Ormakum NA NA NA NA NA<		Ceiling	Concrete	White											25SF	
P260 112 Oymskum W1 Ocrorete Tan Charms Concrete Tan Flaking 0.3 155 ⁻ I I 7280 112 Gymskum W1 Ocrorete Tan Charms Ober Amelia Brown Chiping 0.3 155 ⁻ I I 7280 112 Gymskum W2 Correte Tan Chiping 0.1 Brown Chiping 0.3 657 I I 7280 112 Gymskum W2 - - Column Column Chiping I 0.3 657 I I 7280 112 Gymskum W3 Gorrete Tan Chiping Column Column Column Chiping I 0.2 155 ⁻ I I I 780 112 Gymskum W3 Correte Tan Chiping Gorrete Tan Chiping I I I I I						N/A		N/A	N/A	N/A	N/A	N/A	N/A	N/A	-	
P260 112 Oymskum W1 Ocrorete Tan Charms Concrete Tan Flaking 0.3 155 ⁻ I I 7280 112 Gymskum W1 Ocrorete Tan Charms Ober Amelia Brown Chiping 0.3 155 ⁻ I I 7280 112 Gymskum W2 Correte Tan Chiping 0.1 Brown Chiping 0.3 657 I I 7280 112 Gymskum W2 - - Column Column Chiping I 0.3 657 I I 7280 112 Gymskum W3 Gorrete Tan Chiping Column Column Column Chiping I 0.2 155 ⁻ I I I 780 112 Gymskum W3 Correte Tan Chiping Gorrete Tan Chiping I I I I I						N/A							N/A			
7260 112 Ormasian W1						1							,		15SE	
T260 T12 Openalum W2 Concete Tan Chlping -0.1 Door Fame Metal Brown Chlping 0.3 BSF Dest 7260 112 Gyrnasium W2 - - - Dest Dest <td< td=""><td></td><td></td><td>001101010</td><td></td><td>Cinpping</td><td>1</td><td>0.0</td><td></td><td></td><td></td><td></td><td></td><td></td><td></td><td></td><td></td></td<>			001101010		Cinpping	1	0.0									
7280 112 Operasium W2 Image: Market M			Concrete	Tan	Chipping	1	-0 1		Door		Brown			0.7		
Z80 112 Gyrnasium W2 Concrete Tan Chipping - Cancrete Ian Chipping - 0.3 155* - - 7280 112 Gyrnasium W3 -<			CONCIECE	ian	Chipping	+ +	0.1					Chipping	1			
P280 112 Gymmakum W3 Concrete Tan Chipping -0.1 SSF 7280 112 Gymmakum W3			+			+						Chipping	1			
T26 112 Gymnasium W3	7200 112 Gyrinasium	VV2	Cor	Terr	Chiralas	+	0.2			Motol		Chipping Chipping	1	0.3	1005	
720 112 Gymasium W3 W4 Concrete Tan Chipping 0.2 155F 720 112 Gymasium W4 Concrete Tan Chipping 0.2 155F 720 112 Gymasium Celling Concrete Tan Chipping 0.4 65F 720 112 Gymasium Celling Concrete Tan Chipping 0.1 0.4 65F 720 112 Gymasium Celling Concrete Tan Chipping 0.1 157F 720 112 Gymasium Celling Concrete Tan Chipping -0.1 255F 720 H4 Halway (B 103 W2 Shetrook Blue Chipping -0.1			Concrete	ran	Cnipping	+ +	-0.3									
PZ0 P12 Gymaskum Out M Concrete Tot Out Pace Pace <th< td=""><td></td><td></td><td></td><td></td><td></td><td></td><td></td><td></td><td></td><td></td><td></td><td></td><td>1</td><td></td><td></td><td></td></th<>													1			
T260 112 Symmasium W4 W4 V V V V Dor Frame Metal Brown Chipping 0.4 65F 7260 112 Symmasium Ceiling Concrete Ton Ohlping - 0.1 - - - - 25F - - - - - - - 25F - <td></td> <td>Chipping</td> <td>1</td> <td></td> <td></td> <td></td>												Chipping	1			
7260112GymnasiumOddOddGSFConcreteTanChipping-0.1Door FrameMetalBrownChipping0.4GSFConcreteSSFConcreteConcreteTanChipping-0.1ConcreteMainConcreteTanChipping-0.1ConcreteMainConcreteTanChipping-0.1ConcreteConcreteTanChipping-0.1Concrete			Concrete	Tan	Chipping		-0.2					Chipping				
P260 112 Gymasium Celling Concrete Tan Chipping -0.1 -0	7260 112 Gymnasium								Door Frame	Metal	Brown	Chipping		0.4		
7260112GymasiumCelingConcreteWhiteNone0.1ICICICIC255FICICIC7260114Hallway @ 103W2SheetrockTanChipping-0.1ICICICIC255FICICIC7260144Hallway @ 103W4SheetrockBlueChipping-0.1ICICICIC255FICICIC7260144Hallway @ 103W4SheetrockBlueChipping-0.1IC <td< td=""><td></td><td></td><td>Concrete</td><td>Tan</td><td>Chipping</td><td></td><td>-0.1</td><td></td><td></td><td></td><td></td><td></td><td></td><td></td><td>25SF</td><td></td></td<>			Concrete	Tan	Chipping		-0.1								25SF	
7260112GymasiumGymasiumImage: Construction of the state o																
T260H4Halway@103W2SheetrockTanChipping-0.1<			1			1 1			1				1		25.SF	
P20H4Halway@103W4Sheence the state of the st	7260 H4 Hallway @ 103	W2	Sheetrock	Tan	Chipping	+ +	-0.1		1				1		25SF	
T260 H4 Halway@Stair.B W2 Conce Tan None -0.3 Door Metal Brown Chipping N N SF I I 7260 H4 Halway N/A N/	7260 H4 Hallway @ 103					1			1				1			
7260 H4 Halway N/A N/A<						+ +			Door	Metal	Brown	Chipping	1	0		
P720H7HallwayN/A <t< td=""><td></td><td></td><td></td><td></td><td></td><td>N/A</td><td></td><td>N/A</td><td></td><td></td><td></td><td>N/A</td><td>NI/A</td><td>,</td><td>160</td><td></td></t<>						N/A		N/A				N/A	NI/A	,	160	
T260 H7 Hallway N/A <		IN/A							IN/A				N/A			
7260 H7 Halway N/A N/A <t< td=""><td>7260 H7 Hallway</td><td></td><td></td><td></td><td></td><td></td><td></td><td></td><td></td><td></td><td></td><td></td><td></td><td></td><td></td><td></td></t<>	7260 H7 Hallway															
T260 H1 and 109 N/A	1200 III IIdanidy											14/73				
7260 H1 and 109 N/A																
7260 H1 and 109 N/A	7260 H1 and 109															
7260 H1 and 109 N/A	7260 H1 and 109												N/A			
7260 H5 and 208 N/A													N/A			
7260 H5 and 208 N/A											N/A	N/A				
7260 H5 and 208 N/A					N/A		N/A		N/A	N/A			N/A			
7260 H6 and 212 N/A																
1200 110 on 212 11/A 11/A <t< td=""><td></td><td></td><td></td><td></td><td></td><td></td><td></td><td></td><td></td><td></td><td></td><td></td><td>N/A</td><td></td><td></td><td></td></t<>													N/A			
	7200 H6 and 212	N/A	N/A		N/A	N/A	N/A		N/A	N/A			N/A			
		IN/A	N/A	IN/A	N/A	IN/A	IN/A	IN/A	IN/A	IN/A	IN/A	IN/A	IN/A	IN/A		

7260	H6	and 212	N/A	N/A	N/A	N/A N/A	N/A N/A	N/A N/A	N/A N/A	N/A N/A	N/A	N/A	N/A	N/A N/A	N/A				
7260		Hallway outside Library	N/A		N/A	N/A	N/A	N/A	N/A										
7260	217B	Hallway outside Library	W1							Door	Metal	Brown	Chipping		0.1	8SF			
7260	217B	Hallway outside Library	N/A	N/A	N/A	N/A	N/A	N/A											
7260		Hallway outside Library	N/A	N/A	N/A	N/A	N/A	N/A											
7260	218	Head Librarian's Office	N/A	N/A	N/A	N/A	N/A	N/A											
7260		Head Librarian's Office	N/A	N/A	N/A	N/A	N/A	N/A											
7260		Head Librarian's Office	N/A	N/A	N/A	N/A	N/A	N/A											
7260		Home and School Office in Library	N/A	N/A N/A	N/A N/A	N/A	N/A	N/A	N/A	N/A N/A	N/A	N/A	N/A	N/A N/A	N/A				
			N/A	N/A N/A	N/A	N/A	N/A N/A	N/A	N/A	N/A N/A	N/A	N/A	N/A	N/A N/A	N/A				
7260		Home and School Office in Library																	
7260		Home and School Office in Library	N/A	N/A	N/A	N/A	N/A	N/A											
7260	216	IMC Office Room 200 B	N/A	N/A	N/A	N/A	N/A	N/A											
7260	216	IMC Office Room 200 B	N/A	N/A	N/A	N/A	N/A	N/A											
7260		IMC Office Room 200 B	N/A	N/A	N/A	N/A	N/A	N/A											
7260	100C	Infirmary	N/A	N/A	N/A	N/A	N/A	N/A											
7260	100C	Infirmary	N/A	N/A	N/A	N/A	N/A	N/A											
7260	100C	Infirmary	N/A	N/A	N/A	N/A	N/A	N/A											
7260	112C	Kitchen	N/A	N/A	N/A	N/A	N/A	N/A											
7260		Kitchen	N/A	N/A	N/A	N/A	N/A	N/A											
7260		Kitchen	N/A	N/A	N/A	N/A	N/A	N/A											
7260		Library	W1	Concrete	Brown	Flaking	,/	0		Columns	Concrete	Tan	Flaking		0.1	15SF			
7260		Library	W1	001101010	Brown	riaking		Ű		Door Frame	Metal	Brown	Chipping		0	6SF			
7260			W3									Tan	Flaking		0.1	15SF			
7260		Library Library	N/A	Columns N/A	Concrete N/A	N/A	N/A	N/A	0.1 N/A	1331	+								
																	-	\vdash	
7260		Library	N/A	N/A	N/A	N/A	N/A	N/A	├ ───	+	├								
7260		Mail Room	N/A	N/A N/A	N/A N/A	N/A	N/A N/A	N/A	N/A	N/A	N/A	N/A N/A	N/A	N/A	N/A	├ ───	+	├	
7260	100D		N/A			N/A		N/A	N/A	N/A	N/A		N/A	N/A	N/A		-		
7260		Mail Room	N/A	N/A	N/A	N/A	N/A	N/A		_									
7260	100E		N/A	N/A	N/A	N/A	N/A	N/A	I										
7260	100E	Main Office	N/A	N/A	N/A	N/A	N/A	N/A											
7260	100E		N/A	N/A	N/A	N/A	N/A	N/A											
7260	100E	Main Office	N/A	N/A	N/A	N/A	N/A	N/A											
7260		Main Office	N/A	N/A	N/A	N/A	N/A	N/A											
7260		Maintenance Staff Office	N/A	N/A	N/A	N/A	N/A	N/A											
7260	111B	Maintenance Staff Office	N/A	N/A	N/A	N/A	N/A	N/A											
7260	111B	Maintenance Staff Office	N/A	N/A	N/A	N/A	N/A	N/A											
7260	111B	Maintenance Staff Office	N/A	N/A	N/A	N/A	N/A	N/A											
7260	111B	Maintenance Staff Office	N/A	N/A	N/A	N/A	N/A	N/A											
7260	102A	Auditorium	N/A	N/A	N/A	N/A	N/A	N/A											
7260	102A	Auditorium	N/A	N/A	N/A	N/A	N/A	N/A											
7260	102A		N/A	N/A	N/A	N/A	N/A	N/A											
7260	109A	Classroom 100	N/A	N/A	N/A	N/A	N/A	N/A											
7260	109A	Classroom 100	N/A	N/A	N/A	N/A	N/A	N/A											
7260	1020	Principal's Office														l – – – – – – – – – – – – – – – – – – –	+	<u> </u> −	
7260		Principal's Office Restroom	N/A	N/A	N/A	N/A	N/A	N/A		-	\vdash								
7260	111A	Room 111 F Storage Stage Left	N/A	N/A N/A	N/A	N/A	N/A	N/A	N/A	├ ───	+	├							
7260	111A	Room 111 F Storage Stage Left	N/A		N/A	N/A	N/A	N/A	N/A	l									
7260	111A	Room 111 F Storage Stage Left	N/A	N/A	N/A	N/A	N/A	N/A	├ ───	+	├								
7260	111A	Room 111 F Storage Stage Left	N/A	N/A	N/A	N/A	N/A	N/A											
7260	111A	Room 111 F Storage Stage Left	N/A	N/A	N/A	N/A	N/A	N/A											
7260	211	Room 209 Faculty Lounge	N/A	N/A	N/A	N/A	N/A	N/A		-									
7260		Room 209 Faculty Lounge	N/A	N/A	N/A	N/A	N/A	N/A											
7260		Room 209 Faculty Lounge	N/A	N/A	N/A	N/A	N/A	N/A	I										
7260		107	N/A	N/A	N/A	N/A	N/A	N/A											
7260		107	N/A	N/A	N/A	N/A	N/A	N/A		-									
7260		107	N/A	N/A	N/A	N/A	N/A	N/A											
7260	111C	107	N/A	N/A	N/A	N/A	N/A	N/A											
7260		107													0.1	25SF			
7260		Stairs adjacent to Boiler Room	W2							Stair stringer	Metal	Grey	Chipping		0	12SF			
7260		Stairs adjacent to Boiler Room	W2							Hand rails	Metal	Grey	Chipping N/A			22SF			
7260		Stairs adjacent to Boiler Room	N/A	N/A	N/A		N/A	N/A											
7260		Stairs adjacent to Boiler Room	N/A	N/A	N/A	N/A	N/A	N/A											
7260		Stairs adjacent to Boiler Room	N/A	N/A	N/A	N/A	N/A	N/A											
7260	S3	105	W2							Stair stringer	Metal	Grey	Friction		0.1	12SF			
7260	S3	105	W2							Hand rails	Metal	Grey	Chipping		0	22SF			
7260	S3	105	N/A	N/A	N/A	N/A	N/A	N/A											
7260	S3	105	N/A	N/A	N/A	N/A	N/A	N/A											
7260		105	N/A	N/A	N/A	N/A	N/A	N/A											
7260	S2		N/A	N/A	N/A	N/A	N/A	N/A											
																· · · ·			

																-		
7260	S2	108	N/A															
7260	S2	108	N/A															
7260	S2	108	N/A															
7260	S2	108	N/A															
7260	S1	Stairwell adjacent to Gymnasium	N/A															
7260	S1	Stairwell adjacent to Gymnasium	N/A															
7260	103B	Storage	N/A															
7260	103B	Storage	N/A															
7260	103B	Storage	N/A															
7260	002B	Storage Room	N/A															
7260	002B	Storage Room	N/A															
7260	002B 005C	Storage Room adjacent Stairwell	N/A N/A	N/A N/A	N/A N/A	N/A	N/A N/A	N/A	N/A N/A	N/A N/A	N/A	N/A	N/A N/A	N/A	N/A N/A		I	1
7260	005C	Storage Room adjacent Stairwell	N/A	N/A N/A	N/A N/A	N/A	N/A	N/A N/A	N/A N/A	N/A N/A	N/A N/A	N/A N/A	N/A N/A	N/A N/A	N/A N/A			1
7260	005C	Storage Room adjacent Starwell	N/A N/A	N/A N/A	N/A N/A	N/A N/A	N/A N/A	N/A	N/A N/A	N/A N/A	N/A N/A	N/A N/A	N/A N/A	N/A N/A	N/A N/A			1
7260	003C	Room Stairwell	N/A	N/A N/A	N/A N/A	N/A	N/A N/A	N/A	N/A N/A	N/A N/A	N/A	N/A	N/A N/A	N/A	N/A N/A			
7260	206A	206	N/A	N/A N/A	N/A N/A	N/A	N/A	N/A N/A	N/A N/A	N/A N/A	N/A N/A	N/A N/A	N/A	N/A N/A	N/A N/A			
7260 7260	206A 206A	206	N/A N/A	N/A	N/A N/A													
				N/A														
7260	103A	Storage Room next to Supply Room	N/A															
7260	103A	Storage Room next to Supply Room	N/A															
7260	103A	Storage Room next to Supply Room	N/A															
7260	003B	Room	N/A															
7260	003B	Room	N/A															
7260	103	Supply Room	N/A															
7260	103	Supply Room	N/A															
7260	103	Supply Room	N/A															
7260	111	Teacher's Faculty Lounge	N/A															
7260	102D	Telecommunications Room	N/A															
7260	102D	Telecommunications Room	N/A															
7260	102D	Telecommunications Room	N/A			1												
7260	209	Women's Restroom	N/A															
7260	209	Women's Restroom	N/A															
7260	209	Women's Restroom	N/A															
7260	209	Women's Restroom	N/A															
7260	102B	Auditorium	N/A															
7260	102B	Auditorium	N/A		1													
7260	102B	Auditorium	N/A															
7260	102B	Auditorium	N/A		1													
7260	102B	Auditorium	N/A			1												
7260	102B	Auditorium	N/A	1		1												
7260	102B	Auditorium	N/A															
7260	102B	Classroom 100	N/A	N/A	N/A	N/A	N/A	N/A	N/A N/A	N/A	N/A	N/A	N/A	N/A	N/A N/A			1
7260	109B	Classroom 100	N/A	N/A N/A	N/A N/A	N/A	N/A	N/A	N/A N/A	N/A	N/A	N/A	N/A	N/A	N/A		I	1
7260	109B	Classroom 100	N/A	N/A	N/A	N/A	N/A	N/A	N/A N/A	N/A	N/A	N/A	N/A	N/A	N/A			1
1200	1030		N/A	IN/A	N/A	IN/A	N/A	N/A	13/75	19/74	N/A	N/A	IN/A	N/A	19/74		I	1
							1					1				1	1 1	1

			ROOM	FINISH SCH	EDULE				
						WALLS			
		COLOR			WALL	WAIN	SCOT	CEILING	
NUMBER	NAME	SCHEME	FLOOR	BASE	FINISH	FINISH	HEIGHT	FINISH	REMARKS
FIRST FLOOF	R							1	
100	KINDERGARTEN CLASSROOM	A	VCT	VB	PNT			ACT/PNT	R53, R77
100A	TOILET	G	PT	СТ	СТ			PNT	
100B	TOILET	G	PT	СТ	СТ			PNT	
100C	STORAGE	A	VCT	VB	PNT			ACT	
100D	STORAGE	A	VCT	VB	PNT			ACT	
102	PRE-K CLASSROOM	A	VCT	VB/EPX4	PNT			ACT/PNT	R53, R77
103	PRE-K CLASSROOM	A	VCT	VB/EPX4	PNT			ACT/PNT	R53, R77
104	KINDERGARTEN CLASSROOM	A	VCT	VB/EPX4	PNT/EPX4			PNT	R52, R53, R54
105	KINDERGARTEN CLASSROOM	A	VCT	VB/EPX4	PNT/EPX4			PNT	R52, R53, R54
105A	TOILET	G	PT	СТ	EPX4			PNT	
105B	STORAGE	A	VCT	VB/EPX4	PNT			PNT	
105C	VESTBULE	A	VCT	VB/EPX4	PNT			PNT	
107	1ST GRADE CLASSROOM	B	VCT	VB/EPX4	PNT/EPX4			PNT	R52, R53, R54
108	2ND GRADE CLASSROOM 1	Ć	VCT	VB/EPX4	PNT/EPX4			PNT	R52, R53, R54
109	1ST GRADE CLASSROOM	B	VCT	VB/EPX4	PNT/EPX4			PNT	R52, R53, R54
110	SPECIAL EDUCATION (AS K-2)	В	VCT	VB/EPX4	PNT/EPX4			PNT	R52, R53, R54
111	SPECIAL EDUCATION (ILS K-2)	В	VCT	VB/EPX4	PNT			PNT	R53
SECOND FLC	OOR			1			-		
208	3RD GRADE CLASSROOM (D	VCT	VB/EPX4	PNT/EPX4			PNT	R52, R53, R54
210	3RD GRADE CLASSROOM	(D	VCT	VB/EPX4	PNT/EPX4			PNT	R52, R53, R54
211	2ND GRADE CLASSROOM	С	VCT	VB/EPX4	PNT/EPX4			PNT	R52, R53, R54
212	2ND GRADE CLASSROOM	C	VCT	VB/EPX4	PNT/EPX4			PNT	R52, R53, R54

5

3

						DOOR	SCHEDULE						
				DOOR					FRAME				
-				DOOR	[DIMENSION	S			FRAME	GLAZING/		
OPENING	DOOR	EXISTING /	DOOR	SCHEDULED	WIE)TH		FRAME	FRAME	SCHEDULED	INFILL	HARDWARE	
NUMBER	TYPE	NEW	MATERIAL	FINISH	LEAF 1	LEAF 2	HEIGHT	TYPE	MATERIAL	FINISH	TYPE	SET	REMARKS
FIRST FLOOR												-	
100	Ν	ETR	WD	STN	3' - 0"	3' - 0"	7' - 2"	ETR	HM	PNT	ETR	ELM-05	B, F, G
100A	F	ETR	WD	STN	3' - 0"		7' - 0"	ETR	HM	PNT		ELM-02	B, F, G
100B	F	ETR	WD	STN	3' - 0"		7' - 0"	ETR	HM	PNT		ELM-02	B, F, G
100C	F	ETR	WD	STN	2' - 0"	2' - 0"	7' - 2"	ETR	HM	PNT		ELM-04	B, F, G
100D	F	ETR	WD	STN	2' - 0"	2' - 0"	7' - 2"	ETR	HM	PNT		ELM-04	B, F, G
100E	FG2	ETR	ALUM	CLN	2' - 4"	2' - 4"	7' - 0"	ETR	ALUM	CLN	ETR	ETR	A, F
100F	N	ETR	STL	PNT	3' - 0"		7' - 2"	ETR	STL	PNT	ETR	ETR	A, F, H
102	G	ETR	WD	STN	3' - 0"		8' - 4"	ETR	HM	PNT	TG	ELM-01	B, F, G, I
103	G	ETR	WD	STN	3' - 0"		8' - 4"	ETR	HM	PNT	TG	ELM-01	B, F, G, I
104	G	ETR	WD	STN	3' - 0"		7' - 0"	ETR	HM	PNT	TG	ELM-01	B, F, G, I
104A	F	ETR	WD	STN	2' - 8"		7' - 0"	ETR	HM	PNT		ELM-02	B, F, G
105	G	ETR	WD	STN	3' - 0"		7' - 0"	ETR	HM	PNT	TG	ELM-01	B, F, G, I
105A	F	ETR	WD	STN	2' - 8"		7' - 0"	ETR	HM	PNT		ELM-03	B, F, G
105B	F	ETR	WD	STN	2' - 8"		7' - 0"	ETR	HM	PNT		ELM-02	B, F, G
105C	F	ETR	WD	STN	2' - 8"		7' - 0"	ETR	HM	PNT		ELM-02	B, F, G
105D	F	ETR	WD	STN	2' - 10"	2' - 10"	7' - 0"	ETR	HM	PNT		ELM-04	B, F, G
105E	G1	ETR	WD	STN	3' - 0"		7' - 0"	ETR	HM	PNT	TG	ELM-07	B, F, G, I
105F	N	ETR	STL	PNT	3' - 0"		7' - 2"	ETR	STL	PNT	ETR	ETR	A, F, H
105G	N	ETR	STL	PNT	3' - 0"		7' - 2"	ETR	STL	PNT	ETR	ETR	A, F, H
107	G	ETR	WD	STN	3' - 0"		7' - 0"	ETR	HM	PNT	TG	ELM-01	B, F, G, I
107A	F	ETR	WD	STN	2' - 8"		7' - 0"	ETR	HM	PNT		ELM-02	B, F, G
107B	F	ETR	WD	STN	2' - 8"		7' - 0"	ETR	HM	PNT		ELM-02	B, F, G
108	G	ETR	WD	STN	3' - 0"		7' - 0"	ETR	HM	PNT	TG	ELM-01	B, F, G, I
108A	F	ETR	WD	STN	2' - 8"		7' - 0"	ETR	HM	PNT		ELM-02	B, F, G
108B	F	ETR	WD	STN	2' - 8"		7' - 0"	ETR	HM	PNT		ELM-02	B, F, G
109	G	ETR	WD	STN	3' - 0"		7' - 0"	ETR	HM	PNT	TG	ELM-01	B, F, G, I
109A	F F	ETR	WD	STN	2' - 8"		7' - 0"	ETR	HM	PNT		ELM-02	B, F, G
109B	F	ETR	WD	STN	2' - 8"		7' - 0"	ETR	HM	PNT	 TO	ELM-02	B, F, G
110	G F	ETR	WD WD	STN	3' - 0"		7' - 0"	ETR	HM	PNT	TG	ELM-01	B, F, G, I
110A 110B	F	ETR ETR	WD WD	STN STN	2' - 8" 2' - 8"		7' - 0" 7' - 0"	ETR	HM HM	PNT PNT		ELM-02	B, F, G
111	<u>г</u> G	ETR	WD	STN	2 - 0"		7 - 0	ETR ETR	HM	PNT	 TG	ELM-02 ELM-01	B, F, G
111A	G F	ETR	WD	STN	2' - 8"		7' - 0"	ETR	НМ	PNT		ELM-01	B, F, G, I B, F, G
	•			0									2, : , 0
SECOND FLOO	R												
208	G	ETR	WD	STN	3' - 0"		7' - 0"	ETR	HM	PNT	TG	ELM-01	B, F, G, I
208A	F	ETR	WD	STN	2' - 8"		7' - 0"	ETR	HM	PNT		ELM-02	B, F, G
208B	F	ETR	WD	STN	2' - 8"		7' - 0"	ETR	HM	PNT		ELM-02	B, F, G
210	G	ETR	WD	STN	3' - 0"		7' - 0"	ETR	HM	PNT	ETR	ELM-01	B, F, G
210A	F	ETR	WD	STN	2' - 8"		7' - 0"	ETR	HM	PNT		ELM-02	B, F, G
210B	F	ETR	WD	STN	2' - 8"		7' - 0"	ETR	HM	PNT		ELM-02	B, F, G
211	G	ETR	WD	STN	3' - 0"		7' - 0"	ETR	HM	PNT	ETR	ELM-01	B, F, G
211A	F	ETR	WD	STN	2' - 8"		7' - 0"	ETR	HM	PNT		ELM-02	B, F, G
211B	F	ETR	WD	STN	2' - 8"		7' - 0"	ETR	HM	PNT		ELM-02	B, F, G
212	G	ETR	WD	STN	3' - 0"		7' - 0"	ETR	HM	PNT	TG	ELM-01	B, F, G, I
212A	F	ETR	WD	STN	2' - 8"		7' - 0"	ETR	HM	PNT		ELM-02	B, F, G
212B	F	ETR	WD	STN	2' - 8"		7' - 0"	ETR	HM	PNT		ELM-02	B, F, G

DOOR & BUILT-IN CABINET SCHEDULE NOTES:

2

SCHEDULE REMARKS*:


- A. EXISTING DOOR, FRAME AND HARDWARE TO REMAIN. B. PROVIDE NEW HARDWARE TO EXISTING DOOR AND FRAME.
- C. PROVIDE NEW DOOR AND HARDWARE TO EXISTING FRAME. D. PROVIDE NEW DOOR TO EXISTING FRAME. REINSTALL EXISTING HARDWARE INTO NEW DOOR.
- E. PROVIDE NEW DOOR, FRAME AND HARDWARE. F. CLEAN AND PATCH ALL SURFACES OF EXISTING DOOR, FRAME AND/OR
- HARDWARE TO "LIKE NEW" CONDITION. G. REFINISH DOOR AND/OR FRAME AS SCHEDULED ON BOTH SIDES OF ASSEMBLY.
- H. REFINISH DOOR AND/OR FRAME AS SCHEDULED ON INTERIOR FACE (OR CLASSROOM SIDE) OF ASSEMBLY ONLY. I. REMOVE EXISTING GLAZING AND REPLACE WITH NEW MATERIAL AS
- SCHEDULED. WHERE TACKBOARD IS SCHEDULED, PROVIDE MDF BACKER AND COMPONENTS OF DOOR OR HARDWARE UNTIL TACKBOARD INFILL, TYPICAL. INLAY 1/2" QUARTERROUND WOOD TRIM, CONTINUOUS, AROUND PERIMETER OF ALL TACKBOARD INFILLS. J. REFINISH DOOR AND/OR FRAME AS SCHEDULED ON EXTERIOR FACE (OR
- ALCOVE SIDE) OF ASSEMBLY ONLY. K. EXISTING MOSAIC AND/OR ART TO REMAIN. CONTRACTOR TO PROTECT
- DURING CONSTRUCTION. L. REFER TO I4 SERIES DRAWINGS FOR ADDITIONAL INFORMATION.
- M. REPLACE BROKEN TRANSOM GLAZING WITH NEW TEMPERED GLAZING AS REQUIRED.
- BY THE OWNER'S REPRESENTATIVE. 3. WHERE INDICATED, PROVIDE 3/4" MDF INFILL PANEL IN EXISTING FRAME. RELOCATE AND RESECURE FRAME STOPS AS REQUIRED TO ACCOMODATE NEW MATERIAL. PAINT MDF PANEL | TG TO MATCH FRAME COLOR AS INDICATED ON FINISH SCHEDULE. 4. CONTRACTOR SHALL NOT REMOVE ANY

GENERAL NOTES:

INFORMATION.


- ALL COMPONENTS OF NEW ASSEMBLY ARE PHYSICALLY ON SITE, INCLUDING CORES.
- SCHEDULE FOR COLOR SELECTION. 6. DOORS SHALL BE SHAVED DOWN AS REQUIRED
- TO ACCEPT NEW HARDWARE AND/OR ALLOW FOR USE UNOBSTRUCTED.


*NOTE: NOT ALL NOTES MAY NECESSARILY APPLY

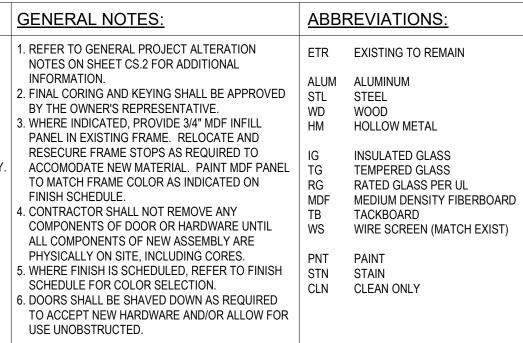



DOOR TYPES


* - RECOMMENDED MOUNTING HEIGHT FROM FINISHED FLOOR TO CENTER LINE OF FIRE EXIT DEVICE ** - COORDINATE WITH DOOR MANUFACTURE REQUIREMENTS

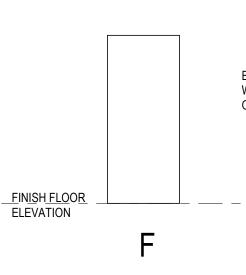

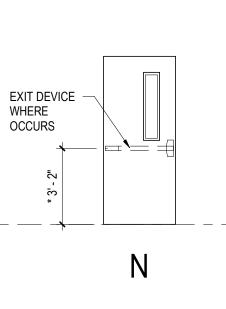

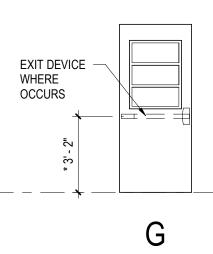

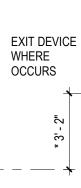

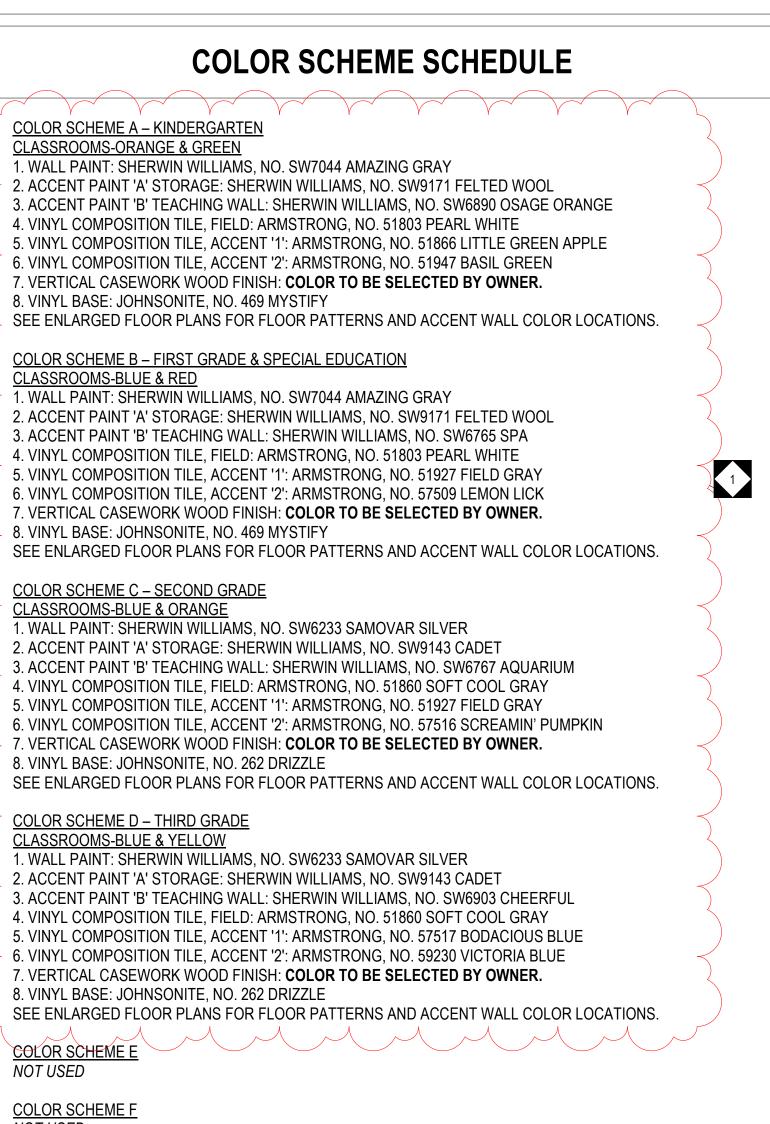

7

NOT USED

6

COLOR SCHEME G **BATHROOMS**

- 1. WALL PAINT: SHERWIN WILLIAMS, NO. SW7029 AGREEABLE GRAY
- 2. PORCELAIN FLOOR TILE: DALTILE, EVER PORCELIAN, COLOR: EV03 ARCTIC UNPOLISHED
- 3. PORCELAIN WALL TILE, FIELD: DALTILE, SEMI-GLOSS GLAZED TILE, 0182 SUEDE GRAY 4. PORCELAIN WALL TILE, ACCENT '1': DALTILE, SEMI-GLOSS GLAZED TILE, Q151 TOTALLY TANGERINE
- 5. PORCELAIN WALL TILE, ACCENT '2': DALTILE, SEMI-GLOSS GLAZED TILE, Q097 ORANGE BURST
- 6. GROUT COLOR FOR WALLS: MAPEI, COLOR: 00 WHITE
- 7. GROUT COLOR FOR FLOORS: MAPEI, COLOR: 27 SILVER SEE ENLARGED PLANS FOR ACCENT WAINSCOT COLOR LOCATIONS.

GENERAL NOTES:

THE FOLLOWING MATERIALS ARE TO BE APPLIED AT ALL LOCATIONS WHERE SPECIFIED

- UNLESS OTHERWISE NOTED: 1. TACK BOARDS: CLARIDGE FABRICORK, KL498 WINTHROPE
- 2. ROLLER WINDOW SHADES : MERMET, GREENSCREEN REVIVE, 5% OPEN, COLOR: 0.22 STONE
- 3. SOLID SURFACE COUNTERTOP & SIDE/BACK SPLASH: CORIAN, COLOR: DEEP CAVIAR
- 4. CEILING PAINT: SHERWIN WILLIAMS, NO. SW7006 EXTRA WHITE
- 5. PREVIOUSLY PAINTED WOOD COMPONENTS: DOORS, TRIM, BASE, CHAIR RAIL, CROWN MOULDING, VISUAL DISPLAY TRIM, WINDOW SILLS.: SHERWIN WILLIAMS, NO. SW7068 GRIZZLE GRAY 6. PREVIOUSLY STAINED WOOD COMPONENTS: WOOD DOORS, WOOD TRIM, WOOD BASE, VISUAL DISPLAY BOARD TRIM, ETC.; COLOR TO MATCH EXISTING AND FIELD VERIFIED BY ARCHITECT/OWNER. 7. NOT USED.
 - 8. PREVIOUSLY PAINTED METAL TIERED COAT HOOKS & PREVIOUSLY PAINTED STUDENT CUBBIES SHALL BE PAINTED TO MATCH ADJACENT WALL COLOR.

<u>NOTES</u>


- A. IF ROOM IS NOT INDICATED TO RECEIVE A FLOOR PATTERN, FIELD COLOR VCT SHALL BE USED.
- B. VCT ORIENTATION SHALL BE MATCHED TO EXISTING ADJACENT ROOM. C. ARCHITECT REQUIRES AN ON-SITE MOCK-UP FOR EACH PAINT COLOR. PROVIDE A MINIMUM 8'x10' AREA,
- A DOOR FRAME. CONTRACTOR MUST RECEIVE ARCHITECT'S APPROVAL BEFORE ORDERING. D. VERTICAL AND HORIZONTAL PLANES OF SOFFIT AND BULKHEAD SHALL BE PAINTED TO MATCH THE ADJACENT WALL COLOR, UNLESS OTHERWISE NOTED.
- E. COORDINATE ROOM FINISH SCHEDULE AND COLOR SCHEME SCHEDULE WITH DEMO/ALTERATION NOTES. F. ALL EXPOSED MECHANICAL, PLUMBING, ELECTRICAL & HVAC COMPONENTS SHALL BE PAINTED THE ADJACENT WALL COLOR. ITEMS INCLUDING BUT NOT LIMITED TO: PIPING, CONDUIT, VENTS, LOUVERS, GRILLES, RADIATORS, RADIATOR COVERS, ELECTRICAL PANELS, METAL ACCESS PANELS SHALL BE PAINTED ADJACENT WALL COLOR.

ROOM F	INISH SCHEDULE LEGEND
F L OO R	FINISH
PT VCT	PORCELAIN TILE VINYL COMPOSITION TILE
FLOOR	REMARKS
R1-R25: N	NOT USED
BASE F	INISH
CT EPX VB	CERAMIC TILE EPOXY PAINT VINYL
BASE F	REMARKS
R26-R50:	NOT USED
WALL	FINISH
CT EPX PNT	CERAMIC TILE EPOXY PAINT PAINT
WALL	REMARKS
R51: R52:	NOT USED SEE INTERIOR ELEVATIONS FOR VARYING WALL MATERIALS.
R53: R54:	PROVIDE ACCENT WALL.
R55-R75:	NOT USED
CEILIN	G FINISH
ACT PNT	ACOUSTICAL CEILING TILE PAINTED GYPSUM WALLBOARD/PLASTER
CEILIN	NG REMARKS
R76: R77: R78-R100	NOT USED SEE REFLECTED CEILING PLANS FOR VARYING CEILING MATERIALS AND HEIGHTS. : NOT USED
GENEF	RAL NOTES
DESC	ER TO SPECIFICATIONS FOR DETAILED CRIPTION OF FINISH SYSTEM/TYPES. ER TO WALL TYPES FOR MASONRY LOCATIONS AND
DETA 3. GYPS	


8

4. ALL HOLLOW METAL DOOR AND FRAMES, INTERIOR AND EXTERIOR. SHALL BE PAINTED. 5. ALL INTERIOR FERROUS METAL SHALL BE PAINTED INCLUDING LINTELS, RAILINGS, GRILLES AND LOUVERS.

- (DOES NOT INCLUDE FACTORY OR PRE-FINISHED ITEMS)
- 6. SEE I7 DRAWINGS FOR MATERIAL TRANSITIONS &
- FLOOR PATTERN PLANS. 7. ETR = EXISTING TO REMAIN
- 8. EXIST = EXISTING

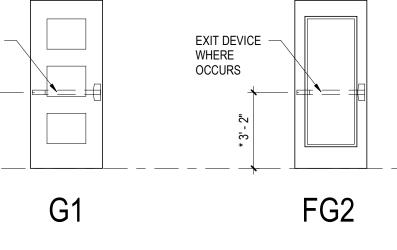


	FICE OF CAPITAL PROGRAMS
PHIL	NORTH BROAD STREET LADELPHIA, PA 19130 - 4015
www	v.philasd.org
SE/	
	STERED ARCH
	8
	THIN REY STRAUB
	EFFREY STRAUB, AIA TE AND LICENSE NO: RA403652
	R <mark>CHITECT</mark> RABTREE, ROHRBAUGH & ASSOCIATES
401 Me	1 E. Winding Hill Road echanicsburg, PA 17055 one: 717-458-0272
Att Em	tn: Jessie Ellis nail: jellis@cra-architects.com
ME	EP ENGINEERS
15	ITY & ASSOCIATES, LTD. 15 Market Street, Suite 1200 iladelphia, PA 19102
Pho Att	iladelphia, PA 19102 one: 703-919-5614 tn: Deepak Ajjimane
Em	nail: deepak.at@setty.com
<u></u>	00% DESIGN SUBMISSION
1/	00% DESIGN SUBMISSION (22/2020
<u>1/</u> 10	
1/ 10 9 8 7 6	
1/ 10 9 8 7	
1/ 10 9 8 7 6 5 4 3	
1/ 10 9 8 7 6 5 4	
1/ 10 9 8 7 6 5 4 3 2 1 NO.	/22/2020
1/ 10 9 8 7 6 5 4 3 2 1 NO. SC EL	22/2020 22/2020 2 2 2 2 2 3 4 4 5 6 6 7 <t< td=""></t<>
1/ 10 9 8 7 6 5 4 3 2 1 NO. SC EL	22/2020
1/ 10 9 8 7 6 5 4 3 2 1 NO. SC EL SC M.	22/2020 22/2020 2 2 2 2 2 3 4 4 5 6 6 7 <t< td=""></t<>
1/ 10 9 8 7 6 5 4 3 2 1 NO. SC EL SC M. STI DE	22/2020 22/2020 2 <t< td=""></t<>
1/ 10 9 8 7 6 5 4 3 2 1 NO. SC EL SC M. STI DE PH	22/2020 22/2020 22/20/2020 22/20/2020 ADDENDUM # 1 02/20/2020 ADDENDUM # 1 DATE REVISION CHOOL & LOCATION LWOOD ELEMENTARY CHOOL AILING ADDRESS: 6701 N 13TH REET, PHILADELPHIA, PA 19126 EED ADDRESS: 1201-51 OAK LN,
1/ 10 9 8 7 6 5 4 3 2 1 NO. SC EL SC M. ST DE PH PR C	22/2020 22/2020 2 <t< td=""></t<>
1/ 10 9 8 7 6 5 4 3 2 1 NO. SC EL SC EL SC M. ST DE PH PR C	22/2020 22/2020 22/20/2020
1/ 10 9 8 7 6 5 4 3 2 1 NO. SC EL SC M. ST DE PH PR C M	22/2020 22/2020 2 <t< td=""></t<>
1/ 10 9 8 7 6 5 4 3 2 1 NO. SC EL SC M. ST DE PH PR C M	22/2020 22/2020 2 <t< td=""></t<>
1/ 10 9 8 7 6 5 4 3 2 1 NO. SC EL SC EL SC M. ST DE PH PR C M ST DE PH R C M	22/2020 22/2020 2 <t< td=""></t<>
1/ 10 9 8 7 6 5 4 3 2 1 NO. SC EL SC EL SC M. STI DE PH PR C M C M	22/2020 22/2020 2 <t< td=""></t<>
1/ 10 9 8 7 6 5 4 3 2 1 NO. SC EL SC M. STI DE PH PR C M STI DE PH R C M	22/2020 22/2020 2 <t< td=""></t<>
1/ 10 9 8 7 6 5 4 3 2 1 NO. SC EL SC M. STI DE PH PR C M STI DE PH R C M	22/2020 22/2020 2 <t< td=""></t<>

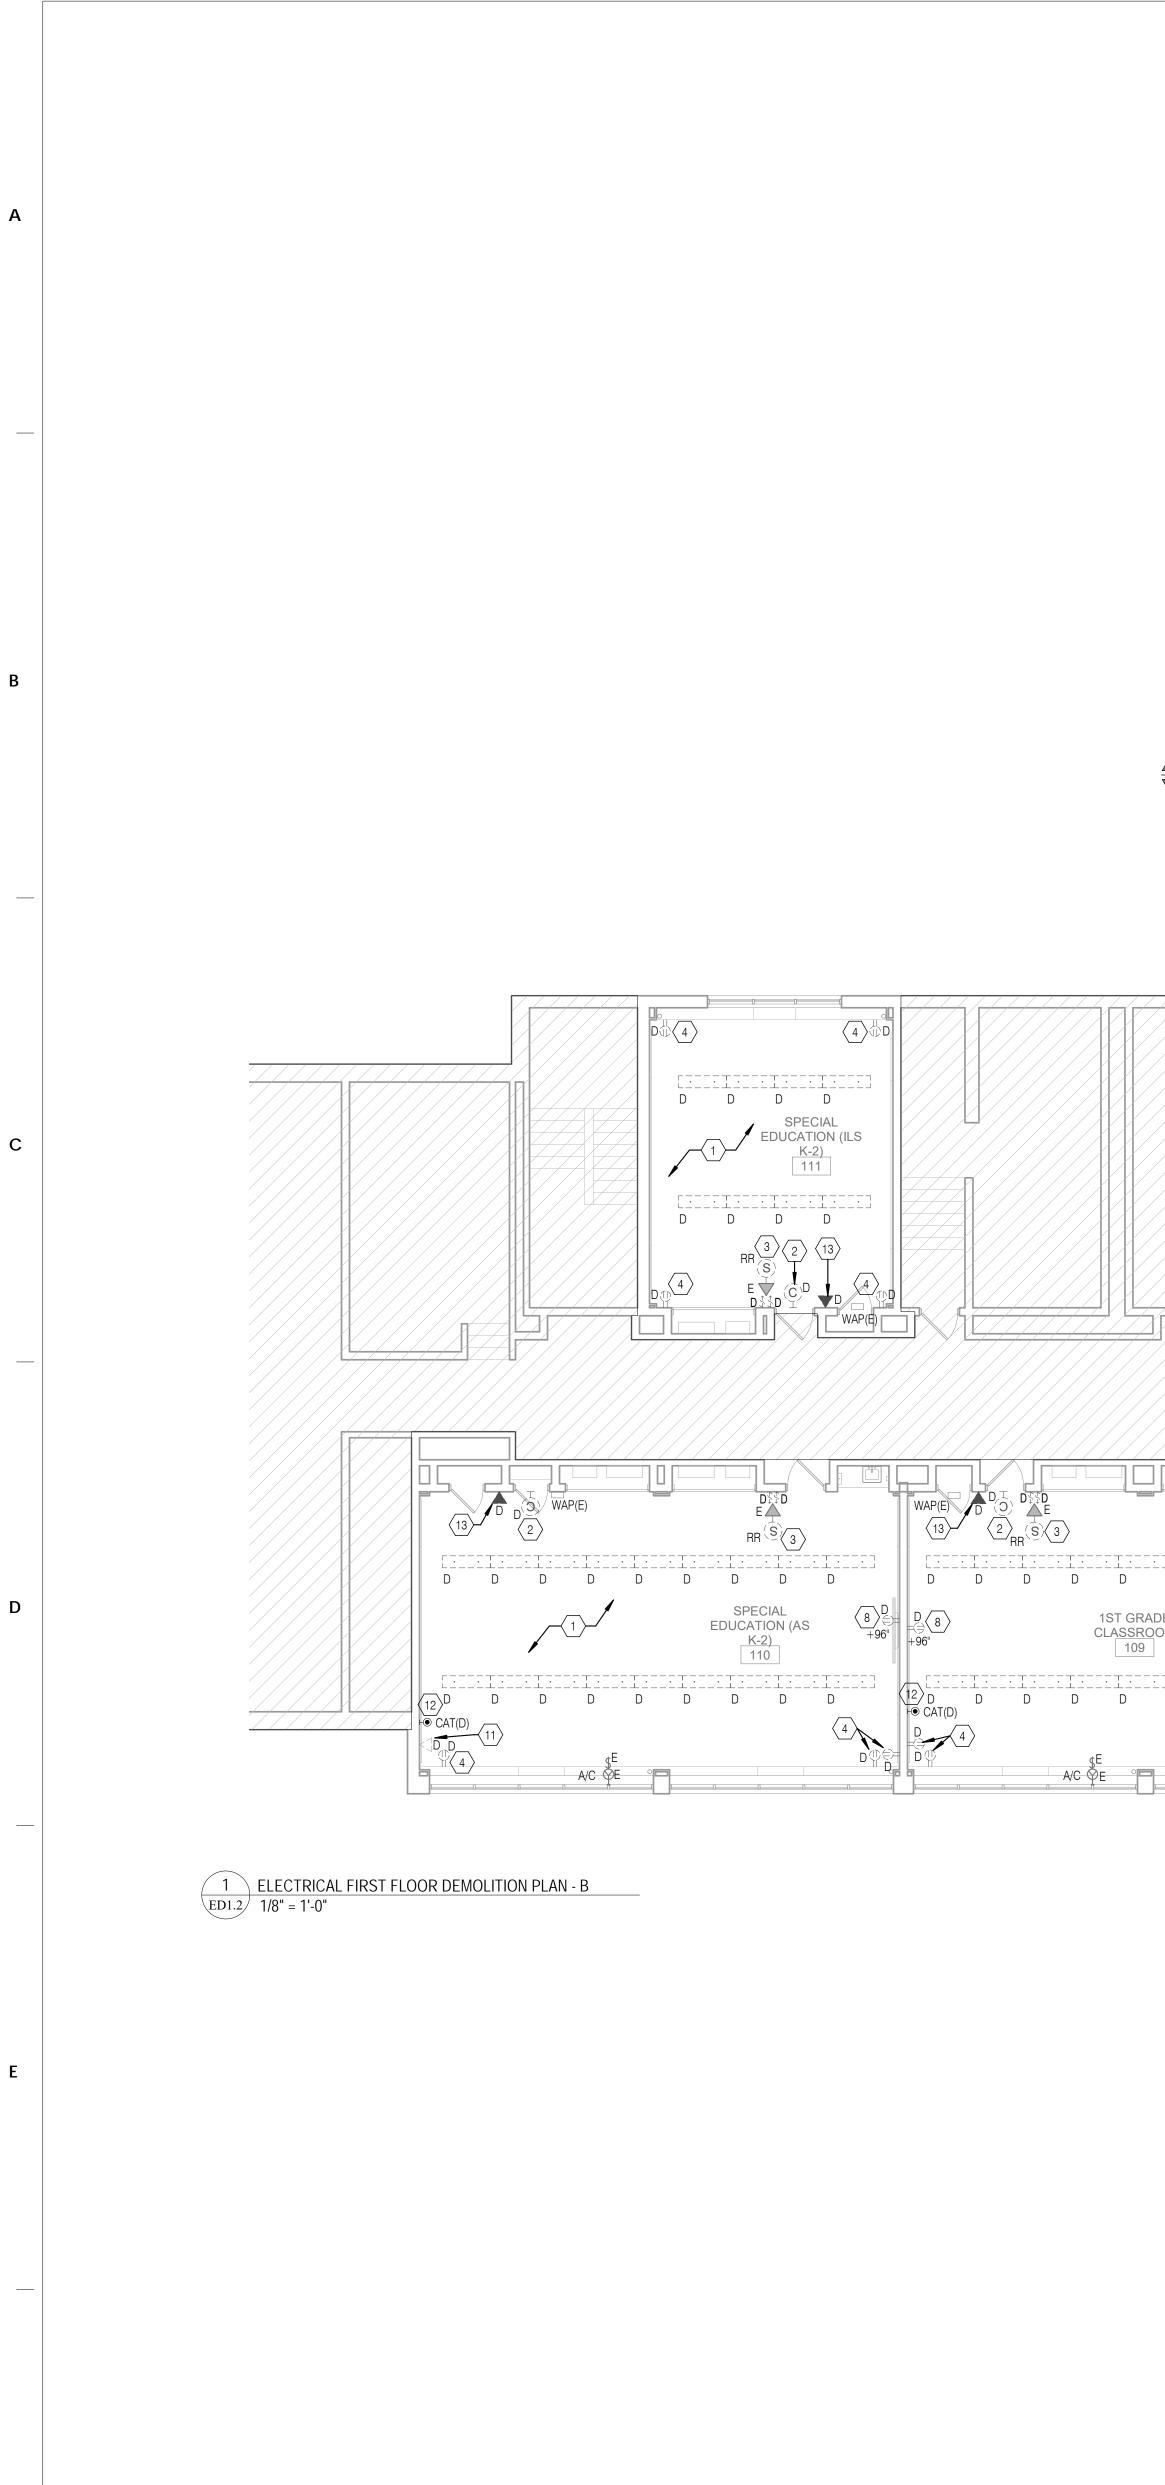

1


		ANEL L-2(D)				
	WAP(E) D D D D D E D RR S 3		WAP(E) D (3) D 13 (2) D RR	5 D E 5 3		<u> </u>
		D D D D		·	D D D	
1ST GRADE CLASSROOM	[□] [□] [□] [−] [−] [−] [−] [−] [−] [−] [−]	2ND GRADE CLASSROOM 108			1ST GRADE CLASSROOM	\langle
	$ \begin{array}{c} \hline \\ \hline $	D D D D	$ \begin{array}{c} \Box \\ D \\ D \\ \end{array} $	D	D D D	D
E T	D\\\\\\\\\\\\\\\\\\\\\\\\\\\\\\\\\\\\			A/C ♥ _F	0	


A/C E

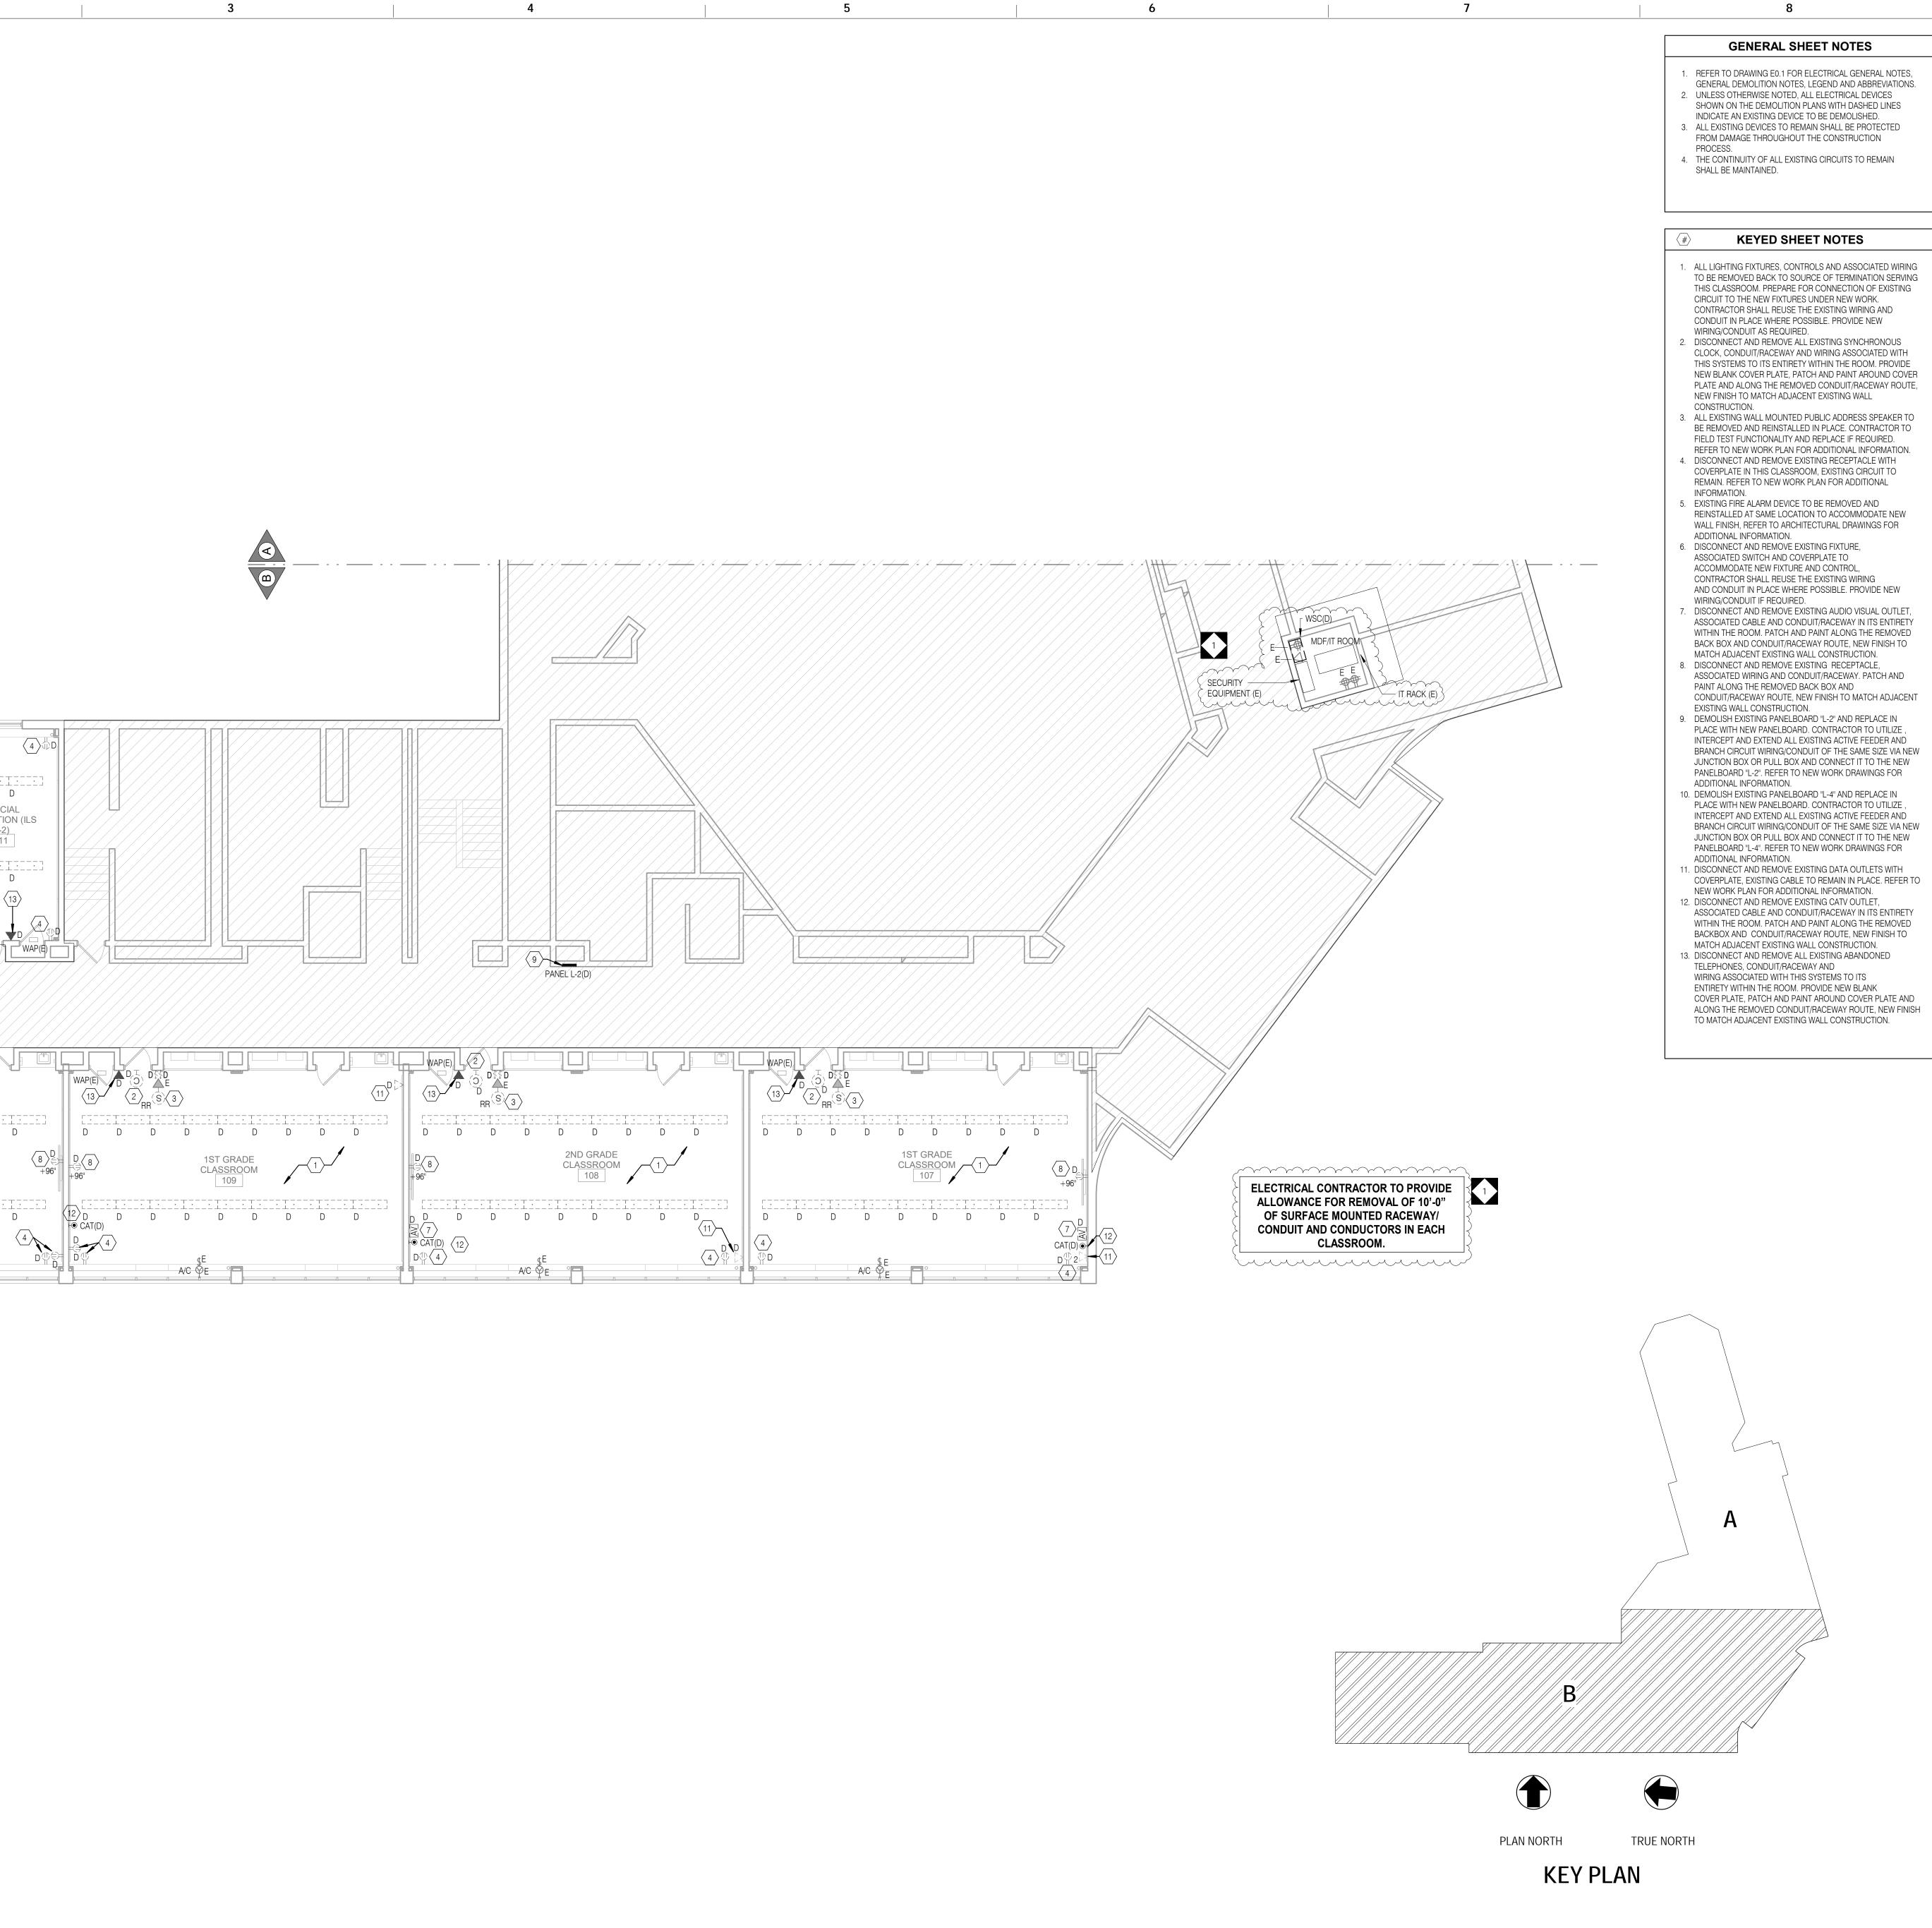


CONRAD DELACRUZ SATIE AND LICENSE NO: PE089048 AND LICENSE NO: PE089048 CARABIREE, ROHRBAUGH & ASSOCIATES 401 E. Wincing Hill Road Mechanicsburg, PA 17055 Phone: 717-458-0272 Email: jharder@cra-architects.com Attn: Jessie Harder SETTY 575 South Charles Street, Suite 403 Batimore, MD 212021 Phone: 667-309-6036 Email: deepak.at@setty.com Attn: Deepak Ajjimane SETTY 575 South Charles Street, Suite 403 Batimore, MD 212021 NOTE: Street, Suite 403 Batimore, MD 212021 Phone: 667-309-6036 Email: deepak.at@setty.com Attn: Deepak Ajjimane SETTY 575 South Charles Street, Suite 403 Batimore, MD 212021 Phone: 667-309-6036 Email: deepak.at@setty.com Attn: Deepak Ajjimane SETTY 575 South Charles Street, Suite 403 Batimore, MD 212021 SETTY Street, Suite 403 Battore, MD 212021 SETTY Street, Suite 403 Battore, MD 212021 Settore, Suite 403 Battore, MD 212021 Settore, Suite 403 Battore, MD 212021	STATE AND LICENSE NO: PE089048 ARCHITECT CRABTREE, ROHRBAUGH & ASSOCIATES 401 E. Winding Hill Road Mechanicsburg, PA 17055 Phome: 717-458-0272 Email: jharder@cra-architects.com Attr: Jessie Harder SETTY 575 South Charles Street, Suite 403 Baltimore, MD 212021 Phome: 667-309-6036 Email: deepak.at@setty.com Attr: Deepak Ajjimane SETA: Deepak Ajjimane Strait: deepak.at@setty.com Attr: Deepak Ajjimane Imail: deepak.at@setty.com Attr: Deepak Ajjimane Imail: deepak.at@setty.com Attr: Deepak Ajjimane Imail: deepak.st@setty.com Imail: deepak.st@setty.com	STATE AND LICENSE NO. PEOPRO19 ARCHITECT CRABIREE, ROHRBAUGH & ASSOCIATES 401 E. Winding Hill Road Mechanicsburg, PA 17055 Phone: 717-458-0272 Email: jharder@cra-architects.com Attn: Jessie Harder SETTY 575 South Charles Street, Suite 403 Baltimore, MD 212021 Phone: 667-309-6036 Email: deepak.at@setty.com Attn: Deepak.Al@mane 100%, DESIGN SUBMISSION 1/22/2020 10 10 10 10 10 10 10 10 10 10 10 10 1	SE	AL:	A THE PARTY
CRABTREE, ROHRBAUGH & ASSOCIATES 401 E. Winding Hill Road Mechanicsburg, PA 17055 Phone: 717-458-0272 Email: jharder@cra-architects.com METY 575 South Charles Street, Suite 403 Baltimore, MD 212021 Phone: 667-309-6036 Email: deepak at@setty.com Attn: Deepak Atjjimane Interpretation of the setty.com Attn: Deepak Atjjimane Interpretation of the setty.com Attn: Deepak Atjjimane Interpretation of the setty.com Interpretatin the setty.com Int	Image: CRABTREE, ROHRBAUGH & ASSOCIATES 401 E. Winding Hill Road Mechanicsburg, PA 17055 Phone: 717-458-0272 Email: jaarder@cra-architects.com Attr: Jessie Harder MEP ENGINEERS SETTY 575 South Charles Street, Suite 403 Baltimore, MD 212021 Phone: 667-309-6036 Email: deepak.at@setty.com Attr: Deepak Aljimane 10 Deepak Aljimane 11: deepak.at@setty.com Attr: Deepak Aljimane 10: gar.gar.gar.gar.gar.gar.gar.gar.gar.gar.	CRABITER E, ROHRBAUGH & ASSOCIATES 401 E, Winding Hill Road Mechanicsburg, PA 17055 Phone:: 11/454-0212 Email: jharder@cra-architects.com Attn: Jessie Harder MEP ENGINEERS SETTY ST5 South Charles Street, Suite 403 Baltimore, MD 212021 Phone: 667-309-6036 Email: depak.at@setty.com Attn: Deepak Aijmane 100%, DESIGN SUBMISSION 1/22/2020 10 9			
1/22/2020 10	1/22/2020 10	1/22/2020 10	CR 401 Me Pho Em Attr SET 575 Bal Pho Em	ABTREE, ROHRBAUGH & ASSOCIATE I E. Winding Hill Road echanicsburg, PA 17055 one: 717-458-0272 nail: jharder@cra-architects.com n: Jessie Harder PENGINEERS TY 5 South Charles Street, Suite 403 ltimore, MD 212021 one: 667-309-6036 nail: deepak.at@setty.com	S
1/22/2020 10	1/22/2020 10	1/22/2020 10			
1/22/2020 10	1/22/2020 10	1/22/2020 10			
9	9	9			
7	7	7			
4	4	4	<u>1/2</u> 10 9		
2	2	2 Image: Constraint of the second	1/2 10 9 8 7		
SCHOOL & LOCATION	SCHOOL & LOCATION ELLWOOD ELEMENTARY	SCHOOL & LOCATION ELLWOOD ELEMENTARY SCHOOL 6701 N 13TH STREET, PHILADELP PA 19126 PROJECT TITLE CLASSROOM MODERNIZATION DRAWING TITLE ELECTRICAL FIRST FLOOR DEMOLITION PLAN - UNIT OCATION NO. FILE NO. DRAWN BY CHECKED BY	1/2 10 9 8 7 6 5 4		
		SCHOOL 6701 N 13TH STREET, PHILADELP PA 19126 PROJECT TITLE CLASSROOM MODERNIZATION DRAWING TITLE ELECTRICAL FIRST FLOOR DEMOLITION PLAN - UNIT OCATION NO. FILE NO. DRAWN BY CHECKED BY	1/2 10 9 8 7 6 5 4 3 2		
6701 N 13TH STREET, PHILADELP PA 19126		ELECTRICAL FIRST FLOOR DEMOLITION PLAN - UNITLOCATION NO.FILE NO.DRAWN BYCHECKED BY	1/2 10 9 8 7 6 5 4 3 7 6 5 4 3 2 1 NO. SC EL SC 67	22/2020 22/2020 2 2 2 2 2 2 2 2 2 2 2 2 2	
	CLASSROOM	ELECTRICAL FIRST FLOOR DEMOLITION PLAN - UNITLOCATION NO.FILE NO.DRAWN BYCHECKED BY	1/2 10 9 8 7 6 5 4 3 2 1 NO. SC EL SC 67 PA PR C	22/2020 2 2/2020 2 2/20	
PA 19126 PROJECT TITLE CLASSROOM	CLASSROOM	DRAWN BY CHECKED BY	1/2 10 9 8 7 6 5 4 3 2 1 NO. SC EL SC 67 PA PR C	22/2020 2 2/2020 2 2/20	
PA 19126 PROJECT TITLE CLASSROOM MODERNIZATION DRAWING TITLE ELECTRICAL FIRST FLOOR	CLASSROOM MODERNIZATION DRAWING TITLE ELECTRICAL FIRST FLOOR		1/2 10 9 8 7 6 5 4 3 2 1 NO. SC EL SC 67 PA PR CI M DR EL	22/2020 22/2020 2 2 2 2 2 2 2 2 2 2 2 2 2	ELP
PROJECT TITLE CLASSROOM MODERNIZATION DRAWING TITLE ELECTRICAL FIRST FLOOR DEMOLITION PLAN - UNIT	CLASSROOM MODERNIZATION DRAWING TITLE ELECTRICAL FIRST FLOOR DEMOLITION PLAN - UNIT	· · · · · · · · · · · · · · · · · · ·	1/2 10 9 8 7 6 5 4 3 2 1 NO. SC EL SC 67 PA PR CI DR EL DI	22/2020	ELP

THE SCHOOL DISTRICT OF

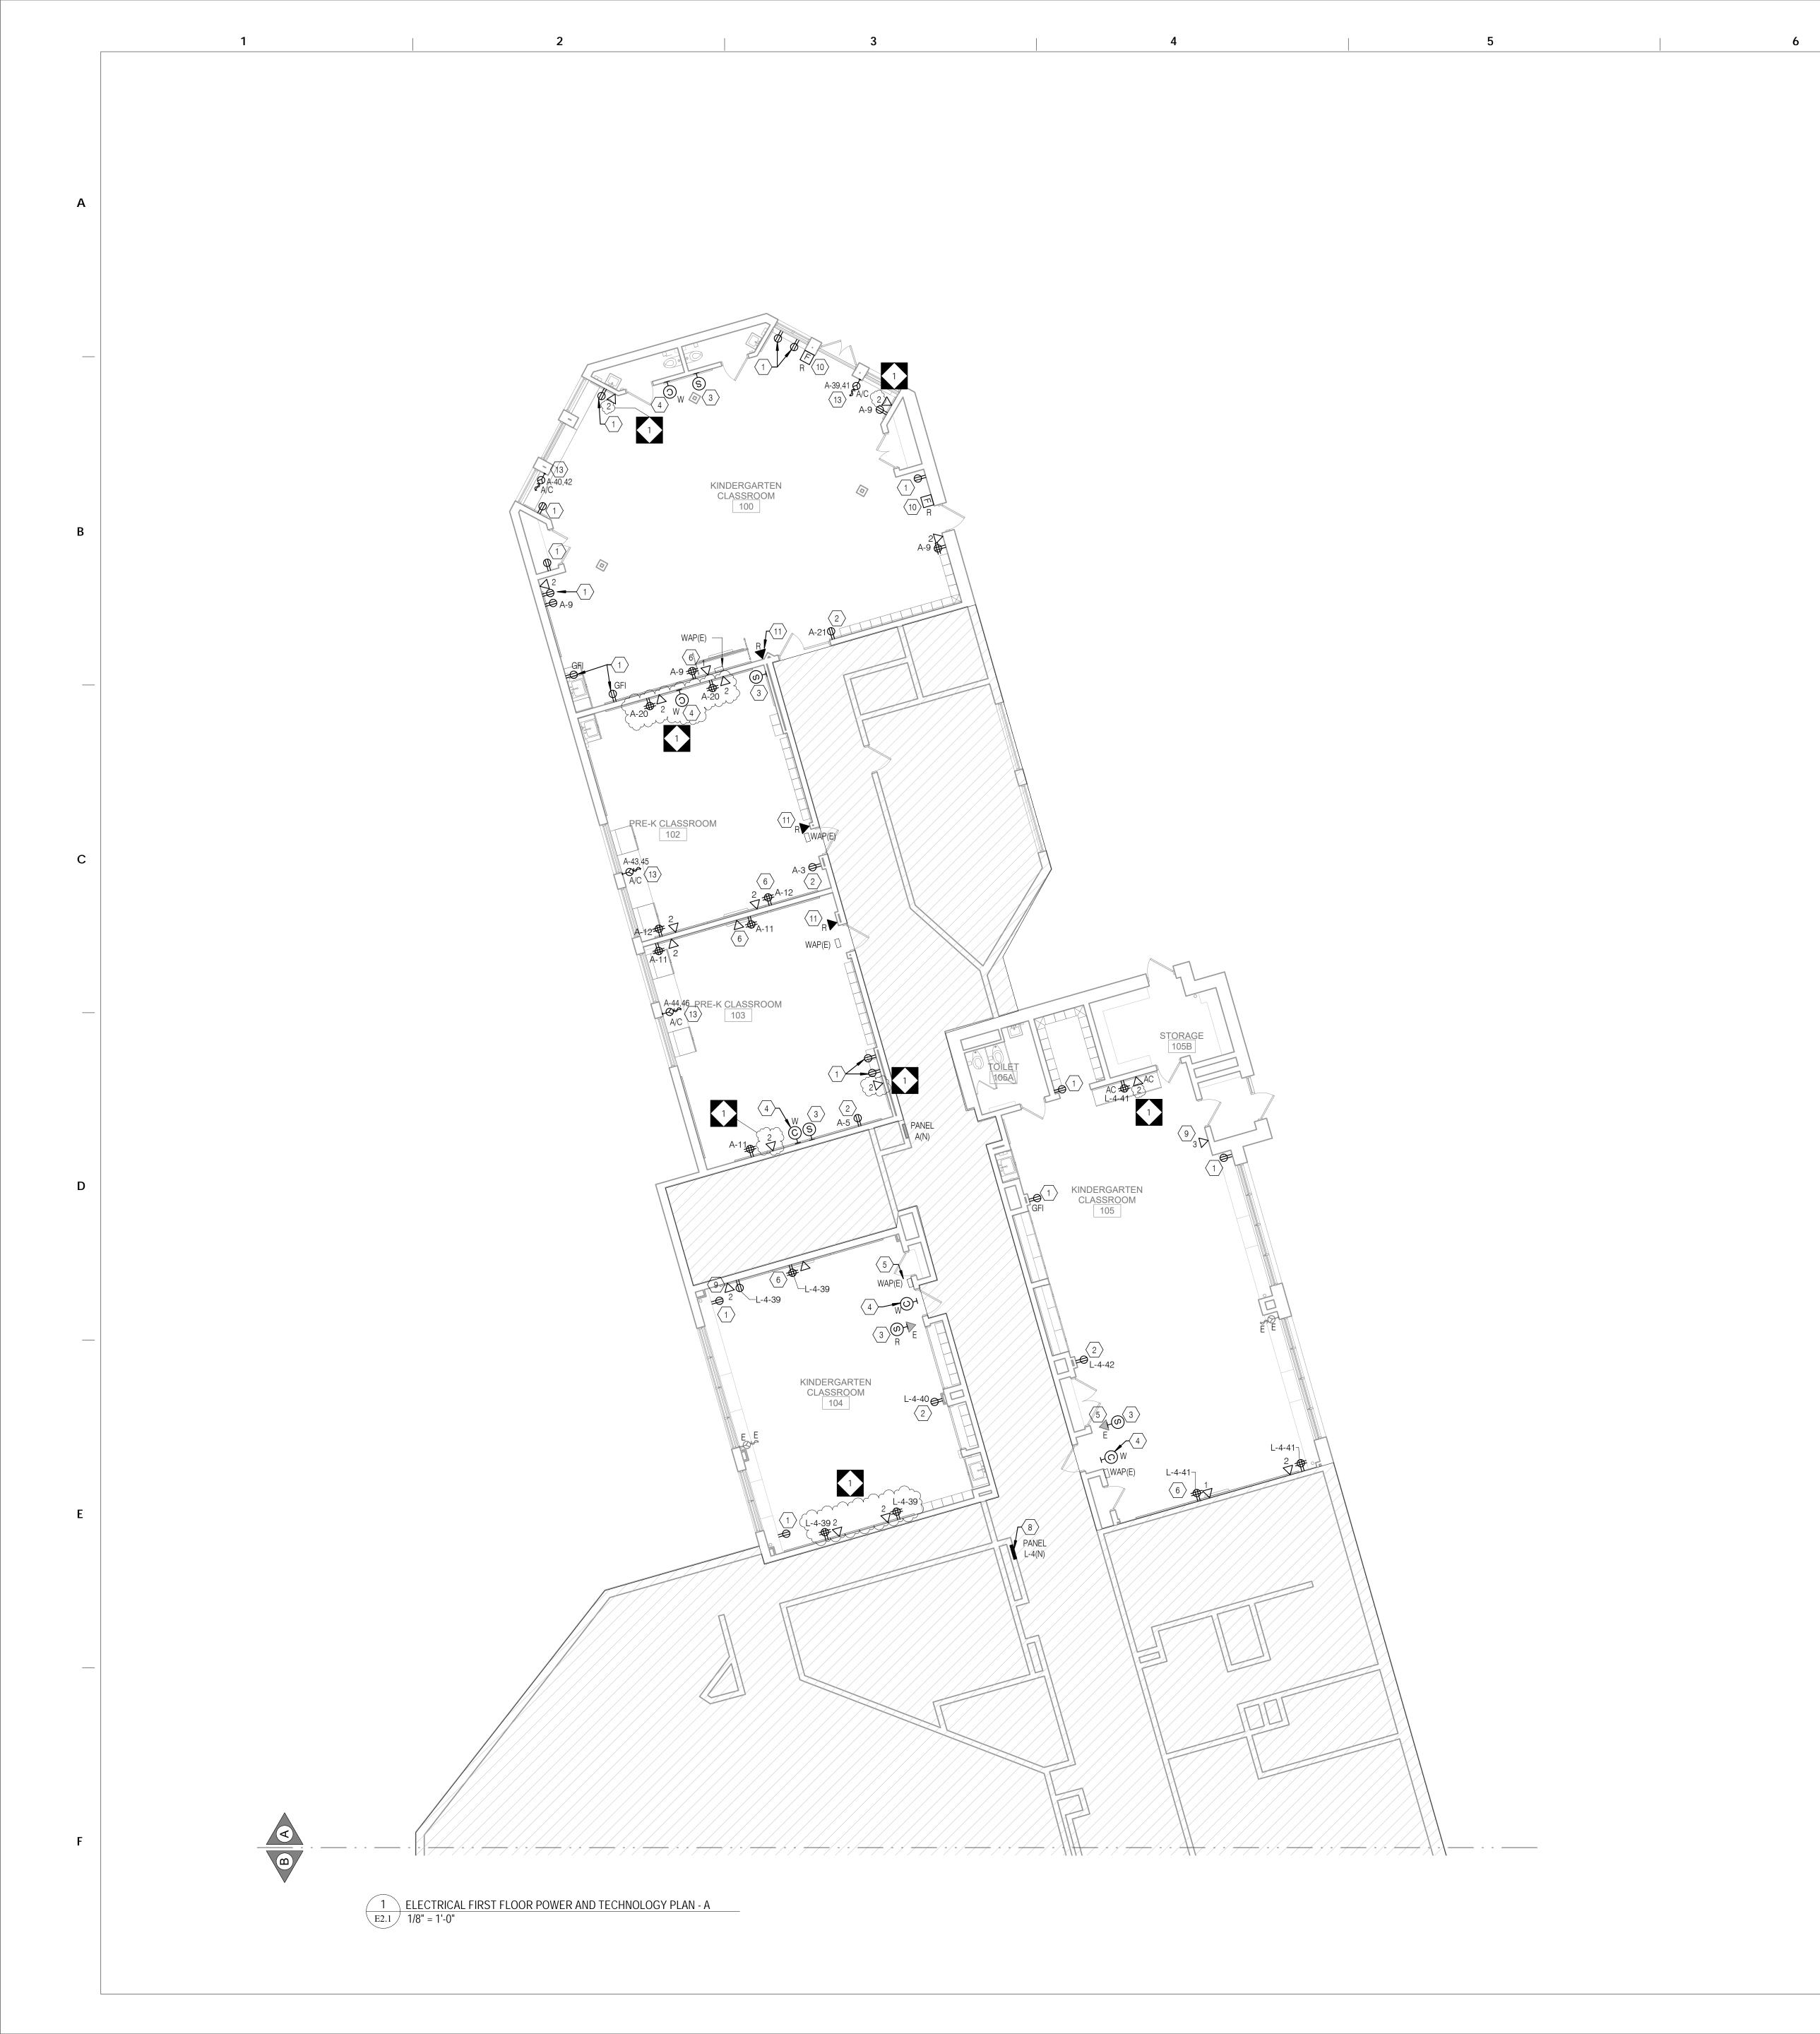

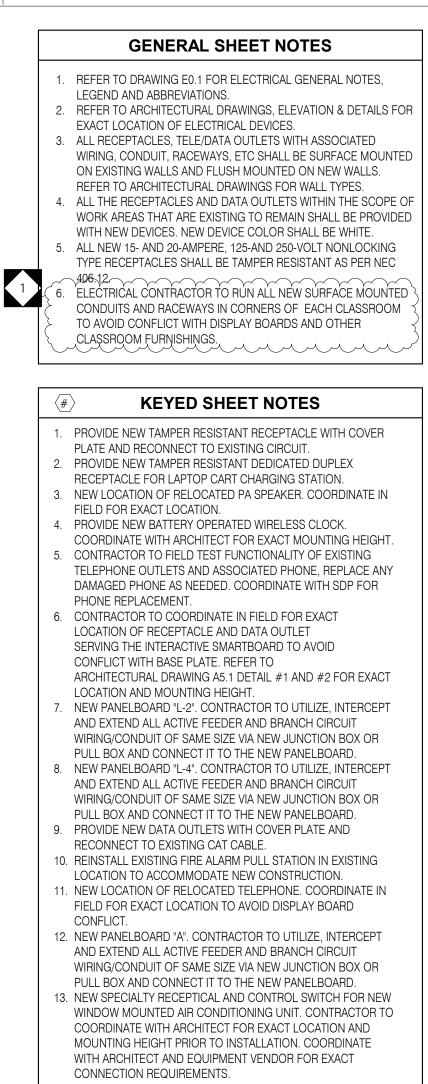

7

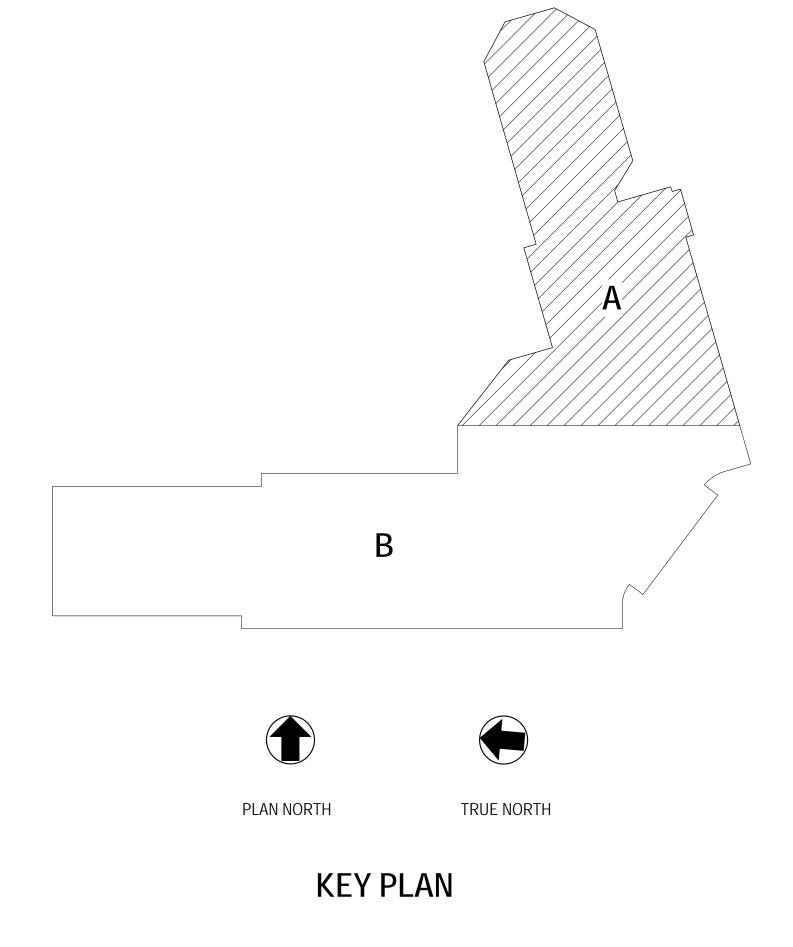

CONRAD DELA CRUZ STATE AND LICENSE NO: PE089048 ARCHITECT CRABTREE, ROHRBAUGH & ASSO 401 E. Winding Hill Road Mechanicsburg, PA 17055 Phone: 717-458-0272 Email: jharder@cra-architects.co Attn: Jessie Harder MEP ENGINEERS SETTY 575 South Charles Street, Suite 40 Baltimore, MD 212021 Phone: 667-309-6036 Email: deepak.at@setty.com Attn: Deepak Ajjimane	m
CRABTREE, ROHRBAUGH & ASSO 401 E. Winding Hill Road Mechanicsburg, PA 17055 Phone: 717-458-0272 Email: jharder@cra-architects.co Attn: Jessie Harder MEP ENGINEERS SETTY 575 South Charles Street, Suite 40 Baltimore, MD 212021 Phone: 667-309-6036 Email: deepak.at@setty.com	m
Attn: Jessie Harder <u>MEP ENGINEERS</u> SETTY 575 South Charles Street, Suite 40 Baltimore, MD 212021 Phone: 667-309-6036 Email: deepak.at@setty.com	
SETTY 575 South Charles Street, Suite 40 Baltimore, MD 212021 Phone: 667-309-6036 Email: deepak.at@setty.com	13
Baltimore, MD 212021 Phone: 667-309-6036 Email: deepak.at@setty.com	
100% DESIGN SUBMISSION 1/22/2020	
10	
9	
8	
7 6	
5	
4	
3 2	
1 02/27/2020 ADDENDUM #1	
IO. DATE REVISION	
	ARY
SCHOOL & LOCATION ELLWOOD ELEMENT SCHOOL	ARY
ELLWOOD ELEMENT SCHOOL 6701 N 13TH STREET, PHI	
ELLWOOD ELEMENT. SCHOOL	
ELLWOOD ELEMENT SCHOOL 6701 N 13TH STREET, PHI	
ELLWOOD ELEMENT SCHOOL 6701 N 13TH STREET, PHI PA 19126 PROJECT TITLE CLASSROOM	
ELLWOOD ELEMENT SCHOOL 6701 N 13TH STREET, PHI PA 19126 PROJECT TITLE	
ELLWOOD ELEMENT SCHOOL 6701 N 13TH STREET, PHI PA 19126 PROJECT TITLE CLASSROOM	
ELLWOOD ELEMENT SCHOOL 6701 N 13TH STREET, PHI PA 19126 PROJECT TITLE CLASSROOM MODERNIZATION	
ELLWOOD ELEMENT SCHOOL 6701 N 13TH STREET, PHI PA 19126 PROJECT TITLE CLASSROOM MODERNIZATION DRAWING TITLE	LADELPH
ELLWOOD ELEMENT SCHOOL 6701 N 13TH STREET, PHI PA 19126 PROJECT TITLE CLASSROOM MODERNIZATION DRAWING TITLE ELECTRICAL FIRST FL POWER AND TECHN	LADELPH
ELLWOOD ELEMENT. SCHOOL 6701 N 13TH STREET, PHI PA 19126 PROJECT TITLE CLASSROOM MODERNIZATION DRAWING TITLE ELECTRICAL FIRST FL POWER AND TECHN PLAN - UNIT A	LADELPH
ELLWOOD ELEMENT SCHOOL 6701 N 13TH STREET, PHI PA 19126 PROJECT TITLE CLASSROOM MODERNIZATION DRAWING TITLE ELECTRICAL FIRST FL POWER AND TECHN PLAN - UNIT A OCATION NO. FILE NO	LADELPH
ELLWOOD ELEMENT. SCHOOL 6701 N 13TH STREET, PHIL PA 19126 PROJECT TITLE CLASSROOM MODERNIZATION DRAWING TITLE ELECTRICAL FIRST FL POWER AND TECHN PLAN - UNIT A	LADELPH
ELLWOOD ELEMENT SCHOOL 6701 N 13TH STREET, PHI PA 19126 PROJECT TITLE CLASSROOM MODERNIZATION DRAWING TITLE ELECTRICAL FIRST FL POWER AND TECHN PLAN - UNIT A OCATION NO. FILE NO DRAWN BY CHECKE NRS CF 20	LADELPH LOOR IOLOG

THE SCHOOL DISTRICT OF PHILADELPHIA

OFFICE OF CAPITAL PROGRAMS

440 NORTH BROAD STREET


www.philasd.org

SEAL:

PHILADELPHIA, PA 19130 - 4015

(215) 400 - 4730 | (215) 400 - 4731 (fax)

BONWER

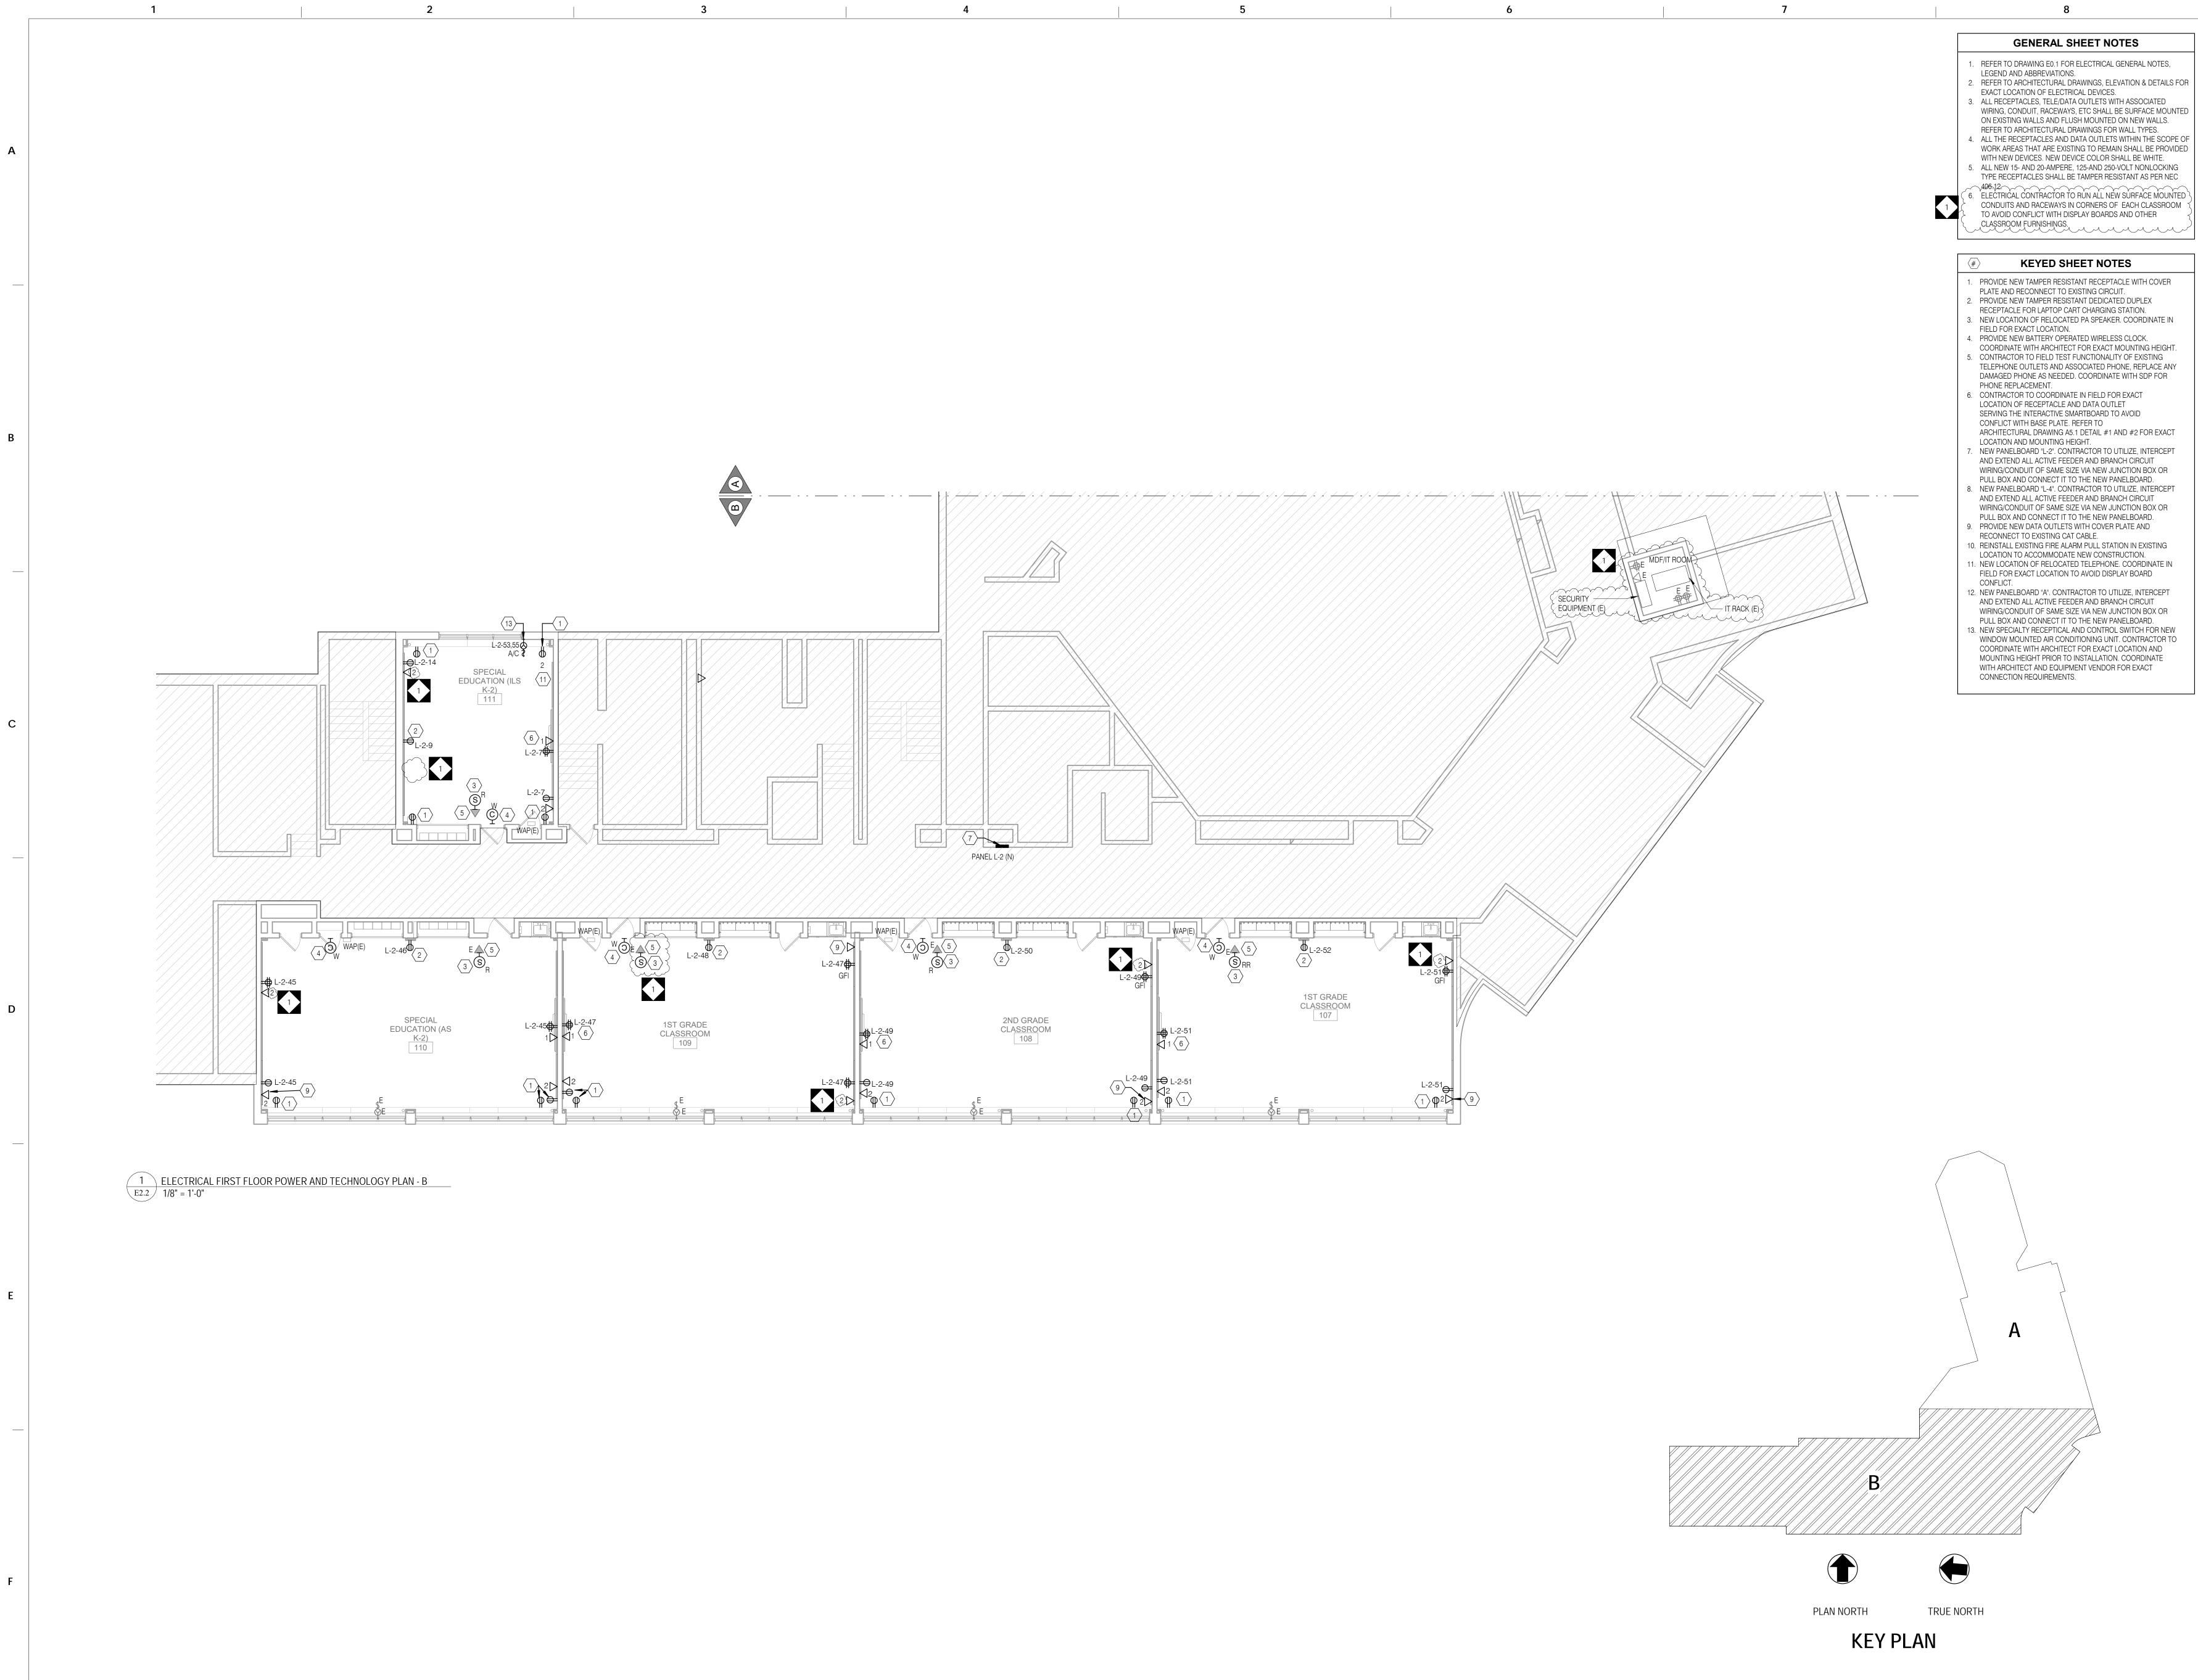

	CONR	ADO D. DELA ORUZ	
	NRAD DELA CRU E AND LICENSE		
CR 40 [°] Pho Em Att SET	E. Winding chanicsburg one: 717-458 ail: jharder@ n: Jessie Har PENGINEER	rg, PA 17055 8-0272 @cra-architects.com rder <u>RS</u>	
Bal Pho	timore, MD one: 667-309		
	0% DESIGN S 2/2020	SUBMISSION	
1/2 10 9 8 7		SUBMISSION	
1/2 10 9 8 7 6 5		SUBMISSION	
1/2 10 9 8 7 6		SUBMISSION	
1/2 10 9 8 7 6 5 4 3 3 2			
1/2 10 9 8 7 6 5 4 3 2 1 NO.	2/2020	ADDENDUM #1 REVISION	
1/2 10 9 8 7 6 5 4 3 2 1 NO. 5 67 PA 07 PA PR C	2/2020 2/2020 02/27/2020 DATE HOOL & LWOOL 01 N 13T 19126 OJECT TIT LASSRC	ADDENDUM #1 REVISION LOCATION D ELEMENTARY 'H STREET, PHILADELPH	
1/2 10 9 8 7 6 5 4 3 2 1 NO. 5 67 PA 0 FR C 07 PA DF EL PC PL LOC	2/2020 2/2020 0 0 0 0 0 0 0 0 0 0 0 0 0	ADDENDUM #1 REVISION LOCATION DELEMENTARY . TIE TIE COM JIZATION TITLE CAL FIRST FLOOR AND TECHNOLOGINIT B D. FILE NO. CHECKED BY DAT	

THE SCHOOL DISTRICT OF PHILA DELPHIA

OFFICE OF CAPITAL PROGRAMS


440 NORTH BROAD STREET

www.philasd.org

SEAL:

PHILADELPHIA, PA 19130 - 4015

(215) 400 - 4730 | (215) 400 - 4731 (fax)

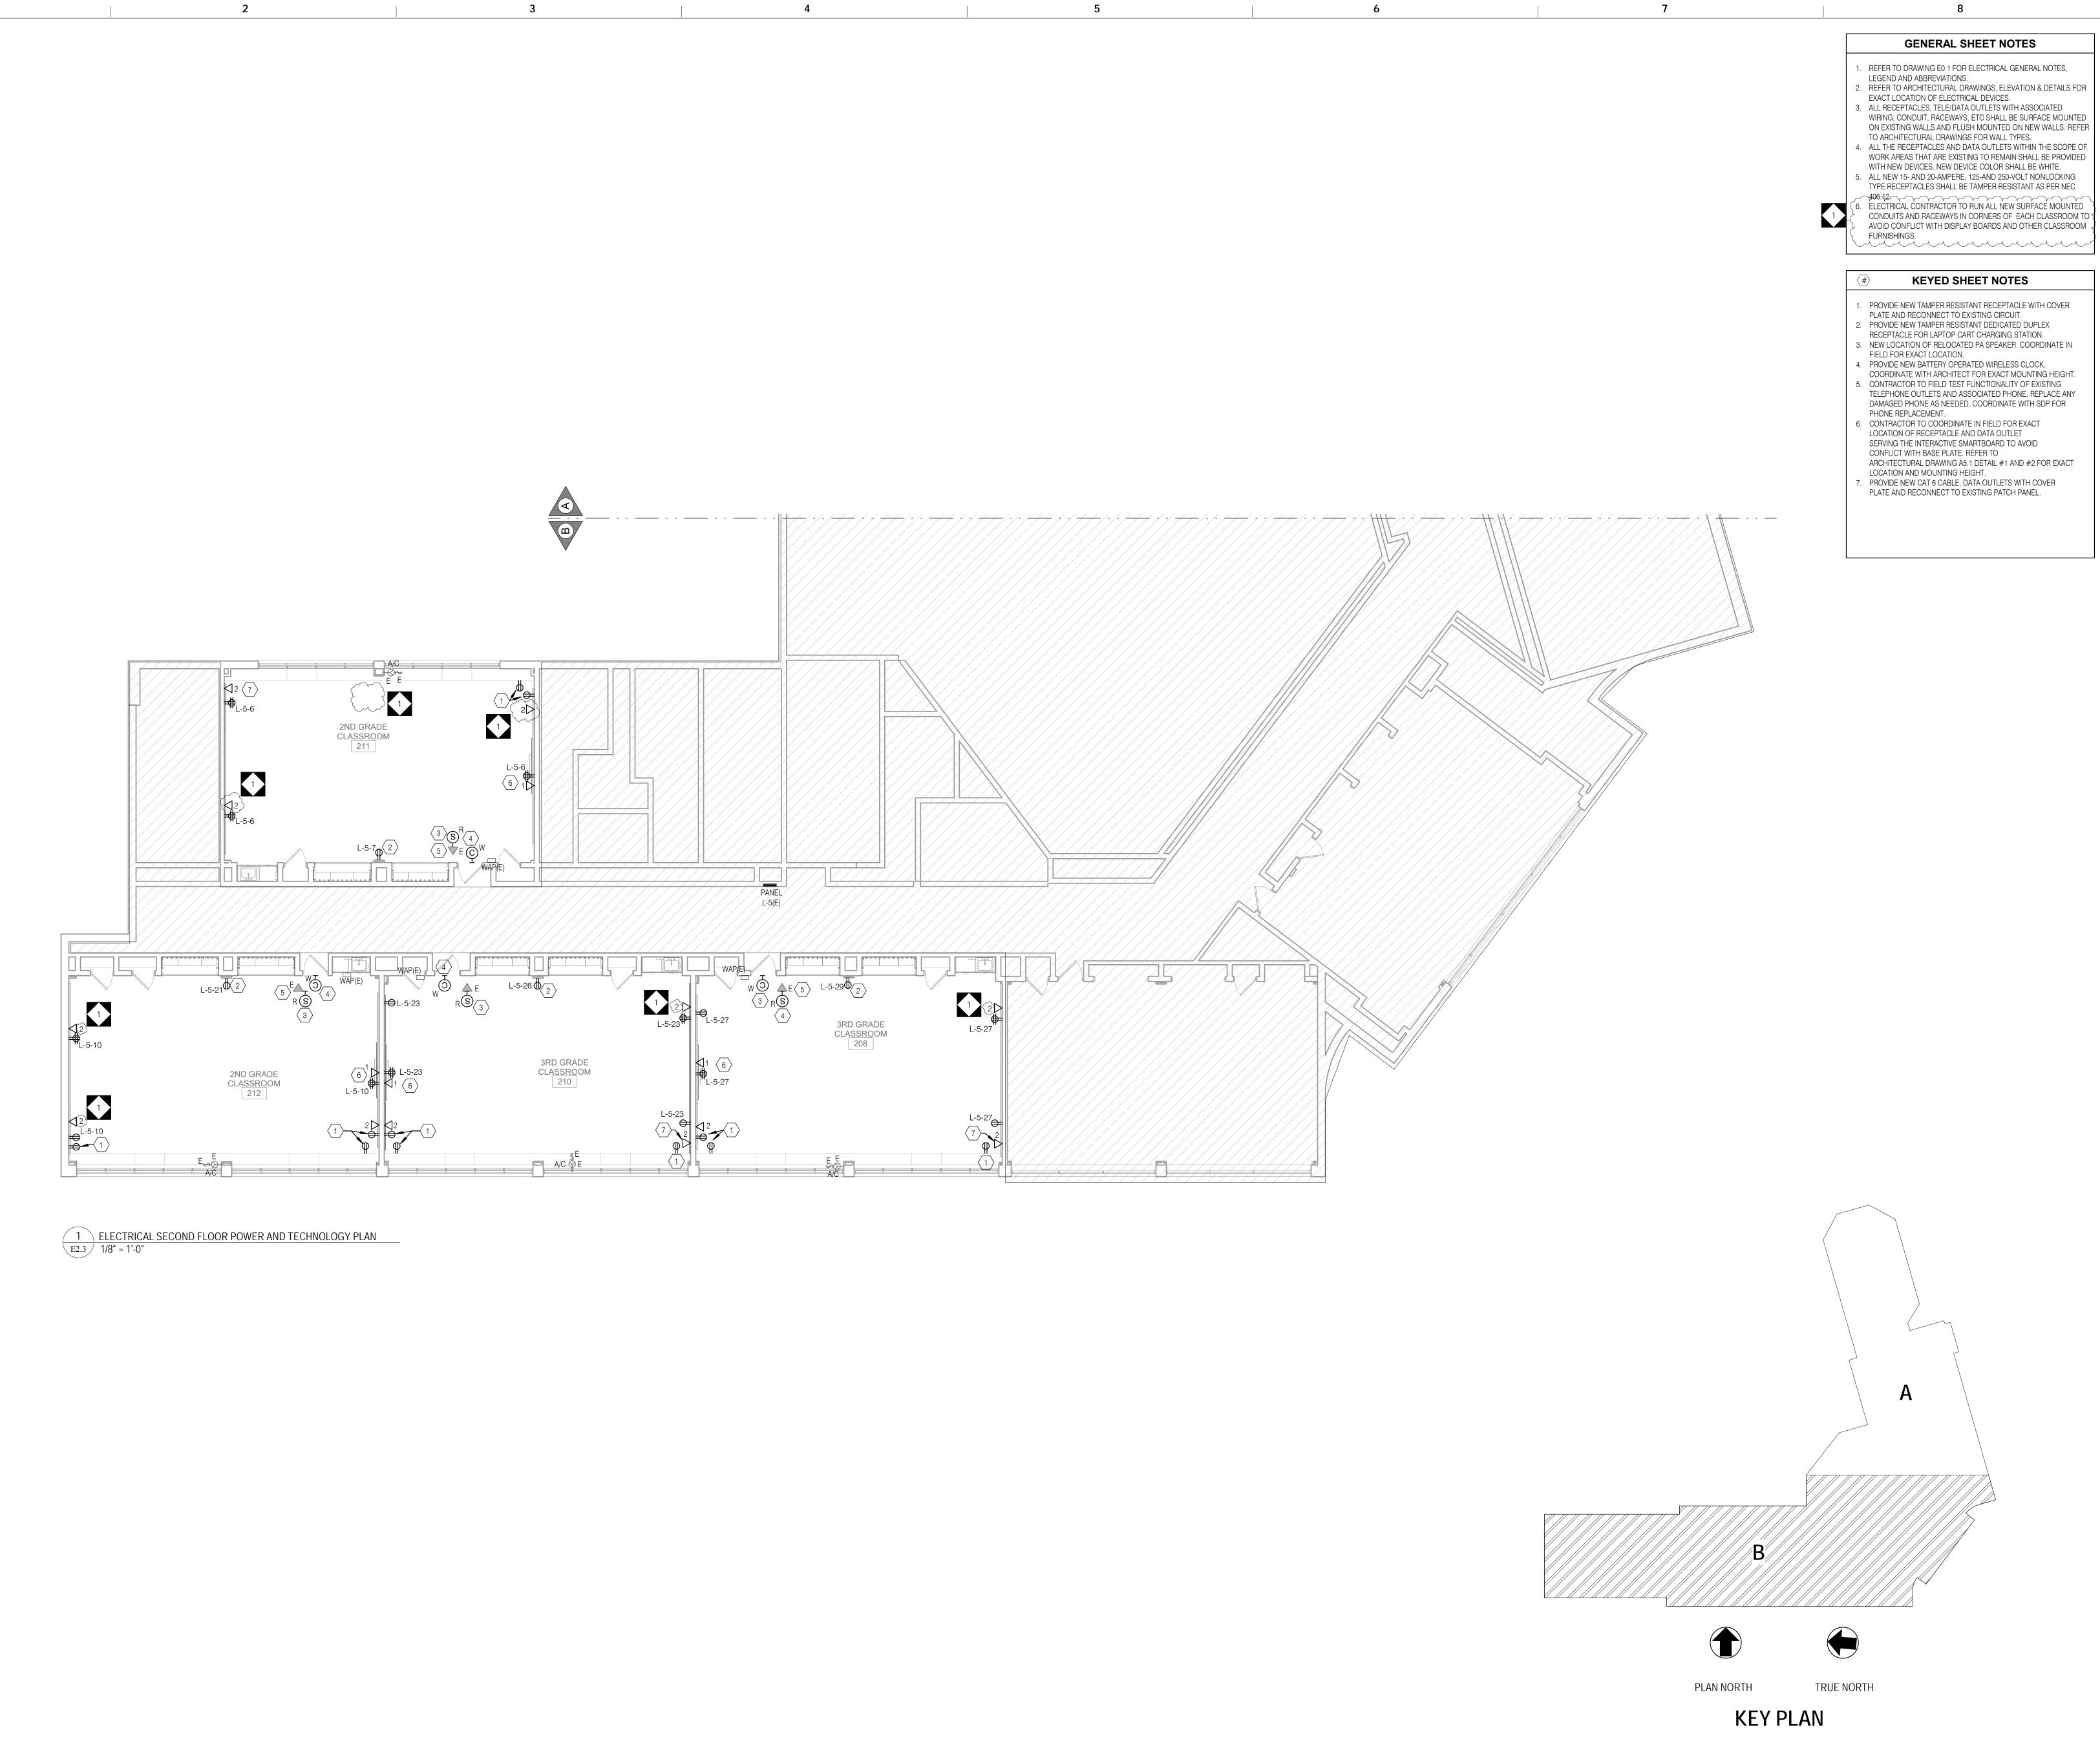

Α

R

100% DESIGN SUBMISSION
1/22/2020
10 9 8
7 6
5 4
3 2
1 02/27/2020 ADDENDUM #1 NO. DATE REVISION
SCHOOL & LOCATION ELLWOOD ELEMENTARY SCHOOL
6701 N 13TH STREET, PHILADELPHIA, PA 19126
PROJECT TITLE CLASSROOM
MODERNIZATION
DRAWING TITLE
ELECTRICAL SECOND FLOOR POWER AND TECHNOLOGY PLAN - UNIT
Image: Register of the second seco
B-039C OF 2018 / 19 B-040C OF 2018 / 19
drawing no. E2.3

SETTY 575 South Charles Street, Suite 403 Baltimore, MD 212021 Phone: 667-309-6036 Email: deepak.at@setty.com Attn: Deepak Ajjimane

ARCHITECT CRABTREE, ROHRBAUGH & ASSOCIATES

401 E. Winding Hill Road Mechanicsburg, PA 17055

Email: jharder@cra-architects.com

Phone: 717-458-0272

Attn: Jessie Harder

MEP ENGINEERS

Conrad dela Cruz State and license no: pe089048



OFFICE OF CAPITAL PROGRAMS

440 NORTH BROAD STREET


www.philasd.org

SEAL:

PHILADELPHIA, PA 19130 - 4015

(215) 400 - 4730 | (215) 400 - 4731 (fax)

ONRADO D. DE

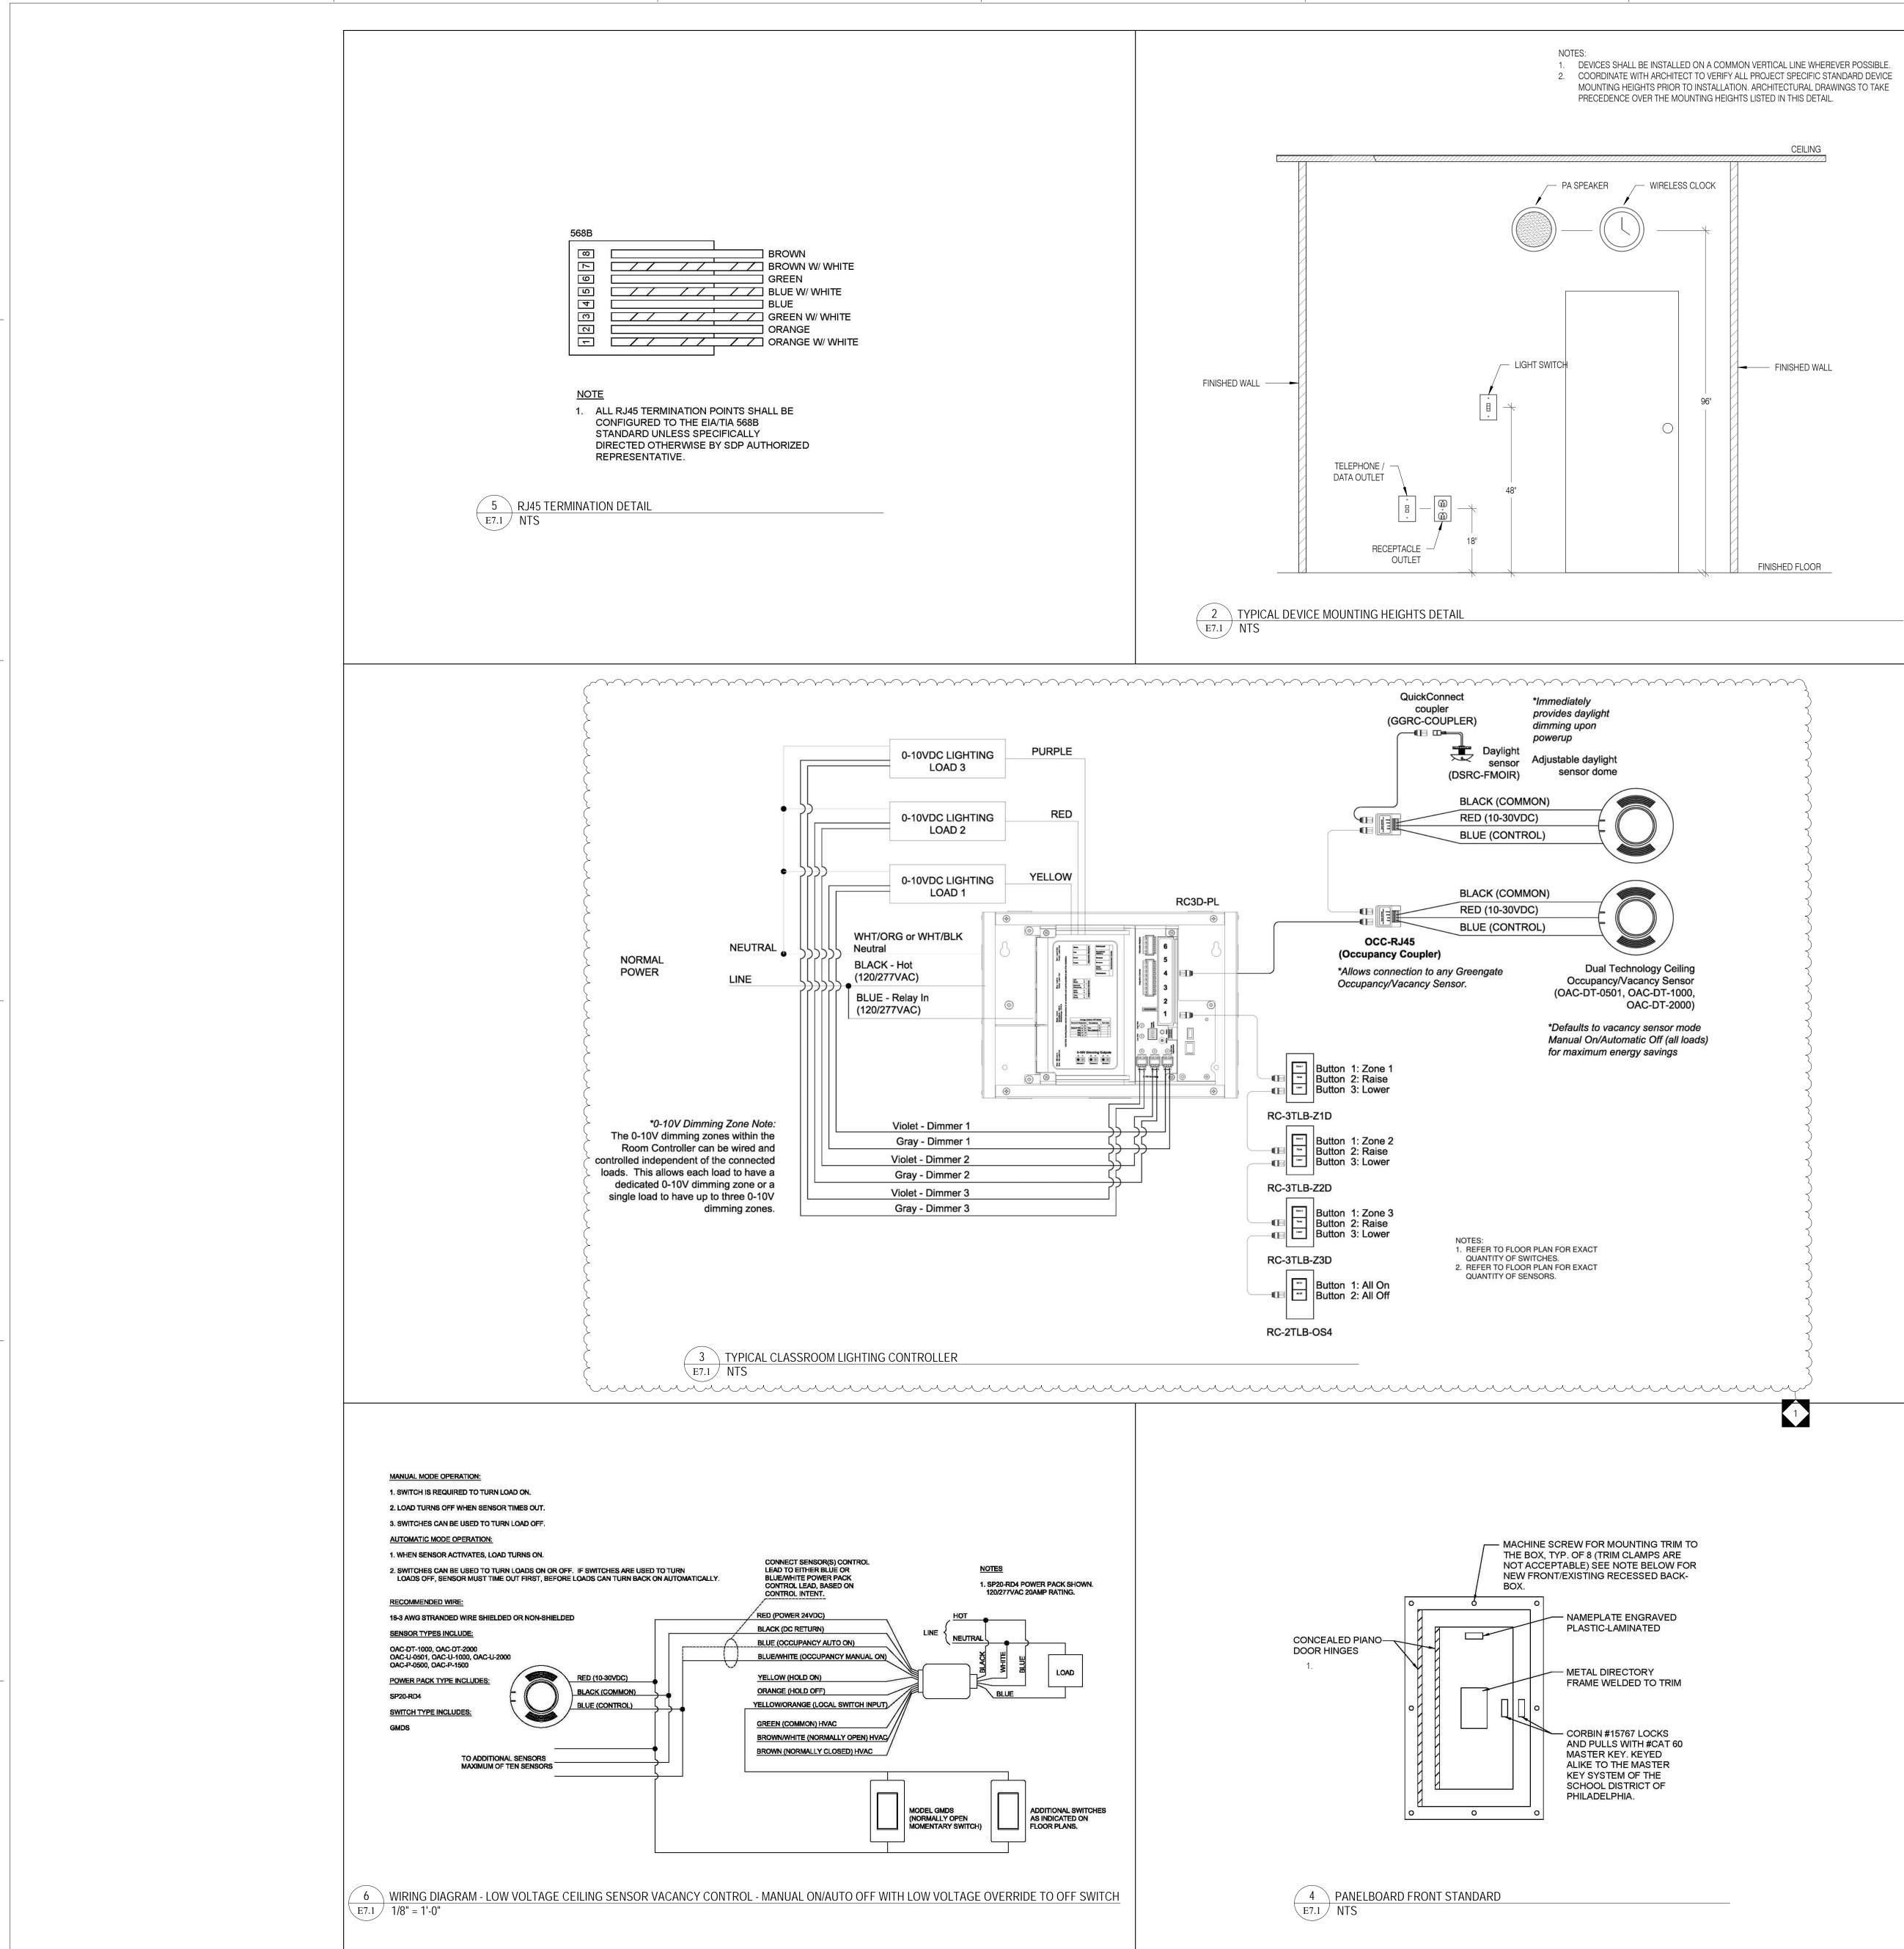

D

2




6



3


8

LESS THAN 1 CFM/SQ FT L RATING AT 400 F -LESS THAN 1 CFM/SQ FT

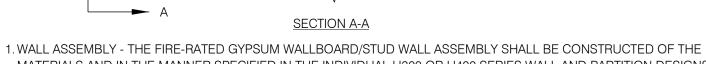

- MATERIALS AND IN THE MANNER SPECIFIED IN THE INDIVIDUAL U300 OR U400 SERIES WALL AND PARTITION DESIGNS IN THE UL FIRE RESISTANCE DIRECTORY AND SHALL INCLUDE THE FOLLOWING CONSTRUCTION FEATURES: 1.1. STUDS - WALL FRAMING MAY CONSIST OF EITHER WOOD STUDS OR STEEL CHANNEL STUDS. WOOD STUDS TO
- CONSIST OF NOM 2 BY 4 IN. LUMBER SPACED 16 IN. OC. STEEL STUDS TO BE MIN 3-5/8 IN. WIDE AND SPACED MAX 24 IN. OC.
- 1.2. GYPSUM BOARD* THICKNESS, TYPE, NUMBER OF LAYERS AND FASTENERS AS REQUIRED IN THE INDIVIDUAL WALL AND PARTITION DESIGN. MAX DIAM OF OPENING IN WOOD STUD WALLS IS 8 IN. MAX DIAM OF OPENING IN STEEL STUD WALLS IS 14 IN. THE HOURLY F RATING OF THE FIRE STOP SYSTEM IS EQUAL TO THE HOURLY FIRE RATING OF THE WALL ASSEMBLY IN WHICH IT IS INSTALLED.
- 2. THROUGH PENETRANT ONE METALLIC PIPE, CONDUIT OR TUBING TO BE INSTALLED WITHIN THE FIRE STOP SYSTEM. THE SPACE BETWEEN PIPE, CONDUIT OR TUBING AND PERIPHERY OF OPENING SHALL BE A MIN 0 IN. (POINT CONTACT) TO A MAX 2 IN. PIPE, CONDUIT OR TUBING TO BE RIGIDLY SUPPORTED ON BOTH SIDES OF WALL ASSEMBLY. THE FOLLOWING TYPES AND SIZES OF METALLIC PIPES, CONDUITS OR TUBING MAY BE USED:
- 2.1. STEEL PIPE NOM 12 IN. DIAM (OR SMALLER) SCHEDULE 5 (OR HEAVIER STEEL PIPE. 2.2. IRON PIPE - NOM 12 IN. DIAM (OR SMALLER) CAST OR DUCTILE IRON PIPE.
- 2.3. CONDUIT NOM 4 IN. DIAM (OR SMALLER) ELECTRICAL METALLIC TUBING, NOM 6 IN. DIAM (OR SMALLER) STEEL CONDUIT OR NOM 1 IN. DIAM (OR SMALLER) FLEXIBLE STEEL CONDUIT.
- 2.4. COPPER TUBING NOM 6 IN. DIAM (OR SMALLER) TYPE L (OR HEAVIER) COPPER TUBING.
- 2.5. COPPER PIPE NOM 6 IN. DIAM (OR SMALLER) REGULAR (OR HEAVIER) COPPER PIPE. 3. FILL, VOID OR CAVITY MATERIAL* - CAULK - MIN 5/8 IN. THICKNESS OF FILL MATERIAL APPLIED WITHIN THE ANNULUS, FLUSH WITH BOTH SURFACES OF WALL. MIN 3/8 IN. DIAM BEAD OF FILL MATERIAL APPLIED AT POINT CONTACT LOCATION AT THE PENETRANT/GYPSUM BOARD INTERFACE ON BOTH SIDES OF WALL.

PENETRATIONS THROUGH STRUCTURE SHALL MAINTAIN FIRE RESISTANCE AND COMPLY WITH SECTION 713.4 OF THE IBC 2018. ALL ANNULAR SPACES BETWEEN RATED STRUCTURE/ENCLOSURE SHALL BE FILLED WITH APPROVED MATERIAL COMPLYING WITH REQUIREMENTS OF UL 1479.

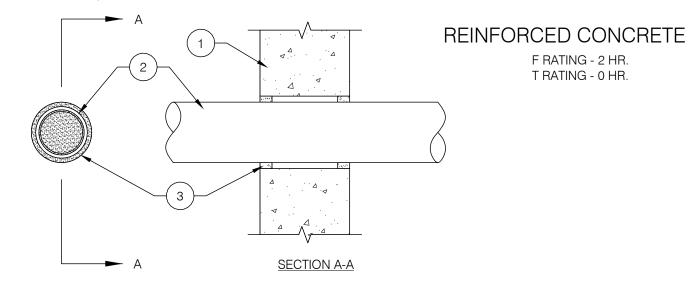

- 1. WALL ASSEMBLY MIN 6 IN. (152 MM) THICK REINFORCED LIGHTWEIGHT OR NORMAL WEIGHT (100-150 PCF OR 1600-2400 KG/M3) CONCRETE. WALL MAY ALSO BE CONSTRUCTED OF ANY UL CLASSIFIED CONCRETE BLOCKS*. MAX DIAM OF OPENING IS 25 IN. (635 MM). SEE CONCRETE BLOCKS (CAZT) CATEGORY IN THE FIRE RESISTANCE DIRECTORY FOR THE NAMES OF MANUFACTURERS.
- 2. THROUGH PENETRANT ONE METALLIC PIPE, TUBING OR CONDUIT TO BE INSTALLED EITHER CONCENTRICALLY OR ECCENTRICALLY WITHIN THE FIRESTOP SYSTEM. THE ANNULAR SPACE BETWEEN PIPES, TUBING OR CONDUITS AND
- PERIPHERY OF OPENING IS DEPENDENT UPON THE TYPE AND MAX DIAM OF THE THROUGH PENETRANT AS TABULATED BELOW. PIPE, TUBING OR CONDUIT TO BE RIGIDLY SUPPORTED ON BOTH SIDES OF WALL ASSEMBLY. THE FOLLOWING
- TYPES AND SIZES OF METALLIC PIPES, TUBING OR CONDUITS MAY BE USED:
- 2.1. STEEL PIPE NOM 24 IN. (610 MM) DIAM (OR SMALLER) SCHEDULE 10 (OR HEAVIER) STEEL PIPE. 2.2. IRON PIPE - NOM 24 IN. (610 MM) DIAM (OR SMALLER) CAST OR DUCTILE IRON PIPE.
- 2.3. COPPER TUBING NOM 6 IN. (152 MM) DIAM (OR SMALLER) TYPE L (OR HEAVIER) COPPER TUBING. 2.4. COPPER PIPE - NOM 6 IN. (152 MM) DIAM (OR SMALLER) REGULAR (OR HEAVIER) COPPER PIPE. 2.5 CONDUIT - NOM 4 IN (102 MM) DIAM (OR SMAILER) STEEL ELECTRICAL METALLIC TUBING, NOM 6 IN. (152 MM) DIAM

2.5.	CONDULT - NOM 4 IN. (102 MM) DIAM	(OR SMALLER) STEEL ELECT	RICAL METALLIC TUBIN
	GALV STEEL CONDUIT OR NOM 1 IN.	DIAM FLEXIBLE STEEL COND	UIT.

	MAX DIAM OF THROUGH	MIN & MAX ANNULAR
TYPE OF THROUGH PENETRANT	PENETRANT, IN. (MM)	SPACE, IN. (MM)
STEEL OR IRON PIPE	4 (102)	0, 1-1/2 (38)
STEEL TUBING OR CONDUIT	4 (102)	0, 1-1/2 (38)
STEEL CONDUIT	6 (152)	1/8 (3), 1/2 (13)
STEEL OR IRON PIPE	24 (610)	1/8 (3), 1/2 (13)
COPPER TUBING OR PIPE	6 (152)	1/8 (3), 1/2 (13)

3. FILL, VOID OR CAVITY MATERIAL* - SEALANT - MIN 5/8 IN. (16 MM) THICKNESS OF FILL MATERIAL APPLIED WITHIN ANNULUS FLUSH WITH BOTH SURFACES OF WALL. AT THE POINT CONTACT LOCATION BETWEEN THROUGH PENETRANT AND CONCRETE, A MIN 3/8 IN. (10 MM) DIAM BEAD OF FILL MATERIAL SHALL BE APPLIED AT THE CONCRETE/THROUGH PENETRANT INTERFACE ON BOTH SURFACES OF WALL.

PENETRATIONS THROUGH STRUCTURE SHALL MAINTAIN FIRE RESISTANCE AND COMPLY WITH SECTION 713.4 OF THE IBC 2018. ALL ANNULAR SPACES BETWEEN RATED STRUCTURE/ENCLOSURE SHALL BE FILLED WITH APPROVED MATERIAL COMPLYING WITH REQUIREMENTS OF UL 1479.

> $\langle 1 \rangle$ Through-penetration fire stop detail E7.1 NTS

SEAL:	RECISTERED NUCEPSEUL DO D. DELA CRUZ ENGINEER No. PEURIOLIS V S Y L V A
CONRAD DELA CRUZ STATE AND LICENSE NO	D: PE089048
401 E. Winding Hi Mechanicsburg, Phone: 717-458-0 Email: jharder@c Attn: Jessie Harde <u>MEP ENGINEERS</u> SETTY	PA 17055 0272 ra-architects.com er es Street, Suite 403 2021 5036 t@setty.com
Email: deepak.a	t@setty.com
<u>100% DESIGN SUI</u> 1/22/2020	BMISSION
<u>1/22/2020</u>	BMISSION
<u>1/22/2020</u>	BMISSION
1/22/2020 10 9 8 7 6 5	BMISSION
1/22/2020 10 9 8 7 6	BMISSION
1/22/2020 10 9 8 7 6 5 4 3	DDENDUM #1
1/22/2020 10 9 8 7 6 5 4 3 2 1 02/27/2020 A NO. DATE SCHOOL & LO ELLWOOD	DDENDUM #1 EVISION
1/22/2020 10 9 8 7 6 5 4 3 2 1 02/27/2020 A NO. DATE SCHOOL & LO ELLWOOD SCHOOL & LO 6701 N 13TH	DDENDUM #1 EVISION OCATION
1/22/2020 10 9 8 7 6 5 4 3 2 1 02/27/2020 A NO. DATE SCHOOL & LO ELLWOOD SCHOOL & LO	DDENDUM #1 EVISION OCATION ELEMENTARY STREET, PHILADELPHI
1/22/2020 10 9 8 7 6 5 4 3 2 1 02/27/2020 A NO. DATE SCHOOL & LO ELLWOOD SCHOOL & LO FULWOOD SCHOOL TITL 6701 N 13TH PROJECT TITL CLASSROO	DDENDUM #1 EVISION OCATION ELEMENTARY STREET, PHILADELPHI E OM ZATION
1/22/2020 10 9 8 7 6 5 4 3 2 1 02/27/2020 A NO: DATE SCHOOL & LO ELLWOOD SCHOOL & LO ELLWOOD SCHOOL & LO PROJECT TITL CLASSROO MODERNIX	DDENDUM #1 EVISION OCATION ELEMENTARY STREET, PHILADELPHI E OM ZATION
1/22/2020 10 9 8 7 6 5 4 3 2 1 02/27/2020 A NO: DATE SCHOOL & LO ELLWOOD SCHOOL & LO ELLWOOD SCHOOL & LO PROJECT TITL CLASSROO MODERNIX	DDENDUM #1 EVISION OCATION ELEMENTARY STREET, PHILADELPHI E OM ZATION

THE SCHOOL DISTRICT OF