

**THE SCHOOL DISTRICT OF PHILADELPHIA
Office of Capital Programs
440 North Broad Street, 3rd Floor – Suite 371
Philadelphia, PA 19130**

TELEPHONE: (215) 400-4730

Addendum No. 01

Subject: Stephen Decatur K-8 School
SDP Contract No. B-082 18/19

Location: Stephen Decatur K-8 School
3500 Academy Road
Philadelphia, PA 19154

This Addendum, dated October 28th, 2020, shall modify and become part of the Contract Documents for the work of this project. Any items not mentioned herein, or affected by, shall be performed strictly in accordance with the original documents.

Bid RFIs:

Question #1:

Please clarify if spec section 262816 Enclosed Switches & Circuit Breakers is applicable to this project. There does not appear to be any scope regarding that spec in the drawings.

Response:

An enclosed switch is indicated on the riser diagram of FA4.0 ahead of the FACP.

Question #2:

Fire alarm general note 24 on drawing FA1.0 is not applicable because there is no scope in the project to replace the fire protection or elevator systems. Please confirm this note can be removed.

Response:


It is correct that the fire protection/sprinkler systems and elevators are not being replaced, and any present are existing to remain; contractor scope of work shall include monitoring any existing points of monitoring for these systems, and as indicated in the latest contract documents.



FIRE ALARM REPLACEMENT PROJECT FOR

SDP#: B-082 C 18/19

ENGINEERING CONTACT

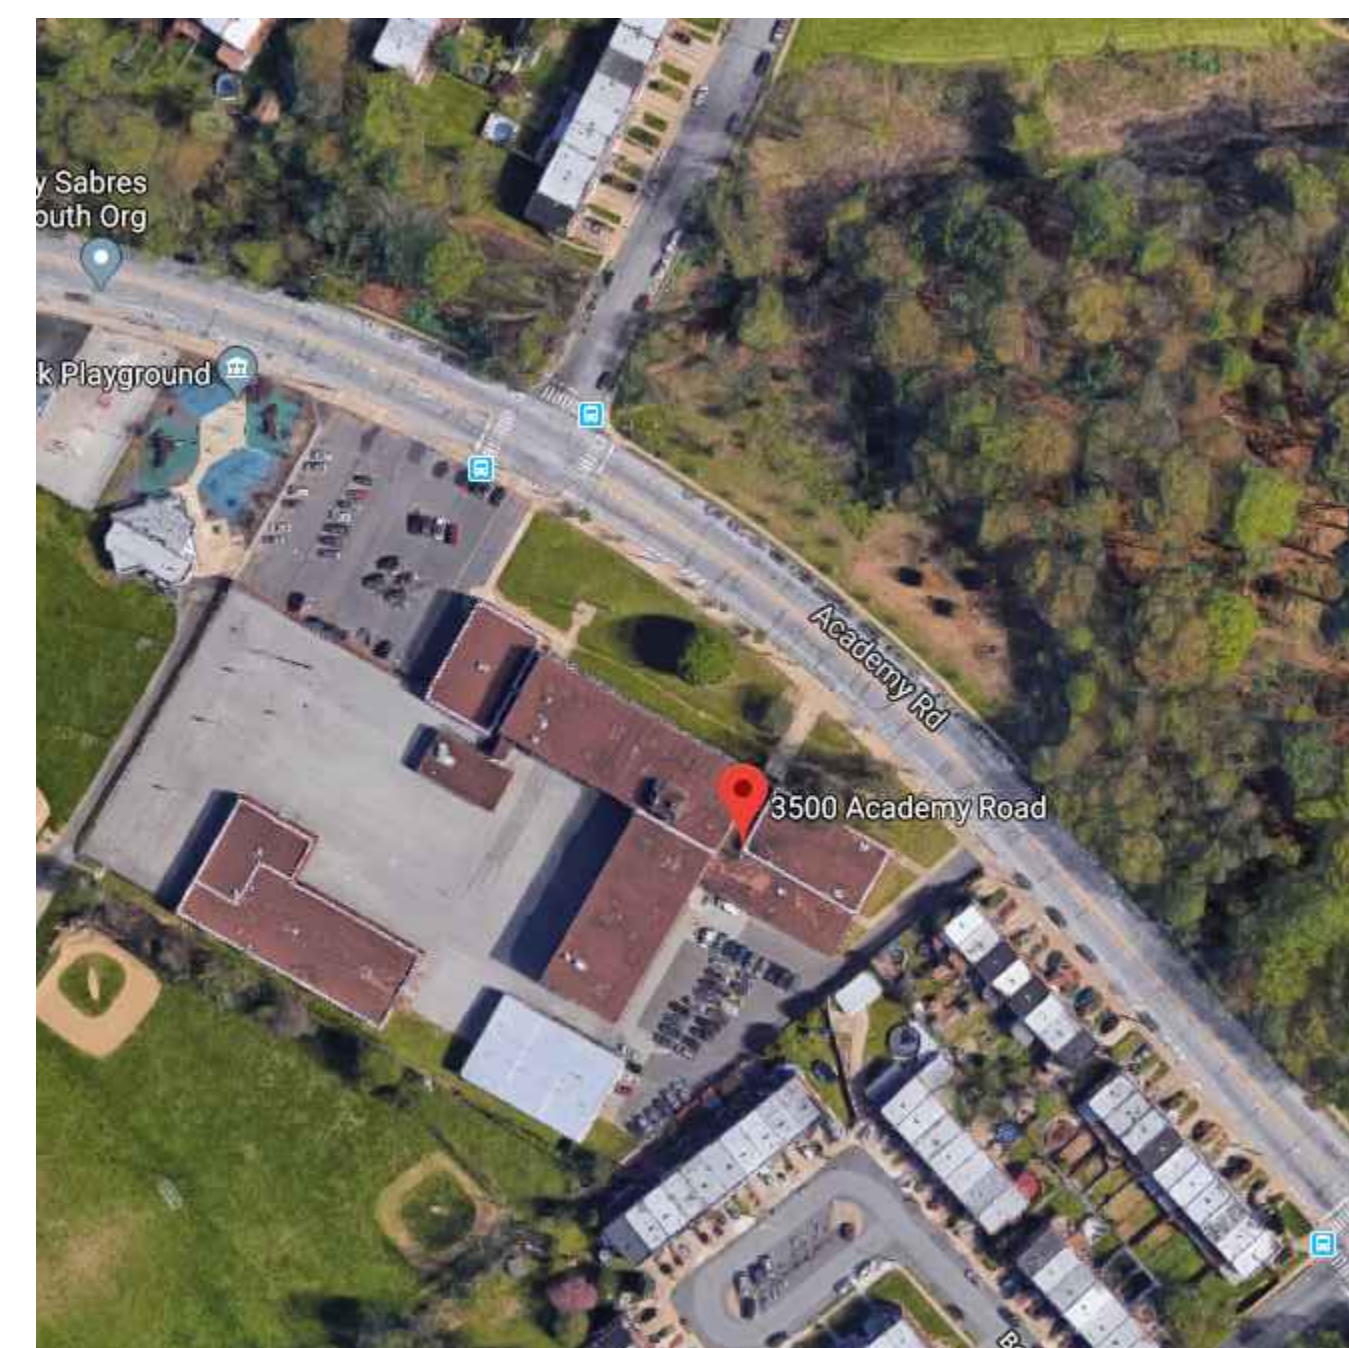A map of the Parkwood and Millbrook areas in Raleigh, North Carolina. The map shows major roads like US-101 (Academy Rd) and US-421 (Liberty Blvd). A red pin marks the location of 3500 Academy Road. Other labeled locations include PNC Bank, Harbor Freight Tools, Knights Road Shopping Center, The Arts Academy at Benjamin Rush, and Northeast Family YMCA. The map also shows various residential streets and green spaces.

5 Christy Drive, Suite 307
Chadds Ford, PA 19317
610.558.3464 office




THE SCHOOL DISTRICT OF
PHILADELPHIA

OFFICE OF CAPITAL PROGRAMS

SEAL:

NAME (LICENSED PROFESSIONAL): PETER J. BONNES DATE
STATE AND LICENSE NO: PA 046114E 09/30/2021

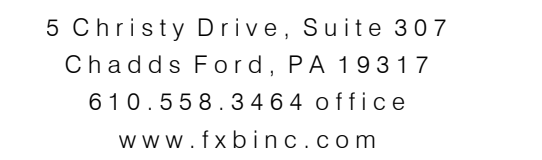

Engineering Excellence Since 1968

NOT TO BE USED FOR
CONSTRUCTION

CONTRACT #S

32 C 18/19

SCHOOL & LOCATION
STEPHEN DECATUR
K-8 SCHOOL
3500 ACADEMY ROAD,
PHILADELPHIA, PA 19154

DRAWING TITLE

OVER SHEET

DRAWN BY AVW / RCK	CHECKED BY PJB
DRAWING NO. CS1.0	
SHEET 01 OF 28	

FIRE ALARM TESTING NOTES


FIRE ALARM GENERAL NOTES

- BIDDING INSTRUCTIONS - BASE BID

ELECTRICAL GENERAL NOTES

1. ALL FEEDER AND BRANCH CIRCUIT WIRING SHALL BE RUN IN CONDUIT AS INDICATED IN THE SECTION 26 SPECIFICATIONS. MC CABLE SHALL ONLY BE USED FOR LIGHTING POWER WHIPS ABOVE ACT. TYPE "AC" OR "TM" CABLE SHALL NOT BE USED. AN INSULATED EQUIPMENT GROUNDING CONDUCTOR MUST BE RUN IN ALL BRANCH CIRCUITS. SEE SPECIFICATIONS FOR ADDITIONAL REQUIREMENTS.
2. ALL EQUIPMENT SHALL BE INSTALLED IN A NEAT AND WORKMANLIKE MANNER, PARALLEL & PERPENDICULAR TO BUILDING STRUCTURE.
3. MINIMUM CONDUIT SIZE SHALL BE 3/4", UNLESS NOTED OTHERWISE. MINIMUM WIRE SIZE SHALL BE #12 AWG TYPE THHN/THWN FOR POWER AND #14 THHN/THWN FOR CONTROL. ALL WIRING TO BE COPPER.
4. ALL RACEWAYS RUNNING THROUGH BUILDING EXPANSION JOINTS SHALL BE EQUIPPED WITH EXPANSION FITTINGS.
5. ALL WORK SHALL BE PERFORMED IN STRICT ACCORDANCE WITH THE 2017 NATIONAL ELECTRICAL CODE, THE PHILADELPHIA FIRE CODE, IBC 2018, IECC 2018, IFC 2018, THE LATEST STATE CODES, AND ALL LOCAL CODES.
6. ALL ELECTRICAL EQUIPMENT, INCLUDING, BUT NOT LIMITED TO CONDUIT, WIRE, BOXES, AND FITTINGS, SHALL BE NEW AND FREE OF DEFECTS, SHALL BEAR THE UL LABEL AND SHALL MEET NEWA AND ANSI STANDARDS.
7. ALL WIRE AND MATERIALS SHALL BE GUARANTEED FREE FROM DEFECTS FOR A MINIMUM PERIOD OF ONE YEAR UNLESS NOTED OTHERWISE. THE WARRANTY PERIOD SHALL BEGIN AT THE DATE OF BENEFICIAL OCCUPANCY OF THE SPACE UNLESS NOTED OTHERWISE IN THE PROJECT SPECIFICATIONS.
8. THE CONTRACTOR IS RESPONSIBLE FOR FILING AND PAYING ALL FEES AND OBTAINING NECESSARY PERMITS, CERTIFICATES OF INSPECTION AND SHALL DELIVER ALL CERTIFICATES OF INSPECTION AND/OR CONSTRUCTION MANAGER OR GENERAL CONTRACTOR INCLUDING COPIES WITH MAINTENANCE MANUALS.
9. ALL NEW BRANCH CIRCUITS SHALL CONTAIN DEDICATED NEUTRAL CONDUCTORS. DO NOT SHARE NEUTRAL CONDUCTORS.
10. CONTRACTOR IS RESPONSIBLE FOR CREATING AND TURNING OVER COMPLETE RED LINED AS-BUILT DRAWINGS TO INDICATE ANY DEVIATIONS IN DESIGN DOCUMENTS. CONTRACTOR SHALL SUBMIT BOTH HARD COPIES AND DIGITAL COPIES OF "AS-BUILT" DRAWINGS UPON ACCEPTANCE OF COMPLETION OF CONSTRUCTION.
11. CONTRACTOR IS RESPONSIBLE FOR CONFIRMING ALL EXISTING SITE CONDITIONS. COORDINATE SITE CONDITIONS WHICH DEVIATE FROM DRAWINGS WITH THIS ENGINEER.
12. ALL NEW BRANCH CIRCUITS, SHALL BE SURFACE MOUNTED, UNLESS NOTED OTHERWISE. PROVIDE FACEPLATES, BACKBOXES, MOUNTING HARDWARE, SURFACE MOUNTED CONDUIT, AND SIMILAR APPROPRIATENESS FOR A FULL INSTALLATION OF ALL REQUIRED WORK.
13. NEW RECEPTABLES MUST BE TAMPER PROOF PER NEC 2017.
14. PATCH, REPAIR, AND PAINT ALL HOLES AND COSMETIC BLEMISHES DUE TO REMOVAL OF DEVICES AND EQUIPMENT. INSTALL BLACK STAINLESS STEEL FACEPLATES ON UNCOVERED OUTLET AND SWITCH BOXES.
15. CAT 5/6 CABLEING FOR LIGHTING CONTROLS SHALL BE PLENUM RATED. ABOVE DROP CEILING, CAT 5/6 CABLE SHALL BE SUSPENDED FROM J-HOOKS, IN WALLS OR EXPOSED, CAT 5/6

DEVICE ADDRESSING

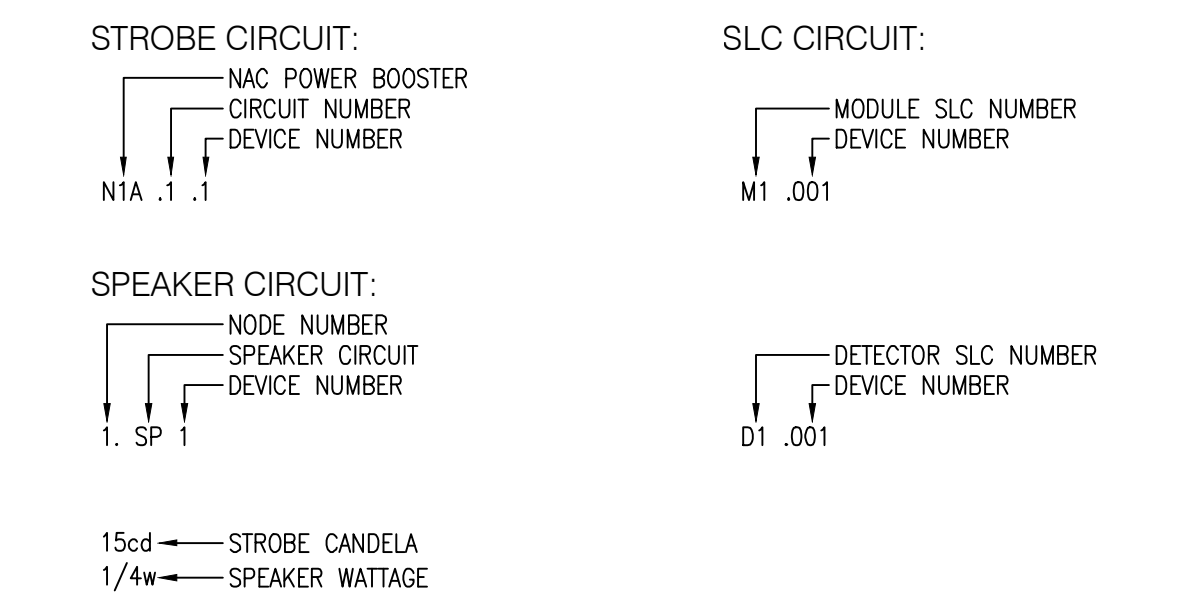

FXB
PARTNERSHIPS THROUGH
ENGINEERING

5 Christy Drive, Suite 307
Chadds Ford, PA 19317
610.558.3464 office
www.fxbinco.com

Engineering Excellence Since 1968

BID
ISSUE ONLY

NOT TO BE USED FOR
CONSTRUCTION

CONTRACT #S
B-082 C 18/19

1	10.28.20	ADDENDUM # 1
0	07.31.20	ISSUE FOR BID
C	12.06.19	ISSUE FOR 100% REVIEW
B	11.21.19	ISSUE FOR 90% REVIEW
A	08.30.19	ISSUE FOR 40% REVIEW
NO.	DATE	REVISION

SCHOOL & LOCATION
**STEPHEN DECATUR
K-8 SCHOOL**
3500 ACADEMY ROAD,
PHILADELPHIA, PA 19154

PROJECT TITLE

FIRE ALARM REPLACEMENT PROJECT

DRAWING TITLE


FIRE ALARM
SYMBOLS & NOTES

DRAWN BY AVW / RCK	CHECKED BY PJB
-----------------------	-------------------

DRAWING NO.

FA1.0

SHEET 02 OF 28

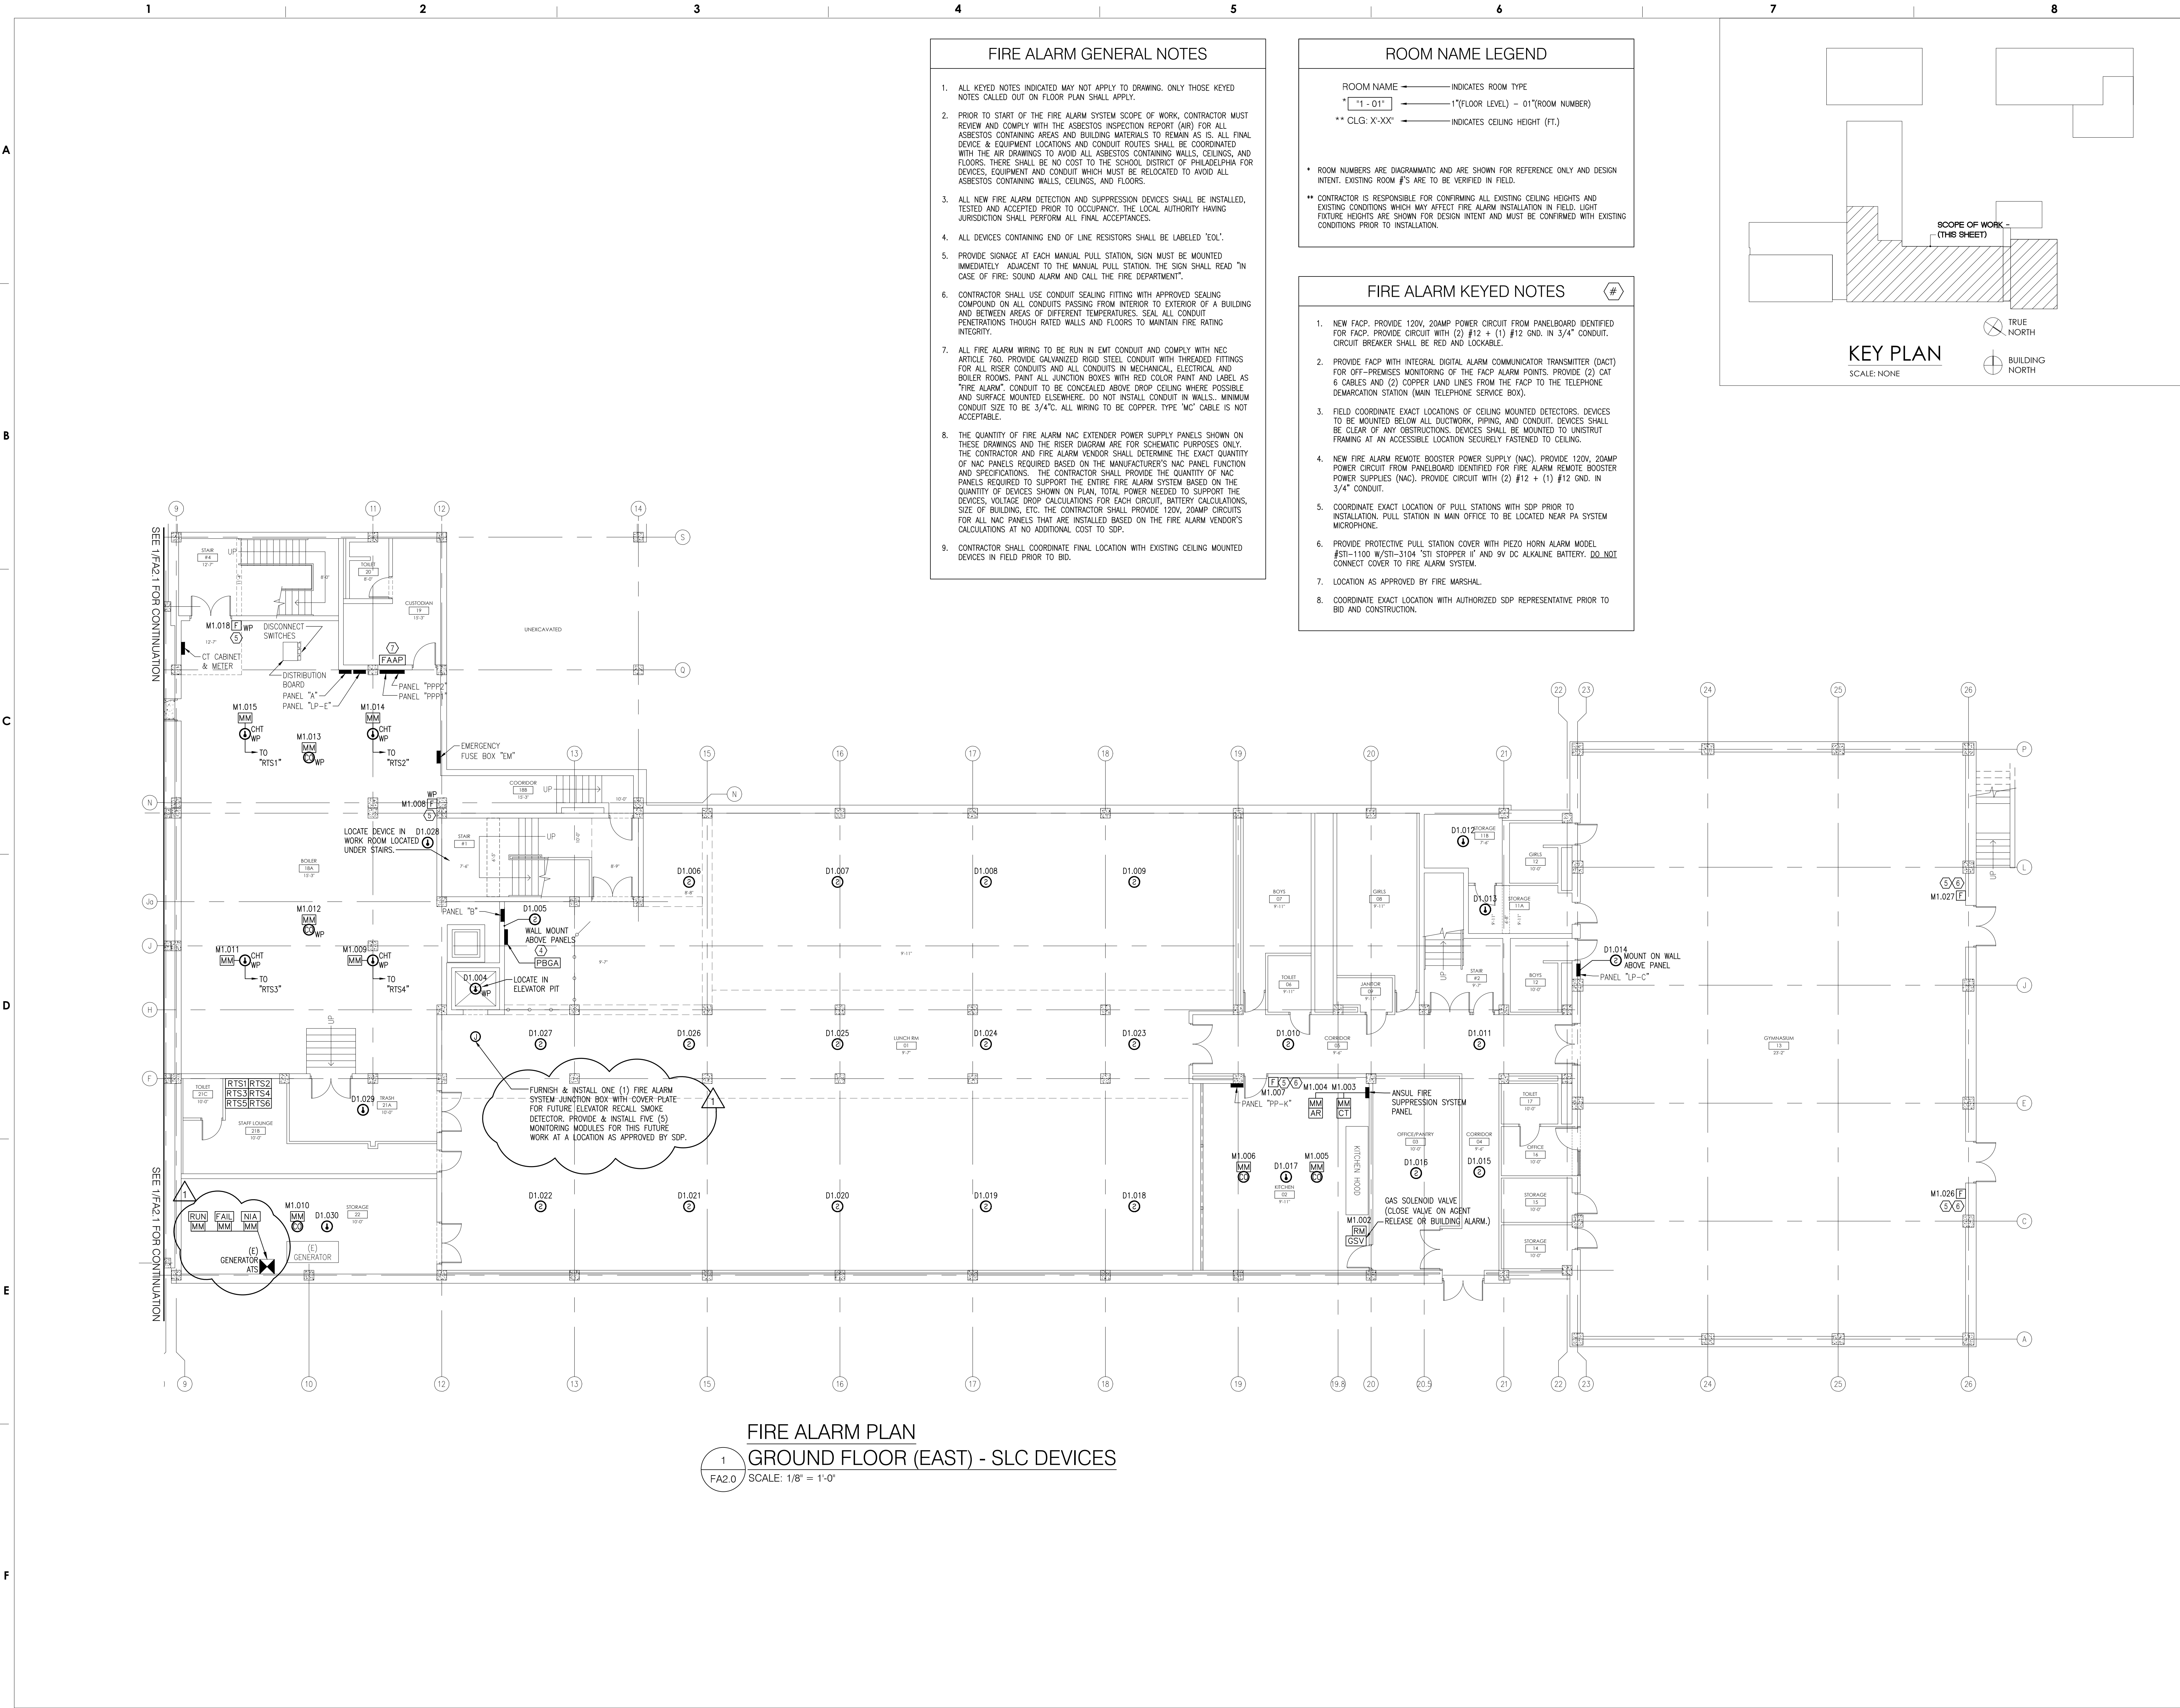

FIRE ALARM GENERAL NOTES

1. ALL KEYED NOTES INDICATED MAY NOT APPLY TO DRAWING. ONLY THOSE KEYED NOTES CALLED OUT ON FLOOR PLAN SHALL APPLY.
2. PRIOR TO START OF THE FIRE ALARM SYSTEM SCOPE OF WORK, CONTRACTOR MUST REVIEW AND COMPLY WITH THE ASBESTOS INSPECTION REPORT (AIR) FOR ALL ASBESTOS CONTAINING AREAS AND BUILDING MATERIALS TO REMAIN AS IS. ALL FINAL DEVICE & EQUIPMENT LOCATIONS AND CONDUIT ROUTES SHALL BE COORDINATED WITH THE AIR DRAWINGS TO AVOID ALL ASBESTOS CONTAINING WALLS, CEILINGS, AND FLOORS. THERE SHALL BE NO COST TO THE SCHOOL DISTRICT OF PHILADELPHIA FOR DEVICES, EQUIPMENT AND CONDUIT WHICH MUST BE RELOCATED TO AVOID ALL ASBESTOS CONTAINING WALLS, CEILINGS, AND FLOORS.
3. ALL NEW FIRE ALARM DETECTION AND SUPPRESSION DEVICES SHALL BE INSTALLED, TESTED AND ACCEPTED PRIOR TO OCCUPANCY. THE LOCAL AUTHORITY HAVING JURISDICTION SHALL PERFORM ALL FINAL ACCEPTANCES.
4. ALL DEVICES CONTAINING END OF LINE RESISTORS SHALL BE LABELED 'EOL'.
5. PROVIDE SIGNAGE AT EACH MANUAL PULL STATION. SIGN MUST BE MOUNTED IMMEDIATELY ADJACENT TO THE MANUAL PULL STATION. THE SIGN SHALL READ "IN CASE OF FIRE: SOUND ALARM AND CALL THE FIRE DEPARTMENT".
6. CONTRACTOR SHALL USE CONDUIT SEALING FITTING WITH APPROVED SEALING COMPOUND ON ALL CONDUITS PASSING FROM INTERIOR TO EXTERIOR OF A BUILDING AND BETWEEN AREAS OF DIFFERENT TEMPERATURES. SEAL ALL CONDUIT PENETRATIONS THROUGH RATED WALLS AND FLOORS TO MAINTAIN FIRE RATING INTEGRITY.
7. ALL FIRE ALARM WIRING TO BE RUN IN EMT CONDUIT AND COMPLY WITH NEC ARTICLE 760. PROVIDE GALVANIZED RIGID STEEL CONDUIT WITH THREADED FITTINGS FOR ALL RISER CONDUITS AND ALL CONDUITS IN MECHANICAL, ELECTRICAL AND BOILER ROOMS. PAINT ALL JUNCTION BOXES WITH RED COLOR PAINT AND LABEL AS "FIRE ALARM". CONDUIT TO BE CONCEALED ABOVE DROP CEILING WHERE POSSIBLE AND SURFACE MOUNTED ELSEWHERE. DO NOT INSTALL CONDUIT IN WALLS. MINIMUM CONDUIT SIZE TO BE 3/4". ALL WIRING TO BE COPPER. TYPE "MC" CABLE IS NOT ACCEPTABLE.
8. THE QUANTITY OF FIRE ALARM NAC EXTENDER POWER SUPPLY PANELS SHOWN ON THESE DRAWINGS AND THE RISER DIAGRAM ARE FOR SCHEMATIC PURPOSES ONLY. THE CONTRACTOR AND FIRE ALARM VENDOR SHALL DETERMINE THE EXACT QUANTITY OF NAC PANELS REQUIRED BASED ON THE MANUFACTURER'S NAC PANEL FUNCTION AND SPECIFICATIONS. THE CONTRACTOR SHALL PROVIDE THE QUANTITY OF NAC PANELS REQUIRED TO SUPPORT THE ENTIRE FIRE ALARM SYSTEM BASED ON THE QUANTITY OF DEVICES SHOWN ON PLAN, TOTAL POWER NEEDED TO SUPPORT THE DEVICES, VOLTAGE DROP CALCULATIONS FOR EACH CIRCUIT, BATTERY CALCULATIONS, SIZE OF BUILDING, ETC. THE CONTRACTOR SHALL PROVIDE 120V, 20AMP CIRCUITS FOR ALL NAC PANELS THAT ARE INSTALLED BASED ON THE FIRE ALARM VENDOR'S CALCULATIONS AT NO ADDITIONAL COST TO SDP.
9. CONTRACTOR SHALL COORDINATE FINAL LOCATION WITH EXISTING CEILING MOUNTED DEVICES IN FIELD PRIOR TO BID.

ROOM NAME LEGEND


ROOM NAME ——— INDICATES ROOM TYPE
"1" - 01" ——— 1"(FLOOR LEVEL) - 01"(ROOM NUMBER)
** CLG: X'-XX" ——— INDICATES CEILING HEIGHT (FT.)

* ROOM NUMBERS ARE DIAGRAMATIC AND ARE SHOWN FOR REFERENCE ONLY AND DESIGN INTENT. EXISTING ROOM #'S ARE TO BE VERIFIED IN FIELD.

** CONTRACTOR IS RESPONSIBLE FOR CONFIRMING ALL EXISTING CEILING HEIGHTS AND EXISTING CONDITIONS WHICH MAY AFFECT FIRE ALARM INSTALLATION IN FIELD. LIGHT FIXTURE HEIGHTS ARE SHOWN FOR DESIGN INTENT AND MUST BE CONFIRMED WITH EXISTING CONDITIONS PRIOR TO INSTALLATION.

FIRE ALARM KEYED NOTES

1. NEW FACP: PROVIDE 120V, 20AMP POWER CIRCUIT FROM PANELBOARD IDENTIFIED FOR FACP. PROVIDE CIRCUIT WITH (2) #12 + (1) #12 GND. IN 3/4" CONDUIT. CIRCUIT BREAKER SHALL BE RED AND LOCKABLE.
2. PROVIDE FACP WITH INTEGRAL DIGITAL ALARM COMMUNICATOR TRANSMITTER (DACT) FOR OFF-PREMISES MONITORING OF THE FACP ALARM POINTS. PROVIDE (2) CAT 6 CABLES AND (2) COPPER LAND LINES FROM THE FACP TO THE TELEPHONE DEMARCATION STATION (MAIN TELEPHONE SERVICE BOX).
3. FIELD COORDINATE EXACT LOCATIONS OF CEILING MOUNTED DETECTORS. DEVICES TO BE MOUNTED BELOW ALL DUCTWORK, PIPING, AND CONDUIT. DEVICES SHALL BE CLEAR OF ANY OBSTRUCTIONS. DEVICES SHALL BE MOUNTED TO UNISTRUT FRAMING AT AN ACCESSIBLE LOCATION SECURELY FASTENED TO CEILING.
4. NEW FIRE ALARM REMOTE BOOSTER POWER SUPPLY (NAC). PROVIDE 120V, 20AMP POWER CIRCUIT FROM PANELBOARD IDENTIFIED FOR FIRE ALARM REMOTE BOOSTER POWER SUPPLIES (NAC). PROVIDE CIRCUIT WITH (2) #12 + (1) #12 GND. IN 3/4" CONDUIT.
5. COORDINATE EXACT LOCATION OF PULL STATIONS WITH SDP PRIOR TO INSTALLATION. PULL STATION IN MAIN OFFICE TO BE LOCATED NEAR PA SYSTEM MICROPHONE.
6. PROVIDE PROTECTIVE PULL STATION COVER WITH PIEZO HORN ALARM MODEL #STI-1100 W/STI-3104 "STI STOPPER" IF AND 9V DC ALKALINE BATTERY. DO NOT CONNECT COVER TO FIRE ALARM SYSTEM.
7. LOCATION AS APPROVED BY FIRE MARSHAL.
8. COORDINATE EXACT LOCATION WITH AUTHORIZED SDP REPRESENTATIVE PRIOR TO BID AND CONSTRUCTION.

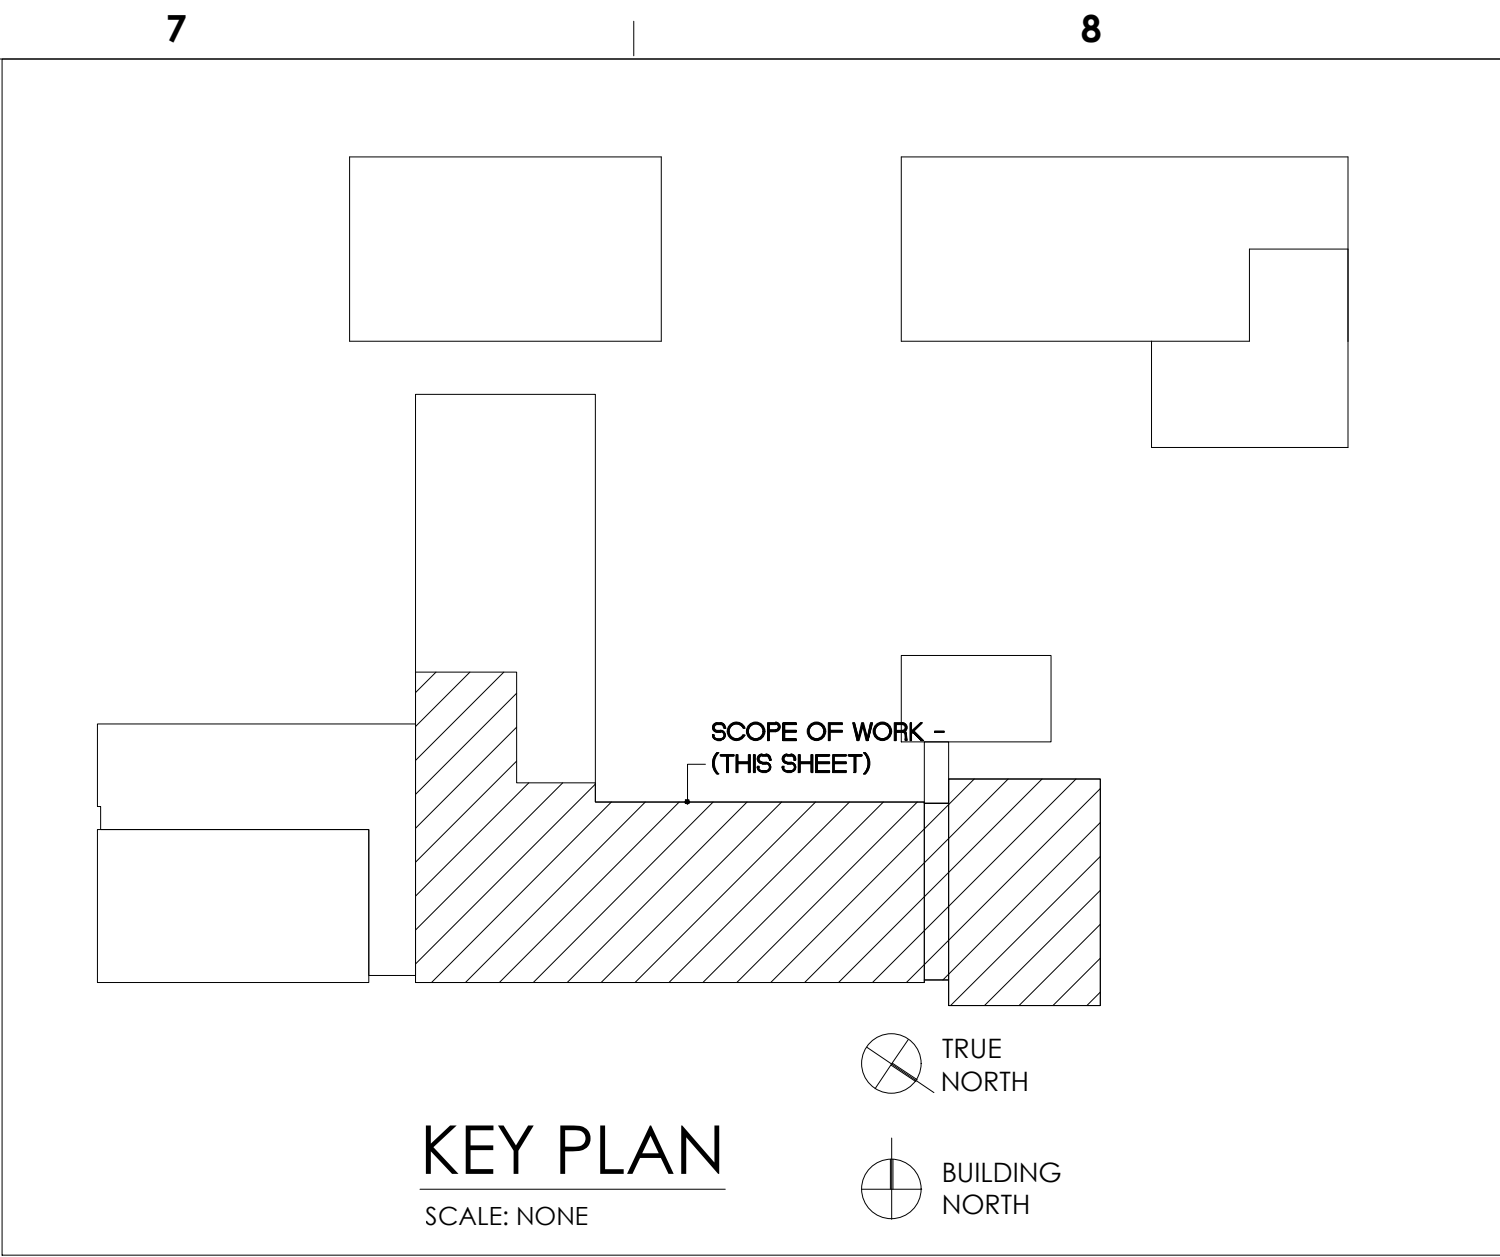

THE SCHOOL DISTRICT OF PHILADELPHIA
OFFICE OF CAPITAL PROGRAMS
440 NORTH BROAD STREET
PHILADELPHIA, PA 19130 - 4015
(215) 400 - 4730 | (215) 400 - 4731 (fax)
www.philasd.org

SEAL:

NAME (LICENSED PROFESSIONAL): PETER J. BONNES DATE 09/30/2021
STATE AND LICENSE NO.: PA 046114E

FXB
PARTNERSHIP THROUGH
ENGINEERING
5 Christy Drive, Suite 307
Chadds Ford, PA 19317
610.558.3464 office
www.fxbinco.com
Engineering Excellence Since 1968

**BID
ISSUE ONLY**
NOT TO BE USED FOR
CONSTRUCTION

CONTRACT #'S
8-262 C 18/19

NO.	DATE	REVISION
1	10.28.20	ADDENDUM #1
0	07.31.20	ISSUE FOR BID
B	12.06.19	ISSUE FOR 100% REVIEW
C	11.21.19	ISSUE FOR 90% REVIEW
A	08.30.19	ISSUE FOR 60% REVIEW

SCHOOL & LOCATION
**STEPHEN DECATUR
K-8 SCHOOL**
3500 ACADEMY ROAD,
PHILADELPHIA, PA 19154

PROJECT TITLE
**FIRE ALARM
REPLACEMENT PROJECT**

DRAWING TITLE
**FIRE ALARM PLAN -
GROUND FLOOR (EAST)
- SLC DEVICES**

DRAWN BY	CHECKED BY
AVW / RCK	PJB

DRAWING NO.
FA2.0

SHEET 04 OF 28

SEAL:

NAME (LICENSED PROFESSIONAL): PETER J. BONNES DATE
STATE AND LICENSE NO: PA 046114E 09/30/2021



Engineering Excellence Since 1968

BID
ISSUE ONLY

NOT TO BE USED FOR
CONSTRUCTION

CONTRACT #S
B-062 C 18/19

1	10.28.20	ADDENDUM #1
0	07.31.20	ISSUE FOR BID
C	12.06.19	ISSUE FOR 100% REVIEW
B	11.21.19	ISSUE FOR 90% REVIEW
A	06.30.19	ISSUE FOR 60% REVIEW
NO.	DATE	REVISION

SCHOOL & LOCATION
**STEPHEN DECATUR
K-8 SCHOOL**
3500 ACADEMY ROAD,
PHILADELPHIA, PA 19154

PROJECT TITLE

**FIRE ALARM
REPLACEMENT PROJECT**

DRAWING TITLE

FIRE ALARM RISER DIAGRAM -
SLC DEVICES

DRAWN BY AVW / RCK	CHECKED BY PJB
-----------------------	-------------------

DRAWING NO.	
-------------	--

FA4.0

SHEET 14 OF 28

TAG	DESCRIPTION	RESISTANCE
(F1)	2/C; #14 CU SOLID; POWER-LIMITED FIRE ALARM CABLE; UNSHIELDED; JACKETED CABLE	2.52 OHMS/1000 FT
(F2)	2/C; #16 CU SOLID; POWER-LIMITED FIRE ALARM CABLE; UNSHIELDED; JACKETED CABLE	4.02 OHMS/1000 FT
(F3)	4/C; #14 CU SOLID; POWER-LIMITED FIRE ALARM CABLE; UNSHIELDED; JACKETED CABLE	2.52 OHMS/1000 FT
(F4)	4/C; #16 CU SOLID; POWER-LIMITED FIRE ALARM CABLE; UNSHIELDED; JACKETED CABLE	4.02 OHMS/1000 FT
TYPE	APPLICATIONS (SEE NEC 2008; 760.154)	
FLP-C (CIRCUIT INTEGRITY)	INSTALLED WHERE 2 HR FIRE RATING OF CABLE IS REQUIRED	
FLP-L (PLENUM RATED)	INSTALLED IN DUCTS, PLENUMS, AND OTHER SPACES USED FOR ENVIRONMENTAL AIR.	
FLP-R (RISER RATED)	INSTALLED IN BUILDING RUNS AND PENETRATING MORE THAN ONE FLOOR OR INSTALLED IN VERTICAL RUNS IN A SHAFT.	
FLP-L (GENERAL PURPOSE)	INSTALLED IN VERTICAL LOCATIONS OTHER THAN THOSE LISTED ABOVE	

1. THIS SCHEMATIC FIRE ALARM RISER IS INTENDED TO INDICATE THE MAJOR FIRE ALARM COMPONENTS AND GENERAL SEPARATION OF INDICATING, INITIATING, COMMUNICATIONS, AND ANNUNCIATION CIRCUITS AS REQUIRED BY THE PROJECT. DRAWINGS IS TO BE PROVIDED AS REQUIRED BY THE FIRE ALARM EQUIPMENT MANUFACTURER. THE RISER DRAWING IS A GENERAL INDICATION OF EQUIPMENT TO BE PROVIDED AND DOES NOT NECESSARILY INDICATE ALL ITEMS OR APPURTENANCES WHICH MAY BE REQUIRED TO PROVIDE A FULLY OPERATIONAL SYSTEM. ALL SUCH ITEMS ARE TO BE PROVIDED AS SCHEDULED IN THE SPECIFICATIONS AND AS REQUIRED BY FIRE ALARM MANUFACTURER FOR OPERATION OF THE SYSTEM.
2. ACTIVATION OF ANY COMMON AREA SMOKE DETECTOR, OR PULL STATION SHALL INITIATE A GENERAL ALARM FOR THE ENTIRE BUILDING.
3. PROVIDE FULLY ADDRESSABLE SYSTEM CAPABLE OF ADDRESSING EACH DEVICE.
4. FACD SHALL BE SUPPLIED WITH BATTERY BACKUP TO COMPLY WITH NFPA 72. ALSO PROVIDE THE APPROPRIATE DIALER TO NOTIFY A CENTRAL MONITORING LOCATION OR CENTRAL STATION.
5. THE INSTALLING CONTRACTOR SHOULD BE ADVISED TO PREPARE THE FOLLOWING DOCUMENTATION AT THE PROJECT CLOSE-OUT:
 - A. SET OF AS-BUILT DRAWINGS AS PER INSPECTED INSTALLATION AND AS APPROVED BY THE FIRE MARSHAL.
 - B. RECORD OF COMPLETION (A DOCUMENT THAT ACKNOWLEDGES THE FEATURES OF INSTALLATION, OPERATION (PERFORMANCE), SERVICE AND EQUIPMENT).
 - C. MANUAL, CONTAINING A SEQUENCE OF ALARM AND A MANUFACTURERS SHEET FOR EACH DEVICE INSTALLED IN THE FIRE ALARM SYSTEM INCLUDING THE MAIN CONSOLE.
6. CONTRACTOR IS RESPONSIBLE TO SCHEDULE/ARRANGE, AND PAY FOR ALL PERMITS AND INSPECTIONS.
7. THE NEW FIRE ALARM SYSTEM IS TO BE ACCEPTABLE BY FIRE MARSHAL BEFORE THE REMOVAL OF THE EXISTING FIRE ALARM SYSTEM.
8. THE QUANTITY OF FIRE ALARM NAC EXTENDER POWER SUPPLY PANELS SHOWN ON THESE DRAWINGS AND THE RISER DRAWING ARE FOR SPECIFIC PURPOSES ONLY. THE CONTRACTOR AND FIRE ALARM VENDOR SHALL DETERMINE THE EXACT QUANTITY OF NAC PANELS REQUIRED BASED ON THE MANUFACTURER'S NAC PANEL FUNCTION AND SPECIFICATIONS. THE CONTRACTOR SHALL PROVIDE THE QUANTITY OF NAC PANELS REQUIRED TO SUPPORT THE EXISTING AND NEW DEVICES BASED ON THE QUANTITY OF DEVICES SHOWN ON PLAN, TOTAL POWER REQUIRED TO SUPPORT THE DEVICES, VOLTAGE DROP CALCULATIONS FOR EACH CIRCUIT, BATTERY CALCULATIONS, SIZE OF BUILDING, ETC. THE CONTRACTOR SHALL PROVIDE 120V, 20AMP CIRCUITS FOR ALL NAC PANELS THAT ARE INSTALLED BASED ON THE QUANTITY OF FIRE ALARM VENDOR'S CALCULATIONS AT NO ADDITIONAL COST TO SGP.

