

# BOARD OF EDUCATION Office of Capital Programs 440 North Broad Street, 3<sup>rd</sup> Floor – Suite 371 Philadelphia, PA 19130

TELEPHONE: (215) 400-4730

# Addendum No. 4

Subject: SDP Contracts No. B-057 C, B-058 C, B-059 C and B-060 C of 2020/21

**Major Renovation and Addition** 

**Location:** Edwin Forrest Elementary School

This Addendum dated May 6, 2022 shall modify and become part of the Contract Documents. Any items not mentioned herein, or affected by, shall remain strictly in accordance with the original document.

## NOTICE TO ALL BIDDERS:

N/A

\_\_\_\_\_\_

1. MODIFICATIONS TO GENERAL AND SUPPLEMENTARY CONDITIONS (DIVISION 00)

N/A

2. MODIFICATIONS TO DIVISION 01 GENERAL REQUIREMENTS (DIVISION 01)

Correct reference in Summary of Work from "Pollock" to "Forrest".

### 3. CHANGES TO TECHNICAL SPECIFICATIONS (DIVISIONS 02-36):

- A. Specification Section 04 03 01: Maintenance for Period Masonry: Delete Section 1.1 C:
- B. Specification Section 09 67 24: Resinous Flooring for Mechanical rooms: Delete in its entirety
- C. Specification Section 09 68 13: Carpet Tile: Delete in its entirety

- D. Specification Section 09 84 13: Acoustic Wall Panels: Delete in its entirety
- **E.** Specification Section 10 22 26: Operable Partitions: Delete in its entirety
- F. Specification Section 12 48 23: Entrance Floor Grids: Delete in its entirety

# 4. CLARIFICATIONS:

N/A

\_\_\_\_\_\_\_

# 5. QUESTIONS AND ANSWERS

RFI from Smith Construct Inc dated Wednesday, April 13 2022 (1 question)

**Question 1:** Per keynote #34, on drawing A202, we are to remove the existing security grates at the first-floor level and replace with new screens over the new windows. Can a specification be provided for the new security screens?

**Answer:** Security screens in the project scope shall be integral to the new windows.

\_\_\_\_\_\_

RFI from Primer Building Restoration dated Wednesday, April 13, 2022 (1 question)

**Question 2:** I was emailing to see if there were any plans or documents available for this project? **Answer:** If you go to the SDP website and click on the project name under the description column, and fill out the required info, you should be able to see the bid documents.

\_\_\_\_\_\_

RFI from The Bedwell Company dated Monday, May 2, 2022 (1 question)

**Question 3:** Re-insulating pipe and fittings

Section 01 1135 Asbestos Abatement lists several locations where asbestos insulation is being removed from pipe and fittings. Please confirm that the re-insulation of the pipe and fittings is not in the General Contractor's scope of work.

**Answer:** Reinsulation of pipe fittings is not in the General Contractor's scope of work. Reinsulation of plumbing piping is the responsibility of the plumbing contractor. Reinsulation of the mechanical piping and duct work is the responsibility of the mechanical contractor.

-----

RFI from The Bedwell Company dated Monday, May 2, 2022 (1 question)

**Question 4:** Please confirm that the all of the Duct Cleaning required in Section 01 1135 is limited to cleaning of masonry ventilation and steam shafts and does not include cleaning of sheet metal ductwork.

**Answer:** Correct, duct cleaning required by Section 011135 is limited to existing masonry ventilation and steam shafts. Section 233113 addresses duct cleaning in new metal duct.

-----

RFI from The Bedwell Company dated Tuesday, May 3, 2022 (1 question)

**Question 5:** The Bid Proposal Form does not provide for the Unit Prices listed in subsection 04 03 01-1.1 C. Please provide direction.

**Answer:** Unit Prices are not required for this scope of work. Subsection 1.1 C shall be deleted.

\_\_\_\_\_

RFI from Smith Construction dated Tuesday, May 3, 2022 (9 questions)

**Question 6:** What is the existing wood base wood species and dimensions/profile. The only reference on the drawings is a 6" high wood base. Per WDB description on drawing A-804 the base at new walls is to be salvaged existing or new to match.

**Answer:** To be verified in field. During construction a sample should be taken either from an area being demolished or an obscure area that can be repaired to determine the species and profile.

**Question 7:** Note D13 on demo plans indicate to remove and salvage existing coat hooks. New Note #6 on new floor plans (ex: A-403) indicates that new coat hooks (34 in each classroom) on new rails are to be provided. What species of wood and dimensions are the new wood rails to be? Is red oak acceptable?

**Answer:** Existing coat hooks and rails: to be removed, cleaned, and reused in classrooms. Use existing first when reinstalling throughout classroom to meet the layout and quantity indicated in elevation 7/A-402. Once all existing have been reused, install new to meet the layout and quantity requirements. Use white oak as wood species for new wood rails, where needed.

**Question 8:** On typical classroom plan 1/A-403 there is a note for closet shelving in the closet. Is the shelving new? If so, please provide a full description of the number of shelves, material, finish and support, or a detail for the same.

**Answer:** Provide new shelving based on detail 9/A-805, widths vary.

**Question 9:** What is the 1'-6" x 3'-0" dimensioned item in the corner of Art Classroom 204 on 1/A-408? Elevation 6/A-408 does not show anything. Is it a new wardrobe cabinet?

**Answer:** This is to be a new wardrobe in keeping with detail 8/A-805 noted on this plan as typical for three locations.

**Question 10:** What material are the wardrobe cabinets on 8/A-805 supposed to be? Plam or finished wood? If finished wood, what is the wood species?

**Answer:** Plastic laminate

**Question 11:** The floor plans dimension 1'-6" deep wardrobe cabinets, however the details on A-805 dimension them as 24" deep. Which is correct?

**Answer:** The depth shall be 24" deep in keeping with the details on A-805.

**Question 12:** On Finish plans A-800 to A-803 there is a Note 7 to install new paint grade flat stock chair rail at the same location as the removed rail. Note 7 is not found on the plans, locations unknown. Note D22 on the demo floor plans indicates the existing chair rail occurs in the Classrooms. Is the existing chair rail on all walls? The interior elevations do not show the chair rail. Please clarify and identify the thickness and width of the chair rail. Is poplar acceptable for the chair rails? **Answer:** Chair rails in classrooms do not exist. New chair rails are not needed. Disregard Note 7 on A-800 and A-803 as well as the D22 demo note.

**Question 13:** Is the new finished wood to have a transparent finish or stained finish? The specs list both. Are there photographs of the existing finished wood, particularly the chair rail and 6" high base. **Answer:** The new finished wood should have a stained finish that matches architect's control sample. Refer to WDB on A-804 for base finish information. Chair rails in classrooms do not exist. Photo enclosed below of existing base:



**Question 14:** Elevation Detail 7/A-409 shows shelving on the lefthand side. These are not on the demo plan as existing to remain, and they do show up on the new floor plan as HEAVY DUTY SHELVING, indicating they are new. There are no notes or detail cuts for the shelving. Please provide clarity to the drawing and a description. The shelving drawn in elevation does not appear to be the same as detail 9/A-805.

**Answer:** Disregard graphic depiction in elevation 7/A-409. Provide new millwork as detailed on 9/A-805.

DEL from The Redwell Company dated Typeday May 2, 2022 (1 gyestian)

RFI from The Bedwell Company dated Tuesday, May 3, 2022 (1 question)

**Question 15:** We cannot find where the work specified in the following is shown on Contract Drawings.

- 1. 096724 Resinous Flooring for Mechanical rooms
- 2. 096813 Carpet Tile
- 3. 098413 Acoustic Wall Panels
- 4. 102226 Operable Partitions

#### 5. 124823 Entrance Floor Grids

Please confirm that the work in these sections is not applicable to the Forrest ES.

Answer: None of these items are being used in the project.

\_\_\_\_\_

RFI from Smith Construction dated Tuesday, May 3, 2022 (1 question)

**Question 16:** Do the windows in the "Gymateria" in the basement, or the clerestory windows in the Auditorium receive shades?

**Answer:** Yes. Typical shades listed within finish specifications. Refer to note general finish note #3.

RFI from The Bedwell Company dated Wednesday, May 4, 2022 (1 question)

**Question 17:** The list of openings below calls for new doors with elevations B, D, or E. These elevations are shown as a combination of panels &/or glass on page A-601. Are these new doors required to be stile & rail construction to match existing?

Opening #:	Door Material:	Door Elevation
18.1	НМ	В
102.3	WD	В
114.1	WD	В
13.1	WD	D
206.4	WD	D
102.2	WD	E

#### Answer:

- 18.1 Stair / Corridor Shall be type K
- 102.3 Coat Room / Classroom This door is existing to remain and should be refinished per drawing note # 9 on A601
- 114.1 Music Classroom / Corridor- Shall be type G
- 13.1 Girls Toilet / Corridor Shall be type H
- 206.4 Science / Storage Rm This door is existing to remain and should be refinished per drawing note # 9 on A601
- 102.2 Classroom / Teacher Wardrobe This door is existing to remain and should be refinished per drawing note # 9 on A601

\_\_\_\_\_

RFI from Smith Construction dated Thursday, May 5, 2022 (3 questions)

**Question 18:** Reference is made to section 078100 Spray Fire-Resistive Materials and Section 07123 Intumescent Fireproofing.

Plan Note 8 on Drawing A-100 states "Provide Spray Fireproofing for New Structural Steel Reinforcement at Floors and Roof Structure shown on Structural Plans. Provide 1 hour fire resistance rating based on UL Design."

We cannot locate a UL Design number on the drawings. The structural drawings state "See Architecture Drawings for Fireproofing Requirements of Steel Framing".

- Question 18A: What UL Design number is applicable for the concealed fireproofing specified in Section 078100 and specifically where on the drawing is it to be applied?
   Answer: Fireproofing shall be provided for the C8 x11.5 and W8 x28 members shown on S101, S102, S103, and S104. Specific UL design to be designated by the contractor to provide a 1-hour fire rating.
- Question 18B: What UL Design number is applicable for the exposed fireproofing specified in Section 078100 and specifically where on the drawings is it shown to be applied?
   Answer: Refer to Question 18A response. Note that due to the length of their span, some structural members are exposed in one space and concealed in an adjacent space.
- Question 18C: What UL Design number is applicable for the intumescent fireproofing specified
  in Section 078100 and specifically where on the drawings is it shown to be applied?
   Answer: Intumescent fireproofing is not used in the project scope.

# **REVISED SPECIFICATION SECTIONS:**

\_\_\_\_\_

#### **REVISED DRAWINGS:**

- A-601: Revised to coordinate with response to RFI 30.
- A-602: Revised to coordinate with response to RFI 30.

**End of Addendum 4** 

K	FROM ROOM	DOC	PR TO ROOM		ND FRAME SCHEDULE BASEMENT, FLOORS 1 AND 2  DOOR FRAME SIZE SIZE DETAIL						EID5	HDWR SET		
_	NAME	NO.	NAME	NO.	DOOF	SIZE WIDTH HEIGHT	MTRL	ELEV. REW	MTRL ELEV		JAMB SILL	FIRE RATING	NO.	COMMENTS
	STOR./ FORMER BOIL. RM.	B-24 B-23	STOR./ FORMER BOIL. RM. STORAGE	B-23 B-25	YES YES	6' - 0" 7' - 0" 3' - 6" 7' - 0"	WD WD	H YES	HM HM-2 HM HM-1	12 12	13 - 13 -	90 MIN.	08.5	REFER TO NOTE 10 REFER TO NOTE 10
	MECH./FORMER FAN RM.	B-26 B-26	STOR./ FORMER BOIL. RM. MECH./FORMER FAN RM.	B-23	YES	5' - 0" 7' - 0" 3' - 0" 7' - 0"	WD WD	H YES	HM HM-2 HM HM-1	12 19	13 - 20 & 22 -	60 MIN. 60 MIN.		REFER TO NOTE 10 REFER TO NOTE 10
	GYM OFFICE  NEW TABLE STORAGE	B-8A B-8B	GYMATERIA GYMATERIA	B-8 B-8	YES YES	3' - 0" 7' - 0" 6' - 0" 7' - 0"	WD WD	I YES	HM HM-1 HM HM-2	12	13 E 13 E			REFER TO NOTE 10 REFER TO NOTE 10
	NEW TABLE STORAGE	B-8C B-8E B-9	GYMATERIA GYMATERIA	B-8 B-8	YES YES YES	6' - 0" 7' - 0" 6' - 0" 7' - 0" 3' - 0" 7' - 0"	WD WD FRP	H YES	HM HM-2 HM HM-2 HM HM-1T	12 12 17	13 E 13 E 18 ETR		_	REFER TO NOTE 10 REFER TO NOTE 10
ne	ent													
	COAT ROOM	B-1 B-1A	CORRIDOR 'C' CLASSROOM	B-1	YES	3' - 0" 7' - 0" 2' - 8" 7' - 0"	WD	I YES	HM HM-1 WD WD-1T		13 B 11 - 11	20 MIN.		REFER TO NOTE 9
_	TEACHER WARDROBE CLASSROOM TEACHER WARDROBE	B-1B B-2 B-2B	CLASSROOM CORRIDOR 'C' CLASSROOM	B-1 B-2	YES	3' - 4" 6' - 6" 3' - 0" 7' - 0" 1' - 8" 6' - 8"	WD WD WD	J YES E	WD   WD-1   HM   HM-1   WD   WD-1	10 12 10	11 - 13 B 11 -	20 MIN.	06	REFER TO NOTE 9  REFER TO NOTE 9
		B-2A B-2A B-2B	CLASSROOM CORRIDOR 'C' CLASSROOM	B-2 B-19 B-2		2' - 8" 7' - 0" 2' - 6" 7' - 0" 3' - 4" 6' - 6"	WD WD WD	C F	WD WD-1T WD WD-1	15 10 10	11 - 11 - 11 -		ETR	REFER TO NOTE 9 REFER TO NOTE 9
	CLASSROOM TEACHER WARDROBE	B-3	CORRIDOR 'C' CLASSROOM	B-19 B-3	YES	2' - 8" 7' - 0" 1' - 8" 6' - 6"	WD WD	G YES	HM HM-1 WD WD-1	12 10	13 B 11 -	20 MIN.	06 ETR	REFER TO NOTE 9
	COAT ROOM TEACHER WARDROBE CORRIDOR 'A'	B-3A B-16	CLASSROOM CLASSROOM NEW KITCHEN / SERVERY	B-3 B-3 B-4	YES	2' - 8" 7' - 0" 3' - 4" 6' - 6" 3' - 0" 7' - 0"	WD WD WD	J H YES	WD WD-1 WD WD-1 HM HM-1	10 10 12	11 - 11 - 13 C		ETRPR	REFER TO NOTE 9 REFER TO NOTE 9 REFER TO NOTE 10
	GAS METER NEW KITCHEN / SERVERY	B-4	NEW KITCHEN / SERVERY GYMATERIA	B-4 B-8		2' - 8" 7' - 0" 4' - 4" 8' - 5"	WD	D	WD WD-1	10	11 -		ETR RU	ROLL-UP DOOR, REFER TO DRAWING A-413, REFER TO NOTE 10
		B-4	GYMATERIA PASSAGE 'B'	B-8 B-17		5' - 0" 9' - 3" 28' - 8 9' - 3"								ROLL-UP DOOR, REFER TO DRAWING A-413, REFER TO NOTE 10 ROLL-UP DOOR, REFER TO DRAWING A-413,
	NEW KITCHEN / SERVERY	B-4 B-5	STAIR A CORRIDOR 'C'	B-18 B-19	YES	5/8" 1' - 2" 4' - 4" 3' - 0" 7' - 0"	WD WD	J H YES	WD WD-1	10	11 ETR 13 D	20 MIN.	08.8	REFER TO NOTE 10  POWER ASSISTED DOOR REQ.
_	VEST. G NEW J.C.	B-7 B-19A	VEST. G	B-7	YES YES	5' - 4" 7' - 0" 3' - 0" 7' - 0"	FRP WD	I YES	HM HM-2 WD WD-1	21 10	22 I 11 -	60 MIN.	E2 EF2	PREP FOR CARD READER
	GYMATERIA	B-19 B-8 B-8F	VEST. G CORRIDOR 'C' GYMATERIA	B-7 B-19 B-8	YES	3' - 0" 7' - 0" 5' - 4" 7' - 0" 2' - 8" 7' - 0"	WD WD WD	K I F	WD WD-1 WD WD-1 WD WD-1	10 10 10	11 - 11 ETR 11 ETR	60 MIN.	EF2 ETRPR ETR	
	GYMATERIA GYMATERIA	B-8 B-8	GYMATERIA VEST. F	B-8 B-9		2' - 8" 7' - 0" 1' - 2" 4' - 4" 3' - 0" 7' - 0"	WD WD	D J B	WD WD-1 WD WD-1 WD WD-1	10 10 10	11 ETR 11 ETR 11 E		ETR 08.8 00	
	MUSIC CLASSROOM	B-11	STORAGE CORRIDOR 'A'	B-10 B-16	YES YES	3' - 4" 6' - 8" 2' - 8" 7' - 0"	FRP WD	H YES G YES	HM HM-1 HM HM-1	21 15	22 ETR 11 B	20 MIN.	08.4 06	DECED TO NOTE O
	MUSIC CLASSROOM STORAGE	B-11C B-11 B-11B	MUSIC CLASSROOM STORAGE MUSIC CLASSROOM	B-11 B-11A B-11		1' - 8" 6' - 8" 2' - 8" 7' - 0" 2' - 8" 7' - 0"	WD WD WD	E H B	WD WD-1 WD WD-1 WD WD-1	10 10 10	11 - 11 - 11 -		ET07 ETR	REFER TO NOTE 9 REFER TO NOTE 9 REFER TO NOTE 9
	NEW KITCHEN SUPPORT	B-11C B-12 B-12A	MUSIC CLASSROOM CORRIDOR 'A' CORRIDOR 'A'	B-11 B-16 B-16	YES YES	3' - 4" 6' - 8" 3' - 6" 7' - 0" 3' - 0" 7' - 0"	WD WD WD	J H YES H YES	WD WD-1 HM HM-1 HM HM-1	10 12 12	11 - 13 B 13 A	20 MIN 20 MIN	05.3	REFER TO NOTE 9 REFER TO NOTE 10 REFER TO NOTE 10
	OFFICE DRY STORAGE	B-12B B-12C	NEW KITCHEN SUPPORT NEW KITCHEN SUPPORT	B-12 B-12	YES YES	3' - 0" 7' - 0" 3' - 0" 7' - 0"	WD WD	H YES	HM HM-1 HM HM-1	23 23	14 - 14 -		05 07.4	REFER TO NOTE 10 REFER TO NOTE 10
	EXIST. GIRLS' TOILET	B-12D B-13 B-14	NEW KITCHEN SUPPORT CORRIDOR 'A' CORRIDOR 'A'	B-12 B-16 B-16	YES	3' - 0" 7' - 0" 2' - 8" 7' - 0" 2' - 6" 7' - 0"	WD / WD WD	4 H YES H YES	HM HM-1 HM HM-1 WD WD-1	23 12 10	14 - 13 D 11 B			POWER ASSISTED DOOR REQ.
	VEST. E	B-15 B-15 B-15	CORRIDOR 'A' CORRIDOR 'A'	B-16	YES YES YES	5' - 4" 7' - 0" 3' - 0" 7' - 0" 3' - 0" 7' - 0"	FRP WD WD	I YES K	HM   HM-2   WD   WD-1   WD   WD-1	10 10	22 I 11 - 11 -	60 MIN. 60 MIN.	E2 EF2 EF2	PREP FOR CARD READER
)	STORAGE CORRIDOR 'A'	B-16B B-16	CORRIDOR 'A' JC	B-16 B-16A	YES	1' - 10" 7' - 0" 2' - 8" 7' - 0"	WD	E H YES	WD WD-1 HM HM-1	10 12	11 13 B		ETR 08.11	REFER TO NOTE 10
2		B-17 B-16	CORRIDOR 'A' STAIR A STAIR A	B-16 B-18 B-18	YES YES YES	6' - 0" 7' - 0" 5' - 4" 7' - 0" 6' - 2" 6' - 11"	FRP	YES YES YES	HM   HM-2   WD   WD-1   WD   WD-1	19 12 4	20 - 13 ETR 9 ETR	20 MIN. 90 MIN.	EF1 E2	PREP FOR CARD READER
2	STORAGE  NEW J.C.  ELEC / IDF	B-19A B-19B	CORRIDOR 'C' CORRIDOR 'C' CORRIDOR 'C'	B-19 B-19 B-19	YES	1' - 10" 7' - 0" 3' - 0" 7' - 0" 3' - 0" 7' - 0"	WD WD WD	E D H YES	WD   WD-1   WD   WD-1   HM   HM-1	10 10 12	11 B 11 B	20 MIN.	ETR ETR 08	REFER TO NOTE 10
2		B-19 B-20 B-21	STAIR 'C'  CORRIDOR 'A'	B-20 B-16	YES YES	5' - 4" 7' - 0" 6' - 2" 6' - 11" 2' - 8" 7' - 0"	HM FRP WD	K YES	HM   HM-2   WD   WD-1   WD   WD-1	12 4 10	13 ETR 9 ETR 11 B	90 MIN.	EF4 E1 ETR	
1	ELEC. CLOS.	B-22 B-17	CORRIDOR 'A' STOR./ FORMER BOIL. RM.	B-16 B-23	YES	5' - 4" 7' - 0" 3' - 0" 7' - 0"	WD WD	H	WD WD-2 HM HM-1	10 24	11 ETR	45 MIN.	ETRPR 08.3	
		B-26A			YES	3' - 6" 1' - 0 19/32" 3' - 0" 5' - 8"	FRP	H YES	HM HM-1	21	22 ETR		BD 08.4	
1	STOR	ID 07			\/E0	01 011 51 011			1184 11844	21				
	ıle	B-27			YES	3' - 0" 5' - 8"	FRP	H YES	HM HM-1		22 ETR		08.4	
	ıle VEST. G	B-27 B-7 B-23	TOILET	B-6	YES	3' - 0" 5' - 8" 3' - 0" 7' - 0" 5' - 0" 7' - 0"	WD FRP	F H YES	WD WD-1	10	11 -		08.1	REFER TO NOTE 10
el 1 .1	ıle VEST. G	B-7	TOILET  1ST GRADE CLASSROOM 1ST GRADE CLASSROOM	B-6		3' - 0" 7' - 0"	WD	F	WD WD-1	10		20 MIN.	08.1	REFER TO NOTE 10
el 1 .1 .2 .3	VEST. G STOR./ FORMER BOIL. RM.  CORRIDOR 'A' TEACHER WARDROBE COAT ROOM STORAGE	B-7 B-23	1ST GRADE CLASSROOM 1ST GRADE CLASSROOM 1ST GRADE CLASSROOM 1ST GRADE CLASSROOM	101 101 101 101	YES	3' - 0" 7' - 0" 5' - 0" 7' - 0" 3' - 0" 7' - 0" 1' - 8" 6' - 8" 2' - 6" 7' - 0" 2' - 6" 7' - 0"	WD FRP WD WD WD WD	F YES	WD   WD-1   HM   HM-2   WD   WD-1T   WD   WD-1T   WD   WD-1   WD   WD-1	15 10 15 10 15	11 - 11 B 11 - 11 - 11 -	20 MIN.	08.1 08.9 06 ETR ET07 ETR	REFER TO NOTE 9
el 1 .1 .2 .3 .4 .5 .6	VEST. G STOR./ FORMER BOIL. RM.  CORRIDOR 'A' TEACHER WARDROBE COAT ROOM STORAGE 1ST GRADE CLASSROOM CORRIDOR 'A'	B-7 B-23 101C 101 101 101 123	1ST GRADE CLASSROOM 1ST GRADE CLASSROOM 1ST GRADE CLASSROOM 1ST GRADE CLASSROOM EXIST. TOILET ROOM EXIST. TOILET ROOM J.C.	101 101 101 101 101A 101A 101B	YES	3' - 0" 7' - 0" 5' - 0" 7' - 0"  3' - 0" 7' - 0"  1' - 8" 6' - 8"  2' - 6" 7' - 0"  2' - 6" 7' - 0"  2' - 6" 7' - 0"  2' - 6" 7' - 0"  3' - 0" 7' - 0"	WD FRP WD WD WD WD WD WD WD	F YES  G E B D B B B H	WD   WD-1   HM   HM-2   WD   WD-1T   WD   WD-1T   WD   WD-1   WD   WD-1   WD   WD-1   WD   WD-1	15 10 15 10 10 10 10	11 - 11 B 11 - 11 - 11 A 11 A		08.1 08.9 06 ETR ET07 ETR ETR ETR 08	
el 1 .1 .2 .3 .4 .5 .6 .7 .1	VEST. G STOR./ FORMER BOIL. RM.  CORRIDOR 'A' TEACHER WARDROBE COAT ROOM STORAGE 1ST GRADE CLASSROOM 1ST GRADE CLASSROOM	B-7 B-23 123 101C	1ST GRADE CLASSROOM 1ST GRADE CLASSROOM 1ST GRADE CLASSROOM 1ST GRADE CLASSROOM EXIST. TOILET ROOM EXIST. TOILET ROOM	101 101 101 101 101A 101A	YES	3' - 0" 7' - 0" 5' - 0" 7' - 0"  3' - 0" 7' - 0"  1' - 8" 6' - 8"  2' - 6" 7' - 0"  2' - 6" 7' - 0"  2' - 6" 7' - 0"  2' - 6" 7' - 0"	WD FRP WD WD WD WD WD WD	F H YES	WD   WD-1   HM   HM-2   WD   WD-1T   WD   WD-1   WD   WD-1   WD   WD-1   WD   WD-1	15 10 15 10 10 10 10 10 15 10	11 - 11 B 11 - 11 - 11 A 11 A	20 MIN.	08.1 08.9 06 ETR ET07 ETR ETR ETR 08 06 ETR	REFER TO NOTE 9 REFER TO NOTE 9 REFER TO NOTE 9
el 1 .1 .2 .3 .4 .5 .6 .7 .1 .2 .3 .4 .5 .5 .6 .7 .1 .2 .3 .4 .5 .5	VEST. G STOR./ FORMER BOIL. RM.  CORRIDOR 'A' TEACHER WARDROBE COAT ROOM STORAGE 1ST GRADE CLASSROOM 1ST GRADE CLASSROOM CORRIDOR 'A' CORRIDOR 'A' TEACHER WARDROBE COAT ROOM STORAGE STORAGE STORAGE	B-7 B-23 101C 101 101 101 123 123 102A	1ST GRADE CLASSROOM 1ST GRADE CLASSROOM 1ST GRADE CLASSROOM 1ST GRADE CLASSROOM EXIST. TOILET ROOM EXIST. TOILET ROOM J.C. 1ST GRADE CLASSROOM	101 101 101 101 101A 101A 101B 102 102 102 102 102 102	YES YES YES	3' - 0" 7' - 0" 5' - 0" 7' - 0"  3' - 0" 7' - 0"  1' - 8" 6' - 8"  2' - 6" 7' - 0"  2' - 6" 7' - 0"  2' - 6" 7' - 0"  3' - 0" 7' - 0"  3' - 0" 7' - 0"  1' - 8" 6' - 8"  2' - 6" 7' - 0"  2' - 6" 7' - 0"  2' - 6" 7' - 0"  2' - 6" 7' - 0"  2' - 6" 7' - 0"	WD FRP WD	F H YES  G E B B B H G E B B B B B B B B B B B B B B B B B B	WD   WD-1   HM   HM-2   WD   WD-1T   WD   WD-1T   WD   WD-1T   WD   WD-1   WD   WD-1   WD   WD-1   WD   WD-1T   WD   WD-1T   WD   WD-1T   WD   WD-1T   WD   WD-1T	10 15 10 15 10 10 10 10 15 10 15 10	11 - 11 B 11 - 11 - 11 A 11 A 11 B 11 ETR 11 - 11 - 11 - 11 - 11 - 11 -		08.1 08.9 06 ETR ET07 ETR ETR 08 06 ETR ET07 ETR	REFER TO NOTE 9 REFER TO NOTE 9 REFER TO NOTE 9 REFER TO NOTE 10 REFER TO NOTE 9
2 el 1	VEST. G STOR./ FORMER BOIL. RM.  CORRIDOR 'A' TEACHER WARDROBE COAT ROOM STORAGE 1ST GRADE CLASSROOM CORRIDOR 'A' CORRIDOR 'A' TEACHER WARDROBE COAT ROOM STORAGE STORAGE STORAGE STORAGE ELEC / IDF CORRIDOR 'C' TEACHER WARDROBE	B-7 B-23 101C 101 101 101 123 123 102A 102B	1ST GRADE CLASSROOM 1ST GRADE CLASSROOM 1ST GRADE CLASSROOM 1ST GRADE CLASSROOM EXIST. TOILET ROOM EXIST. TOILET ROOM J.C. 1ST GRADE CLASSROOM	101 101 101 101 101A 101B 102 102 102 102 102 102 102 103 103	YES	3' - 0" 7' - 0" 5' - 0" 7' - 0"  3' - 0" 7' - 0"  1' - 8" 6' - 8"  2' - 6" 7' - 0"  2' - 6" 7' - 0"  2' - 6" 7' - 0"  3' - 0" 7' - 0"  3' - 0" 7' - 0"  1' - 8" 6' - 8"  2' - 6" 7' - 0"  2' - 6" 7' - 0"  2' - 6" 7' - 0"  2' - 6" 7' - 0"  2' - 6" 7' - 0"  2' - 6" 7' - 0"  2' - 6" 7' - 0"  1' - 8" 6' - 8"	WD FRP WD	F H YES  G E B B B H G E B B B B B B B B B B B B B B B B B B	WD   WD-1   HM   HM-2   WD   WD-1T   WD   WD-1T   WD   WD-1   WD   WD-1   WD   WD-1   WD   WD-1T   WD   WD-1T   WD   WD-1T   WD   WD-1T   WD   WD-1   HM   HM-1   WD   WD-1T   WD   WD-1T   WD   WD-1T   WD   WD-1T   WD   WD-1T	10 15 10 15 10 10 10 10 15 10 15 10 15 10 15 10	11 - 11 B 11 - 11 - 11 A 11 A 11 B 11 ETR 11 - 11 - 11 - 11 B 11 ETR 11 - 11 B 11 ETR 11 -		08.1 08.9 06 ETR ETO7 ETR ETR 08 06 ETR ETO7 ETR ETR 08.5 06 ETR	REFER TO NOTE 9 REFER TO NOTE 9 REFER TO NOTE 9 REFER TO NOTE 10 REFER TO NOTE 9
el 1 .1 .2 .3 .4 .5 .6 .7 .1 .2 .3 .4 .5 .5 .6 .7 .1 .2 .3 .4 .5 .5 .6 .7 .1 .2 .3 .4 .5 .5 .6 .7 .1 .2 .3 .4 .5 .5 .6 .7 .1 .2 .3 .4 .5 .5 .6 .7 .1 .2 .3 .4 .5 .5 .6 .7 .1 .2 .3 .4 .5 .5 .6 .7 .1 .2 .3 .4 .5 .5 .6 .7 .1 .2 .3 .4 .5 .5 .6 .7 .1 .2 .3 .4 .5 .5 .6 .7 .1 .2 .3 .4 .5 .5 .6 .7 .7 .1 .2 .3 .4 .5 .5 .6 .7 .7 .7 .7 .7 .7 .7 .7 .7 .7 .7 .7 .7	VEST. G STOR./ FORMER BOIL. RM.  CORRIDOR 'A' TEACHER WARDROBE COAT ROOM STORAGE 1ST GRADE CLASSROOM CORRIDOR 'A' CORRIDOR 'A' TEACHER WARDROBE COAT ROOM STORAGE STORAGE STORAGE STORAGE STORAGE ELEC / IDF CORRIDOR 'C'	B-7 B-23 101C 101 101 123 123 102A	1ST GRADE CLASSROOM 1ST GRADE CLASSROOM 1ST GRADE CLASSROOM 1ST GRADE CLASSROOM EXIST. TOILET ROOM EXIST. TOILET ROOM J.C. 1ST GRADE CLASSROOM CORRIDOR 'C' 1ST GRADE CLASSROOM	101 101 101 101 101A 101A 101B 102 102 102 102 102 102 102 102	YES YES YES YES YES	3' - 0" 7' - 0" 5' - 0" 7' - 0"  3' - 0" 7' - 0"  1' - 8" 6' - 8"  2' - 6" 7' - 0"  2' - 6" 7' - 0"  2' - 6" 7' - 0"  3' - 0" 7' - 0"  3' - 0" 7' - 0"  1' - 8" 6' - 8"  2' - 6" 7' - 0"  2' - 6" 7' - 0"  2' - 6" 7' - 0"  2' - 6" 7' - 0"  2' - 6" 7' - 0"  3' - 0" 7' - 0"  3' - 0" 7' - 0"	WD FRP WD	F H YES	WD WD-1 HM HM-2  WD WD-1T WD WD-1T WD WD-1 WD WD-1 WD WD-1 WD WD-1 WD WD-1 WD WD-1 WD WD-1T	15 10 15 10 10 10 10 10 15 15 10 15 15 10 12 15 10	11	20 MIN.	08.1 08.9 06 ETR ET07 ETR ETR 08 06 ETR ET07 ETR ETR 08.5 06 ETR	REFER TO NOTE 9 REFER TO NOTE 9 REFER TO NOTE 9 REFER TO NOTE 10  REFER TO NOTE 9
2 el 1	VEST. G STOR./ FORMER BOIL. RM.  CORRIDOR 'A' TEACHER WARDROBE COAT ROOM STORAGE 1ST GRADE CLASSROOM 1ST GRADE CLASSROOM CORRIDOR 'A' CORRIDOR 'A' TEACHER WARDROBE COAT ROOM STORAGE STORAGE STORAGE ELEC / IDF CORRIDOR 'C' TEACHER WARDROBE 1ST GRADE CLASSROOM 1ST GRADE CLASSROOM CORRIDOR 'C' TEACHER WARDROBE 1ST GRADE CLASSROOM CORRIDOR 'C' TEACHER WARDROBE COAT ROOM	B-7 B-23 101C 101 101 101 123 123 102A 102B 125	1ST GRADE CLASSROOM 1ST GRADE CLASSROOM 1ST GRADE CLASSROOM 1ST GRADE CLASSROOM EXIST. TOILET ROOM EXIST. TOILET ROOM J.C. 1ST GRADE CLASSROOM CORRIDOR 'C' 1ST GRADE CLASSROOM 1ST GRADE CLASSROOM 1ST GRADE CLASSROOM 1ST GRADE CLASSROOM COAT ROOM TOILET ROOM 1ST GRADE CLASSROOM 1ST GRADE CLASSROOM	101 101 101 101 101A 101A 101B 102 102 102 102 102 102 103 103 103 103B 103A 104 104	YES YES YES YES YES YES	3' - 0"	WD FRP  WD	F H YES  G E B B B B B B B B B B B B B B B B B B	WD   WD-1   HM   HM-2   WD   WD-1T   WD   WD-1T   WD   WD-1T   WD   WD-1   WD   WD-1   WD   WD-1   WD   WD-1T   WD   WD-1T   WD   WD-1T   WD   WD-1T   WD   WD-1T   WD   WD-1   WD   WD-1	10 15 10 15 10 10 10 10 15 15 10 12 15 10 10 10 11 10 11 10 11 10 11 10 11 10 11 10 11 10 11 10 10	11 - 11 B 11 - 11 - 11 - 11 A 11 A 11 B 11 ETR 11 - 11 - 11 - 11 B 11 ETR 11 - 11 - 11 - 11 - 11 F	20 MIN. 20 MIN.	08.1 08.9 06 ETR ETO7 ETR ETR 08 06 ETR ETO7 ETR 08.5 06 ETR ETO7 ETR 08.5 06 ETR ETO7 ETR	REFER TO NOTE 9 REFER TO NOTE 9 REFER TO NOTE 9 REFER TO NOTE 10  REFER TO NOTE 9 REFER TO NOTE 10  REFER TO NOTE 9
el 1 .1 .2 .3 .4 .5 .6 .7 .1 .2 .3 .4 .5 .5 .6 .7 .1 .2 .3 .4 .5 .5 .1 .2 .3 .4 .4 .1 .2 .3 .4 .4 .4 .5 .5 .1 .2 .2 .3 .4 .4 .4 .5 .5 .1 .2 .2 .3 .4 .4 .5 .5 .1 .2 .2 .3 .4 .4 .5 .5 .1 .2 .2 .2 .3 .4 .2 .2 .3 .4 .4 .5 .5 .1 .2 .2 .3 .4 .4 .4 .5 .5 .1 .2 .2 .3 .4 .4 .4 .5 .4 .4 .5 .4 .4 .4 .4 .4 .5 .4 .4 .4 .4 .4 .4 .4 .4 .4 .4 .4 .4 .4	VEST. G STOR./ FORMER BOIL. RM.  CORRIDOR 'A' TEACHER WARDROBE COAT ROOM STORAGE 1ST GRADE CLASSROOM 1ST GRADE CLASSROOM CORRIDOR 'A' CORRIDOR 'A' TEACHER WARDROBE COAT ROOM STORAGE STORAGE STORAGE ELEC / IDF CORRIDOR 'C' TEACHER WARDROBE 1ST GRADE CLASSROOM CORRIDOR 'C' TEACHER WARDROBE COAT ROOM STORAGE 1ST GRADE CLASSROOM STORAGE 1ST GRADE CLASSROOM	B-7 B-23  101C  101 101 101 123 123  102A  102B 125  103 103 125  104A	1ST GRADE CLASSROOM 1ST GRADE CLASSROOM 1ST GRADE CLASSROOM 1ST GRADE CLASSROOM EXIST. TOILET ROOM EXIST. TOILET ROOM J.C. 1ST GRADE CLASSROOM CORRIDOR 'C' 1ST GRADE CLASSROOM	101 101 101 101 101A 101A 101B 102 102 102 102 102 103 103 103 103B 103A 104 104 104 104 104 104 105	YES YES YES YES YES YES	3'-0" 7'-0" 5'-0" 7'-0" 1'-8" 6'-8" 2'-6" 7'-0" 2'-6" 7'-0" 2'-6" 7'-0" 3'-0" 7'-0" 3'-0" 7'-0" 1'-8" 6'-8" 2'-6" 7'-0" 2'-6" 7'-0" 2'-6" 7'-0" 2'-6" 7'-0" 2'-6" 7'-0" 2'-6" 7'-0" 2'-6" 7'-0" 2'-6" 7'-0" 2'-6" 7'-0" 2'-6" 7'-0" 1'-8" 6'-8" 2'-6" 7'-0" 1'-8" 6'-8" 2'-6" 7'-0" 3'-0" 7'-0" 1'-8" 6'-8" 2'-6" 7'-0" 1'-8" 6'-8"	WD FRP WD	F H YES  G E B B B B B B B B B B B B B B B B B B	WD   WD-1   HM   HM-2   WD   WD-1T   WD   WD-1T   WD   WD-1   WD   WD-1   WD   WD-1   WD   WD-1   WD   WD-1T   WD   WD-1T   WD   WD-1T   WD   WD-1T   WD   WD-1   WD   WD-1	10 15 10 10 10 10 10 10 15 10 15 10 12 15 10 10 10 15 10 15 10 15 10 15 10 15 10 10 15 10 10 10 10 10 10 10 10 10 10	11	20 MIN. 20 MIN.	08.1 08.9 06 ETR ETO7 ETR ETR 08 06 ETR ETO7 ETR ETR 08.5 06 ETR ETO7 ETR ETO7 ETR 06 ETR	REFER TO NOTE 9 REFER TO NOTE 9 REFER TO NOTE 9 REFER TO NOTE 10  REFER TO NOTE 9 REFER TO NOTE 10  REFER TO NOTE 9
WARDROBE 1ST GRADE CLASSROOM CORRIDOR 'C' TEACHER WARDROBE COAT ROOM STORAGE 1ST GRADE CLASSROOM TEACHER WARDROBE COAT ROOM STORAGE 1ST GRADE CLASSROOM TEACHER WARDROBE COAT ROOM STORAGE 1ST GRADE CLASSROOM TEACHER WARDROBE COAT ROOM STORAGE	B-7 B-23  123  101C  101 101 123 123  102A  102B 125  103 103 125  104A  105  105A	1ST GRADE CLASSROOM EXIST. TOILET ROOM J.C. 1ST GRADE CLASSROOM CORRIDOR 'C' 1ST GRADE CLASSROOM 1ST GRADE CLASSROOM TOILET ROOM 1ST GRADE CLASSROOM	101 101 101 101 101A 101A 101B 102 102 102 102 102 102 103 103 103 103 103A 104 104 104 104 105 105	YES YES YES YES YES YES YES	3' - 0" 7' - 0" 5' - 0" 7' - 0" 1' - 8" 6' - 8" 2' - 6" 7' - 0" 2' - 6" 7' - 0" 2' - 6" 7' - 0" 3' - 0" 7' - 0" 3' - 0" 7' - 0" 3' - 0" 7' - 0" 2' - 6" 7' - 0" 2' - 6" 7' - 0" 2' - 6" 7' - 0" 2' - 6" 7' - 0" 2' - 6" 7' - 0" 2' - 6" 7' - 0" 2' - 6" 7' - 0" 1' - 8" 6' - 8" 2' - 6" 7' - 0" 1' - 8" 6' - 8" 2' - 6" 7' - 0" 1' - 8" 6' - 8" 2' - 6" 7' - 0" 1' - 8" 6' - 8" 2' - 6" 7' - 0" 1' - 8" 6' - 8" 2' - 6" 7' - 0" 1' - 8" 6' - 8" 2' - 6" 7' - 0" 1' - 8" 6' - 8" 2' - 6" 7' - 0" 1' - 8" 6' - 8" 2' - 6" 7' - 0" 1' - 8" 6' - 8" 2' - 6" 7' - 0" 1' - 8" 6' - 8" 2' - 6" 7' - 0" 1' - 8" 6' - 8"	WD FRP WD	F H YES  G E B B B B B B B B B B B B B B B B B B	WD   WD-1   HM   HM-2   WD   WD-1T   WD   WD-1T   WD   WD-1   WD   WD-1   WD   WD-1   WD   WD-1   WD   WD-1T   WD   WD-1T   WD   WD-1T   WD   WD-1   WD   WD-1	15 10 15 10 10 10 10 10 11 15 10 15 10 11 10 10 11 10 11 10 11 10 11 10 11 10 11 10 11 10 11 10 11 10 11 10 10	11	20 MIN. 20 MIN. 20 MIN.	08.1 08.9  06 ETR ETO7 ETR ETR 08 06 ETR ETO7 ETR ETR 08.5 06 ETR ETO7 ETR ETR 06 ETR ETO7 ETR ETR 06 ETR	REFER TO NOTE 9 REFER TO NOTE 9 REFER TO NOTE 9 REFER TO NOTE 10  REFER TO NOTE 9 REFER TO NOTE 10  REFER TO NOTE 9
2 el 1	VEST. G STOR./ FORMER BOIL. RM.  CORRIDOR 'A' TEACHER WARDROBE COAT ROOM STORAGE 1ST GRADE CLASSROOM 1ST GRADE CLASSROOM CORRIDOR 'A' CORRIDOR 'A' TEACHER WARDROBE COAT ROOM STORAGE STORAGE STORAGE ELEC / IDF CORRIDOR 'C' TEACHER WARDROBE 1ST GRADE CLASSROOM 1ST GRADE CLASSROOM 1ST GRADE CLASSROOM 1ST GRADE CLASSROOM CORRIDOR 'C' TEACHER WARDROBE 1ST GRADE CLASSROOM STORAGE 1ST GRADE CLASSROOM COAT ROOM STORAGE 1ST GRADE CLASSROOM TEACHER WARDROBE COAT ROOM STORAGE 1ST GRADE CLASSROOM TEACHER WARDROBE COAT ROOM STORAGE 2ND GRADE CLASSROOM	B-7 B-23  101C  101 101 101 123 123  102A  102B 125  103 103 125  104A  105	1ST GRADE CLASSROOM EXIST. TOILET ROOM EXIST. TOILET ROOM J.C. 1ST GRADE CLASSROOM CORRIDOR 'C' 1ST GRADE CLASSROOM TOILET ROOM 1ST GRADE CLASSROOM	101 101 101 101 101 101 101A 101B 102 102 102 102 102 102 103 103 103B 103A 104 104 104 105 105 105 105 105 105 105 105 106	YES YES YES YES YES YES YES	3' - 0" 7' - 0" 5' - 0" 7' - 0" 1' - 8" 6' - 8" 2' - 6" 7' - 0" 2' - 6" 7' - 0" 2' - 6" 7' - 0" 3' - 0" 7' - 0" 3' - 0" 7' - 0" 3' - 0" 7' - 0" 2' - 6" 7' - 0" 2' - 6" 7' - 0" 2' - 6" 7' - 0" 2' - 6" 7' - 0" 2' - 6" 7' - 0" 2' - 6" 7' - 0" 2' - 6" 7' - 0" 1' - 8" 6' - 8" 2' - 6" 7' - 0" 2' - 8" 7' - 0" 1' - 8" 6' - 8" 2' - 6" 7' - 0" 1' - 8" 6' - 8" 2' - 6" 7' - 0" 1' - 8" 6' - 8" 2' - 6" 7' - 0" 1' - 8" 6' - 8" 2' - 6" 7' - 0" 1' - 8" 6' - 8" 2' - 6" 7' - 0" 1' - 8" 6' - 8" 2' - 6" 7' - 0" 1' - 8" 6' - 8" 2' - 6" 7' - 0" 1' - 8" 6' - 8" 2' - 6" 7' - 0" 1' - 8" 6' - 8" 2' - 6" 7' - 0"	WD FRP WD	F H YES  G E B B B B B B B B B B B B B B B B B B	WD   WD-1   HM   HM-2   WD   WD-1T   WD   WD-1T   WD   WD-1T   WD   WD-1T   WD   WD-1   WD   WD-1   WD   WD-1   WD   WD-1   WD   WD-1T	10 15 10 15 10 10 10 10 15 10 15 10 11 10 11 10 10 11 10 11 10 11 10 11 10 11 10 10	11	20 MIN. 20 MIN.	08.1 08.9  06 ETR ETO7 ETR ETR O8 06 ETR ETO7 ETR ETR O8.5 06 ETR ETO7 ETR O6 ETR ETO7 ETR O6 ETR ETO7 ETR O6 ETR	REFER TO NOTE 9 REFER TO NOTE 9 REFER TO NOTE 9 REFER TO NOTE 10  REFER TO NOTE 9 REFER TO NOTE 10  REFER TO NOTE 9
el 1 .1 .2 .3 .4 .5 .6 .7 .1 .2 .3 .4 .5 .6 .7 .1 .2 .3 .4 .5 .5 .6 .7 .1 .2 .3 .4 .5 .5 .6 .7 .1 .2 .3 .4 .5 .5 .6 .7 .1 .2 .3 .3 .4 .5 .5 .6 .7 .6 .7 .7 .7 .7 .7 .7 .7 .7 .7 .7 .7 .7 .7	VEST. G STOR./ FORMER BOIL. RM.  CORRIDOR 'A' TEACHER WARDROBE COAT ROOM STORAGE 1ST GRADE CLASSROOM CORRIDOR 'A' CORRIDOR 'A' TEACHER WARDROBE COAT ROOM STORAGE 1ST GRADE CLASSROOM CORRIDOR 'C' TEACHER WARDROBE 1ST GRADE CLASSROOM CORRIDOR 'C' TEACHER WARDROBE COAT ROOM STORAGE 1ST GRADE CLASSROOM TEACHER WARDROBE COAT ROOM STORAGE 2ND GRADE CLASSROOM TEACHER WARDROBE COAT ROOM STORAGE 2ND GRADE CLASSROOM TEACHER WARDROBE COAT ROOM STORAGE 2ND GRADE CLASSROOM TEACHER WARDROBE COAT ROOM STORAGE	B-7 B-23  123  101C  101 101 123 123  102A  102A  102B 125  103 103 125  104A  105  105A 105A 106A  106A	1ST GRADE CLASSROOM 1ST GRADE CLASSROOM 1ST GRADE CLASSROOM 1ST GRADE CLASSROOM EXIST. TOILET ROOM EXIST. TOILET ROOM J.C. 1ST GRADE CLASSROOM 2ND GRADE CLASSROOM 2ND GRADE CLASSROOM 2ND GRADE CLASSROOM	101 101 101 101 101 101A 101B 102 102 102 102 102 102 103 103 103B 103B 103A 104 104 104 105 105 105 105 105 105 105 106 106 106	YES YES YES YES YES YES YES YES YES	3' - 0"	WD FRP WD	F H YES  G E B B B B B B B B B B B B B B B B B B	WD   WD-1   HM   HM-2   WD   WD-1T   WD   WD-1T   WD   WD-1   WD   WD-1   WD   WD-1   WD   WD-1   WD   WD-1T	10 15 10 15 10 10 10 10 10 15 10 15 10 11 10 15 10 10 15 10 10 15 10 10 15 10 10 15 10 10 15 10 10 10 10 10 10 10 10 10 10	11	20 MIN.  20 MIN.  20 MIN.  20 MIN.	08.1 08.9  06 ETR ETO7 ETR ETR 08 06 ETR ETO7 ETR ETR 08.5 06 ETR ETO7 ETR 06 ETR ETO7 ETR 06 ETR ETO7 ETR 06 ETR ETO7 ETR TETR 06 ETR ETO7 ETR TETR TETR TETR TETR TETR TETR TETR	REFER TO NOTE 9 REFER TO NOTE 9 REFER TO NOTE 9 REFER TO NOTE 10  REFER TO NOTE 9 REFER TO NOTE 10  REFER TO NOTE 9
2 3 4 5 6 7 1 2 3 4 5 5 6 7 1 2 3 4 1 2 3 4 1 2 3 4 1 2 3 4 1 2 1 2 3 1 2 3 3 4 1 2 3 3 4 1 2 3 3 4 3 3 4 3 3 4 3 3 4 3 3 4 3 3 3 3	VEST. G STOR./ FORMER BOIL. RM.  CORRIDOR 'A' TEACHER WARDROBE COAT ROOM STORAGE 1ST GRADE CLASSROOM CORRIDOR 'A' CORRIDOR 'A' TEACHER WARDROBE COAT ROOM STORAGE STORAGE STORAGE STORAGE STORAGE ELEC / IDF CORRIDOR 'C' TEACHER WARDROBE 1ST GRADE CLASSROOM CORRIDOR 'C' TEACHER WARDROBE COAT ROOM STORAGE 1ST GRADE CLASSROOM TEACHER WARDROBE COAT ROOM STORAGE 2ND GRADE CLASSROOM TEACHER WARDROBE COAT ROOM COAT ROOM STORAGE 2ND GRADE CLASSROOM	123 101C 101 101 101 123 102A 102B 102B 125 103 103 125 104A 105A 105A 106A 106A 107	1ST GRADE CLASSROOM EXIST. TOILET ROOM EXIST. TOILET ROOM J.C. 1ST GRADE CLASSROOM 2ND GRADE CLASSROOM	101 101 101 101 101 101A 101B 102 102 102 102 102 102 103 103 103B 103A 104 104 104 105 105 105 105 105 106 106 106 106 106 106 107	YES YES YES YES YES YES YES	3' - 0"	WD FRP WD	F H YES  G E B B B B B B B B B B B B B B B B B B	WD   WD-1   HM   HM-2   WD   WD-1T   WD   WD-1T   WD   WD-1	10 15 10 15 10 10 10 10 10 10 10 15 15 10 10 15 10 10 15 10 10 15 15 10 15 10 15 15 10 15 15 10 15 15 10 15 15 10 15 15 10 15 15 10 15 15 10 15 15 10 15 15 10 15 15 10 15 15 10 15 15 10 15 15 10 15 15 10 15 15 10 15 15 10 15 15 10 15 15 15 10 15 15 15 10 15 15 15 10 15 15 15 10 15 15 15 10 15 15 15 10 15 15 15 10 15 15 15 16 17 16 17 17 18 18 18 18 18 18 18 18 18 18 18 18 18	11	20 MIN. 20 MIN. 20 MIN.	08.1 08.9  06 ETR ETO7 ETR ETR 08 06 ETR ETO7 ETR ETR 08.5 06 ETR ETO7 ETR ETR 06 ETR ETO7	REFER TO NOTE 9 REFER TO NOTE 9 REFER TO NOTE 10  REFER TO NOTE 10  REFER TO NOTE 9 REFER TO NOTE 10  REFER TO NOTE 9
el 1 .1 .2 .3 .4 .5 .6 .7 .1 .2 .3 .4 .5 .5 .1 .2 .3 .4 .5 .1 .2 .3 .4 .5 .1 .2 .3 .4 .5 .5 .1 .5 .5 .1 .5 .5 .1 .5 .5 .1 .5 .5 .5 .5 .5 .7 .7 .7 .7 .7 .7 .7 .7 .7 .7 .7 .7 .7	VEST. G STOR./ FORMER BOIL. RM.  CORRIDOR 'A' TEACHER WARDROBE COAT ROOM STORAGE 1ST GRADE CLASSROOM CORRIDOR 'A' CORRIDOR 'A' TEACHER WARDROBE COAT ROOM STORAGE STORAGE STORAGE STORAGE ELEC / IDF CORRIDOR 'C' TEACHER WARDROBE 1ST GRADE CLASSROOM 1ST GRADE CLASSROOM 1ST GRADE CLASSROOM 1ST GRADE CLASSROOM CORRIDOR 'C' TEACHER WARDROBE 1ST GRADE CLASSROOM CORRIDOR 'C' TEACHER WARDROBE COAT ROOM STORAGE 1ST GRADE CLASSROOM TEACHER WARDROBE COAT ROOM STORAGE 2ND GRADE CLASSROOM TEACHER WARDROBE COAT ROOM STORAGE	B-7 B-23  123  101C  101 101 123 123  102A  102B 125  103 103 125  104A  105A  106A  106A  107	1ST GRADE CLASSROOM EXIST. TOILET ROOM EXIST. TOILET ROOM J.C. 1ST GRADE CLASSROOM CORRIDOR 'C' 1ST GRADE CLASSROOM 2ND GRADE CLASSROOM 2ND GRADE CLASSROOM 2ND GRADE CLASSROOM 2ND GRADE CLASSROOM CORRIDOR 'C' 2ND GRADE CLASSROOM	101 101 101 101 101 101 101A 101B 102 102 102 102 102 102 103 103 103B 103A 104 104 104 105 105 105 105 105 106 106 106 106 106 106 106 107	YES YES YES YES YES YES YES YES YES	3' - 0"	WD FRP WD	F H YES  G E B B B B B B B B B B B B B B B B B B	WD   WD-1   HM   HM-2   WD   WD-1T   WD   WD-1T   WD   WD-1T   WD   WD-1   WD   WD-1   WD   WD-1   WD   WD-1   WD   WD-1T	10 15 10 10 10 10 10 10 10 10 15 10 15 10 10 15 10 10 15 10 10 15 10 10 10 15 10 10 10 10 10 10 10 10 10 10 10 10 10	11	20 MIN.  20 MIN.  20 MIN.  20 MIN.	08.1 08.9  06 ETR ETO7 ETR ETR 08 06 ETR ETO7 ETR ETR 08.5 06 ETR ETO7 ETR O6 ETR ETO7 ETR ETR O6 ETR ETO7 ETR ETR O6 ETR ETO7 ETR ETR O6 ETR	REFER TO NOTE 9 REFER TO NOTE 9 REFER TO NOTE 9 REFER TO NOTE 10  REFER TO NOTE 9
el 1 .1 .2 .3 .4 .5 .6 .7 .1 .2 .3 .4 .5 .5 .1 .2 .3 .4 .5 .1 .2 .3 .3 .4 .5 .1 .2 .3 .3 .4 .5 .1 .2 .3 .3 .4 .5 .1 .2 .3 .3 .4 .5 .1 .2 .3 .3 .4 .5 .1 .2 .3 .3 .4 .5 .1 .2 .3 .3 .4 .5 .1 .2 .3 .3 .4 .5 .1 .2 .3 .3 .4 .5 .1 .2 .3 .3 .4 .5 .1 .2 .3 .3 .4 .5 .1 .2 .3 .3 .4 .5 .1 .2 .3 .3 .4 .5 .1 .2 .3 .3 .4 .5 .1 .2 .3 .3 .4 .5 .5 .1 .2 .3 .3 .4 .4 .5 .5 .1 .2 .3 .3 .4 .4 .5 .5 .1 .2 .3 .3 .4 .4 .5 .5 .1 .2 .3 .3 .4 .4 .5 .5 .1 .2 .3 .4 .4 .5 .5 .1 .2 .2 .3 .3 .4 .4 .5 .5 .1 .2 .2 .3 .3 .4 .4 .5 .5 .1 .2 .2 .3 .3 .4 .4 .5 .5 .1 .2 .2 .3 .3 .4 .4 .5 .5 .1 .2 .2 .3 .3 .4 .4 .5 .5 .1 .2 .2 .3 .3 .4 .4 .5 .5 .1 .2 .2 .3 .3 .4 .4 .5 .5 .1 .2 .2 .3 .3 .4 .4 .5 .5 .1 .2 .2 .3 .3 .4 .4 .5 .5 .1 .2 .2 .3 .4 .4 .5 .5 .1 .2 .2 .3 .4 .4 .5 .5 .4 .4 .5 .5 .4 .4 .5 .5 .4 .4 .5 .5 .4 .4 .5 .5 .4 .4 .5 .4 .5 CLASSROOM TEACHER WARDROBE COAT ROOM STORAGE 2ND GRADE CLASSROOM TEACHER WARDROBE COAT ROOM STORAGE 2ND GRADE CLASSROOM TEACHER WARDROBE COAT ROOM STORAGE 2ND GRADE CLASSROOM	B-7   B-23   123   101C   101   101   123   123   102A   102A   102B   125   103   105   105   105   105   105   106   106   106   107   107   107   107   107   107   108	1ST GRADE CLASSROOM 1ST GRADE CLASSROOM 1ST GRADE CLASSROOM 1ST GRADE CLASSROOM EXIST. TOILET ROOM EXIST. TOILET ROOM EXIST. TOILET ROOM J.C. 1ST GRADE CLASSROOM CORRIDOR 'C' 1ST GRADE CLASSROOM 1ST GRADE CLASSROOM COAT ROOM TOILET ROOM 1ST GRADE CLASSROOM 2ND GRADE CLASSROOM	101 101 101 101 101 101 101A 101B 102 102 102 102 102 102 103 103 103B 103A 104 104 104 104 105 105 105 105 105 105 105 105 105 105	YES	3' - 0"	WD FRP WD	F H YES  G E B B B B B B B B B B B B B B B B B B	WD   WD-1   HM   HM-2   WD   WD-1T   WD   WD-1T   WD   WD-1   WD   WD-1   WD   WD-1   WD   WD-1   WD   WD-1T	10 15 10 15 10 10 10 10 10 10 10 15 10 11 10 11 10 11 10 11 10 15 10 11 10 15 10 10 15 10 10 15 10 10 15 10 10 15 10 10 11 11	11	20 MIN.  20 MIN.  20 MIN.  20 MIN.	08.1 08.9  06 ETR ETO7 ETR ETR 08 06 ETR ETO7 ETR ETR 08.5 06 ETR ETO7 ETR O6 ETR ETO7 ETR ETR O6 ETR ETO7 ETR ETR O6 ETR ETO7 ETR ETR O6 ETR ETR O6 ETR ETO7 ETR ETR O6 ETR ETR O6 ETR ETO7 ETR ETR O6 ETR ETR O6 ETR ETR O6 ETR	REFER TO NOTE 9
Pel 1 1 .1 .2 .3 .4 .5 .6 .7 .1 .2 .3 .4 .5 .5 .1 .2 .3 .4 .5 .5 .1 .2 .2 .3 .4 .5 .5 .1 .2 .2 .3 .4 .5 .5 .1 .2 .2 .3 .4 .5 .5 .1 .2 .2 .3 .4 .5 .5 .5 .1 .2 .2 .3 .5 .5 .5 .1 .2 .2 .3 .5 .5 .5 .1 .2 .2 .3 .5 .5 .5 .5 .1 .2 .2 .3 .5 .5 .5 .5 .5 .5 .5 .5 .5 .5 .5 .5 .5	VEST. G STOR./ FORMER BOIL. RM.  CORRIDOR 'A' TEACHER WARDROBE COAT ROOM STORAGE 1ST GRADE CLASSROOM CORRIDOR 'A' CORRIDOR 'A' TEACHER WARDROBE COAT ROOM STORAGE STORAGE STORAGE STORAGE STORAGE STORAGE ELEC / IDF CORRIDOR 'C' TEACHER WARDROBE 1ST GRADE CLASSROOM CORRIDOR 'C' TEACHER WARDROBE 1ST GRADE CLASSROOM STORAGE 1ST GRADE CLASSROOM CORRIDOR 'C' TEACHER WARDROBE COAT ROOM STORAGE 1ST GRADE CLASSROOM TEACHER WARDROBE COAT ROOM STORAGE 1ST GRADE CLASSROOM TEACHER WARDROBE COAT ROOM STORAGE 2ND GRADE CLASSROOM TEACHER WARDROBE STORAGE 2ND GRADE CLASSROOM TEACHER WARDROBE STORAGE COAT ROOM STORAGE 2ND GRADE CLASSROOM	B-7 B-23  123  101C  101 101 123 123  102A  102B 125  103 103 125  104A  105A  106A  106A  107  107A 107A 107A 108  108A	1ST GRADE CLASSROOM 1ST GRADE CLASSROOM 1ST GRADE CLASSROOM 1ST GRADE CLASSROOM EXIST. TOILET ROOM EXIST. TOILET ROOM J.C. 1ST GRADE CLASSROOM 2ND GRADE CLASSROOM	101 101 101 101 101 101 101A 101B 102 102 102 102 102 102 103 103 103B 103A 104 104 104 104 105 105 105 105 105 105 105 105 105 105	YES	3' - 0"	WD FRP WD	F H YES  G E B B B B B B B B B B B B B B B B B B	WD   WD-1   HM   HM-2   WD   WD-1T   WD   WD-1T   WD   WD-1   WD   WD-1   WD   WD-1   WD   WD-1   WD   WD-1   WD   WD-1T	15 10 15 10 15 15 10 15 15 10 15 15 10 15 15 10 15 15 10 15 15 10 15 15 10 15 15 10 15 15 10 15 15 10 15 15 10 15 15 10 15 15 10 15 15 10 15 15 10 15 15 10 15 15 10 10 15 15 15 10 10 15 15 10 10 15 15 15 10 10 15 15 15 10 10 15 15 15 10 10 10 10 10 10 10 10 10 10 10 10 10	11	20 MIN.  20 MIN.  20 MIN.  20 MIN.	08.1 08.9  06 ETR ETO7 ETR ETR 08 06 ETR ETO7 ETR ETR 08.5 06 ETR ETO7 ETR O6 ETR ETO7 ETR O6 ETR ETO7 ETR O6 ETR ETO7 ETR O6 ETR ETO7 ETR ETR O6 ETR	REFER TO NOTE 9 REFER TO NOTE 9 REFER TO NOTE 9 REFER TO NOTE 9 REFER TO NOTE 10  REFER TO NOTE 9
106A   107A   107A   107A   107A   108A   10	1ST GRADE CLASSROOM EXIST. TOILET ROOM J.C. 1ST GRADE CLASSROOM CORRIDOR 'C' 1ST GRADE CLASSROOM 2ND GRADE CLASSROOM	101 101 101 101 101 101 101A 101B 102 102 102 102 102 102 103 103 103B 103A 104 104 104 104 105 105 105 105 105 105 105 105 105 105	YES	3' - 0"	WD FRP WD	F H YES  G E B B B B B B B B B B B B B B B B B B	WD   WD-1   HM   HM-2   WD   WD-1T   WD   WD-1T   WD   WD-1   WD   WD-1   WD   WD-1   WD   WD-1   WD   WD-1T	10 15 10 15 10 10 10 10 10 10 10 15 10 15 10 10 15 10 10 15 15 10 15 10 15 15 10 15 15 10 15 15 10 15 15 10 15 15 10 15 15 10 15 15 10 15 15 10 15 15 10 15 15 10 15 15 10 15 15 10 15 15 10 15 15 10 15 15 10 15 15 10 15 15 10 15 15 15 10 15 15 15 10 15 15 15 10 15 15 15 16 17 16 17 17 18 18 18 18 18 18 18 18 18 18 18 18 18	11	20 MIN.  20 MIN.  20 MIN.  20 MIN.  20 MIN.	08.1 08.9  06 ETR ETO7 ETR ETR 08 06 ETR ETO7 ETR ETR 08.5 06 ETR ETO7 ETR O6 ETR ETO7 ETR O6 ETR ETO7 ETR O6 ETR ETO7 ETR O6 ETR ETO7 ETR ETR O6 ETR ETR O6 ETR ETO7 ETR ETR O6 ETR ETO7 ETR ETR O6 ETR ETR O6 ETR ETO7 ETR ETR O6 ETR ETR OF ETR ETR ETR OF ETR ETR ETR OF ETR ETR ETR OF ETR	REFER TO NOTE 9 REFER TO NOTE 9 REFER TO NOTE 9 REFER TO NOTE 10  REFER TO NOTE 9 REFER TO NOTE 10  REFER TO NOTE 9
el 1 .1 .2 .3 .4 .5 .6 .7 .1 .2 .3 .4 .5 .5 .1 .2 .3 .4 .5 .5 .1 .2 .3 .4 .5 .5 .1 .2 .3 .4 .5 .5 .1 .2 .3 .4 .5 .5 .1 .2 .3 .4 .5 .5 .1 .2 .3 .4 .5 .5 .1 .2 .3 .4 .5 .5 .1 .2 .2 .3 .4 .5 .5 .1 .2 .2 .3 .4 .5 .5 .1 .2 .2 .3 .4 .5 .5 .1 .2 .2 .3 .4 .5 .5 .1 .2 .2 .3 .4 .5 .5 .1 .2 .2 .3 .4 .5 .5 .1 .2 .2 .3 .4 .5 .5 .1 .2 .2 .3 .4 .5 .5 .1 .2 .2 .3 .4 .5 .5 .1 .2 .2 .3 .4 .5 .5 .1 .2 .2 .3 .4 .2 .2 .3 .4 .4 .5 .5 .1 .2 .2 .3 .4 .4 .5 .5 .1 .2 .2 .2 .3 .4 .2 .2 .2 .2 .2 .2 .2 .2 .2 .2 .2 .2 .2	VEST. G STOR./ FORMER BOIL. RM.  CORRIDOR 'A' TEACHER WARDROBE COAT ROOM STORAGE 1ST GRADE CLASSROOM 1ST GRADE CLASSROOM CORRIDOR 'A' CORRIDOR 'A' TEACHER WARDROBE COAT ROOM STORAGE STORAGE STORAGE STORAGE STORAGE ELEC / IDF CORRIDOR 'C' TEACHER WARDROBE 1ST GRADE CLASSROOM 1ST GRADE CLASSROOM 1ST GRADE CLASSROOM CORRIDOR 'C' TEACHER WARDROBE 1ST GRADE CLASSROOM TST GRADE CLASSROOM CORTIDOR 'C' TEACHER WARDROBE COAT ROOM STORAGE 1ST GRADE CLASSROOM TEACHER WARDROBE COAT ROOM STORAGE 2ND GRADE CLASSROOM TEACHER WARDROBE COAT ROOM 2ND GRADE CLASSROOM TEACHER WARDROBE COAT ROOM STORAGE 2ND GRADE CLASSROOM TEACHER WARDROBE	B-7   B-23   123   101C   101   101   123   123   102A   102A   102B   125   103   105A   105A   105A   106A   106A   107A   107A   107A   107A   107A   107A   108A   109   109A   10	1ST GRADE CLASSROOM 1ST GRADE CLASSROOM 1ST GRADE CLASSROOM 1ST GRADE CLASSROOM EXIST. TOILET ROOM EXIST. TOILET ROOM J.C. 1ST GRADE CLASSROOM CORRIDOR 'C' 1ST GRADE CLASSROOM 2ND GRADE CLASSROOM	101 101 101 101 101 101 101 101A 101B 102 102 102 102 102 102 103 103 103B 103A 104 104 104 104 105 105 105 105 105 105 105 105 107 107 107 107 107 107 107 107 107 107	YES	3' - 0"	WD FRP WD	F H YES  G E B B B B B B B B B B B B B B B B B B	WD   WD-1   HM   HM-2   WD   WD-1T   WD   WD-1T   WD   WD-1   WD   WD-1   WD   WD-1   WD   WD-1   WD   WD-1   WD   WD-1T	10 15 10 15 10 10 10 10 10 10 10 15 15 10 10 15 10 10 15 15 10 10 15 15 10 10 10 15 15 10 10 10 15 15 10 10 10 15 15 10 10 10 15 15 10 10 10 10 15 15 10 10 10 10 15 15 10 10 10 10 10 10 10 10 10 10 15 10 10 10 10 10 10 10 10 10 10 10 10 10	11	20 MIN.  20 MIN.  20 MIN.  20 MIN.  20 MIN.	08.1 08.9  06 ETR ETO7 ETR ETR 08 06 ETR ETO7 ETR ETR 08.5 06 ETR ETO7 ETR TETR 06 ETR ETO7 ETR TETR TETR TETR TETR TETR TETR TETR	REFER TO NOTE 9
el 1 .1 .2 .3 .4 .5 .6 .7 .1 .2 .3 .4 .5 .8 .1 .2 .3 .4 .5 .1 .2 .3 .4 .4 .5 .5 .1 .2 .3 .4 .5 .4 .5 .1 .2 .3 .4 .5 .5 .4 .5 .6 .7 .7 .7 .7 .7 .7 .7 .7 .7 .7 .7 .7 .7	VEST. G STOR./ FORMER BOIL. RM.  CORRIDOR 'A' TEACHER WARDROBE COAT ROOM STORAGE 1ST GRADE CLASSROOM 1ST GRADE CLASSROOM CORRIDOR 'A' CORRIDOR 'A' TEACHER WARDROBE COAT ROOM STORAGE STORAGE STORAGE STORAGE STORAGE STORAGE STORAGE IST GRADE CLASSROOM 1ST GRADE CLASSROOM 1ST GRADE CLASSROOM 1ST GRADE CLASSROOM 1ST GRADE CLASSROOM CORRIDOR 'C' TEACHER WARDROBE 1ST GRADE CLASSROOM TST GRADE CLASSROOM STORAGE 1ST GRADE CLASSROOM TEACHER WARDROBE COAT ROOM STORAGE 2ND GRADE CLASSROOM TEACHER WARDROBE COAT ROOM TEACHER WARDROBE COAT ROOM TEACHER WARDROBE COAT ROOM TEACHER WARDROBE	B-7   B-23   101C   101   101   123   123   102A   102A   102B   125   103   103   125   104A   105A   105A   106A   106A   107A   107A   107A   107A   107A   108A   109A   10	1ST GRADE CLASSROOM 1ST GRADE CLASSROOM 1ST GRADE CLASSROOM 1ST GRADE CLASSROOM EXIST. TOILET ROOM EXIST. TOILET ROOM J.C. 1ST GRADE CLASSROOM 2ND GRADE CLASSROOM	101 101 101 101 101 101 101 101A 101B 102 102 102 102 102 102 103 103 103B 103A 104 104 104 104 105 105 105 105 105 106 106 106 106 106 106 107 107 107 107 107 107 107 107 107 107	YES	3' - 0"	WD FRP WD	F H YES  G E B B B B B B B B B B B B B B B B B B	WD   WD-1   HM   HM-2   WD   WD-1T   WD   WD-1T   WD   WD-1   WD   WD-1T   WD   WD-1T   WD   WD-1	10 15 10 15 10 10 10 10 10 10 10 15 15 10 10 15 10 10 15 15 10 10 15 15 10 10 15 15 10 10 15 15 10 10 15 15 10 10 15 15 10 10 15 15 10 10 15 15 10 10 15 15 10 10 15 15 10 10 15 15 10 10 15 15 10 10 15 15 10 10 15 15 10 10 10 15 15 10 10 10 15 15 10 10 10 15 15 10 10 10 10 15 15 10 10 10 10 15 15 10 10 10 15 15 10 10 10 10 10 10 10 10 15 15 10 10 10 10 10 10 10 10 10 10 10 10 10	11	20 MIN.  20 MIN.  20 MIN.  20 MIN.  20 MIN.  20 MIN.	08.1 08.9  06 ETR ETO7 ETR ETR 08 06 ETR ETO7 ETR ETR 08.5 06 ETR ETO7 ETR O6 ETR ETO7 ETR O6 ETR ETO7 ETR ETR	REFER TO NOTE 9 REFER TO NOTE 10  REFER TO NOTE 9
22	VEST. G STOR./ FORMER BOIL. RM.  CORRIDOR 'A' TEACHER WARDROBE COAT ROOM STORAGE 1ST GRADE CLASSROOM 1ST GRADE CLASSROOM CORRIDOR 'A' CORRIDOR 'A' TEACHER WARDROBE COAT ROOM STORAGE STORAGE STORAGE STORAGE ELEC / IDF CORRIDOR 'C' TEACHER WARDROBE 1ST GRADE CLASSROOM CORRIDOR 'C' TEACHER WARDROBE 1ST GRADE CLASSROOM CORRIDOR 'C' TEACHER WARDROBE COAT ROOM STORAGE 1ST GRADE CLASSROOM TEACHER WARDROBE COAT ROOM STORAGE 2ND GRADE CLASSROOM TEACHER WARDROBE COAT ROOM COAT ROOM STORAGE 2ND GRADE CLASSROOM TEACHER WARDROBE COAT ROOM TEACHER WARDROBE STORAGE COAT ROOM COAT ROOM COAT ROOM TEACHER WARDROBE STORAGE COAT ROOM	B-7   B-23	1ST GRADE CLASSROOM 1ST GRADE CLASSROOM 1ST GRADE CLASSROOM 1ST GRADE CLASSROOM EXIST. TOILET ROOM EXIST. TOILET ROOM J.C. 1ST GRADE CLASSROOM CORRIDOR 'C' 1ST GRADE CLASSROOM 2ND GRADE CLASSROOM	101 101 101 101 101 101 101A 101B 102 102 102 102 102 102 103 103 103 103B 103A 104 104 104 104 1105 105 105 105 105 106 106 106 106 106 106 107 107 107 107 107 107 107 107 107 107	YES	3' - 0"	WD FRP WD	F H YES  G E B B B B B B B B B B B B B B B B B B	WD   WD-1   HM   HM-2   WD   WD-1T   WD   WD-1T   WD   WD-1   WD   WD-1   WD   WD-1   WD   WD-1   WD   WD-1T	10 15 10 15 10 10 10 10 10 10 10 10 15 10 11 10 10 10 11 10 11 10 11 10 15 15 10 11 15 10 11 15 10 11 15 10 11 15 10 11 15 10 11 15 10 11 15 10 11 10 10 10 10 10 10 10 10 10 10 10	11	20 MIN.  20 MIN.  20 MIN.  20 MIN.  20 MIN.  20 MIN.	08.1 08.9  06 ETR ETO7 ETR ETR 08 06 ETR ETO7 ETR ETR 08.5 06 ETR ETO7 ETR O6 ETR ETO7 ETR O6 ETR ETO7 ETR ETR 06 ETR ETO7 ETR ETR O6 ETR ETO7 ETR ETR ETO7 ETR ETR ETO7 O6 ETR ETO7 ETR ETR ETO7 ETR ETR ETO7 ETR ETR ETO7 ETR ETR ETO7 O6 ETR ETO7 ETR ETR ETO7 ETR ETR ETO7 ETR ETR ETO7 ETR ETR ETO7 O6 ETR ETO7 ETR ETR ETO7 ETR ETR ETO7 ETR ETR ETO7 ETR ETR ETO7 O6 ETR ETO7 ETR ETR ETO7 ETR ETR ETO7 ETR ETR ETO7 ETR ETR ETO7 O6 ETR ETO7 ETR ETR ETO7 ETR ETR ETO7 ETR ETR ETO7 ETR ETR ETO7 O6 ETR ETO7 ETR ETR ETR ETO7 ETR ETR ETO7 ETR ETR ETR ETO7 ETR ETR ETO7 ETR ETR ETR ETR ETR ETO7 ETR ETR ETR ETR ETO7 ETR ETR ETR ETR ETR ETR	REFER TO NOTE 9
22	VEST. G STOR./ FORMER BOIL. RM.  CORRIDOR 'A' TEACHER WARDROBE COAT ROOM STORAGE 1ST GRADE CLASSROOM 1ST GRADE CLASSROOM CORRIDOR 'A' CORRIDOR 'A' TEACHER WARDROBE COAT ROOM STORAGE STORAGE STORAGE STORAGE ELEC / IDF CORRIDOR 'C' TEACHER WARDROBE 1ST GRADE CLASSROOM CORRIDOR 'C' TEACHER WARDROBE 1ST GRADE CLASSROOM CORRIDOR 'C' TEACHER WARDROBE 1ST GRADE CLASSROOM TST GRADE CLASSROOM TST GRADE CLASSROOM TEACHER WARDROBE COAT ROOM STORAGE 2ND GRADE CLASSROOM TEACHER WARDROBE STORAGE COAT ROOM TEACHER WARDROBE COAT ROOM TEACHER WARDROBE COAT ROOM TEACHER WARDROBE STORAGE COAT ROOM COAT ROOM TEACHER WARDROBE COAT ROOM COAT ROOM COAT ROOM STORAGE 2ND GRADE CLASSROOM TEACHER WARDROBE COAT ROOM	B-7   B-23   123   101C   101   101   123   123   102A   102A   102B   125   103   105A   105A   105A   106A   106A   107A   1	1ST GRADE CLASSROOM 1ST GRADE CLASSROOM 1ST GRADE CLASSROOM 1ST GRADE CLASSROOM EXIST. TOILET ROOM EXIST. TOILET ROOM J.C. 1ST GRADE CLASSROOM CORRIDOR 'C' 1ST GRADE CLASSROOM 2ND GRADE CLASSROOM	101 101 101 101 101 101 101 101 101A 101B 102 102 102 102 102 102 103 103 103B 103A 104 104 104 105 105 105 105 105 105 105 105 106 106 106 106 106 107 107 107 107 107 107 107 107 107 107	YES	3' - 0"	WD FRP WD	F H YES  G E B B B B B B B B B B B B B B B B B B	WD   WD-1   HM   HM-2   WD   WD-1T   WD   WD-1T   WD   WD-1   WD   WD-1   WD   WD-1   WD   WD-1   WD   WD-1   WD   WD-1T   WD   WD-1T	10  15  10  15  10  10  10  10  10  10	11	20 MIN.  20 MIN.  20 MIN.  20 MIN.  20 MIN.  20 MIN.	08.1 08.9  06 ETR ETO7 ETR ETR 08 06 ETR ETO7 ETR ETR 08.5 06 ETR ETO7 ETR O6 ETR ETO7 ETR ETR 06 ETR ETO7 ETR ETR ETR 06 ETR ETO7 ETR ETR	REFER TO NOTE 9

DOOR							DC	OR					FRAME				HDWR	
MARK	FROM ROOM		TO ROOM		NEW	S	IZE	MTRL	ELEV.	NEW	MTRL	ELEV		DETAIL		FIRE	SET	
WARN	NAME	NO.	NAME	NO.	DOOR	WIDTH	HEIGHT	WIIKL	ELEV.	FRAME	WIIKL	ELEV	HEAD	JAMB	SILL	RATING	NO.	COMMENTS
								ı										
16.3	PRINCIPAL'S OFFICE	117	MAIN OFFICE	116		2' - 8"	7' - 0"	WD	В		WD	WD-1T	15	11			ETR	
17.1	PRINCIPAL'S OFFICE	117	CORRIDOR 'A'	123	YES	3' - 0"	7' - 0"	WD	G		WD	WD-1T	15	11	В	20 MIN.	05.2	
17.2	PRINCIPAL'S OFFICE	117	STORAGE	117B		2' - 8"	7' - 0"	WD	F		WD	WD-1	10	11	-		ETR	
17.3	EXIST. TOILET ROOM	117A	PRINCIPAL'S OFFICE	117		2' - 8"	7' - 0"	WD	F		WD	WD-1	10	11	F		ETR	
118.1	EXIST. FAC. WOMEN'S TL.	118	CORRIDOR 'A'	123	YES	2' - 8"	7' - 0"	WD	Н		WD	WD-1	10	11	D	20 MIN.	06.2	
119.1	CORRIDOR 'C'	125	STAIR A	119		3' - 6"	7' - 0"	AL	Α		AL	ST-1	30	26 & 27	29	90 MIN.	RAL	
19.2	CORRIDOR 'C'	125	STAIR A	119		3' - 6"	7' - 0"	AL	Α		AL	ST-1	30	26 & 27	29	90 MIN.	RAL	
20.1	EXIST. GIRLS' TOILET	120	CORRIDOR 'C'	125	YES	2' - 8"	7' - 0"	WD	Н		WD	WD-1T	15	11	F	20 MIN.	06.1	
20.2	EXIST. GIRLS' TOILET	120	EXIST. GIRLS' TOILET	120		2' - 8"	7' - 0"	WD	В		WD	WD-1T	15	11	-	20 MIN.	ETR	
21.1	EXIST. BOYS' TOILET	121	CORRIDOR 'C'	125	YES	2' - 8"	7' - 0"	WD	Н		WD	WD-1T	15	11	G		06.1	
21.2	EXIST. BOYS' TOILET	121	EXIST. BOYS' TOILET	121		2' - 8"	7' - 0"	WD	В		WD	WD-1T	15	11	-		ETR	
22.1	STAIR C	122	CORRIDOR 'C'	125		3' - 6"	7' - 0"	AL	Α		AL	ST-1	30	26 & 27	29	90 MIN.	RAL	
122.2	STAIR C	122	CORRIDOR 'C'	125		3' - 6"	7' - 0"	AL	Α		AL	ST-1	30	26 & 27	29	90 MIN.	RAL	
125.1	STORAGE		CORRIDOR 'C'	125		2' - 8"	7' - 0"	WD	F		WD	WD-1	10	11	ETR		ETR	
125.2	STORAGE		CORRIDOR 'C'	125		2' - 8"	7' - 0"	WD	F		WD	WD-1	10	11	ETR		ETR	
140	VEST.	113	STAIR B	112		3' - 4"	7' - 0"	WD	В		WD	WD-1	10	11	ETR		E6	
141	CORRIDOR 'C'	125	VEST.	113		3' - 4"	7' - 0"	WD	В		WD	WD-1	10	11	ETR		E9	

1. REFER TO A-602 FOR ADDITIONAL DOOR SCHEDULES. 2. REFER TO SPECIFICATIONS FOR HARDWARE SET INFORMATION.


3. REFER TO A-603 FOR FRAME HEAD, JAMB, AND SILL DETAILS 4. ALL METAL DOORS TO BE PREPARED TO RECEIVE PAINT. PRIME AND PAINT ALL METAL DOORS.

5. ALL WOOD DOORS AND FRAMES TO BE CLEANED, SANDED & STAINED, UNLESS OTHERWISE NOTED. 6. ALL OTHER DOOR FRAMES TO BE PAINTED U.O.N.

7. REFER TO INTERIOR FINISH SCHEDULE FOR PAINT TYPES. 8. EXISTING TO REMAIN IS ABBREVIATED AS ETR.

9. STRIP / SAND & REFINISH DOORS & FRAMES NOTED IN DOOR SCHEDULE.

10. REFER TO LINTEL SCHEDULE ON S-003 FOR LINTELS AT NEW OPENINGS IN MASONRY WALLS. PROVIDE CFMF BOX HEADER AT NON MASONRY OPENINGS.

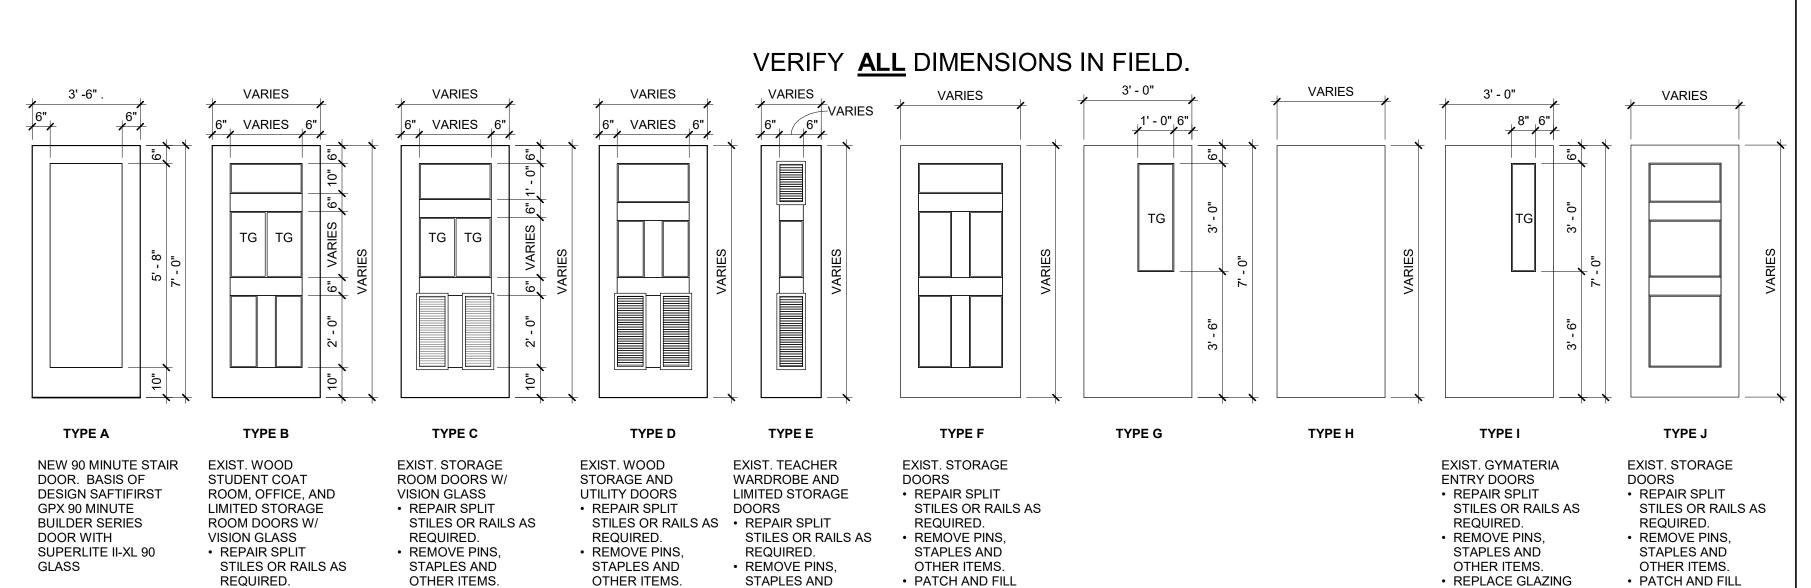

DAMAGED AREAS.

PRIMER AND PAINT.

SCHEDULED, REFER

TYPE K

PREPARE FOR

PREPARE TO

RECEIVE NEW

HARDWARE AS

SCHEDULE FOR

TO DOOR

LOCATIONS.

**DOOR TYPES** 

SCALE: 3/8" = 1'-0"

REMOVE PINS,

STAPLES AND

OTHER ITEMS.

WITH NEW

TEMPERED

PATCH AND FILL

CLEAN, SAND &

PREPARE TO

TO DOOR

LOCATIONS.

EXIST. METAL STAIRWELL

RECEIVE NEW

HARDWARE AS

SCHEDULE FOR

BREEZEWAY DOORS W/ WIRE GLASS. PREPARE FOR PRIMER AND PAINT.
• PREPARE TO RECEIVE NEW HARDWARE AS

SCHEDULED, REFER

TO DOOR

SCHEDULE FOR LOCATIONS.

SCHEDULED, REFER

DAMAGED AREAS.

GLAZING.

REPLACE GLAZING

OR MISSING LITES

REPLACE GLAZING

OR MISSING LITES

REPLACE DAMAGED

LOUVER BLADES.

DAMAGED AREAS.

PRIMER AND PAINT.

SCHEDULED, REFER

PATCH AND FILL

PREPARE FOR

PREPARE TO

TO DOOR

LOCATIONS.

RECEIVE NEW HARDWARE AS

SCHEDULE FOR

WITH NEW

TEMPERED

OR MISSING

GLAZING.

REPLACE DAMAGED

LOUVER BLADES.

DAMAGED AREAS.

PRIMER AND PAINT.

SCHEDULED, REFER

PATCH AND FILL

PREPARE FOR

PREPARE TO

TO DOOR

LOCATIONS.

RECEIVE NEW

HARDWARE AS

SCHEDULE FOR

OR MISSING

OTHER ITEMS.

OR MISSING

STAIN.

REPLACE DAMAGED

LOUVER BLADES.

DAMAGED AREAS.

PATCH AND FILL

CLEAN, SAND &

PREPARE TO

TO DOOR

LOCATIONS

RECEIVE NEW

HARDWARE AS

SCHEDULE FOR

SCHEDULED, REFER

THE SCHOOL DISTRICT OF PHILADELPHIA

OFFICE OF CAPITAL PROGRAMS

440 NORTH BROAD STREET PHILADELPHIA, PA 19130 - 4015 (215) 400 - 4730 | (215) 400 - 4731 (fax) www.philasd.org

SEAL:

**ARCHITECT** 

DIGROUPARCHITECTURE 15 Bethany Street

New Brunswick, NJ 08901 Phone: (732) 249-6242 Fax:(732) 247-1825 Email:eackerman@digrouparchitecture.com

Attn:Elizabeth Ackerman

SCHILLER AND HERSH ASSOCIATES, INC. 636 W Skippack Pike #200 Blue Bell, PA 19422 Phone:(215) 886-8947 Fax:(215) 886-8956 Email:rdelp@schillerhersh.com

CIVIL

Attn:Richard Delp

KS ENGINEERS, P.C. 530 Walnut Street, Suite 460 Philadelphia, PA 19106 Phone: (215) 925-0425 Fax:(215) 925-0430 Email:dhassinger@kseng.com Attn:David J. Hassinger

**STRUCTURAL** 

123 S Broad Street Suite 1130 Philadelphia, PA 19109 Phone: (215) 372-3400 Email: jevans@davidmason.com Attn: Jeff Evans

**KITCHEN** 

MCFARLAND KISTLER & ASSOCIATES 1130 Perry Highway, Suite 115 Pittsburgh, PA 15237 Phone: (412) 367-1905 Fax: (412) 367-4487 Email: kkistler-mka@comcast.net Attn: Ken Kistler

**MASONRY** 

SCHNABEL CONSERVATION LLC 110 Kensington Avenue Trenton NJ 08618 Phone: (215) 582-3680

Email: lorraine@schnabelconservation.com Attn: Lorraine Schnabel

4	2022-05-06	ADDENDUM NO. 4
2	2022-03-31	ISSUED FOR BID
1	2022-03-10	ISSUED FOR PERMIT
NO.	DATE	REVISION
SC		LOCATION WIN FORREST
		ENTARY SCHOOL

4300 BLEIGH AVENUE

PROJECT TITLE

PHILADELPHIA, PA 19136

MAJOR RENOVATIONS

DRAWING TITLE

DAMAGED AREAS.

PRIMER AND PAINT.

SCHEDULED, REFER

PREPARE FOR

PREPARE TO

TO DOOR

RECEIVE NEW

HARDWARE AS

SCHEDULE FOR

LOCATIONS.

W/ TEMPERED.

PATCH AND FILL

PREPARE FOR

PREPARE TO

TO DOOR

TYPE L

LOCATIONS.

RECEIVE NEW

HARDWARE AS

SCHEDULE FOR

DAMAGED AREAS

PRIMER AND PAINT.

SCHEDULED, REFER

DOOR SCHEDULE AND **DOOR TYPES** 

	_
DRAWING SCALE 3/8" = 1'-0"	
LOCATION NO.	FILE NO. 20.083
DRAWN BY	CHECKED BY

MF, JB, LMJ MC, LMJ GC: B-057 C OF 2020 / 21 MC: B-058 C OF 2020 / 21 PC: B-059 C OF 2020 / 21 EC: B-060 C OF 2020 / 21

DRAWING NO.

A-601 SHEET 0

CORRIDOR 'A' TEACHER WARDROBE STORAGE STORAGE CORRIDOR 'A' TEACHER WARDROBE COAT ROOM COAT ROOM STORAGE CORRIDOR 'B' TEACHER WARDROBE STORAGE COAT ROOM NEW ART CLASSROOM TEACHER WARDROBE STORAGE STORAGE STORAGE STORAGE NEW ART CLASSROOM STORAGE NEW ART CLASSROOM STORAGE TEACHER WARDROBE NEW SGI CLASSROOM STORAGE STOR	B: A	NO	TO ROOM	NO	NEW		ZE	MTRL	ELEV.	NEW	MTRL	ELEV	UEAR	DETAIL	en .	FIRE	HDWR SET NO. COMMENTS
TEACHER WARDROBE STORAGE STORAGE TOORRIDOR 'A' TEACHER WARDROBE COAT ROOM COAT ROOM COAT ROOM TEACHER WARDROBE CORRIDOR 'B' TEACHER WARDROBE TEACHER TOOR	NAIVIE	NO.	NAME	NO.	DOOR	WIDTH	HEIGHT			FRAME			HEAD	JAMB	SILL	RATING	NO. COMMENTS
STORAGE STORAGE STORAGE CORRIDOR 'A' TEACHER WARDROBE COAT ROOM COAT ROOM STORAGE CORRIDOR 'B' TEACHER WARDROBE STORAGE COAT ROOM NEW ART CLASSROOM TEACHER WARDROBE STORAGE S	DR 'A'	222	NEW MAKER SPACE	201	YES	3' - 0"	7' - 0"	WD	G		WD	WD-1T	15	11	ETR	20 MIN.	06.4
4 STORAGE 1 CORRIDOR 'A' 2 TEACHER WARDROBE 3 COAT ROOM 4 COAT ROOM 5 STORAGE 1 CORRIDOR 'B' 2 TEACHER WARDROBE 4 STORAGE 5 COAT ROOM 1 NEW ART CLASSROOM 2 TEACHER WARDROBE 3 STORAGE 5 STORAGE 6 NEW ART CLASSROOM 7 STORAGE 8 TEACHER WARDROBE 1 NEW SGI CLASSROOM 2 STORAGE 1 NEW SGI CLASSROOM 2 STORAGE 1 NEW SCIENCE CLASSI 2 TEACHER WARDROBE 3 STORAGE 4 STORAGE 5 STORAGE 6 STORAGE 7 NEW SCIENCE CLASSI 1 NEW SCIENCE CLASSI 2 TEACHER WARDROBE 3 STORAGE 4 STORAGE 6 STORAGE 7 NEW SCIENCE CLASSI 1 NEW SCIENCE CLASSI 1 STORAGE 1 CORRIDOR 'A' 1 CORRIDOR 'B' 1 CORRIDOR 'B' 1 CORRIDOR 'B' 1 CORRIDOR 'B' 1 NEW J.C. 1 VEST. 1 CORRIDOR 'B' 1 STAIR C 2 STAIR C 1 STORAGE 2 STORAGE 2 STORAGE 3 COAT ROOM 4 STORAGE 4 STORAGE 4 STORAGE 5 STORAGE 5 STORAGE 6 STORAGE 6 STORAGE 6 STORAGE 7 NEW SCIENCE CLASSRO 7 NEW SCIENCE CLASSRO 8 STORAGE 8 STORAGE 8 STORAGE 9 ST		0044	NEW MAKER SPACE	201		1' - 8"	6' - 8"	WD	E		WD	WD-1	10	11	-		ETR REFER TO NOTE 9
1 CORRIDOR 'A' 2 TEACHER WARDROBE 3 COAT ROOM 4 COAT ROOM 5 STORAGE 1 CORRIDOR 'B' 2 TEACHER WARDROBE 4 STORAGE 5 COAT ROOM 1 NEW ART CLASSROOM 1 NEW ART CLASSROOM 2 TEACHER WARDROBE 3 STORAGE 5 STORAGE 6 NEW ART CLASSROOM 7 STORAGE 8 TEACHER WARDROBE 1 NEW SGI CLASSROOM 2 STORAGE 1 NEW SCIENCE CLASSI 2 TEACHER WARDROBE 3 STORAGE 1 NEW SCIENCE CLASSI 2 TEACHER WARDROBE 3 STORAGE 1 NEW SCIENCE CLASSI 1 NEW SCIENCE CLASSI 1 NEW SCIENCE CLASSI 1 STORAGE 5 STORAGE 6 STORAGE 7 NEW SCIENCE CLASSI 1 NEW SCIENCE CLASSI 1 STORAGE 1 NEW SCIENCE CLASSI 1 STORAGE 2 TEACHER WARDROBE 3 STORAGE 4 STORAGE 1 CORRIDOR 'G' 1 COUNSELOR 1 CORRIDOR 'G' 1 COUNSELOR 1 CORRIDOR 'B' 1 NEW J.C. 1 VEST. 1 CORRIDOR 'B' 1 STORAGE 2 STORAGE 2 STORAGE 2 STORAGE 3 COAT ROOM 4 STORAGE 4 STORAGE 4 STORAGE 5 STORAGE 5 STORAGE 6 STORAGE 6 STORAGE 7 NEW SCIENCE CLASSRO 6 STORAGE 7 NEW SCIENCE CLASSRO 7 STORAGE 8 STORAGE 8 STORAGE 8 STORAGE 9 STO		201A	NEW MAKER SPACE NEW MAKER SPACE	201		2' - 8"	7' - 0" 7' - 0"	WD WD	B D		WD WD	WD-1 WD-1	10 10	11 11	-		ETR REFER TO NOTE 9 ETR REFER TO NOTE 9
COAT ROOM COAT ROOM COAT ROOM COAT ROOM CORRIDOR 'B' CORRIDOR 'B' COAT ROOM	PR 'A'	222	3RD GRADE CLASSROOM	202	YES	3' - 0"	7' - 0"	WD	G		WD	WD-1T	15	11	ETR	20 MIN.	06
.4 COAT ROOM .5 STORAGE .1 CORRIDOR 'B' .2 TEACHER WARDROBE .4 STORAGE .5 COAT ROOM .1 NEW ART CLASSROON .2 TEACHER WARDROBE .3 STORAGE .5 STORAGE .6 NEW ART CLASSROON .7 STORAGE .8 TEACHER WARDROBE .1 NEW SGI CLASSROON .2 STORAGE .3 STORAGE .4 STORAGE .4 STORAGE .4 STORAGE .5 STORAGE .4 STORAGE .5 STORAGE .6 NEW SCIENCE CLASSI .2 TEACHER WARDROBE .3 STORAGE .4 STORAGE .5 STORAGE .6 STORAGE .6 STORAGE .7 NEW SCIENCE CLASSI .1 STORAGE .3 STORAGE .4 STORAGE .5 STORAGE .6 STORAGE .7 NEW SCIENCE CLASSI .1 STORAGE .3 STORAGE .4 STORAGE .5 STORAGE .1 3RD GRADE CLASSRO .2 TEACHER WARDROBE .3 STORAGE .1 3RD GRADE CLASSRO .2 TEACHER WARDROBE .3 COAT ROOM .4 STORAGE .1 3RD GRADE CLASSRO .2 TEACHER WARDROBE .3 COAT ROOM .4 STORAGE .1 GORRIDOR 'C' .1 COUNSELOR .1 FACULTY ROOM .2 TEACHER WARDROBE .3 NEW FACULTY TOILET .4 MDF .1 CORRIDOR 'A' .1 CORRIDOR 'B' .1 CORRIDOR 'B' .1 CORRIDOR 'B' .1 STAIR C .2 STAIR C .1 STORAGE .1		202A	3RD GRADE CLASSROOM 3RD GRADE CLASSROOM	202		1' - 8" 2' - 6"	6' - 8" 7' - 0"	WD WD	E B		WD WD	WD-1 WD-1T	10 15	11 11	-		ETR REFER TO NOTE 9 ETR REFER TO NOTE 9
1 CORRIDOR 'B' 2 TEACHER WARDROBE 4 STORAGE 5 COAT ROOM 1 NEW ART CLASSROOM 2 TEACHER WARDROBE 3 STORAGE .5 STORAGE .6 NEW ART CLASSROOM .7 STORAGE .8 TEACHER WARDROBE .1 NEW SGI CLASSROOM .2 STORAGE .3 STORAGE .4 STORAGE .4 STORAGE .1 NEW SCIENCE CLASSI .2 TEACHER WARDROBE .3 STORAGE .4 STORAGE .5 STORAGE .6 STORAGE .7 NEW SCIENCE CLASSI .1 STORAGE .3 STORAGE .4 STORAGE .5 STORAGE .6 STORAGE .6 STORAGE .7 NEW SCIENCE CLASSI .1 SRD GRADE CLASSRO .2 TEACHER WARDROBE .3 STORAGE .4 STORAGE .4 STORAGE .4 STORAGE .5 STORAGE .1 3RD GRADE CLASSRO .2 TEACHER WARDROBE .3 COAT ROOM .4 STORAGE .1 CORRIDOR 'C' .1 COUNSELOR .1 CORRIDOR 'B' .1 STAIR C .2 STAIR C .1 STORAGE .		202A 202A	3RD GRADE CLASSROOM	202		2' - 6"	7' - 0"	WD	В		WD	WD-1T	15	11	-		ETR REFER TO NOTE 9
TEACHER WARDROBE  TEACHER WARDROBE  TOOAT ROOM  NEW ART CLASSROOM  TEACHER WARDROBE  STORAGE  STORAGE  NEW ART CLASSROOM  TEACHER WARDROBE  TEACHER WARDROBE  TEACHER WARDROBE  TEACHER WARDROBE  NEW SGI CLASSROOM  TEACHER WARDROBE			3RD GRADE CLASSROOM	202	1,500	2' - 6"	7' - 0"	WD	D		WD	WD-1	10	11			ETR REFER TO NOTE 9
4 STORAGE 5 COAT ROOM 1 NEW ART CLASSROOM 2 TEACHER WARDROBE 3 STORAGE 5 STORAGE 6 NEW ART CLASSROOM 7 STORAGE 8 TEACHER WARDROBE 8 TEACHER WARDROBE 1 NEW SGI CLASSROOM 2 STORAGE 1 NEW SCIENCE CLASSI 2 TEACHER WARDROBE 3 STORAGE 4 STORAGE 5 STORAGE 6 STORAGE 7 NEW SCIENCE CLASSI 6 STORAGE 7 NEW SCIENCE CLASSI 7 NEW SCIENCE CLASSI 1 NEW SCIENCE CLASSI 1 NEW SCIENCE CLASSI 1 STORAGE 5 STORAGE 6 STORAGE 7 NEW SCIENCE CLASSI 1 SRD GRADE CLASSRO 2 TEACHER WARDROBE 3 STORAGE 4 STORAGE 5 STORAGE 6 STORAGE 1 SRD GRADE CLASSRO 2 TEACHER WARDROBE 3 COAT ROOM 4 STORAGE 1 SRD GRADE CLASSRO 2 TEACHER WARDROBE 3 COAT ROOM 4 STORAGE 1 SRD GRADE CLASSRO 2 TEACHER WARDROBE 3 COAT ROOM 4 STORAGE 1 STORAGE 1 COUNSELOR 1 COUNSELOR 1 CORRIDOR 'C' 1 COUNSELOR 1 CORRIDOR 'B' 1 TEACHER WARDROBE 3 COAT ROOM 4 STORAGE 4 ELEC / IDF 6 STORAGE 5 TEACHER WARDROBE 6 STORAGE 6 TEACHER WARDROBE 7 TEACHER WARDROBE		223	3RD GRADE CLASSROOM 3RD GRADE CLASSROOM	203	YES	3' - 0" 1' - 8"	7' - 0" 6' - 8"	WD WD	G E		WD WD	WD-1T WD-1	15 10	11	B	20 MIN.	06 ETR REFER TO NOTE 9
1 NEW ART CLASSROOM 2 TEACHER WARDROBE 3 STORAGE 5 STORAGE 6 NEW ART CLASSROOM 7 STORAGE 8 TEACHER WARDROBE 1 NEW SGI CLASSROOM 2 STORAGE 3 STORAGE 4 STORAGE 1 NEW SCIENCE CLASSI 2 TEACHER WARDROBE 3 STORAGE 4 STORAGE 5 STORAGE 6 STORAGE 7 NEW SCIENCE CLASSI 1 STORAGE 5 STORAGE 6 STORAGE 7 NEW SCIENCE CLASSI 1 SRD GRADE CLASSRO 2 TEACHER WARDROBE 3 STORAGE 4 STORAGE 5 STORAGE 6 STORAGE 7 NEW SCIENCE CLASSI 1 SRD GRADE CLASSRO 2 TEACHER WARDROBE 3 STORAGE 4 STORAGE 5 STORAGE 5 STORAGE 1 SRD GRADE CLASSRO 2 TEACHER WARDROBE 3 COAT ROOM 4 STORAGE 1 STORAGE 1 GOUNSELOR 1 FACULTY ROOM 2 TEACHER WARDROBE 1 CORRIDOR 'C' 1 COUNSELOR 1 FACULTY ROOM 2 TEACHER WARDROBE 1 CORRIDOR 'A' 1 CORRIDOR 'A' 1 CORRIDOR 'B' 1 STORAGE 1 STORAGE 2 STORAGE 3 COAT ROOM 4 STORAGE 4 THA GRADE CLASSRO 5 STORAGE A ELEC / IDF 6 STORAGE 1 STO			3RD GRADE CLASSROOM	203		2' - 6"	7' - 0"	WD	D		WD	WD-1	10	11	-		ETR REFER TO NOTE 9
TEACHER WARDROBE  STORAGE  STORAGE  NEW ART CLASSROOM  TEACHER WARDROBE  REACHER WARDROBE  TEACHER WARDROBE  COAT ROOM  TEACHER WARDROBE		203A	3RD GRADE CLASSROOM	203	VEC	2' - 8"	7' - 0" 7' - 0"	WD	В		WD	WD-1T	15	11	- D	20 MIN	ETR REFER TO NOTE 9
STORAGE  NEW ART CLASSROOM  STORAGE  NEW SGI CLASSROOM  STORAGE  STORAGE  STORAGE  NEW SGI CLASSROOM  STORAGE  NEW SCIENCE CLASSI  TEACHER WARDROBE  STORAGE  TEACHER WARDROBE  STORAGE  STORAGE  STORAGE  STORAGE  STORAGE  NEW SCIENCE CLASSI  NEW SCIENCE CLASSI  NEW SCIENCE CLASSI  STORAGE  TEACHER WARDROBE  STORAGE  STORAGE  TEACHER WARDROBE  COAT ROOM  STORAGE  TEACHER WARDROBE  COAT ROOM  MA  STORAGE  TEACHER WARDROBE  COAT ROOM  MA  COORRIDOR 'C'  COUNSELOR  FACULTY ROOM  COUNSELOR  TEACHER WARDROBE  COAT ROOM  COORRIDOR 'A'  CORRIDOR 'B'  TEACHER WARDROBE  TEACHER WARDRO		204	CORRIDOR 'B'  NEW ART CLASSROOM	223 204	YES	3' - 0" 1' - 8"	6' - 8"	WD WD	G E		WD WD	WD-1T WD-1	15 10	11 11	B 	20 MIN.	06 ETR REFER TO NOTE 9
.6 NEW ART CLASSROOM .7 STORAGE .8 TEACHER WARDROBE .1 NEW SGI CLASSROOM .2 STORAGE .3 STORAGE .4 STORAGE .4 STORAGE .3 STORAGE .4 STORAGE .5 TEACHER WARDROBE .5 STORAGE .6 STORAGE .7 NEW SCIENCE CLASSI .1 NEW SCIENCE CLASSI .1 NEW SCIENCE CLASSI .1 STORAGE .3 STORAGE .4 STORAGE .5 STORAGE .6 STORAGE .1 3RD GRADE CLASSRO .2 TEACHER WARDROBE .3 STORAGE .4 STORAGE .4 STORAGE .4 STORAGE .5 STORAGE .1 3RD GRADE CLASSRO .2 TEACHER WARDROBE .3 COAT ROOM .4 STORAGE .1 3RD GRADE CLASSRO .2 TEACHER WARDROBE .3 COAT ROOM .4 STORAGE .1 GOUNSELOR .1 FACULTY ROOM .2 TEACHER WARDROBE .3 COAT ROOM .4 STORAGE .1 CORRIDOR 'C' .1 COUNSELOR .1 FACULTY TOILET .4 MDF .1 CORRIDOR 'B' .2 NEW NURSE OFFICE .1 CORRIDOR 'B' .2 NEW NURSE OFFICE .1 CORRIDOR 'B' .1 STAIR C .2 STAIR C .1 STORAGE .1 STORA		204A	NEW ART CLASSROOM	204		2' - 6"	7' - 0"	WD	В		WD	WD-1T	15	11	-		ETR REFER TO NOTE 9
TEACHER WARDROBE  NEW SGI CLASSROOM  STORAGE  TEACHER WARDROBE  STORAGE  TEACHER WARDROBE		204	NEW ART CLASSROOM CORRIDOR 'B'	204 223	YES	2' - 6" 3' - 0"	7' - 0" 7' - 0"	WD WD	D G		WD WD	WD-1 WD-1T	10 15	11 11	- В	20 MIN.	ET07 REFER TO NOTE 9
NEW SGI CLASSROOM STORAGE STORAGE TEACHER WARDROBE		204B	NEW ART CLASSROOM	204	ILO	2' - 6"	7' - 0"	WD	В		WD	WD-1T	15	11	-	ZO IVIIIV.	ETR REFER TO NOTE 9
STORAGE  STORAGE  NEW SCIENCE CLASSI  TEACHER WARDROBE  STORAGE  STORAGE  STORAGE  STORAGE  STORAGE  STORAGE  STORAGE  NEW SCIENCE CLASSI  NEW SCIENCE CLASSI  STORAGE  TEACHER WARDROBE  COAT ROOM  COAT ROOM  COAT ROOM  MUSTORAGE  STORAGE  TEACHER WARDROBE  COAT ROOM  COONSELOR  COUNSELOR  STORAGE  TEACHER WARDROBE  CORRIDOR 'B'  CORRIDOR 'B'  STORAGE  STORAGE  TEACHER WARDROBE  STORAGE  TEACHER WARDROBE  COAT ROOM  STORAGE  TEACHER WARDROBE  TEACHER WARDROBE  COAT ROOM  TEACHER WARDROBE  TEACH			NEW ART CLASSROOM	204	1,500	1' - 8"	6' - 8"	WD	E		WD	WD-1	10	11	_		ETR REFER TO NOTE 9
STORAGE  STORAGE  NEW SCIENCE CLASSI  TEACHER WARDROBE  STORAGE  STORAGE  STORAGE  STORAGE  NEW SCIENCE CLASSI  NEW SCIENCE CLASSI  NEW SCIENCE CLASSI  STORAGE  TEACHER WARDROBE  COAT ROOM  STORAGE  TEACHER WARDROBE  COAT ROOM  COAT ROOM  MUSTORAGE  TEACHER WARDROBE  COAT ROOM  TEACHER WARDROBE  COAT ROOM  TEACHER WARDROBE  CORRIDOR 'A'  CORRIDOR 'A'  CORRIDOR 'B'  CORRIDOR 'B'  TEACHER WARDROBE		205 205A	CORRIDOR 'B' NEW SGI CLASSROOM	223 205	YES	3' - 0" 2' - 6"	7' - 0" 7' - 0"	WD WD	G B		WD WD	WD-1T WD-1T	15 15	11	B		06 ET07 REFER TO NOTE 9
1 NEW SCIENCE CLASSI 2 TEACHER WARDROBE 3 STORAGE 4 STORAGE 5 STORAGE 6 STORAGE 7 NEW SCIENCE CLASSI 1 NEW SCIENCE CLASSI 1 3RD GRADE CLASSRO 2 TEACHER WARDROBE 3 STORAGE 4 STORAGE 4 STORAGE 5 STORAGE 6 STORAGE 7 NEW SCIENCE CLASSI 1 3RD GRADE CLASSRO 2 TEACHER WARDROBE 3 STORAGE 1 3RD GRADE CLASSRO 2 TEACHER WARDROBE 3 COAT ROOM 4 STORAGE 1 3RD GRADE CLASSRO 2 TEACHER WARDROBE 3 COAT ROOM 4 STORAGE 1 GOUNSELOR 1 COUNSELOR 1 FACULTY ROOM 2 NEW FACULTY TOILET 4 MDF 1 CORRIDOR 'A' 1 CORRIDOR 'A' 1 CORRIDOR 'B' 1 CORRIDOR 'B' 1 CORRIDOR 'B' 1 NEW J.C. 1 VEST. 1 CORRIDOR 'B' 1 NEW J.C. 1 VEST. 1 CORRIDOR 'B' 1 STAIR C 2 STAIR C 1 STORAGE 1 ST	Ξ		NEW SGI CLASSROOM	205		2' - 6"	7' - 0"	WD	D		WD	WD-11	10	11			ETR REFER TO NOTE 9
TEACHER WARDROBE  TEACHER WARDROBE  TORAGE  TEACHER WARDROBE  TORRIDOR 'A'  CORRIDOR 'B'  CORRIDOR 'B'  CORRIDOR 'B'  TORAGE  TORAGE  TORAGE  TORAGE  TORAGE  TORAGE  TORAGE  TORAGE  TEACHER WARDROBE  TORAGE  TEACHER WARDROBE		000	NEW SGI CLASSROOM	205	\/==	2' - 6"	7' - 0"	WD	В	_	WD	WD-1T	15	11		00.84%	ETR REFER TO NOTE 9
3 STORAGE 4 STORAGE 5 STORAGE 6 STORAGE 6 STORAGE 7 NEW SCIENCE CLASSI 1 NEW SCIENCE CLASSI 1 3RD GRADE CLASSRO 2 TEACHER WARDROBE 3 STORAGE 4 STORAGE 4 STORAGE 1 3RD GRADE CLASSRO 2 TEACHER WARDROBE 3 COAT ROOM 4 STORAGE 5 STORAGE 6 STORAGE 1 3RD GRADE CLASSRO 2 TEACHER WARDROBE 3 COAT ROOM 4 STORAGE 1 3RD GRADE CLASSRO 2 TEACHER WARDROBE 3 COAT ROOM 4 COAT ROOM 5 NEW FACULTY TOILET 6 MDF 1 CORRIDOR 'A' 1 CORRIDOR 'A' 1 CORRIDOR 'B' 1 STAIR C 2 STAIR C 1 STORAGE A ELEC / IDF  el 3 1 4TH GRADE CLASSRO 2 TEACHER WARDROBE 3 COAT ROOM 4 STORAGE 1 STORAGE		206	CORRIDOR 'B' NEW SCIENCE CLASSROOM	223 206	YES	3' - 0" 1' - 8"	7' - 0" 6' - 8"	WD WD	G E ^		WD WD	WD-1T WD-1	15 10	11 11	B	20 MIN.	06 ETR REFER TO NOTE 9
.5 STORAGE .6 STORAGE .7 NEW SCIENCE CLASSI .1 NEW SCIENCE CLASSI .1 3RD GRADE CLASSRO .2 TEACHER WARDROBE .3 STORAGE .4 STORAGE .4 STORAGE .4 STORAGE .1 3RD GRADE CLASSRO .2 TEACHER WARDROBE .3 COAT ROOM .4 STORAGE .5 STORAGE .1 3RD GRADE CLASSRO .2 TEACHER WARDROBE .3 COAT ROOM .4 STORAGE .1 GORRIDOR 'C' .1 COUNSELOR .1 FACULTY ROOM .2 STORAGE .1 STORAGE .1 CORRIDOR 'A' .2 NEW NURSE OFFICE .1 CORRIDOR 'B' .1 CORRIDOR 'B' .1 CORRIDOR 'B' .1 CORRIDOR 'B' .1 NEW J.C1 VEST1 CORRIDOR 'B' .1 STAIR C .2 STAIR C .1 STORAGE .2 STORAGE .3 TEACHER WARDROBE .4 A ELEC / IDF .6 STORAGE .5 STORAGE .1 STORAGE .1 STORAGE .2 TEACHER WARDROBE .3 COAT ROOM .4 STORAGE .1 4TH GRADE CLASSRO .2 TEACHER WARDROBE .3 COAT ROOM .4 STORAGE .1 4TH GRADE CLASSRO .2 TEACHER WARDROBE .3 COAT ROOM .4 STORAGE .1 4TH GRADE CLASSRO .2 TEACHER WARDROBE .3 COAT ROOM .4 STORAGE .1 4TH GRADE CLASSRO .2 TEACHER WARDROBE .3 COAT ROOM .4 STORAGE .1 4TH GRADE CLASSRO .2 TEACHER WARDROBE .3 COAT ROOM .4 STORAGE .1 4TH GRADE CLASSRO .2 TEACHER WARDROBE .3 COAT ROOM .4 STORAGE .1 4TH GRADE CLASSRO .2 TEACHER WARDROBE .3 COAT ROOM .4 STORAGE .1 4TH GRADE CLASSRO .2 TEACHER WARDROBE .3 COAT ROOM .4 STORAGE .1 4TH GRADE CLASSRO .2 TEACHER WARDROBE .3 COAT ROOM .4 STORAGE .1 4TH GRADE CLASSRO .2 TEACHER WARDROBE .3 COAT ROOM .4 STORAGE .1 4TH GRADE CLASSRO .2 TEACHER WARDROBE .3 COAT ROOM .4 STORAGE .1 4TH GRADE CLASSRO .2 TEACHER WARDROBE .3 COAT ROOM .4 STORAGE .1 4TH GRADE CLASSRO .2 TEACHER WARDROBE .3 COAT ROOM .4 STORAGE .1 4TH GRADE CLASSRO .2 TEACHER WARDROBE .3 COAT ROOM .4 STORAGE .1 4TH GRADE CLASSRO .2 TEACHER WARDROBE .3 COAT ROOM .4 STORAGE .1 4TH GRADE CLASSRO .3 COAT ROOM .4 STORAGE .1 4TH GRADE CLASSRO	Ξ		NEW SCIENCE CLASSROOM	206 /	4	2' - 6"	7' - 0"	WD	B 4		WD	WD-1T	15	11			ETR REFER TO NOTE 9
.7 NEW SCIENCE CLASSI .1 NEW SCIENCE CLASSI .1 3RD GRADE CLASSRO .2 TEACHER WARDROBE .3 STORAGE .4 STORAGE .4 STORAGE .1 3RD GRADE CLASSRO .2 TEACHER WARDROBE .3 COAT ROOM .4 STORAGE .1 3RD GRADE CLASSRO .2 TEACHER WARDROBE .3 COAT ROOM .4 STORAGE .1 3RD GRADE CLASSRO .2 TEACHER WARDROBE .3 COAT ROOM .4 COAT ROOM .4 CORRIDOR 'C' .1 COUNSELOR .1 FACULTY ROOM .2 NEW FACULTY TOILET .4 MDF .1 CORRIDOR 'A' .2 NEW NURSE OFFICE .1 CORRIDOR 'B' .1 CORRIDOR 'B' .1 CORRIDOR 'B' .1 NEW J.C1 VEST1 CORRIDOR 'B' .1 STAIR C .2 STAIR C .1 STORAGE .2 STORAGE .4 STORAGE .A ELEC / IDF  el 3 .1 4TH GRADE CLASSRO .2 TEACHER WARDROBE .3 COAT ROOM .4 STORAGE .1 4TH GRADE CLASSRO .2 TEACHER WARDROBE .3 COAT ROOM .4 STORAGE .1 4TH GRADE CLASSRO .2 TEACHER WARDROBE .3 COAT ROOM .4 COAT ROOM .5 STORAGE .1 4TH GRADE CLASSRO .2 TEACHER WARDROBE .3 COAT ROOM .4 COAT ROOM .5 STORAGE .1 4TH GRADE CLASSRO .2 TEACHER WARDROBE .3 COAT ROOM .4 COAT ROOM .5 STORAGE .1 4TH GRADE CLASSRO .2 TEACHER WARDROBE .3 COAT ROOM .4 COAT ROOM .5 STORAGE .1 4TH GRADE CLASSRO .2 TEACHER WARDROBE .3 COAT ROOM .4 COAT ROOM .5 STORAGE .1 4TH GRADE CLASSRO .2 TEACHER WARDROBE .3 COAT ROOM .4 STORAGE .1 4TH GRADE CLASSRO .2 TEACHER WARDROBE .3 COAT ROOM .4 STORAGE .1 4TH GRADE CLASSRO .2 TEACHER WARDROBE .3 COAT ROOM .4 STORAGE .1 4TH GRADE CLASSRO .2 TEACHER WARDROBE .3 COAT ROOM .4 STORAGE .1 4TH GRADE CLASSRO .2 TEACHER WARDROBE .3 COAT ROOM .4 STORAGE .1 4TH GRADE CLASSRO .2 TEACHER WARDROBE .3 COAT ROOM .4 STORAGE .1 4TH GRADE CLASSRO .2 TEACHER WARDROBE .3 COAT ROOM .4 STORAGE .1 4TH GRADE CLASSRO		000	NEW SCIENCE CLASSROOM	206		2' - 6"	7' - 0"	WD	D (		WD	WD-1	10	11	-		ETR REFER TO NOTE 9
.1 NEW SCIENCE CLASSI .1 3RD GRADE CLASSRO .2 TEACHER WARDROBE .3 STORAGE .4 STORAGE .1 3RD GRADE CLASSRO .2 TEACHER WARDROBE .3 COAT ROOM .4 STORAGE .1 3RD GRADE CLASSRO .2 TEACHER WARDROBE .5 STORAGE .1 3RD GRADE CLASSRO .2 TEACHER WARDROBE .3 COAT ROOM .4 STORAGE .1 GOAT ROOM .4 CORRIDOR 'C' .1 COUNSELOR .1 FACULTY ROOM .2 STORAGE .1 CORRIDOR 'A' .2 NEW NURSE OFFICE .1 CORRIDOR 'B' .1 CORRIDOR 'B' .1 CORRIDOR 'B' .1 CORRIDOR 'B' .1 STAIR C .2 STAIR C .1 STORAGE .3 STORAGE .4 STORAGE .4 STORAGE .5 STORAGE .6 STORAGE .7 STORAGE .8 STORAGE .9 STORAGE .1 STORAGE .1 STORAGE .2 STORAGE .3 COAT ROOM .4 STORAGE .1 4TH GRADE CLASSRO .5 STORAGE .1 4TH GRADE CLASSRO .6 TEACHER WARDROBE .7 STORAGE .1 STO		206A 206A	NEW SCIENCE CLASSROOM NEW SCIENCE CLASSROOM	206 206	+-	2' - 6" 2' - 6"	7' - 0" 7' - 0"	WD WD	B B		WD WD	WD-1T WD-1	15 10	11 11	-		ETR REFER TO NOTE 9  07.3 REFER TO NOTE 10
1 3RD GRADE CLASSRO 12 TEACHER WARDROBE 13 STORAGE 14 STORAGE 15 3RD GRADE CLASSRO 16 TEACHER WARDROBE 17 3RD GRADE CLASSRO 18 STORAGE 19 3RD GRADE CLASSRO 19 TEACHER WARDROBE 10 3RD GRADE CLASSRO 10 3RD GRADE CLASSRO 11 3RD GRADE CLASSRO 12 TEACHER WARDROBE 13 COAT ROOM 14 CORRIDOR 'C' 14 COUNSELOR 15 FACULTY ROOM 16 CORRIDOR 'A' 17 CORRIDOR 'A' 18 CORRIDOR 'B' 19 CORRIDOR 'B' 11 CORRIDOR 'B' 11 NEW J.C. 11 VEST. 11 CORRIDOR 'B' 12 CORRIDOR 'B' 13 STAIR C 14 STORAGE 15 STORAGE 16 STORAGE 17 STORAGE 18 TEACHER WARDROBE 19 TEACHER WARDROBE 10 ATH GRADE CLASSRO 11 STORAGE 11 STORAGE 12 TEACHER WARDROBE 13 COAT ROOM 14 STORAGE 15 TEACHER WARDROBE 16 TEACHER WARDROBE 17 TEACHER WARDROBE 18 TEACHER WARDROBE 19 TEACHER WARDROBE 19 TEACHER WARDROBE 10 TEACHER WARDROBE 11 TEACHER WARDROBE 12 TEACHER WARDROBE 13 COAT ROOM 15 STORAGE 11 TEACHER WARDROBE 15 TEACHER WARDROBE 16 TEACHER WARDROBE 17 TEACHER WARDROBE 18 TEACHER WARDROBE 19 TEACHER WARDROBE 20 TEACHER WARDROBE 21 TEACHER WARDROBE 22 TEACHER WARDROBE 23 COAT ROOM 24 COAT ROOM 25 STORAGE 26 TEACHER WARDROBE 27 TEACHER WARDROBE 28 TEACHER WARDROBE 29 TEACHER WARDROBE 20 TEACHER WARDROBE 21 TEACHER WARDROBE 22 TEACHER WARDROBE 23 COAT ROOM 24 STORAGE 25 TEACHER WARDROBE 26 TEACHER WARDROBE 27 TEACHER WARDROBE 28 TEACHER WARDROBE 29 TEACHER WARDROBE 20 TEACHER WARDROBE 21 TEACHER WARDROBE 21 TEACHER WARDROBE 22 TEACHER WARDROBE 23 COAT ROOM 24 STORAGE 25 TEACHER WARDROBE 26 TEACHER WARDROBE 27 TEACHER WARDROBE 28 TEACHER WARDROBE 29 TEACHER WARDROBE 20 TEACHER WARDROBE 21 TEACHER WARDROBE 21 TEACHER WARDROBE 21 TEACHER WARDROBE		206A 206	CORRIDOR 'B'	223	YES	3' - 0"	7'-0"	WD	G		WD	WD-1T	15	11	B	20 MIN.	06 REFER TO NOTE 10
TEACHER WARDROBE  TEACHER WARDROBE  TEACHER WARDROBE  TEACHER WARDROBE  COAT ROOM  STORAGE  TEACHER WARDROBE  TEACHER WARDROBE  TEACHER WARDROBE  TEACHER WARDROBE  TEACHER WARDROBE  COAT ROOM  CORRIDOR 'C'  COUNSELOR  FACULTY ROOM  MUF  CORRIDOR 'A'  CORRIDOR 'A'  CORRIDOR 'B'  CORRIDOR 'B'  CORRIDOR 'B'  CORRIDOR 'B'  TOURSEL  TEACHER WARDROBE  TOURSEL  TOURSE  TOURSEL  TOURSEL  TOURSEL  TOURSEL  TOURSEL  TOURSEL  TOURSE		206	SCIENCE STORAGE	220	YES	3' - 0"	7' - 0"	WD	Н	YES	HM	HM-1	12	13	-	00.84%	07.3
3 STORAGE 4 STORAGE 1 3RD GRADE CLASSRO 2 TEACHER WARDROBE 3 COAT ROOM 4 STORAGE 5 STORAGE 1 3RD GRADE CLASSRO 2 TEACHER WARDROBE 3 COAT ROOM 4 CORRIDOR 'C' 1 COUNSELOR 1 FACULTY ROOM 2 STORAGE 1 CORRIDOR 'A' 2 NEW FACULTY TOILET 4 MDF 1 CORRIDOR 'A' 2 NEW NURSE OFFICE 1 CORRIDOR 'B' 2 CORRIDOR 'B' 1 NEW J.C. 1 VEST. 1 CORRIDOR 'B' 1 STAIR C 2 STAIR C 1 STORAGE 2 STORAGE A ELEC / IDF  el 3 1 4TH GRADE CLASSRO 2 TEACHER WARDROBE 3 COAT ROOM 4 STORAGE 1 4TH GRADE CLASSRO 2 TEACHER WARDROBE 3 COAT ROOM 5 STORAGE 1 4TH GRADE CLASSRO 1 TEACHER WARDROBE 1 COAT ROOM 5 STORAGE 1 4TH GRADE CLASSRO 1 TEACHER WARDROBE 1 COAT ROOM 5 STORAGE 1 4TH GRADE CLASSRO 1 TEACHER WARDROBE 1 COAT ROOM 5 STORAGE 1 4TH GRADE CLASSRO 1 TEACHER WARDROBE 1 COAT ROOM 5 STORAGE 1 4TH GRADE CLASSRO 1 TEACHER WARDROBE 1 COAT ROOM 5 STORAGE 1 4TH GRADE CLASSRO		208	CORRIDOR 'B'  3RD GRADE CLASSROOM	223 208	YES	3' - 0" 1' - 8"	7' - 0" 6' - 8"	WD WD	G E		WD WD	WD-1T WD-1	15 10	11 11	ĿTR -	20 MIN.	06 ETR REFER TO NOTE 9
1 3RD GRADE CLASSRO 2 TEACHER WARDROBE 3 COAT ROOM 4 STORAGE 5 STORAGE 5 STORAGE 1 3RD GRADE CLASSRO 2 TEACHER WARDROBE 3 COAT ROOM 4 1 CORRIDOR 'C' 1 COUNSELOR 1 FACULTY ROOM 2 3 NEW FACULTY TOILET 4 MDF 1 CORRIDOR 'A' 2 NEW NURSE OFFICE 1 CORRIDOR 'B' 1 CORRIDOR 'B' 1 CORRIDOR 'B' 1 STAIR C 2 STAIR C 1 STORAGE 2 STORAGE A ELEC / IDF el 3 1 4TH GRADE CLASSRO 2 TEACHER WARDROBE 3 COAT ROOM 4 STORAGE 1 4TH GRADE CLASSRO 2 TEACHER WARDROBE 3 COAT ROOM 5 STORAGE 1 4TH GRADE CLASSRO 2 TEACHER WARDROBE 1 COAT ROOM 5 STORAGE 1 4TH GRADE CLASSRO 1 TEACHER WARDROBE 1 COAT ROOM 5 STORAGE 1 4TH GRADE CLASSRO 1 TEACHER WARDROBE 1 COAT ROOM 5 STORAGE 1 4TH GRADE CLASSRO 1 TEACHER WARDROBE 1 COAT ROOM 5 STORAGE 1 4TH GRADE CLASSRO 1 TEACHER WARDROBE 1 COAT ROOM 5 STORAGE 1 4TH GRADE CLASSRO	Ξ	208A	3RD GRADE CLASSROOM	208		2' - 8"	7' - 0"	WD	В		WD	WD-1	10	11	-		ETR REFER TO NOTE 9
TEACHER WARDROBE  COAT ROOM  STORAGE  STORAGE  TEACHER WARDROBE  TEACHER WARDROBE  COAT ROOM  COAT ROOM  COUNSELOR  RECORDOR 'C'  COUNSELOR  RECORDOR 'A'  CORRIDOR 'A'  CORRIDOR 'A'  CORRIDOR 'B'  CORRIDOR 'B'  CORRIDOR 'B'  CORRIDOR 'B'  CORRIDOR 'B'  STAIR C  STAIR C  STAIR C  STORAGE  A ELEC / IDF  COAT ROOM  ATH GRADE CLASSRO  TEACHER WARDROBE  COAT ROOM  ATH GRADE CLASSRO  TEACHER WARDROBE  COAT ROOM  COAT ROOM  COAT ROOM  COAT ROOM  COAT ROOM  STORAGE  TEACHER WARDROBE  COAT ROOM  COA		200	3RD GRADE CLASSROOM	208	VEC	2' - 6"	7' - 0"	WD	D		WD	WD-1	10	11	-	20 MIN	ETR REFER TO NOTE 9
.3 COAT ROOM .4 STORAGE .5 STORAGE .1 3RD GRADE CLASSRO .2 TEACHER WARDROBE .3 COAT ROOM .4 .1 CORRIDOR 'C' .1 COUNSELOR .1 FACULTY ROOM .2 .3 NEW FACULTY TOILET .4 MDF .1 CORRIDOR 'A' .2 NEW NURSE OFFICE .1 CORRIDOR 'B' .1 CORRIDOR 'B' .1 NEW J.C1 NEW J.C1 VEST1 CORRIDOR 'B' .1 STAIR C .2 STAIR C .2 STAIR C .1 STORAGE .2 STORAGE .4 ELEC / IDF .3 COAT ROOM .4 STORAGE .1 4TH GRADE CLASSRO .2 TEACHER WARDROBE .3 COAT ROOM .4 COAT ROOM .5 STORAGE .1 4TH GRADE CLASSRO .2 TEACHER WARDROBE .3 COAT ROOM .4 COAT ROOM .5 STORAGE .1 4TH GRADE CLASSRO .2 TEACHER WARDROBE .3 COAT ROOM .4 COAT ROOM .5 STORAGE .1 4TH GRADE CLASSRO .2 TEACHER WARDROBE .3 COAT ROOM .4 COAT ROOM .5 STORAGE .1 4TH GRADE CLASSRO .2 TEACHER WARDROBE .3 COAT ROOM .4 COAT ROOM .5 STORAGE .1 4TH GRADE CLASSRO .2 TEACHER WARDROBE .3 COAT ROOM .4 STORAGE .1 4TH GRADE CLASSRO .2 TEACHER WARDROBE .3 COAT ROOM .4 STORAGE .1 4TH GRADE CLASSRO .2 TEACHER WARDROBE .3 COAT ROOM .4 STORAGE .1 4TH GRADE CLASSRO		209	CORRIDOR 'B' 3RD GRADE CLASSROOM	223 209	YES	3' - 0" 1' - 8"	7' - 0" 6' - 8"	WD WD	G E		WD WD	WD-1T WD-1	15 10	11	ETR -	20 MIN.	06 ETR REFER TO NOTE 9
.5 STORAGE .1 3RD GRADE CLASSRO .2 TEACHER WARDROBE .3 COAT ROOM .4 .1 CORRIDOR 'C' .1 COUNSELOR .1 FACULTY ROOM .2 .3 NEW FACULTY TOILET .4 MDF .1 CORRIDOR 'A' .2 NEW NURSE OFFICE .1 CORRIDOR 'B' .2 CORRIDOR 'B' .1 CORRIDOR 'B' .1 NEW J.C1 VEST1 CORRIDOR 'B' .1 STAIR C .2 STAIR C .2 STAIR C .1 STORAGE .2 STORAGE .4 ELEC / IDF .5 STORAGE .4 ELEC / IDF .6 STORAGE .1 4TH GRADE CLASSRO .2 TEACHER WARDROBE .3 COAT ROOM .4 STORAGE .1 4TH GRADE CLASSRO .2 TEACHER WARDROBE .3 COAT ROOM .4 COAT ROOM .5 STORAGE .1 4TH GRADE CLASSRO .2 TEACHER WARDROBE .3 COAT ROOM .4 COAT ROOM .5 STORAGE .1 4TH GRADE CLASSRO .2 TEACHER WARDROBE .3 COAT ROOM .4 COAT ROOM .5 STORAGE .1 4TH GRADE CLASSRO .2 TEACHER WARDROBE .3 COAT ROOM .4 COAT ROOM .5 STORAGE .1 4TH GRADE CLASSRO .2 TEACHER WARDROBE .3 COAT ROOM .4 STORAGE .1 4TH GRADE CLASSRO .2 TEACHER WARDROBE .3 COAT ROOM .4 STORAGE .1 4TH GRADE CLASSRO .2 TEACHER WARDROBE .3 COAT ROOM .4 STORAGE .1 4TH GRADE CLASSRO		209A	3RD GRADE CLASSROOM	209		2' - 6"	7' - 0"	WD	В		WD	WD-1T	15	11	-		ETR REFER TO NOTE 9
.1 3RD GRADE CLASSRO .2 TEACHER WARDROBE .3 COAT ROOM .4 .1 CORRIDOR 'C' .1 COUNSELOR .1 FACULTY ROOM .2 .3 NEW FACULTY TOILET .4 MDF .1 CORRIDOR 'A' .2 NEW NURSE OFFICE .1 CORRIDOR 'B' .2 CORRIDOR 'B' .1 NEW J.C1 VEST1 CORRIDOR 'B' .1 STAIR C .2 STAIR C .2 STAIR C .1 STORAGE .2 STORAGE .4 ELEC / IDF .1 ATH GRADE CLASSRO .2 TEACHER WARDROBE .3 COAT ROOM .4 STORAGE .1 4TH GRADE CLASSRO .2 TEACHER WARDROBE .3 COAT ROOM .4 COAT ROOM .5 STORAGE .1 4TH GRADE CLASSRO .2 TEACHER WARDROBE .3 COAT ROOM .4 COAT ROOM .5 STORAGE .1 4TH GRADE CLASSRO .2 TEACHER WARDROBE .3 COAT ROOM .4 COAT ROOM .5 STORAGE .1 4TH GRADE CLASSRO .2 TEACHER WARDROBE .3 COAT ROOM .4 COAT ROOM .5 STORAGE .1 4TH GRADE CLASSRO .2 TEACHER WARDROBE .3 COAT ROOM .4 STORAGE .1 4TH GRADE CLASSRO .2 TEACHER WARDROBE .3 COAT ROOM .4 STORAGE .1 4TH GRADE CLASSRO .2 TEACHER WARDROBE .3 COAT ROOM .4 STORAGE .1 4TH GRADE CLASSRO .2 TEACHER WARDROBE .3 COAT ROOM .4 STORAGE .1 4TH GRADE CLASSRO			3RD GRADE CLASSROOM	209		2' - 6"	7' - 0"	WD	В		WD	WD-1T	15	11	-		ETR REFER TO NOTE 9
2 TEACHER WARDROBE 3 COAT ROOM 4 1 CORRIDOR 'C' 1 COUNSELOR 1 FACULTY ROOM 2 3 NEW FACULTY TOILET 4 MDF 1 CORRIDOR 'A' 2 NEW NURSE OFFICE 1 CORRIDOR 'B' 2 CORRIDOR 'B' 1 NEW J.C. 1 NEW J.C. 1 VEST. 1 CORRIDOR 'B' 2 STAIR C 2 STAIR C 2 STAIR C 3 STORAGE A ELEC / IDF el 3 1 4TH GRADE CLASSRO 2 TEACHER WARDROBE 3 COAT ROOM 4 STORAGE 1 4TH GRADE CLASSRO 2 TEACHER WARDROBE 3 COAT ROOM 4 COAT ROOM 5 STORAGE 1 4TH GRADE CLASSRO 2 TEACHER WARDROBE 3 COAT ROOM 5 STORAGE 1 4TH GRADE CLASSRO 2 TEACHER WARDROBE 3 COAT ROOM 5 STORAGE 1 4TH GRADE CLASSRO 2 TEACHER WARDROBE 3 COAT ROOM 5 STORAGE 1 4TH GRADE CLASSRO 1 TEACHER WARDROBE 3 COAT ROOM 5 STORAGE 1 4TH GRADE CLASSRO 1 4TH GRADE CLASSRO 1 TEACHER WARDROBE 3 COAT ROOM 5 STORAGE 1 4TH GRADE CLASSRO		210	3RD GRADE CLASSROOM CORRIDOR 'C'	209 224	YES	2' - 6" 3' - 0"	7' - 0" 7' - 0"	WD WD	D G		WD WD	WD-1 WD-1T	10 15	11	- ETR	20 MIN.	ETR REFER TO NOTE 9
.4		210	3RD GRADE CLASSROOM	210	120	1' - 8"	6' - 8"	WD	E		WD	WD-1	10	11	-	20 1/11111	ETR REFER TO NOTE 9
.1 CORRIDOR 'C' .1 COUNSELOR .1 FACULTY ROOM .2 .3 NEW FACULTY TOILET .4 MDF .1 CORRIDOR 'A' .2 NEW NURSE OFFICE .1 CORRIDOR 'B' .1 CORRIDOR 'B' .2 CORRIDOR 'B' .1 NEW J.C1 VEST1 CORRIDOR 'B' .1 STAIR C .2 STAIR C .2 STAIR C .1 STORAGE .2 STORAGE .4 ELEC / IDF  el 3 .1 4TH GRADE CLASSRO .2 TEACHER WARDROBE .3 COAT ROOM .4 STORAGE .1 4TH GRADE CLASSRO .2 TEACHER WARDROBE .3 COAT ROOM .4 STORAGE .1 4TH GRADE CLASSRO .5 STORAGE .1 4TH GRADE CLASSRO .6 STORAGE .1 4TH GRADE CLASSRO .7 TEACHER WARDROBE .8 COAT ROOM .9 STORAGE .1 4TH GRADE CLASSRO .1 TEACHER WARDROBE .3 COAT ROOM .4 COAT ROOM .5 STORAGE .1 4TH GRADE CLASSRO .2 TEACHER WARDROBE .3 COAT ROOM .4 STORAGE .1 4TH GRADE CLASSRO .2 TEACHER WARDROBE .3 COAT ROOM .4 STORAGE .1 4TH GRADE CLASSRO	OM	210A	3RD GRADE CLASSROOM	210		2' - 8"	7' - 0"	WD	В		WD	WD-1	10	11	-		ETR REFER TO NOTE 9
.1 COUNSELOR .1 FACULTY ROOM .2 .3 NEW FACULTY TOILET .4 MDF .1 CORRIDOR 'A' .2 NEW NURSE OFFICE .1 CORRIDOR 'B' .1 CORRIDOR 'B' .2 CORRIDOR 'B' .1 NEW J.C1 VEST1 CORRIDOR 'B' .1 STAIR C .2 STAIR C .2 STAIR C .1 STORAGE .2 STORAGE .4 ELEC / IDF  el 3 .1 4TH GRADE CLASSRO .2 TEACHER WARDROBE .3 COAT ROOM .4 STORAGE .1 4TH GRADE CLASSRO .2 TEACHER WARDROBE .3 COAT ROOM .4 STORAGE .1 4TH GRADE CLASSRO .2 TEACHER WARDROBE .3 COAT ROOM .4 COAT ROOM .5 STORAGE .1 4TH GRADE CLASSRO .2 TEACHER WARDROBE .3 COAT ROOM .4 COAT ROOM .5 STORAGE .1 4TH GRADE CLASSRO .2 TEACHER WARDROBE .3 COAT ROOM .4 COAT ROOM .5 STORAGE .1 4TH GRADE CLASSRO .2 TEACHER WARDROBE .3 COAT ROOM .4 STORAGE .1 4TH GRADE CLASSRO .2 TEACHER WARDROBE .3 COAT ROOM .4 STORAGE .1 4TH GRADE CLASSRO	DR 'C'	224	3RD GRADE CLASSROOM NEW GIRLS RESTROOM	210 211	YES	2' - 6" 3' - 0"	7' - 0" 7' - 0"	WD WD	D H	YES	WD HM	WD-1 HM-1	10 12	11 13 & 14	- G	20 MIN.	ETR REFER TO NOTE 9  06.2 REFER TO NOTE 10
.3 NEW FACULTY TOILET .4 MDF .1 CORRIDOR 'A' .2 NEW NURSE OFFICE .1 CORRIDOR 'B' .1 CORRIDOR 'B' .2 CORRIDOR 'B' .1 NEW J.C1 VEST1 CORRIDOR 'B' .1 STAIR C .2 STAIR C .2 STAIR C .1 STORAGE .2 STORAGE .4 ELEC / IDF  el 3 .1 4TH GRADE CLASSRO .2 TEACHER WARDROBE .3 COAT ROOM .4 STORAGE .1 4TH GRADE CLASSRO .2 TEACHER WARDROBE .3 COAT ROOM .4 STORAGE .1 4TH GRADE CLASSRO .2 TEACHER WARDROBE .3 COAT ROOM .4 STORAGE .1 4TH GRADE CLASSRO .2 TEACHER WARDROBE .3 COAT ROOM .4 COAT ROOM .5 STORAGE .1 4TH GRADE CLASSRO .2 TEACHER WARDROBE .3 COAT ROOM .4 STORAGE .1 4TH GRADE CLASSRO .2 TEACHER WARDROBE .3 COAT ROOM .4 STORAGE .1 4TH GRADE CLASSRO		212	CORRIDOR 'B'	223	YES	2' - 8"	7' - 0"	WD	G	1.20	WD	WD-1T	15	11	В	20 MIN.	05.2
.3 NEW FACULTY TOILET .4 MDF .1 CORRIDOR 'A' .2 NEW NURSE OFFICE .1 CORRIDOR 'B' .1 CORRIDOR 'B' .2 CORRIDOR 'B' .1 NEW J.C1 VEST1 CORRIDOR 'B' .1 STAIR C .2 STAIR C .2 STAIR C .1 STORAGE .2 STORAGE .4 ELEC / IDF  el 3 .1 4TH GRADE CLASSRO .2 TEACHER WARDROBE .3 COAT ROOM .4 STORAGE .1 4TH GRADE CLASSRO .2 TEACHER WARDROBE .3 COAT ROOM .4 STORAGE .1 4TH GRADE CLASSRO .5 STORAGE .1 4TH GRADE CLASSRO .6 TEACHER WARDROBE .7 COAT ROOM .8 STORAGE .1 4TH GRADE CLASSRO .1 4TH GRADE CLASSRO .2 TEACHER WARDROBE .3 COAT ROOM .4 COAT ROOM .5 STORAGE .1 4TH GRADE CLASSRO .2 TEACHER WARDROBE .3 COAT ROOM .4 STORAGE .1 4TH GRADE CLASSRO .2 TEACHER WARDROBE .3 COAT ROOM .4 STORAGE .1 4TH GRADE CLASSRO	ROOM	213	CORRIDOR 'A'	222	YES	3' - 0"	7' - 0"	WD	G		WD	WD-1T	15	11	В	20 MIN.	06.1
.4 MDF .1 CORRIDOR 'A' .2 NEW NURSE OFFICE .1 CORRIDOR 'A' .1 CORRIDOR 'B' .2 CORRIDOR 'B' .1 NEW J.C1 VEST1 CORRIDOR 'B' .1 STAIR C .2 STAIR C .2 STAIR C .1 STORAGE .2 STORAGE .4 ELEC / IDF  el 3 .1 4TH GRADE CLASSRO .2 TEACHER WARDROBE .3 COAT ROOM .4 STORAGE .1 4TH GRADE CLASSRO .2 TEACHER WARDROBE .3 COAT ROOM .4 STORAGE .1 4TH GRADE CLASSRO .2 TEACHER WARDROBE .3 COAT ROOM .4 STORAGE .1 4TH GRADE CLASSRO .2 TEACHER WARDROBE .3 COAT ROOM .4 COAT ROOM .5 STORAGE .1 4TH GRADE CLASSRO .2 TEACHER WARDROBE .3 COAT ROOM .4 STORAGE .1 4TH GRADE CLASSRO .2 TEACHER WARDROBE .3 COAT ROOM .4 STORAGE .1 4TH GRADE CLASSRO .2 TEACHER WARDROBE .3 COAT ROOM .4 STORAGE	CULTY TOILET	213B			YES	2' - 6" 3' - 0"	7' - 0" 7' - 0"	WD WD	H	YES	WD HM	WD-1 HM-1	10 23	11 14	- F		04.1
.2 NEW NURSE OFFICE .1 CORRIDOR 'A' .1 CORRIDOR 'B' .2 CORRIDOR 'B' .1 NEW J.C1 VEST1 CORRIDOR 'B' .1 STAIR C .2 STAIR C .2 STAIR C .1 STORAGE .2 STORAGE .4 ELEC / IDF  el 3 .1 4TH GRADE CLASSRO .2 TEACHER WARDROBE .3 COAT ROOM .4 STORAGE .1 4TH GRADE CLASSRO .2 TEACHER WARDROBE .3 COAT ROOM .4 STORAGE .1 4TH GRADE CLASSRO .2 TEACHER WARDROBE .3 COAT ROOM .4 COAT ROOM .5 STORAGE .1 4TH GRADE CLASSRO .2 TEACHER WARDROBE .3 COAT ROOM .4 COAT ROOM .5 STORAGE .1 4TH GRADE CLASSRO .2 TEACHER WARDROBE .3 COAT ROOM .4 STORAGE .1 4TH GRADE CLASSRO .2 TEACHER WARDROBE .3 COAT ROOM .4 STORAGE .1 4TH GRADE CLASSRO		213A	FACULTY ROOM	213		6' - 0"	7' - 0"	WD	Н		WD	WD-2	10	11	-		ETRPR PREP FOR CARD READER
.1 CORRIDOR 'A' .1 CORRIDOR 'B' .2 CORRIDOR 'B' .1 NEW J.C1 VEST1 CORRIDOR 'B' .1 STAIR C .2 STAIR C .1 STORAGE .2 STORAGE .2 STORAGE .3 COAT ROOM .4 STORAGE .1 4TH GRADE CLASSRO .2 TEACHER WARDROBE .3 COAT ROOM .4 STORAGE .1 4TH GRADE CLASSRO .2 TEACHER WARDROBE .3 COAT ROOM .4 STORAGE .1 4TH GRADE CLASSRO .2 TEACHER WARDROBE .3 COAT ROOM .4 COAT ROOM .5 STORAGE .1 4TH GRADE CLASSRO .2 TEACHER WARDROBE .3 COAT ROOM .4 COAT ROOM .5 STORAGE .1 4TH GRADE CLASSRO .2 TEACHER WARDROBE .3 COAT ROOM .4 STORAGE .1 4TH GRADE CLASSRO .2 TEACHER WARDROBE .3 COAT ROOM .4 STORAGE .1 4TH GRADE CLASSRO		222	NEW NURSE OFFICE	214	YES	3' - 0"	7' - 0"	WD	G H		WD	WD-1T	15	11	В	20 MIN.	05.4 ETD
.2 CORRIDOR 'B' .1 NEW J.C1 VEST1 CORRIDOR 'B' .1 STAIR C .2 STAIR C .1 STORAGE .2 STORAGE .2 STORAGE .3 COAT ROOM .4 STORAGE .1 4TH GRADE CLASSRO .2 TEACHER WARDROBE .3 COAT ROOM .4 STORAGE .1 4TH GRADE CLASSRO .2 TEACHER WARDROBE .1 4TH GRADE CLASSRO .2 TEACHER WARDROBE .3 COAT ROOM .4 COAT ROOM .5 STORAGE .1 4TH GRADE CLASSRO .2 TEACHER WARDROBE .3 COAT ROOM .5 STORAGE .1 4TH GRADE CLASSRO .2 TEACHER WARDROBE .3 COAT ROOM .4 STORAGE .1 4TH GRADE CLASSRO .2 TEACHER WARDROBE .3 COAT ROOM .4 STORAGE .1 4TH GRADE CLASSRO		214 222	TOILET ROOM  NEW BOYS RESTROOM	214A 215	YES	3' - 0" 3' - 0"	7' - 0" 7' - 0"	WD WD	Н	YES	WD HM	WD-1 HM-1	10 12	11 13 & 14	G F	20 MIN.	ETR 06.2 REFER TO NOTE 10
.1 NEW J.C1 VEST1 CORRIDOR 'B' .1 STAIR C .2 STAIR C .1 STORAGE .2 STORAGE .2 STORAGE .3 ELEC / IDF  el 3 .1 4TH GRADE CLASSRO .2 TEACHER WARDROBE .3 COAT ROOM .4 STORAGE .1 4TH GRADE CLASSRO .2 TEACHER WARDROBE .3 COAT ROOM .4 STORAGE .1 4TH GRADE CLASSRO .2 TEACHER WARDROBE .3 COAT ROOM .4 COAT ROOM .5 STORAGE .1 4TH GRADE CLASSRO .2 TEACHER WARDROBE .3 COAT ROOM .5 STORAGE .1 4TH GRADE CLASSRO .2 TEACHER WARDROBE .3 COAT ROOM .4 STORAGE .1 4TH GRADE CLASSRO		223	STAIR A	216		3' - 6"	7' - 0"	AL	Α		AL	ST-1	30	26 & 27	29	90 MIN.	RAL
.1 VEST1 CORRIDOR 'B' .1 STAIR C .2 STAIR C .1 STORAGE .2 STORAGE .2 STORAGE A ELEC / IDF  el 3 .1 4TH GRADE CLASSRO .2 TEACHER WARDROBE .3 COAT ROOM .4 STORAGE .1 4TH GRADE CLASSRO .2 TEACHER WARDROBE .3 COAT ROOM .4 STORAGE .1 4TH GRADE CLASSRO .2 TEACHER WARDROBE .3 COAT ROOM .4 COAT ROOM .5 STORAGE .1 4TH GRADE CLASSRO .2 TEACHER WARDROBE .3 COAT ROOM .5 STORAGE .1 4TH GRADE CLASSRO .2 TEACHER WARDROBE .3 COAT ROOM .4 STORAGE .1 4TH GRADE CLASSRO	DR 'B'	223 217	STAIR A CORRIDOR 'B'	216 223	YES	3' - 6" 2' - 8"	7' - 0" 7' - 0"	AL WD	A H		AL WD	ST-1 WD-1T	30 15	26 & 27 11	29 B	90 MIN. 20 MIN.	RAL 08
.1 CORRIDOR 'B' .1 STAIR C .2 STAIR C .1 STORAGE .2 STORAGE .2 STORAGE A ELEC / IDF  el 3 .1 4TH GRADE CLASSRO .2 TEACHER WARDROBE .3 COAT ROOM .4 STORAGE .1 4TH GRADE CLASSRO .2 TEACHER WARDROBE .3 COAT ROOM .4 STORAGE .1 4TH GRADE CLASSRO .2 TEACHER WARDROBE .3 COAT ROOM .4 COAT ROOM .5 STORAGE .1 4TH GRADE CLASSRO .2 TEACHER WARDROBE .3 COAT ROOM .5 STORAGE .1 4TH GRADE CLASSRO .2 TEACHER WARDROBE .3 COAT ROOM .4 STORAGE .1 4TH GRADE CLASSRO		217	STAIR B	218	TES	3' - 4"	7'-0"	WD	В		WD	WD-11	10	11	ETR	ZU IVIIIN.	ETR
.2 STAIR C .1 STORAGE .2 STORAGE A ELEC / IDF  el 3 .1 4TH GRADE CLASSRO .2 TEACHER WARDROBE .3 COAT ROOM .4 STORAGE .1 4TH GRADE CLASSRO .2 TEACHER WARDROBE .3 COAT ROOM .4 STORAGE .1 4TH GRADE CLASSRO .2 TEACHER WARDROBE .3 COAT ROOM .4 COAT ROOM .5 STORAGE .1 4TH GRADE CLASSRO .2 TEACHER WARDROBE .3 COAT ROOM .4 STORAGE .1 4TH GRADE CLASSRO .3 COAT ROOM .4 STORAGE .1 4TH GRADE CLASSRO	PR 'B'	223	VEST.	219		3' - 4"	7' - 0"	WD	В		WD	WD-1	10	11	ETR		ETR
.1 STORAGE .2 STORAGE A ELEC / IDF  el 3 .1 4TH GRADE CLASSRO .2 TEACHER WARDROBE .3 COAT ROOM .4 STORAGE .1 4TH GRADE CLASSRO .2 TEACHER WARDROBE .3 COAT ROOM .4 COAT ROOM .4 COAT ROOM .5 STORAGE .1 4TH GRADE CLASSRO .2 TEACHER WARDROBE .3 COAT ROOM .5 STORAGE .1 4TH GRADE CLASSRO .2 TEACHER WARDROBE .3 COAT ROOM .4 STORAGE .1 4TH GRADE CLASSRO		221 221	CORRIDOR 'B'	223		3' - 6"		AL	A		AL	ST-1	30	26 & 27		90 MIN.	RAL
.2 STORAGE A ELEC / IDF  el 3 .1 4TH GRADE CLASSRO .2 TEACHER WARDROBE .3 COAT ROOM .4 STORAGE .1 4TH GRADE CLASSRO .2 TEACHER WARDROBE .3 COAT ROOM .4 COAT ROOM .4 COAT ROOM .5 STORAGE .1 4TH GRADE CLASSRO .2 TEACHER WARDROBE .3 COAT ROOM .5 STORAGE .1 4TH GRADE CLASSRO .2 TEACHER WARDROBE .3 COAT ROOM .4 STORAGE .1 4TH GRADE CLASSRO		221	CORRIDOR 'B'	223 223		3' - 6" 2' - 8"	7' - 0" 7' - 0"	AL WD	A F		AL WD	ST-1 WD-1	30 10	26 & 27 11	29 ETR	90 MIN.	RAL ETR
el 3 .1 4TH GRADE CLASSRO .2 TEACHER WARDROBE .3 COAT ROOM .4 STORAGE .1 4TH GRADE CLASSRO .2 TEACHER WARDROBE .3 COAT ROOM .4 COAT ROOM .5 STORAGE .1 4TH GRADE CLASSRO .2 TEACHER WARDROBE .1 4TH GRADE CLASSRO .2 TEACHER WARDROBE .3 COAT ROOM .4 STORAGE .1 4TH GRADE CLASSRO .4 STORAGE	Ξ		CORRIDOR 'B'	223		2' - 8"	7' - 0"	WD	F		WD	WD-1	10	11	ETR		ETR
.1 4TH GRADE CLASSRO .2 TEACHER WARDROBE .3 COAT ROOM .4 STORAGE .1 4TH GRADE CLASSRO .2 TEACHER WARDROBE .3 COAT ROOM .4 COAT ROOM .5 STORAGE .1 4TH GRADE CLASSRO .2 TEACHER WARDROBE .3 COAT ROOM .5 STORAGE .1 4TH GRADE CLASSRO .2 TEACHER WARDROBE .3 COAT ROOM .4 STORAGE .1 4TH GRADE CLASSRO	F	224A	CORRIDOR 'C'	224	YES	3' - 0"	7' - 0"	WD	Н	YES	НМ	HM-1	12	13	В		08 REFER TO NOTE 10
.1 4TH GRADE CLASSRO .2 TEACHER WARDROBE .3 COAT ROOM .4 STORAGE .1 4TH GRADE CLASSRO .2 TEACHER WARDROBE .3 COAT ROOM .4 COAT ROOM .5 STORAGE .1 4TH GRADE CLASSRO .2 TEACHER WARDROBE .3 COAT ROOM .5 STORAGE .1 4TH GRADE CLASSRO .2 TEACHER WARDROBE .3 COAT ROOM .4 STORAGE .1 4TH GRADE CLASSRO																	
.3 COAT ROOM .4 STORAGE .1 4TH GRADE CLASSRO .2 TEACHER WARDROBE .3 COAT ROOM .4 COAT ROOM .5 STORAGE .1 4TH GRADE CLASSRO .2 TEACHER WARDROBE .3 COAT ROOM .4 STORAGE .1 4TH GRADE CLASSRO .4 STORAGE .1 4TH GRADE CLASSRO		301	CORRIDOR 'A'	320	YES	3' - 0"	7' - 0"	WD	G		WD	WD-1T	15	11	ETR	20 MIN.	06
.4 STORAGE .1 4TH GRADE CLASSRO .2 TEACHER WARDROBE .3 COAT ROOM .4 COAT ROOM .5 STORAGE .1 4TH GRADE CLASSRO .2 TEACHER WARDROBE .3 COAT ROOM .4 STORAGE .1 4TH GRADE CLASSRO		204 4	4TH GRADE CLASSROOM	301		1' - 8"	6' - 8" 7' - 0"	WD	E		WD	WD-1	10	11	-		ETR REFER TO NOTE 9
.1 4TH GRADE CLASSRO .2 TEACHER WARDROBE .3 COAT ROOM .4 COAT ROOM .5 STORAGE .1 4TH GRADE CLASSRO .2 TEACHER WARDROBE .3 COAT ROOM .4 STORAGE .1 4TH GRADE CLASSRO		301A	4TH GRADE CLASSROOM 4TH GRADE CLASSROOM	301 301		2' - 8" 2' - 6"	7' - 0" 7' - 0"	WD WD	B D		WD WD	WD-1 WD-1	10 10	11	-		ETR REFER TO NOTE 9 ETR REFER TO NOTE 9
.3 COAT ROOM .4 COAT ROOM .5 STORAGE .1 4TH GRADE CLASSRO .2 TEACHER WARDROBE .3 COAT ROOM .4 STORAGE .1 4TH GRADE CLASSRO	DE CLASSROOM	302	CORRIDOR 'A'	320	YES	3' - 0"	7' - 0"	WD	G		WD	WD-1T	15	11	ETR	20 MIN.	06
.4 COAT ROOM .5 STORAGE .1 4TH GRADE CLASSRO .2 TEACHER WARDROBE .3 COAT ROOM .4 STORAGE .1 4TH GRADE CLASSRO		302A	4TH GRADE CLASSROOM 4TH GRADE CLASSROOM	302 302		1' - 8" 2' - 6"	6' - 8" 7' - 0"	WD WD	E B		WD WD	WD-1 WD-1T	10 15	11 11	-		ETR REFER TO NOTE 9 ETR REFER TO NOTE 9
.5 STORAGE .1 4TH GRADE CLASSRO .2 TEACHER WARDROBE .3 COAT ROOM .4 STORAGE .1 4TH GRADE CLASSRO		302A 302A	4TH GRADE CLASSROOM  4TH GRADE CLASSROOM	302		2' - 6"	7'-0"	WD	В		WD	WD-11	15	11	-		ETR REFER TO NOTE 9
.2 TEACHER WARDROBE .3 COAT ROOM .4 STORAGE .1 4TH GRADE CLASSRO	=		4TH GRADE CLASSROOM	302		2' - 6"	7' - 0"	WD	D		WD	WD-1	10	11	-	00 7	ETR REFER TO NOTE 9
.3 COAT ROOM .4 STORAGE .1 4TH GRADE CLASSRO		303	CORRIDOR 'B' 4TH GRADE CLASSROOM	321 303	YES	3' - 0" 1' - 8"	7' - 0" 6' - 8"	WD WD	G E		WD WD	WD-1T WD-1	15 10	11 11	ETR -	20 MIN.	06 ETR REFER TO NOTE 9
.4 STORAGE .1 4TH GRADE CLASSRO		303A	4TH GRADE CLASSROOM	303		2' - 8"	7' - 0"	WD	В		WD	WD-1	10	11	-		ETR REFER TO NOTE 9
		001	4TH GRADE CLASSROOM	303	\/==	2' - 6"	7' - 0"	WD	D		WD	WD-1	10	11	-	00.1415	ETR REFER TO NOTE 9
.2 TEACHER WARDROBE	DE CLASSROOM  R WARDROBE	304	CORRIDOR 'B'  4TH GRADE CLASSROOM	321 304	YES	3' - 0" 1' - 8"	7' - 0" 6' - 8"	WD WD	G E		WD WD	WD-1T WD-1	15 10	11	±1K -	20 MIN.	06 ETR REFER TO NOTE 9
.3 COAT ROOM		304A	4TH GRADE CLASSROOM	304		2' - 6"	7' - 0"	WD	В		WD	WD-1T	15	11	-		ETR REFER TO NOTE 9
.5 STORAGE		00-	4TH GRADE CLASSROOM	304	\ /= ÷	2' - 6"	7' - 0"	WD	D		WD	WD-1	10	11	-	00.14:::	ET07 REFER TO NOTE 9
.1 4TH GRADE CLASSRO .2 TEACHER WARDROBE		305	CORRIDOR 'B'  4TH GRADE CLASSROOM	321 305	YES	3' - 0" 1' - 8"	7' - 0" 6' - 8"	WD WD	G E		WD WD	WD-1T WD-1	15 10	11	EIR -	20 MIN.	06 ETR REFER TO NOTE 9
.3 COAT ROOM		305A	4TH GRADE CLASSROOM	305		2' - 6"	7' - 0"	WD	В		WD	WD-1T	15	11			ETR REFER TO NOTE 9
.4 COAT ROOM		305A	4TH GRADE CLASSROOM	305		2' - 6"	7' - 0"	WD	В		WD	WD-1T	15	11	-		ETR REFER TO NOTE 9
.5 STORAGE .1 5TH GRADE CLASSRO		306	4TH GRADE CLASSROOM CORRIDOR 'B'	305 321	YES	2' - 6" 3' - 0"	7' - 0" 7' - 0"	WD WD	D G		WD WD	WD-1 WD-1T	10 15	11 11	- ETD	20 MIN.	ETR REFER TO NOTE 9
.1 51H GRADE CLASSRO .2 TEACHER WARDROBE	PE OEMOORUUIVI	300	5TH GRADE CLASSROOM	306	153	1' - 8"	6' - 8"	WD	E		WD	WD-11	10	11	- -	ZU IVIIIN.	ETR REFER TO NOTE 9
.3 COAT ROOM	R WARDROBE	306A	5TH GRADE CLASSROOM	306		2' - 6"		WD	В			WD-1T	15	11			ETR REFER TO NOTE 9

				DOOR FRAME										HDWR				
MARK	FROM ROOM	TO ROOM		NEW		IZE	MTRL	ELEV.	NEW	MTRL	ELEV		DETAIL		FIRE	SET		
WIMIXIX	NAME	NO.	NAME	NO.	DOOR	WIDTH	HEIGHT	WITTE	LLL V.	FRAME			HEAD	JAMB	SILL	RATING	NO.	COMMENTS
06.4	COAT ROOM	306A	5TH GRADE CLASSROOM	306		2' - 6"	7' - 0"	WD	В		WD	WD-1T	15	11	-		ETR	REFER TO NOTE 9
06.5	STORAGE		5TH GRADE CLASSROOM	306		2' - 6"	7' - 0"	WD	D		WD	WD-1	10	11	-		ETR	REFER TO NOTE 9
07.1	5TH GRADE CLASSROOM	307	CORRIDOR 'B'	321	YES	3' - 0"	7' - 0"	WD	G		WD	WD-1T	15	11	В	20 MIN.	06	
307.2	TEACHER WARDROBE		5TH GRADE CLASSROOM	307		1' - 8"	6' - 8"	WD	Е		WD	WD-1	10	11	-		ETR	REFER TO NOTE 9
07.3	COAT ROOM	307A	5TH GRADE CLASSROOM	307		2' - 6"	7' - 0"	WD	В		WD	WD-1T	15	11	-		ETR	REFER TO NOTE 9
07.4	COAT ROOM	307A	5TH GRADE CLASSROOM	307		2' - 6"	7' - 0"	WD	В		WD	WD-1T	15	11	-		ETR	REFER TO NOTE 9
07.5	STORAGE		5TH GRADE CLASSROOM	307		2' - 6"	7' - 0"	WD	D		WD	WD-1	10	11	-		ETR	REFER TO NOTE 9
307.6	NEW J.C.	318	CORRIDOR 'B'	321	YES	3' - 0"	7' - 0"	WD	Α		WD	WD-1T	15	11	В	20 MIN.	08	
308.1	5TH GRADE CLASSROOM	308	CORRIDOR 'B'	321	YES	3' - 0"	7' - 0"	WD	G		WD	WD-1T	15	11	ETR	20 MIN.	06	
808.2	TEACHER WARDROBE		5TH GRADE CLASSROOM	308		1' - 8"	6' - 8"	WD	Е		WD	WD-1	10	11	-		ETR	REFER TO NOTE 9
308.3	COAT ROOM	308A	5TH GRADE CLASSROOM	308		2' - 8"	7' - 0"	WD	В		WD	WD-1	10	11	-		ETR	REFER TO NOTE 9
308.4	STORAGE		5TH GRADE CLASSROOM	308		2' - 6"	7' - 0"	WD	D		WD	WD-1	10	11	-			REFER TO NOTE 9
809.1	5TH GRADE CLASSROOM	309	CORRIDOR 'B'	321	YES	3' - 0"	7' - 0"	WD	G		WD	WD-1T	15	11	ETR	20 MIN.	06	
09.2	TEACHER WARDROBE		5TH GRADE CLASSROOM	309		1' - 8"	6' - 8"	WD	E		WD	WD-1	10	11	-			REFER TO NOTE 9
09.3	COAT ROOM	309A	5TH GRADE CLASSROOM	309		2' - 6"	7' - 0"	WD	В		WD	WD-1T	15	11	-		ETR	REFER TO NOTE 9
09.4	COAT ROOM	309A	5TH GRADE CLASSROOM	309		2' - 6"	7' - 0"	WD	В		WD	WD-1T	15	11	-			REFER TO NOTE 9
09.5	STORAGE		5TH GRADE CLASSROOM	309		2' - 6"	7' - 0"	WD	D		WD	WD-1	10	11	-			REFER TO NOTE 9
10.1	5TH GRADE CLASSROOM	310	CORRIDOR 'C'	322	YES	3' - 0"	7' - 0"	WD	G		WD	WD-1T	15	11	ETR	20 MIN.	06	
10.2	TEACHER WARDROBE		5TH GRADE CLASSROOM	310		1' - 8"	6' - 8"	WD	Е		WD	WD-1	10	11	-			REFER TO NOTE 9
10.3	STORAGE		5TH GRADE CLASSROOM	310		2' - 6"	7' - 0"	WD	D		WD	WD-1	10	11	-		ETR	REFER TO NOTE 9
310.4	COAT ROOM	311E	5TH GRADE CLASSROOM	310		2' - 8"	7' - 0"	WD	В		WD	WD-1	10	11	-		ETR	REFER TO NOTE 9
11.1	COMPUTER ROOM	311	CORRIDOR 'A'	320	YES	3' - 0"	7' - 0"	WD	G		WD	WD-1T	15	11	ETR	20 MIN.	06.4	
311.2	TEACHER WARDROBE		COMPUTER ROOM	311		1' - 10"	7' - 0"	WD	Е		WD	WD-1	10	11	-		ETR	
11.3	NEW STORAGE	311A	COMPUTER ROOM	311	YES	3' - 0"	7' - 0"	WD	Н	YES	НМ	HM-1	12	13	Н		08	REFER TO NOTE 10
311.4	NEW STORAGE	311A	STORAGE			2' - 6"	7' - 0"	WD	Н		WD	WD-1	10	11	-		ETR	
11.5	NEW FACULTY TOILET	311B	CORRIDOR 'B'	321	YES	3' - 0"	7' - 0"	WD	Н	YES	НМ	HM-1	12	13	G		04.2	REFER TO NOTE 10
311.6	TEACHER WARDROBE		COMPUTER ROOM	311		2' - 6"	7' - 0"	WD	D		WD	WD-1	10	11	-		ETR	
12.1	CORRIDOR 'C'	322	NEW GIRLS RESTROOM	312	YES	3' - 0"	7' - 0"	WD	Н	YES	НМ	HM-1	10	13 & 14	G			REFER TO NOTE 10
313.1	CORRIDOR 'A'	320	NEW BOYS RESTROOM	313	YES	3' - 0"	7' - 0"	WD	Н	YES	НМ	HM-1	1012	13 & 14	G			REFER TO NOTE 10
14.1	COUNSELOR	314	CORRIDOR 'B'	321	YES	2' - 8"	7' - 0"	WD	G		WD	WD-1	10	11	В	20 MIN.	05.2	
15.1	NEW STORAGE	315	CORRIDOR 'B'	321	YES	2' - 8"	7' - 0"	WD	Н		WD	WD-1T	15	11	В		08.5	
316.1	VEST.	317	STAIR B	316		3' - 4"	7' - 0"	WD	В		WD	WD-1	10	11	ETR		ETR	
17.1	CORRIDOR 'B'	321	VEST.	317		3' - 4"	7' - 0"	WD	В		WD	WD-1	10	11	ETR		ETR	
18.1	CORRIDOR 'B'	321	STAIR A	318		3' - 6"	7' - 0"	AL	Α		AL	ST-1	ETR	ETR	29	90 MIN.	RAL	8'-4" WIDE OVERALL
18.2	CORRIDOR 'B'	321	STAIR A	318		3' - 6"	7' - 0"	AL	Α		AL	ST-1	ETR	ETR	29	90 MIN.	RAL	8'-4" WIDE OVERALL
18.3	STAIR A	318	ATTIC STAIR			2' - 8"	7' - 0"	WD	Н		WD	WD-1	10	11	ETR		ETR	
19.1	STAIR C	319	CORRIDOR 'B'	321		3' - 6"	7' - 0"	AL	Α		AL	ST-1		26 & 27	29	90 MIN.	RAL	
19.2	STAIR C	319	CORRIDOR 'B'	321		3' - 6"	7' - 0"	AL	Α		AL	ST-1		26 & 27	29	60 MIN.	RAL	
21.1			CORRIDOR 'B'	321		2' - 8"	7' - 0"	WD	F		WD	WD-1	10	11	ETR		ETR	
321.2	STORAGE		CORRIDOR 'B'	321	1	2' - 8"	7' - 0"	WD	F		WD	WD-1	10	11	ETR		ETR	

3' - 6" 4' - 6"

NOTES:
1. REFER TO A-602 FOR ADDITIONAL DOOR SCHEDULES.

2. REFER TO SPECIFICATIONS FOR HARDWARE SET INFORMATION. HARDWARE SET "RAL" TO CONSIST OF POSITIVE LATCH, DOOR CLOSER, PANIC DEVICE, CONTINUOUS HINGES, AND AUTOMATIC DOOR BOTTOM TO BE COORDINATED WITH MANUF. FOR RATED ALUM AND GLASS DOOR ASSEMBLY AT THE FIRST,

SECOND, AND THIRD FLOOR STAIRS.
3. REFER TO A-603 FOR FRAME HEAD, JAMB, AND SILL DETAILS
4. ALL METAL DOORS TO BE PREPARED TO RECEIVE PAINT. PRIME AND PAINT ALL METAL DOORS.

5. ALL WOOD DOORS AND FRAMES TO BE CLEANED, SANDED & STAINED, UNLESS OTHERWISE NOTED.6. ALL OTHER DOOR FRAMES TO BE PAINTED U.O.N.

7. REFER TO INTERIOR FINISH SCHEDULE FOR PAINT TYPES.
8. EXISTING TO REMAIN IS ABBREVIATED AS ETR.

9. STRIP / SAND & REFINISH DOORS & FRAMES NOTED IN DOOR SCHEDULE.

10. REFER TO LINTEL SCHEDULE ON S-003 FOR LINTELS AT NEW OPENINGS IN MASONRY WALLS. PROVIDE

CFMF BOX HEADER AT NON MASONRY OPENINGS.


10'-10', TVP.
V.I.F.

8'-4' @ 3RD FLR STAIR A
V.I.F.

3'-6'
HOLD


6" PANEL +:- @ ST-1
HOLD

73 A-603

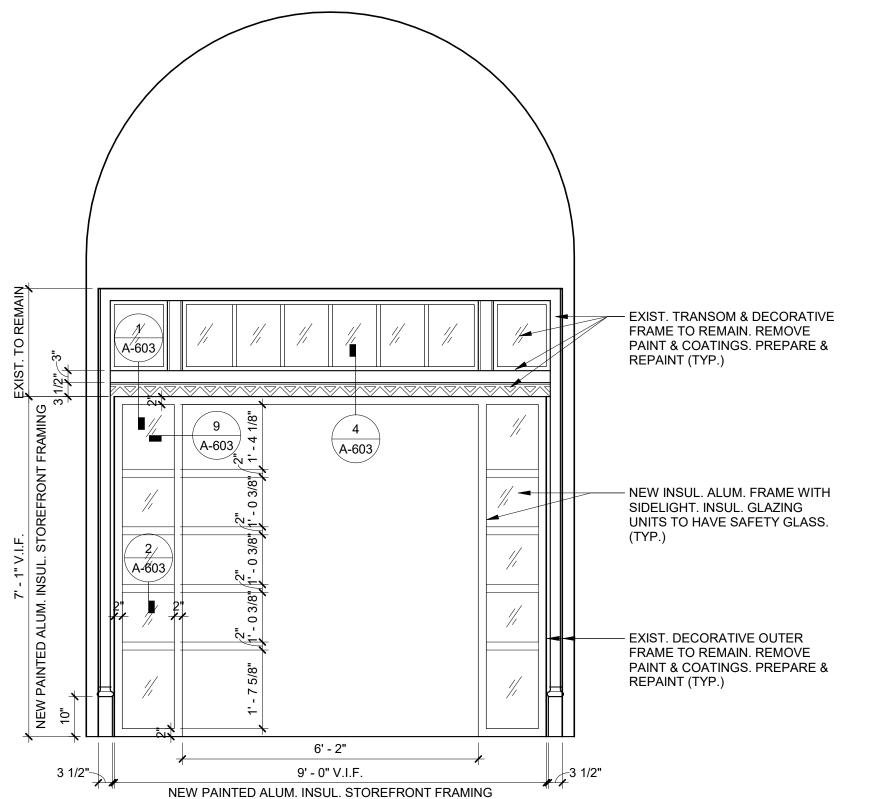

MAIN ENTRY DOOR FRAME ELEVATION

SCALE: 1/2" = 1'-0"

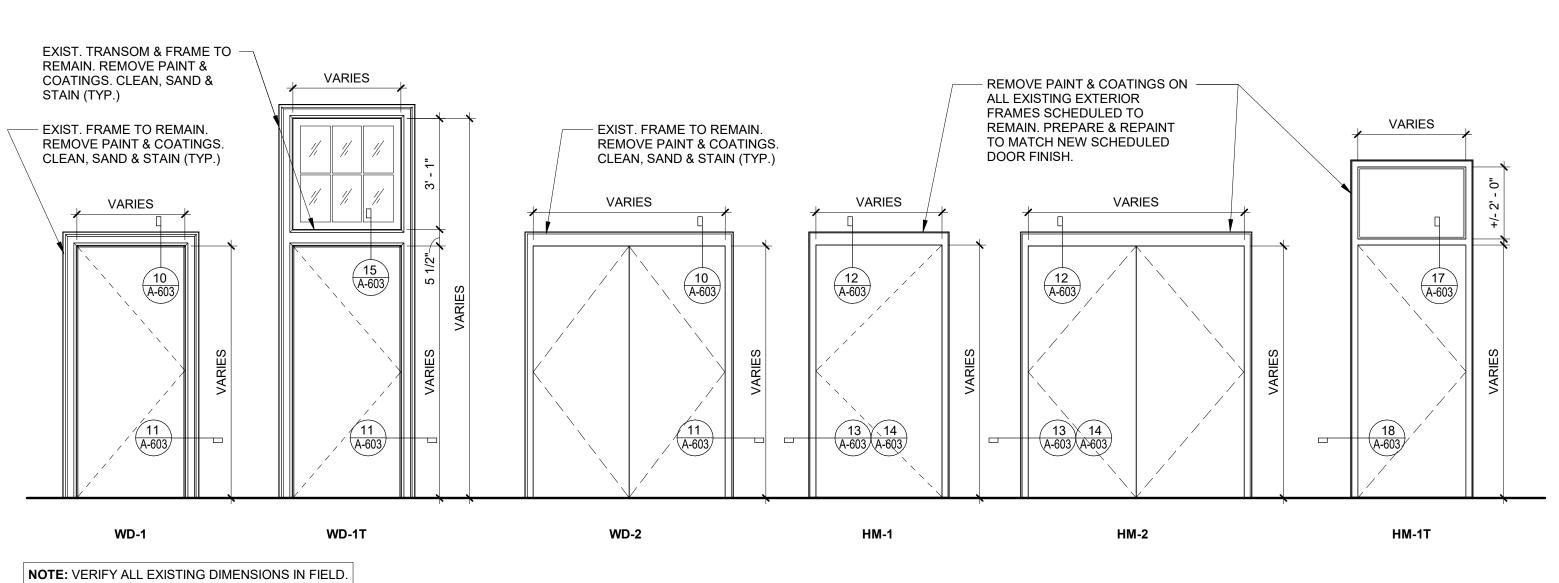

need to varify **ALL** dimensions

Frame Types

SCALE: 3/8" = 1'-0"

3 SCALE: 1/2" = 1'-0"

THE SCHOOL DISTRICT OF PHILADELPHIA

OFFICE OF CAPITAL PROGRAMS

440 NORTH BROAD STREET
PHILADELPHIA, PA 19130 - 4015
(215) 400 - 4730 | (215) 400 - 4731 (fax)
www.philasd.org

SEAL:

DA

ARCHITECT

DIGROUPARCHITECTURE 15 Bethany Street New Brunswick, NJ 08901 Phone:(732) 249-6242

Attn:Elizabeth Ackerman

Fax:(732) 247-1825

MEP

SCHILLER AND HERSH ASSOCIATES, INC. 636 W Skippack Pike #200
Blue Bell, PA 19422
Phone:(215) 886-8947
Fax:(215) 886-8956

Email:rdelp@schillerhersh.com

Email:eackerman@digrouparchitecture.com

CIVIL

Attn:Richard Delp

KS ENGINEERS, P.C. 530 Walnut Street, Suite 460 Philadelphia, PA 19106 Phone:(215) 925-0425 Fax:(215) 925-0430 Email:dhassinger@kseng.com Attn:David J. Hassinger

STRUCTURAL

DAVID MASON ASSOCIATES 123 S Broad Street Suite 1130 Philadelphia, PA 19109 Phone: (215) 372-3400 Email: jevans@davidmason.com Attn: Jeff Evans

<u>KITCHEN</u>

MCFARLAND KISTLER & ASSOCIATES 1130 Perry Highway, Suite 115 Pittsburgh, PA 15237 Phone: (412) 367-1905 Fax: (412) 367-4487 Email: kkistler-mka@comcast.net Attn: Ken Kistler

MASONRY

SCHNABEL CONSERVATION LLC 110 Kensington Avenue Trenton NJ 08618 Phone: (215) 582-3680 Email: lorraine@schnabelconservation.com Attn: Lorraine Schnabel

4 2022-05-06 ADDENDUM NO. 4
2 2022-03-31 ISSUED FOR BID
1 2022-03-10 ISSUED FOR PERMIT
NO. DATE REVISION

SCHOOL & LOCATION
EDWIN FORREST

PHILADELPHIA, PA 19136
PROJECT TITLE

MAJOR RENOVATIONS

**ELEMENTARY SCHOOL** 

4300 BLEIGH AVENUE

DRAWING TITLE

DOOR SCHEDULE AND FRAME TYPES

As indicated

LOCATION NO. FILE NO. 20.083

DRAWN BY CHECKED BY MC, LMJ

GC: B-057 C OF 2020 / 21

MC: B-058 C OF 2020 / 21

PC: B-059 C OF 2020 / 21

EC: B-060 C OF 2020 / 21

DRAWING SCALE

DRAWING NO.

A-602