


1 NORTH ELEVATION (FACING SPRUCE STREET)

SCALE: NOT TO SCALE

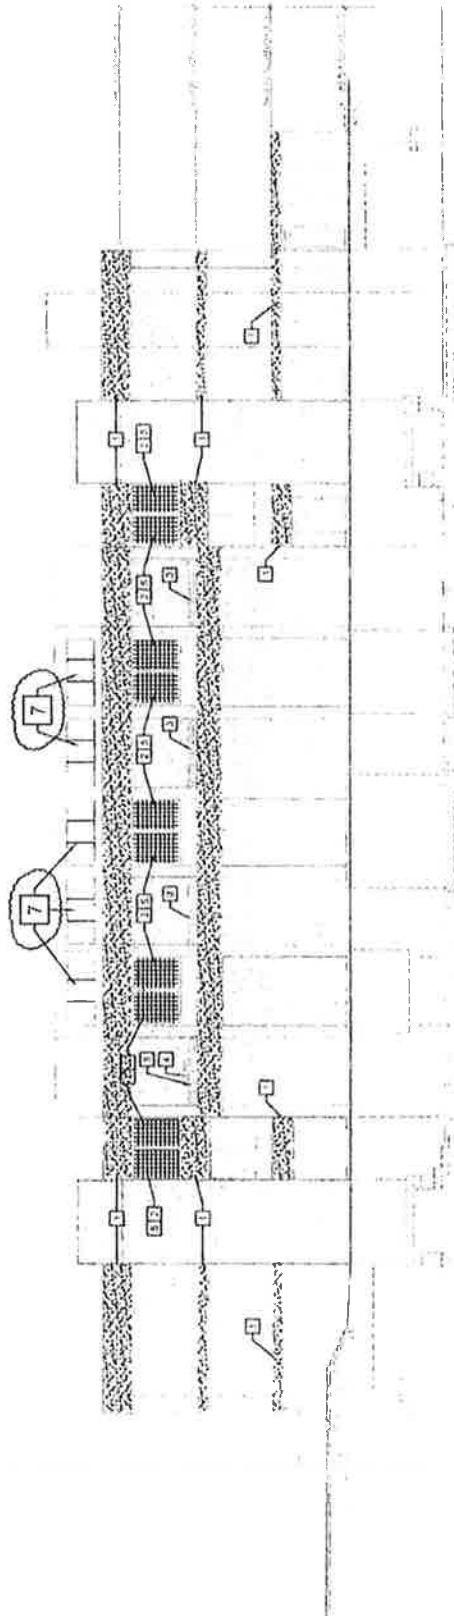

2 SOUTH ELEVATION (FACING PINE STREET)

SCALE: NOT TO SCALE



**KEY NOTES**

[7] : REMOVE AND REPLACE SEALANTS AROUND ALL CLEARSTORY SKYLIGHT WINDOWS BELOW ROOF AREAS C AND E.

NOTE: THE CLEARSTORY WINDOWS TO BE RESEALED BELOW THE NORTH SIDE OF ROOF AREA C AND BELOW THE SOUTH SIDE OF ROOF AREA E ARE NOT SHOWN ON THE ELEVATION DRAWINGS.

**WJE** ENGINEERS  
ARCHITECTS  
MATERIALS SCIENTISTS

Wiss, Janney, Elstner Associates, Inc.  
5 Vaughn Drive, Suite 100  
Princeton, New Jersey 08540  
609.739.7799 tel | 609.799.7088 fax  
www.wje.com

Project  
ROOF REPLACEMENT  
ANDREW HAMILTON ELEMENTARY SCHOOL  
5640 SPRUCE STREET

Sheet Title  
ELEVATIONS

Proj. No. 2017.1121

Date 01/12/2018

Drawn KHK

Checked SSD

Scale NOT TO SCALE

Sheet No.

**ADD. #1**

## SIGN-IN SHEET

- School Name: HAMILTON - ROOF
- Scope of Work: PRE-BID MTG.
- Conference Date: JAN - 10 - 2018 @ 10:00 AM

NAME	ORGANIZATION	PHONE	E-MAIL
ANTHONY BIRER	SOP	215.400.5192	ABIRER@PHILASD.ORG
URBAN DI PASQUALE	ARC Roofing Co. Inc	215 453 5800	U.Di.Pasquale@concrete.net
Connie Weiss	Soprema	610-458-8864	cawweiss@comcast.net
SCOTT DOWAN	WJF	609-799-7799	S.DOWAN@WJF.COM
Jason Forman	EDA	267-223-7537	jforman@educatractor.com
Tim Weaver	Patriot Roofing	609-724-8891	tweaver@patriotroof.com
KEVIN MOSK	PIRESTONE	484678-5835	KEVINM@PIRESTONE.COM
Bill Campbell	Robert Michaels & Assoc	215-237-1908	BCampbell@RobertMichaelsInc.com
John Gannon	GANTIK	2155313546	JGANNON@GANTIKCONTRACTORS.COM
Gerard Fara	US Roofing Co.	610-2226600	g.fara@usroofing.com
Shawn Palmer	Palmer	215 464-4222	shawn@palmerinc.net
Eric Schneider	Schneider Restoration	215-579-9151	ERS4900@HOTMAIL.COM