

SCHOOL & LOCATION  
Commodore John Barry Elementary School  
5900 Race Street, Philadelphia PA 19139

PROJECT TITLE  
NEW CONSTRUCTION

DRAWING TITLE  
THIRD FLOOR PLAN POWER

APPROVED BY

SCHOOL DISTRICT OF PHILADELPHIA  
THE SCHOOL REFORM COMMISSION

DEPARTMENT OF DESIGN AND CONSTRUCTION SERVICES


ANY, 3000 STREET  
PHILADELPHIA, PA 19106  
(215) 400-8700 FAX (215) 400-4701

CONTRACTOR TO VERIFY ALL CONDITIONS AND DIMENSIONS AT SITE

NO.	DATE	REVISION
1		
2		
3		
4		
5		
6		
7		
8		
9		

SPEC NO. B-840C of 2005/06	DATE 12/29/06
SCALE 1/8"=1'-0"	LOCATION NO. 120
DRAWN BY CDM	TYPE NO. -
CHECKED BY	FILE NO. -

DRAWING NO.  
**E103**

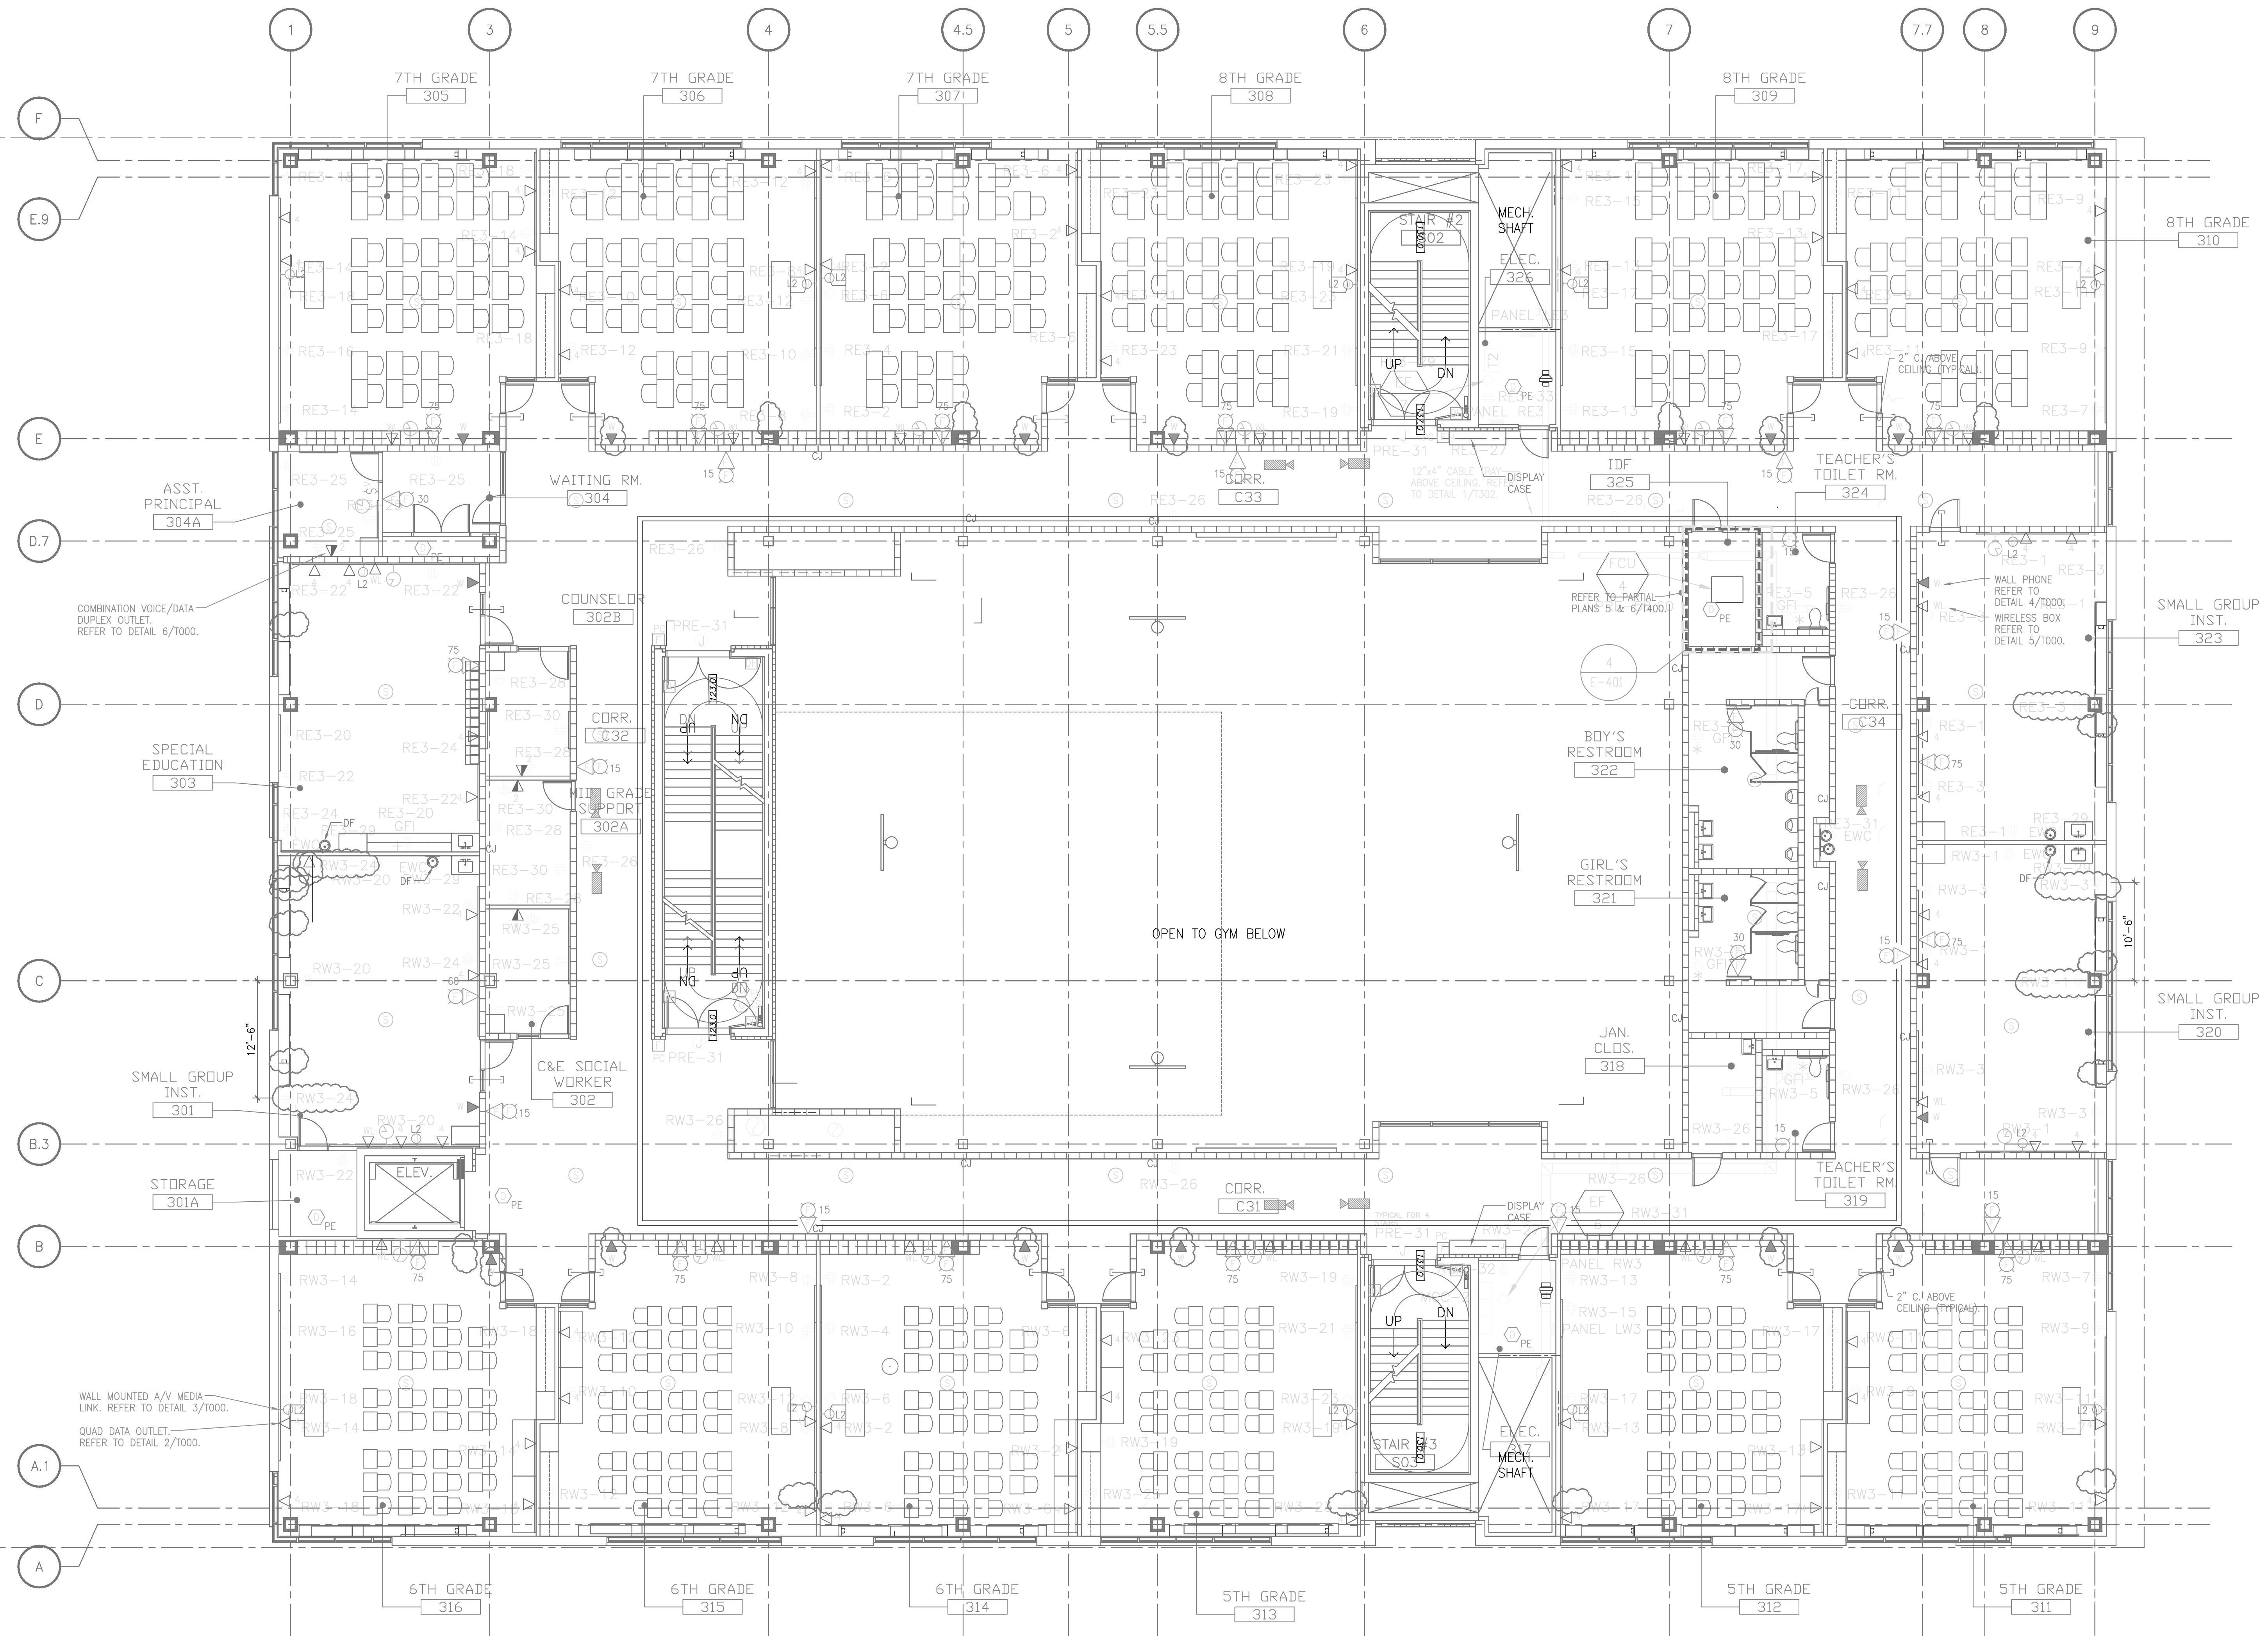

MECH. CONTROL PANEL-

PROVIDE 120V CIRCUIT TO THE FOLLOWING ROOMS AT LOCATION  
REQUIRED BY MECHANICAL EQUIPMENT-  
ROOMS 303, 305, 306, 307 CONNECT TO RE3-32.  
ROOMS 308, 309, 310, 323 CONNECT TO RE3-34.  
ROOMS 301, 316, 315, 314 CONNECT TO RW3-28.  
ROOMS 313, 312, 311, 320 CONNECT TO RW3-30.

NOTES

- REFER TO DWG. E001 FOR INCOMING PRIMARY SERVICE.
- REFER TO DWGS. E500, E501 AND E502 FOR PANEL SCHEDULES.
- REFER TO DWG. E000 FOR SYMBOLS LIST.
- REFER TO DWG. E301 FOR EMERGENCY LIGHTING PANEL, WIRING DIAGRAMS AND SCHEDULES.
- REFER TO DWG. E300 FOR SINGLE LINE DIAGRAM.
- PROVIDE A SAFETY SWITCH FOR ALL MECHANICAL EQUIPMENT SIZED PER NEC - SUPPLIED WITH MECHANICAL EQUIPMENT, INSTALLED AND WIRED UNDER ELECTRICAL WORK.
- JUNCTION BOX MOUNTED ABOVE CEILING FOR MAGNET DOOR HOLDER.

1 THIRD FLOOR PLAN POWER  
1/8"=1'-0"