

SEAL



THE SHAW-WHITE PARTNERSHIP
220 CHESTNUT STREET PHILADELPHIA, PENNSYLVANIA 19103
215.251.1501
www.shaw-white.com

Wideman - Zelig Group, LLC
1415 N. Delaware Avenue
Philadelphia, PA 19122
(215) 462-2166 • (215) 462-2841
www.wideman-zelig.com

CSA CENTRAL, INC.
100 North Delaware Ave., 2nd Floor Philadelphia, PA 19103
(215) 427-8700, FAX (215) 427-8710

E&M ENGINEERING, INC.
1000 Locust Street, 10th Floor Philadelphia, PA 19106
(215) 592-4000 • FAX (215) 592-8811
www.eandm.com

SCHOOL & LOCATION
Commodore John Barry Elementary School
5900 Race Street, Philadelphia PA 19139

PROJECT TITLE
NEW CONSTRUCTION

DRAWING TITLE
SECOND FLOOR PLAN POWER

APPROVED BY

SCHOOL DISTRICT OF PHILADELPHIA
THE SCHOOL REFORM COMMISSION

DEPARTMENT OF DESIGN AND CONSTRUCTION SERVICES

440 ALBANY ROAD, 6TH FLOOR
PHILADELPHIA, PA 19106
(215) 499-4700 FAX (215) 400-0731

CONTRACTOR TO VERIFY ALL CONDITIONS AND DIMENSIONS AT SITE

NO.	DATE	REVISION
1	1/17/07	ADDITION No. 1

SPEC. NO.
9-840C of 2005/06

SCALE
1/8"=1'-0"

DRAWN BY
CDM

CHECKED BY

DATE
12/29/06


LOCATION NO.
120

TYPE NO.
-

FILE NO.
-

DRAWING NO.

E102

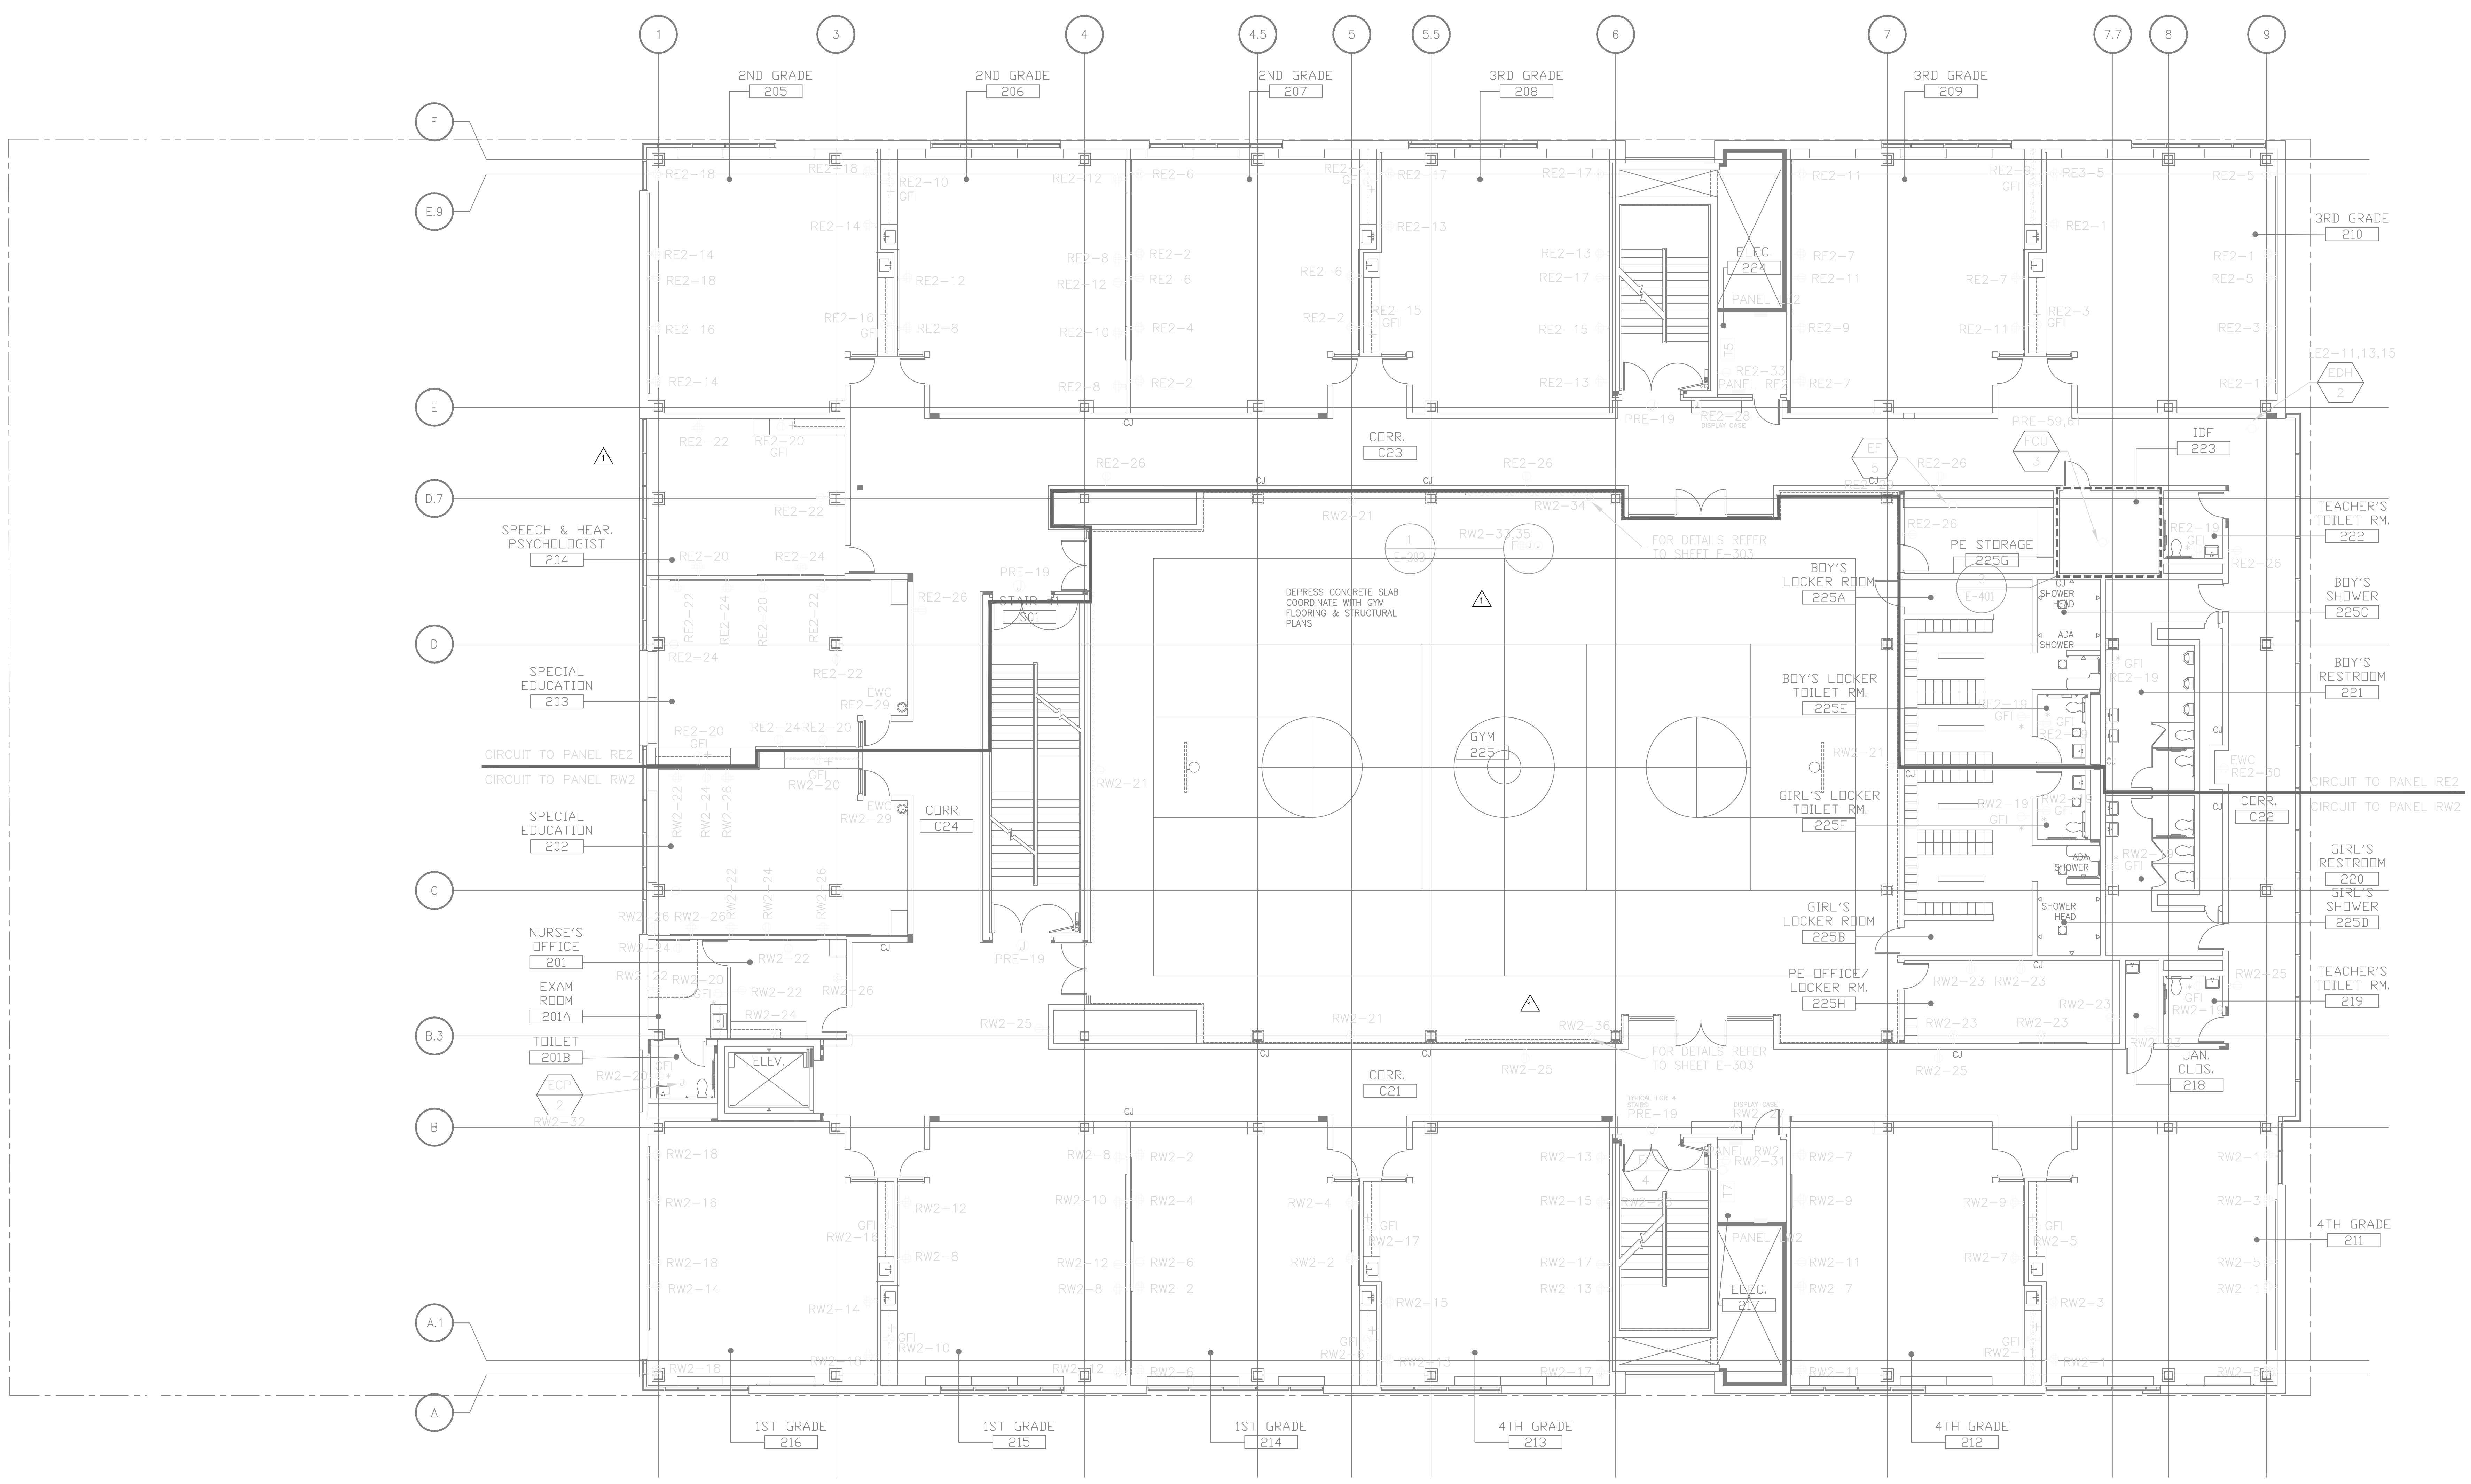

MECH. CONTROL PANEL-

PROVIDE 120V CIRCUIT TO THE FOLLOWING ROOMS AT LOCATION REQUIRED BY MECHANICAL EQUIPMENT-
ROOMS 203, 204, 205, 206 CONNECT TO RE2-31.
ROOMS 207, 208, 209, 210 CONNECT TO RE2-32.
ROOMS 202, 216, 215, 214 CONNECT TO RW2-28.
ROOMS 213, 212, 211 CONNECT TO RW2-30.

NOTES

1. REFER TO DWG. E001 FOR INCOMING PRIMARY SERVICE.
2. REFER TO DWGS. E500, E501 AND E502 FOR PANEL SCHEDULES.
3. REFER TO DWG. E000 FOR SYMBOLS LIST.
4. REFER TO DWG. E301 FOR EMERGENCY LIGHTING PANEL, WIRING DIAGRAMS AND SCHEDULES.
5. REFER TO DWG. E300 FOR SINGLE LINE DIAGRAM.
6. PROVIDE A SAFETY SWITCH FOR ALL MECHANICAL EQUIPMENT SIZED PER NEC - SUPPLIED WITH MECHANICAL EQUIPMENT, INSTALLED AND WIRED UNDER ELECTRICAL WORK.
7. JUNCTION BOX MOUNTED ABOVE CEILING FOR MAGNET DOOR HOLDER.

1 SECOND FLOOR PLAN POWER
1/8"=1'-0"