EIGHTH GRADE
402

CLOS

STAIRWAY
001
DN

AUDITORIUM BELOW

EIGHTH GRADE
403

THIRD HOUSE OFFICE
415

ROOF ACC.
416

SEE ISOMETRIC VIEW

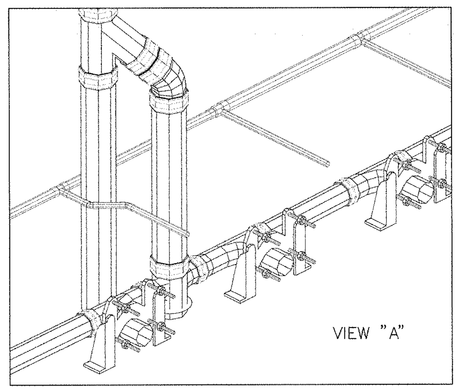

EIGHTH GRADE
404

CLOS

CLOS

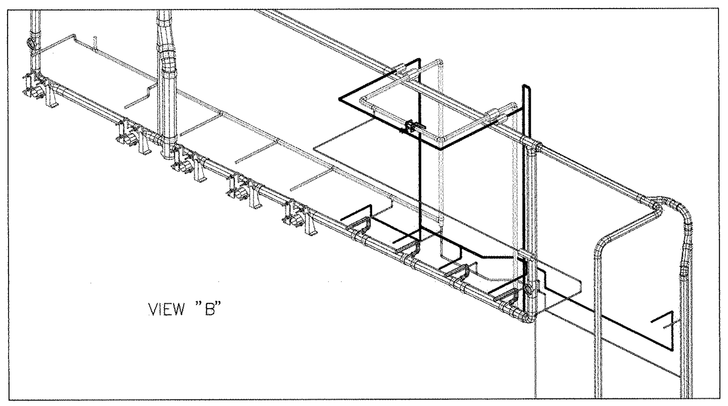

CORRIDOR
400B

GIRLS
417

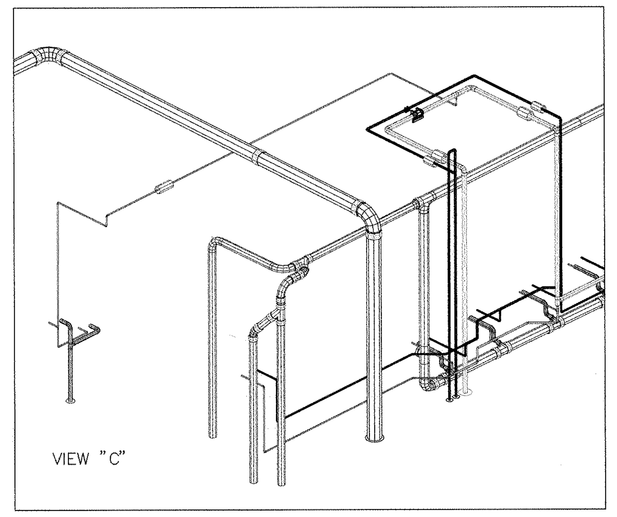

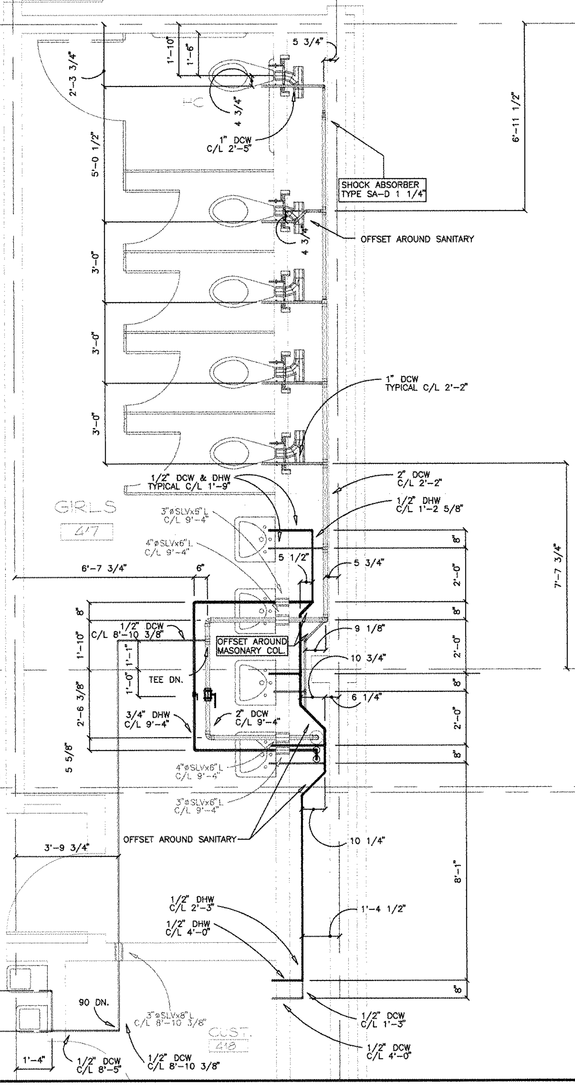

SEE ISOMETRIC VIEW

MATCHLINE
SEE DWG. W-16 FOR CONTINUATION

LEARN SUPPORT
405

AS-BUILT
9/19/97

BRINJAC, I... ASSOCIATES, INC.
REVI... DATE: 9/24/98
BY:

TRACEY MECHANICAL, INC.
401 CITY LINE AVE.
SUITE 212
BALA CYNWYD, PA. 19004

JOB NAME: 6TH AND DUNCANNON

TITLE: PARTIAL 4TH FLOOR WATER & GAS SERVICES

DATE: 11/8/96
SCALE: 3/8" = 1'-0"
DRAWN: D.G.

DRAWING NO. W-15

NO.	REVISION	DATE	BY

H:\CAD\DUNC\PW-15 Fri, Sep 19 15:26:45 1997