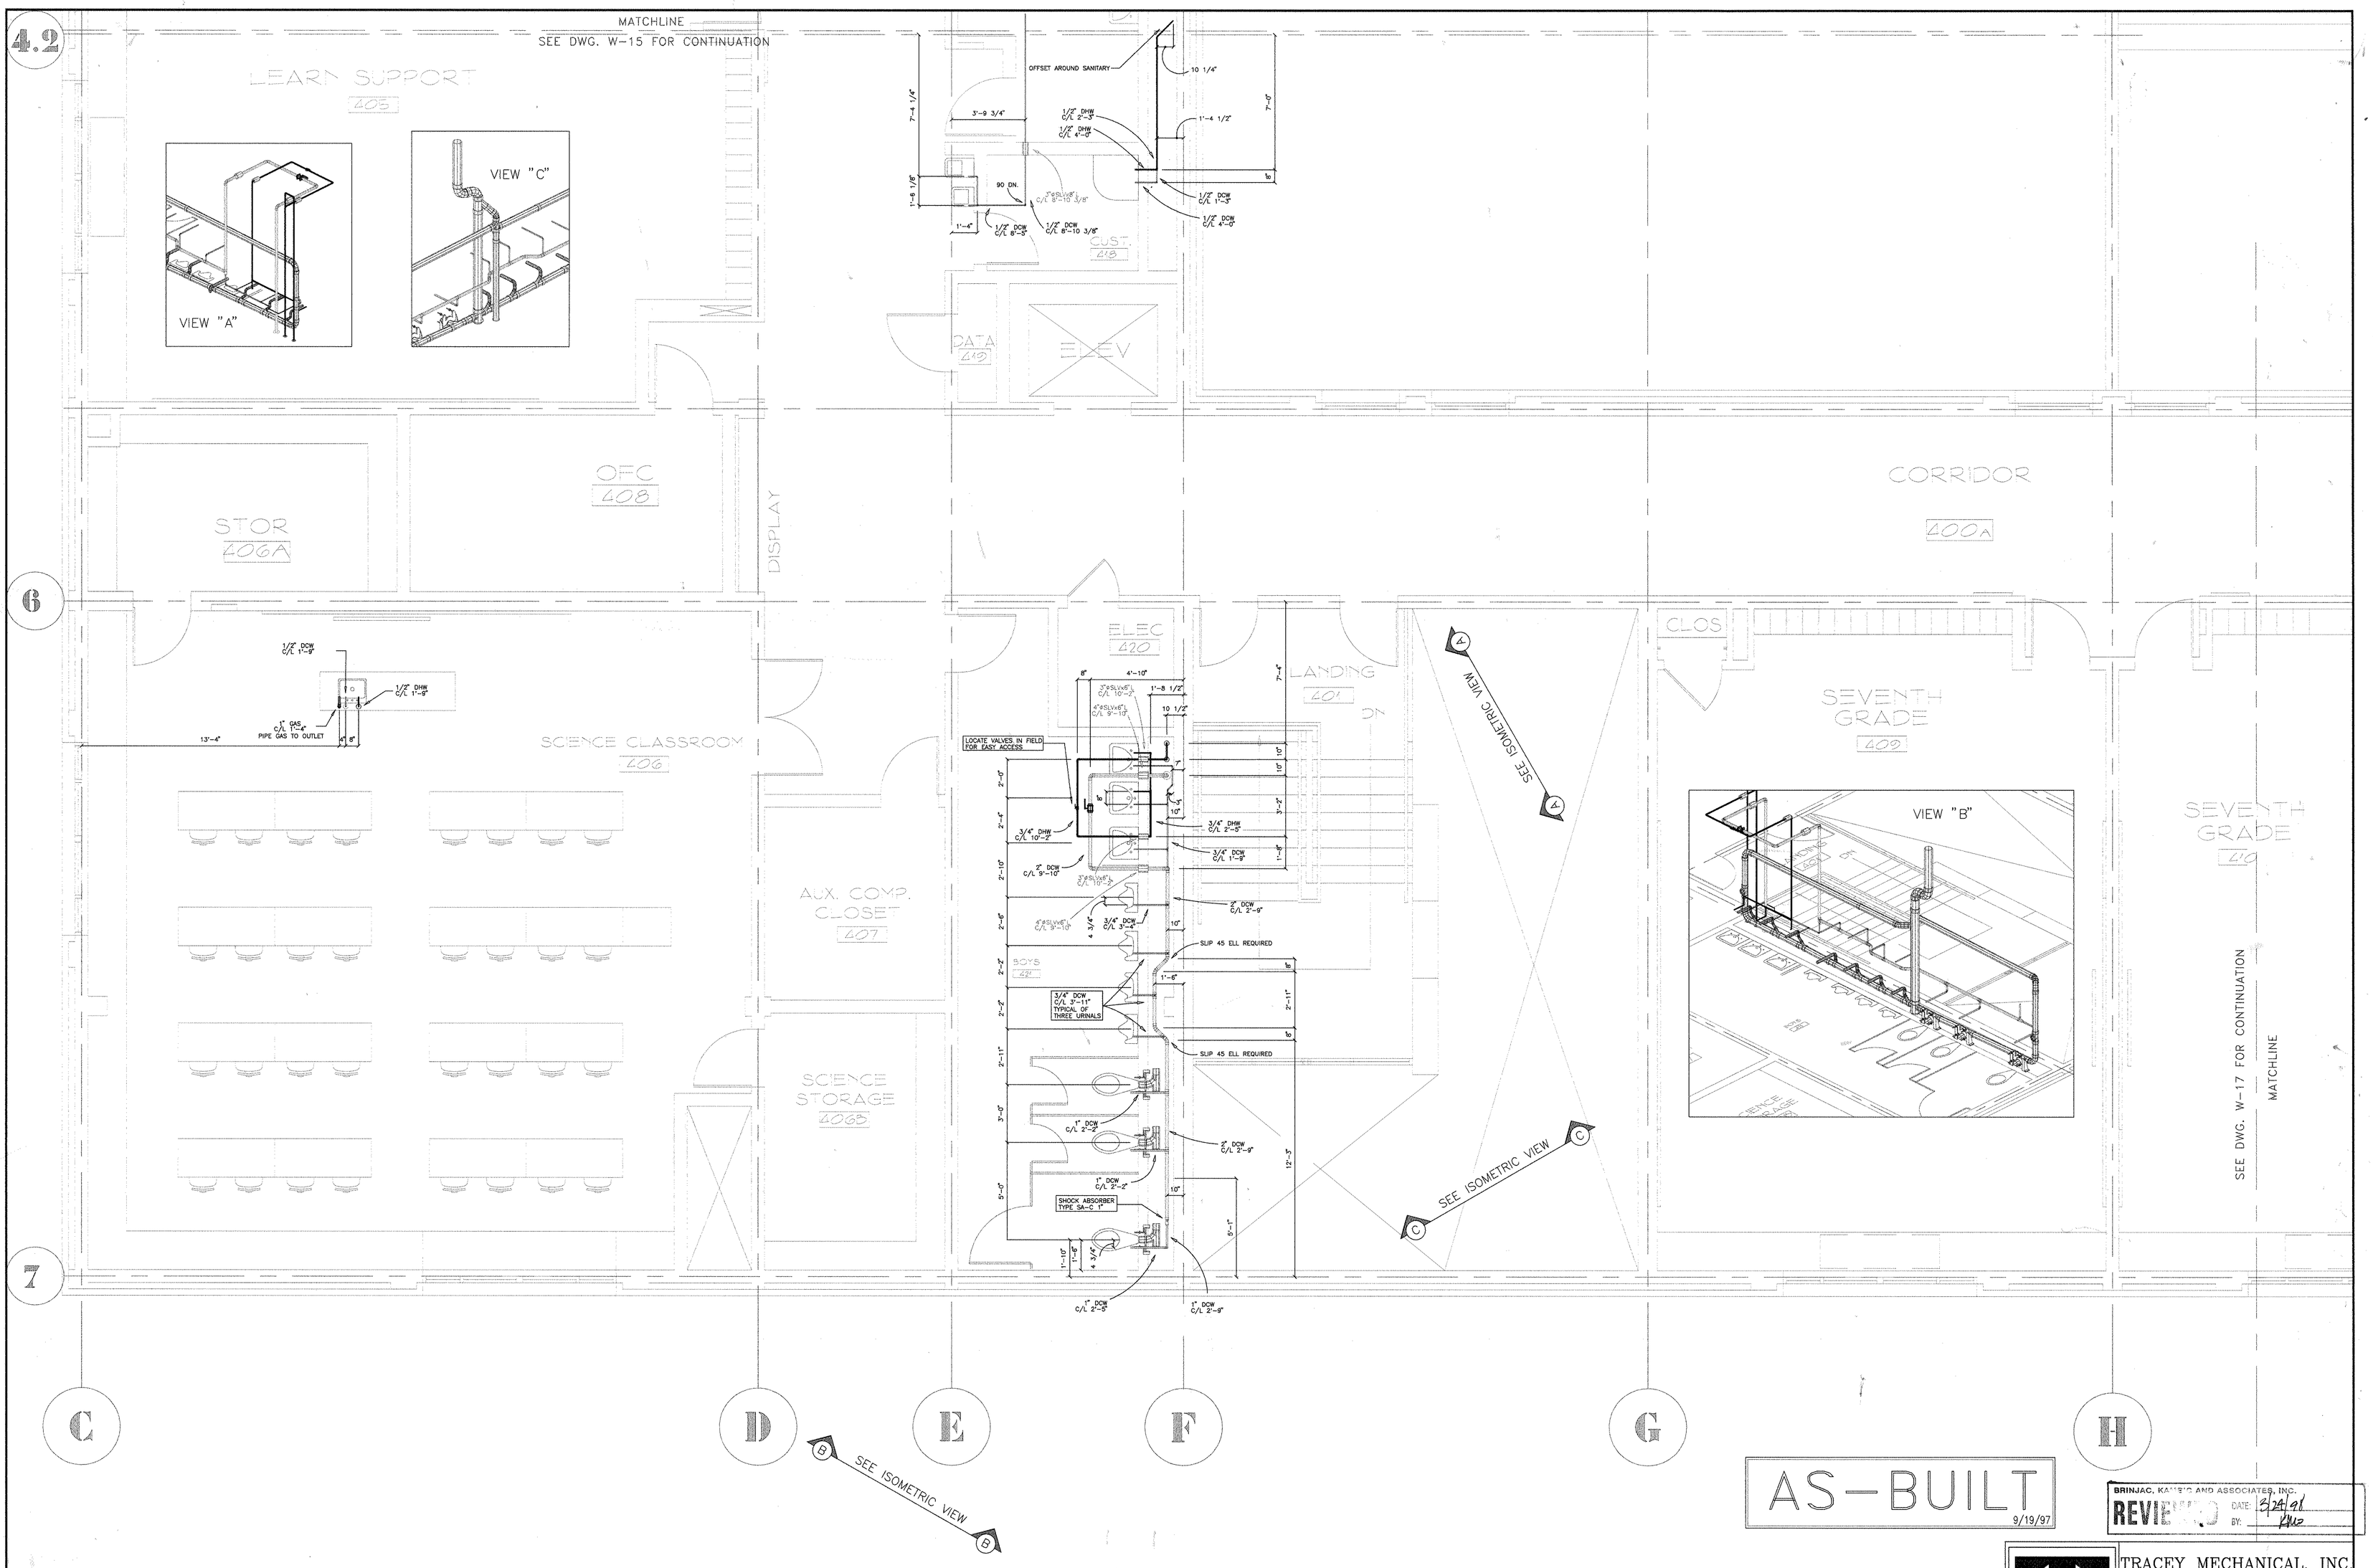

AS-BUILT
9/19/97

BRINJAC, KAMEIS AND ASSOCIATES, INC.
REVIEWED DATE: 3/24/98 BY: KMO

TRACEY MECHANICAL, INC.
401 CITY LINE AVE.
SUITE 212
BALA CYNWYD, PA. 19004

JOB NAME: 6TH AND DUNCANNON

TITLE: PARTIAL 4TH FLOOR WATER & GAS SERVICES

NO.	REVISION	DATE	BY

DATE: 11/12/96
SCALE: 3/8" = 1'-0"
DRAWN: D.G.

DRAWING NO. W-16