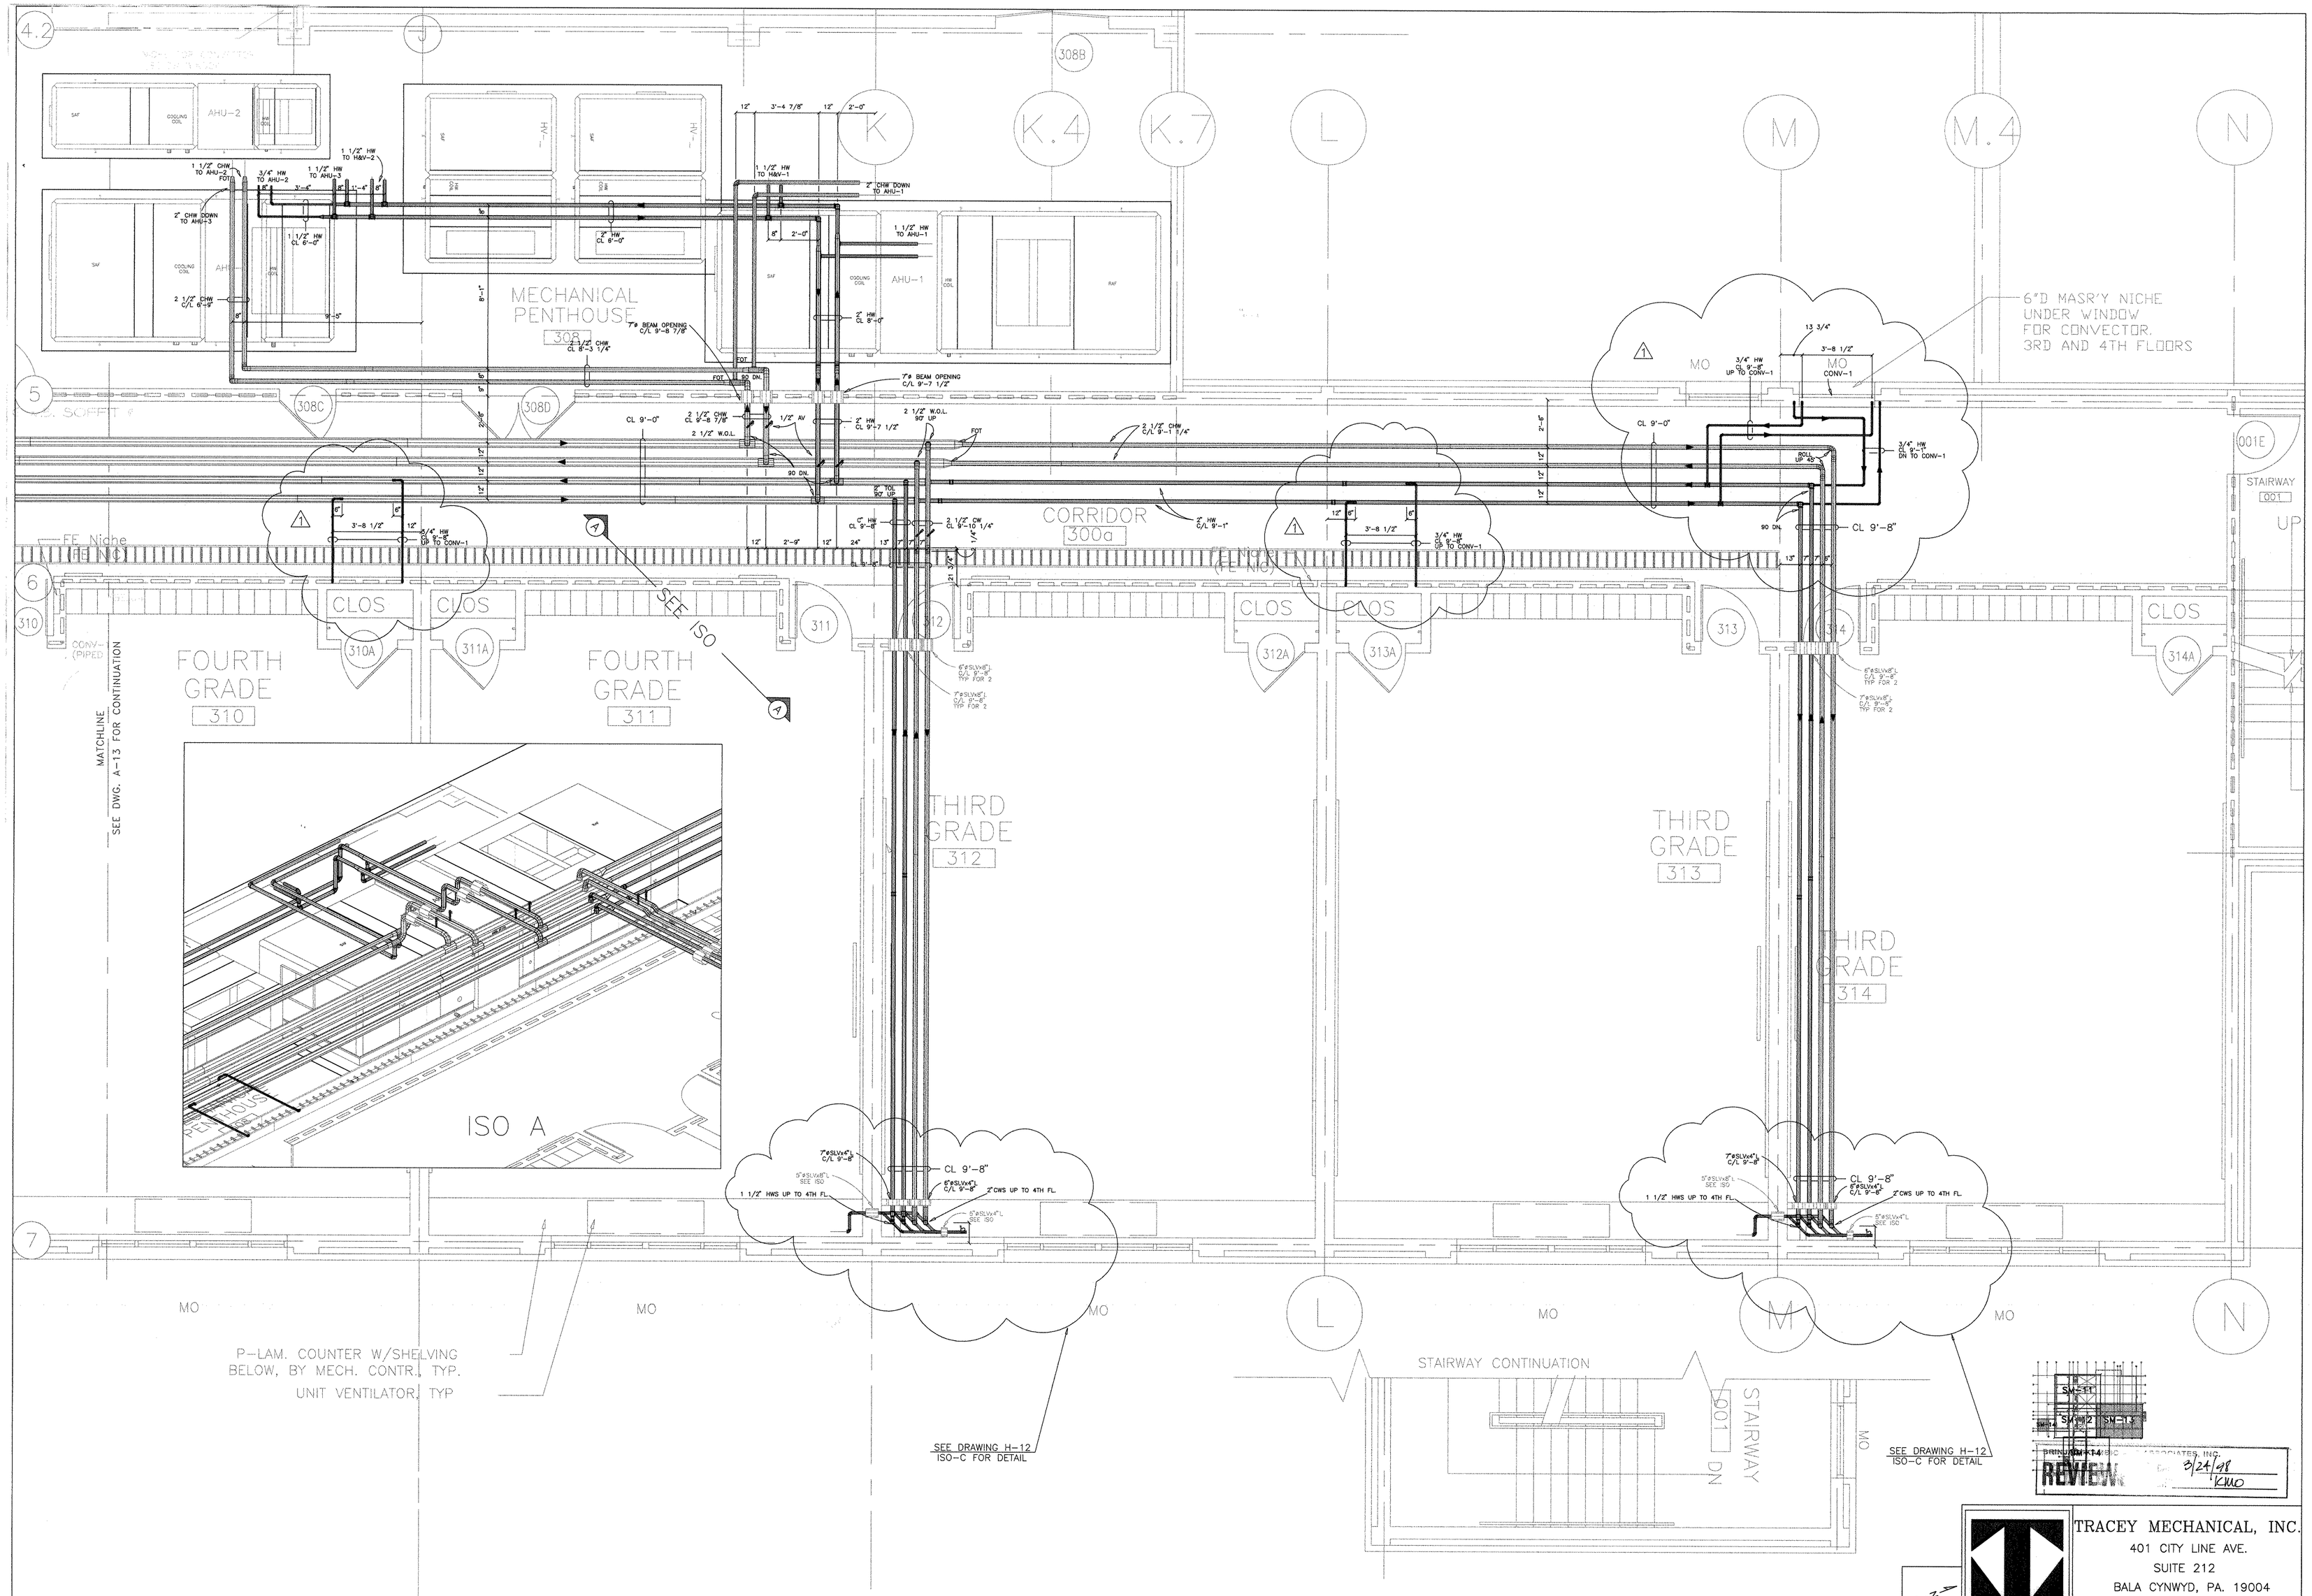

AS-BUILT
9/19/97

SLEEVE COUNT

TAG	QUA.	SIZE	LENGTH
SL1	10	5"	0'-8"
SL2	10	5"	0'-4"
SL3	4	6"	0'-8"
SL4	4	7"	0'-8"
SL3	4	6"	0'-4"
SL4	4	7"	0'-4"

NO.	REVISION	DATE	BY
1	4TH FLOOR CONVECTORS PER RFI RESPONSE	12/20/96	WJF

REVIEW 3/24/98 KMO

TRACEY MECHANICAL, INC.
401 CITY LINE AVE.
SUITE 212
BALA CYNWYD, PA. 19004

JOB NAME: 6TH AND DUNCANNON

TITLE: PARTIAL 3RD FLOOR

DATE:
SCALE:
DRAWN:

DRAWING NO. H-13