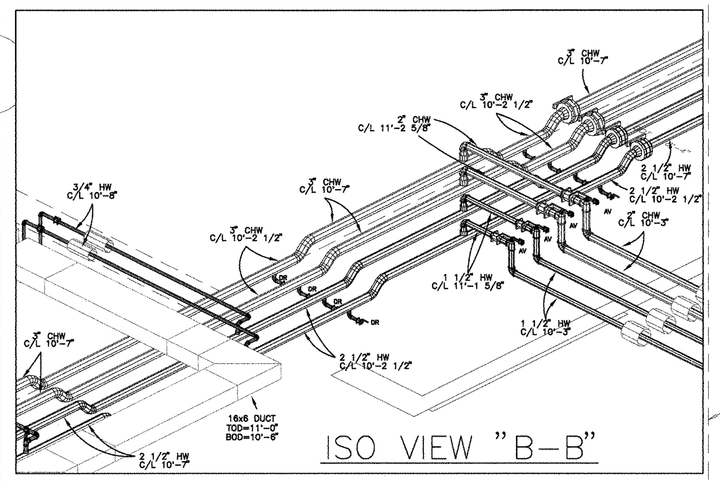

ISO VIEW "B-B"

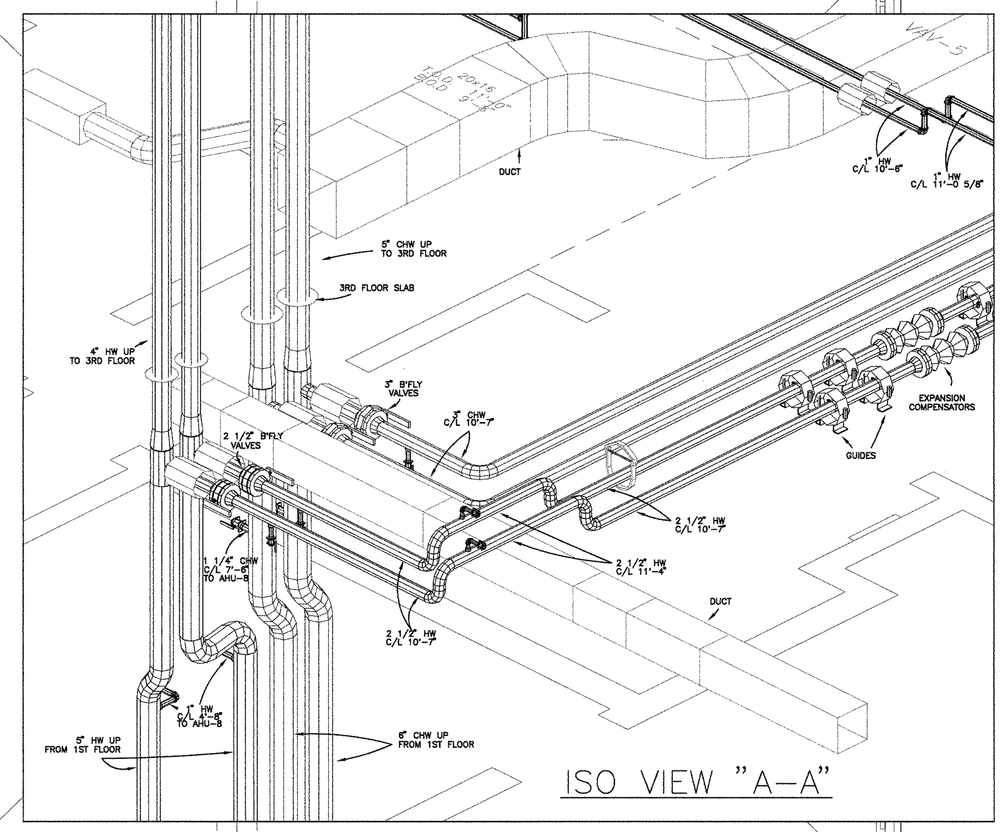

ISO VIEW "A-A"

SEE DWG. H-6 FOR CONTINUATION
MATCHLINE

SEE DWG. H-9 FOR CONTINUATION
MATCHLINE

SEE DWG. H-10 FOR CONTINUATION

SEE DWG. H-10 FOR CONTINUATION
MATCHLINE

SEE ISO VIEW "A-A"

SEE ISO VIEW "B-B"

SLEEVE COUNT

TAG	QUA.	SIZE	LENGTH
SL1	4	7"	0'-10"
SL2	4	6"	0'-8"
SL3	6	5"	0'-8"
SL4	4	4"	0'-10"
SL5	2	4"	0'-8"

HVAC PIPING NOTES

1. ALL DRAINS ARE 3/4" UNLESS NOTED OTHERWISE
2. ALL VENTS ARE 1/2" UNLESS NOTED OTHERWISE
3. PIPE ELEVATIONS ARE TAKEN FROM 2ND FLOOR FF

SM-6	SM-7		
SM-8	SM-9		
SM-10			

AS-BUILT
9/19/97

ERINJAC ASSOCIATES, INC.
REVIEWED DATE: 3/24/98
BY: KMG

TRACEY MECHANICAL, INC.
401 CITY LINE AVE.
SUITE 212
BALA CYNWYD, PA. 19004

JOB NAME: 6TH AND DUNCANNON

TITLE: PARTIAL 2ND FLOOR

DRAWING NO. H-8

NO.	REVISION	DATE	BY
2	ADD SLEEVES	10/28/96	L.W.
1	ADD 3/4" HWS&R FOR CONVECTOR IN 1ST HOUSE	10/9/96	L.W.

DATE: 10/2/96
SCALE: 3/8" = 1'-0"
DRAWN BY: L.W.

H:\CAD\DWG\H10-8 Fri Sep 19 15:48:19 1997