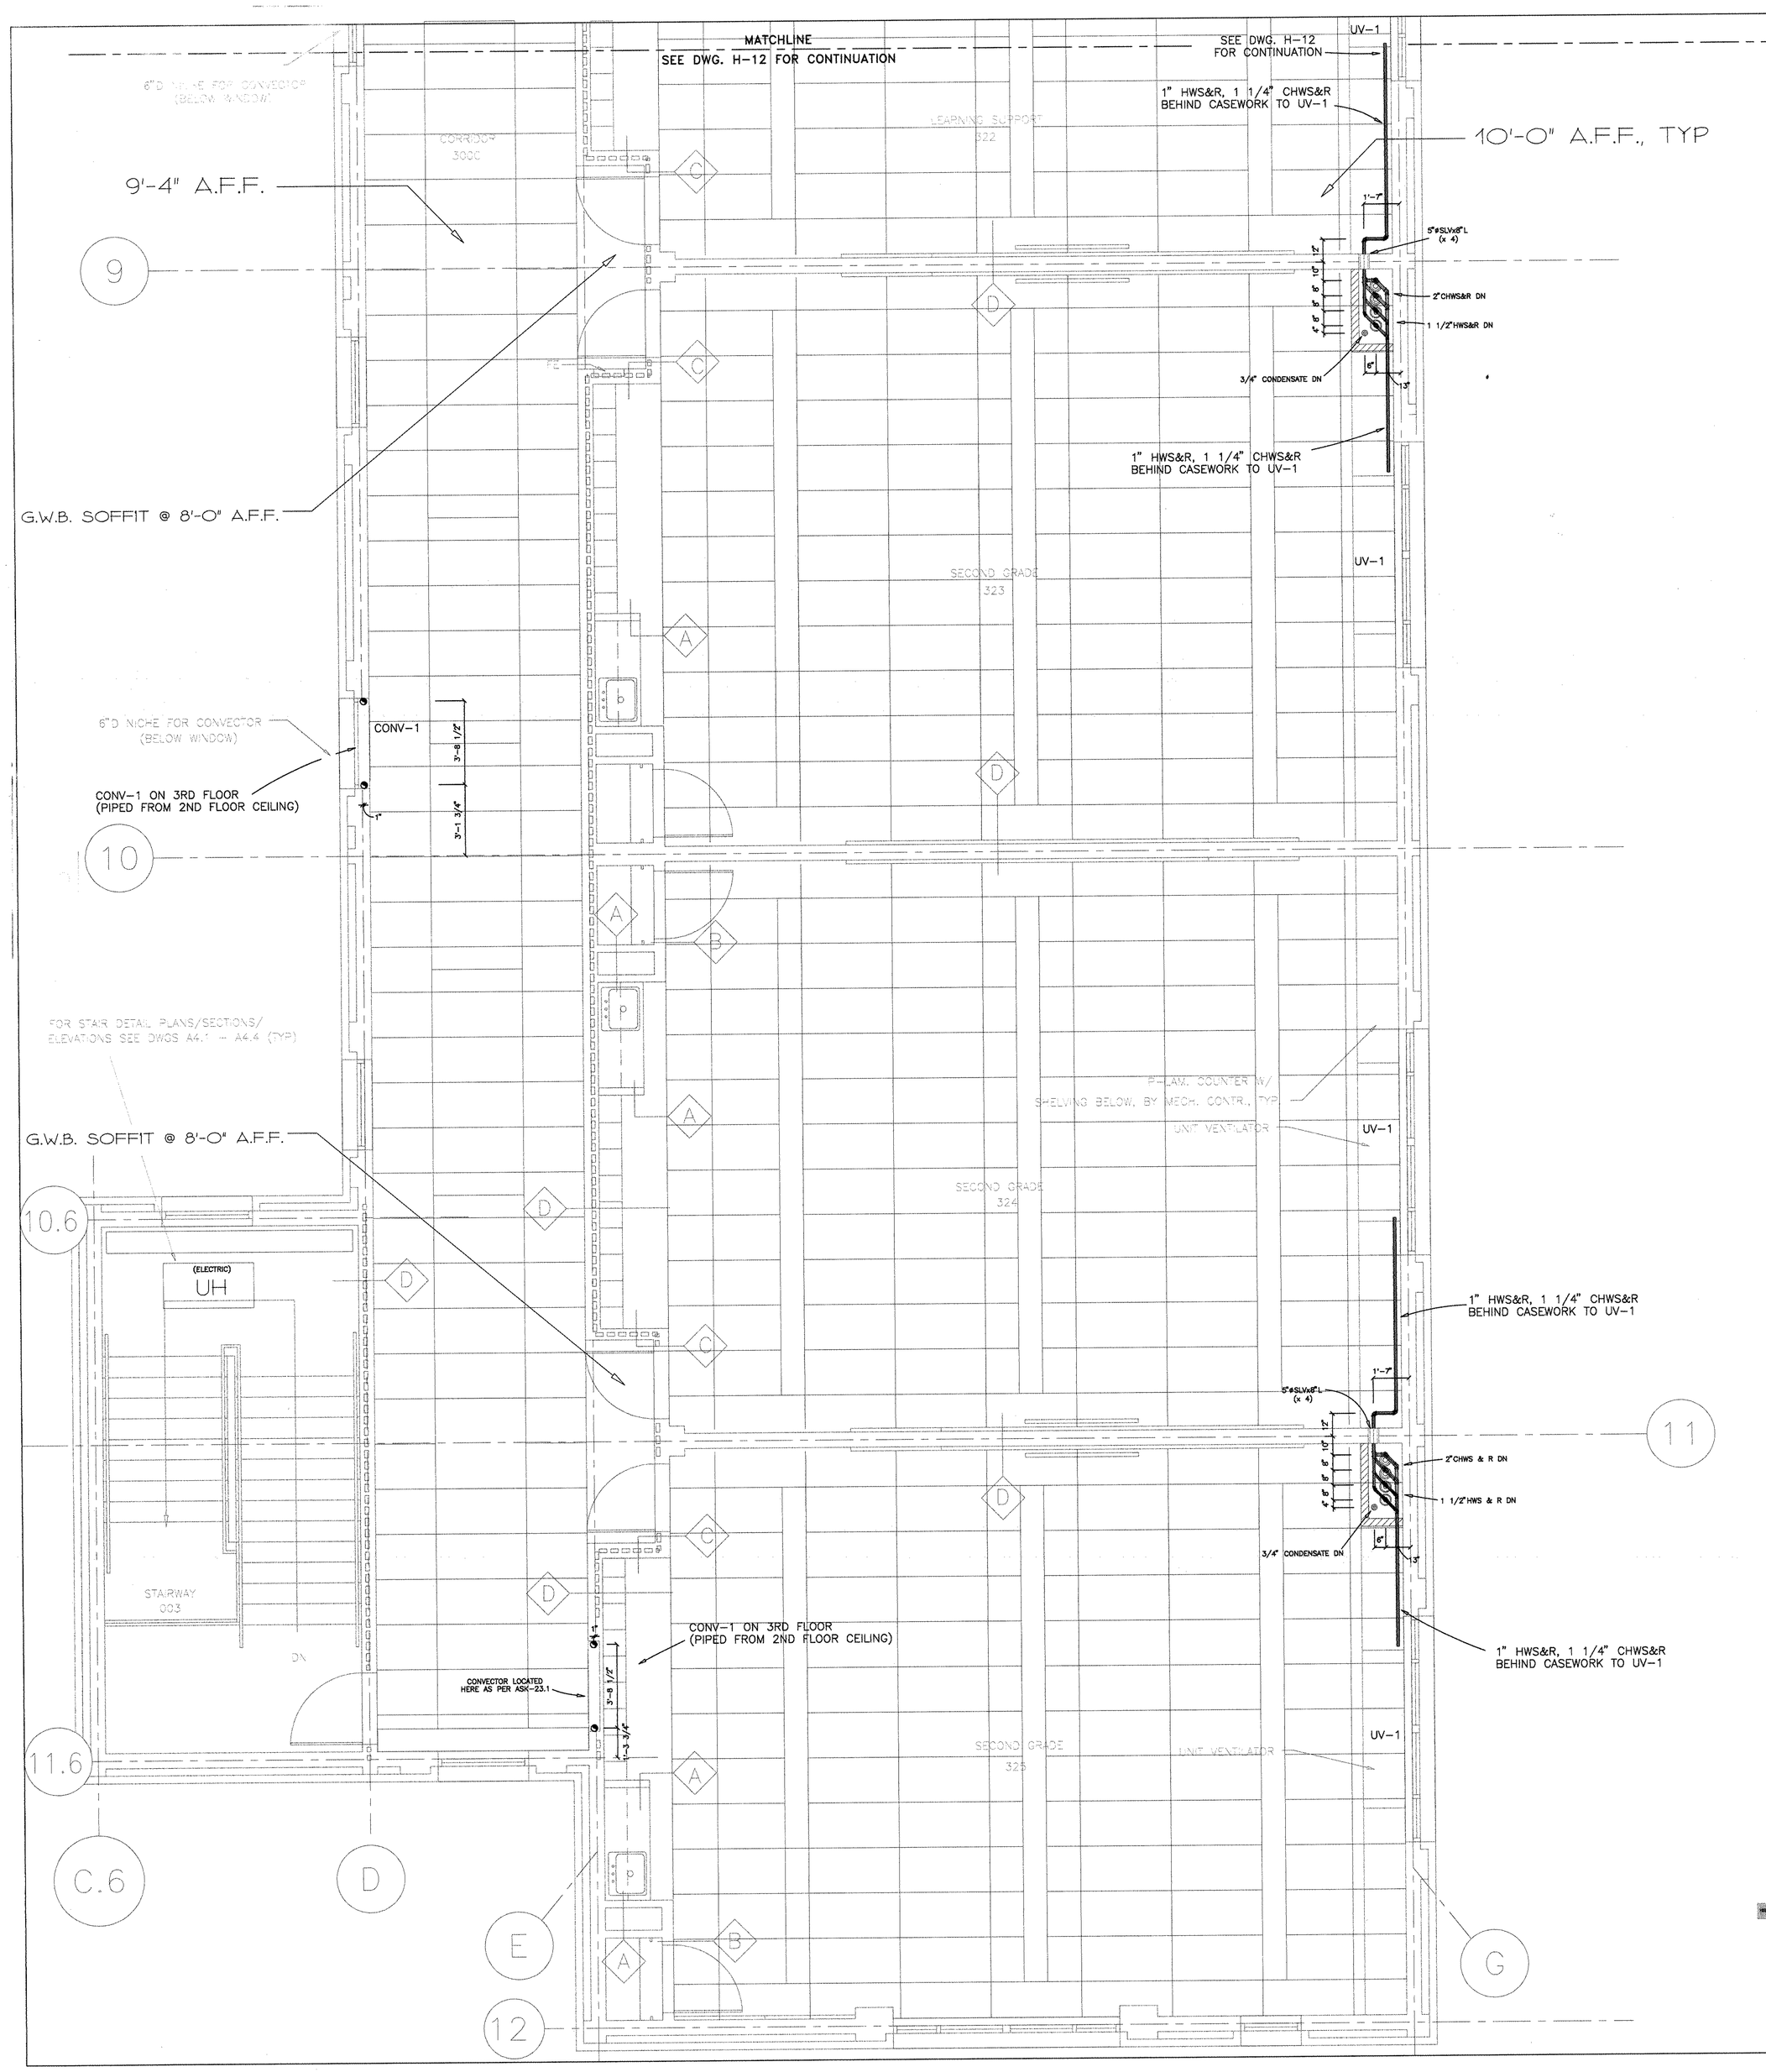

HVAC PIPING NOTES

1. ALL DRAINS ARE 3/4" UNLESS NOTED OTHERWISE
2. ALL VENTS ARE 1/2" UNLESS NOTED OTHERWISE
3. PIPE ELEVATIONS ARE TAKEN FROM 3RD FLOOR FIN. FL.

AS-BUILT

BRINJAC, KAMI... ASSOCIATES, INC.
REVIEW DATE 3/24/98 BY: KWO 3/19/97

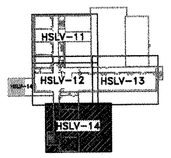

TRACEY MECHANICAL, INC.
401 CITY LINE AVE.
SUITE 212
BALA CYNWYD, PA. 19004

JOB NAME: 6TH AND DUNCANNON

TITLE: PARTIAL 3RD FLOOR HVAC PIPING

NO.	REVISION	DATE	BY

DATE: 10/11/96
SCALE: 3/8"-1'-0"
DRAWN: L.W.

DRAWING NO. H-14