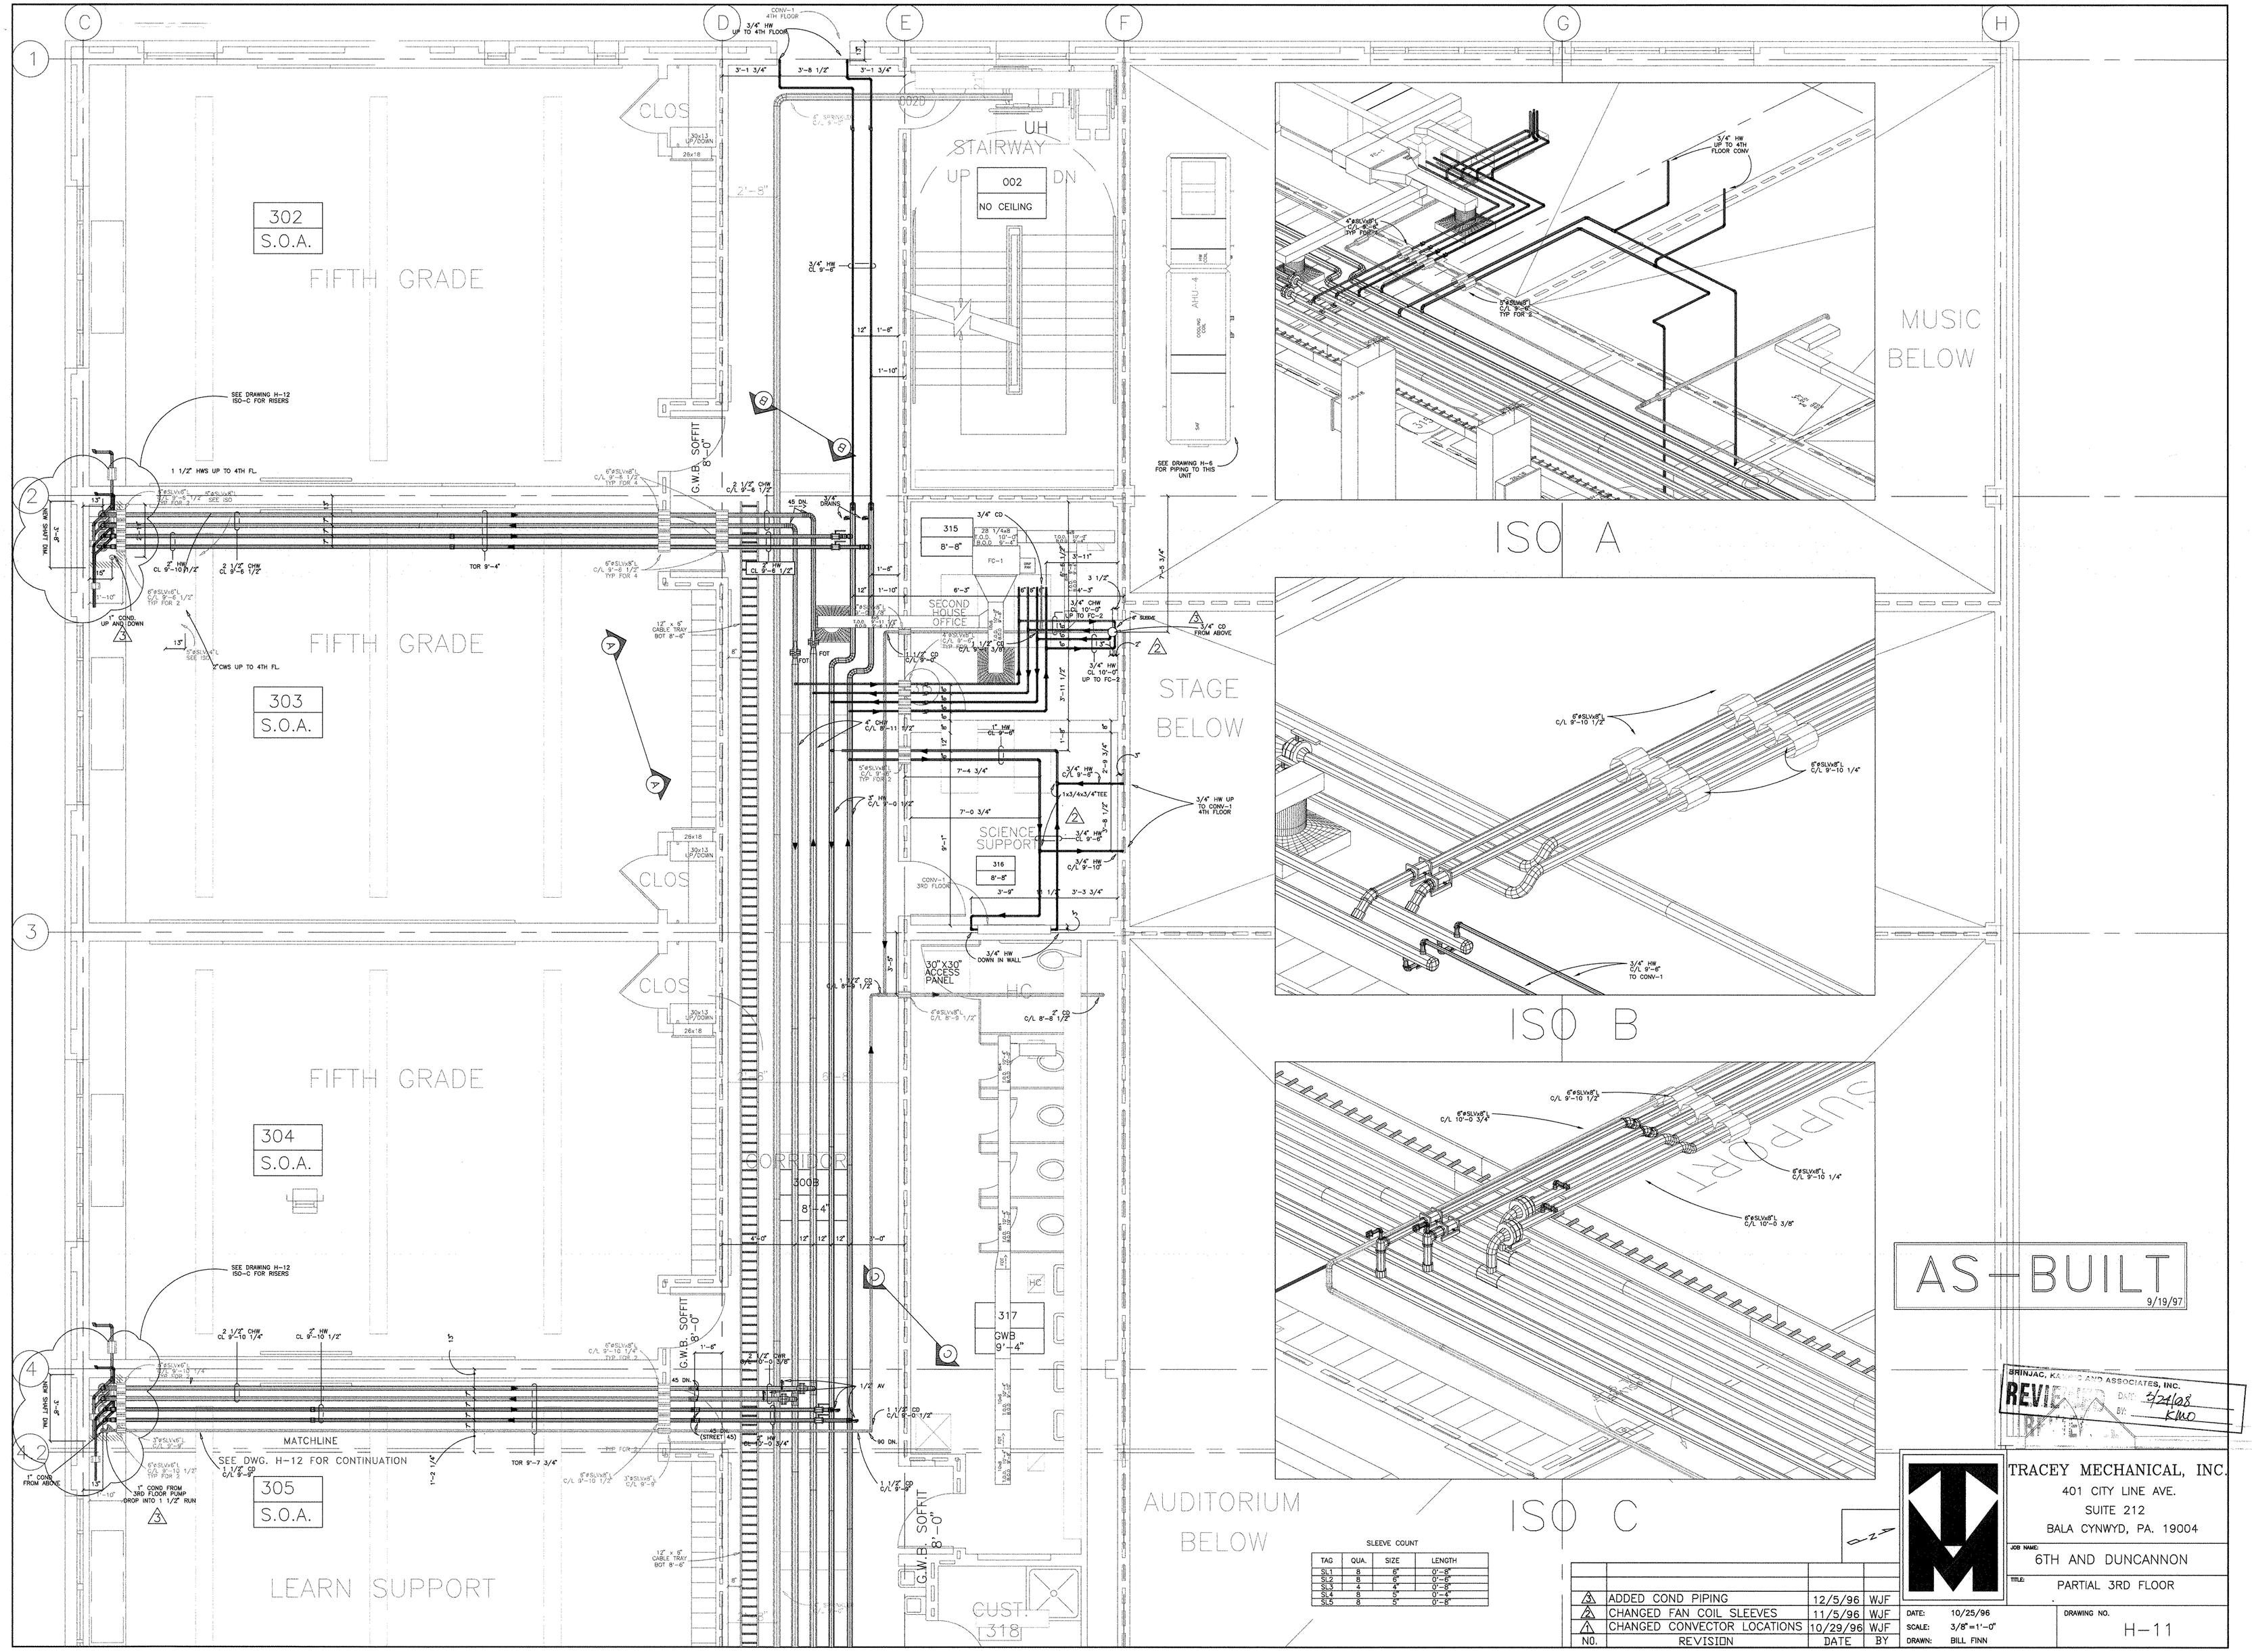

SLEEVE COUNT

TAG	QUA.	SIZE	LENGTH
SL1	8	6"	0'-8"
SL2	8	6"	0'-6"
SL3	4	4"	0'-8"
SL4	8	5"	0'-4"
SL5	8	5"	0'-8"

NO.	REVISION	DATE	BY
3	ADDED COND PIPING	12/5/96	WJF
2	CHANGED FAN COIL SLEEVES	11/5/96	WJF
1	CHANGED CONVECTOR LOCATIONS	10/29/96	WJF

BRINJAC, KA... AND ASSOCIATES, INC.
REVIEWED
DATE: 3/24/98
BY: KMO

TRACEY MECHANICAL, INC.
401 CITY LINE AVE.
SUITE 212
BALA CYNWYD, PA. 19004

JOB NAME: 6TH AND DUNCANNON

TITLE: PARTIAL 3RD FLOOR

DATE: 10/25/96
SCALE: 3/8"=1'-0"
DRAWN: BILL FINN

DRAWING NO. H-11