MATCHLINE
SEE DWG. H-11 FOR CONTINUATION

ISO A

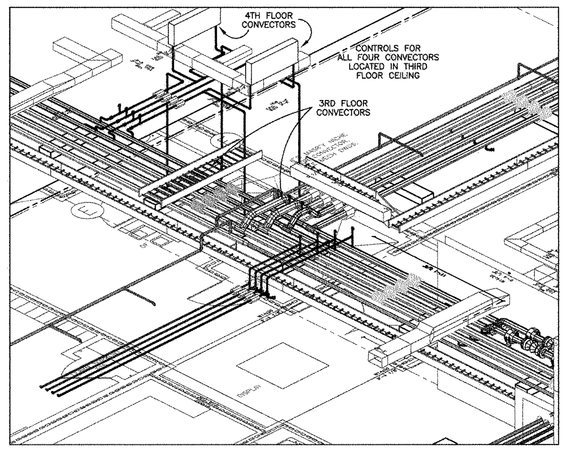

ISO B

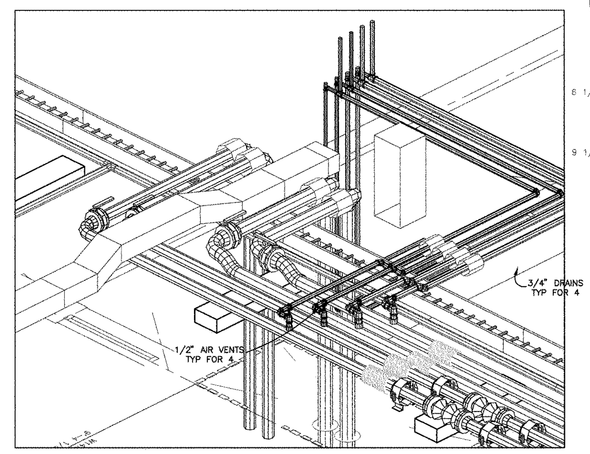

ISO C

NOTES FROM MTG. 10/23/96

CEILING HT. 8'-4"
LIGHTS IN CORRIDOR SURFACE MTD.
SOFFIT @ DRAINS
CABLE TRAY MAY RUN @ CLG.
ASK SHARON TO CHANGE DUCT AS SHOWN

BOTTOM OF BOND BEAM = 9'-10"

BOTTOM OF BOND BEAM = 9'-10"

SEE ISO

SEE ISO

SEE ISO

MATCHLINE
SEE DWG. H-13 FOR CONTINUATION

MATCHLINE
SEE DWG. H-14 FOR CONTINUATION

ROOF BELOW - SEE SHT. A1.0 FOR ROOF PLAN AND PENETRATIONS

THE SUBMITTALS FOR THE UNIT VENTILATORS INDICATE THE CASEWORK TO BE 22" DEEP.

R.W.OLSON
SKETCH #52B,52A
7/29/96

AS-BUILT
9/19/97

BRINJAC, KAMBIC AND ASSOCIATES, INC.
REVIEWED DATE: 3/24/98
BY: LMO

TRACEY MECHANICAL, INC.
401 CITY LINE AVE.
SUITE 212
BALA CYNWYD, PA. 19004

JOB NAME: 6TH AND DUNCANNON

TITLE: PARTIAL 3RD FLOOR HVAC PIPING

DRAWING NO. H-12

DATE: 10/11/96
SCALE: 3/8"=1'-0"
DRAWN: L.W.

NO.	REVISION	DATE	BY
2	MOVED CHW BRANCH 1/2" FOR NITTERHOUSE	11/8/96	L.W.
1	ADDED BRANCH PIPE	11/4/96	WJF

H:\CAD\DWG\H-12 Fri Sep 19 15:39:37 1997