EIGHTH GRADE
402

CLOS

STAIRWAY
002
DN

AUDITORIUM BELOW

EIGHTH GRADE
403

THIRD HOUSE OFFICE
415

ROOF ACC.
416

EIGHTH GRADE
407

CORRIDOR
400B

GIRLS
417

CUST.
418

LEARN SUPPORT
405

4'-7 1/2"
3'-0"
1'-0"
6" STORM BOP 9'-6"
6" STORM BOP 9'-5 5/8"
APPROX. LOCATION OF LIGHT FIXTURE
6" STORM BOP 5'-4 1/4"
6" STORM BOP 9'-2"
6" STORM BOP 9'-3 3/8"
12"xSLV/6"L C/L 9'-6"
5'-4 1/2"
6'-11"
2'-2 1/8"
1'-5 3/8"
6" SANV BOP 9'-3 5/8"
6"xSLV/6"L C/L 9'-6 5/8"
6" SWEEP
4" QUARTER BEND
4" TEST TEE
4" QUARTER BEND
1'-10"
1'-5"
HC
4" SANV BOP 8'-3 3/4"
1'-5"
9 1/2"
6X4" INVERTED SAN CROSS
6" SWEEP
6" EIGHTH BEND FMU
6X4" SAN CROSS
6" EIGHTH BEND
6" INVERTED WYE
4" SANV BOP 8'-3 3/4"
7 1/2"
1'-1 3/8"
6'-4 3/8"
9 5/8"
5'-0 1/2"
3'-0"
3'-0"
3'-0"
3'-2 1/2"
2'-8"
2'-8"
2'-8"
4X1 1/2" TAPPED WYE ON ITS BACK
1 1/2" DWV EIGHTH BEND
1 1/2" DWV SWEEP
1 1/2" DWV ADAPTER
TYPICAL OF FOUR
RUN TRAP PRIMER PIPING UNDER FLOOR FROM FLUSHOMETER TO DRAIN
6" SANV BOP 8'-4 1/8"
4" SANV BOP 8'-2 3/4"
4" QUARTER BEND
4" TEST TEE
4" SAN TEE LOOKING DOWN
4X3" REDUCER
4'-0 1/2"
4'-7"
1'-5"
2'-7"
10"
3" SANV BOP 8'-2 3/4"
3" WYE
3" LONG EIGHTH BEND
3" SWEEP
6'-7 1/2"
1'-3 1/2"
10" 10"
3" SWEEP
3" INVERTED WYE
3" EIGHTH BEND FMU
8'-5"
6'-11"
1'-6"
4'-7 1/2"
6" STORM BOP 9'-2 5/8"
10"xSLV/6 1/2"L C/L 9'-6 1/2"
10"xSLV/6"L C/L 9'-3 5/8"
5"xSLV/6"L C/L 8'-4 1/4"
3" SANV BOP 8'-2 1/2"
6" STORM BOP 9'-3 3/4"

SEE ISOMETRIC VIEW

SEE ISOMETRIC VIEW

SEE ISOMETRIC VIEW

VIEW "A"

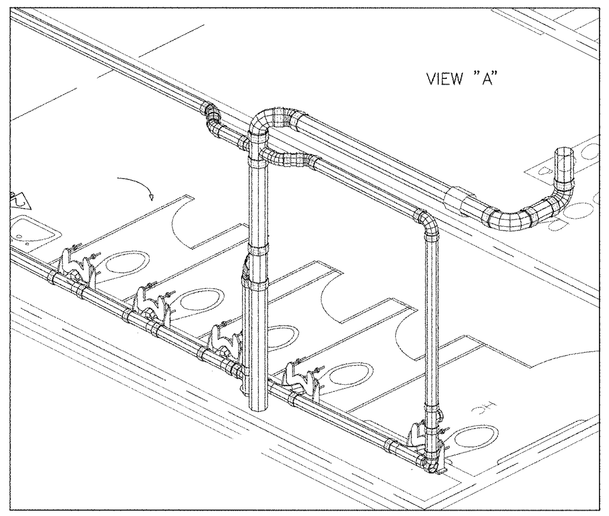

VIEW "B"

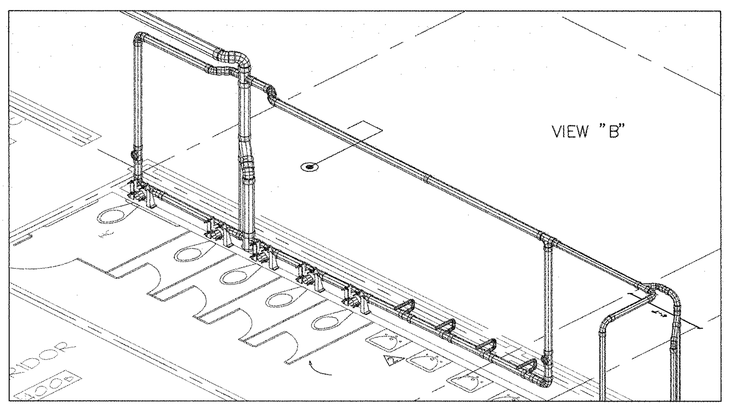

VIEW "C"

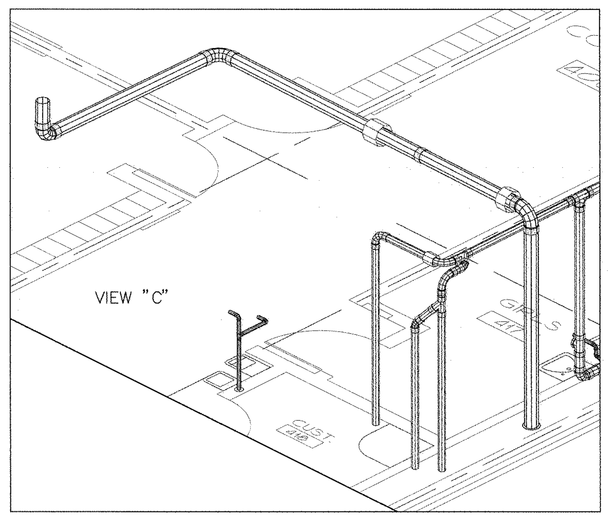

MATCHLINE
SEE DWG. P-16 FOR CONTINUATION

AS-BUILT
9/19/97

BRINJAC, KAMBIC AND ASSOCIATES, INC.
REVIEWED DATE: 3/4/98
BY:

NO.	REVISION	DATE	BY
2	ADDED TRAP PRIMER PIPING	4/7/97	D.G.
1	ROOF DRAINS RELOCATED DUE TO RFI RESPONCE	1-20-97	D.G.

DATE: 11/7/96
SCALE: 3/8" = 1'-0"
DRAWN: D.G.

TRACEY MECHANICAL, INC.
401 CITY LINE AVE.
SUITE 212
BALA CYNWYD, PA. 19004

JOB NAME: 6TH AND DUNCANNON

TITLE: PARTIAL 4TH FLOOR SANITARY & VENTING

DRAWING NO. P-15

H:\CAD\DUNC\P1P-15 Fri Sep 19 13:24:55 1997