C D E F G H

1 2 3 4 4.2

FIFTH GRADE
302

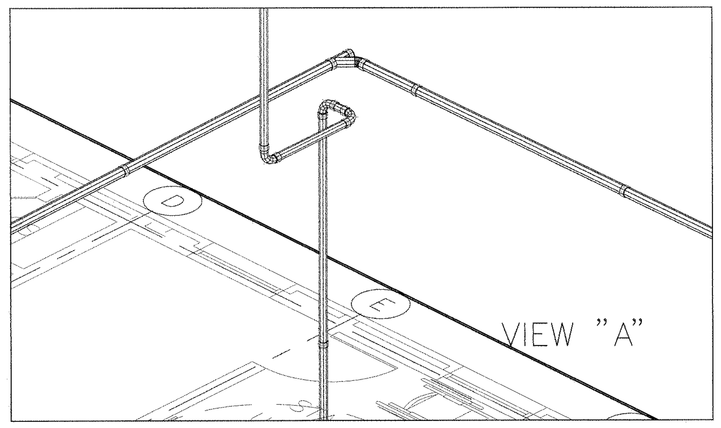

FIFTH GRADE
303

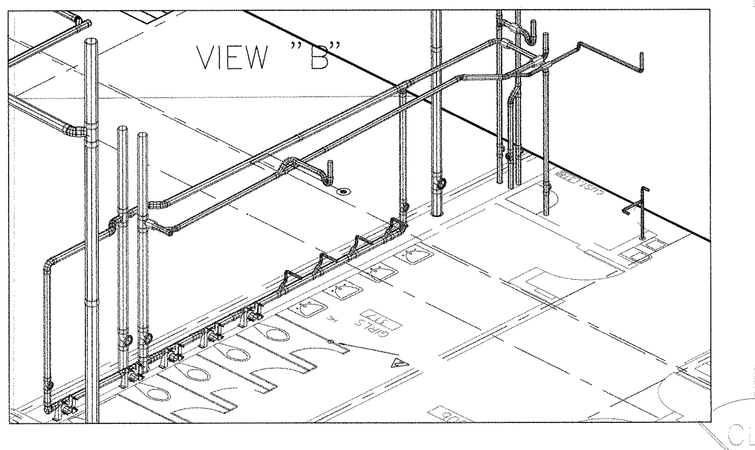

FIFTH GRADE
304

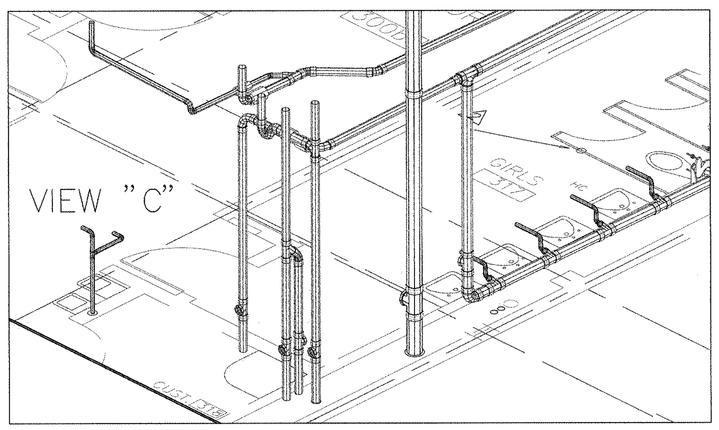

LEARN SUPPORT
305

CLOS

STAIRWAY
UP 002 DN

SECOND
HOUSE
OFFICE
315

316
SCIENCE
SUPPORT

CORRIDOR
306

GIRLS
317

CUST. 318

MUSIC
BELOW

STAGE
BELOW

AUDITORIUM
BELOW

SEE ISOMETRIC VIEW A

SEE ISOMETRIC VIEW B

SEE ISOMETRIC VIEW C

RESPONSE CAD RFI 41
CEILING LOWERED

RUN TRAP PRIMER PIPING UNDER FLOOR FROM FLUSHOMETER TO DRAIN

DIMENSIONS NORTH OF COL LINE F
BASED ON 2ND FL FINISH FLOOR
116'-10" AT HIGHEST POINT

MATCHLINE
SEE DWG. P-14 FOR CONTINUATION

AS-BUILT
9/19/97

BRINJAC, KAMBIC AND ASSOCIATES INC.
REVIEWED DATE: 3/24/98
BY: KMD

TRACEY MECHANICAL, INC.
401 CITY LINE AVE.
SUITE 212
BALA CYNWYD, PA. 19004

JOB NAME:
6TH AND DUNCANNON

TITLE:
PARTIAL 3RD FLOOR
SANITARY & VENTING

NO.	REVISION	DATE	BY
2	ADDED TRAP PRIMER PIPING	4/7/97	D.G.
1	RELOCATE VENT 4'-6" EAST	2/5/97	D.G.

DATE: 10/21/96
SCALE: 3/8" = 1'-0"
DRAWN: D.G.

DRAWING NO.
P-11

H:\CAD\DWG\P\P-11 Fri Sep 19 13:13:44 1997