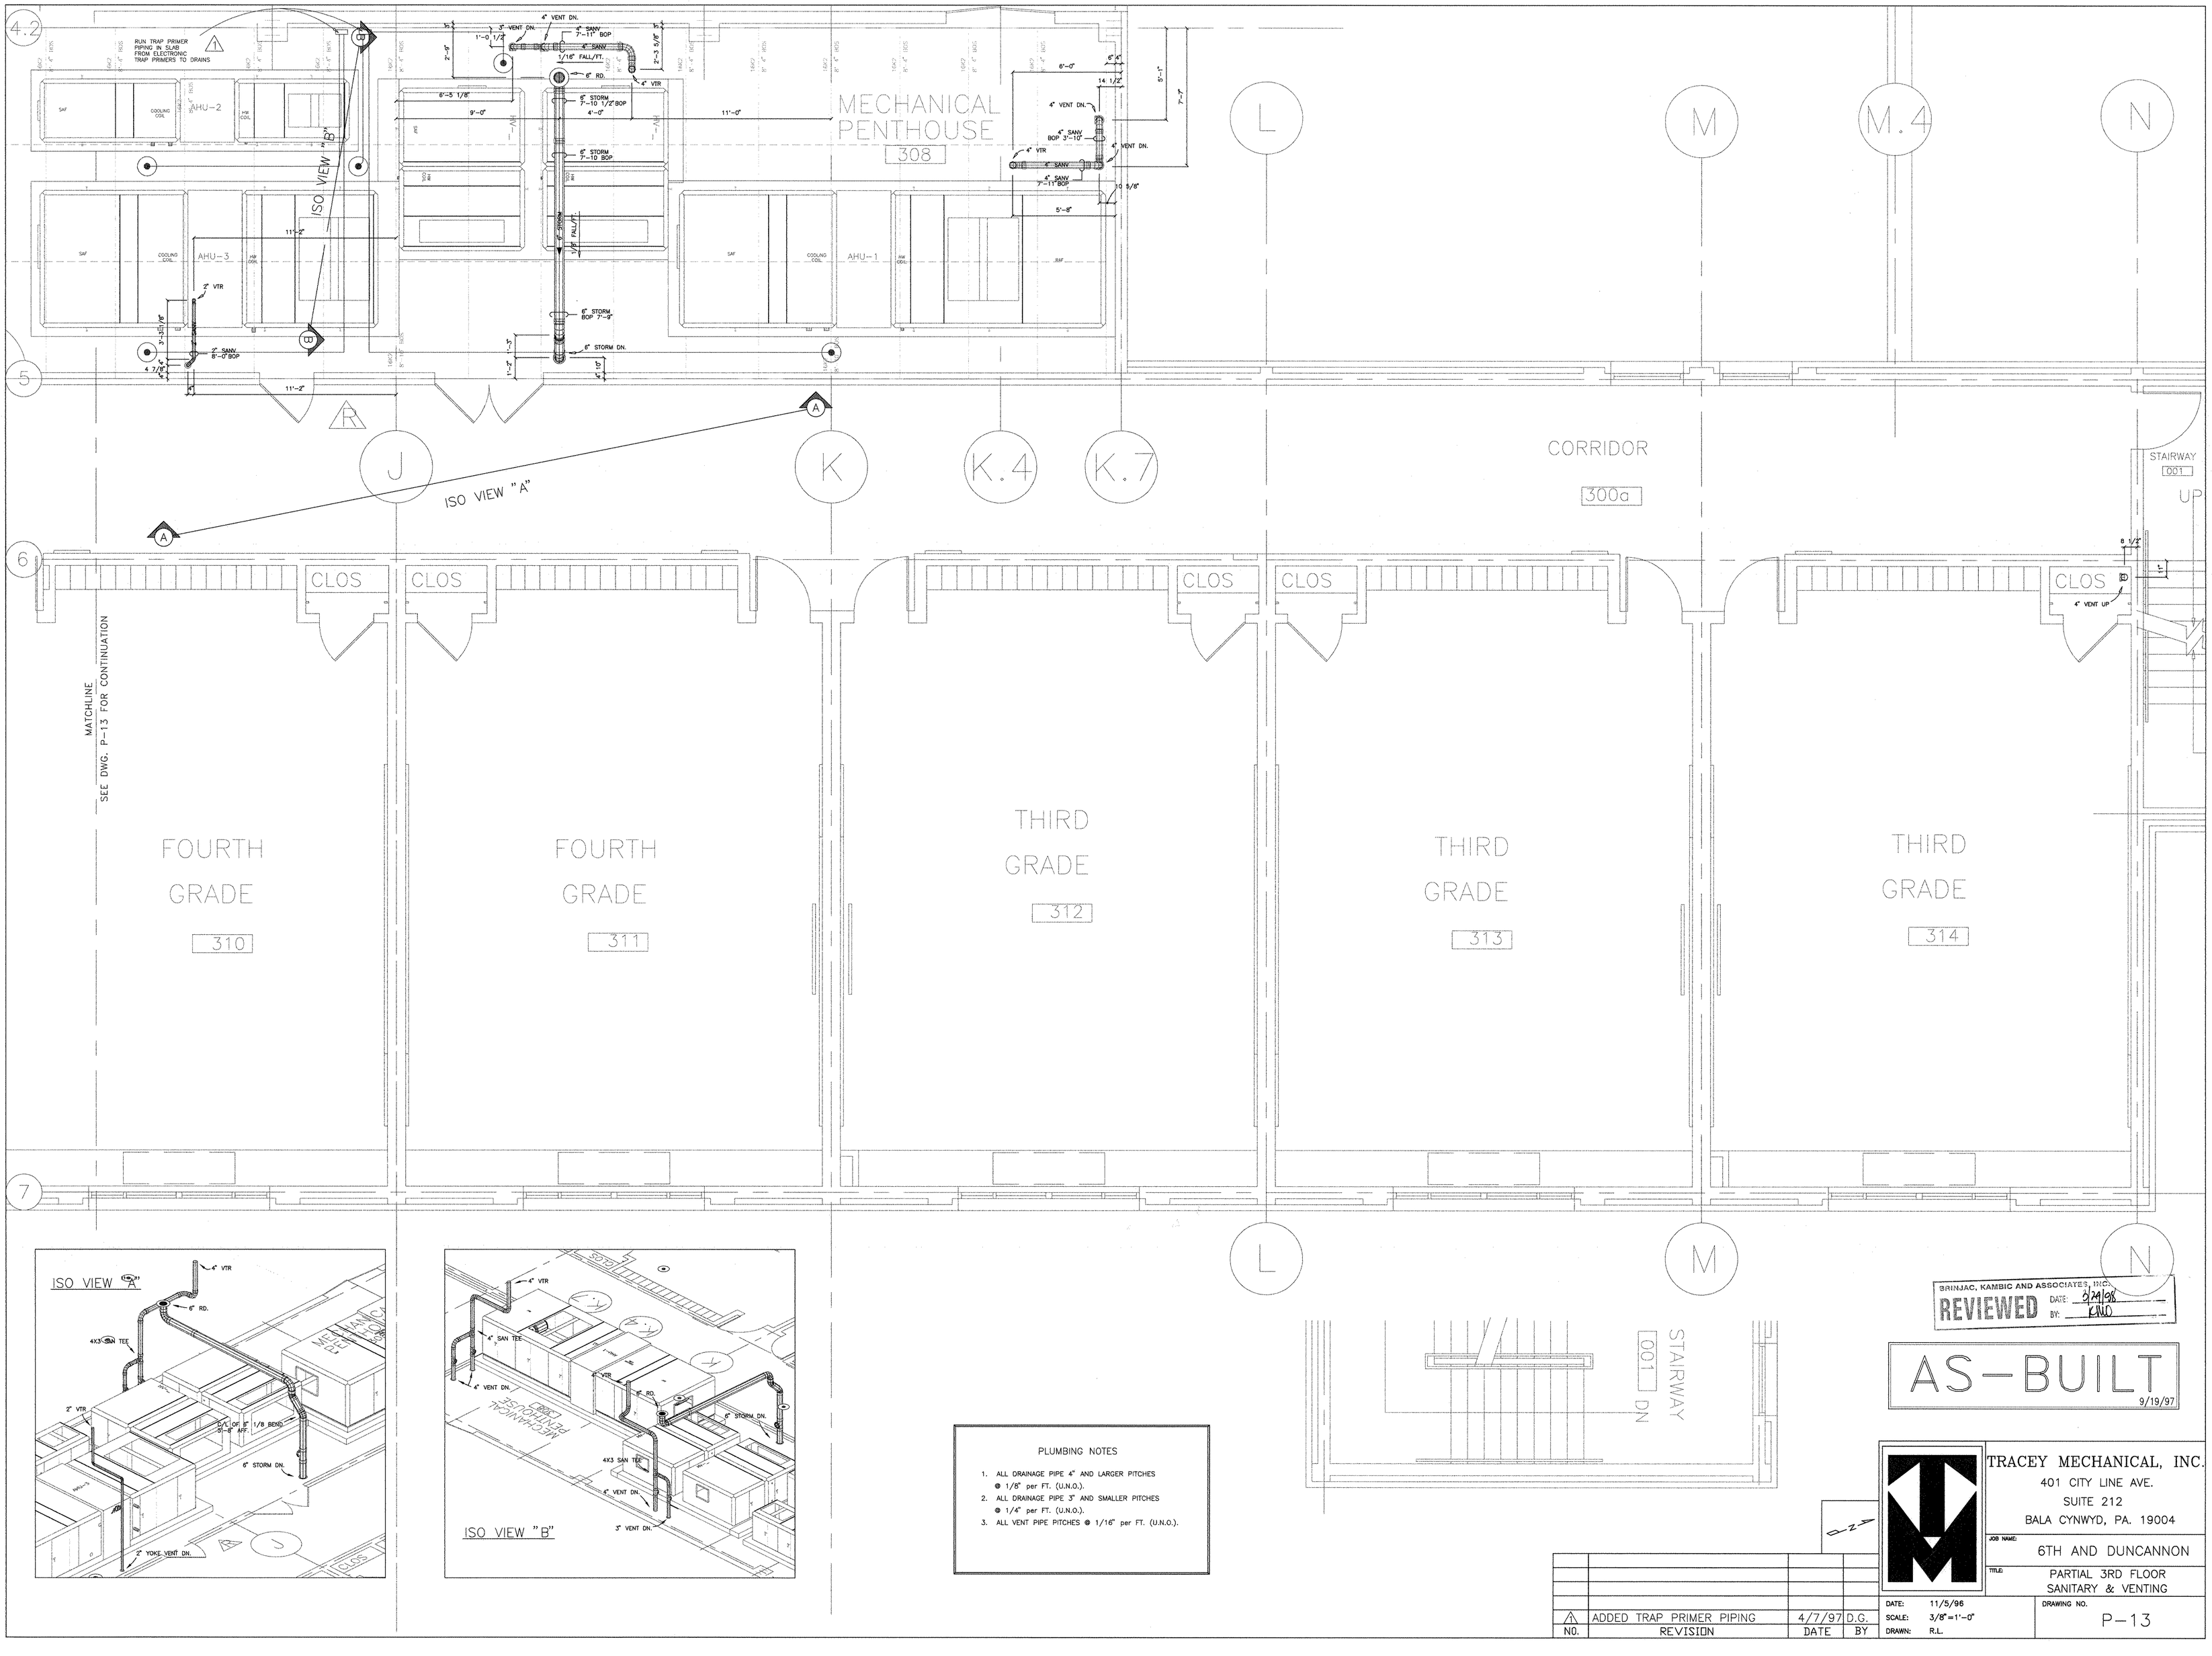

PLUMBING NOTES

1. ALL DRAINAGE PIPE 4" AND LARGER PITCHES @ 1/8" per FT. (U.N.O.).
2. ALL DRAINAGE PIPE 3" AND SMALLER PITCHES @ 1/4" per FT. (U.N.O.).
3. ALL VENT PIPE PITCHES @ 1/16" per FT. (U.N.O.).

SRINJAC, KAMBIC AND ASSOCIATES, INC.
REVIEWED DATE: 9/29/98
BY: KMD

AS-BUILT
9/19/97

TRACEY MECHANICAL, INC.
401 CITY LINE AVE.
SUITE 212
BALA CYNWYD, PA. 19004

JOB NAME: 6TH AND DUNCANNON

TITLE: PARTIAL 3RD FLOOR SANITARY & VENTING

NO.	REVISION	DATE	BY
1	ADDED TRAP PRIMER PIPING	4/7/97	D.G.

DATE: 11/5/96
SCALE: 3/8"=1'-0"
DRAWN: R.L.

DRAWING NO. P-13

M:\CAD\DWG\P\P-13 Fri Sep 19 13:23:05 1997