MATCHLINE
SEE DWG. P-12 FOR CONTINUATION

CORRIDOR
300c

LEARNING SUPPORT
322

SECOND GRADE
323

SECOND GRADE
324

SECOND GRADE
325

STAIRWAY
003

9

10

10.6

11

11.6

C.6

D

E

G

12

SEE ISOMETRIC VIEW (A)

SEE ISOMETRIC VIEW (B)

SEE ISOMETRIC VIEW (C)

1 1/2" DWV SWEEPS

2" DWV TEST TEE
2" DWV EIGHTH BEND
4X2" INVERTED WYE
4" TEST TEE
4X1 1/2" TAPPED SAN TEE
1 1/2" DWV STREET ELL
1 1/2" X MALE ADAPTER
4" INVERTED WYE
4" EIGHTH BEND
4" TEST TEE

1'-7 5/8"
7'-0 3/8"
6'-6 1/2"
1'-6 1/2" 6" 6"

4" QUARTER BEND
4" EIGHTH BEND FMU
8'-0"
8'-6"
6'-6 1/2"

1'-6 1/2" 6" 6"

4" TEST TEE
4" SWEEP
4" COMBO

5X1 1/2" TAPPED SAN TEE
5" TEST TEE
5X2" INVERTED WYE
2" DWV EIGHTH BEND
2" DWV TEST TEE
1 1/2" X MALE ADAPTER
1 1/2" DWV STREET ELL

8"ROOF DRAIN
(IN CEILING)
5'-9"

8"ø SLV w/8"L
C/L 8'-10 3/4"

4" STORM
BOP 8'-8 3/8"

1

1 1/2" DWV SWEEPS

2'-0"
3'-6"
6"ROOF DRAIN
(IN CEILING)
5'-9"
4" STORM
BOP 8'-9 3/4"
11'-6"

2'-6 1/2"
1'-3 3/4"
1'-1"
3'-4"
1'-7 3/4"

8"ø SLV w/8"L
C/L 8'-10 3/4"

4" STORM
BOP 8'-6"

5" DWV TEST TEE
2" DWV EIGHTH BEND
4X2" INVERTED WYE
4" TEST TEE
4X1 1/2" TAPPED SAN TEE
1 1/2" DWV STREET ELL
1 1/2" X MALE ADAPTER

8"ø SLV w/4 1/8"L
C/L 8'-10 1/8"

1 1/2" DWV SWEEPS

1'-6 1/2" 6" 6"

4" TEST TEE
4" SWEEP

8'-6 1/2"

VIEW "A"

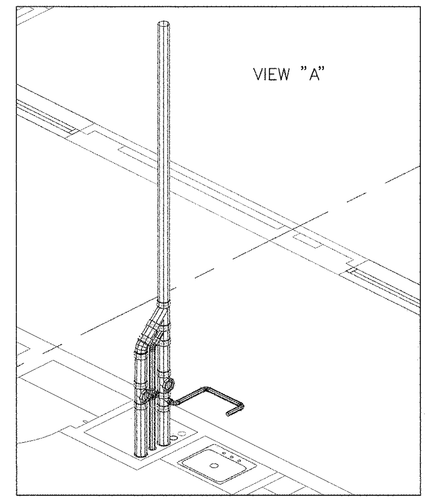

VIEW "B"

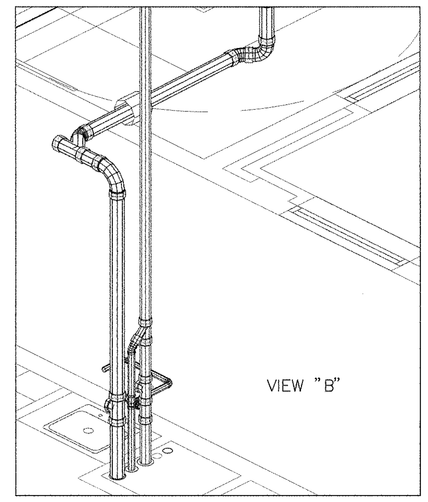

VIEW "C"

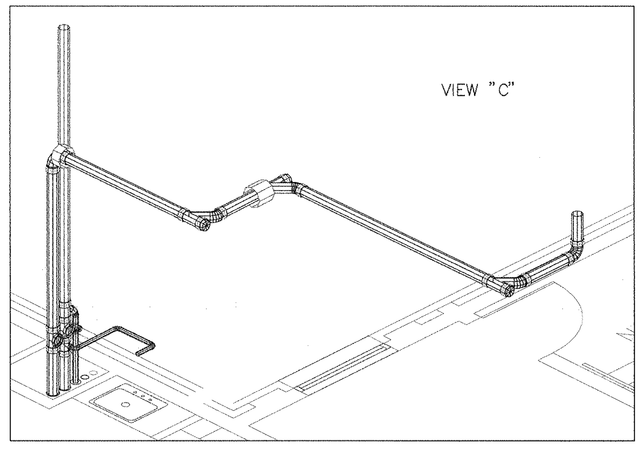

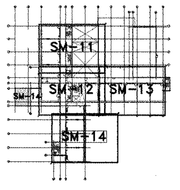

BRINJAC, KAMBIC AND ASSOCIATES, INC.
REVIEWED DATE: 9/21/06
BY: KMC

AS-BUILT
9/19/97

NO.	REVISION	DATE	BY
1	ADDED ELEVATION PER RFI RESPONCE	12-24-96	D.G.

TRACEY MECHANICAL, INC.
401 CITY LINE AVE.
SUITE 212
BALA CYNWYD, PA. 19004

JOB NAME: 6TH AND DUNCANNON

TITLE: PARTIAL 3RD FLOOR SANITARY & VENTING

DATE: 11/4/96
SCALE: 3/8" = 1'-0"
DRAWN: D.G.

DRAWING NO. P-14

K:\CAD\DWG\P\P-14 Fri Sep 19 13:23:58 1997