SEE DWG. P-3 FOR CONTINUATION

MATCHLINE

RAMP DOWN 1:12

KINDERGARTEN 122

CORRIDOR 100B

KINDERGARTEN 123

KINDERGARTEN 124

KINDERGARTEN 125

STAIRWAY 003

HEAD START CLASSROOM 128

HEAD START CLASSROOM 127

CORRIDOR 100D

SEE DWG. P-3 FOR CONTINUATION

SEE ISOMETRIC VIEW

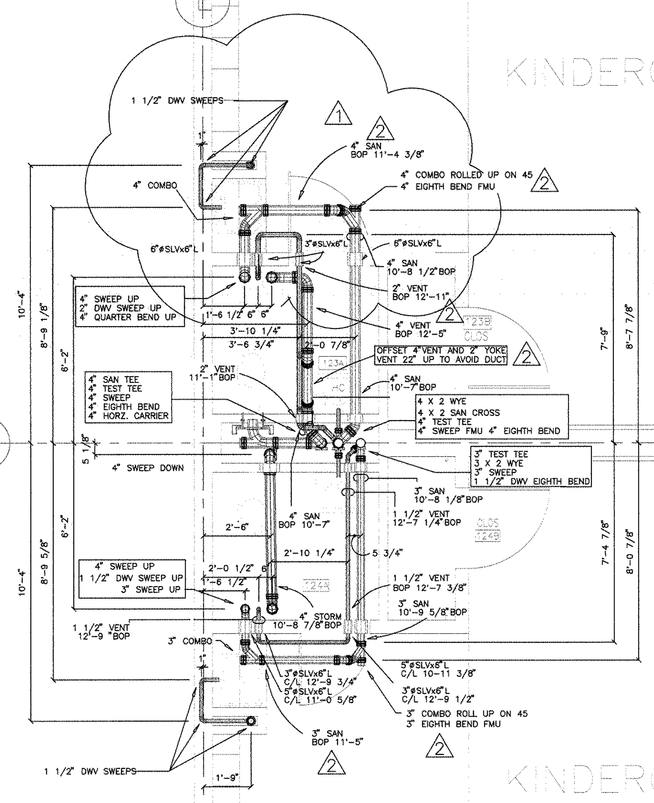

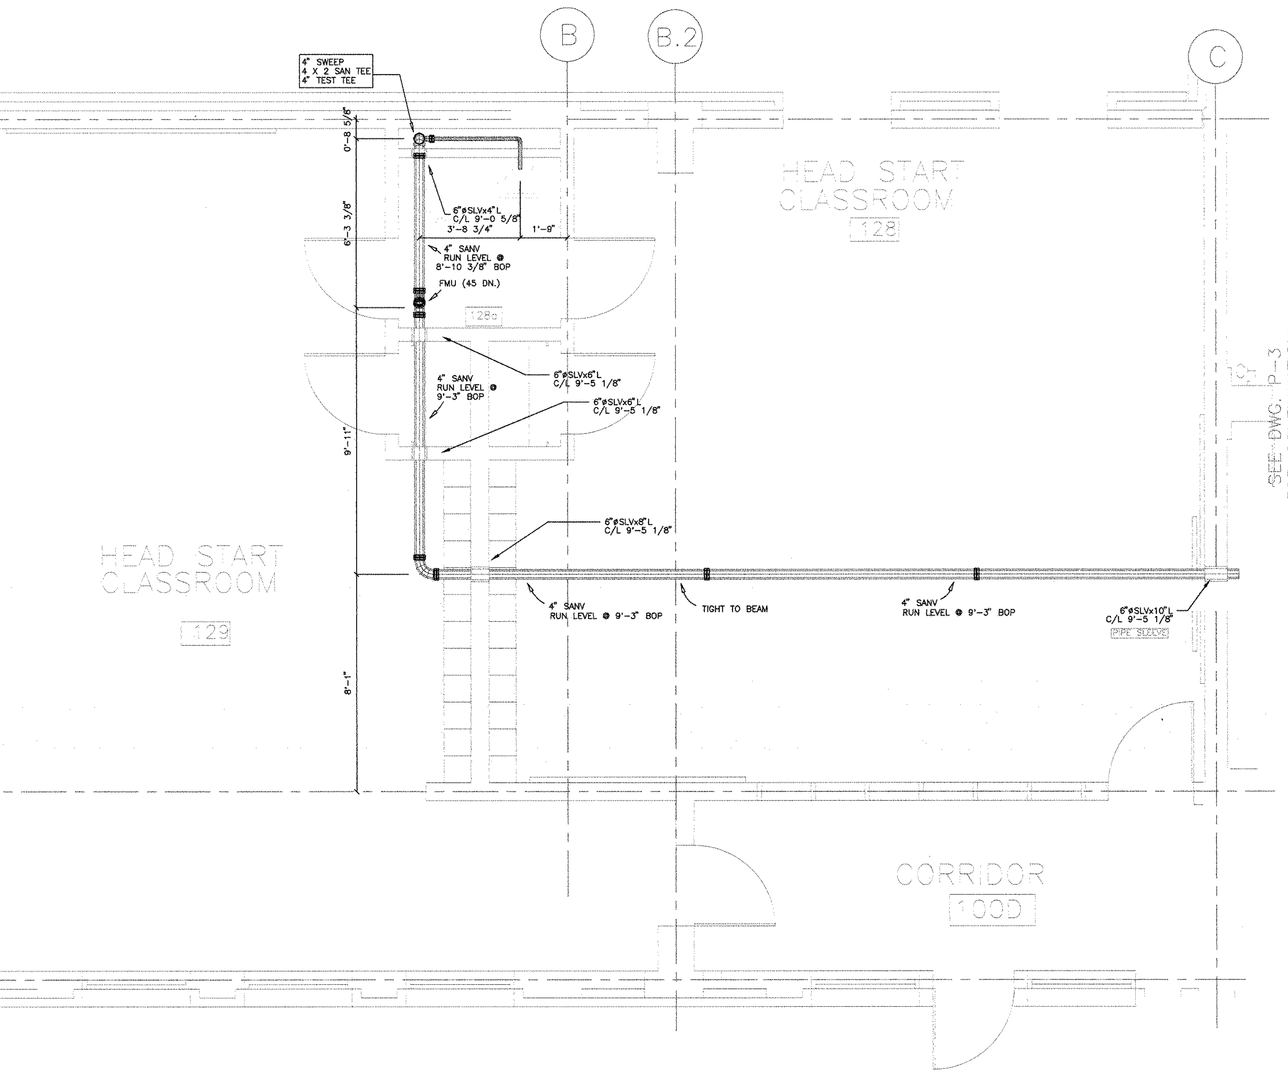

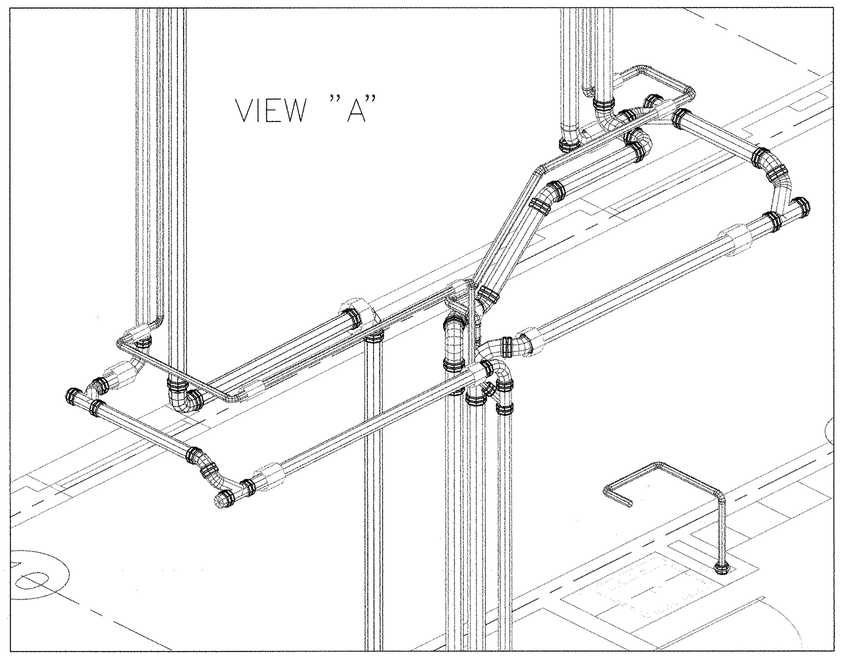

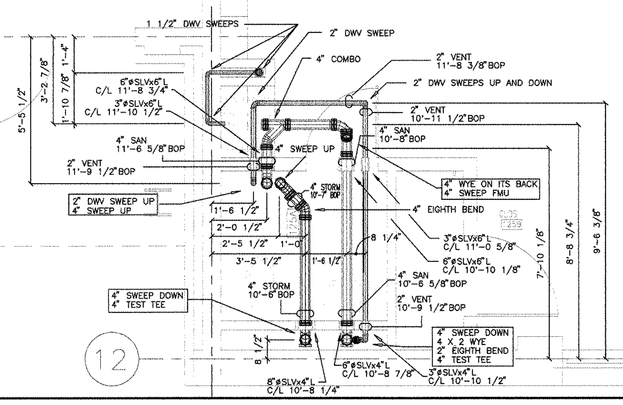

AS-BUILT 9/19/97

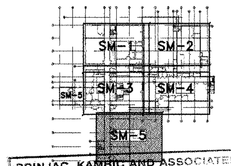

BRINJAC, KAMBIC AND ASSOCIATES, INC.
REVIEWED DATE: 3/24/98
BY: KMD

NO.	REVISION	DATE	BY
2	CHANGED VENT & SANITARY ELEV.	11/20/96	D.G.
1	MOVED VENT & SANITARY LOCATIONS	9/30/96	D.G.
1	FIELD ISSUE	9/16/96	D.G.

DATE: 8-19-96
SCALE: 3/8" = 1'-0"
DRAWN: D.G.

TRACEY MECHANICAL, INC.
401 CITY LINE AVE.
SUITE 212
BALA CYNWYD, PA. 19004

JOB NAME: 6TH AND DUNCANNON

TITLE: PARTIAL 1ST FLOOR SANITARY & VENTING

DRAWING NO. P-5

R:\CAD\DWG\PUP-5 Fri Sep 19 15:18:34 1997