

**THE SCHOOL DISTRICT OF PHILADELPHIA
Office of Capital Programs
440 North Broad Street, 3rd Floor – Suite 371
Philadelphia, PA 19130**

TELEPHONE: (215) 400-4730

Addendum No. 005

**Subject: 2020 Classroom Modernizations
SDP Contract Numbers: B-007 C of 19/20 & B-009 C of 19/20**

**Location: George Sharswood School
2300 S. 2nd St, Philadelphia PA 19148**

This Addendum, dated March 06, 2020, shall modify and become part of the Contract Documents for the work of this project. Any items not mentioned herein, or affected by, shall be performed strictly in accordance with the original documents.

GENERAL

CLARIFICATION – Any/all scope dictated in the Asbestos Inspection Report specification and/or the Paint and Plaster specification (where applicable) shall utilize the proposed finishes as indicated on the Color Scheme Schedule within the Classroom Modernization drawings. All color selections and locations shall be approved by the architect.

ARCHITECTURAL DRAWINGS

DRAWING D1.1 – OVERALL FIRST FLOOR DEMOLITION PLAN

1. REVISED demolition note 8A to read “Existing wood trim throughout entire room including, but not limited to base, door, crown molding, window trim and intermittent wood mullions, shall be stripped of any nails, staples, tape, and etc. sand and patch any penetrations and prepare to receive new finish as scheduled.”

DRAWING D1.2 – OVERALL SECOND FLOOR DEMOLITION PLAN

1. REVISED demolition note 8A to read “Existing wood trim throughout entire room including, but not limited to base, door, crown molding, window trim and intermittent wood mullions, shall be stripped of any nails, staples, tape, and etc. sand and patch any penetrations and prepare to receive new finish as scheduled.”

ELECTRICAL DRAWINGS

DRAWING E2.1 - ELECTRICAL FIRST FLOOR POWER AND TECHNOLOGY PLAN

1. REVISE data outlet locations and scope as indicated on the drawings.

DRAWING E2.2 - ELECTRICAL SECOND FLOOR POWER AND TECHNOLOGY PLAN

1. REVISE data outlet locations and scope as indicated on the drawings.

DRAWING E7.1 - ELECTRICAL DETAILS

1. REVISE 3/E7.1 Typical Classroom Lighting Controller diagram as indicated on the drawings.

ATTACHMENTS

DRAWINGS

| | |
|--------------|---------------------------------------------------|
| DRAWING E2.1 | ELECTRICAL FIRST FLOOR POWER AND TECHNOLOGY PLAN |
| DRAWING E2.2 | ELECTRICAL SECOND FLOOR POWER AND TECHNOLOGY PLAN |
| DRAWING E7.1 | ELECTRICAL DETAILS |

END OF ADDENDUM #005

SEAL:



CONRAD DELACRUZ
STATE AND LICENSE NO. PE09048

ARCHITECT

CRABTREE, ROHRBAUGH & ASSOCIATES
401 E. Winding Hill Road
Mechanicsburg, PA 17055
Phone: 717-458-0272

Email: jharder@cra-architects.com
Attn: Jessie Harder

M/E/P ENGINEERS

SETTY
575 South Charles Street, Suite 403
Baltimore, MD 21201
Phone: 667-309-6036


Email: deepak.at@setty.com
Attn: Deepak Ajmane

GENERAL SHEET NOTES

- REFER TO DRAWING E01 FOR ELECTRICAL GENERAL NOTES, LEGEND AND ABBREVIATIONS.
- REFER TO ARCHITECTURAL DRAWINGS, ELEVATION & DETAILS FOR EXACT LOCATION OF ELECTRICAL DEVICES.
- ALL RECEPTACLES, TELEDATA OUTLETS WITH ASSOCIATED WIRING, CONDUIT, RACEWAYS, ETC SHALL BE SURFACE MOUNTED ON EXISTING WALLS AND FLUSH MOUNTED ON NEW WALLS. REFER TO ARCHITECTURAL DRAWINGS FOR WALL TYPES.
- ALL THE RECEPTACLES AND DATA OUTLETS WITHIN THE SCOPE OF WORK AREAS THAT ARE EXISTING TO REMAIN SHALL BE PROVIDED WITH NEW DEVICES. NEW DEVICE COLOR SHALL BE WHITE.
- ALL NEW 15- AND 20-AMPERE, 125- AND 250-VOLT NON-LOCKING TYPE RECEPTACLES SHALL BE TAMPER RESISTANT AS PER NEC 408.12.
- ELECTRICAL CONTRACTOR TO RUN ALL NEW SURFACE MOUNTED CONDUITS AND RACEWAYS IN CORNERS OF EACH CLASSROOM TO AVOID CONFLICT WITH DISPLAY BOARDS AND OTHER CLASSROOM FURNISHINGS.

KEYED SHEET NOTES

- NEW LOCATION OF PA SPEAKER. COORDINATE IN FIELD FOR EXACT LOCATION AND IF REQUIRE EXTEND WIRING/CONDUIT TO NEW PA SPEAKER LOCATION.
- PROVIDE NEW TAMPER RESISTANT DEDICATED DUPLEX RECEPTACLE FOR LAPTOP CART CHARGING STATION.
- PROVIDE NEW BATTERY OPERATED WIRELESS CLOCK. COORDINATE WITH ARCHITECT FOR EXACT MOUNTING HEIGHT.
- CONTRACTOR TO FIELD TEST FUNCTIONALITY OF EXISTING TELEPHONE OUTLETS AND REPLACE AS REQUIRED. NEW TO MATCH EXISTING IN KIND MAKE AND TYPE.
- NEW PANELBOARD 'A'. CONTRACTOR TO UTILIZE, INTERCEPT AND EXTEND ALL ACTIVE FEEDER AND BRANCH CIRCUIT WIRING/CONDUIT OF SAME SIZE VIA NEW JUNCTION BOX OR PULL BOX AND CONNECT IT TO THE NEW PANELBOARD.
- NEW PANELBOARD 'B'. CONTRACTOR TO UTILIZE, INTERCEPT AND EXTEND ALL ACTIVE FEEDER AND BRANCH CIRCUIT WIRING/CONDUIT OF SAME SIZE VIA NEW JUNCTION BOX OR PULL BOX AND CONNECT IT TO THE NEW PANELBOARD.
- NEW PANELBOARD 'C'. CONTRACTOR TO UTILIZE, INTERCEPT AND EXTEND ALL ACTIVE FEEDER AND BRANCH CIRCUIT WIRING/CONDUIT OF SAME SIZE VIA NEW JUNCTION BOX OR PULL BOX AND CONNECT IT TO THE NEW PANELBOARD.
- CONTRACTOR TO COORDINATE IN FIELD FOR EXACT LOCATION OF RECEPTACLE AND DATA OUTLET SERVING THE INTERACTIVE SMARTBOARD TO AVOID CONFLICT WITH BASE PLATE. REFER TO ARCHITECTURAL DRAWING AS 1 DETAIL #1 AND #2 FOR EXACT LOCATION AND MOUNTING HEIGHT.

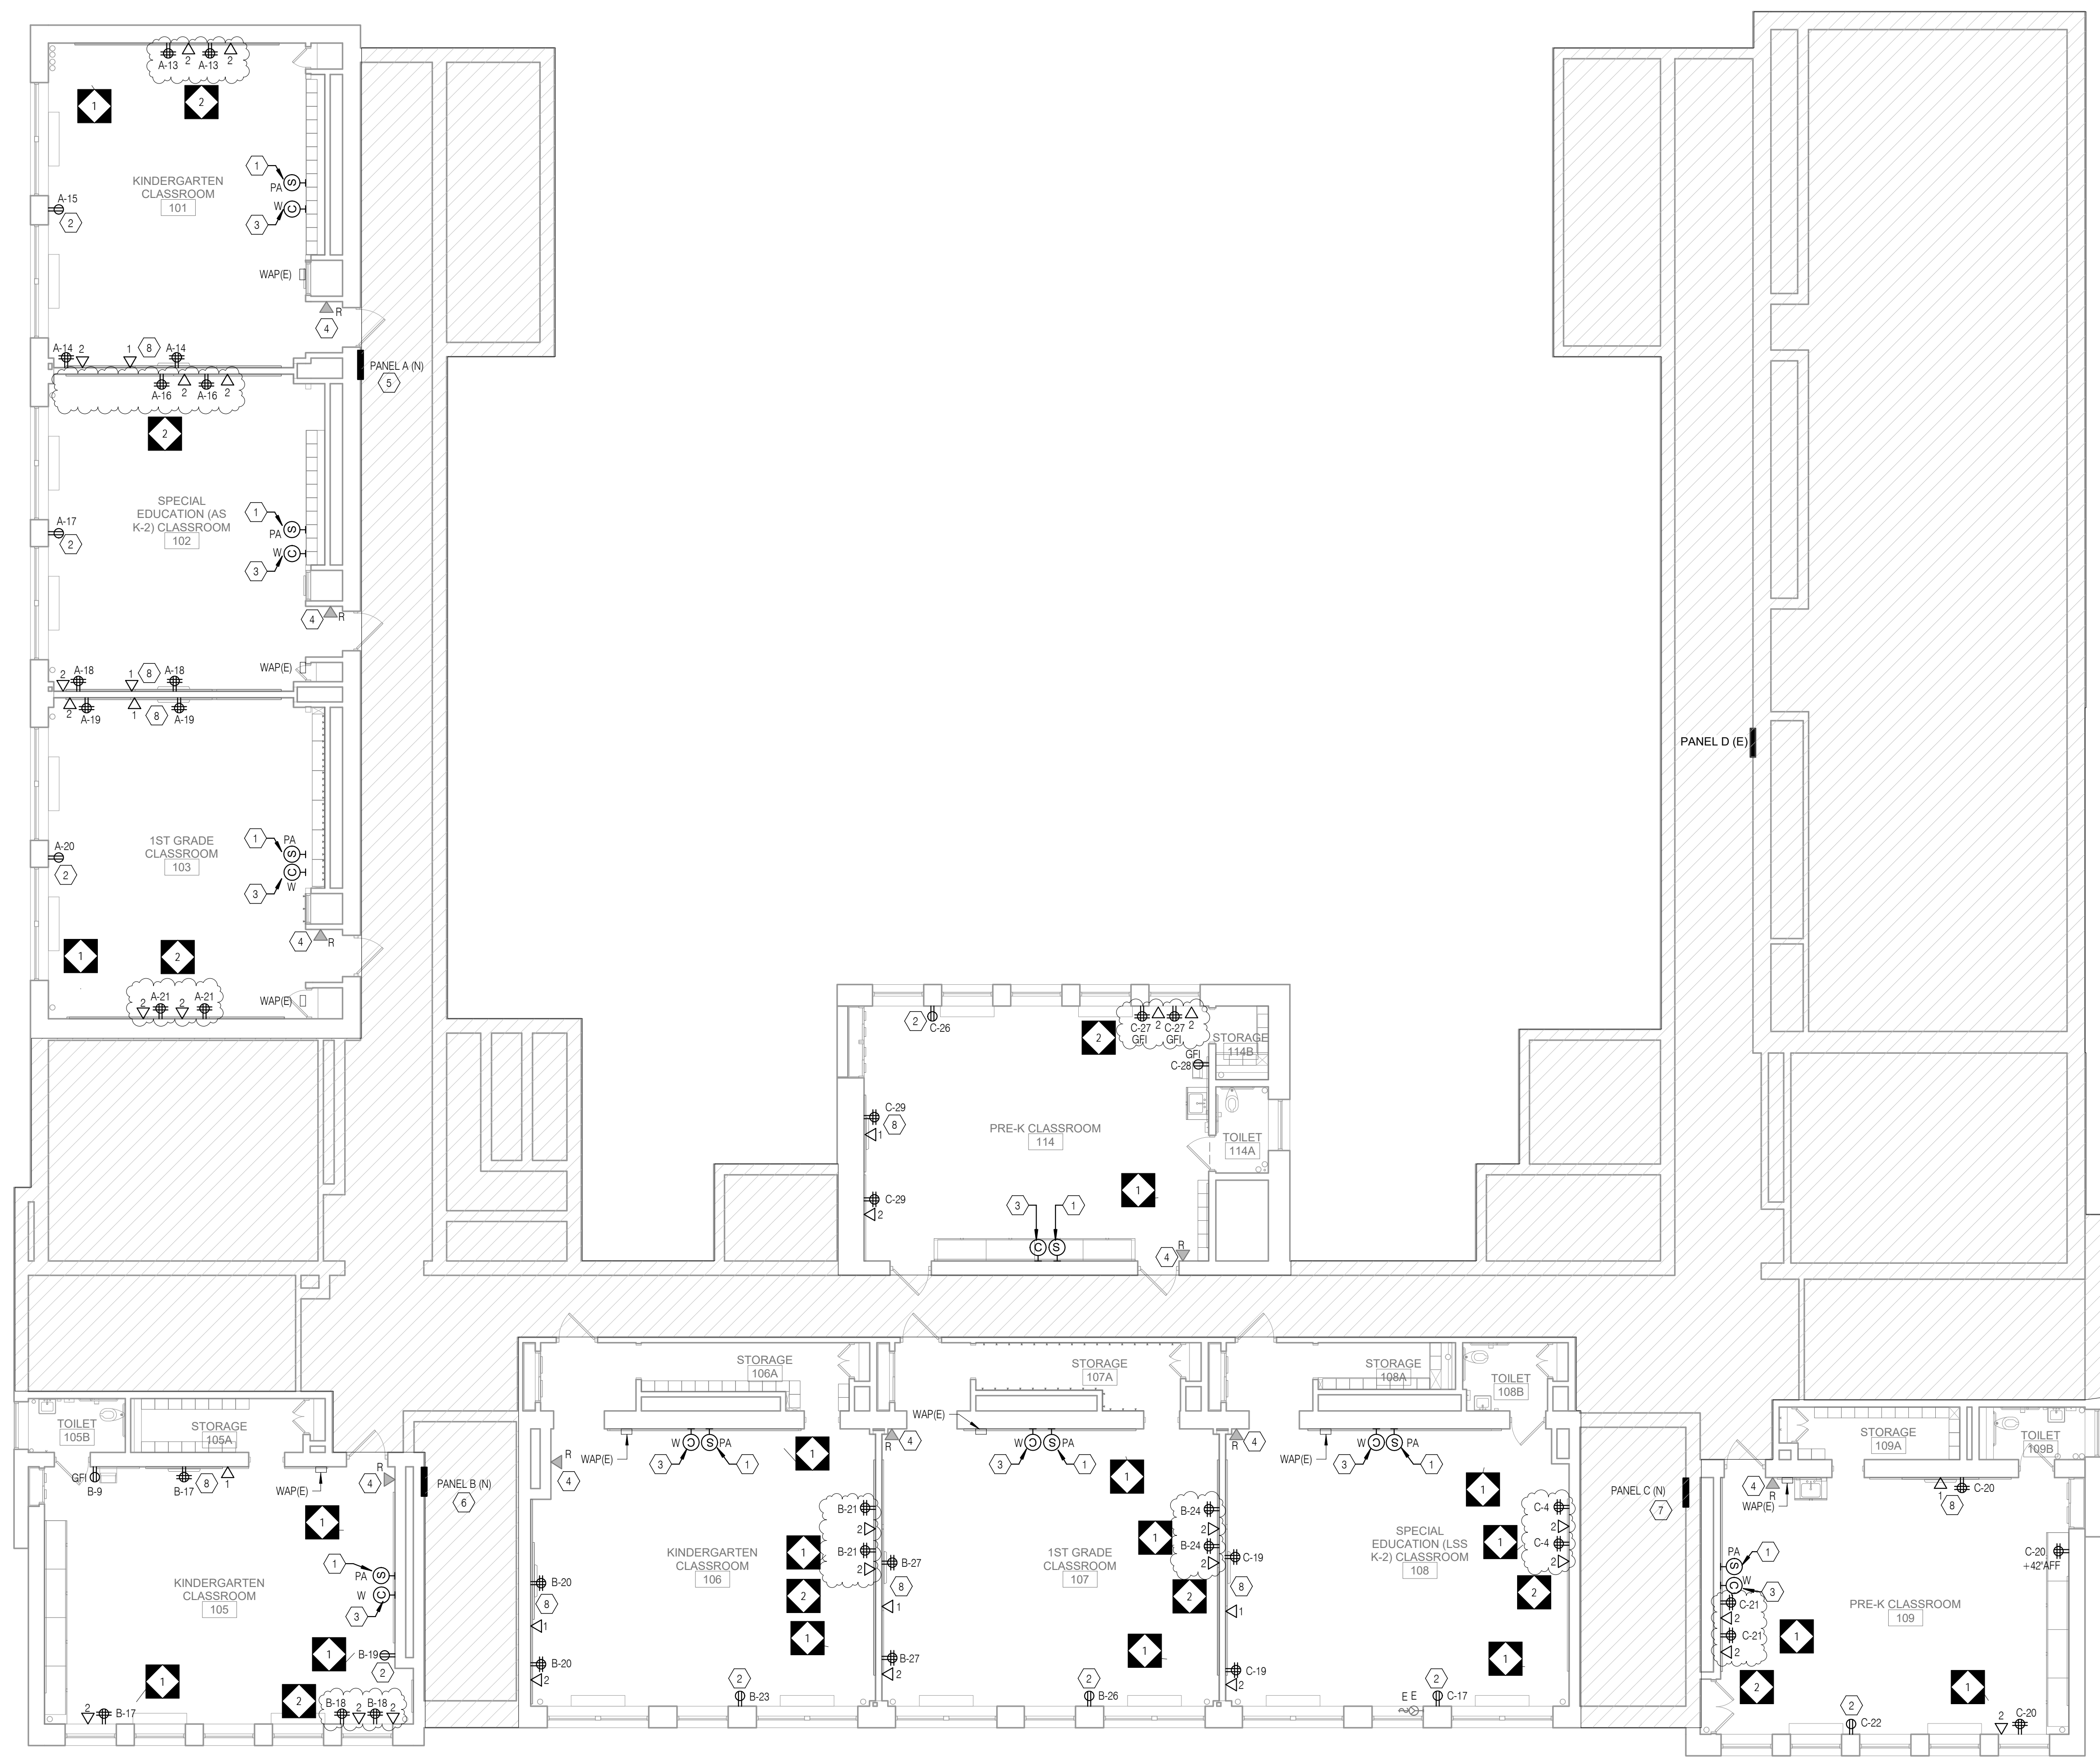

1 ELECTRICAL FIRST FLOOR POWER PLAN
E2.1 1/8" = 1'-0"

100% DESIGN SUBMISSION
1/22/2020

| 10 | | |
|-----|------------|-------------|
| 9 | | |
| 8 | | |
| 7 | | |
| 6 | | |
| 5 | | |
| 4 | | |
| 3 | | |
| 2 | 02/27/2020 | ADDENDUM #2 |
| 1 | 02/20/2020 | ADDENDUM #1 |
| NO. | DATE | REVISION |

SCHOOL & LOCATION
GEORGE SHARSWOOD
ELEMENTARY SCHOOL

2300 S 2ND STREET, PHILADELPHIA, PA 19148

PROJECT TITLE
CLASSROOM
MODERNIZATION

DRAWING TITLE
ELECTRICAL FIRST FLOOR
POWER AND TECHNOLOGY
PLAN

| LOCATION NO. | FILE NO. |
|---------------------|---------------------|
| DRAWN BY | CHECKED BY |
| NBS | DAT |
| B-039C OF 2018 / 19 | B-040C OF 2018 / 19 |

DRAWING NO.
E2.1

SEAL:



CONRAD DELACRUZ
STATE AND LICENSE NO. PE09048

ARCHITECT

CRABTREE, ROHRBAUGH & ASSOCIATES
401 E. Winding Hill Road
Mechanicsburg, PA 17055
Phone: 717-458-0272

Email: jharder@cra-architects.com
Attn: Jessie Harder

M/E/P ENGINEERS

SETTY
575 South Charles Street, Suite 403
Baltimore, MD 21201
Phone: 667-309-6036


Email: deepak.ah@setty.com
Attn: Deepak Ajimane

GENERAL SHEET NOTES

- REFER TO DRAWING ED 1 FOR ELECTRICAL GENERAL NOTES, LEGEND AND ABBREVIATIONS.
- REFER TO ARCHITECTURAL DRAWINGS, ELEVATION & DETAILS FOR EXACT LOCATION OF ELECTRICAL DEVICES.
- ALL RECEPTACLES, TELEDATA OUTLETS WITH ASSOCIATED WIRING, CONDUIT, RACEWAYS, ETC SHALL BE SURFACE MOUNTED ON EXISTING WALLS AND FLUSH MOUNTED ON NEW WALLS. REFER TO ARCHITECTURAL DRAWINGS FOR WALL TYPES.
- ALL THE RECEPTACLES AND DATA OUTLETS WITHIN THE SCOPE OF WORK AREAS THAT ARE EXISTING TO REMAIN SHALL BE PROVIDED WITH NEW DEVICES. NEW DEVICE COLOR SHALL BE WHITE.
- ALL NEW 15- AND 20-AMPERE, 125- AND 250-VOLT NONLOCKING TYPE RECEPTACLES SHALL BE TAMPER RESISTANT AS PER NEC 408.12.
- ELECTRICAL CONTRACTOR TO RUN ALL NEW SURFACE MOUNTED CONDUITS AND RACEWAYS IN CORNERS OF EACH CLASSROOM TO AVOID CONFLICT WITH DISPLAY BOARDS AND OTHER CLASSROOM FURNISHINGS.

KEYED SHEET NOTES

- NEW LOCATION OF PA SPEAKER. COORDINATE IN FIELD FOR EXACT LOCATION AND IF REQUIRE EXTEND WIRING/CONDUIT TO NEW PA SPEAKER LOCATION.
- PROVIDE NEW TAMPER RESISTANT DEDICATED DUPLEX RECEPTACLE FOR LAPTOP CHARGING STATION.
- PROVIDE NEW BATTERY OPERATED WIRELESS CLOCK. COORDINATE WITH ARCHITECT FOR EXACT MOUNTING HEIGHT.
- CONTRACTOR TO FIELD TEST FUNCTIONALITY OF EXISTING TELEPHONE OUTLETS AND REPLACE AS REQUIRED. NEW TO MATCH EXISTING IN KIND MAKE AND TYPE.
- CONTRACTOR TO PROVIDE NEW TELEPHONE OUTLET. SDP TO PROVIDE NEW WALL MOUNTED TELEPHONE.
- NEW PANELBOARD 'A2'. CONTRACTOR TO UTILIZE, INTERCEPT AND EXTEND ALL ACTIVE FEEDER AND BRANCH CIRCUIT WIRING/CONDUIT OF SAME SIZE VIA NEW JUNCTION BOX OR PULL BOX AND CONNECT IT TO THE NEW PANELBOARD.
- NEW PANELBOARD 'B2'. CONTRACTOR TO UTILIZE, INTERCEPT AND EXTEND ALL ACTIVE FEEDER AND BRANCH CIRCUIT WIRING/CONDUIT OF SAME SIZE VIA NEW JUNCTION BOX OR PULL BOX AND CONNECT IT TO THE NEW PANELBOARD.
- NEW PANELBOARD 'C2'. CONTRACTOR TO UTILIZE, INTERCEPT AND EXTEND ALL ACTIVE FEEDER AND BRANCH CIRCUIT WIRING/CONDUIT OF SAME SIZE VIA NEW JUNCTION BOX OR PULL BOX AND CONNECT IT TO THE NEW PANELBOARD.
- NEW PANELBOARD 'D2'. CONTRACTOR TO UTILIZE, INTERCEPT AND EXTEND ALL ACTIVE FEEDER AND BRANCH CIRCUIT WIRING/CONDUIT OF SAME SIZE VIA NEW JUNCTION BOX OR PULL BOX AND CONNECT IT TO THE NEW PANELBOARD.
- CONTRACTOR TO COORDINATE IN FIELD FOR EXACT LOCATION OF RECEPTACLE AND DATA OUTLET SERVING THE INTERACTIVE SMARTBOARD TO AVOID CONFLICT WITH BASE PLATE. REFER TO ARCHITECTURAL DRAWING AS 1 DETAIL #1 AND #2 FOR EXACT LOCATION AND MOUNTING HEIGHT.

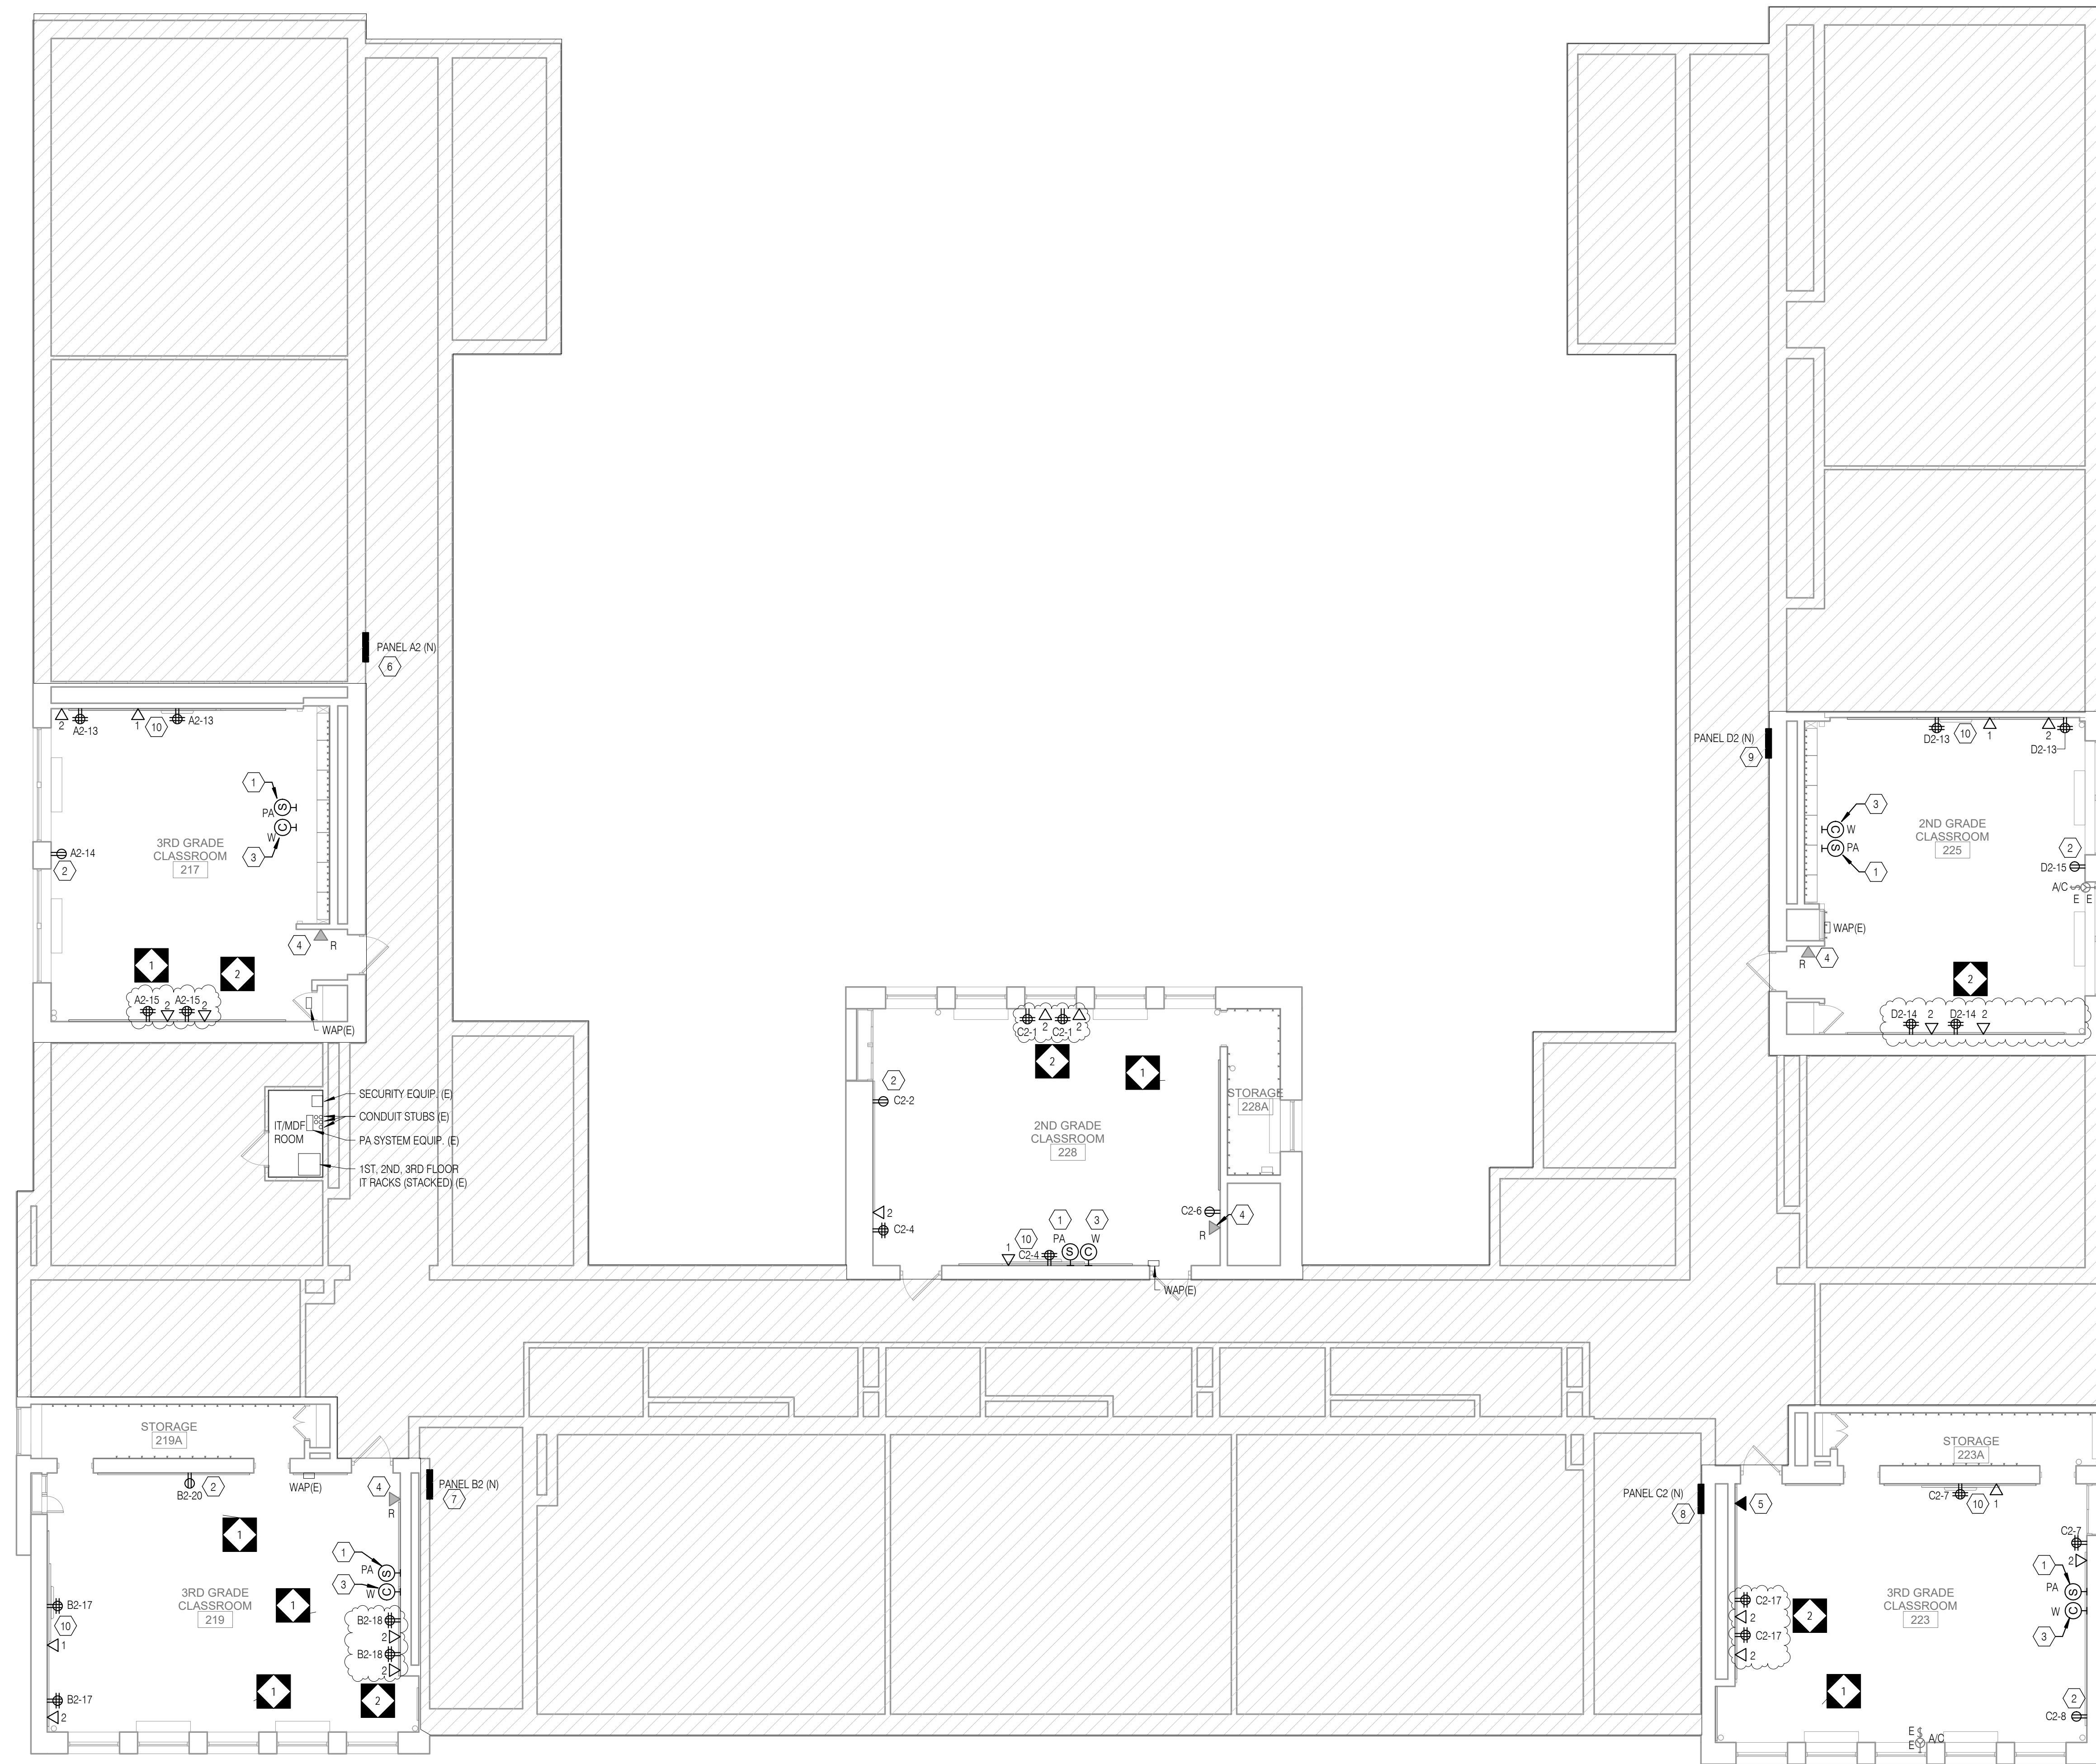

1 ELECTRICAL SECOND FLOOR POWER PLAN
E2.2 1/8" = 1'-0"

100% DESIGN SUBMISSION
1/22/2020

| 10 | | |
|-----|------------|-------------|
| 9 | | |
| 8 | | |
| 7 | | |
| 6 | | |
| 5 | | |
| 4 | | |
| 3 | | |
| 2 | 02/27/2020 | ADDENDUM #2 |
| 1 | 02/20/2020 | ADDENDUM #1 |
| NO. | DATE | REVISION |

SCHOOL & LOCATION
GEORGE SHARWOOD
ELEMENTARY SCHOOL

2300 S 2ND STREET, PHILADELPHIA, PA 19148

PROJECT TITLE
CLASSROOM
MODERNIZATION

DRAWING TITLE
ELECTRICAL SECOND
FLOOR POWER AND
TECHNOLOGY PLAN

| LOCATION NO. | FILE NO. |
|---------------------|---------------------|
| | |
| DRAWN BY | CHECKED BY |
| NBS | DAT |
| B-039C OF 2018 / 19 | B-040C OF 2018 / 19 |

DRAWING NO.
E2.2

SEAL:



CONRAD DELACRUZ
STATE AND LICENSE NO. PE09048

ARCHITECT

CRABTREE, ROHRBAUGH & ASSOCIATES
401 E. Winding Hill Road
Mechanicsburg, PA 17055
Phone: 717-458-0272

Email: jharder@cra-architects.com
Attn: Jessie Harder

M/E/P ENGINEERS

SETTY
575 South Charles Street, Suite 403
Baltimore, MD 21201
Phone: 667-309-6036

Email: deepak.aj@setty.com
Attn: Deepak Ajmani

1 2 3 4 5 6 7 8

A


B

C


D

E


F

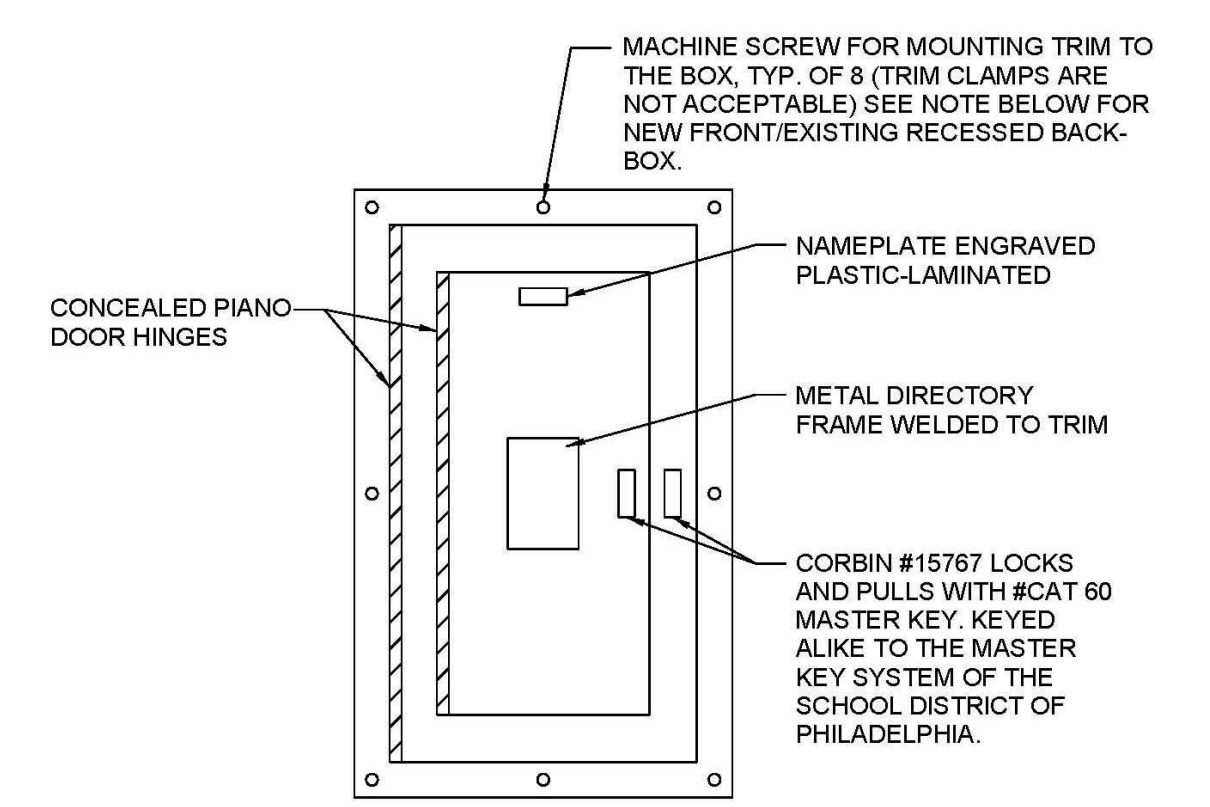


4 PANELBOARD FRONT STANDARD
E7.1 NTS

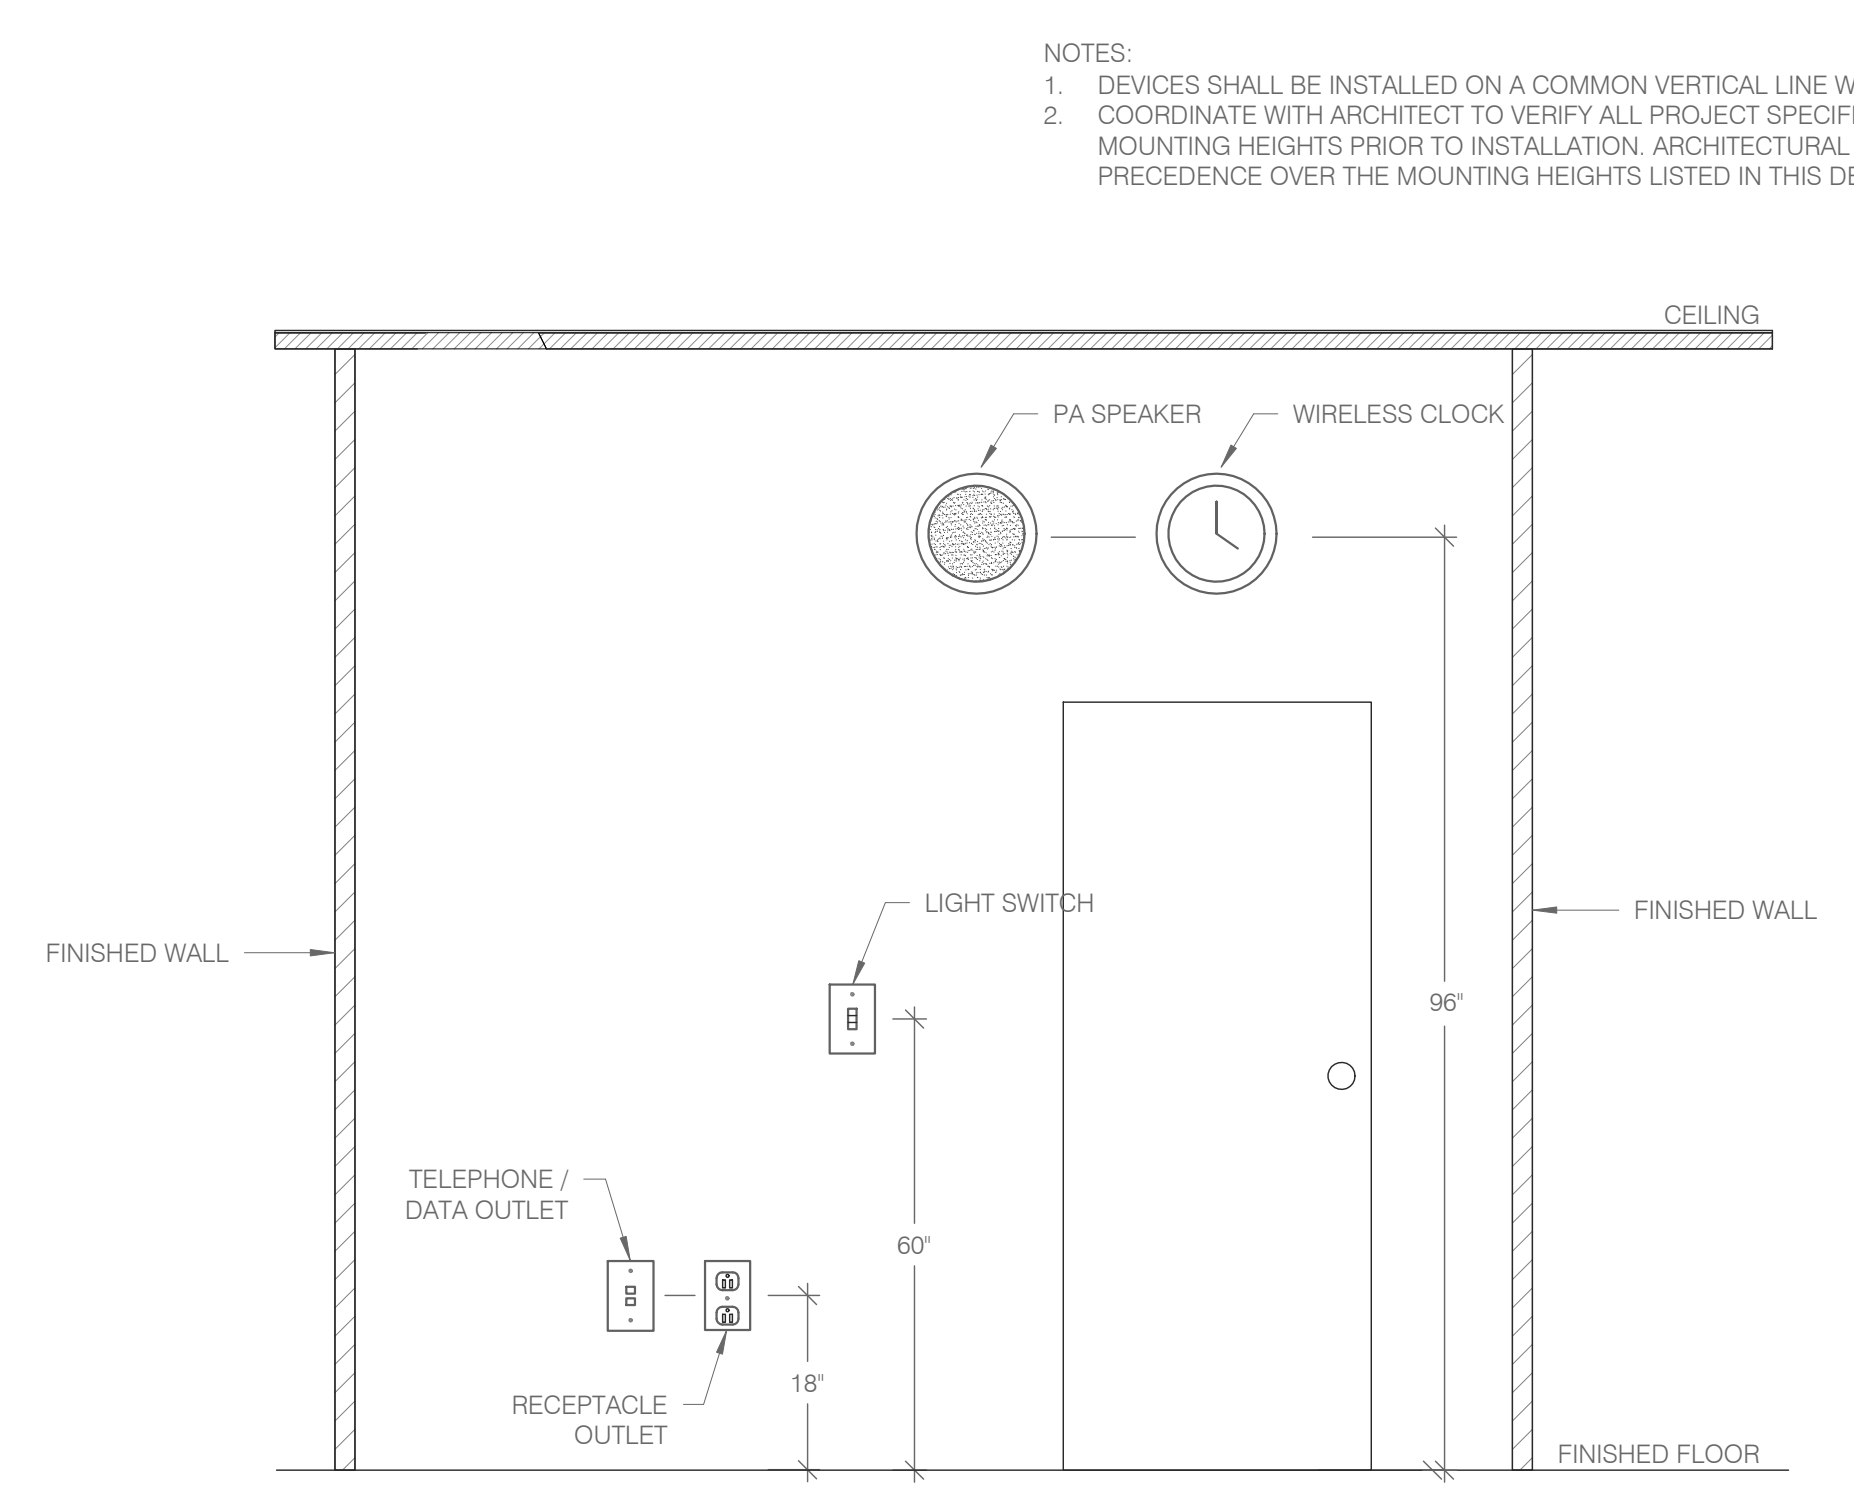

2 TYPICAL DEVICE MOUNTING HEIGHTS DETAIL
E7.1 NTS

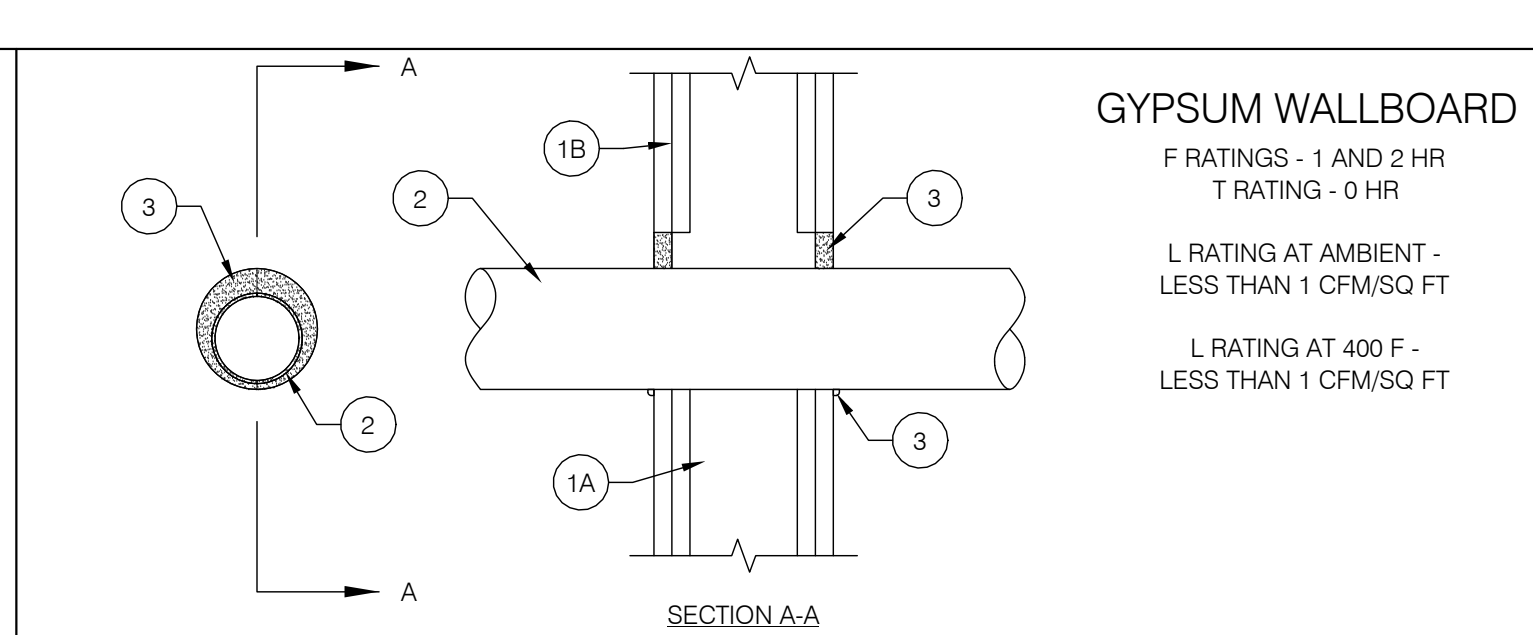


- GYPSUM WALLBOARD**
F RATINGS - 1 AND 2 HR
T RATING - 0 HR
L RATING AT AMBIENT - LESS THAN 1 CFM/SQ FT
L RATING AT 400 F - LESS THAN 1 CFM/SQ FT
- WALL ASSEMBLY - THE FIRE-RATED GYPSUM WALLBOARD/STUD WALL ASSEMBLY SHALL BE CONSTRUCTED OF THE MATERIALS AND IN THE MANNER SPECIFIED IN THE INDIVIDUAL U300 OR U400 SERIES WALL AND PARTITION DESIGNS IN THE UL FIRE RESISTANCE DIRECTORY AND SHALL INCLUDE THE FOLLOWING CONSTRUCTION FEATURES:
 - STUDS - WALL FRAMING MAY CONSIST OF EITHER WOOD STUDS OR STEEL CHANNEL STUDS. WOOD STUDS TO CONSIST OF NOM 2 BY 4 IN. LUMBER SPACED 16 IN. OC. STEEL STUDS TO BE MIN 3-5/8 IN. WIDE AND SPACED MAX 24 IN. OC.
 - GYPSUM BOARD* - THICKNESS, TYPE, NUMBER OF LAYERS AND FASTENERS AS REQUIRED IN THE INDIVIDUAL WALL AND PARTITION DESIGN. MAX DIAM OF OPENING IN WOOD STUD WALLS IS 8 IN. MAX DIAM OF OPENING IN STEEL STUD WALLS IS 14 IN. THE HOURLY F RATING OF THE FIRE STOP SYSTEM IS EQUAL TO THE HOURLY FIRE RATINGS OF THE WALL ASSEMBLY IN WHICH IT IS INSTALLED.
 - THROUGH PENETRANT - ONE METALLIC PIPE, CONDUIT OR TUBING TO BE INSTALLED WITHIN THE FIRE STOP SYSTEM. THE SPACE BETWEEN PIPE, CONDUIT OR TUBING AND PERIPHERY OF OPENING SHALL BE A MIN 0 IN. (POINT CONTACT) TO A MAX 2 IN. PIPE, CONDUIT OR TUBING TO BE RIGIDLY SUPPORTED ON BOTH SIDES OF WALL ASSEMBLY. THE FOLLOWING TYPES AND SIZES OF METALLIC PIPES, CONDUITS OR TUBING MAY BE USED:
 - STEEL PIPE - NOM 12 IN. DIAM (OR SMALLER) SCHEDULE 5 (OR HEAVIER STEEL PIPE).
 - IRON PIPE - NOM 12 IN. DIAM (OR SMALLER) CAST OR DUCTILE IRON PIPE.
 - CONDUIT - NOM 4 IN. DIAM (OR SMALLER) ELECTRICAL METALLIC TUBING, NOM 6 IN. DIAM (OR SMALLER) STEEL CONDUIT OR NOM 1 IN. DIAM (OR SMALLER) FLEXIBLE STEEL CONDUIT.
 - COPPER TUBING - NOM 6 IN. DIAM (OR SMALLER) TYPE L (OR HEAVIER) COPPER TUBING.
 - COPPER PIPE - NOM 6 IN. DIAM (OR SMALLER) REGULAR (OR HEAVIER) COPPER PIPE.
 - FILL VOID OR CAVITY MATERIAL* - CALK - MIN 5/8 IN. THICKNESS OF FILL MATERIAL APPLIED WITHIN THE ANNULUS. FLUSH WITH BOTH SURFACES OF WALL. MIN 3/8 IN. DIAM BEAD OF FILL MATERIAL APPLIED AT POINT CONTACT LOCATION AT THE PENETRANT/GYPSUM BOARD INTERFACE ON BOTH SIDES OF WALL.

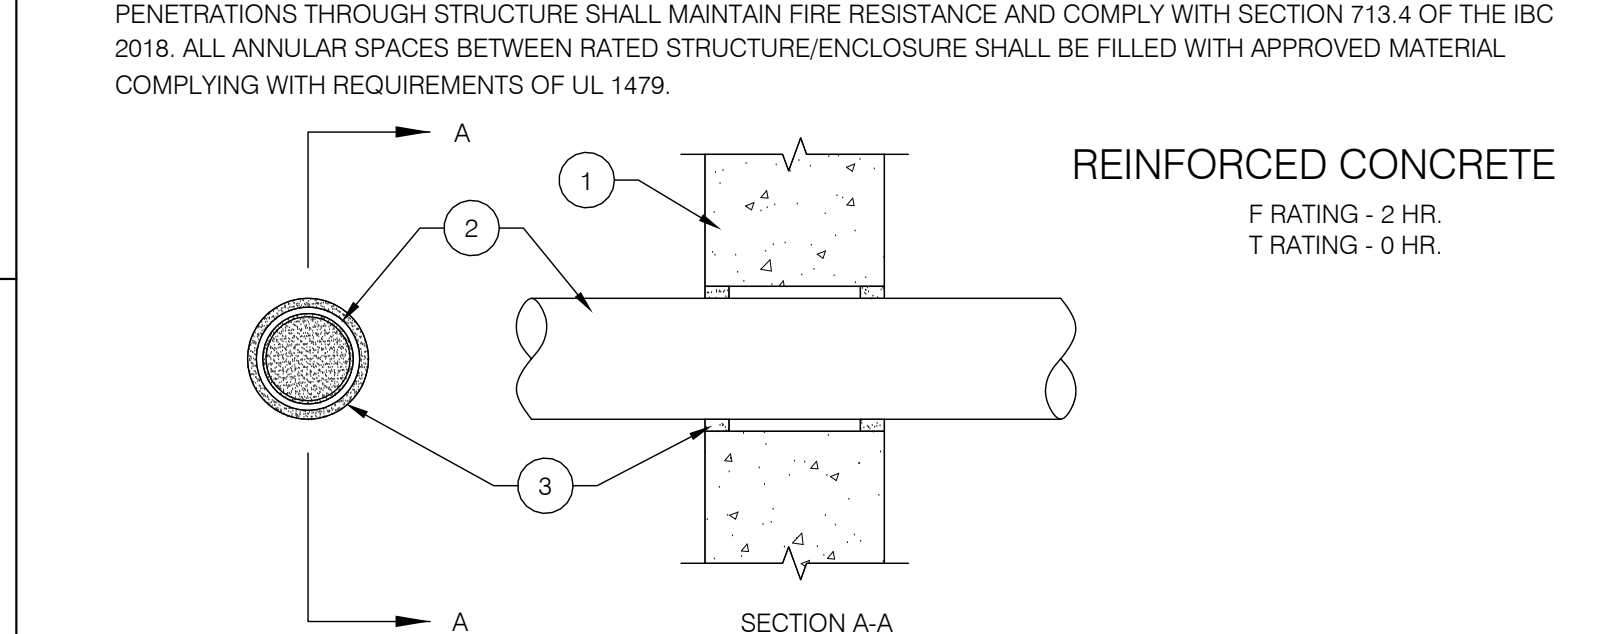


- REINFORCED CONCRETE**
F RATING - 2 HR
T RATING - 0 HR
- WALL ASSEMBLY - MIN 8 IN. (192 MM) THICK REINFORCED LIGHTWEIGHT OR NORMAL WEIGHT (100-150 PCF OR 1600-2400 KG/M3) CONCRETE. WALL MAY ALSO BE CONSTRUCTED OF ANY UL CLASSIFIED CONCRETE BLOCKS*. MAX DIAM OF OPENING IS 25 IN. (635 MM). SEE CONCRETE BLOCKS (CAZ) CATEGORY IN THE FIRE RESISTANCE DIRECTORY FOR THE NAMES OF MANUFACTURERS.
 - THROUGH PENETRANT - ONE METALLIC PIPE, TUBING OR CONDUIT TO BE INSTALLED EITHER CONCENTRICALLY OR ECCENTRICALLY WITHIN THE FIRESTOP SYSTEM. THE ANNULAR SPACE BETWEEN PIPES, TUBING OR CONDUITS AND PERIPHERY OF OPENING IS DEPENDENT UPON THE TYPE AND MAX DIAM OF THE THROUGH PENETRANT AS TABULATED BELOW. PIPE, TUBING OR CONDUIT TO BE RIGIDLY SUPPORTED ON BOTH SIDES OF WALL ASSEMBLY. THE FOLLOWING TYPES AND SIZES OF METALLIC PIPES, TUBING OR CONDUITS MAY BE USED:
 - STEEL PIPE - NOM 24 IN. (610 MM) DIAM (OR SMALLER) SCHEDULE 10 (OR HEAVIER) STEEL PIPE.
 - IRON PIPE - NOM 24 IN. (610 MM) DIAM (OR SMALLER) CAST OR DUCTILE IRON PIPE.
 - COPPER TUBING - NOM 6 IN. (152 MM) DIAM (OR SMALLER) TYPE L (OR HEAVIER) COPPER TUBING.
 - COPPER PIPE - NOM 6 IN. (152 MM) DIAM (OR SMALLER) REGULAR (OR HEAVIER) COPPER PIPE.
 - CONDUIT - NOM 4 IN. (102 MM) DIAM (OR SMALLER) STEEL ELECTRICAL METALLIC TUBING, NOM 6 IN. (152 MM) DIAM GALV STEEL CONDUIT OR NOM 1 IN. DIAM FLEXIBLE STEEL CONDUIT.
- | TYPE OF THROUGH PENETRANT | MAX DIAM OF THROUGH PENETRANT, IN. (MM) | MIN & MAX ANNULAR SPACE, IN. (MM) |
|---------------------------|-----------------------------------------|-----------------------------------|
| STEEL OR IRON PIPE | 4 (102) | 0, 1-1/2 (38) |
| STEEL TUBING OR CONDUIT | 4 (102) | 0, 1-1/2 (38) |
| STEEL CONDUIT | 6 (152) | 1/8 (3), 1/2 (13) |
| STEEL OR IRON PIPE | 24 (610) | 1/8 (3), 1/2 (13) |
| COPPER TUBING OR PIPE | 6 (152) | 1/8 (3), 1/2 (13) |
- FILL VOID OR CAVITY MATERIAL* - SEALANT - MIN 5/8 IN. (16 MM) THICKNESS OF FILL MATERIAL APPLIED WITHIN ANNULUS. FLUSH WITH BOTH SURFACES OF WALL. AT THE POINT CONTACT LOCATION BETWEEN THROUGH PENETRANT AND CONCRETE. A MIN 3/8 IN. (10 MM) DIAM BEAD OF FILL MATERIAL SHALL BE APPLIED AT THE CONCRETE/THROUGH PENETRANT INTERFACE ON BOTH SURFACES OF WALL.
- PENETRATIONS THROUGH STRUCTURE SHALL MAINTAIN FIRE RESISTANCE AND COMPLY WITH SECTION 713.4 OF THE IBC 2018. ALL ANNULAR SPACES BETWEEN RATED STRUCTURE/ENCLOSURE SHALL BE FILLED WITH APPROVED MATERIAL COMPLYING WITH REQUIREMENTS OF UL 1479.

1 THROUGH-PENETRANT FIRE STOP DETAIL
E7.1 NTS

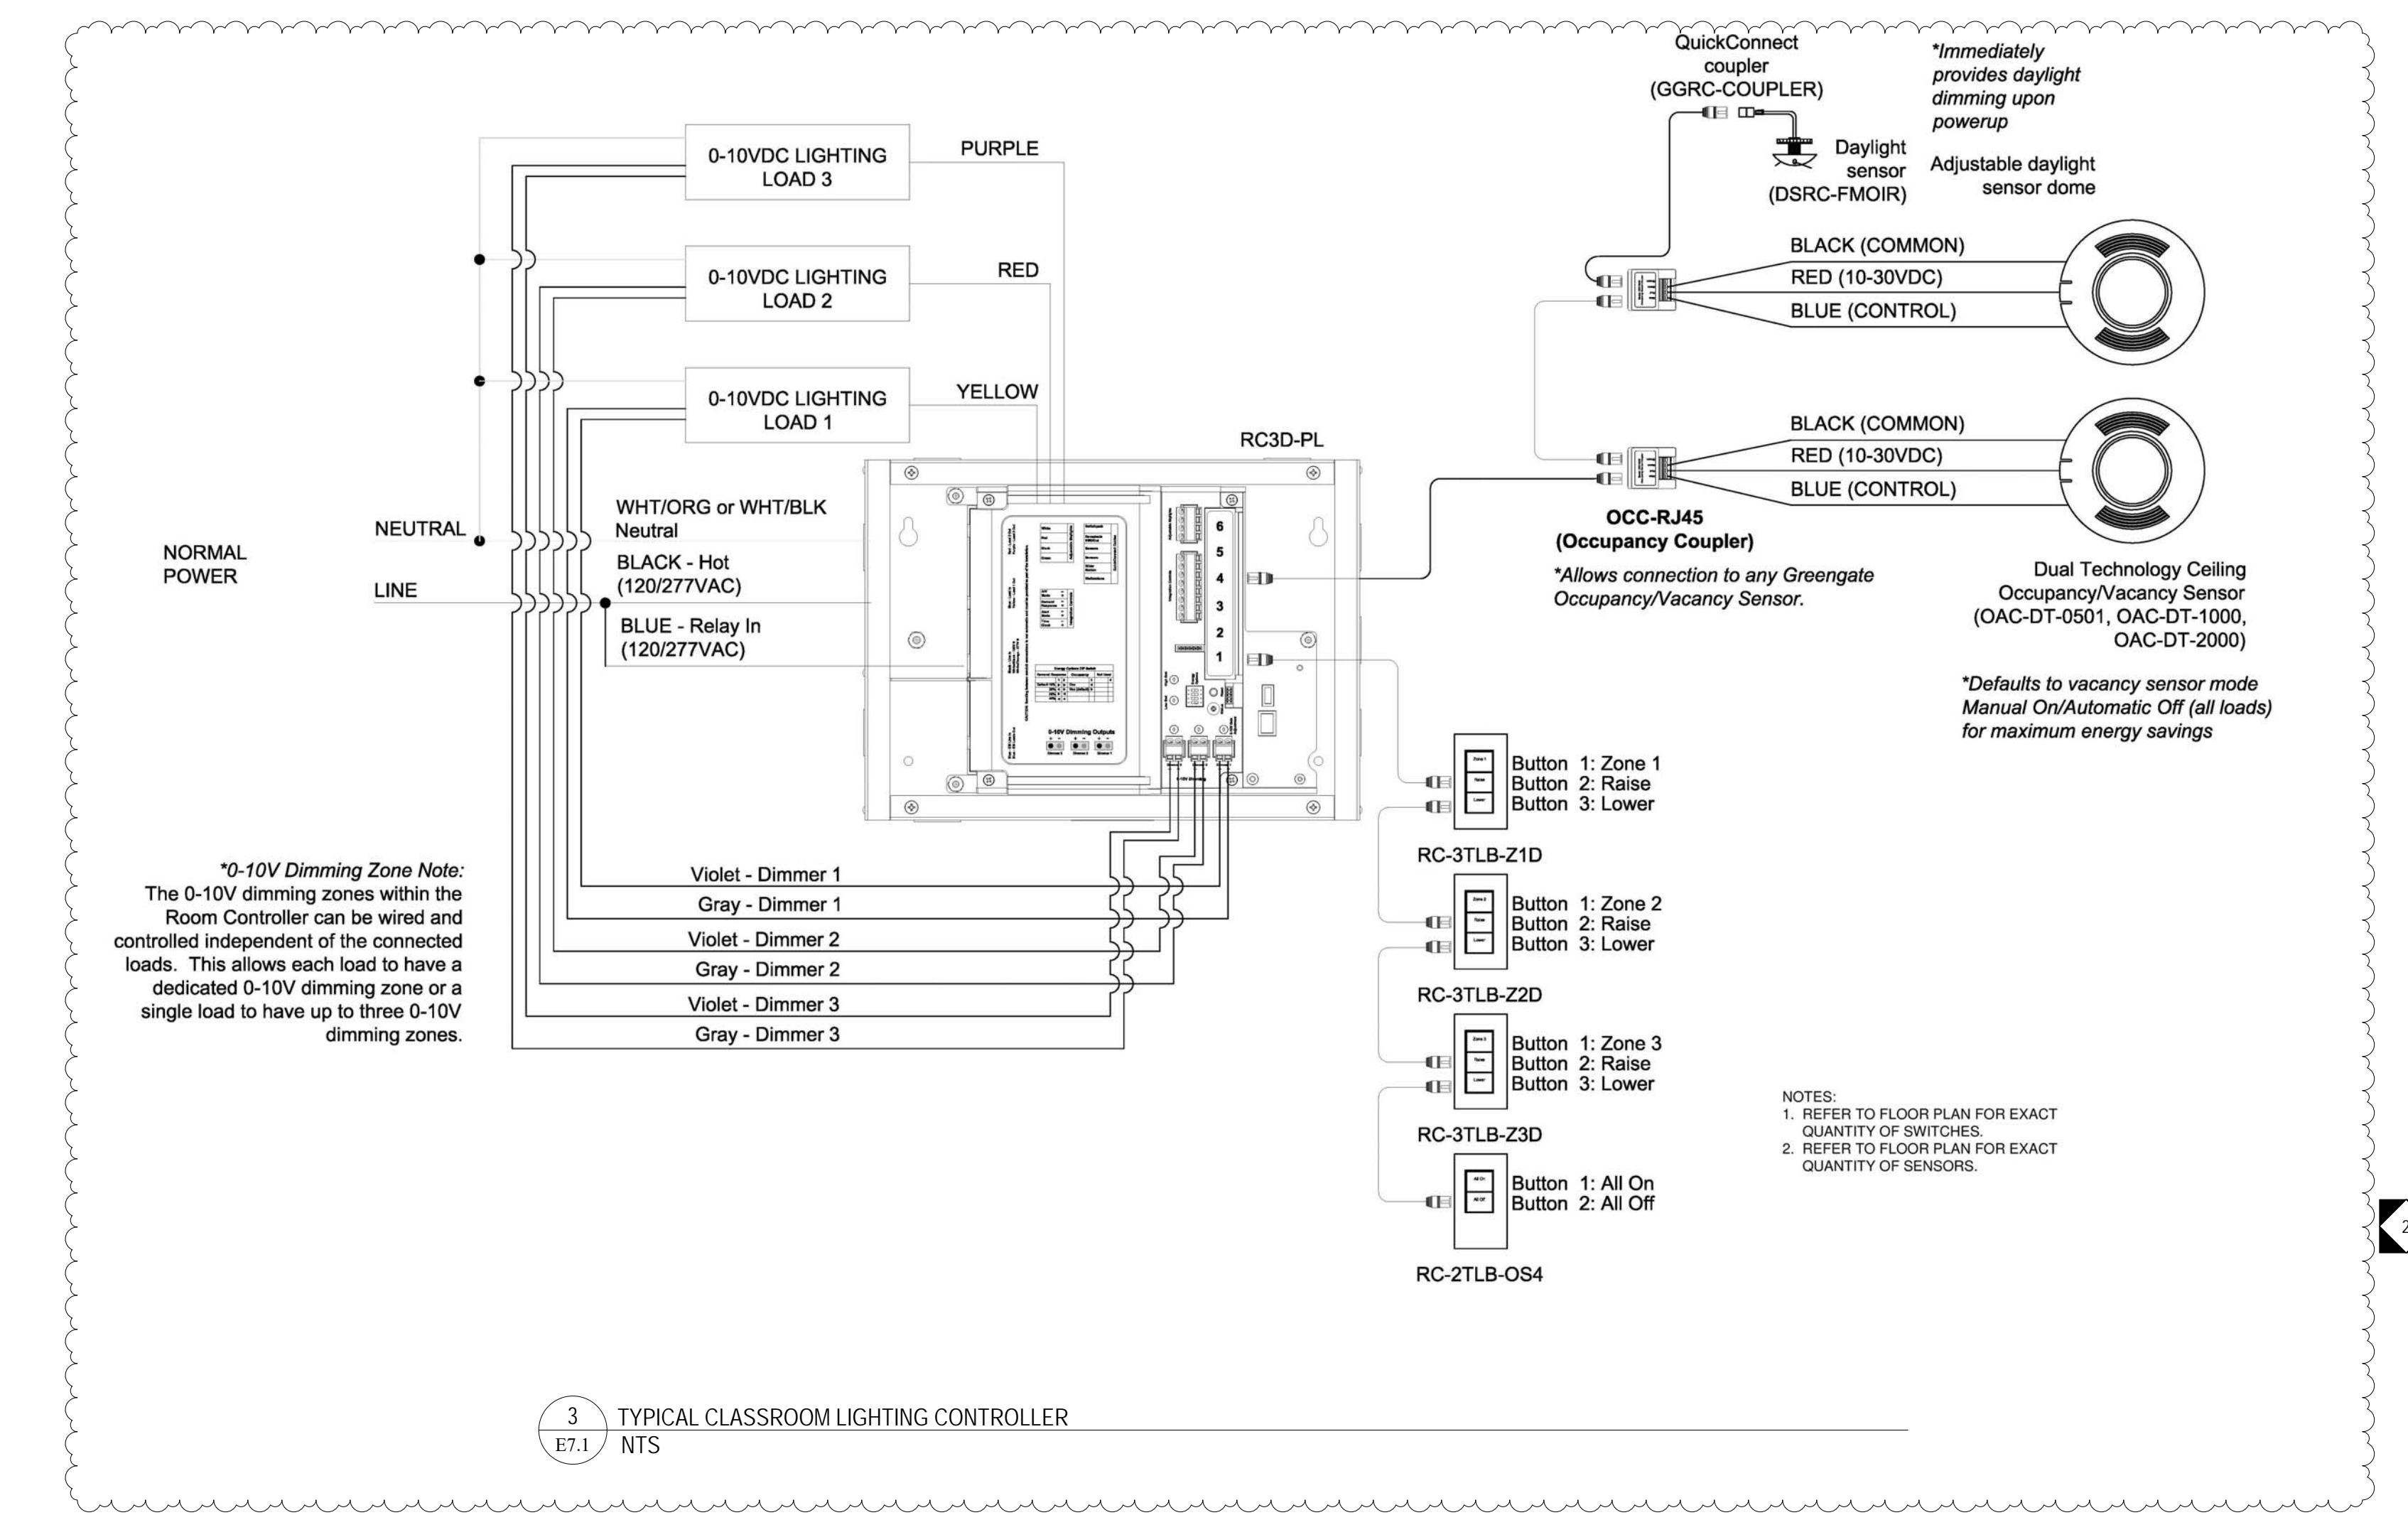

3 TYPICAL CLASSROOM LIGHTING CONTROLLER
E7.1 NTS

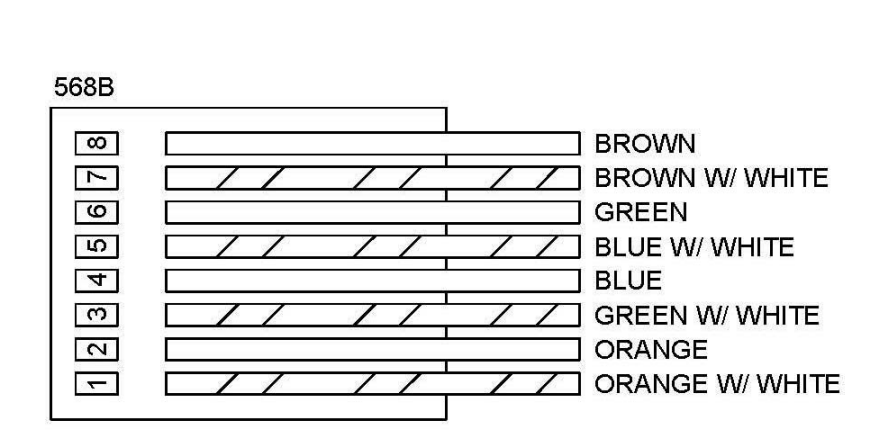

5 RJ45 TERMINATION DETAIL
E7.1 NTS

NOTE
1. ALL RJ45 TERMINATION POINTS SHALL BE CONFIGURED TO THE EIA/TIA 568B STANDARD UNLESS SPECIFICALLY DIRECTED OTHERWISE BY SDP AUTHORIZED REPRESENTATIVE.

100% DESIGN SUBMISSION
1/22/2020

| 10 | | |
|-----|------------|-------------|
| 9 | | |
| 8 | | |
| 7 | | |
| 6 | | |
| 5 | | |
| 4 | | |
| 3 | | |
| 2 | 02/23/2020 | ADDENDUM #2 |
| 1 | 02/20/2020 | ADDENDUM #1 |
| NO. | DATE | REVISION |

SCHOOL & LOCATION
GEORGE SHARWOOD ELEMENTARY SCHOOL

2300 S 2ND STREET, PHILADELPHIA, PA 19148

PROJECT TITLE
CLASSROOM MODERNIZATION

DRAWING TITLE
ELECTRICAL DETAILS

| LOCATION NO. | FILE NO. |
|---------------------|---------------------|
| DRAWN BY | CHECKED BY |
| NBS | DAT |
| B-039C OF 2018 / 19 | B-040C OF 2018 / 19 |

DRAWING NO.
E7.1