

THE SCHOOL DISTRICT OF PHILADELPHIA
Office of Capital Programs
440 North Broad Street, 3rd Floor – Suite 371
Philadelphia, PA 19130

TELEPHONE: (215) 400-4730

ADDENDUM No. 02

Subject: Northeast High School – AC Upgrade Project
SDP Contract No. B-006c & 007c 2020/21

Location: Northeast High School
1601 Cottman Avenue
Philadelphia PA 19111

This ADDENDUM dated May 25, 2021 shall modify and become part of the Contract Documents for the work of this project. Any items not mentioned herein, or affected by, shall be performed strictly in accordance with the original documents.

Questions

Question #1:

Drawing E101, sheet note #1 indicates to connect to a 20/2 CB in new panel P2. Is this the correct panelboard since the ground floor units are shown to connect to panel P1 on drawing E502? If P1 is the correct panelboard, ACU units 033 & 034 are shown with 30/2 CB's Which is correct?

Response: Note #1 on Drawing E101 will be revised to indicate “Panel P1” instead of Panel 2. For Units 033 & 034, the correct CB is 30/2. Panel schedule is correct.

Question #2:

Drawing E101, ACU 035 is shown but not indicated on M501. Is this unit being replaced? PTAC units 035 & 035B are shown on M502 but not on drawing E101 or E502. Are these units being installed?

Response: Drawings E101 & E502 will be updated to show units PTAC-035 & 035B as shown on M101.

Question #3:

Drawing E101, sheet notes 2 & 3 reference panel P2 when E502 indicates P1. Which is correct?

Response: Panel P1 is the correct panel.

Question #4:

Drawing E101, ACU units 18B & 18C indicate sheet note 4. Is this correct or should it be sheet note 5?

Response: Note #5 is correct.

Question #5:

Drawing E101, ODU-009A does not a note next to it? Is this being replaced?

Response: ODU-009A does have a note #5 next to it. Refer to E101 (Boiler RM C-7). The

designation inside room 9A should be "IDU-009A".

Question #6:

Drawing E102, sheet note #4 references panel P1. Is this correct or should it panel P2?

Response: Panel P2 is the correct panel.

Question #7:

Drawing E102, are ODU-101E, ODU-101F and ODU-101H being provided? They are not shown on E102 or E502 but are shown in the schedule on M502 as IDU units.

Response: Units referenced above will be provided and are shown on both E102 and M502.

Question #8:

Drawing E102, ODU 101D is not shown on this drawing or E502 but is shown on M502. Is this unit being provided?

Response: ODU-101D will be added to E102 and Panel P2 on E502.

Question #9:

Drawing E102, ODU 145A is not shown on this drawing or E502 and is only shown as an IDU on M502. Is this unit being provided?

Response: ODU-145 is shown on both E102 and M502. ODU-145 on roof will feed units IDU-145 A&C.

Question #10:

Drawing E102, UV-133-1 & UV-133-2 are not shown on this drawing but are indicated on M502. Are they being installed?

Response: Yes, these units will be installed and will be added to E102 and Panel P2 on E502.

Question #11:

Drawing E502, panelboard schedule P1 does not have circuits for units shown to be new on M501 & M502, ODU14A, ACU017C, ACU018D & ACU019A. Do these units need new circuits? If so what size?

Response: Yes, they will need new circuits. ODU-014A (30/2), ACU-017C (30/2), ACU-018D & 019A (20/2). Will be added to P1 on E502.

Question #12:

Drawing E502, panel schedule P2 indicates new AHU. Is this RTU-131? If so, is the circuit breaker sized correctly?

Response: Correct, RTU-131 circuit will be revised accordingly.

Question #13:

Drawing E502, ACU 229B is indicated as ACU229A on M501. Which is correct?

Response: The correct designation is ACU-229B.

Question #14:

Will the school district allow usage of the adult restrooms or will temporary units need to be provided? If so, where would they be installed?

Response: Electrical Contractor, as the Lead Prime, is required to provide temporary toilet facilities in accordance with Supplementary Conditions, SC-9 SANITARY PROVISIONS, locations

to be approved in the field.

Question #15:

Can an abatement survey be provided?

Response: See attached Technical Specification for Asbestos Abatement, prepared by SNERTECH, INCORPORATED, dated may 25, 2021 and related documents.

Question #16:

Can a painting specification and scope of work of indoor versus exterior per Prime be provided?

Response: See attached Specification 09 9000 Painting and Coating.

Question #17:

Can the rated walls be identified on the project?

Response: Corridor walls and stair shafts shall be considered fire-rated.

Question #18:

If multiple shifts are required to meet the substantial completion date, will the building be available?

Response: The building will be made available to support multiple shifts. SDP will keep the building open as needed if requested by the contractor.

Question #19:

Will existing studies of the switchgear be provided to aid in the coordination, arc flash & short circuit studies for the new panels?

Response: Arc flash studies not required under this Contract; arc flash warning labels to be provided.

Question #20:

Summary of work 1.15 "Perform necessary short circuit & arc flash studies", are we required to do the entire building as the specifications show? Can you provide more information on number of sub-stations, panels, etc.?

Response: Delete Summary of Work item 1.15. No electrical studies are required under this Contract.

Question #21:

Summary of work states electrical contractor is responsible for all environmental remediation. Can you supply a report on what the remediation that is required? Lead Paint Stabilization? Floor tiles? Spec's state this will be shown in an addendum.

Response: See attached Technical Specification for Asbestos Abatement, etc. and Summary Reports for Asbestos in Paint and Lead Based Paint for scope of environmental remediation.

EC must engage a licensed and qualified Asbestos Abatement Contractor (AAC) for asbestos abatement including drilling holes in floors, walls and ceilings to attach or pass through conduit or feeders in the spaces identified as containing asbestos in paint or removing asbestos containing floor tiles.

Lead Based Paint Stabilization may be performed by the prime contractor in accordance with PART 4- RENOVATION, REPAIR AND PAINTING- US EPA LEAD BASED PAINT RULE of Section 01 1100 ENVIRONMENTAL COORDINATION.

Also attached is an Asbestos Inspection Report required by the City of Philadelphia for a permit.

Question #22:

All Drawings – I assume where drawing notes call for Nema 6-15P, Nema 6-20P and Nema 6-30P an “R” (receptacle) is required and not a “P” (plug) for each air conditioner?

Response: Correct, the correct designations are, NEMA 6-15R, NEMA 6-20R and NEMA 6-30R.

Question #23:

Can the location(s) for the chases that will allow the 4” feeder conduit be shown on the drawings?

Response: The Contractor shall verify the best routing for new feeder conduits in the field and coordinate same with the Owner prior to commencing installation. For bidding purposes, assume that a separate core drill is required for each feeder conduit at each floor penetration, and that floor penetrations are to be located in Storage 157 / Storage 235A, adjacent to the Auditorium. Should the Contractor locate existing chase(s) where conduits may be installed, without interference or impeding access to other building utilities/equipment, the use of existing chases may be permitted by Owner. Conduits shall NOT be installed in stair towers, however.

Question #24:

Can the height of the existing electrical rooms be confirmed?

Response: The height of the electrical rooms is not available at this time. Contractor shall verify height in field.

Drawings:

- M501, E101, E102, and E502 have been updated for clarity of scope. See attached drawings.


Specifications

- ADD specification section 09 9000 Painting and Coating
- ADD Specification for Asbestos Abatement
- ADD Asbestos Inspection Report

Local File: BM 3601063684 - School District of Philadelphia (R2020)063684_SOP_NEHS_DOC_MEP_CENTRAL_R20_BM360106.vrt
Project Number: 066025.001
5/20/2021 1:33:02 PM


A
B
C
D
E
F

- GENERAL NOTES
- INTERIOR SUPPORT ANGLES TO BE 2"x2"x5/16" ALUMINUM ANGLE FASTENED TO WINDOW FRAMING.
 - WINDOW UNIT TO BE SUPPORTED BY ALUMINUM FRAMING AND INTERIOR ANGLE AND NOT RESTING ON METAL PANEL INFILL MATERIAL.
 - FLASHING SHALL BE 18 GAUGE AND SCREWED THROUGH METAL PANEL INFILL. SEALANT SHALL BE SILICON.
 - ALL FASTENERS SHALL BE STAINLESS STEEL.
 - PAINT ALUMINUM FRAMING AND INTERIOR ANGLE TO MATCH EXISTING FINISHES

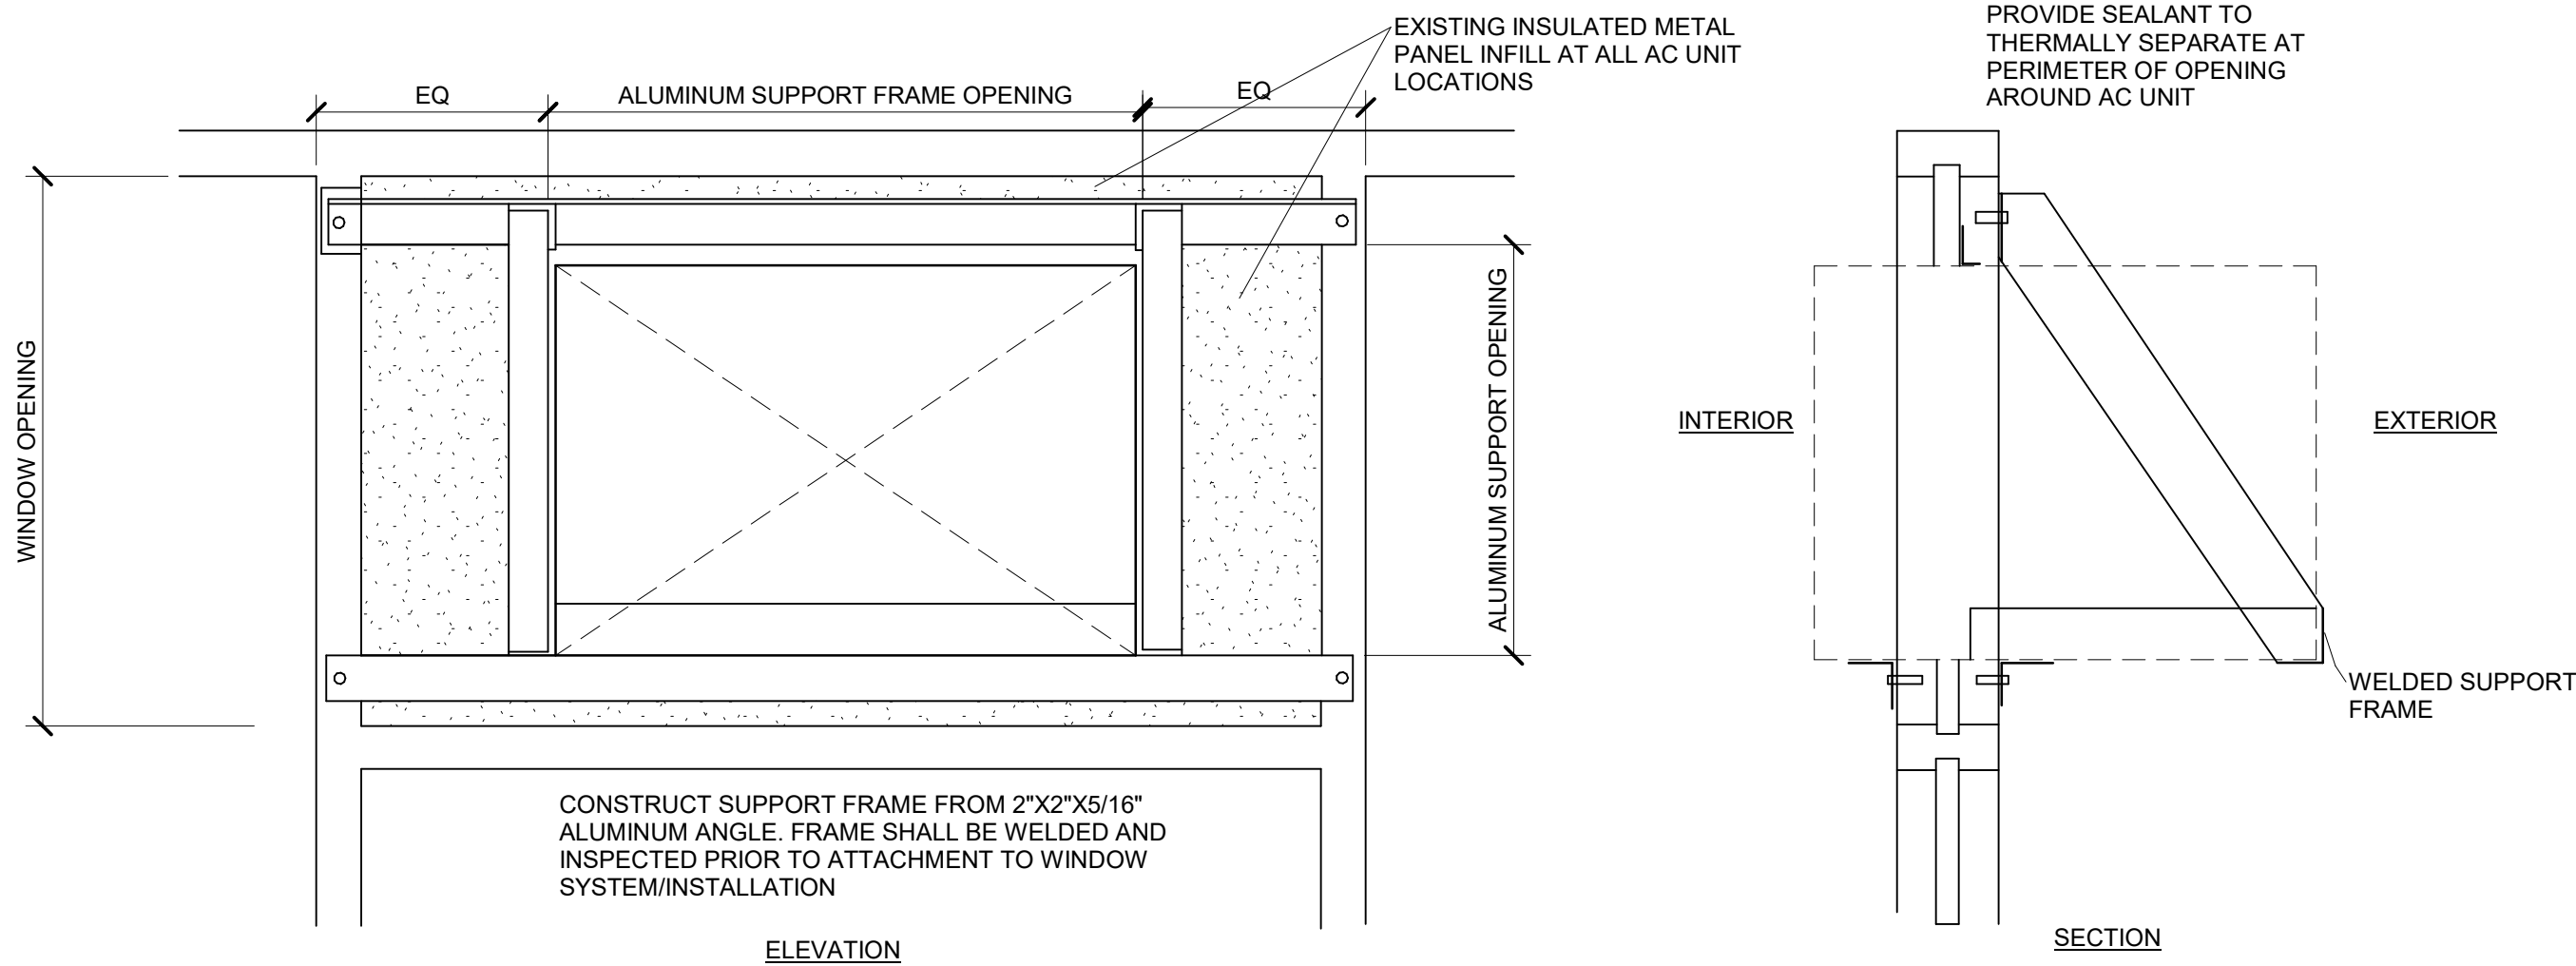


1 EXTERIOR AIR CONDITIONING WALL UNIT - INSTALLATION DETAIL

SCALE: NTS

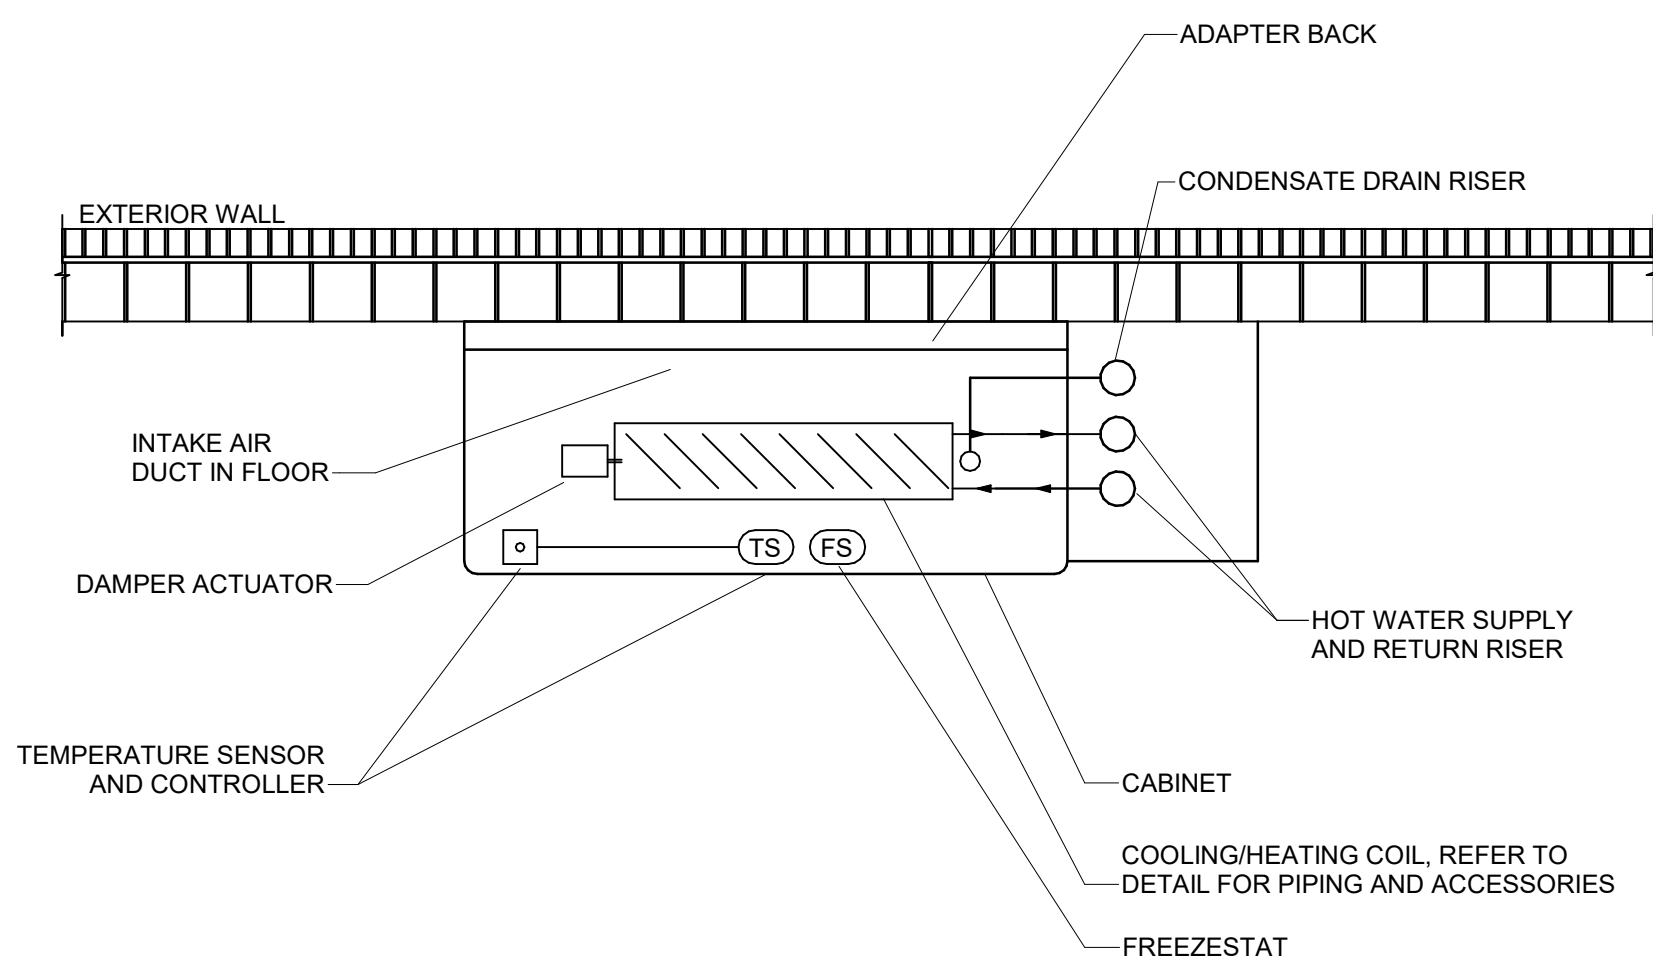


2 UNIT VENTILATOR

SCALE: NTS

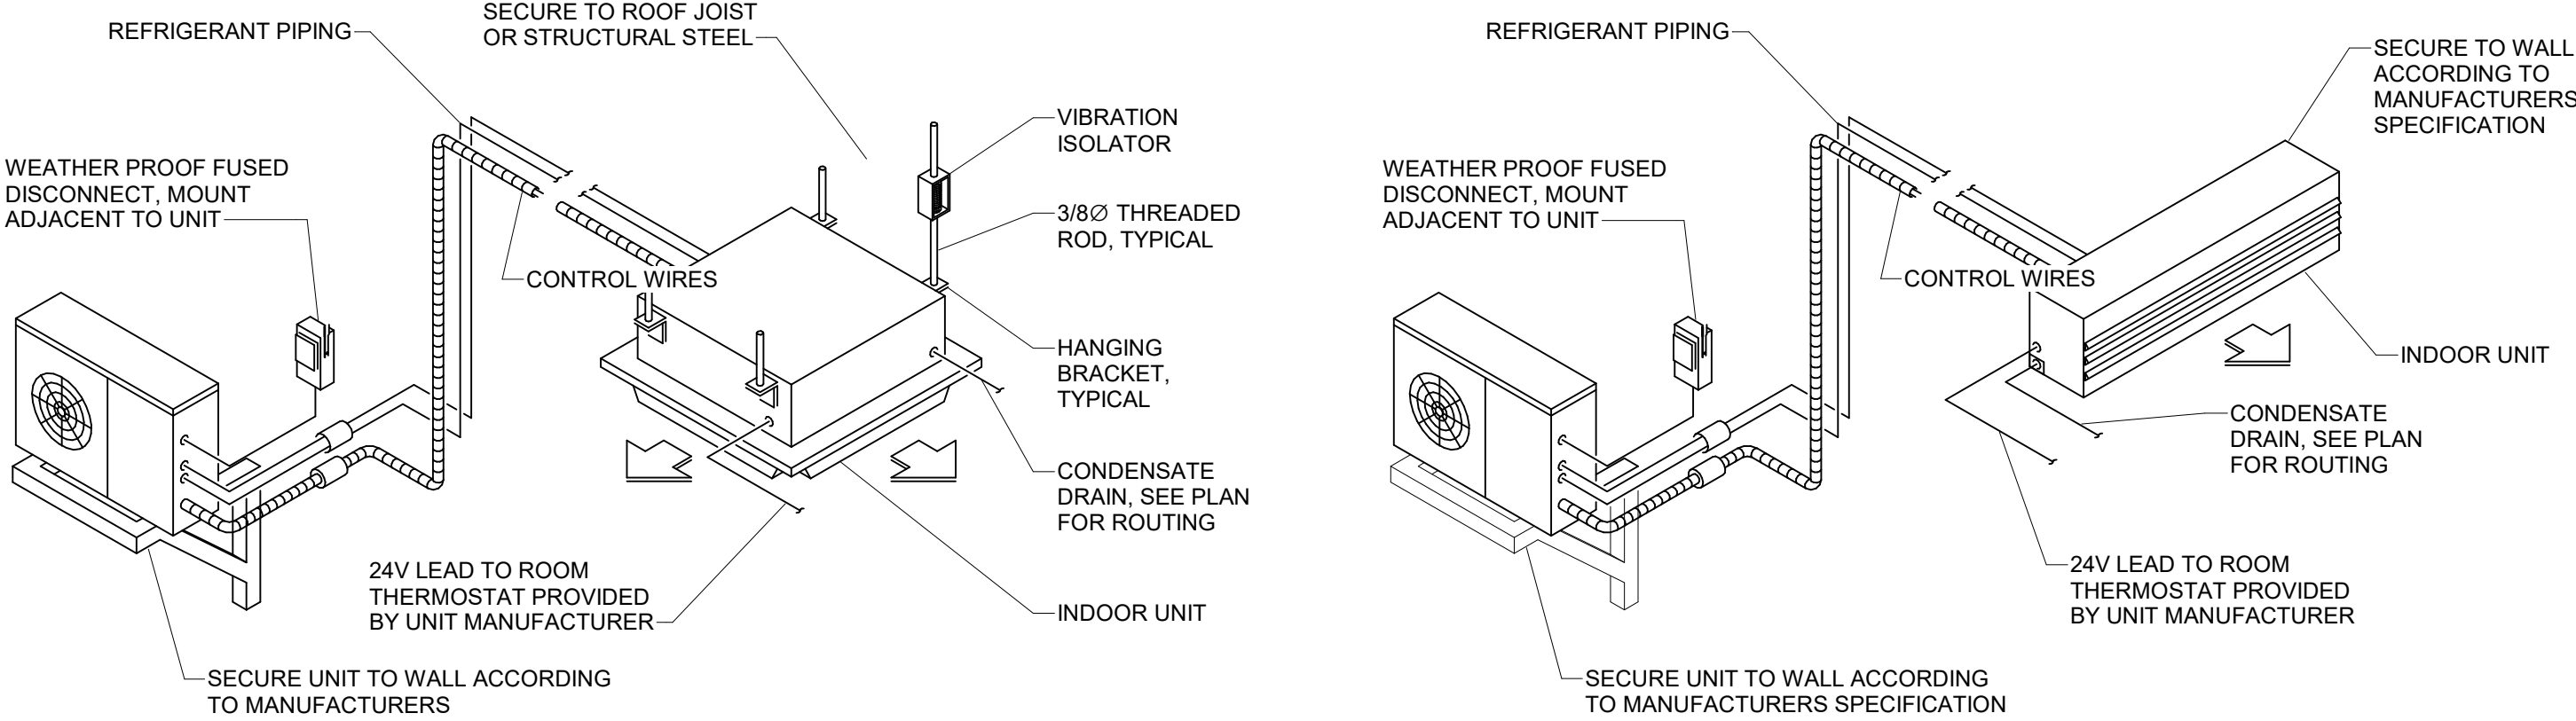

3 DUCTLESS SPLIT SYSTEM WALL MOUNTED INSTALL DETAIL

SCALE: NTS

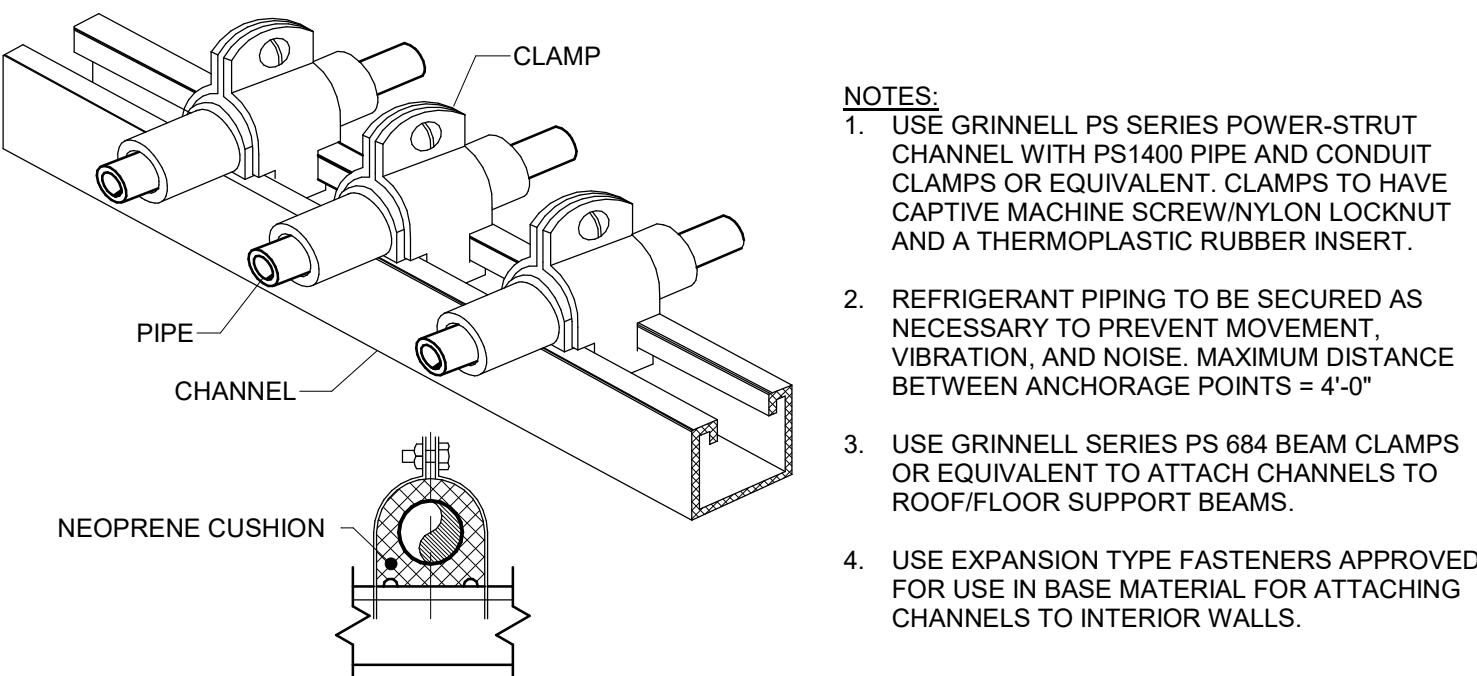

4 REFRIGERANT AND CONDENSATE PIPING SUPPORT DETAIL

SCALE: NTS

INSULATION THICKNESS SCHEDULE							
FLUID OPERATING TEMPERATURE RANGE AND USAGE (°F)		INSULATION CONDUCTIVITY		NOMINAL PIPE OR TUBE SIZE (INCHES)			
		CONDUCTIVITY (BTU-IN/(H-FT²-F))	MEAN RATING TEMP. (°F)	< 1	1 TO < 1.5	1.5 TO < 4	4 TO < 8
COOLING SYSTEMS (CHILLED WATER, REFRIGERANT, AIR CONDITIONING CONDENSATE)							
40 - 60		0.21 - 0.27	75	0.5	0.5	1	1
< 40		0.20 - 0.26	50	0.5	1	1	1.5

AIR CONDITIONING UNIT SCHEDULE									
MARK	SUPPLY AIRFLOW (CFM)	COOLING CAPACITY (MBH)	ELECTRICAL DATA			APPROX. OPERATING WEIGHT (LBS)	BASIS OF DESIGN		REMARKS
			V	Ø	HZ		MANUFACTURER	MODEL	
ACU-002	330	15.7	230	1	60	141	FRIEDRICH	KCS16A30A	1
ACU-003	330	15.7	230	1	60	141	FRIEDRICH	KCS16A30A	1
ACU-004	330	15.7	230	1	60	141	FRIEDRICH	KCS16A30A	1
ACU-005	330	15.7	230	1	60	141	FRIEDRICH	KCS16A30A	1
ACU-006	725	35	230	1	60	212	FRIEDRICH	KCL36A30A	1
ACU-007	725	35	230	1	60	212	FRIEDRICH	KCL36A30A	1
ACU-008	725	35	230	1	60	212	FRIEDRICH	KCL36A30A	1
ACU-009	725	35	230	1	60	212	FRIEDRICH	KCL36A30A	1
ACU-010	725	35	230	1	60	212	FRIEDRICH	KCL36A30A	1
ACU-011	725	35	230	1	60	212	FRIEDRICH	KCL36A30A	1
ACU-012-1	330	15.7	230	1	60	141	FRIEDRICH	KCS16A30A	1
ACU-012-2	330	15.7	230	1	60	141	FRIEDRICH	KCS16A30A	1
ACU-013-1	330	15.7	230	1	60	141	FRIEDRICH	KCS16A30A	1
ACU-013-2	330	15.7	230	1	60	141	FRIEDRICH	KCS16A30A	1
ACU-014	725	35	230	1	60	212	FRIEDRICH	KCL36A30A	1
ACU-015-1	330	15.7	230	1	60	141	FRIEDRICH	KCS16A30A	1
ACU-015-2	330	15.7	230	1	60	141	FRIEDRICH	KCS16A30A	1
ACU-016A	640	28	230	1	60	193	FRIEDRICH	KCL28A30A	1
ACU-016B	725	35	230	1	60	212	FRIEDRICH	KCL36A30A	1
ACU-017A	640	28	230	1	60	193	FRIEDRICH	KCL28A30A	1
ACU-017B	725	35	230	1	60	212	FRIEDRICH	KCL36A30A	1
ACU-017C	640	28	230	1	60	193	FRIEDRICH	KCL28A30A	1
ACU-018D	300	12	230	1	60	116	FRIEDRICH	KCS12A30A	1
ACU-018A	300	12	230	1	60	116	FRIEDRICH	KCS12A30A	1
ACU-018B	725	35	230	1	60	212	FRIEDRICH	KCL36A30A	1
ACU-023	640	28	230	1	60	193	FRIEDRICH	KCL28A30A	1
ACU-024	330	15.7	230	1	60	141	FRIEDRICH	KCS16A30A	1
ACU-025	300	12	230	1	60	116	FRIEDRICH	KCS12A30A	1
ACU-033	300	12	230	1	60	116	FRIEDRICH	KCS12A30A	1
ACU-034	300	12	230	1	60	116	FRIEDRICH	KCS12A30A	1
ACU-056	330	15.7	230	1	60	141	FRIEDRICH	KCS16A30A	1
ACU-057	330	15.7	230	1	60	141	FRIEDRICH	KCS16A30A	1
ACU-100A	300	12	230	1	60	116	FRIEDRICH	KCS12A30A	1
ACU-100B	300	12	230	1	60	116	FRIEDRICH	KCS12A30A	1
ACU-101-1	640	28	230	1	60	193	FRIEDRICH	KCL28A30A	1
ACU-101-2	640	28	230	1	60	193	FRIEDRICH	KCL28A30A	1
ACU-101A	300	12	230	1	60	116	FRIEDRICH	KCS12A30A	1
ACU-101J	300	12	230	1	60	116	FRIEDRICH	KCS12A30A	1
ACU-101K	300	12	230	1	60	116	FRIEDRICH	KCS12A30A	1
ACU-101L	300	12	230	1	60	116	FRIEDRICH	KCS12A30A	1
ACU-101M	300	12	230	1	60	116	FRIEDRICH	KCS12A30A	1
ACU-102	330	15.7	230	1	60	141	FRIEDRICH	KCS16A30A	1
ACU-104	300	12	230	1	60	116	FRIEDRICH	KCS12A30A	1
ACU-105B	300	12	230	1	60	116	FRIEDRICH	KCS12A30A	1
ACU-106	725	35	230	1	60	212	FRIEDRICH	KCL36A30A	1
ACU-108	725	35	230	1	60	212	FRIEDRICH	KCL36A30A	1
ACU-109	725	35	230	1	60	212	FRIEDRICH	KCL36A30A	1
ACU-110	725	35	230	1	60	212	FRIEDRICH	KCL36A30A	1
ACU-111	725	35	230	1	60	212	FRIEDRICH	KCL36A30A	1
ACU-112	725	35	230	1	60	212	FRIEDRICH	KCL36A30A	1
ACU-113	725	35	230	1	60	212	FRIEDRICH	KCL36A30A	1
ACU-114	640	28	230	1	60	193	FRIEDRICH	KCL28A30A	1
ACU-115	725	35	230	1	60	212	FRIEDRICH	KCL36A30A	1
ACU-116	640	28	230	1	60	193	FRIEDRICH	KCL28A30A	1
ACU-117	640	28	230	1	60	193	FRIEDRICH	KCL28A30A	1
ACU-118	640	28	230	1	60	193	FRIEDRICH	KCL28A30A	1
ACU-119	725	35	230	1	60	212	FRIEDRICH	KCL36A30A	1
ACU-120A	300	12	230	1	60	116	FRIEDRICH	KCS12A30A	1
ACU-121	725	35	230	1	60	212	FRIEDRICH	KCL36A30A	1
ACU-122	725	35	230	1	60	212	FRIEDRICH	KCL36A30A	1
ACU-123	640	28	230	1	60	193	FRIEDRICH	KCL28A30A	1
ACU-124	725	35	230	1	60	212	FRIEDRICH	KCL36A30A	1
ACU-125	725	35	230	1	60	212	FRIEDRICH	KCL36A30A	1
ACU-126	330	15.7	230	1	60	141	FRIEDRICH	KCS16A30A	1
ACU-127	725	35	230	1	60	212	FRIEDRICH	KCL36A30A	1
ACU-129	300	12	230	1	60	116	FRIEDRICH	KCS12A30A	1
ACU-130-1	640	28	230	1	60	193	FRIEDRICH	KCL28A30A	1
ACU-130-2	330	15.7	230	1	60	141	FRIEDRICH	KCS16A30A	1
ACU-131J	330	15.7	230	1	60	141	FRIEDRICH	KCS16A30A	1
ACU-132-1	640	28	230	1	60	193	FRIEDRICH	KCL28A30A	1
ACU-132-2	640	28	230	1	60	193	FRIEDRICH	KCL28A30A	1
ACU-134	330	15.7	230	1	60	141	FRIEDRICH	KCS16A30A	1
ACU-136-1	640	28	230	1	60	193	FRIEDRICH	KCL28A30A	1
ACU-136-2	640	28	230	1	60	193	FRIEDRICH	KCL28A30A	1
ACU-137	640	28	230	1	60	193	FRIEDRICH	KCL28A30A	1
ACU-138	725	35	230	1	60	212	FRIEDRICH	KCL36A30A	1
ACU-139	640	28	230	1	60	193	FRIEDRICH	KCL28A30A	1
ACU-140-1	330	15.7	230	1	60	141	FRIEDRICH	KCS16A30A	1
ACU-140-2	330	15.7	230	1	60	141	FRIEDRICH	KCS16A30A	1
ACU-141	640	28	230	1	60	193	FRIEDRICH	KCL28A30A	1
ACU-143	640	28	230	1	60	193	FRIEDRICH	KCL28A30A	1
ACU-145	640	28	230	1	60	193	FRIEDRICH	KCL28A30A	1
ACU-145B	300	12	230	1	60	116	FRIEDRICH	KCS12A30A	1
ACU-145D	640	28	230	1	60	193	FRIEDRICH	KCL28A30A	1
ACU-150	640	28	230	1	60	193	FRIEDRICH	KCL28A30A	1
ACU-152	640	28	230	1	60	193	FRIEDRICH	KCL28A30A	1
ACU-154	640	28	230	1	60	193	FRIEDRICH	KCL28A30A	1
ACU-156	640	28	230	1	60	193	FRIEDRICH	KCL28A30A	1
ACU-158	640	28	230	1	60	193	FRIEDRICH	KCL28A30A	1
ACU-160	640	28	230	1	60	193	FRIEDRICH	KCL28A30A	1
ACU-162	330	15.7	230	1	60	141	FRIEDRICH	KCS16A30A	1
ACU-200	640	28	230	1	60	193	FRIEDRICH	KCL28A30A	1
ACU-201	725	35	230	1	60	212	FRIEDRICH	KCL36A30A	1
ACU-202	640	28	230	1	60	193	FRIEDRICH	KCL28A30A	1
ACU-203	725	35	230	1	60	212	FRIEDRICH	KCL36A30A	1
ACU-203A	640	28	230	1	60	193	FRIEDRICH	KCL28A30A	1
ACU-204	330	15.7	230	1	60	141	FRIEDRICH	KCS16A30A	1
ACU-205	725	35	230	1	60	212	FRIEDRICH	KCL36A30A	1
ACU-206	640	28	230	1	60	193	FRIEDRICH	KCL28A30A	1
ACU-207-1	640	28	230	1	60	193	FRIEDRICH	KCL28A30A	1
ACU-207-2	640	28	230	1	60	193	FRIEDRICH	KCL28A30A	1
ACU-208	640	28	230	1	60	193	FRIEDRICH	KCL28A30A	1
ACU-209-1	640	28	230	1	60	193	FRIEDRICH	KCL28A30A	1
ACU-209-2	640	28	230	1	60	193	FRIEDRICH	KCL28A30A	1
ACU-210	640	28	230	1	60	193	FRIEDRICH	KCL28A30A	1
ACU-211	725	35	230	1	60	212	FRIEDRICH	KCL36A30A	1
ACU-212	725	35	230	1	60	212	FRIEDRICH	KCL36A30A	1
ACU-213	725	35	230	1	60	212	FRIEDRICH	KCL36A30A	1
ACU-214	640	28	230	1	60	193	FRIEDRICH	KCL28A30A	1
ACU-216	725	35	230	1	60	212	FRIEDRICH	KCL36A30A	1
ACU-217	725	35	230	1	60	212	FRIEDRICH	KCL36A30A	1
ACU-218	640	28	230	1	60	193	FRIEDRICH	KCL28A30A	1
ACU-219A	640	28	230	1	60	193	FRIEDRICH	KCL28A30A	1
ACU-219B	640	28	230	1	60	193	FRIEDRICH	KCL28A30A	1
ACU-219C	300	12	230	1	60	116	FRIEDRICH	KCS12A30A	1
ACU-220	640	28	230	1	60	193	FRIEDRICH	KCL28A30A	1
ACU-221A	725	35	230	1	60	212	FRIEDRICH	KCL36A30A	1
ACU-221B	640	28	230	1	60	193	FRIEDRICH	KCL28A30A	1
ACU-222	725	35	230	1	60	212	FRIEDRICH	KCL36A30A	1
ACU-223A	640	28	230	1	60	193	FRIEDRICH	KCL28A30A	1
ACU-223C	640	28	230	1	60	193	FRIEDRICH	KCL28A30A	1
ACU-225	725	35	230	1	60	212	FRIEDRICH	KCL36A30A	1
ACU-227A	640	28	230	1	60	193	FRIEDRICH	KCL28A30A	1
ACU-227B	640	28	230	1	60	193	FRIEDRICH	KCL28A30A	1
ACU-228	725	35	230	1	60	212	FRIEDRICH	KCL36A30A	1
ACU-229B	640	28	230	1	60	193	FRIEDRICH	KCL28A30A	1
ACU-229C	640	28	230	1	60	193	FRIEDRICH	KCL28A30A	1
ACU-231	640	28	230	1	60	193	FRIEDRICH	KCL28A30A	1
ACU-232	725	35	230	1	60	212	FRIEDRICH	KCL36A30A	1
ACU-233	640	28	230	1	60	193	FRIEDRICH	KCL28A30A	1
ACU-234	640	28	230	1	60	193	FRIEDRICH	KCL28A30A	1
ACU-235	640	28	230	1	60	193	FRIEDRICH	KCL28A30A	1
ACU-236	725	35	230	1	60	212	FRIEDRICH	KCL36A30A	1
ACU-238	640	28	230	1	60	193	FRIEDRICH	KCL28A30A	1
ACU-240	725	35	230	1	60	212	FRIEDRICH	KCL36A30A	1
ACU-241	300	12	230	1	60	116	FRIEDRICH	KCS12A30A	1
ACU-242	640	28	230	1	60	193	FRIEDRICH	KCL28A30A	1
ACU-244	725	35	230	1	60	212	FRIEDRICH	KCL36A30A	1

1. SEE ELECTRICAL SHEET E001 FOR GENERAL NOTES AND WIRING METHODS
2. ALL ELECTRICAL EQUIPMENT SHOWN ON DRAWING IS NEW UNLESS NOTED OTHERWISE.
3. ALL WIRING SHALL BE INSTALLED IN CONDUIT OF REQUIRED SIZE BUT NO SMALLER THAN SIZE INDICATED.
4. NOT ALL SHEET NOTES MAY BE USED ON THIS SHEET.
5. LABEL ALL NEW PANELS, SWITCHES AND RECEPTACLES.
6. COORDINATE EFFORTS WITH SDP-PROCURED COMMISSIONING AGENT.
7. INSTALL ALL DISCONNECT SWITCHES FURNISHED BY MECHANICAL CONTRACTOR. PROVIDE CONDUIT AND WIRING THROUGH DISCONNECT SWITCHES TO EQUIPMENT.



7. REMOVE FLOOR TILES AS NECESSARY TO PENETRATE CORRIDOR FLOOR FROM LEVEL BELOW TO THE FRONT SIDE OF THE UNIT. (E501)

[illegible]

PROJECT TITLE

AIR CONDITIONING UPGRADE


DRAWING TITLE

ELECTRICAL POWER GROUND
FLOOR

DRAWING SCALE AS NOTED	
LOCATION NO. 8020	ENGINEER'S PRJ. NO. 068625.001
DRAWN BY FJR	CHECKED BY BAM

MC - B-006 C	OF	2020/21
EC - B-007 C	OF	2020/21


DRAWING NO.
E101
SHEET 12 OF 18

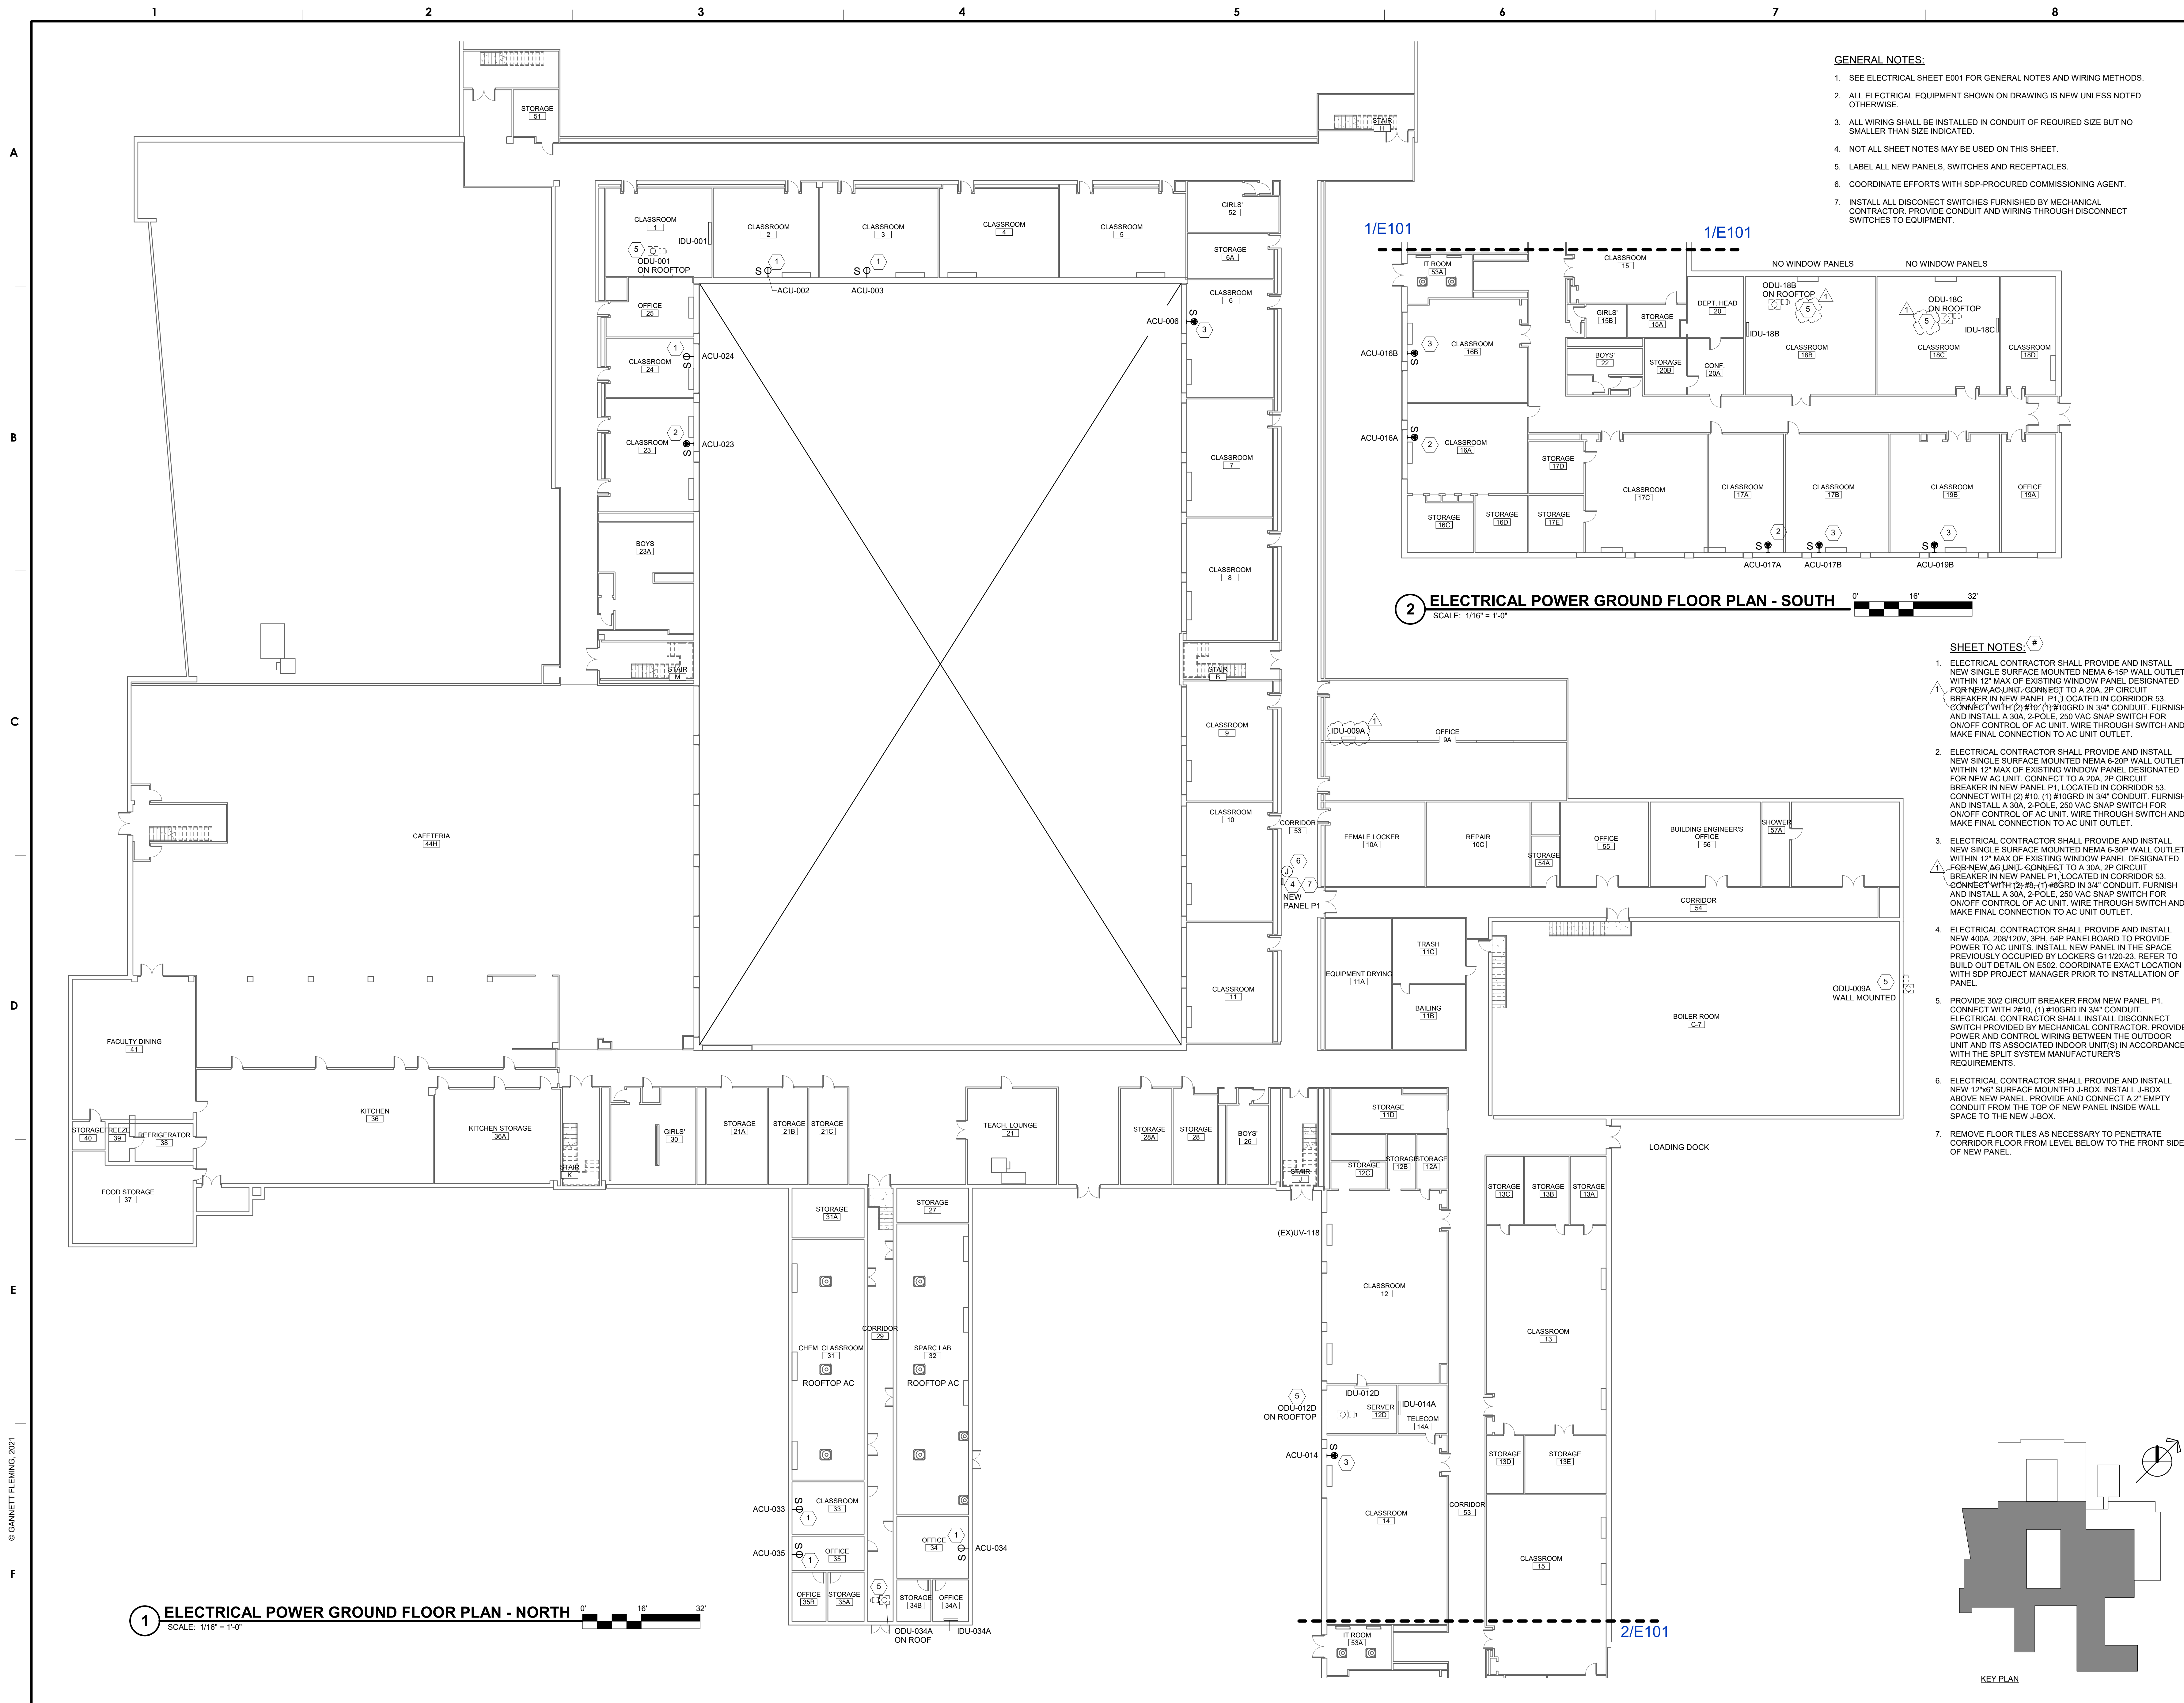


GENERAL NOTES:

1. SEE ELECTRICAL SHEET E001 FOR GENERAL NOTES AND WIRING METHODS.
2. ALL ELECTRICAL EQUIPMENT SHOWN ON DRAWING IS NEW UNLESS NOTED OTHERWISE.
3. ALL WIRING SHALL BE INSTALLED IN CONDUIT OF REQUIRED SIZE BUT NO SMALLER THAN SIZE INDICATED.
4. NOT ALL SHEET NOTES MAY BE USED ON THIS SHEET.
5. LABEL ALL NEW PANELS, SWITCHES AND RECEPTACLES.
6. COORDINATE EFFORTS WITH SDP-PROCURED COMMISSIONING AGENT.
7. INSTALL ALL DISCONNECT SWITCHES FURNISHED BY MECHANICAL CONTRACTOR. PROVIDE CONDUIT AND WIRING THROUGH DISCONNECT SWITCHES TO EQUIPMENT.

SHEET NOTES:  #

1. ELECTRICAL CONTRACTOR SHALL PROVIDE AND INSTALL NEW SINGLE SURGE MOUNTED NEMA 6-15P WALL OUTLET WITH 12" MAX OF EXISTING WOUND PANEL DESIGNATED FOR NEW AC UNIT. CONNECT TO A 30A, 2P, 250V CIRCUIT BREAKER IN NEW PANEL P2. LOCATED IN CORRIDOR 53. CONNECT WITH (2) #10, (1) #10GRD IN 3/4" CONDUIT. FURNISH AND INSTALL A 30A, 2-P, 250V VAC SWAP SWITCH FOR ON/OFF CONTROL OF AC UNIT. WIRE THROUGH SWITCH AND MAKE FINAL CONNECTION TO AC UNIT OUTLET.
2. ELECTRICAL CONTRACTOR SHALL PROVIDE AND INSTALL NEW SINGLE SURGE MOUNTED NEMA 6-20P WALL OUTLET WITH 12" MAX OF EXISTING WOUND PANEL DESIGNATED FOR NEW AC UNIT. CONNECT TO A 30A, 2P, 250V CIRCUIT BREAKER IN NEW PANEL P2. LOCATED IN CORRIDOR 53. CONNECT WITH (2) #10, (1) #10GRD IN 3/4" CONDUIT. FURNISH AND INSTALL A 30A, 2-P, 250V VAC SWAP SWITCH FOR ON/OFF CONTROL OF AC UNIT. WIRE THROUGH SWITCH AND MAKE FINAL CONNECTION TO AC UNIT OUTLET.
3. ELECTRICAL CONTRACTOR SHALL PROVIDE AND INSTALL NEW SINGLE SURGE MOUNTED NEMA 6-30P WALL OUTLET WITH 12" MAX OF EXISTING WOUND PANEL DESIGNATED FOR NEW AC UNIT. CONNECT TO A 30A, 2P, 250V CIRCUIT BREAKER IN NEW PANEL P2. LOCATED IN CORRIDOR 53. CONNECT WITH (2) #10, (1) #10GRD IN 3/4" CONDUIT. FURNISH AND INSTALL A 30A, 2-P, 250V VAC SWAP SWITCH FOR ON/OFF CONTROL OF AC UNIT. WIRE THROUGH SWITCH AND MAKE FINAL CONNECTION TO AC UNIT OUTLET.
4. PROVIDE 3002 CIRCUIT BREAKER FOR NEW PANEL P2. CONNECT WITH #10, (1) #10GRD IN 3/4" CONDUIT. 
5. ELECTRICAL CONTRACTOR SHALL INSTALL DISCONNECT SWITCH, PROTECT BY MECHANICAL CONTROLLER. PROVIDE POWER AND CONTROL WIRING BETWEEN THE OUTDOOR UNIT AND ASSOCIATED INDUOR UNIT IN ACCORDANCE WITH THE SPLIT SYSTEM MANUFACTURERS REQUIREMENTS.
6. UV UNITS 133-1 AND 133-2. RECONNECT TO EXISTING

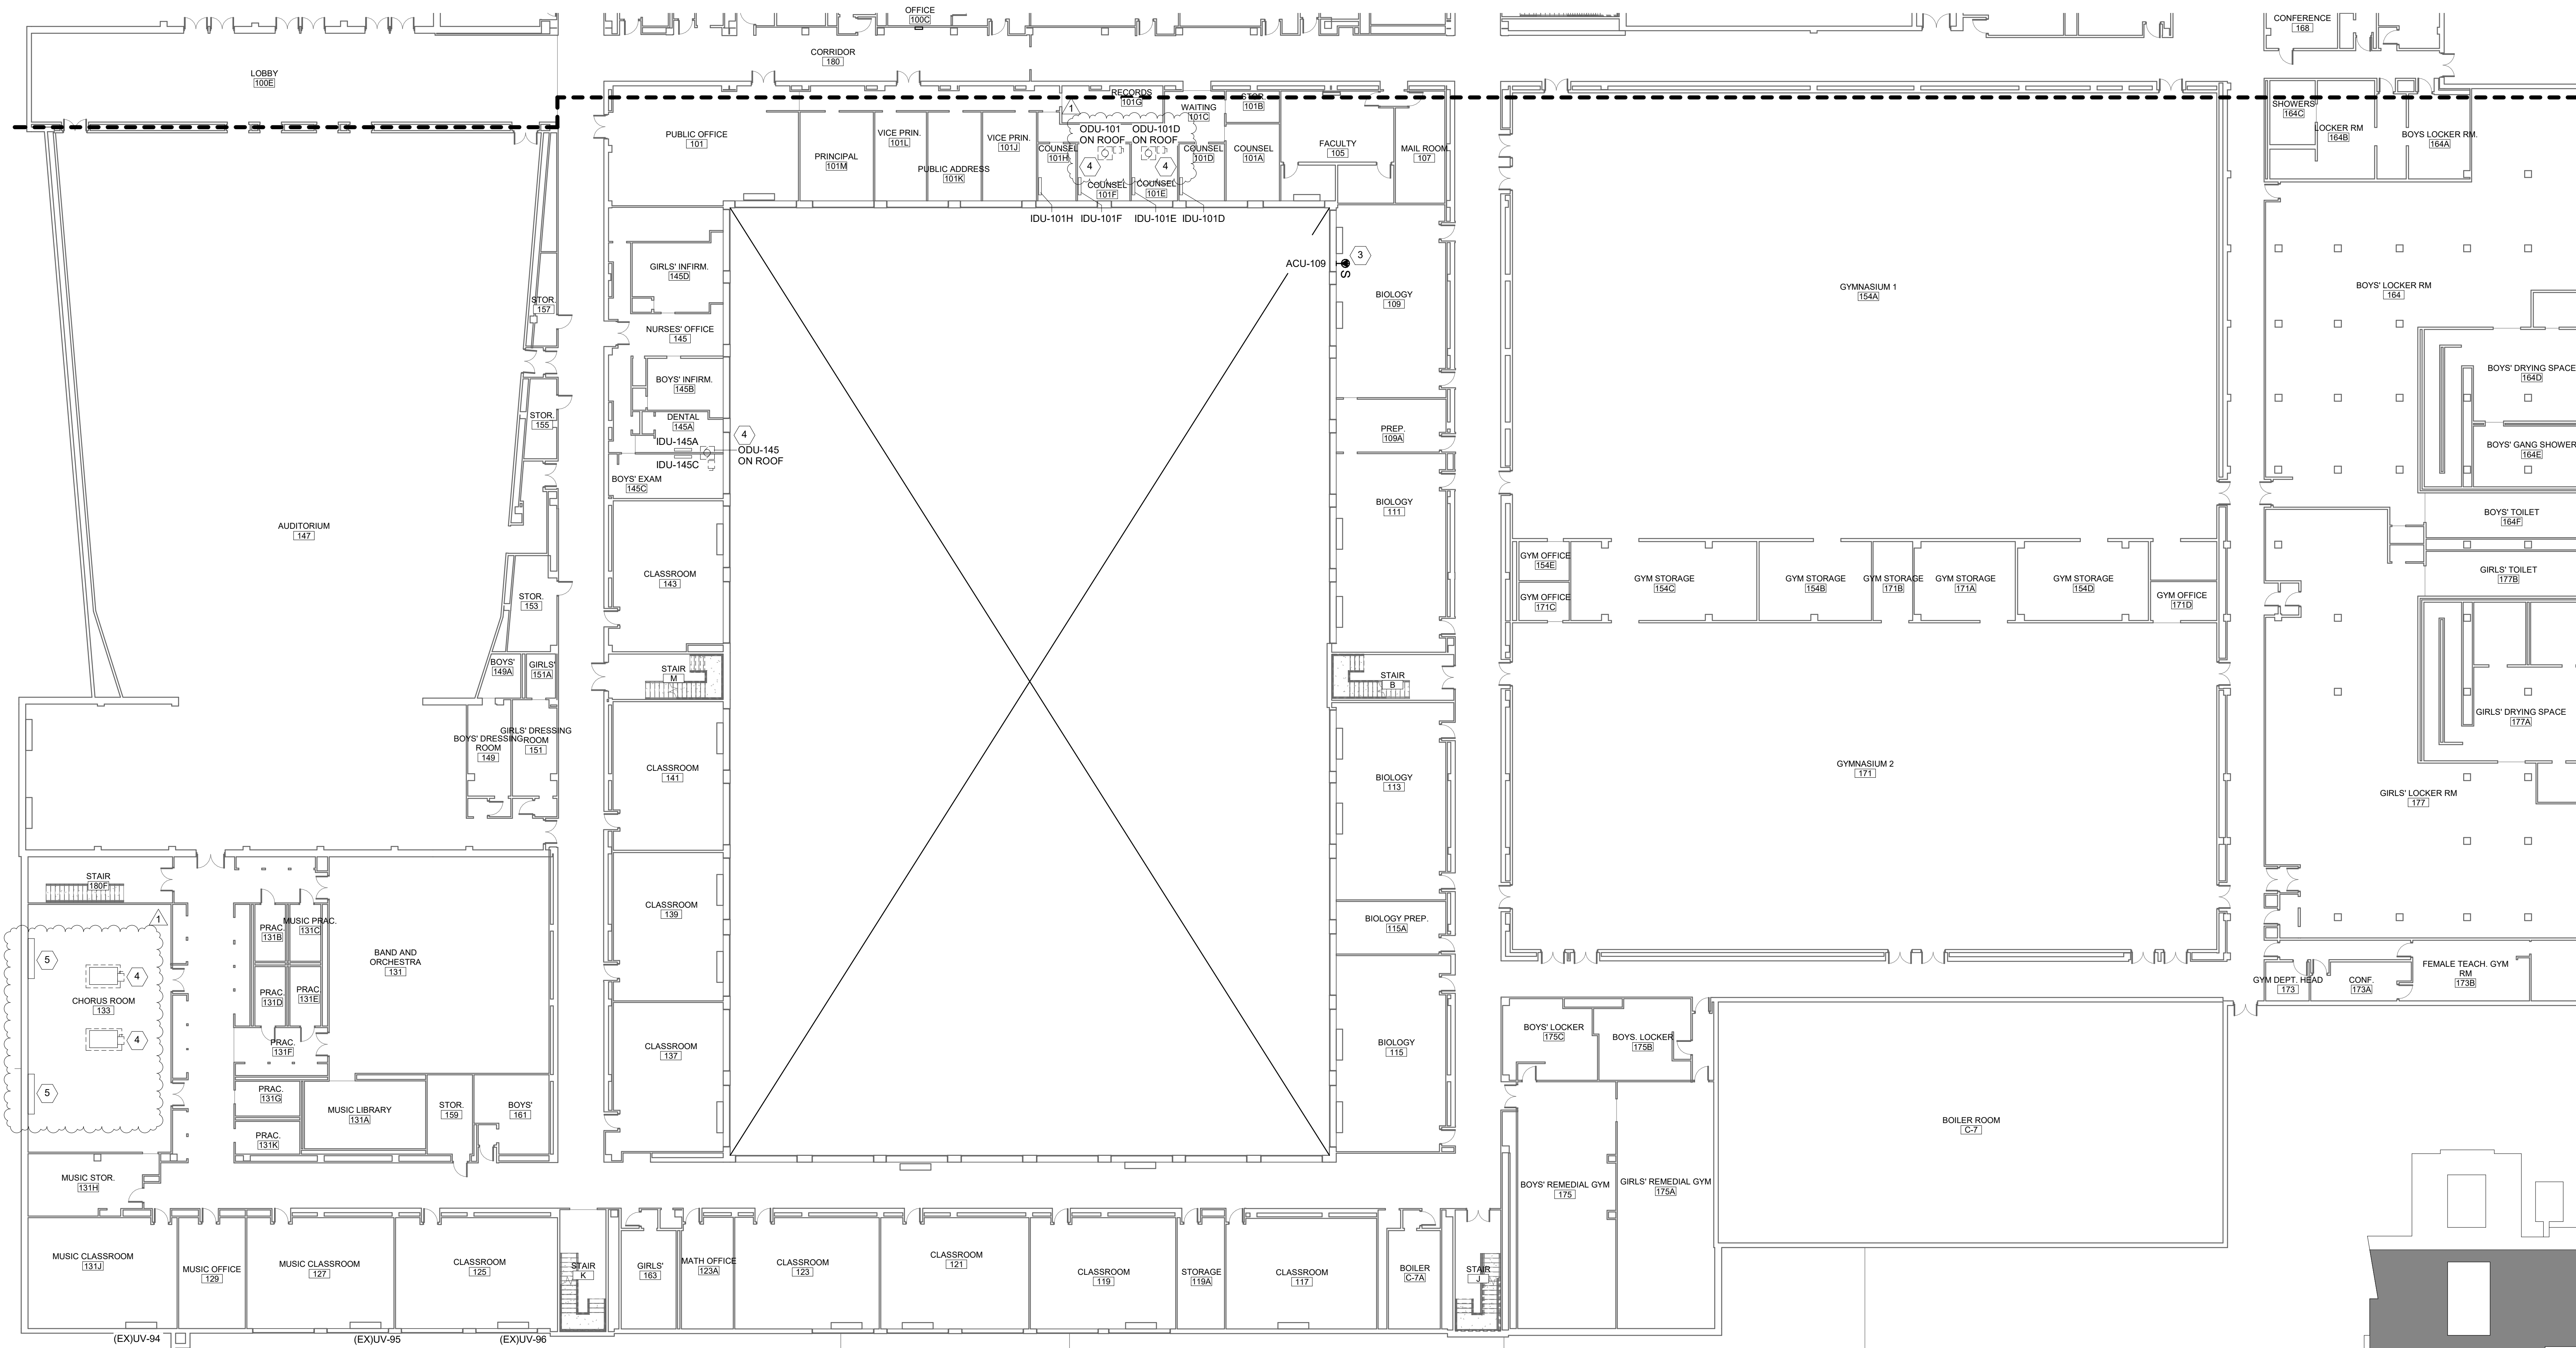

KEY PLAN

1 ELECTRICAL POWER FIRST FLOOR PLAN - SOUTH
SCALE: 1/16" = 1'-0"

ISSUED FOR BID
05/20/2021

[illegible]

SCHOOL & LOCATION
1601 COTTMAN AVE, PHILADELPHIA PA
19111

PROJECT TITLE _____

AIR CONDITIONING UPGRADE

DRAWING TITLE

**ELECTRICAL POWER FIRST
FLOOR PLAN - SOUTH**

DRAWING SCALE AS NOTED			
LOCATION NO. 8020		ENGINEER'S PRJ. NO. 068625.001	
DRAWN BY FJR		CHECKED BY BAM	
MC - B-006 C		OF	2020/21
EC - B-007 C		OF	2020/21

DRAWING NO.
E102
SHEET 13 OF 18

Local File: BWI 360/1063684 - School District of Philadelphia (R2020)063684_SOP_NEHS_DOC_MEP_CENTRAL_R20_BIM360.v4
Project Number: 066625.001
5/20/2021 1:32:49 PM

A
B
C
D
E
F

PANEL DESIGNATION						TYPE: BRANCH CIRCUIT NUMBER OF POLES: 66 MAIN BUS RATING: 400A MAIN RATING: 400A			LOCATION: GROUND FLOOR CORRIDOR 53 VOLTAGE: 208Y/120V, 3-PHASE, 4-WIRE PANEL MOUNTING: RECESSED PANEL ENCLOSURE (NEMA): 1 SHORT CIRCUIT: 22KAIC									
NEW PANEL 'P1'																		
CIR. No.	CIR. BKR.	DESCRIPTION	WIRE	GROUND	CONDUIT	LOAD - KVA			LOAD - KVA			CONDUIT	GROUND	WIRE	DESCRIPTION	CIR. BKR.	CIR. No.	
1	3					ΦA	ΦB	ΦC	ΦA	ΦB	ΦC							
1	20/2	ACU-002	#10	#10	3/4"	0.70			0.70			3/4"	#10	#10	ACU-003	20/2	2	
3							0.70										4	
5	30/2	ACU-006	#10	#10	3/4"			1.90			0.70	3/4"	#10	#10	ACU-024	20/2	6	
7						1.90											8	
9	20/2	ACU-023	#10	#10	3/4"		1.40				0.50	3/4"	#10	#10	ACU-033	30/2	10	
11								1.40									12	
13	20/2	ACU-035	#10	#10	3/4"		0.50					3/4"	#10	#10	ACU-014	30/2	14	
15							0.50				1.90						16	
17	30/2	ACU-016B	#10	#10	3/4"			1.90			1.40	3/4"	#10	#10	ACU-014A	20/2	18	
19						1.90											20	
21	20/2	ACU-017A	#10	#10	3/4"		1.40			1.40	1.40	3/4"	#10	#10	ACU-016A	20/2	22	
23								1.40									24	
25	20/2	ACU-017B	#10	#10	3/4"		1.90			1.40	1.40	3/4"	#10	#10	ACU-18D	20/2	26	
27								1.90									28	
29	30/2	ACU-17C	#10	#10	3/4"						1.40	3/4"	#10	#10	ACU-019A	20/2	30	
31						1.90											32	
33	30/2	ACU-034	#10	#10	3/4"		0.70			1.90		3/4"	#10	#10	ACU-019B	30/2	34	
35								0.70			1.90						36	
37	20/2	PTAC-035	#10	#10	3/4"		0.70			0.70		3/4"	#10	#10	ODU-009A	30/2	38	
39							0.70										40	
41	20/2	PTAC-035B	#10	#10	3/4"		0.70			0.70	0.70	3/4"	#10	#10	ODU-18B	30/2	42	
43						0.70											44	
45	30/2	ODU-001	#10	#10	3/4"			0.70		0.70	0.70	3/4"	#10	#10	ODU-18C	30/2	46	
47																	48	
49	30/2	ODU-012D	#10	#10	3/4"		0.70			0.70		3/4"	#10	#10	ODU-014A	30/2	50	
51								0.70			0.70						52	
53	30/2	ODU-034A	#10	#10	3/4"		0.70								SPARE	30/2	54	
55						0.70											56	
57	20/2	SPARE													SPARE	30/2	58	
59																	60	
61		SPACE													SPACE		62	
63		SPACE													SPACE		64	
65		SPACE													SPACE		66	
TOTAL						11.6	8.7	11.3	9.6	9.9	8.7	TOTAL						
PANEL CONNECTED LOAD																		
ΦA 21.2						X SOLID NEUTRAL BUS												
ΦB 18.6						X EQUIPMENT GROUND BUS												
ΦC 20.0						X INTEGRAL SPD												
59.8 KVA CONNECTED TOTAL																		

1 NEW PANEL P1
SCALE: 12" = 1'-0"

PANEL DESIGNATION			TYPE: BRANCH CIRCUIT NUMBER OF POLES: 66 MAIN BUS RATING: 400A MAIN RATING: 400A			LOCATION: 2nd FLOOR CORRIDOR 270 VOLTAGE: 208Y/120V, 3-PHASE, 4-WIRE PANEL MOUNTING: RECESSED PANEL ENCLOSURE (NEMA): 1 SHORT CIRCUIT: 22KAIC																	
NEW PANEL 'P3A'																							
CIR. No.	CIR. BKR.	DESCRIPTION	WIRE	GROUND	CONDUIT	LOAD - KVA			LOAD - KVA			CONDUIT	GROUND	WIRE	DESCRIPTION	CIR. BKR.	CIR. No.						
						ΦA	ΦB	ΦC	ΦA	ΦB	ΦC												
1	3	30/2 ACU-203	#10	#10	3/4"	1.90			1.90			3/4"	#10	#10	ACU-205	30/2	2						
5	7	20/2 ACU-203A	#10	#10	3/4"			1.40		1.90		3/4"	#10	#10	ACU-211	30/2	4						
9	11	30/2 ACU-213	#10	#10	3/4"	1.40		1.90			1.90	3/4"	#10	#10	ACU-217	30/2	6						
13	15	20/2 ACU-219A	#10	#10	3/4"		1.40					3/4"	#10	#10	ACU-219B	20/2	8						
17	19	20/2 ACU-241	#10	#10	3/4"			0.50		1.90		3/4"	#10	#10	ACU-221A	30/2	10						
21	23	20/2 ACU-221B	#10	#10	3/4"			1.40			1.40	3/4"	#10	#10	ACU-223C	20/2	12						
25	27	20/2 ACU-223A	#10	#10	3/4"			1.40		1.90		3/4"	#10	#10	ACU-225	30/2	14						
29	31	20/2 ACU-227A	#10	#10	3/4"				1.40		1.40	3/4"	#10	#10	ACU-227B	20/2	16						
33	35	20/2 ACU-229B	#10	#10	3/4"			1.40			1.40	3/4"	#10	#10	ACU-229C	20/2	18						
37	39	20/2 ACU-231	#10	#10	3/4"				1.40			3/4"	#10	#10	ACU-233	20/2	20						
41	43	20/2 ACU-235	#10	#10	3/4"					0.70		3/4"	#10	#10	ODU-207A	30/2	22						
45	47	30/2 SPARE	#10	#10	3/4"							3/4"	#10	#10	SPARE	20/2	24						
49		SPACE													SPACE		26						
51		SPACE													SPACE		28						
53		SPACE													SPACE		30						
55		SPACE													SPACE		32						
57		SPACE													SPACE		34						
59		SPACE													SPACE		36						
61		SPACE													SPACE		38						
63		SPACE													SPACE		40						
65		SPACE													SPACE		42						
TOTAL						10.8	10.8	9.4	12.2	11.3	10.6	TOTAL											
PANEL CONNECTED LOAD																							
ΦA 23.0						X SOLID NEUTRAL BUS																	
ΦB 22.1						X EQUIPMENT GROUND BUS																	
ΦC 20.0						X INTEGRAL SPD																	
65.1 KVA CONNECTED TOTAL																							

3 NEW PANEL P3A

PANEL DESIGNATION						TYPE: BRANCH CIRCUIT NUMBER OF POLES: 66 MAIN BUS RATING: 400A MAIN RATING: 400A			LOCATION: 1ST FLOOR CORRIDOR 180 VOLTAGE: 208Y/120V, 3-PHASE, 4-WIRE PANEL MOUNTING: RECESSED PANEL ENCLOSURE (NEMA): 1 SHORT CIRCUIT: 22KAIC											
NEW PANEL 'P2'																				
CIR. No.	CIR. BKR.	DESCRIPTION	WIRE	GROUND	CONDUIT	LOAD - KVA			LOAD - KVA			CONDUIT	GROUND	WIRE	DESCRIPTION	CIR. BKR.	CIR. No.			
						ΦA	ΦB	ΦC	ΦA	ΦB	ΦC									
1	30/2	ACU-109	#10	#10	3/4"	1.90			1.90			1.90	3/4"	#10	#10	ACU-106	30/2	2		
3							1.90										4			
5	30/2	ACU-108	#10	#10	3/4"			1.90			1.90	3/4"	#10	#10	ACU-110	30/2	6			
7						1.90											8			
9	30/2	ACU-112	#10	#10	3/4"		1.90							#10	#10	ACU-114	20/2	10		
11								1.90									12			
13	20/2	ACU-116	#10	#10	3/4"		1.40							#10	#10	ACU-118	20/2	14		
15							1.40										16			
17	20/2	ACU-120A	#10	#10	3/4"			0.50				1.90	3/4"	#10	#10	ACU-122	30/2	18		
19						0.50											20			
21	30/2	ACU-124	#10	#10	3/4"		1.90							#10	#10	ACU-126	20/2	22		
23							1.90										24			
25	20/2	ACU-134	#10	#10	3/4"	0.70						0.70	3/4"	#10	#10	ACU-138	30/2	26		
27						0.70	0.70										28			
29								0.70									30			
31	30/2	ODU-101	#10	#10	3/4"	0.70						0.70	3/4"	#10	#10	ODU-120	30/2	32		
33							0.70										34			
35	30/2	ODU-101D	#10	#10	3/4"			0.70									36			
37						0.70											38			
39	30/2	ODU-145	#10	#10	3/4"		0.70										40			
41																	42			
43	30/2	CU-133-1	#10	#10	3/4"	1.50											44			
45							1.50										46			
47	30/2	CU-133-2	#10	#10	3/4"			1.50									48			
49		SPACE															50			
51		SPACE															52			
53		SPACE															54			
55		SPACE															56			
57		SPACE															58			
59		SPACE															60			
61		SPACE															62			
63		SPACE															64			
65		SPACE															66			
TOTAL						9.3	10.7	10.6	12.7	10.3	9.6	TOTAL								
PANEL CONNECTED LOAD																				
ΦA 22.0						X SOLID NEUTRAL BUS														
ΦB 21.0						X EQUIPMENT GROUND BUS														
ΦC 20.2						X INTEGRAL SPD														
63.2 KVA CONNECTED TOTAL																				

2 NEW PANEL P2
SCALE: 12" = 1'-0"

PANEL DESIGNATION			TYPE: BRANCH CIRCUIT NUMBER OF POLES: 66 MAIN BUS RATING: 400A MAIN RATING: 400A			LOCATION: 2nd FLOOR CORRIDOR 270 VOLTAGE: 208Y/120V, 3-PHASE, 4-WIRE PANEL MOUNTING: RECESSED PANEL ENCLOSURE (NEMA): 1 SHORT CIRCUIT: 22KAIC													
NEW PANEL 'P3B'																			
CIR. No.	CIR. BKR.	DESCRIPTION	WIRE	GROUND	CONDUIT	LOAD - KVA			LOAD - KVA			CONDUIT	GROUND	WIRE	DESCRIPTION	CIR. BKR.	CIR. No.		
						ΦA	ΦB	ΦC	ΦA	ΦB	ΦC								
1						1.40			1.40										
3	20/2	SPARE	#10	#10	3/4"		1.40			1.40			3/4"	#10	#10	ACU-200	20/2		
5																			
7	20/2	ACU-202	#10	#10	3/4"			1.40		0.70			3/4"	#10	#10	ACU-204	20/2		
9						1.40													
11	20/2	ACU-206	#10	#10	3/4"		1.40			1.40			3/4"	#10	#10	ACU-208	20/2		
13																			
15	20/2	ACU-210	#10	#10	3/4"		1.40			1.40			3/4"	#10	#10	ACU-212	30/2		
17																			
19	20/2	ACU-214	#10	#10	3/4"		1.40			1.40			3/4"	#10	#10	ACU-216	30/2		
21																			
23	20/2	ACU-218	#10	#10	3/4"		1.40			1.40			3/4"	#10	#10	ACU-220	20/2		
25																			
27	30/2	ACU-222	#10	#10	3/4"		1.90			1.90			3/4"	#10	#10	ACU-232	30/2		
29							1.90			1.90									
31	20/2	ACU-234	#10	#10	3/4"		1.40			1.40			3/4"	#10	#10	ACU-236	30/2		
33																			
35	20/2	ACU-238	#10	#10	3/4"		1.40			1.40			3/4"	#10	#10	ACU-240	30/2		
37																			
39	20/2	ACU-242	#10	#10	3/4"		1.40			1.40			3/4"	#10	#10	ACU-244	30/2		
41																			
43	30/2	ODU-226	#10	#10	3/4"					0.70			3/4"	#10	#10	ODU-230	30/2		
45							0.70												
47	30/2	SPARE	#10	#10	3/4"								3/4"	#10	#10	SPARE	20/2		
49		SPACE														SPACE			
51		SPACE														SPACE			
53		SPACE														SPACE			
55		SPACE														SPACE			
57		SPACE														SPACE			
59		SPACE														SPACE			
61		SPACE														SPACE			
63		SPACE														SPACE			
65		SPACE														SPACE			
TOTAL						11.0	10.3	9.1	TOTAL						12.3	11.8	9.9	TOTAL	
PANEL CONNECTED LOAD																			
ΦA 23.3																			
ΦB 22.1																			
ΦC 19.0																			
64.4 KVA CONNECTED TOTAL																			
X SOLID NEUTRAL BUS																			
X EQUIPMENT GROUND BUS																			
X INTEGRAL SPD																			

**SECTION 09 9000
PAINTING AND COATING**

PART 1 GENERAL

1.01 SECTION INCLUDES

- A. Surface preparation.
- B. Interior painting and coating systems.
- C. Scope:
 - 1. Finish surfaces exposed to view, unless fully factory-finished and unless otherwise indicated, including the following:
 - a. Interior:
 - 1) Concrete Masonry Units: Concrete, split face, scored, smooth, high density, low density, and fluted.

1.02 REFERENCE STANDARDS

- A. 40 CFR 59, Subpart D - National Volatile Organic Compound Emission Standards for Architectural Coatings; U.S. Environmental Protection Agency.
- B. SSPC-SP 1 - Solvent Cleaning.
- C. SSPC-SP 2 - Hand Tool Cleaning.
- D. SSPC-SP 3 - Power Tool Cleaning.
- E. SSPC-SP 13 - Surface Preparation of Concrete.

1.03 SUBMITTALS

- A. See Section 01 3000 - Administrative Requirements for submittal procedures.
- B. Product Data: Provide complete list of products to be used, with the following information for each:
 - 1. Product characteristics.
 - 2. Surface preparation instructions and recommendations.
 - 3. Primer requirements and finish specification.
 - 4. Storage and handling requirements and recommendations.
 - 5. Application methods.
 - 6. Clean-up information.
- C. Samples: Submit four paper draw down samples, 8-1/2 by 11 inches in size, illustrating range of colors available for each finishing product specified.
- D. Certification: By manufacturer that paints and finishes comply with VOC limits specified.
- E. Maintenance Data: Submit coating maintenance manual including finish schedule showing where each product/color/finish was used, product technical data sheets, safety data sheets (SDS), care and cleaning instructions, touch-up procedures, repair of painted and finished surfaces, and color samples of each color and finish used.

1.04 QUALITY ASSURANCE

- A. Applicator Qualifications: Company specializing in performing the type of work specified with minimum 3 years experience and approved by manufacturer.

1.05 DELIVERY, STORAGE, AND HANDLING

- A. Deliver products to site in sealed and labeled containers; inspect to verify acceptability.
- B. Container Label: Include manufacturer's name, type of paint, product name, product code, color designation, VOC content, batch date, environmental handling, surface preparation, application, and use instructions.
- C. Paint Materials: Store at a minimum of 45 degrees F and a maximum of 90 degrees F, in ventilated area, and as required by manufacturer's instructions.

1.06 FIELD CONDITIONS

- A. Do not apply materials when environmental conditions are outside the ranges required by manufacturer.
- B. Follow manufacturer's recommended procedures for producing the best results, including testing substrates, moisture in substrates, and humidity and temperature limitations.

PART 2 PRODUCTS

2.01 MANUFACTURERS

- A. Basis of Design Products: Subject to compliance with requirements, provide Sherwin-Williams Company (The) products indicated; www.sherwin-williams.com/#sle.
- B. Comparable Products: Products of approved manufacturers will be considered in accordance with 01 6000 - Product Requirements, and the following:
 - 1. Products that meet or exceed performance and physical characteristics of basis of design products.
 - 2. Other Acceptable Manufacturers:
 - a. Benjamin Moore & Co..
 - b. PPG Industries.
 - c. Or approved equal.

2.02 PAINTINGS AND COATINGS

- A. General:
 - 1. Provide factory-mixed coatings unless otherwise indicated.
 - 2. Do not reduce, thin, or dilute coatings or add materials to coatings unless specifically indicated in manufacturer's instructions.
- B. Volatile Organic Compound (VOC) Content:
 - 1. Provide paints and finishes that comply with the most stringent requirements specified in the following:
 - a. 40 CFR 59, Subpart D--National Volatile Organic Compound Emission Standards for Architectural Coatings.
 - b. Architectural coatings VOC limits of State in which the project is located.
- C. Accessory Materials: Provide primers, sealers, cleaning agents, cleaning cloths, sanding materials, and clean-up materials as required for final completion of painted surfaces.

2.03 PAINT SYSTEMS - INTERIOR

- A. Masonry CMU: Concrete, split face, scored, smooth, high density, low density, and fluted.
 - 1. Latex Systems:
 - a. Semi-Gloss Finish High Performance (HP):
 - 1) 1st Coat: Sherwin-Williams PrepRite Block Filler, B25W25: www.sherwin-williams.com/#sle.
(a) 75 to 125 sq ft/gal.
 - 2) 2nd and 3rd Coat: Sherwin-Williams ProMar 200 HP Zero VOC Latex Semi-Gloss, B31-1950 Series: www.sherwin-williams.com/#sle.
(a) 4 mils wet, 1.6 mils dry per coat.
 - b. Eg-Shel/Satin Finish High Performance (HP):
 - 1) 1st Coat: Sherwin-Williams PrepRite Block Filler, B25W25: www.sherwin-williams.com/#sle.
(a) 75 to 125 sq ft/gal.
 - 2) 2nd and 3rd Coat: Sherwin-Williams ProMar 200 HP Zero VOC Eg-Shel, B20-1950 Series: www.sherwin-williams.com/#sle.
(a) 4 mils wet, 1.7 mils dry per coat.
 - c. Low Sheen Finish High Performance (HP):
 - 1) 1st Coat: Sherwin-Williams PrepRite Block Filler, B25W25: www.sherwin-williams.com/#sle.

- (a) 75 to 125 sq ft/gal.
- 2) 2nd and 3rd Coat: Sherwin-Williams ProMar 200 HP Zero VOC Latex Low Gloss Eg-Shel, B41-1950 Series: www.sherwin-williams.com/#sle.
- (a) 4 mils wet, 1.6 mils dry per coat.

PART 3 EXECUTION

3.01 EXAMINATION

- A. Verify that surfaces are ready to receive work as instructed by the product manufacturer.
- B. Examine surfaces scheduled to be finished prior to commencement of work. Report any condition that may potentially affect proper application.

3.02 PREPARATION

- A. Clean surfaces thoroughly and correct defects prior to application.
- B. Prepare surfaces using the methods recommended by the manufacturer for achieving the best result for the substrate under the project conditions.
- C. Masonry: Remove efflorescence and chalk.

3.03 APPLICATION

- A. Remove unfinished louvers, grilles, covers, and access panels on mechanical and electrical components and paint separately.
- B. Apply products in accordance with manufacturer's written instructions.
- C. Apply coatings at spread rate required to achieve manufacturer's recommended dry film thickness.

3.04 PRIMING

- A. Apply primer to all surfaces unless specifically not required by coating manufacturer. Apply in accordance with coating manufacturer's instructions.
- B. Primers specified in painting schedules may be omitted on items factory primed or factory finished items if acceptable to top coat manufacturers.

3.05 CLEANING

- A. Collect waste material that could constitute a fire hazard, place in closed metal containers, and remove daily from site.
- B. Clean surfaces immediately of overspray, splatter, and excess material.
- C. After coating has cured, clean and replace finish hardware, fixtures, and fittings previously removed.

3.06 PROTECTION

- A. Protect finished coatings from damage until completion of project.
- B. Touch-up damaged finishes after Substantial Completion.

END OF SECTION

This page intentionally left blank

SPECIFICATION
for
ASBESTOS ABATEMENT
at the
NORTHEAST HIGH SCHOOL
1601 Cottman Avenue
Philadelphia, Pennsylvania 19111

prepared for:

THE SCHOOL DISTRICT OF PHILADELPHIA
OFFICE OF ENVIRONMENTAL MANAGEMENT
440 North Broad Street
3rd Floor, Room 3053
Philadelphia, Pennsylvania 19130

prepared by:

SYNERTECH INCORPORATED
228 Moore Street
Philadelphia, Pennsylvania 19148
Project # 010-4629

May 25, 2021



Bernard J. Bryson
Certified Pennsylvania Asbestos Project Designer
No. 037636

1.00 INTRODUCTION

- .01** This specification outlines the required tasks and procedures involved in the removal of asbestos containing material (ACM) throughout the Northeast High School in conjunction with the Air Conditioning Upgrade Project. ACM removal, associated equipment demolition and associated decontamination cleaning procedures shall be accomplished under asbestos-abatement conditions. The Asbestos Abatement Contractor (AAC) shall be employed as a sub-contractor to the Prime Electrical Contractor (MC) awarded this project.
- a.** The AAC shall be a current pre-qualified contractor by the School District of Philadelphia and must demonstrate they have the necessary personnel, equipment, materials, and experience to complete a project of this nature in the required time period.
- .02** The scope of work includes, but is not limited to:
- a.** Removal and disposal of approximately 100 square feet of vinyl asbestos floor tile and associated mastic in various locations to allow for core drilling through floors, in accordance with PART 5.00-PREPARATION AND ABATEMENT-REMOVAL OF VINYL ASBESTOS FLOOR TILE AND MASTIC-NON-FRIABLE PROJECTS of these specifications
- b.** Drilling of holes into walls and ceilings with asbestos containing paint to allow for the installation of mechanical fasteners for mechanical, electrical and plumbing components, in accordance with PART 6.00-PREPARATION AND ABATEMENT-DRILLING OF HOLES IN WALL AND CEILINGS WITH ASBESTOS CONTAINING PAINT of these specifications
See attached Letter Report of Results ACM in Paint Testing, prepared by REPSG, dated 5/220/21, 39 pages, identifying known locations of ACM in Paint in the project area; however, ALL painted CMU walls in the project area shall be assumed to contain ACM and treated accordingly.
- c.** Stabilization of Lead Based Paint may be performed by the Electrical Contractor with its own forces, provided it is done in compliance with the requirements of PART 4-RENOVATION, REPAIR AND PAINTING-US EPA LEAD BASED PAINT RULE of Section 01 1100 ENVIRONMENTAL COORDINATION of the Construction Contract.

See attached Letter Report of Results of Lead in Paint Testing, prepared by REPSG, dated 5/20/21, 23 pages, identifying know location of Lead in Paint in the project area.
- .03** The AAC shall furnish all labor, materials, employee training, services, permits, fees, insurance and equipment necessary to carry out the asbestos removal, decontamination operations and disposal in accordance with EPA, OSHA, and all other applicable Federal, State, and local government regulations, and this Specification.

2.00 GENERAL ABATEMENT PROJECT CONDITIONS

- .01** The asbestos abatement listed are Incidental and Non-Friable Projects as defined by the Philadelphia Asbestos Control Regulation (ACR) and shall comply with all requirements therein.
 - a.** The AAC shall have a PA licensed Supervisor on site at all times during asbestos abatement activities. The AAC shall not perform any abatement activities, including prep, bag-out, and teardown unless a City of Philadelphia certified API is on site.
- .02** The AAC shall be served with a Stop Work Order by the Project Designer and/or API when they are in non-compliance with this Contract Specification and/or other pertinent regulations (Refer to *Section 3.01.a-o*).
 - a.** The project shall remain halted until all matters identified in the Stop Work Order are corrected.
- .03** The Owner reserves the right to require asbestos abatement and associated work is performed at times when the building is unoccupied.

3.00 QUALITY ASSURANCE

- .01** All work and disposal shall be performed in compliance with all applicable Federal, State, and local regulations including, but not limited to:
- a.** 29 CFR 1926.1101 (OSHA);
 - b.** 29 CFR 1926.501 (OSHA);
 - c.** 40 CFR Part 61 (NESHAP);
 - d.** 40 CFR Part 763 (AHERA);
 - e.** 40 CFR 761 (PCB Regulations);
 - f.** Resource Conservation and Recovery Act (RCRA);
 - g.** 40 CFR 300-399, EPA Comprehensive Environmental Response Compensation & Liability Act
 - h.** 40 CFR 745, EPA Toxic Substances Control Act; LBP Poisoning Prevention
 - i.** EPA Renovation, Repair, and Painting (RRP) rule under the Toxic Substances Control Act
 - j.** 49 CFR 171-180, DOT Hazardous Material Regulations
 - k.** 42 CFR Part 84 & 30 CFR Part 11 (NIOSH/DHHS respirator standards);
 - l.** the Asbestos Control Regulation (Philadelphia Department of Public Health);
 - m.** Act 194 & Act 161 (Pennsylvania Department of Labor and Industry);
 - n.** Section F-315.8 (R) of the Philadelphia Fire Prevention Code;
 - o.** this Specification.
- .02** The AAC has the responsibility of informing themselves fully of the requirements of these agencies and shall satisfy completely this Specification and all referenced regulations. All other applicable federal state and local regulations are incorporated by reference.
- .03** The AAC must be a City of Philadelphia Licensed Asbestos Abatement Contractor as well as a Pennsylvania Licensed Asbestos Contractor and employ asbestos workers certified to work in the state of Pennsylvania.
- .04** Heavy-duty polyethylene tape shall be used for sealing fixed objects, the construction of critical barriers, decontamination chambers and tent containments.

4.00 NOTIFICATIONS

- .01** The AAC shall notify all applicable agencies including the EPA, DEP, and Philadelphia Air Management Services, using the appropriate form(s), prior to the commencement of asbestos abatement project.

**5.00 PREPARATION & ABATEMENT – REMOVAL OF VINYL ASBESTOS FLOOR TILE
AND MASTIC – NON-FRIABLE PROJECTS**

- .01** This section is intended to specify the acceptable non-friable methods for the removal of vinyl asbestos floor tile and associated mastic.
- a.** Removal of vinyl floor tile shall be performed using infra-red heat machines or dry-ice along with a chemical solvent for mastic removal.
 - b.** If it is apparent the AAC cannot remove the floor tile and/or mastic in a non-friable manner, the API will stop work and all requirements of a friable project will be implemented at no additional cost to the Owner.
- .02** The AAC shall assure that exits from the building are not obstructed and that appropriate safety barriers are established to prevent access to the work area by unauthorized persons. The work areas are to be kept neat, clean, and safe.
- .03** Only approved noncombustible or flame-resistant materials shall be used in the construction of temporary enclosures. Polyethylene sheeting to be used shall be certified to conform to NFPA 701.
- .04** Post OSHA specified, asbestos specific danger signs at the entrance to the work area.
- .05** Assure any HVAC systems associated with or which course through any work area are sealed, shut down and locked out.
- a.** The AAC shall supply sufficient temporary lighting to illuminate the work area during abatement.
- .06** Install an approved high quality HEPA equipped air filtration devices (AFDs) so as to develop and hold a negative differential air pressure. The AFD exhaust shall be vented outside of the building.
- .07** Construct a one-stage decontamination unit at the work area entrance. Workers shall wear two disposable Tyvek-type suits and a Type A respirator in the work area.
- .08** Install critical barriers consisting of one (1) layer of six-mil polyethylene over all doors, HVAC ducts and any other critical openings inside the work area such that the work area is isolated from the rest of the building. Areas where critical barriers are to be installed shall first be pre-cleaned via wet wipe and HEPA vacuum techniques.
- .09** Upon completion of preparation of the work area and approval by the API, perform removal of the floor tile, using the appropriate non-friable method to facilitate non-friable removal. Tiles shall be removed and placed into waste containers in as complete sections as possible to minimize the release of asbestos fibers and dust.
- a.** Remove all binding strips or other restrictive moldings holding floor tile at locations such as doorways, walls, thresholds, etc...
 - b.** Using the appropriate non-friable method to loosen the tile's adhesion to the substrate, wedge a scraper beneath the edge of the floor tile and lift the tile intact to minimize the release of asbestos fibers and dust.

- .10** If it is apparent the AAC cannot remove the tiles in a non-friable manner without breakage, work will be stopped by the API and all requirements of a friable project will be implemented, as per ACR Section V1.
- .11** Remove all remaining mastic residue from concrete floor surfaces using a chemical solvent.
- .12** Upon completion of all floor tile and mastic, perform final cleaning of the work area. Final cleaning shall be performed via HEPA vacuum and wet wiping techniques. AFDs shall remain in operation during this procedure.
- .13** The API shall conduct a detailed final inspection to ensure that no visible dust or ACM debris (tile chips, dust) remains on any surfaces.
- .14** The floor surface need not be encapsulated, as some replacement tile/mastic system manufacturers instructions preclude the use of an encapsulant in order to ensure proper adhesive performance.
- .15** Final air sampling is recommended for documentation for any potential future inquiries regarding the protocols and protections used during the renovation project. Air sampling requirements shall be adopted by the School District of Philadelphia Office of Environmental Services.
- .16** Carefully dismantle all materials used in the work area containment. Removed ACM and materials used in the work area containment shall be disposed of in sealable plastic bags as asbestos contaminated waste.

6.00 PREPARATION & ABATEMENT – DRILLING OF HOLES INTO WALLS AND CEILINGS WITH ASBESTOS CONTAINING PAINT

- .01** Paint applied to CMU block walls, concrete columns and concrete ceilings is assumed and, in some cases, confirmed to contain low levels of chrysotile asbestos. This section is intended to specify the acceptable methods for the drilling of holes into painted structures to allow for the installation of fasteners intended to secure mechanical, electrical and plumbing components.
- .02** All locations of asbestos containing paint impact via drilling should be considered **Incidental Projects** according to the Philadelphia ACR (5 sf or less of friable surfacing area impact – meaning, it would take in excess of 2,880 drill penetrations to exceed 5 sf of paint impact with a ¼” drill bit; 1440 drill penetrations with a ½” drill bit, and so on).
- .03** All building occupants shall be removed from the work area floors during this project.
- .04** All necessary building occupants remaining in the building during the asbestos abatement project shall be denied access to the asbestos abatement work area(s) by isolation barriers and/or locked doors.
- .05** Assure any HVAC systems associated with or which course through any work area are sealed, shut down and locked out.

 - a.** The AAC shall supply sufficient temporary lighting to illuminate the work area during abatement.
- .06** Erect a tent containment consisting of walls and ceiling, completely enclosing and isolating the drill location(s) using one (1) layer of six (6) mil polyethylene sheeting. Seal the tent containment to the wall/ceiling in which the drilling is to occur. Polyethylene sheeting shall be installed in such a manner as to cause minimal damage to underlying surfaces. The AAC shall ensure proper adhesion of the sheeting to problem areas, such as walls with peeling paint.
- .07** Construct an airlock at the entrance to the tent containment. The airlock shall consist of two sheets of polyethylene sheeting.

 - a.** One sheet shall be completely taped along all four edges. The polyethylene sheeting is then cut down the middle.
 - b.** The second sheet shall be taped along the top and acts as a flap covering the slit in the first sheet of plastic.
- .08** Tape one (1) layer of six (6) mil polyethylene sheeting to the floor of the tent containment.
- .09** All fixed, unmovable objects to be enclosed in the tent containment shall be pre-cleaned and sealed with one (1) layer of six (6) mil polyethylene sheeting.
- .10** Post OSHA specified, asbestos specific danger signs at the entrance to the tent containment. Such signs shall also be posted when applicable to critical and separation barriers, and waste storage containers.

- .11 Cut a slit into the tent containment to allow for the passage of the hose of a HEPA vacuum into the tent. Power the HEPA vacuum on and maintain operation of the HEPA vacuum to provide a negative pressure differential inside the tent containment throughout the drilling and subsequent cleaning tasks.
- .12 Install a tack-pad at the tent containment entrance.
- .13 The AAC shall wear an approved respirator and protective clothing during the drilling processes and subsequent cleaning tasks (dual cartridge, air purifying respirator [Type A] and disposable Tyvek-type suit).
- .14 Install painter's tape at the drill location to limit the disturbance and fracturing of the paint around the drill hole location. Utilize a sharp masonry drill bit and a hammer drill. The drill shall be equipped with a shroud or containment system equipped with a HEPA vacuum attachment to collect dust and debris at the point of generation.
- .15 After the hole has been drilled, remove the painter's tape and clean all residue from the fastener holes, as well as any dust and debris released onto the polyethylene floor and wall sheeting, utilizing wet-wiping and HEPA vacuum techniques.
- .16 Encapsulate around the drill location using an encapsulant approved by the Department of Public Health. The API shall inspect the sealant/encapsulant to confirm adequate and proper application.
- .17 Carefully roll up the polyethylene floor sheeting inside the tent containment and tack-pad at the tent containment entrance. Place the rolled polyethylene sheeting and tack-pad into appropriate asbestos waste containers.
- .18 Remove the tent containment from the wall/ceiling location and apply encapsulant to any areas that affected the adhesion of the painted surface the tape was adhered to.
- .19 This process shall be repeated for all drill fastener installation locations. The AAC may be able to relocate and reuse the tent containment following an acceptable final visual inspection by the onsite API.
- .20 Final air sampling is recommended for documentation for any potential future inquiries regarding the protocols and protections used during the renovation project. Air sampling requirements shall be adopted by the School District of Philadelphia Office of Environmental Services.
- .21 Carefully dismantle all materials used in the work area containment. Removed ACM and materials used in the work area containment shall be disposed of in sealable plastic bags as asbestos contaminated waste.

7.00 ACM WASTE DISPOSAL

- .01** Approval must be obtained from the API prior for temporary storage of any asbestos waste containers or construction debris on site, prior to being loaded into appropriate dumpsters. The waste shall be appropriately packaged according to the type of waste. A polyethylene drop cloth and covering shall be provided and the storage areas restricted by barrier tape and appropriate signage. Asbestos waste containers must be distinctly stored separately from other waste. No long-term storage may occur in these areas.
- .02** The loading, transportation, and disposal of asbestos waste at the landfill shall occur in accordance with regulatory requirements of NESHAPS and applicable state and local guidelines and regulations.
- .03** Waste disposal containers shall conform to one of the following. Waste with sharp edges shall not be disposed of solely in polyethylene bags. All six-mil polyethylene bags shall be transparent so that when filled, the contents of the bag are readily visible.
 - a.** Two (2) six-mil polyethylene bags, one placed inside the other, separately sealed. The bags shall be carefully closed to minimize dead air space and taped shut.
- .04** The AAC shall label asbestos waste with the name of the generator and the location from which the waste was generated.
- .05** The container used for transporting and disposing of ACM waste shall be clearly and properly labeled as specified in EPA and DOT regulations. In addition to generator labels, containers must carry the following labels:

**DANGER
CONTAINS ASBESTOS FIBERS
AVOID CREATING DUST
CANCER AND LUNG DISEASE HAZARD**

-and-

DOT labels requirement: (Easily readable in sharp relief)

**CAUTION
Contains Asbestos Fibers
Avoid Opening or Breaking Container
Breathing Asbestos is Hazardous
to your Health
RQ ASBESTOS
9,NA2212,PG III
(ASBESTOS)**

- .06** During waste load out, post asbestos specific danger signs along the waste disposal route, and on and around the vehicle or dumpster being used to transport the waste off site.

- .07** Waste routes must be approved by the Owner and on-site API prior to the commencement of work. All waste being transported through the building must be placed in covered/enclosed containers bearing proper warning signs. The waste route must be kept clean.

 - a.** The rolling of waste drums or the dropping of waste bags down stairs is strictly prohibited!
 - b.** After transport of waste through the building is completed, the AAC shall wet mop the waste removal route to assure continued cleanliness and removal of any debris associated with the waste transport tasks.
- .08** All documentation of transportation and disposal transactions such as dump receipts, trip tickets and waste manifests shall be completed and delivered to the Owner for their records.
- .09** Should the Owner not receive a receipt of the waste shipment record within 35 days, the Owner shall contact the AAC to determine the status/disposition of the waste.
- .10** Should the Owner not receive a receipt of the waste shipment record within 45 days, the Owner shall notify the EPA.

8.00 PROJECT CLOSEOUT

- .01** After achieving acceptable air sample clearance and dismantling the work area, the AAC shall be released after the following items are completed:
- a.** Removal of all temporary signs, labels, tape and glue/tape adhesive residue.
 - b.** Removal of all temporary devices, facilities, and equipment.
 - c.** Cleaning the project site and storage areas of trash, etc.
 - d.** Replacement/repair of any damage.
 - e.** SDP deems the repair work (if any) is acceptable for re-occupancy.
 - f.** Removal of all waste containers (asbestos, scrap, and construction debris) from site and proper disposal of waste.
- .02** Upon completion of the project, the AAC shall submit final documentation to the Owner, including but not limited to, all waste handling/shipping documentation/manifests.

END OF SPECIFICATION



May 20, 2021

The School District of Philadelphia
Office of Capital Programs
440 North Broad Street
Philadelphia, PA 19130
Attn: Mr. Kevin Meldrum
kmeldrum@philasd.org

RE: Results of ACM in Paint Testing
Capital Project – Air Conditioning System Upgrade
North East High School (ULCS No. 8020)
1601 Cottman Avenue
Philadelphia, PA 19111
REPSG Project Number 12654.240.01

Dear Mr. Meldrum

React Environmental Professional Services Group, Inc., (REPSG) has performed asbestos in paint testing at “North East High School (ULCS No. 8020)” located at 1601 Cottman Avenue in the City of Philadelphia, Pennsylvania (the subject property).

The scope of this investigation was limited to building components at accessible areas of the subject property structure within the scope of planned air conditioning system upgrades. Components included within this scope of work included select concrete masonry unit (CMU) walls covered in at least one coat of visible and deteriorating paint that were within the planned installation scope of work at the subject property. This letter report summarizes the sampling activities performed and the results of the asbestos analyses.

Asbestos containing material (ACM) is defined as material that is shown by polarized light microscopy (PLM) techniques to contain greater than 1% asbestos. Friable ACMs are those that when dry can be pulverized by hand pressure and are therefore more susceptible to creating airborne asbestos hazards.

This survey was conducted by Ms. Suzanne Shourds, Mr. James Arbuckle, and Ms. Quanda Beck, EPA-accredited and Philadelphia-certified Asbestos Investigators. All sampling was conducted in

P.O. Box 5377
6901 Kingsessing Avenue, Suite 201
Philadelphia, PA 19142-0377

Office: 215.729.3220
Fax: 215.729.1557
www.repsg.com

The School District of Philadelphia
May 20, 2021

Asbestos Paint Sampling Services
North East High School (ULCS No. 8020)
1601 Cottman Ave, Philadelphia, PA 19111
REPSG Project Number 12654.240.01

accordance with AHERA regulations.

The samples of suspected ACMs were submitted to EMSL Analytical Inc., an analytical testing laboratory located in Cinnaminson, New Jersey, for analysis. EMSL is an American Industrial Hygiene Association (AIHA) and National Voluntary Laboratory Accreditation Program (NVLAP) accredited laboratory. Due to positive stops and the presence of multiple layers of materials on samples, a total of 104 samples were analyzed via polarized light microscopy (PLM EPA Method 600/R-93/116), and one (1) sample was analyzed via 400-point count methodology.

The results of the laboratory testing that indicate the presence of asbestos in paint on CMU walls at the subject property are summarized on **Table 1**. Full documentation of the sampling and analysis, including laboratory analysis reports and chain of custody documentation, are included in the Philadelphia A.I.R., included as an attachment to this letter.



Table 1: Summary Results of Asbestos in Paint at the Subject Property

Building Element (ID)	Floor	Space # (on Floor Plan)	Space Type	On-Site Room Name	Material Description	Observable Color	Asbestos Content	Amount of Material (SF)	Amount of Damage
B802001-3	1	150	Senior High	Classroom 150	CMU Block Wall Paint	Peach on Yellow on White	<1% Chrysotile	1840	0
B802001-3	1	152A	Senior High	Classroom 152A	CMU Block Wall Paint	Peach on Yellow on White	Assumed (Same Top Layer of Material as in Classrooms 150 & 154)	1840	0
B802001-3	1	154	Senior High	Classroom 154	CMU Block Wall Paint	Peach on Yellow on White	<1% Chrysotile	1840	0
B802001-3	1	156	Senior High	Classroom 156	CMU Block Wall Paint	Peach on Yellow on White	Assumed (Same Top Layer of Material as in Classrooms 150 & 154)	1840	0
B802001-3	1	158	Senior High	Classroom 158	CMU Block Wall Paint	Blue on White	2% Chrysotile	1840	5 LF (Scattered)
B802001-3	1	160	Senior High	Classroom 160	CMU Block Wall Paint	Blue on White	Assumed (Same Top Layer of Material as in Classrooms 158)	1840	10 SF (Scattered)
B802001-1	2	246A	Restrooms, Staff - Male	Men's Staff/Faculty Restroom across from Classroom 201	CMU Block Wall Paint	Yellow-Tan	<0.25% Chrysotile	950	0

P.O. Box 5377
 6901 Kingsessing Avenue, Suite 201
 Philadelphia, PA 19142-0377

Office: 215.729.3220
 Fax: 215.729.1557
www.repsg.com

The School District of Philadelphia
May 20, 2021

Asbestos Paint Sampling Services
North East High School (ULCS No. 8020)
1601 Cottman Ave, Philadelphia, PA 19111
REPSG Project Number 12654.240.01

Based upon observations completed by REPSG during the course of this inspection, the presence of asbestos in paint on CUM walls within all classrooms at the building element wing housing classrooms 150 to 160 should be assumed.

Notated diagrams indicating the approximate locations of ACM paint covered components at the subject property are included attachments to this letter.

If you have any further questions or comments, please do not hesitate to contact our office.

Sincerely,
REPSG Environmental Professional Services Group, Inc.



Suzanne Shourds
Senior Project Manager
Philadelphia Asbestos Building Inspector License No.: AIC-0624

Attachments





THE SCHOOL DISTRICT OF PHILADELPHIA

NORTHEAST HIGH SCHOOL 1601 COTTMAN AVE, PHILADELPHIA, PA 19104 NORTHEAST HIGH SCHOOL AIR CONDITIONING UPGRADE

100% Design Submission: April 30, 2021

OWNER

SCHOOL DISTRICT OF PHILADELPHIA
440 North Broad
Philadelphia, PA 19130-4015
Phone: 215-400-4740
Fax: 215-400-4721
Email: nward@philsd.org
Attn: Nicole Ward, Design Manager
Office of Capital Programs
www.philsd.org

ENGINEER OF RECORD

GANNETT FLEMING, INC.
1010 Adams Avenue
Valley Forge, PA 19403
Phone: 610-650-8156
Fax: 610-650-8190
Email: bwelsser@gfnet.com
Attn: Brian M. Welsser, P.E.

ZONING DATA

EDUCATIONAL
OCCUPANCY

BUILDING DATA

ORIGINAL CONSTRUCTION: 1957
MAJOR RENOVATIONS: 1973 - SPARC WING
GROUND FLOOR: 105,660 SF
FIRST FLOOR: 158,490 SF
SECOND FLOOR: 88,133 SF
TOTAL AREA: 352,283 SF
UNSPRINKLED

CODE DATA

1. PHILADELPHIA BUILDING CONSTRUCTION AND OCCUPANCY CODE:
 - SUBCODE "A": THE PHILADELPHIA ADMINISTRATIVE CODE
 - SUBCODE "B": THE PHILADELPHIA BUILDING CODE
 - SUBCODE "E": THE PHILADELPHIA ELECTRICAL CODE
 - SUBCODE "EP": THE PHILADELPHIA EXISTING BUILDING CODE
 - SUBCODE "EO": THE PHILADELPHIA ENERGY CONSERVATION CODE
 - SUBCODE "FP": THE PHILADELPHIA FIRE CODE
 - SUBCODE "FC": THE PHILADELPHIA CODE FOR BUILDINGS AND MAINTENANCE
 - SUBCODE "PM": THE PHILADELPHIA PROPERTY MAINTENANCE CODE
 - PHILADELPHIA CROSS CONNECTION CODE
 - 2018 INTERNATIONAL BUILDING CODE CHAPTER 11 AND APPENDIX E (ADA)
2. NFPA 70-2017, NATIONAL ELECTRIC CODE
3. NFPA 72-2013, NATIONAL FIRE ALARM CODE

SUBCONTRACTOR RESPONSIBILITIES

THE ELECTRICAL CONTRACTOR IS RESPONSIBLE FOR PROCUREMENT OF THE ENVIRONMENTAL REMEDIATION CONTRACTOR AND EXECUTION OF ALL ASBESTOS ABATEMENT AND LEAD-BASED PAINT/ABATEMENT REQUIRED FOR THE PERFORMANCE OF THE WORK OF THIS CONTRACT.



LOCATION MAP

SCALE: NTS

DRAWING LIST		
SHEET #	DRAWING #	SHEET NAME
1	0001	COVER SHEET
2	W001	LEGEND, ABBREVIATIONS & GENERAL NOTES
3	W101	MECHANICAL HVAC BROWNE FLOOR PLAN
4	W102	MECHANICAL HVAC FIRST FLOOR PLAN - SOUTH
5	W103	MECHANICAL HVAC FIRST FLOOR PLAN - NORTH
6	W104	MECHANICAL HVAC SECOND FLOOR PLAN - SOUTH
7	W105	MECHANICAL HVAC SECOND FLOOR PLAN - NORTH
8	W001	MECHANICAL SCHEDULES AND DETAILS
9	E001	ELECTRICAL ABBREVIATIONS & GENERAL NOTES
10	E101	ELECTRICAL POWER GROUND FLOOR
11	E102	ELECTRICAL POWER FIRST FLOOR & BASEMENT 1
12	E103	ELECTRICAL POWER FIRST FLOOR PLAN PART 2
13	E104	ELECTRICAL POWER SECOND FLOOR PLAN PART 1
14	E105	ELECTRICAL POWER SECOND FLOOR PLAN PART 2
15	E001	PHILADELPHIA ELECTRICAL SCHEDULES
16	E002	ELECTRICAL SCHEDULES AND DETAILS

THE SCHOOL DISTRICT OF
PHILADELPHIA

OFFICE OF CAPITAL PROGRAMS

440 NORTH BROAD STREET
PHILADELPHIA, PA 19130 - 4015
TEL: 215-400-4740 | FAX: 215-400-4721 (Ext.)
www.philsd.org

SEAL:

ENGINEER OF RECORD:

NICHOLAS J. LAMBERTS, ENGINEER
GANNETT FLEMING, INC.
1010 ADAMS AVENUE
VALLEY FORGE, PA 19403
Phone: 610-650-8156
Email: BWELSSER@GFNET.COM
Attn: Brian Welsser

100% SUBMISSION
04/30/2021

NO.	DATE	REVISION


SCHOOL & LOCATION
1601 COTTMAN AVE, PHILADELPHIA, PA
19111


PROJECT TITLE
AIR CONDITIONING UPGRADE

DRAWING TITLE

COVER SHEET

DRAWING SCALE	
AS NOTED	
LOCATION NO.	ENGINEER'S P.E. NO.
NSP	00000000
DRAWN BY	CHECKED BY
NSP	NSP
MC - 8-000 - 00	2020/01
PC - 8-000 - 00	2020/01
TC - 8-000 - 00	2020/01
DRAWING NO.	
G001	
SHEET 1 OF 16	

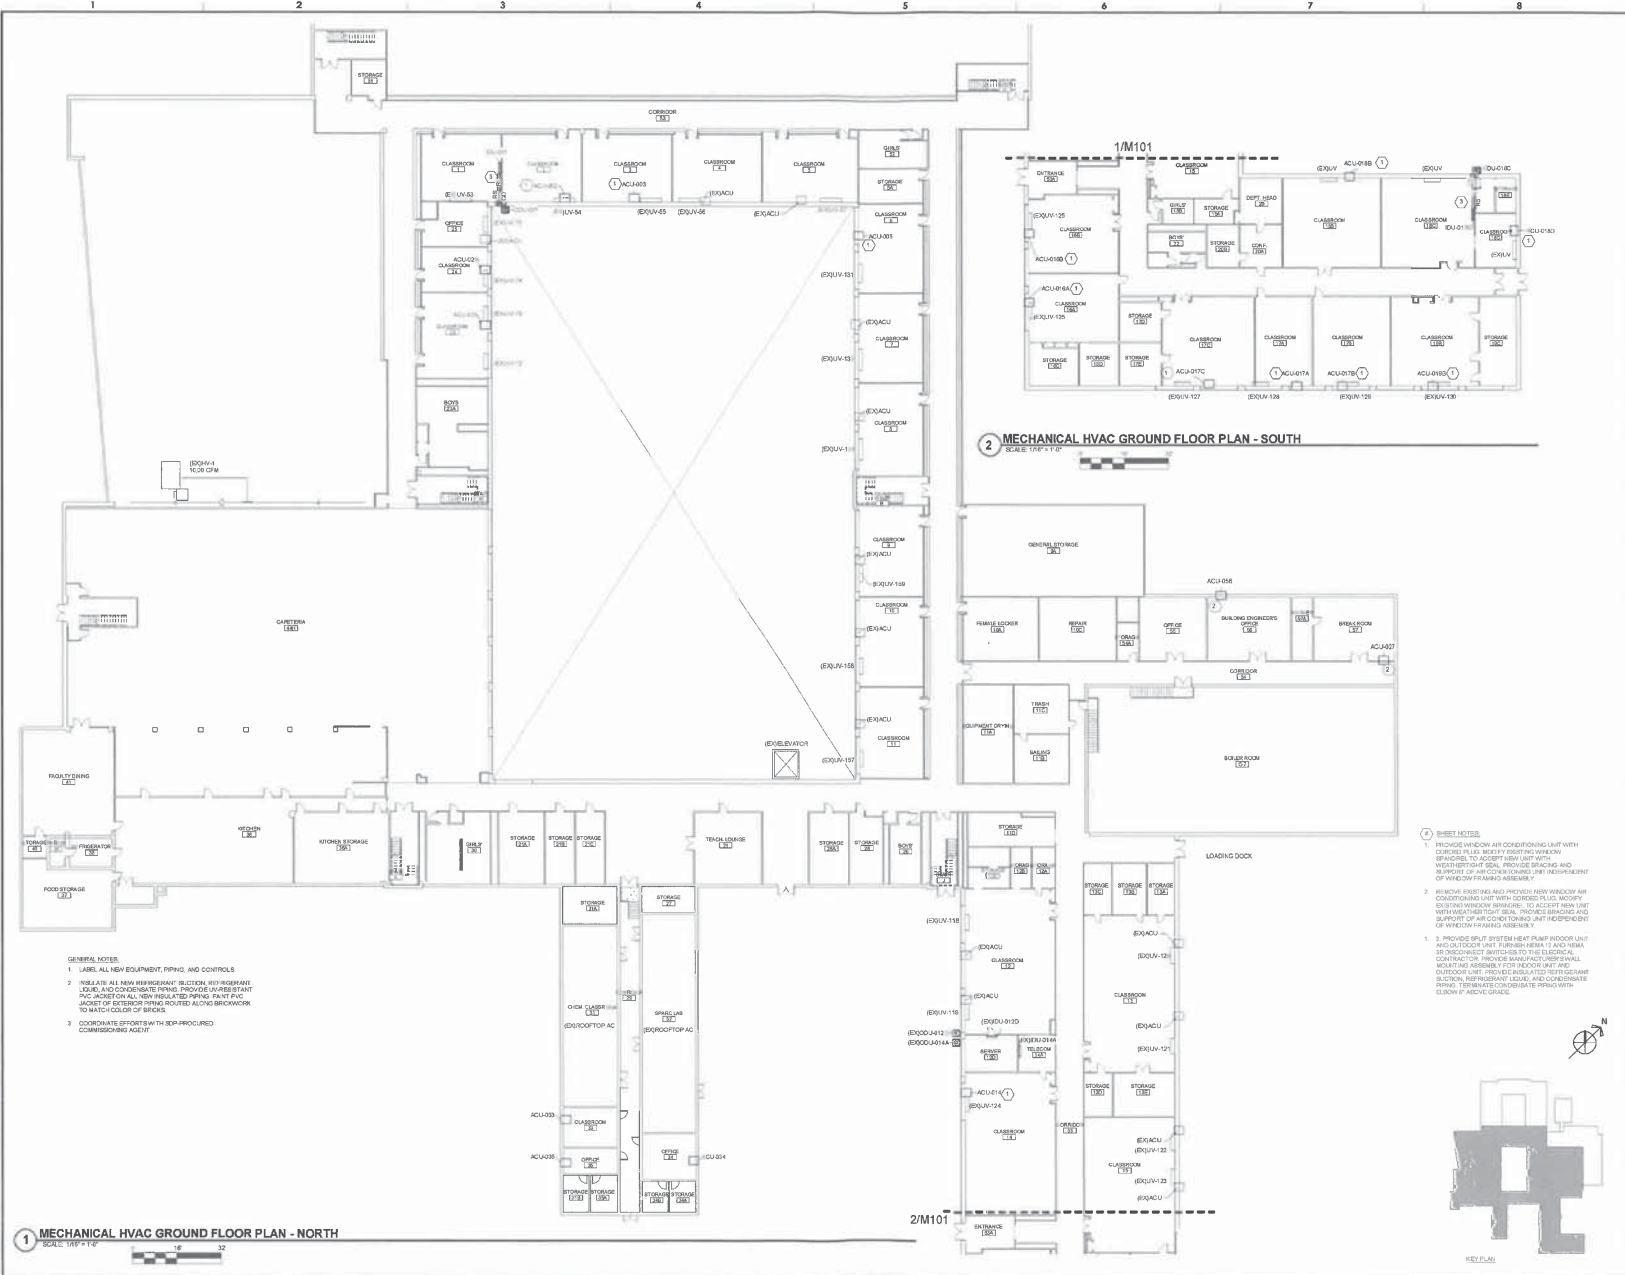

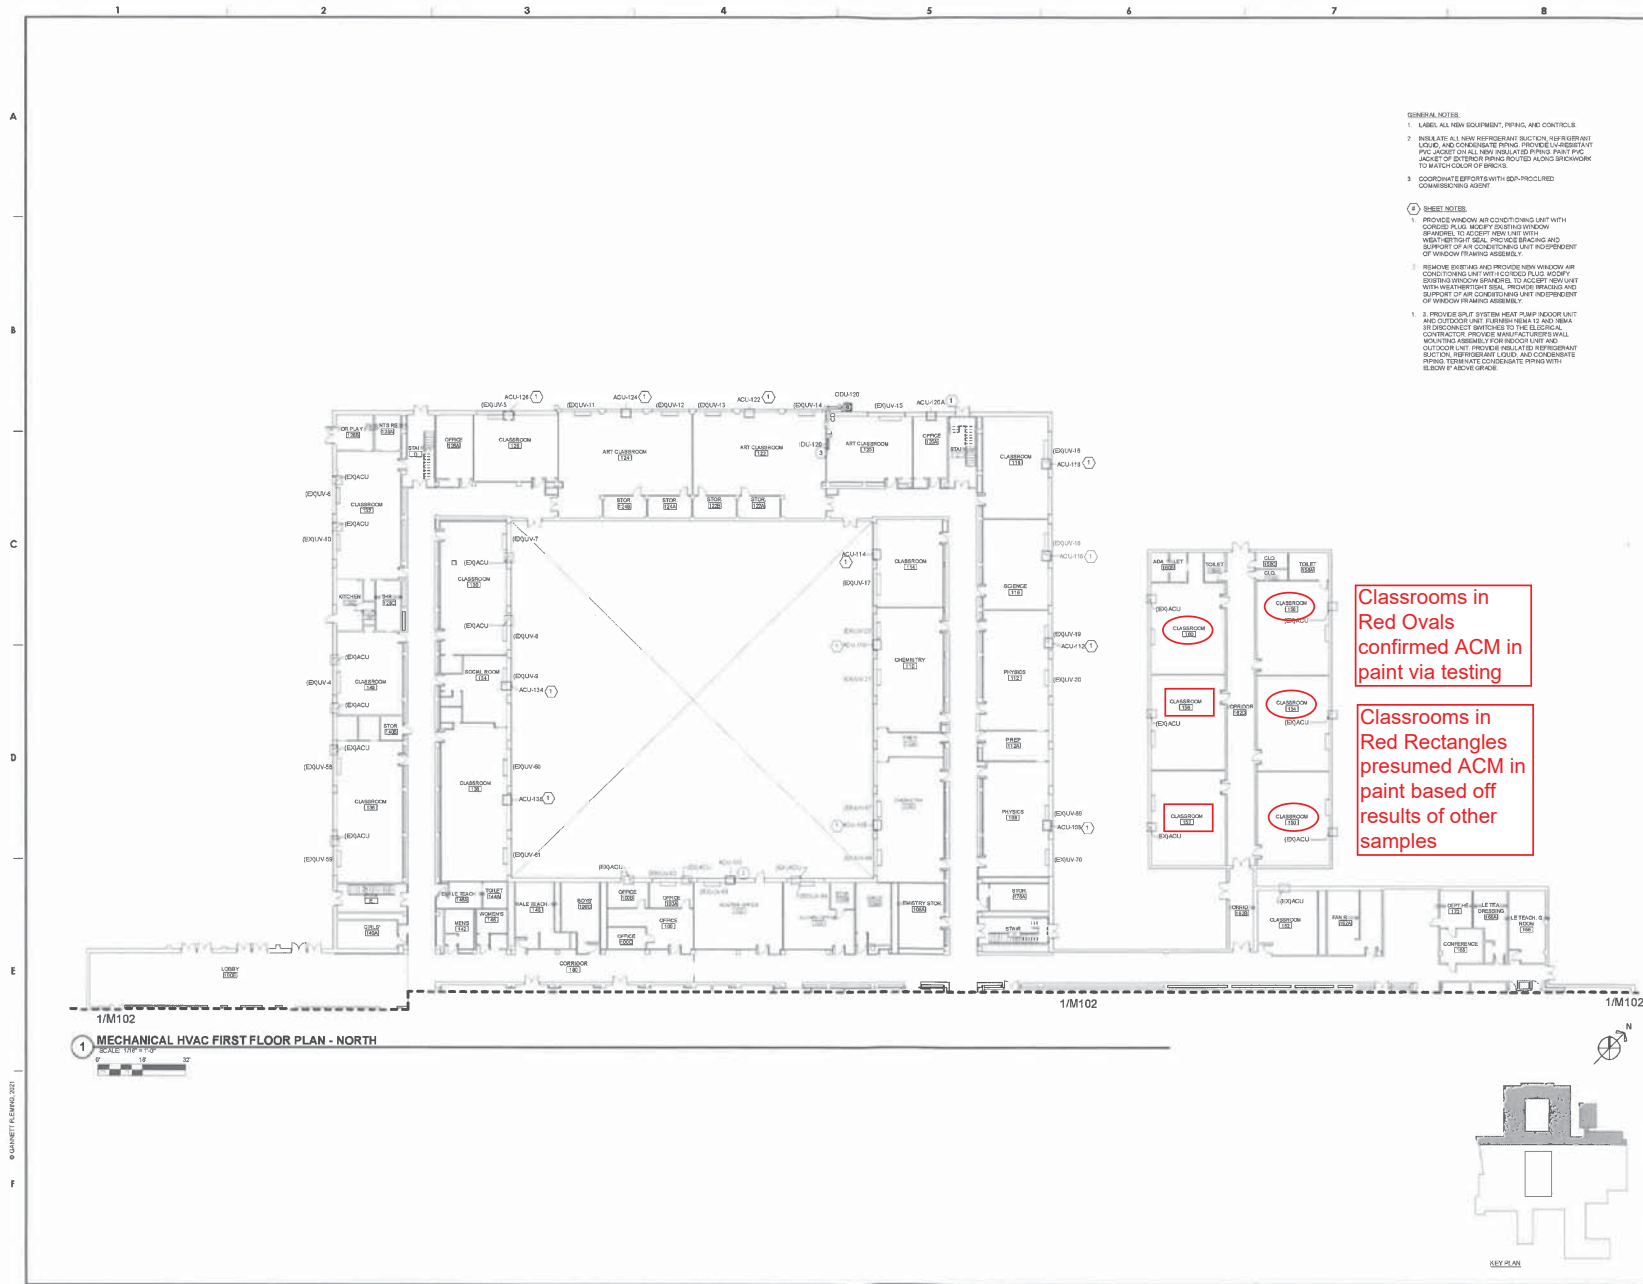

1 2 3 4 5 6 7 8

A

B

C

D

E

F

Project Internal: 04/20/2021
4/20/2021 11:23:39 AM



THE SCHOOL DISTRICT OF PHILADELPHIA
OFFICE OF CAPITAL PROGRAMS

440 NORTH BROAD STREET
PHILADELPHIA, PA 19130 - 4015




GENERAL NOTES:

1. LABEL ALL NEW EQUIPMENT, PIPING, AND CONTROLS.



Classrooms in Red Ovals confirmed ACM in paint via testing

Classrooms in Red Rectangles presumed ACM in paint based off results of other samples

GENERAL NOTES:

1. LABEL ALL NEW EQUIPMENT, PIPING, AND CONTROLS
2. INSULATE ALL NEW REFRIGERANT SUCTION, REFRIGERANT LIQUID, AND CONDENSATE PIPING. PROVIDE UV-RESISTANT PVC JACKET ON ALL NEW INSULATED PIPING. PAINT PVC JACKET OF EXTERIOR PIPING ROUTED ALONG BRICKWORK TO MATCH COLOR OF BRICKS.
3. COORDINATE EFFORTS WITH SOB-PROCURED COMMISSIONING AGENT.

SHEET NOTES

1. PROVIDE WINDOW AIR CONDITIONING UNIT WITH CORDED PLUG. MODIFY EXISTING WINDOW SPANDREL TO ACCEPT NEW UNIT WITH WEATHERTIGHT SEAL, PROVIDE BRACING AND SUPPORT OF AIR CONDITIONING UNIT INDEPENDENT OF WINDOW FRAMING ASSEMBLY.
2. REMOVE EXISTING AND PROVIDE NEW WINDOW AIR CONDITIONING UNIT WITH CORDED PLUG. MODIFY EXISTING WINDOW SPANDREL TO ACCEPT NEW UNIT WITH WEATHERTIGHT SEAL, PROVIDE BRACING AND SUPPORT OF AIR CONDITIONING UNIT INDEPENDENT OF WINDOW FRAMING ASSEMBLY.

ENGINEER OF RECORD:
MECHANICAL / PLUMBING ENGINEER
GANNETT FLEMING, INC.
1010 ADAMS AVENUE
VALLEY FORGE, PA 19403
Phone: 610.783.3862
Email: JWEISSER@GFNET.COM
Attn: SARAH WEXLER

100% SUBMISSION
04/30/2021

[illegible]

NO	DATE	SESSION
----	------	---------

SCHOOL & LOCATION
1601 COTTMAN AVE, PHILADELPHIA, PA
19111

PROJECT TITLE
AIR CONDITIONING UPGRADE

DRAWING TITLE
**MECHANICAL HVAC SECOND
FLOOR PLAN - SOUTH**

DRAWING SCALE AS NOTED	
LOCATION NO. 8020	ENGINEER'S PRA. NO. 06M25.001
DRAWN BY JAA	CHECKED BY BNW
MC - 8-XXX C OF 2020/21 PC - 8-XXX C OF 2020/21 EC - 8-XXX C OF 2020/21	

DRAWING NO.
M104
SHEET 6 OF 16



1 MECHANICAL HVAC SECOND FLOOR PLAN - SOUTH



SEAL:

GENERAL NOTES:


1. LABEL ALL NEW EQUIPMENT, PIPING, AND CONTROLS.
2. INSULATE ALL NEW REFRIGERANT SUCTION, REFRIGERANT LIQUID, AND CONDENSATE PIPING. PROVIDE UV-RESISTANT PVC JACKET ON ALL NEW INSULATED PIPING. PAINT PVC JACKET OF EXTERIOR PIPING ROUTED ALONG BRICKWORK TO MATCH COLOR OF BRICKS.
3. COORDINATE EFFORTS WITH SDP-PROCURED COMMISSIONING AGENT.

 SHEET NOTES

1. PROVIDE WINDOW AIR CONDITIONING UNIT WITH CORDED PLUG. MODIFY EXISTING WINDOW SPANDREL TO ACCEPT NEW UNIT WITH WEATHERTIGHT SEAL. PROVIDE BRACING AND SUPPORT OF AIR CONDITIONING UNIT INDEPENDENT OF WINDOW FRAMING ASSEMBLY.

ENGINEER OF RECORD:

MECHANICAL / PLUMBING ENGINEER
GANNETT PLUMBING, INC.
1010 ADAMS AVENUE
VALLEY FORGE, PA 19403
Phone: 610.783.3862
Email: BWEISSER@GANNETT.COM
Attn: BRIAN WEISSER

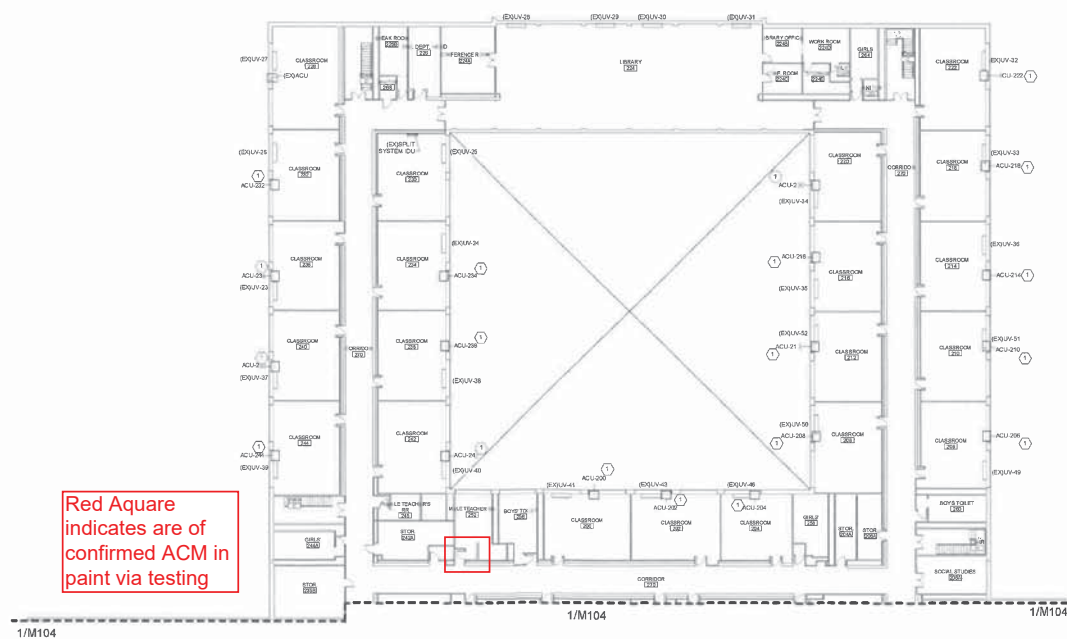

Red Square indicates are of confirmed ACM in paint via testing

1/M104

1/M104

1/M104

MECHANICAL HVAC SECOND FLOOR PLAN - NORTH

SCALE 1" = 10'



100% SUBMISSION
04/30/2021

[illegible]

NO.	DATE	REVISION
-----	------	----------

SCHOOL & LOCATION
1601 COTMAN AVE, PHILADELPHIA PA
19111










PROJECT TITLE
AIR CONDITIONING UPGRADE

DRAWING TITLE
MECHANICAL HVAC SEC
FLOOR PLAN - NORTH

DRAWING SCALE AS NOTED	
LOCATION NO. R020	ENGINEER'S PRJ. NO. 048425.001
DRAWN BY JMJ	CHECKED BY BMW

MC - B-300C	CF	20/20/21
PC - B-300C	OF	20/20/21
EC - B-300C	OF	20/20/21

DRAWING NO.
M105
SHEET 7 OF 16

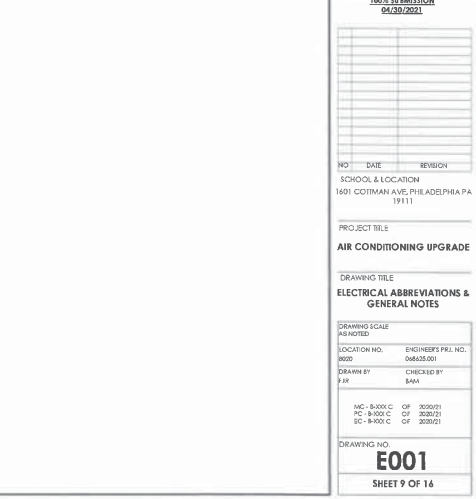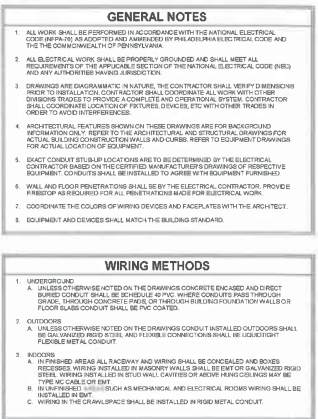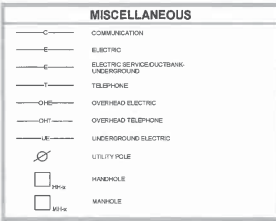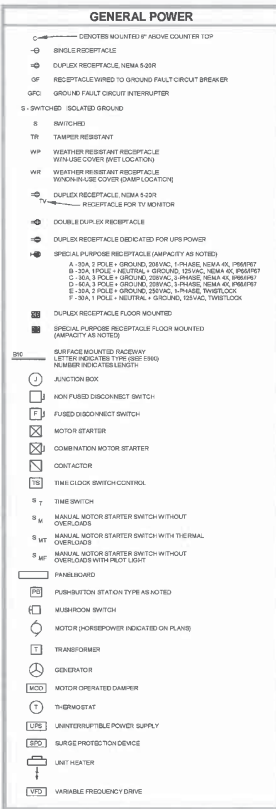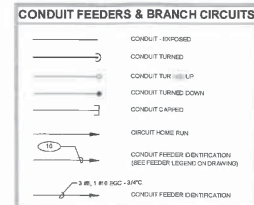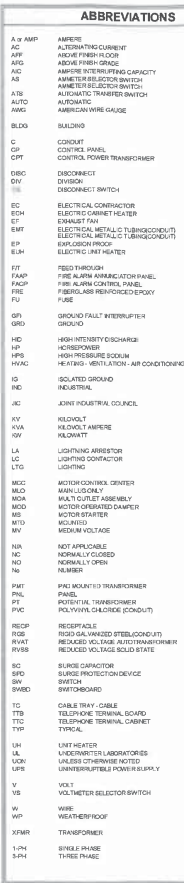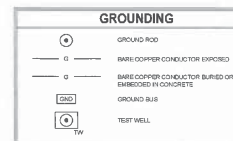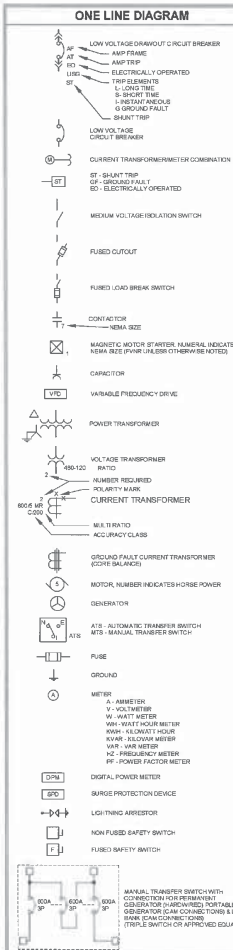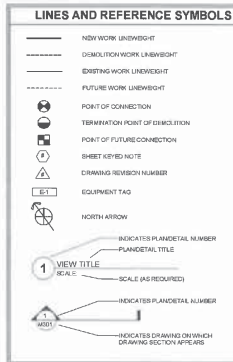



City of Philadelphia - Department of Public Health
Air Management Services, 2nd Fl. Asbestos Control Unit
321 University Ave. Philadelphia, PA 19104

Office Use Only

Date Received L&I:

Date Received AMS:

Date Inspected

Inspector No.

Asbestos Inspection Report

1. Name of Building / Property: North East High School	Address 1601 Cottman Avenue	
2. Name of Building / Property Owner: School District of Philadelphia	Address 440 N. Broad Street	Phone No. (215) 400-4000
3. Name of Philadelphia Certified Investigator: Suzanne Shourds	Certification No. AIC-0624	Contact Information / Email / Phone No. sshourds@repsg.com/215-729-3220
L&I Commercial Activity No. (Former Business Privilege License No.) 356481	Business Tax ID No. 20-3007762	

4. Name of Philadelphia Licensed Laboratory: EMSL	License No. ALL-137	Phone No. 800-220-3675
------------------------------------------------------	------------------------	---------------------------

5. Scope of Work: (Insert or attach a complete description of the portion of the subject property inspected and the anticipated work that will result in the disturbance of the identified Asbestos Containing Materials (ACMs) (e.g. demolition, asbestos abatement, and / or renovation activities).)

Renovations related the installation/upgrade of air conditioning units at CMU wall systems at specified areas throughout the school. All accessible areas within the proposed scope of work were inspected. Should any additional suspect ACMs be found during the course of renovation activities, or should the scope of work change, work should immediately stop in that area and REPSG should be contacted for further investigation and/or abatement.

6. ☐ Property has been declared to be in imminent danger (ID) of failure or collapse by the City of Philadelphia Department of Licenses & Inspections. Attached is a copy of the L&I Notice of Violation declaring the property I.D. **Note: INVESTIGATOR MUST BE ON SITE DURING DEMOLITION!

7. (ACMs) identified? ☒ Yes (List Below) ☐ No (explain)

8. Suspected ACM's sampled? ☒ Yes (attached are copies of the laboratory chain of custody and bulk sample results.) ☐ No (Why?)

9. List all identified ACM's located in the planned renovation/demolition areas. Damaged ACM must be listed and then repaired or removed prior to renovation. You (Investigator) must label all ACM that may be left in the work area. (Attached are add'tl sheets)

Location	Description	Type (Code 1)	Amount		Condition (Code 2)	Action (Code 3)
			Square	Linear		
SEE ATTACHED						

Code 1

FRI - Friable
NF1 - Non-Friable, Cat. 1
NF2 - Non-Friable, Cat. 2

Code 2

DD - Deteriorated or
Delaminated
ND - Non-Damaged

Code 3

REM - Removal necessary prior to Demo/Reno
NRN - No removal necessary, label ACM
REP - Repair & Label ACM, removal not necessary

10. I hereby certify that the foregoing statements are true and the information contained in this report is true. This certification is made subject to the penalties set forth in 18 PA. C.S. S4904 relating to unsworn falsification to authorities. Furthermore I certify that the inspection, sampling, and labeling requirements of section X of the Asbestos Control Regulation (ACR) have been met. The building owner has been notified of the ACR requirements and given a copy of this report. If the inspection has revealed ACM which will be disturbed by the proposed work or if it has revealed ACM in bad condition, the building owner has been notified to remove or repair the ACM in accordance with the ACR prior to renovation or demolition activity.

11. Signature of Certified Asbestos Investigator: 	Date: 5/14/2021	Signature of Building Owner:	Date:
-------------------------------------------------------	--------------------	------------------------------	-------



EMSL Analytical, Inc.

200 Route 130 North Cinnaminson, NJ 08077
 Phone/Fax: (800) 220-3675 / (856) 786-5974
<http://www.EMSL.com> / cinnasblab@EMSL.com

EMSL Order ID: 042110374
 Customer ID: REAC59A
 Customer PO:
 Project ID:

Attn: Suzanne Shourds
 REACT Environmental Prof Svcs Grp, Inc.
 6901 Kingsessing Avenue
 Suite 201
 Philadelphia, PA 19142

Phone: (215) 729-3220
Fax:
Collected: 5/ 3/2021
Received: 5/03/2021
Analyzed: 5/04/2021

Proj: North East High School

Summary Test Report for Asbestos Analysis of Bulk Material via EPA 600/R-93/116

Client Sample ID: G11-001 **Lab Sample ID:** 042110374-0001

Sample Description: Hallway by Room G11 - Left of Door/Yellow Paint

TEST	Analyzed Date	Color	Non-Asbestos		Asbestos	Comment
			Fibrous	Non-Fibrous		
PLM	5/03/2021	Yellow	0.0%	100.0%	None Detected	

Client Sample ID: G11-002 **Lab Sample ID:** 042110374-0002

Sample Description: Room G11 - Right of Door/Peach Paint

TEST	Analyzed Date	Color	Non-Asbestos		Asbestos	Comment
			Fibrous	Non-Fibrous		
PLM	5/03/2021	Peach	0.0%	100.0%	None Detected	

Client Sample ID: G11-003 **Lab Sample ID:** 042110374-0003

Sample Description: Room G11 - Right of Door/Caulk

TEST	Analyzed Date	Color	Non-Asbestos		Asbestos	Comment
			Fibrous	Non-Fibrous		
PLM	5/03/2021	Gray	0.0%	100.0%	None Detected	Sample appears to be plaster

Client Sample ID: G11-004 **Lab Sample ID:** 042110374-0004

Sample Description: Room G11 - Right of Door/Peach Paint

TEST	Analyzed Date	Color	Non-Asbestos		Asbestos	Comment
			Fibrous	Non-Fibrous		
PLM	5/04/2021	Peach	0.0%	100.0%	None Detected	

Client Sample ID: G11-005 **Lab Sample ID:** 042110374-0005

Sample Description: Hallway by Room G11 - Right of Door/Yellow Paint

TEST	Analyzed Date	Color	Non-Asbestos		Asbestos	Comment
			Fibrous	Non-Fibrous		
PLM	5/03/2021	Yellow	0.0%	100.0%	None Detected	

Client Sample ID: G11-006 **Lab Sample ID:** 042110374-0006

Sample Description: Hallway by Room G11 - Above Locker/Yellow Paint

TEST	Analyzed Date	Color	Non-Asbestos		Asbestos	Comment
			Fibrous	Non-Fibrous		
PLM	5/04/2021	Yellow	0.0%	100.0%	None Detected	

Client Sample ID: 100-001 **Lab Sample ID:** 042110374-0007

Sample Description: Hallway by Room 100 - Right of Door/Beige Paint

TEST	Analyzed Date	Color	Non-Asbestos		Asbestos	Comment
			Fibrous	Non-Fibrous		
PLM	5/03/2021	Beige	0.0%	100.0%	None Detected	



EMSL Analytical, Inc.

200 Route 130 North Cinnaminson, NJ 08077
Phone/Fax: (800) 220-3675 / (856) 786-5974
<http://www.EMSL.com> / cinnasblab@EMSL.com

EMSL Order ID: 042110374
Customer ID: REAC59A
Customer PO:
Project ID:

Summary Test Report for Asbestos Analysis of Bulk Material via EPA 600/R-93/116

Client Sample ID: 100-002 **Lab Sample ID:** 042110374-0008

Sample Description: Hallway by Room 100 - Left of Door/Beige Paint

TEST	Analyzed Date	Color	Non-Asbestos		Asbestos	Comment
			Fibrous	Non-Fibrous		
PLM	5/03/2021	Beige	0.0%	100.0%	None Detected	

Client Sample ID: 100-003 **Lab Sample ID:** 042110374-0009

Sample Description: Hallway by Room 100 - Above Locker/Beige Paint

TEST	Analyzed Date	Color	Non-Asbestos		Asbestos	Comment
			Fibrous	Non-Fibrous		
PLM	5/04/2021	Beige	0.0%	100.0%	None Detected	

Client Sample ID: 100-004 **Lab Sample ID:** 042110374-0010

Sample Description: Closet in Room 100/Blue and Pink Paint

TEST	Analyzed Date	Color	Non-Asbestos		Asbestos	Comment
			Fibrous	Non-Fibrous		
PLM	5/03/2021	Blue	0.0%	100.0%	None Detected	

Client Sample ID: 201-001 **Lab Sample ID:** 042110374-0011

Sample Description: Room 201 - Right of Door/Beige and Green Paint

TEST	Analyzed Date	Color	Non-Asbestos		Asbestos	Comment
			Fibrous	Non-Fibrous		
PLM	5/03/2021	Green/Beige	0.0%	100.0%	None Detected	

Client Sample ID: 201-002 **Lab Sample ID:** 042110374-0012

Sample Description: Room 201 - Left of Door/Beige and Green Paint

TEST	Analyzed Date	Color	Non-Asbestos		Asbestos	Comment
			Fibrous	Non-Fibrous		
PLM	5/03/2021	Green/Beige	0.0%	100.0%	None Detected	

Client Sample ID: 201-003 **Lab Sample ID:** 042110374-0013

Sample Description: Room 201 - Right of Door/Beige and Green Paint

TEST	Analyzed Date	Color	Non-Asbestos		Asbestos	Comment
			Fibrous	Non-Fibrous		
PLM	5/04/2021	Green/Beige	0.0%	100.0%	None Detected	

Client Sample ID: 201-004 **Lab Sample ID:** 042110374-0014

Sample Description: Room 201 - Right of Door/Cauk

TEST	Analyzed Date	Color	Non-Asbestos		Asbestos	Comment
			Fibrous	Non-Fibrous		
PLM	5/03/2021	Gray	0.0%	100.0%	None Detected	Sample appears to be plaster

Client Sample ID: 252-001 **Lab Sample ID:** 042110374-0015

Sample Description: Men's Room 252 - Across from Door/Beige Paint

TEST	Analyzed Date	Color	Non-Asbestos		Asbestos	Comment
			Fibrous	Non-Fibrous		
PLM	5/03/2021	Beige	0.0%	100.0%	<1% Chrysotile	
400 PLM Pt Ct	5/04/2021	Beige	0.0%	100.0%	<0.25% Chrysotile	



EMSL Analytical, Inc.

200 Route 130 North Cinnaminson, NJ 08077
Phone/Fax: (800) 220-3675 / (856) 786-5974
<http://www.EMSL.com> / cinnasblab@EMSL.com

EMSL Order ID: 042110374
Customer ID: REAC59A
Customer PO:
Project ID:

Summary Test Report for Asbestos Analysis of Bulk Material via EPA 600/R-93/116

Client Sample ID: 256-001-Paint

Lab Sample ID: 042110374-0016

Sample Description: Hallway outside Room 256 - Above Locker/Beige and White Paint

TEST	Analyzed Date	Color	Non-Asbestos		Asbestos	Comment
			Fibrous	Non-Fibrous		
PLM	5/03/2021	White/Beige	0.0%	100.0%	None Detected	

Client Sample ID: 256-001-Caulk

Lab Sample ID: 042110374-0016A

Sample Description: Hallway outside Room 256 - Above Locker/Caulk

TEST	Analyzed Date	Color	Non-Asbestos		Asbestos	Comment
			Fibrous	Non-Fibrous		
PLM	5/03/2021	Beige	0.0%	100.0%	None Detected	

Analyst(s):

Laura Kantor 400 PLM Pt Ct (1)
Nancy Stalter PLM (4)
Nicholas Montoya-Orozco PLM (13)

Reviewed and approved by:

Samantha Rundstrom, Laboratory Manager
or Other Approved Signatory

EMSL maintains liability limited to cost of analysis. This report relates only to the samples reported above and may not be reproduced, except in full, without written approval by EMSL. This test report must not be used to claim product endorsement by NVLAP or any agency of the U.S. Government. EMSL bears no responsibility for sample collection activities or analytical method limitations. The laboratory is not responsible for the accuracy of results when requested to physically separate and analyze layered samples. PLM alone is not consistently reliable in detecting asbestos in floor coverings and similar NOBs

Samples analyzed by EMSL Analytical, Inc. Cinnaminson, NJ NVLAP Lab Code 101048-0, AIHA-LAP, LLC-IHLAP Lab 100194, NYS ELAP 10872, NJ DEP 03036, PA ID# 68-00367, LA #04127

Report amended: 05/04/2021 13:59:00 Replaces initial report from: 05/04/2021 07:27:31 Reason Code: Client-Additional Analysis

EMSL ANALYTICAL, INC.
LABORATORY • PRODUCTS • TRAININGAsbestos Bulk Building Material
Chain of Custody

EMSL Order Number (Lab Use Only):

042110374

Cinnaminson, NJ 08077
PHONE: 1-800-220-3675
FAX: (856) 786-5974

Company: REPSG, Inc.		EMSL-Bill to: <input checked="" type="checkbox"/> Same <input type="checkbox"/> Different If Bill to is Different note instructions in Comments**	
Street: 6901 Kingsessing Avenue Suite 201		Third Party Billing requires written authorization from third party	
City: Philadelphia	State/Province: PA	Zip/Postal Code: 19142	Country: US
Report To (Name): Suzanne Shourds		Telephone #: 2157293220	
Email Address: sshourds@repsg.com		Fax #: 2157291557	Purchase Order:
Project Name/Number: North East High School		Please Provide Results: <input type="checkbox"/> Fax <input checked="" type="checkbox"/> Email <input type="checkbox"/> Mail	
U.S. State Samples Taken: PA		CT Samples: <input type="checkbox"/> Commercial/Taxable <input type="checkbox"/> Residential/Tax Exempt	

Turnaround Time (TAT) Options* - Please Check

☐ 3 Hour ☒ 6 Hour ☐ 24 Hour ☐ 48 Hour ☐ 72 Hour ☐ 96 Hour ☐ 1 Week ☐ 2 Week

*For TEM Air 3 hr through 6 hr, please call ahead to schedule. *There is a premium charge for 3 Hour TEM AHERA or EPA Level II TAT. You will be asked to sign an authorization form for this service. Analysis completed in accordance with EMSL's Terms and Conditions located in the Analytical Price Guide.

PLM - Bulk (reporting limit)		TEM - Bulk	
<input checked="" type="checkbox"/> PLM EPA 600/R-93/116 (<1%)		<input type="checkbox"/> TEM EPA NOB - EPA 600/R-93/116 Section 2.5.5.1	
<input type="checkbox"/> PLM EPA NOB (<1%)		<input type="checkbox"/> NY ELAP Method 198.4 (TEM)	
Point Count <input type="checkbox"/> 400 (<0.25%) <input type="checkbox"/> 1000 (<0.1%)		<input type="checkbox"/> Chatfield Protocol (semi-quantitative)	
Point Count w/Gravimetric <input type="checkbox"/> 400 (<0.25%) <input type="checkbox"/> 1000 (<0.1%)		<input type="checkbox"/> TEM % by Mass - EPA 600/R-93/116 Section 2.5.5.2	
<input type="checkbox"/> NIOSH 9002 (<1%)		<input type="checkbox"/> TEM Qualitative via Filtration Prep Technique	
<input type="checkbox"/> NY ELAP Method 198.1 (friable in NY)		<input type="checkbox"/> TEM Qualitative via Drop Mount Prep Technique	
<input type="checkbox"/> NY ELAP Method 198.6 NOB (non-friable-NY)		Other	
<input type="checkbox"/> OSHA ID-191 Modified			
<input type="checkbox"/> Standard Addition Method			

☒ Check For Positive Stop - Clearly Identify Homogenous Group Date Sampled: 5-3-21

Samplers Name: Suzanne Shourds Samplers Signature: [Signature]

Sample #	HA #	Sample Location	Material Description
G11-001	1	Hallway by Rm G11, Left of Door	Yellow Paint
G11-002	2	Room G11, Right of Door	Peach Paint
G11-003		↓ Right of Door	Caulk
G11-004	2	↓, ^{Room} Left of Door	Peach Paint
G11-005	1	Hallway by Rm G11, Right of Door	Yellow Paint
G11-006	1	↓, Above Locker	Yellow Paint
100-001	3	Hallway by Rm 100, Right of Door	Beige Paint
100-002	3	↓, Left of Door	↓
100-003	3	↓, Above Locker	↓
100-004		Closet in Rm 100	Blue Paint

Client Sample # (s): 10 Total # of Samples: 10

Relinquished (Client): [Signature] Date: 5-3-21 Time: 1951

Received (Lab): [Signature] Date: 5/3/21 Time: 809

Comments/Special Instructions:



EMSL ANALYTICAL, INC.
LABORATORY • PRODUCTS • TRAINING

Asbestos Bulk Building Material Chain of Custody

EMSL Order Number (*Lab Use Only*): _____

042110374

Cinnaminson, NJ 08077

PHONE: 1-800-220-3675

FAX: (856) 786-5974

Additional Pages of the Chain of Custody are only necessary if needed for additional sample information

[illegible]

Christy, Sherry

04210374

From: Suzanne Shourds <SShourds@repsg.com>
Sent: Tuesday, May 4, 2021 10:54 AM
To: Christy, Sherry; EMSL Lab - Cinnaminson Asbestos
Subject: RE: EMSL report, COC for order(s) 042110374 (042110374 - North East High School)
Attachments: 042110374_001.pdf; 042110374_coc.pdf

[EXTERNAL E-MAIL]

Thank you! Can we please run sample 252-001 via 400 point count on a 6-hour TAT?

Regards,

Suzanne Shourds
Senior Project Manager

REPSG

**React Environmental
Professional Services Group, Inc.**

6901 Kingsessing Avenue, Suite 201
P.O. Box 5377
Philadelphia, PA 19142-0377
Phone: 215-729-3220 Ext. 378
Cell: 267-688-7311
Fax: 215-729-1557
Email: sshourds@repsg.com
Website: <http://www.repsg.com>
[Facebook](#), [Instagram](#), and [LinkedIn](#)

This message and any attachments are intended only for the use of the addressee and may contain information that is privileged and confidential. If the reader of the message is not the intended recipient or an authorized representative of the intended recipient, you are hereby notified that any dissemination of this communication is strictly prohibited. If you have received this communication in error, notify the sender immediately by return email and delete the message and any attachments from your system.

 Please consider the environment before printing this email

From: EMSL (Cinnaminson) <cinnasblab@EMSL.com>
Sent: Tuesday, May 4, 2021 9:09 AM
To: Suzanne Shourds <SShourds@repsg.com>
Subject: EMSL report, COC for order(s) 042110374 (042110374 - North East High School)



EMSL Analytical, Inc.

200 Route 130 North Cinnaminson, NJ 08077

Tel/Fax: (800) 220-3675 / (856) 786-5974

<http://www.EMSL.com> / cinnasblab@EMSL.com

EMSL Order: 042111132

Customer ID: REAC51A

Customer PO:

Project ID:

Attention: Suzanne Shourds

Hepaco React, LLC

6901 Kingsessing Avenue

First Floor

Philadelphia, PA 19142

Project: Northeast High School - 12654.240.01

Phone: (215) 729-3224

Fax: (215) 729-8678

Received Date: 05/12/2021 9:30 AM

Analysis Date: 05/12/2021 - 05/13/2021

Collected Date: 05/11/2021

Test Report: Asbestos Analysis of Bulk Materials via EPA 600/R-93/116 Method using Polarized Light Microscopy

Sample	Description	Appearance	Non-Asbestos		Asbestos
			% Fibrous	% Non-Fibrous	% Type
GH-001 042111132-0001	Ground Floor Hallway by Room 011 Upper Wall - White to Yellow to Pink paint	White/Yellow/Pink Non-Fibrous Homogeneous	HA: 1	100% Non-fibrous (Other)	None Detected
GH-002 042111132-0002	Ground Floor Hallway by Room 9A Upper Wall - White to Yellow to Pink paint	White/Yellow/Pink Non-Fibrous Homogeneous	HA: 1	100% Non-fibrous (Other)	None Detected
GH-003 042111132-0003	Ground Floor Hallway between Room 7 and 6 Upper Wall - White to Yellow to Pink paint	White/Yellow/Pink Non-Fibrous Homogeneous	HA: 1	100% Non-fibrous (Other)	None Detected
GH-004 042111132-0004	Ground Floor Hallway by Room 5 Upper Wall - White to Yellow to Pink paint	White/Yellow/Pink Non-Fibrous Homogeneous	HA: 1	100% Non-fibrous (Other)	None Detected
GH-005 042111132-0005	Ground Floor Hallway by Room 4 and 3 Upper Wall - White to Yellow to Pink paint	White/Yellow/Pink Non-Fibrous Homogeneous	HA: 1	100% Non-fibrous (Other)	None Detected
GH-006 042111132-0006	Ground Floor Hallway by Room 1 Upper Wall - White to Yellow to Pink paint	White/Yellow/Pink Non-Fibrous Homogeneous	HA: 1	100% Non-fibrous (Other)	None Detected
GH-007 042111132-0007	Ground Floor Hallway across from Room 24 Upper Wall - White to Yellow to Pink paint	White/Yellow/Pink Non-Fibrous Homogeneous	HA: 1	100% Non-fibrous (Other)	None Detected
GH-008 042111132-0008	Ground Floor Hallway across from M Stairs Upper Wall - White to Yellow to Pink paint	White/Yellow/Pink Non-Fibrous Homogeneous	HA: 1	100% Non-fibrous (Other)	None Detected
GH-009 042111132-0009	Ground Floor Hallway by Room 22a Upper Wall - White to Yellow to Pink paint	White/Yellow/Pink Non-Fibrous Homogeneous	HA: 1	100% Non-fibrous (Other)	None Detected
GH-010 042111132-0010	Ground Floor Hallway by Storage Room 51 above Locker 24 Lower Wall - Yellow to Pink Paint	Yellow/Pink Non-Fibrous Homogeneous	HA: 2	100% Non-fibrous (Other)	None Detected

Initial report from: 05/13/2021 19:38:38



EMSL Analytical, Inc.

200 Route 130 North Cinnaminson, NJ 08077

Tel/Fax: (800) 220-3675 / (856) 786-5974

<http://www.EMSL.com> / cinnasblab@EMSL.com

EMSL Order: 042111132

Customer ID: REAC51A

Customer PO:

Project ID:

Test Report: Asbestos Analysis of Bulk Materials via EPA 600/R-93/116 Method using Polarized Light Microscopy

Sample	Description	Appearance	Non-Asbestos		Asbestos % Type
			% Fibrous	% Non-Fibrous	
GH-011 042111132-0011	Ground Floor Hallway by Room 23 Lower Wall - Yellow to Pink Paint	Yellow/Pink Non-Fibrous Homogeneous	HA: 2	100% Non-fibrous (Other)	None Detected
GH-012 042111132-0012	Ground Floor Hallway by Room 22a Lower Wall - Yellow to Pink Paint	Yellow/Pink Non-Fibrous Homogeneous	HA: 2	100% Non-fibrous (Other)	None Detected
GH-013 042111132-0013	Ground Floor Hallway by D Stairs Lower Wall - Yellow to Pink Paint	Yellow/Pink Non-Fibrous Homogeneous	HA: 2	100% Non-fibrous (Other)	None Detected
GH-014 042111132-0014	Ground Floor Hallway by Womens Room Lower Wall - Yellow to Pink Paint	Yellow/Pink Non-Fibrous Homogeneous	HA: 2	100% Non-fibrous (Other)	None Detected
GH-015 042111132-0015	Ground Floor Hallway by Room 25 Lower Wall - Yellow to Pink Paint	Yellow/Pink Non-Fibrous Homogeneous	HA: 2	100% Non-fibrous (Other)	None Detected
GC-001 042111132-0016	Ground Floor Cafeteria Walls and Columns - Blue to Yellow Paint	Blue/Yellow Non-Fibrous Homogeneous	HA: 3	100% Non-fibrous (Other)	None Detected
GC-002 042111132-0017	Ground Floor Cafeteria Walls and Columns - Blue to Yellow Paint	Blue/Yellow Non-Fibrous Homogeneous	HA: 3	100% Non-fibrous (Other)	None Detected
GC-003 042111132-0018	Ground Floor Cafeteria Walls and Columns - Blue to Yellow Paint	Blue/Yellow Non-Fibrous Homogeneous	HA: 3	100% Non-fibrous (Other)	None Detected
G8-001 042111132-0019	Ground Floor Room 8 Walls - Peach to Green Paint	Green/Peach Non-Fibrous Homogeneous	HA: 4	100% Non-fibrous (Other)	None Detected
G7-002 042111132-0020	Ground Floor Room 7 Walls - Peach to Green Paint	Green/Peach Non-Fibrous Homogeneous	HA: 4	100% Non-fibrous (Other)	None Detected
G5-003 042111132-0021	Ground Floor Room 5 Walls - Peach to Green Paint	Green/Peach Non-Fibrous Homogeneous	HA: 4	100% Non-fibrous (Other)	None Detected
G4-004 042111132-0022	Ground Floor Room 4 Walls - Peach to Green Paint	Green/Peach Non-Fibrous Homogeneous	HA: 4	100% Non-fibrous (Other)	None Detected
G2-005 042111132-0023	Ground Floor Room 2 Walls - Peach to Green Paint	Green/Peach Non-Fibrous Homogeneous		100% Non-fibrous (Other)	None Detected

Initial report from: 05/13/2021 19:38:38



EMSL Analytical, Inc.

200 Route 130 North Cinnaminson, NJ 08077

Tel/Fax: (800) 220-3675 / (856) 786-5974

<http://www.EMSL.com> / cinnasblab@EMSL.com

EMSL Order: 042111132

Customer ID: REAC51A

Customer PO:

Project ID:

Test Report: Asbestos Analysis of Bulk Materials via EPA 600/R-93/116 Method using Polarized Light Microscopy

			Non-Asbestos	Asbestos	
Sample	Description	Appearance	% Fibrous	% Non-Fibrous	% Type
HA: 4					
G9-006 042111132-0024	Ground Floor Room 9 Walls - Peach to Green Paint	Green Non-Fibrous Homogeneous		100% Non-fibrous (Other)	None Detected
HA: 4					
G6-007 042111132-0025	Ground Floor Room 6 Walls - Peach to Green Paint	Green Non-Fibrous Homogeneous		100% Non-fibrous (Other)	None Detected
HA: 4					
GBR-001 042111132-0026	Ground Floor Boys Room by Cafeteria Walls - Yellow to Tan Paint	Tan/Yellow Non-Fibrous Homogeneous		100% Non-fibrous (Other)	None Detected
HA: 5					
G22A-001 042111132-0027	Ground Floor Room 22A Walls - Peach to Green Paint	White/Pink/Green Non-Fibrous Homogeneous		100% Non-fibrous (Other)	None Detected
HA: 6					
G14-001 042111132-0028	Ground Floor Room 14 Walls - Peach, Yellow and Green Paint	Yellow/Green/Peac h Non-Fibrous Homogeneous		100% Non-fibrous (Other)	None Detected
HA: 7					
G15-001 042111132-0029	Ground Floor Room 15 Walls - Peach, Yellow and Green Paint	Yellow/Pink/Peach Non-Fibrous Homogeneous		100% Non-fibrous (Other)	None Detected
HA: 8					
GH-016 042111132-0030	Ground Floor Hallway by Room 16B Walls - Blue on Yellow on White Paint	White/Blue/Yellow Non-Fibrous Homogeneous		100% Non-fibrous (Other)	None Detected
HA: 9					
GH-017 042111132-0031	Ground Floor Hallway by Room 14A Walls - Blue on Yellow on White Paint	White/Blue/Yellow Non-Fibrous Homogeneous		100% Non-fibrous (Other)	None Detected
HA: 9					
GH-018 042111132-0032	Ground Floor Hallway by Room 14 Walls - Blue on Yellow on White Paint	White/Blue/Yellow Non-Fibrous Homogeneous		100% Non-fibrous (Other)	None Detected
HA: 9					
G16B-01 042111132-0033	Ground Floor Room 16B Walls - Peach, Yellow and Green Paint	Yellow/Green Non-Fibrous Homogeneous		100% Non-fibrous (Other)	None Detected
HA: 10					
GH-019 042111132-0034	Ground Floor Hallway near Room 19B Walls - Blue on Yellow on White Paint	Blue/Yellow Non-Fibrous Homogeneous		100% Non-fibrous (Other)	None Detected
HA: 9					
GH-020 042111132-0035	Ground Floor Hallway near Room 18D Walls - Blue on Yellow on White Paint	White/Blue/Yellow Non-Fibrous Homogeneous		100% Non-fibrous (Other)	None Detected
HA: 9					

Initial report from: 05/13/2021 19:38:38



EMSL Analytical, Inc.

200 Route 130 North Cinnaminson, NJ 08077

Tel/Fax: (800) 220-3675 / (856) 786-5974

<http://www.EMSL.com> / cinnasblab@EMSL.com

EMSL Order: 042111132

Customer ID: REAC51A

Customer PO:

Project ID:

Test Report: Asbestos Analysis of Bulk Materials via EPA 600/R-93/116 Method using Polarized Light Microscopy

Sample	Description	Appearance	Non-Asbestos		Asbestos
			% Fibrous	% Non-Fibrous	% Type
119-005 042111132-0036	1st Floor Room 119 Lower Wall - Peach on Yellow on White and green paint	White/Yellow/Green Non-Fibrous Homogeneous		100% Non-fibrous (Other)	None Detected
HA: 9					
1H-001 042111132-0037	1st Floor Hallway by Room 119 Lower Wall - Blue on White on Pink Paint	White/Blue/Pink Non-Fibrous Homogeneous		100% Non-fibrous (Other)	None Detected
HA: 11					
1H-002 042111132-0038	1st Floor Hallway across from Room 127 Lower Wall - Blue on White on Pink Paint	White/Blue/Pink Non-Fibrous Homogeneous		100% Non-fibrous (Other)	None Detected
HA: 12					
1H-003 042111132-0039	1st Floor Hallway across from Room 133 Lower Wall - Blue on White on Pink Paint	White/Blue/Pink Non-Fibrous Homogeneous		100% Non-fibrous (Other)	None Detected
HA: 12					
1H-004 042111132-0040	1st Floor Hallway next to Stage Lower Wall - Blue on White on Pink Paint	White/Blue/Pink Non-Fibrous Homogeneous		100% Non-fibrous (Other)	None Detected
HA: 12					
1H-005 042111132-0041	1st Floor Hallway next to J Stairs Lower Wall - Blue on White on Pink Paint	White/Blue/Pink Non-Fibrous Homogeneous		100% Non-fibrous (Other)	None Detected
HA: 12					
1BR-001 042111132-0042	1st Floor Boys Room next to J Stairs Lower Wall - Yellow and Tan Paint	Tan/Yellow Non-Fibrous Homogeneous		100% Non-fibrous (Other)	None Detected
HA: 12					
1H-006 042111132-0043	1st Floor Hallway across from Room 115 Lower Wall - Beige on Yellow on White on pink Paint	White/Yellow/Beige Non-Fibrous Homogeneous		100% Non-fibrous (Other)	None Detected
HA: 13					
1H-007 042111132-0044	1st Floor Hallway next to Room 111 Lower Wall - Beige on Yellow on White on pink Paint	White/Yellow/Beige Non-Fibrous Homogeneous		100% Non-fibrous (Other)	None Detected
HA: 14					
1H-008 042111132-0045	1st Floor Hallway next to Room 109 Lower Wall - Beige on Yellow on White on pink Paint	White/Yellow/Beige Non-Fibrous Homogeneous		100% Non-fibrous (Other)	None Detected
HA: 14					
1H-009 042111132-0046	1st Floor Hallway next to Room 108 Lower Wall - Beige on Yellow on White on pink Paint	White/Yellow/Beige Non-Fibrous Homogeneous		100% Non-fibrous (Other)	None Detected

Initial report from: 05/13/2021 19:38:38



EMSL Analytical, Inc.

200 Route 130 North Cinnaminson, NJ 08077

Tel/Fax: (800) 220-3675 / (856) 786-5974

<http://www.EMSL.com> / cinnasblab@EMSL.com

EMSL Order: 042111132

Customer ID: REAC51A

Customer PO:

Project ID:

Test Report: Asbestos Analysis of Bulk Materials via EPA 600/R-93/116 Method using Polarized Light Microscopy

			Non-Asbestos	Asbestos	
Sample	Description	Appearance	% Fibrous	% Non-Fibrous	% Type
HA: 14					
1H-010 042111132-0047	1st Floor Hallway next to Room 110 Lower Wall - Beige on Yellow on White on pink Paint	White/Yellow/Beige Non-Fibrous Homogeneous		100% Non-fibrous (Other)	None Detected
HA: 14					
1H-011 042111132-0048	1st Floor Hallway across from Room 178 near Exit Door Lower Wall - Beige on Yellow on White on pink Paint	White/Yellow/Beige Non-Fibrous Homogeneous		100% Non-fibrous (Other)	None Detected
HA: 14					
150-008 042111132-0049	1st Floor Room 150 Wall - Peach on Yellow on White and Green Paint	White/Yellow/Peac h Non-Fibrous Homogeneous		100% Non-fibrous (Other)	<1% Chrysotile
HA: 11					
154-009 042111132-0050	1st Floor Room 154 Wall - Peach on Yellow on White and Green Paint	White/Yellow/Peac h Non-Fibrous Homogeneous		100% Non-fibrous (Other)	<1% Chrysotile
HA: 11					
158-001 042111132-0051	1st Floor Room 158 Wall - Electric Blue Paint	Blue Non-Fibrous Homogeneous		98% Non-fibrous (Other)	2% Chrysotile
HA: 16					
160-002 042111132-0052	1st Floor Room 160 Wall - Electric Blue Paint				Positive Stop (Not Analyzed)
HA: 16					
1H-012 042111132-0053	1st Floor Hallway next to A Stairs - Priple-blue on White Paint	White/Blue/Purple Non-Fibrous Homogeneous		100% Non-fibrous (Other)	None Detected
HA: 17					
1H-013 042111132-0054	1st Floor Hallway next to Room 132 Wall - Priple-blue on White Paint	White/Blue/Purple Non-Fibrous Homogeneous		100% Non-fibrous (Other)	None Detected
HA: 17					
1H-014 042111132-0055	1st Floor Hallway Next to Room 126 Wall - Priple-blue on White Paint	White/Blue/Purple Non-Fibrous Homogeneous		100% Non-fibrous (Other)	None Detected
HA: 17					
126-001 042111132-0056	1st Floor Room 126 Wall - Peach on Yellow on White and Green Paint	White/Yellow/Green Non-Fibrous Homogeneous		100% Non-fibrous (Other)	None Detected
HA: 11					
140-002 042111132-0057	1st Floor Room 140 Wall - Peach on Yellow on White and Green Paint	White/Yellow/Green Non-Fibrous Homogeneous		100% Non-fibrous (Other)	None Detected
HA: 11					

Initial report from: 05/13/2021 19:38:38



EMSL Analytical, Inc.

200 Route 130 North Cinnaminson, NJ 08077

Tel/Fax: (800) 220-3675 / (856) 786-5974

<http://www.EMSL.com> / cinnasblab@EMSL.com

EMSL Order: 042111132

Customer ID: REAC51A

Customer PO:

Project ID:

Test Report: Asbestos Analysis of Bulk Materials via EPA 600/R-93/116 Method using Polarized Light Microscopy

Sample	Description	Appearance	Non-Asbestos		Asbestos
			% Fibrous	% Non-Fibrous	% Type
138-001 042111132-0058	1st Floor Room 138 Wall - Blue on Yellow Paint	Blue/Yellow Non-Fibrous Homogeneous	HA: 18	100% Non-fibrous (Other)	None Detected
143-001 042111132-0059	1st Floor Room 143 Wall - Yellow Cream on Green paint	Yellow/Green/Beige Non-Fibrous Homogeneous	HA: 15	100% Non-fibrous (Other)	None Detected
141-002 042111132-0060	1st Floor Room 141 Wall - Yellow Cream on Green paint	Yellow/Green/Beige Non-Fibrous Homogeneous	HA: 15	100% Non-fibrous (Other)	None Detected
139-003 042111132-0061	1st Floor Room 139 Wall - Peach on Yellow on White and Green Paint	White/Yellow/Green Non-Fibrous Homogeneous	HA: 11	100% Non-fibrous (Other)	None Detected
127-004 042111132-0062	1st Floor Room 127 Wall - Peach on Yellow on White and Green Paint	White/Yellow/Green Non-Fibrous Homogeneous	HA: 11	100% Non-fibrous (Other)	None Detected
129-002 042111132-0063	1st Floor Room 129 Wall - Blue on Yellow Paint	Blue/Yellow Non-Fibrous Homogeneous	HA: 18	100% Non-fibrous (Other)	None Detected
123-006 042111132-0064	1st Floor Room 123 Wall - Peach on Yellow on White and Green Paint	White/Yellow/Green Non-Fibrous Homogeneous	HA: 11	100% Non-fibrous (Other)	None Detected
113-007 042111132-0065	1st Floor Room 113 Wall - Peach on Yellow on White and Green Paint	White/Yellow/Peac h Non-Fibrous Homogeneous	HA: 11	100% Non-fibrous (Other)	None Detected
134-003 042111132-0066	1st Floor Room 143 Wall - Blue on Yellow Paint	Blue/Yellow Non-Fibrous Homogeneous	HA: 18	100% Non-fibrous (Other)	None Detected
1GR-002 042111132-0067	1st Floor Girls Room near Room 138 Wall - Yellow Tan Paint	Tan/Yellow Non-Fibrous Homogeneous	HA: 13	100% Non-fibrous (Other)	None Detected
143-003 042111132-0068	1st Floor Room 143 Wall - Yellow Cream on Green Paint	Yellow/Green/Beige Non-Fibrous Homogeneous	HA: 15	100% Non-fibrous (Other)	None Detected



EMSL Analytical, Inc.

200 Route 130 North Cinnaminson, NJ 08077

Tel/Fax: (800) 220-3675 / (856) 786-5974

<http://www.EMSL.com> / cinnasblab@EMSL.com

EMSL Order: 042111132

Customer ID: REAC51A

Customer PO:

Project ID:

Analyst(s)

Andrew Borsos (17)

Alex Francois (11)

John Witcraft (25)

Mark Shuts (7)

Nicholas Montoya-Orozco (7)

Samantha Rundstrom, Laboratory Manager
or Other Approved Signatory

EMSL maintains liability limited to cost of analysis. Interpretation and use of test results are the responsibility of the client. This report relates only to the samples reported above, and may not be reproduced, except in full, without written approval by EMSL. EMSL bears no responsibility for sample collection activities or analytical method limitations. The report reflects the samples as received. Results are generated from the field sampling data (sampling volumes and areas, locations, etc.) provided by the client on the Chain of Custody. Samples are within quality control criteria and met method specifications unless otherwise noted. The above analyses were performed in general compliance with Appendix E to Subpart E of 40 CFR (previously EPA 600/M4-82-020 "Interim Method") but augmented with procedures outlined in the 1993 ("final") version of the method. This report must not be used by the client to claim product certification, approval, or endorsement by NVLAP, NIST or any agency of the federal government. Non-friable organically bound materials present a problem matrix and therefore EMSL recommends gravimetric reduction prior to analysis. Unless requested by the client, building materials manufactured with multiple layers (i.e. linoleum, wallboard, etc.) are reported as a single sample. Estimation of uncertainty is available on request.

Samples analyzed by EMSL Analytical, Inc. Cinnaminson, NJ NVLAP Lab Code 101048-0, AIHA-LAP, LLC-IHLAP Lab 100194, NYS ELAP 10872, NJ DEP 03036, PA ID# 68-00367, LA #04127

Initial report from: 05/13/2021 19:38:38

EMSL Analytical, Inc.
200 Route 130 North



EMSL ANALYTICAL, INC.
LABORATORY • PRODUCTS • TRAINING

Asbestos Bulk Building Material Chain of Custody

EMSL Order Number (Lab Use Only)

RECEIVED
EMSL
MINNAPOLIS, N.J.

Cinnaminson, NJ 08077
PHONE: 1-800-220-3675
FAX: (856) 786-5974

06211132

21 MAY 12 AM 9:27

[illegible]

Revised 5/12/21 3:25 pm
50

RECEIVED
EMSL
CINNAMINSON, N.J.

04211132

Sample Log - Bulk Asbestos

21 MAY 12 PM 3:55

Client:	REPSG, Inc.	Project Name:	North East High School
Sampling Date/Time:	5/11/2021; 1500	Project Number:	12654.240.01

Bulk Asbestos Sample Log					
Client Sample #	Lab ID #	Material Description	Sample Location	HA	Notes
GH-001		White to Yellow to Pink Paint	Ground Floor, Hallway by Room 011 Upper wall	HA1	
GH-002		White to Yellow to Pink Paint	Ground Floor, Hallway By Room 9A Upper wall	HA1	
GH-003		White to Yellow to Pink Paint	Ground Floor, Hallway Between Room 7 and 6 Upper wall	HA1	
GH-004		White to Yellow to Pink Paint	Ground Floor, Hallway by Room 5 Upper wall	HA1	
GH-005		White to Yellow to Pink Paint	Ground Floor, Hallway Between 4 and 3 Upper wall	HA1	
GH-006		White to Yellow to Pink Paint	Ground Floor, Hallway by Room 1 Upper wall	HA1	
GH-007		White to Yellow to Pink Paint	Ground Floor, hallway across from Room 24 Upper wall	HA1	
GH-008		White to Yellow to Pink Paint	Ground Floor, Hallway across from M Stairs Upper wall	HA1	
GH-009		White to Yellow to Pink Paint	Ground Floor, Hallway by Room 22a Upper wall	HA1	
GH-010		Yellow to Pink Paint	Ground Floor, Hallway by storage Room 51 above locker on 24 Lower wall	HA2	
GH-011		Yellow to Pink Paint	Ground Floor, Hallway by Room 23 Lower wall	HA2	
GH-012		Yellow to Pink Paint	Ground Floor, Hallway by Room 22a Lower wall	HA2	
GH-013		Yellow to Pink Paint	Ground Floor, Hallway by D Stairs Lower wall	HA2	
GH-014		Yellow to Pink Paint	Ground Floor, Hallway by women's rm Lower wall	HA2	
GH-015		Yellow to Pink Paint	Ground Floor, Hallway by Room 25 Lower wall	HA2	
GC-001		Blue to Yellow Paint	Ground Floor, Cafeteria Walls and Columns	HA3	

04211132 RECEIVED
EMSL
CINNAMINSON, NJ
21 MAY 12 PM 3:55

Sample Log –Bulk Asbestos

Client:	REPSG, Inc.	Project Name:	North East High School
Sampling Date/Time:	5/11/2021; 1500	Project Number:	12654.240.01

Bulk Asbestos Sample Log

Client Sample #	Lab ID #	Material Description	Sample Location	HA	Notes
GC-002		Blue to Yellow Paint	Ground Floor, Cafeteria Walls and Columns	HA3	
GC-003		Blue to Yellow Paint	Ground Floor, Cafeteria Walls and Columns	HA3	
G8-001		Peach to green Paint	Ground Floor, Room 8 Walls	HA4	
G7-002		Peach to green Paint	Ground Floor, Room 7 Walls	HA4	
G5-003		Peach to green Paint	Ground Floor, Room 5 Walls	HA4	
G4-004		Peach to green Paint	Ground Floor, Room 4 Walls	HA4	
G2-005		Peach to green Paint	Ground Floor, Room 2 Walls	HA4	
G9-006		Peach to green Paint	Ground Floor, Room 9 Walls	HA4	
G6-007		Peach to green Paint	Ground Floor, Room 6 Walls	HA4	
GBR-001		Yellow-Tan Paint	Ground Floor, Boys Room by Cafeteria Walls	HA5	
G22A-001		Peach to green Paint	Ground Floor, Room 22A Walls	HA4	
G14-001		Peach, yellow, & green Paint	Ground Floor, Room 14 Walls	HA6	
G15-001		Peach, yellow, & green Paint	Ground Floor, Room 15 Walls	HA6	
GH-016		Blue on yellow on white Paint	Ground Floor, Hallway by Room 16B Walls	HA9	
GH-017		Blue on yellow on white Paint	Ground Floor, Hallway by Room 14A Walls	HA9	
GH-018		Blue on yellow on white Paint	Ground Floor, Hallway by Room 14 Walls	HA9	

04211132

RECEIVED
EMSL
CINNAMINSON, NJ

Sample Log –Bulk Asbestos

21 MAY 12 PM 3:55

Client:	REPSG, Inc.	Project Name:	North East High School
Sampling Date/Time:	5/11/2021; 1500	Project Number:	12654.240.01

Bulk Asbestos Sample Log					
Client Sample #	Lab ID #	Material Description	Sample Location	HA	Notes
G16B-001		Peach, yellow, & green Paint	Ground Floor, Room 16B Walls	HA6	
GH-019		Blue on yellow on white Paint	Ground Floor, Hallway near Room 19B Walls	HA9	
GH-020		Blue on yellow on white Paint	Ground Floor, Hallway near Room 18D Walls	HA9	
119-005		Peach on yellow on white & Green Paint	1st Floor, Room 119 Lower wall	HA11	
1H-001		Blue on white on pink Paint	1st Floor, Hallway by Room 119 Lower wall	HA12	
1H-002		Blue on white on pink Paint	1st Floor, Hallway across from Room 127 Lower wall	HA12	
1H-003		Blue on white on pink Paint	1st Floor, Hallway across from Room 133 Lower wall	HA12	
1H-004		Blue on white on pink Paint	1st Floor, Hallway next to Stage Lower wall	HA12	
1H-005		Blue on white on pink Paint	1st Floor, Hallway next to J Stairs Lower wall	HA12	
1BR-001		Yellow-Tan Paint	1st Floor, Boys Room next to J Stairs Lower wall	HA13	
1H-006		Beige on yellow on white on pink Paint	1st Floor, Hallway across from Room 115 Lower wall	HA14	
1H-007		Beige on yellow on white on pink Paint	1st Floor, Hallway next to Room 111 Lower wall	HA14	
1H-008		Beige on yellow on white on pink Paint	1st Floor, Hallway next to Room 109 Lower wall	HA14	
1H-009		Beige on yellow on white on pink Paint	1st Floor, Hallway next to Room 108 Lower wall	HA14	
1H-010		Beige on yellow on white on pink Paint	1st Floor, Hallway next to Room 110 Lower wall	HA14	
1H-011		Beige on yellow on white on pink Paint	1st Floor, Hallway across from Room 178, near exit door Lower wall	HA14	

04211132

RECEIVED
EMSL
CINNAMINSON, NJ

Sample Log -Bulk Asbestos					
Client:	REPSG, Inc.	Project Name:	21 MAY 12 PM 3:55 North East High School		
Sampling Date/Time:	5/11/2021; 1500	Project Number:	12654.240.01		

Bulk Asbestos Sample Log					
Client Sample #	Lab ID #	Material Description	Sample Location	HA	Notes
150-008		Peach on yellow on white & Green Paint	1st Floor, Room 150 Wall	HA11	
154-009		Peach on yellow on white & Green Paint	1st Floor, Room 154 Wall	HA11	
158-001		Electric blue Paint	1st Floor, Room 158 Wall	HA16	
160-002		Electric blue Paint	1st Floor, Room 160 Wall	HA16	
1H-012		Purple-blue on white Paint	1st Floor, Hallway next to A Stairs Wall	HA17	
1H-013		Purple-blue on white Paint	1st Floor, Hallway next to Room 132 Wall	HA17	
1H-014		Purple-blue on white Paint	1st Floor, Hallway next to Room 126 Wall	HA17	
126-001		Peach on yellow on white & Green Paint	1st Floor, Room 126 Wall	HA11	
140-002		Peach on yellow on white & Green Paint	1st Floor, Room 140 Wall	HA11	
138-001		Blue on yellow Paint	1st Floor, Room 138 Wall	HA18	
143-001		Yellow cream on green Paint	1st Floor, Room 143 Wall	HA15	
141-002		Yellow cream on green Paint	1st Floor, Room 141 Wall	HA15	
139-003		Peach on yellow on white & Green Paint	1st Floor, Room 139 Wall	HA11	
127-004		Peach on yellow on white & Green Paint	1st Floor, Room 127 Wall	HA11	
129-002		Blue on yellow Paint	1st Floor, Room 129 Wall	HA18	
123-006		Peach on yellow on white & Green Paint	1st Floor, Room 123 Wall	HA11	

04211132

RECEIVED
EMSL
CINNAMINSON, N.J.

Sample Log -Bulk Asbestos

21 MAY 12 PM 3:55

Client:	REPSG, Inc.	Project Name:	North East High School
Sampling Date/Time:	5/11/2021; 1500	Project Number:	12654.240.01

Bulk Asbestos Sample Log					
Client Sample #	Lab ID #	Material Description	Sample Location	HA	Notes
113-007		Peach on yellow on white & Green Paint	1st Floor, Room 113 Wall	HA11	
134-003		Blue on yellow Paint	1st Floor, Room 143 Wall	HA18	
1GR-002		Yellow-Tan Paint	1st Floor, Girls Room near Room 138 Wall	HA13	
143-003		Yellow cream on green Paint	1st Floor, Room 143 Wall	HA15	
0					
0					
0					
0					
0					
0					
0					
0					
0					
0					
0					
0					
0					
0					



EMSL Analytical, Inc.

5221 Militia Hill Road Plymouth Meeting, PA 19462

Tel/Fax: (610) 828-3102 / (610) 828-3122

<http://www.EMSL.com> / plymouthmeetinglab@emsl.com

EMSL Order: 182101669

Customer ID: REAC59A

Customer PO:

Project ID:

Attention: Suzanne Shourds

REACT Environmental Prof Svcs Grp, Inc.

6901 Kingsessing Avenue

Suite 201

Philadelphia, PA 19142

Project: North East HS / 12654.01

Phone: (215) 729-3220

Fax:

Received Date: 05/12/2021 4:45 PM

Analysis Date: 05/13/2021

Collected Date:

Test Report: Asbestos Analysis of Bulk Materials via EPA 600/R-93/116 Method using Polarized Light Microscopy

Sample	Description	Appearance	Non-Asbestos		Asbestos % Type
			% Fibrous	% Non-Fibrous	
221B-001 182101669-0001	2nd Floor, Room 221B Wall - Peach on Green With Pink Paint	Tan/White/Green Non-Fibrous Homogeneous		100% Non-fibrous (Other)	None Detected
			HA: 19		
225-002 182101669-0002	2nd Floor, Room 225 Wall - Peach on Green With Pink Paint	Tan/White/Green Non-Fibrous Homogeneous		100% Non-fibrous (Other)	None Detected
			HA: 19		
227B-003 182101669-0003	2nd Floor, Room 227B Wall - Peach on Green With Pink Paint	Tan/White/Pink Non-Fibrous Homogeneous		100% Non-fibrous (Other)	None Detected
			HA: 19		
229B-04 182101669-0004	2nd Floor, Room 229B Wall - Peach on Green With Pink Paint	Tan/Pink Non-Fibrous Homogeneous		100% Non-fibrous (Other)	None Detected
			HA: 19		
235-005 182101669-0005	2nd Floor, Room 235 Wall - Peach on Green With Pink Paint	Tan/Pink Non-Fibrous Homogeneous		100% Non-fibrous (Other)	None Detected
			HA: 19		
242-006 182101669-0006	2nd Floor, Room 242 Wall - Peach on Green With Pink Paint	Tan/Pink/Green Non-Fibrous Homogeneous		100% Non-fibrous (Other)	None Detected
			HA: 19		
206-007 182101669-0007	2nd Floor, Room 206 Wall - Peach on Green With Pink Paint	Tan/White Non-Fibrous Homogeneous		100% Non-fibrous (Other)	None Detected
			HA: 19		
207-008 182101669-0008	2nd Floor, Room 207 Wall - Peach on Green With Pink Paint	Tan/White/Green Non-Fibrous Homogeneous		100% Non-fibrous (Other)	None Detected
			HA: 19		
2H-001 182101669-0009	2nd Floor, Hallway by Room 219A Wall - Grey-Cream and White Paint	Tan/White Non-Fibrous Homogeneous		100% Non-fibrous (Other)	None Detected
			HA: 20		
2BR-001 182101669-0010	2nd Floor, Boys Room Near J Stairs Wall - Grey-Cream with Yellow and White Paint	Tan/White Non-Fibrous Homogeneous		100% Non-fibrous (Other)	None Detected
			HA: 21		

Initial report from: 05/13/2021 13:00:23



EMSL Analytical, Inc.

5221 Militia Hill Road Plymouth Meeting, PA 19462

Tel/Fax: (610) 828-3102 / (610) 828-3122

<http://www.EMSL.com> / plymouthmeetinglab@emsl.com

EMSL Order: 182101669

Customer ID: REAC59A

Customer PO:

Project ID:

Test Report: Asbestos Analysis of Bulk Materials via EPA 600/R-93/116 Method using Polarized Light Microscopy

Sample	Description	Appearance	Non-Asbestos		Asbestos
			% Fibrous	% Non-Fibrous	% Type
2H-002 182101669-0011	2nd Floor, Hallway by Room 217 Wall - Grey-Cream and White Paint	Tan/White Non-Fibrous Homogeneous	HA: 20	100% Non-fibrous (Other)	None Detected
2H-003 182101669-0012	2nd Floor, Hallway Across From Room 213 Wall - Grey-Cream and White Paint	Tan/White Non-Fibrous Homogeneous	HA: 20	100% Non-fibrous (Other)	None Detected
2H-004 182101669-0013	2nd Floor, Hallway by Room 207 Wall - Grey-Cream and White Paint	White Non-Fibrous Homogeneous	HA: 20	100% Non-fibrous (Other)	None Detected
2H-005 182101669-0014	2nd Floor, Hallway by Room 218 Wall - Grey-Cream and White Paint	White Non-Fibrous Homogeneous	HA: 20	100% Non-fibrous (Other)	None Detected
2H-006 182101669-0015	2nd Floor, Hallway by Room 231 Wall - Grey-Cream and White Paint	White Non-Fibrous Homogeneous	HA: 20	100% Non-fibrous (Other)	None Detected
2H-007 182101669-0016	2nd Floor, Hallway by Room 226A Wall - Grey-Cream and White Paint	Tan/White Non-Fibrous Homogeneous	HA: 20	100% Non-fibrous (Other)	None Detected
2H-008 182101669-0017	2nd Floor, Hallway by Room 201 Wall - Grey-Cream and White Paint	White Non-Fibrous Homogeneous	HA: 20	100% Non-fibrous (Other)	None Detected
1BR-003 182101669-0018	1st Floor, Boys Room Across From Main Office Wall - Yellow - Tan Paint	White Non-Fibrous Homogeneous	HA: 13	100% Non-fibrous (Other)	None Detected
GBR-002 182101669-0019	Ground Floor, Boys Room Near J Stairs Wall - Yellow - Tan Paint	Tan/White Non-Fibrous Homogeneous	HA: 5	100% Non-fibrous (Other)	None Detected
GWR-003 182101669-0020	Ground Floor, Womens Room Near D Stairs Wall - Yellow - Tan Paint	Tan/White Non-Fibrous Homogeneous	HA: 5	100% Non-fibrous (Other)	None Detected



EMSL Analytical, Inc.

5221 Militia Hill Road Plymouth Meeting, PA 19462

Tel/Fax: (610) 828-3102 / (610) 828-3122

<http://www.EMSL.com> / plymouthmeetinglab@emsl.com

EMSL Order: 182101669

Customer ID: REAC59A

Customer PO:

Project ID:

Analyst(s)

Adam Gart (20)

Kevin Ream, Laboratory Manager
or Other Approved Signatory

EMSL maintains liability limited to cost of analysis. Interpretation and use of test results are the responsibility of the client. This report relates only to the samples reported above, and may not be reproduced, except in full, without written approval by EMSL. EMSL bears no responsibility for sample collection activities or analytical method limitations. The report reflects the samples as received. Results are generated from the field sampling data (sampling volumes and areas, locations, etc.) provided by the client on the Chain of Custody. Samples are within quality control criteria and met method specifications unless otherwise noted. The above analyses were performed in general compliance with Appendix E to Subpart E of 40 CFR (previously EPA 600/M4-82-020 "Interim Method") but augmented with procedures outlined in the 1993 ("final") version of the method. This report must not be used by the client to claim product certification, approval, or endorsement by NVLAP, NIST or any agency of the federal government. Non-friable organically bound materials present a problem matrix and therefore EMSL recommends gravimetric reduction prior to analysis. Unless requested by the client, building materials manufactured with multiple layers (i.e. linoleum, wallboard, etc.) are reported as a single sample. Estimation of uncertainty is available on request.

Samples analyzed by EMSL Analytical, Inc. Plymouth Meeting, PA NVLAP Lab Code 200699-0, Philadelphia ALL-292, VA 3333000315, AIHA-LAP, LLC IHLAP #178659

Initial report from: 05/13/2021 13:00:23



EMSL ANALYTICAL, INC.
LABORATORY • PRODUCTS • TRAINING

Asbestos Bulk Building Material Chain of Custody

EMSL Order Number (Lab Use Only):

18 2 10 16 69

LITTLE & WILSON, INC.

200 Route 130 North

Cinnaminson, NJ 08077

PHONE: 1-800-220-3675

FAX: (856) 786-5974

Company : REPSG, Inc.					
Street: 6901 Kingessing Avenue Suite 201					
City: Philadelphia		State/Province: PA		Zip/Postal Code: 19142 Country: US	
Report To (Name): Suzanne Shourds				Telephone #: 2157293220	
Email Address: sshourds@repsg.com				Fax #:	Purchase Order:
Project Name/Number: North East HS / 12654.240.01				Please Provide Results:	Fax <input type="checkbox"/> Email <input checked="" type="checkbox"/> Mail <input type="checkbox"/>
U.S. State Samples Taken: PA				CT Samples: <input type="checkbox"/> Commercial/Taxable <input type="checkbox"/> Residential/Tax Exempt	
Turnaround Time (TAT) Options* - Please Check <input type="checkbox"/> 3 Hour <input checked="" type="checkbox"/> 6 Hour <input type="checkbox"/> 24 Hour <input type="checkbox"/> 48 Hour <input type="checkbox"/> 72 Hour <input type="checkbox"/> 96 Hour <input type="checkbox"/> 1 Week <input type="checkbox"/> 2 Week					
*For TEM Air 3 hr through 6 hr, please call ahead to schedule.*There is a premium charge for 3 Hour TEM AHERA or EPA Level II TAT. You will be asked to sign an authorization form for this service. Analysis completed in accordance with EMSL's Terms and Conditions located in the Analytical Price Guide.					
PLM - Bulk (reporting limit)			TEM - Bulk		
<input checked="" type="checkbox"/> PLM EPA 600/R-93/116 (<1%) <input type="checkbox"/> PLM EPA NOB (<1%) Point Count <input type="checkbox"/> 400 (<0.25%) <input type="checkbox"/> 1000 (<0.1%) Point Count w/Gravimetric <input type="checkbox"/> 400 (<0.25%) <input type="checkbox"/> 1000 (<0.1%) <input type="checkbox"/> NIOSH 9002 (<1%) <input type="checkbox"/> NY ELAP Method 198.1 (friable in NY) <input type="checkbox"/> NY ELAP Method 198.6 NOB (non-friable-NY) <input type="checkbox"/> OSHA ID-191 Modified <input type="checkbox"/> Standard Addition Method			<input type="checkbox"/> TEM EPA NOB – EPA 600/R-93/116 Section 2.5.5.1 <input type="checkbox"/> NY ELAP Method 198.4 (TEM) <input type="checkbox"/> Chatfield Protocol (semi-quantitative) <input type="checkbox"/> TEM % by Mass – EPA 600/R-93/116 Section 2.5.5.2 <input type="checkbox"/> TEM Qualitative via Filtration Prep Technique <input type="checkbox"/> TEM Qualitative via Drop Mount Prep Technique <u>Other</u> <input type="checkbox"/>		
<input checked="" type="checkbox"/> Check For Positive Stop – Clearly Identify Homogenous Group				Date Sampled: 5/12/2021	
Samplers Name: Quanda Beck				Samplers Signature: [Signature]	
Sample #	HA #	Sample Location	Material Description		
		SEE ATTACHED PAGES			
Client Sample # (s):			Total # of Samples:		
Relinquished (Client): [Signature]			Date: 5/12/2021	Time: 4:30pm	
Received (Lab): [Signature]			Date: 5/12/21	Time: 4:45	
Comments/Special Instructions:					

182101669

Sample Log –Bulk Asbestos

Client:	REPSG, Inc.		Project Name:		North East High School
Sampling Date/Time:	5/12/2021; 1000		Project Number:		12654.240.01

Bulk Asbestos Sample Log

Client Sample #	Lab ID #	Material Description	Sample Location	HA	Notes
221B-001		Peach on green with pink Paint	2nd Floor, Room 221B Wall	HA19	
225-002		Peach on green with pink Paint	2nd Floor, Room 225 Wall	HA19	
227B-003		Peach on green with pink Paint	2nd Floor, Room 227B Wall	HA19	
229B-004		Peach on green with pink Paint	2nd Floor, Room 229B Wall	HA19	
235-005		Peach on green with pink Paint	2nd Floor, Room 235 Wall	HA19	
242-006		Peach on green with pink Paint	2nd Floor, Room 242 Wall	HA19	
206-007		Peach on green with pink Paint	2nd Floor, Room 206 Wall	HA19	
207-008		Peach on green with pink Paint	2nd Floor, Room 207 Wall	HA19	
2H-001		Grey-Cream and White Paint	2nd Floor, Hallway by Room 219A Wall	HA20	
2BR-001		Grey-Cream with Yellow and White Paint	2nd Floor, Boys Room near J stairs Wall	HA21	
2H-002		Grey-Cream and White Paint	2nd Floor, Hallway by Room 217 Wall	HA20	
2H-003		Grey-Cream and White Paint	2nd Floor, Hallway across from Room 213 Wall	HA20	
2H-004		Grey-Cream and White Paint	2nd Floor, Hallway by Room 207 Wall	HA20	
2H-005		Grey-Cream and White Paint	2nd Floor, Hallway by Room 218 Wall	HA20	
2H-006		Grey-Cream and White Paint	2nd Floor, Hallway by Room 231 Wall	HA20	
2H-007		Grey-Cream and White Paint	2nd Floor, Hallway by Room 226A Wall	HA20	

Sample Log – Bulk Asbestos					
Client:	REPSG, Inc.		Project Name:		North East High School
Sampling Date/Time:	5/12/2021; 1000		Project Number:		12654.240.01

[illegible]



May 20, 2021

The School District of Philadelphia
Office of Capital Programs
440 North Broad Street
Philadelphia, PA 19130
Attn: Mr. Kevin Meldrum
kmeldrum@philasd.org

**RE: Results of Lead in Paint Testing via XRF Method
Capital Project – Air Conditioning System Upgrade
North East High School (ULCS No. 8020)
1601 Cottman Avenue
Philadelphia, PA 19111
REPSG Project Number 12654.240.01**

Dear Mr. Meldrum

React Environmental Professional Services Group, Inc., (REPSG) has performed lead in paint testing at “North East High School (ULCS No. 8020)” located at 1601 Cottman Avenue in the City of Philadelphia, Pennsylvania (the subject property).

This survey was conducted using X-Ray Fluorescence (XRF) methodology. The scope of this investigation was limited to building components at accessible areas of the subject property structure within the scope of planned air conditioning system upgrades. Components included within this scope of work included select walls and ceilings covered in at least one coat of visible paint that were within the planned installation scope of work. This letter report summarizes the sampling activities performed and the results of the XRF analyses.

Lead-based paint (LBP) is defined by the US Environmental Protection Agency (EPA) and the US Department of Housing and Urban Development (HUD) as those paint samples that have been shown by Flame Atomic Absorption Spectrometry (AAS) analysis to contain greater than 0.5% lead concentration by weight, or 1.0 mg/cm² or greater when using X-Ray Fluorescence (XRF) technology. The City of Philadelphia Department of Public Health (DoH) defines LBP as those paint samples that contain lead content of 0.7 mg/cm² or greater when using XRF technology. The Occupational Safety and Health Administration (OSHA) considers paint that contains lead at concentrations above 0.1 mg/cm² when using XRF technology to be lead-containing paint (LCP) for construction worker exposure purposes.

P.O. Box 5377
6901 Kingsessing Avenue, Suite 201
Philadelphia, PA 19142-0377

Office: 215.729.3220
Fax: 215.729.1557
www.repsg.com

The XRF testing was conducted using methodology within the guidelines set forth in HUD regulations 24 CFR 35. These XRF sampling services were conducted by Ms. Suzanne Shourds, an EPA-Certified and Pennsylvania Licensed Lead Inspector/Risk Assessor and X-Ray Fluorescence (XRF) technician, and Mr. Sherif Mohamed, Mr. James Arbuckle, and Ms. Shalaunda Gouridine, a trained XRF technicians.

For the purposes of this assessment “Wall 1 (W1)” is defined as the wall that the main entry door to the space is located on, with “Wall 2 (W2),” “Wall 3 (W3),” and “Wall 4 (W4)” being located in a clockwise fashion from the door within the room. In the majority of classrooms, this typically means that W3 is the wall where the window systems are located. Based on conversations that REPSG had with both SDP staff as well as on-site building engineering staff, it was assumed that the necessary electrical work needed to support the air conditioning upgrades would be run through the hallways along the upper wall systems, and then would be fed into the classrooms at W1 via proposed penetrations in the concrete masonry unit (CMU) wall systems.

The results of the XRF testing that indicate the presence of LBP at the subject property is summarized on **Table 1**.



Table 1: Summary Results of XRF Results for LBP at the Subject Property

Building Element	Floor	Space #	Space Type	On-Site Room Name	Component	Substrate Material	Color	Description of Damage	Damage Quantity (LF)	XRF Reading (mg/cm2)	XRF (positive/negative)
1	G	44	Cafeteria (Dining Area)	Cafeteria	W1	Ceramic Tile	Gray	Cracking	1	>1	Positive ¹
1	1	H17	Circulation (Hallway)	Hallway between Classroom 109 and Classroom 111	W4	Concrete	Beige & White	Chipping	10	1	Positive
1	1	H13A	Circulation (Hallway)	Hallway between Main Office and Counselor's 103 Suites	W1	Concrete	Beige & White	Chipping	10	1.07	Positive
1	1	H13A	Circulation (Hallway)	Hallway between Main Office and Counselor's 103 Suites	W2	Concrete	Beige & White	Chipping	10	1	Positive
1	1	H13A	Circulation (Hallway)	Hallway between Main Office and Counselor's 103 Suites	W3	Concrete	Beige & White	Chipping	10	1.25	Positive
1	1	H13A	Circulation (Hallway)	Hallway between Main Office and Counselor's 103 Suites	W4	Concrete	Beige & White	Chipping	10	1	Positive
1	1	122	Art - Senior High	Classroom 122	W2	Concrete	Multi (Paint Splatters)	None	0	1	Positive ²

¹ This component is outside the scope of planned renovations. In addition, based on the component substrate (ceramic tile) the potential exists that the source of lead identified via the XRF testing is within the substrate material (ceramic tile) and not within the paint present on the surface.

² The part of this component that tested positive for lead is located within an art classroom, and had an area of paint splatter located on the wall above the sink used for cleaning art supplies. All other locations along the same component wall surface within this classroom assessed via XRF were negative for lead.

Building Element	Floor	Space #	Space Type	On-Site Room Name	Component	Substrate Material	Color	Description of Damage	Damage Quantity (LF)	XRF Reading (mg/cm2)	XRF (positive/negative)
1	1	H14C	Circulation (Hallway)	Hallway from Classroom 115 to Stairwell Q	W4	Concrete	Beige & White	Chipping	10	1	Positive
1	2	H26	Circulation (Hallway)	Second Floor Hallway from Stairwell B to Library	W2	Concrete	Grey-Cream and White	None	0	1	Positive
1	2	H26	Circulation (Hallway)	Second Floor Hallway from Stairwell B to Library	W3	Concrete	Grey-Cream and White	None	0	1	Positive
1	2	H27C	Circulation (Hallway)	Second Floor Hallway from Stairwell B to Classroom 236	W3	Concrete	Grey-Cream and White	None	0	1	Positive
1	2	201C	Student Restrooms - Male (4-12)	Boy's Restroom adjacent to Classroom 200	W1	Concrete	Beige & White	Cracking	1	1.11	Positive
1	2	201C	Student Restrooms - Male (4-12)	Boy's Restroom adjacent to Classroom 200	W2	Concrete	Beige & White	Cracking	1	1.21	Positive
1	2	201C	Student Restrooms - Male (4-12)	Boy's Restroom adjacent to Classroom 200	W3	Concrete	Beige & White	None	0	1.04	Positive





A complete copy of the results along with notated diagrams indicating the approximate locations of LBP covered components at the subject property are included attachments to this letter.

If you have any further questions or comments, please do not hesitate to contact our office.

Sincerely,

REPSG Environmental Professional Services Group, Inc.

Suzanne Shourds
Senior Project Manager
PA Risk Assessor License No.: 005966

Attachments



THE SCHOOL DISTRICT OF PHILADELPHIA

NORTHEAST HIGH SCHOOL 1601 COTTMAN AVE, PHILADELPHIA, PA 19104 NORTHEAST HIGH SCHOOL AIR CONDITIONING UPGRADE

100% Design Submission: April 30, 2021

OWNER

SCHOOL DISTRICT OF PHILADELPHIA
440 North Broad
Philadelphia, PA 19130-4015
Phone: 215-400-4740
Fax: 215-400-4721
Email: nward@philsd.org
Attn: Nicole Ward, Design Manager
Office of Capital Programs
www.philsd.org

ENGINEER OF RECORD

GANNETT FLEMING, INC.
1010 Adams Avenue
Valley Forge, PA 19403
Phone: 610-650-8156
Fax: 610-650-8190
Email: bwelsser@gfnet.com
Attn: Brian M. Welsser, P.E.

ZONING DATA

EDUCATIONAL
OCCUPANCY

BUILDING DATA

ORIGINAL CONSTRUCTION: 1957
MAJOR RENOVATIONS: 1973 - SPARC WING
GROUND FLOOR: 105,660 SF
FIRST FLOOR: 158,490 SF
SECOND FLOOR: 88,133 SF
TOTAL AREA: 352,283 SF
UNSPRINKLED

CODE DATA

1. PHILADELPHIA BUILDING CONSTRUCTION AND OCCUPANCY CODE:
 - SUBCODE "A": THE PHILADELPHIA ADMINISTRATIVE CODE
 - SUBCODE "B": THE PHILADELPHIA BUILDING CODE
 - SUBCODE "E": THE PHILADELPHIA ELECTRICAL CODE
 - SUBCODE "EP": THE PHILADELPHIA EXISTING BUILDING CODE
 - SUBCODE "EO": THE PHILADELPHIA ENERGY CONSERVATION CODE
 - SUBCODE "F": THE PHILADELPHIA FIRE CODE
 - SUBCODE "FC": THE PHILADELPHIA CODE FOR BUILDINGS AND MAINTENANCE
 - SUBCODE "PM": THE PHILADELPHIA PROPERTY MAINTENANCE CODE
 - PHILADELPHIA CROSS CONNECTION CODE
 - 2018 INTERNATIONAL BUILDING CODE CHAPTER 11 AND APPENDIX E (ADA)
2. NFPA 70-2017, NATIONAL ELECTRIC CODE
3. NFPA 72-2013, NATIONAL FIRE ALARM CODE

SUBCONTRACTOR RESPONSIBILITIES

THE ELECTRICAL CONTRACTOR IS RESPONSIBLE FOR PROCUREMENT OF THE ENVIRONMENTAL REMEDIATION CONTRACTOR AND EXECUTION OF ALL ASBESTOS ABATEMENT AND LEAD-BASED PAINT/ABATEMENT REQUIRED FOR THE PERFORMANCE OF THE WORK OF THIS CONTRACT.



LOCATION MAP

SCALE: NTS

DRAWING LIST		
SHEET #	DRAWING #	SHEET NAME
1	0001	COVER SHEET
2	W001	LEGEND, ABBREVIATIONS & GENERAL NOTES
3	W101	MECHANICAL HVAC BROWNE FLOOR PLAN
4	W102	MECHANICAL HVAC FIRST FLOOR PLAN - SOUTH
5	W103	MECHANICAL HVAC FIRST FLOOR PLAN - NORTH
6	W104	MECHANICAL HVAC SECOND FLOOR PLAN - SOUTH
7	W105	MECHANICAL HVAC SECOND FLOOR PLAN - NORTH
8	W001	MECHANICAL SCHEDULES AND DETAILS
9	E001	ELECTRICAL ABBREVIATIONS & GENERAL NOTES
10	E101	ELECTRICAL POWER GROUND FLOOR
11	E102	ELECTRICAL POWER FIRST FLOOR & BASEMENT 1
12	E103	ELECTRICAL POWER FIRST FLOOR PLAN PART 2
13	E104	ELECTRICAL POWER SECOND FLOOR PLAN PART 1
14	E105	ELECTRICAL POWER SECOND FLOOR PLAN PART 2
15	E001	PHILADELPHIA ELECTRICAL SCHEDULES
16	E002	ELECTRICAL SCHEDULES AND DETAILS

THE SCHOOL DISTRICT OF
PHILADELPHIA
OFFICE OF CAPITAL PROGRAMS

440 NORTH BROAD STREET
PHILADELPHIA, PA 19130 - 4015
(215) 400-4740 | (215) 400-4721 (fax)
www.philsd.org

SEAL:

ENGINEER OF RECORD:
MICHAEL J. LAMBERTS, ENGINEER
GANNETT FLEMING, INC.
1010 ADAMS AVENUE
VALLEY FORGE, PA 19403
Phone: 610-650-8156
Email: BWELSSER@GFNET.COM
Attn: Brian Welsser

100% SUBMISSION
04/30/2021

NO.	DATE	REVISION

SCHOOL & LOCATION
1601 COTTMAN AVE, PHILADELPHIA, PA
19111


PROJECT TITLE
AIR CONDITIONING UPGRADE

DRAWING TITLE

COVER SHEET

DRAWING SCALE	
AS NOTED	
LOCATION NO.	ENGINEER'S P.E. NO.
NSP	00001001
DRAWN BY	CHECKED BY
AWJ	BMW
DATE: 8-10-01	DATE: 8-10-01
BY: 8-10-01	BY: 8-10-01
DATE: 8-10-01	DATE: 8-10-01
DRAWING NO.	
G001	
SHEET 1 OF 16	

SCHOOL DISTRICT OF PHILADELPHIA OFFICE OF CAPITAL PROGRAMS			

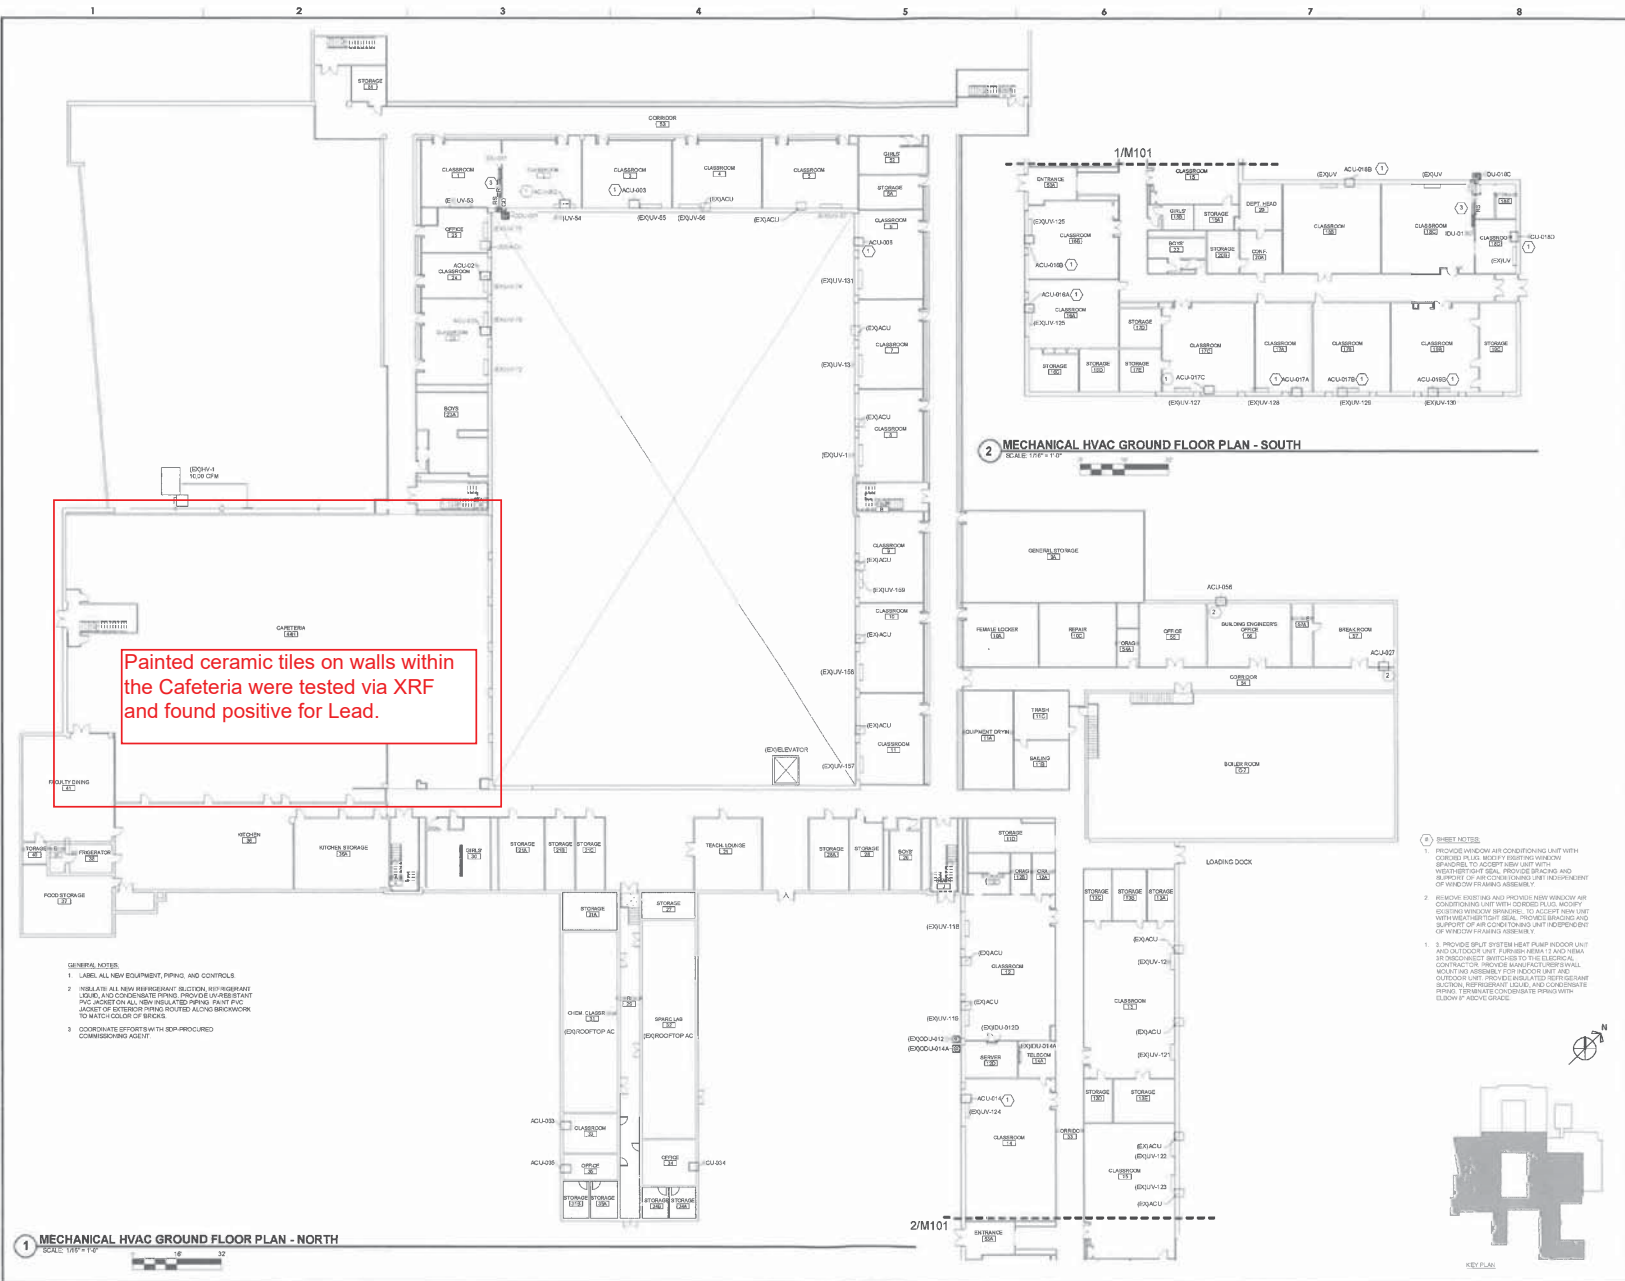

1. LABEL ALL NEW EQUIPMENT, PIPING, AND CONTROLS.
2. INSULATE ALL NEW REFRIGERANT SUCTION, REFRIGERANT LIQUID, AND CONDENSATE PIPING. PROVIDE UV-RESISTANT PVC JACKET ON ALL NEW INSULATED PIPING. PAINT PVC JACKET OF EXISTOR PIPING ROUTED ALONG BRICKWORK TO MATCH COLOR OF BRICKS.
3. COORDINATE EFFORTS WITH SEIP-PROCURED COMMISSIONING AGENT.

1. PROVIDE WINDOW AIR CONDITIONING UNIT WITH CORDED PLUG. MODIFY EXISTING WINDOW SPANREL TO ACCEPT NEW UNIT WITH WEATHER-TIGHT SEAL. PROVIDE BRACING AND SUPPORT OF AIR CONDITIONING UNIT INDEPENDENT OF WINDOW FRAMING ASSEMBLY.

ENGINEER OF RECORD:

MECHANICAL PLUMBING ENGINEERS
GANNETT FLEMING, INC.
1010 ADAMS AVENUE
VALLEY FORGE, PA 19403
Phone: 610.783.3662
Email: BWISSER@GFNET.COM
Attn: BRIAN WEISSER

Painted walls along this corridor at the school were tested via XRF and found positive for LBP

SCALE: 1/8" = 1'-0"

04/30/2021

NO	DATE	DIVISION
----	------	----------

SCHOOL & LOCATION
1601 COTTMAN AVE, PHILADELPHIA PA
19111

PROJECT TITLE

... ..

DRAWING: 1111

MECHANICAL HVAC FIRST
FLOOR PLAN - SOUTH

DRAWING SCALE

AS NOTED	
LOCATION NO. 8000	ENGINEER'S PRJ. NO. 068625.001
DRAWN BY JAU	CHECKED BY BAW

MC - B-300X C	OF	2020/21
PC - B-300X C	OF	2020/21
EC - B-300X C	OF	2020/21

DRAFTING NO.

M102

SHEET 4 OF 16

SEAL:

DATE: 10/10/2021
BY: [Signature]

ENGINEER OF RECORD

MECHANICAL ENGINEERING
GANNETT FLEMING, INC.
1000 MARKET STREET
VALLEY FORGE, PA 19383
PHILADELPHIA
PHILADELPHIA
ALSO: [Signature]

100% SUBMISSION
04/30/2021

NO DATE REVISION
SCHOOL & LOCATION
1601 COTMAN AVE. PHILADELPHIA PA
19111

PROJECT TITLE
AIR CONDITIONING UPGRADE


DRAWING TITLE
MECHANICAL HVAC FIRST
FLOOR PLAN - NORTH

DRAWING SCALE
AS NOTED
LOCATION NO. ENGINEER P.R. NO.
NO. 00000000
DRAWN BY CHECKED BY
JLB BHW
MC - 0-000 C OF 3020/01
PC - 0-000 C OF 3020/01
SC - 0-000 C OF 3020/01
DRAWING NO.
M103
SHEET 5 OF 16


- GENERAL NOTES:
1. LABEL ALL NEW EQUIPMENT, PIPING, AND CONTROLS.
 3. COORDINATE EFFORTS WITH SDP-PROCLINED COMMERCIAL AGENT.
- REMARKS:

Multi-colored paint splatters on this wall in this art classroom at the school were tested via XRF and found positive for LBP.

Painted walls along this corridor at the school were tested via XRF and found positive for LBP.

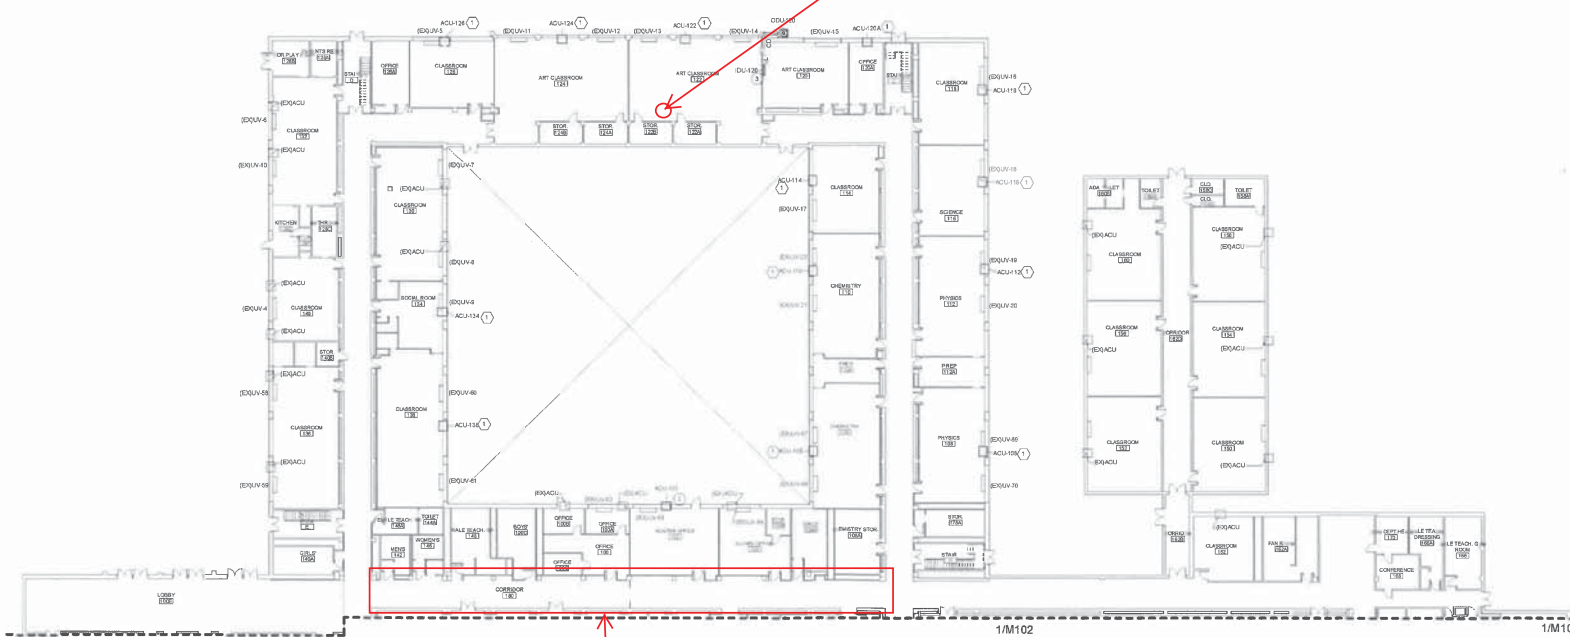

1 MECHANICAL HVAC FIRST FLOOR PLAN - NORTH

 

GENERAL NOTES

1. LABEL ALL NEW EQUIPMENT, PIPING, AND CONTROLS
3. COORDINATE EFFORTS WITH SC-200 PROCURED COMMISSIONING AGENT.

SHIFT NOTES

1. PROVIDE WINDOW AIR CONDITIONING UNIT WITH CORDED PLUG. MODIFY EXISTING WINDOW SPANDREL TO ACCEPT NEW UNIT WITH WEATHERTIGHT SEAL. PROVIDE BRACING AND SUPPORT OF AIR CONDITIONING UNIT INDEPENDENT OF WINDOW FRAMING ASSEMBLY.
2. REMOVE EXISTING AND PROVIDE NEW WINDOW AIR CONDITIONING UNIT WITH CORDED PLUG. MODIFY EXISTING WINDOW SPANDREL TO ACCEPT NEW UNIT WITH WEATHERTIGHT SEAL. PROVIDE BRACING AND SUPPORT OF AIR CONDITIONING UNIT INDEPENDENT OF WINDOW FRAMING ASSEMBLY.

ENGINEER OF RECORD

MECHANICAL / PLUMBING ENGINEER
GANNETT FLEMING, INC.
1010 ADAMS AVENUE
VALLEY FORGE, PA 19403
Phone: 610.283.3862
Email: JWEISSER@GFNET.COM
Attn: DEAN WITTESSER

100% SUBMISSION
04/30/2021

[illegible]

NO	DATE	SESSION
----	------	---------

SCHOOL & LOCATION
1601 COTTMAN AVE. PHILADELPHIA PA
19111

PROJECT TITLE
AIR CONDITIONING UPGRADE

DRAWING TITLE
MECHANICAL HVAC SECOND
FLOOR PLAN - SOUTH

DRAWING SCALE AS NOTED	
LOCATION NO. 8020	ENGINEER'S PRA. NO. 06M25.001
DRAWN BY JAA	CHECKED BY BNW
MC - 8-XXX C OF 2020/21 PC - 8-XXX C OF 2020/21 EC - 8-XXX C OF 2020/21	

DRAWING NO.
M104
SHEET 6 OF 16



1 MECHANICAL HVAC SECOND FLOOR PLAN - SOUTH



GENERAL NOTES

1. LABEL ALL NEW EQUIPMENT, PIPING, AND CONTROLS.
2. INSULATE ALL NEW REFRIGERANT SUCTOR, REFRIGERANT LIQUID, AND CONDENSATE PIPING. PROVIDE FLARELESS PIPING JOINTS ON ALL NEW INSULATED PIPING. PAINT PIPING JOINTS OR EXISTING BRASS PIPING ALONG BRICKWORK TO MATCH COLOR OF BRICKS.
3. COORDINATE EFFORTS WITH SDP-PROCESSED COMMISSIONING AGENT.

EXISTING NOTES


Painted walls along this corridor at the school were tested via XRF and found positive for LBP.

Painted walls in this Boy's Restroom at the school were tested via XRF and found positive for LBP.

MECHANICAL HVAC SECOND FLOOR PLAN - NORTH



100% SUBMISSION
04/26/2021

NO.	REVISION

SCHOOL & LOCATION
1401 COTTMAN AVE. PHILADELPHIA PA 19111








PROJECT TITLE
AIR CONDITIONING UPGRADE

DRAWING TITLE
MECHANICAL HVAC SECOND FLOOR PLAN - NORTH

DRAWING SCALE
AS NOTED
LOCATION NO. ENGINEER'S REG. NO.
ROOM EXAMINER
DRAWN BY
JAN
CHECKED BY
BAM

MC - A-100 C OF 2020/01
PC - B-100 C OF 2020/01
RC - B-100 C OF 2020/01

DRAWING NO.
M105
SHEET 7 OF 16

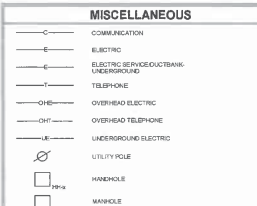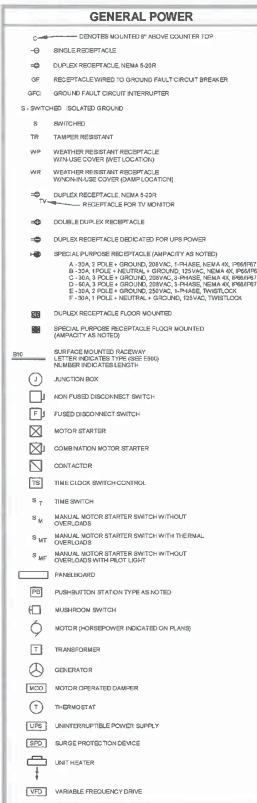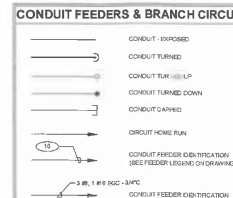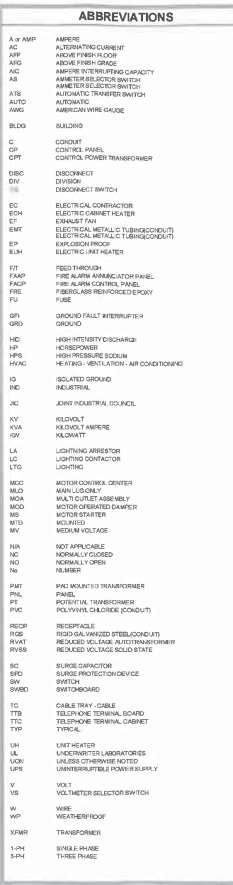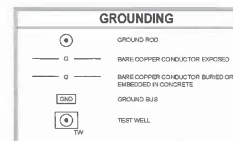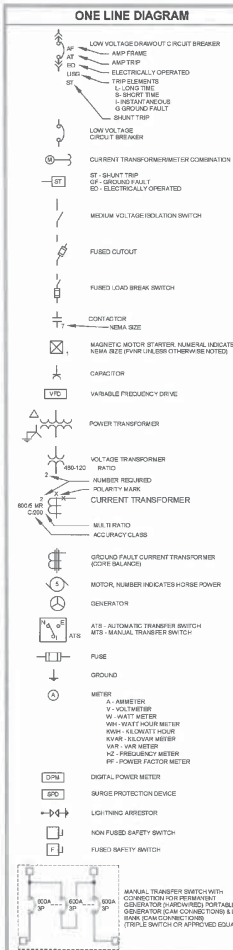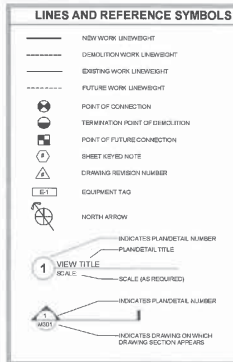

- [illegible]

- ## WIRING METHODS
1. **UNDERGROUND**
 - A. UNLESS OTHERWISE NOTED ON THE DRAWINGS CONCRETE ENCASED AND DIRECT BURIED CABLE SHALL BE SCHEDULE 40-PC WHERE CONDUITS SHALL PASS THROUGH CONCRETE OR MASONRY CONDUITS SHALL BE 1-1/2" MIN. RIGID POLYETHYLENE OR FLOW MOLD FLARE SLABS CONDUIT SHALL BE PVC COATED
 2. **OUTDOORS**
 - A. UNLESS OTHERWISE NOTED ON THE DRAWINGS CONDUIT INSTALLED OUTDOORS SHALL BE GALVANIZED RIBBON RITEL AND 1-1/2" MIN. CONNECTIONS SHALL BE LIGHTLY FLUORIDABLE METAL CONDUIT
 3. **INDOORS**
 - A. IN FINISHED AREAS RACEWAY AND WIRING SHALL BE CONCEALED AND BOXED
 - B. IN FINISHED WIRING INSTALLED IN MASONRY WALLS SHALL BE SET OUT OR JAWGERS SET, WIRING INSTALLED IN STUCCO WALL, CAVITIES OR AROUND HUNG CEILING SHALL BE SET OUT OR JAWGERS SET
 - C. IN UNFINISHED (SUCH AS MECHANICAL AND ELECTRICAL ROOMS) WIRING SHALL BE SET OUT OR JAWGERS SET
 - D. WIRING IN THE CRAWLSPACE SHALL BE INSTALLED IN RIGID METAL CONDUIT

 THE SCHOOL DISTRICT OF
PHILADELPHIA

OFFICE OF CAPITAL PROGRAMS

440 NORTH BROAD STREET
PHILADELPHIA, PA 19130 - 4015

(215) 400 - 4730 | (215) 400 - 4731 (fax)
www.phildist.org

ENGINEER OF RECORD:
MECHANICAL / PLUMBING ENGINEER
GANNETT FLEMING, INC.
1010 ADAMS AVENUE
VALLEY Forge, PA 19403
Phone: 410-783-3842
Email: SWES@GFCFHE.COM
Attn: BRIAN WEISER

[illegible]

PROJECT TITLE
AIR CONDITIONING UPGRADE

DRAWING TITLE
**ELECTRICAL ABBREVIATIONS &
GENERAL NOTES**

DRAWING SCALE AS NOTED	
LOCATION NO. 0020	ENGINEER'S PRJ. NO. 006635.001
DRAWN BY FJR	CHECKED BY BAM
MC - B-300X C	OF 2020/21
PC - B-300X C	OF 2020/21
EC - B-300X C	OF 2020/21

DRAWING NO.
E001

SHEET 9 OF 16

ULCS#					Inspection Dates: 5/3/2021, 5/11-12/2021, 5/18-19/2021			School District of Philadelphia						
					Name of Inspector: Suzanne Shourds, Shaluanda Gourdine, Sherif Mohamed, James Arbuckle,			Lead Safe Certification Assessment Report						
					Inspection Company: REPSG, Inc.			North East High School (ULCS No. 8020)						
ULCS#	Element	ID	Floor	Space #	Space Type	On-Site Room Name	Teacher	Component	Substrate Material	Color	Description of Damage	(sf)	(mg/cm2)	(positive/ negative)
8020	1	B802001-1	G	H07A	Circulation (Hallway)	Hallway adjacent to Boiler Room and Crawl Space	N	W1	Concrete	Tan	None	0	0	Negative
8020	1	B802001-1	G	H07A	Circulation (Hallway)	Hallway adjacent to Boiler Room and Crawl Space	N	W2	Concrete	Tan	Flaking	20	0	Negative
8020	1	B802001-1	G	H07A	Circulation (Hallway)	Hallway adjacent to Boiler Room and Crawl Space	N	W3	Concrete	Tan	Flaking	10	0	Negative
8020	1	B802001-1	G	H07A	Circulation (Hallway)	Hallway adjacent to Boiler Room and Crawl Space	N	W4	Concrete	Tan	None	0	0	Negative
8020	1	B802001-1	G	010F	Administrative Office	Building Engineer's Office adjacent to Boiler Room	N	W1	Concrete	Blue	None	0	0	Negative
8020	1	B802001-1	G	010F	Administrative Office	Building Engineer's Office adjacent to Boiler Room	N	W2	Concrete	Blue	None	0	0	Negative
8020	1	B802001-1	G	010F	Administrative Office	Building Engineer's Office adjacent to Boiler Room	N	W3	Concrete	Blue	None	0	0	Negative
8020	1	B802001-1	G	010F	Administrative Office	Building Engineer's Office adjacent to Boiler Room	N	W4	Concrete	Blue	None	0	0	Negative
8020	1	B802001-1	G	H07	Circulation (Hallway)	Hallway outside Building Engineer's Office and Boiler Room	N	W1	Concrete	Tan	None	0	N/A	N/A
8020	1	B802001-1	G	H07	Circulation (Hallway)	Hallway outside Building Engineer's Office and Boiler Room	N	W2	Concrete	Tan	None	0	N/A	N/A
8020	1	B802001-1	G	H07	Circulation (Hallway)	Hallway outside Building Engineer's Office and Boiler Room	N	W3	Concrete	Tan	None	0	N/A	N/A
8020	1	B802001-1	G	H07	Circulation (Hallway)	Hallway outside Building Engineer's Office and Boiler Room	N	W4	Concrete	Tan	None	0	N/A	N/A
8020	1	B802001-1	G	9	Computer - Senior High	Classroom 9	Y	W1	Concrete	Peach & White	None	0	0	Negative
8020	1	B802001-1	G	9	Computer - Senior High	Classroom 9	Y	W2	Concrete	Peach & White	None	0	N/A	N/A
8020	1	B802001-1	G	9	Computer - Senior High	Classroom 9	Y	W3	Concrete	Peach & White	Cracking		0	Negative
8020	1	B802001-1	G	9	Computer - Senior High	Classroom 9	Y	W4	Concrete	Peach & White	None	0	N/A	N/A
8020	1	B802001-1	G	10	Senior High	Classroom 10	Y	W1	Concrete	Peach & White	None	0	N/A	N/A
8020	1	B802001-1	G	10	Senior High	Classroom 10	Y	W2	Concrete	Peach & White	None	0	N/A	N/A
8020	1	B802001-1	G	10	Senior High	Classroom 10	Y	W3	Concrete	Peach & White	None	0	N/A	N/A
8020	1	B802001-1	G	10	Senior High	Classroom 10	Y	W4	Concrete	Peach & White	None	0	N/A	N/A
8020	1	B802001-1	G	11	Senior High	Classroom 11	Y	W1	Concrete	Peach	None	0	0	Negative
8020	1	B802001-1	G	11	Senior High	Classroom 11	Y	W2	Concrete	Peach	None	0	0	Negative
8020	1	B802001-1	G	11	Senior High	Classroom 11	Y	W3	Concrete	Peach	None	0	0	Negative
8020	1	B802001-1	G	11	Senior High	Classroom 11	Y	W4	Concrete	Peach	None	0	0	Negative
8020	1	B802001-1	G	11	Senior High	Classroom 11	Y	Door Frame	Metal	White	Peeling	1	0.12	Negative
8020	1	B802001-1	G	H01B	Circulation (Hallway)	Hallway in Wing D adjacent to Loading Dock	Y	W1	Concrete	Blue & White	Chipping		0	Negative
8020	1	B802001-1	G	H01B	Circulation (Hallway)	Hallway in Wing D adjacent to Loading Dock	Y	W2	Concrete	Blue & White	Chipping		0	Negative
8020	1	B802001-1	G	H01B	Circulation (Hallway)	Hallway in Wing D adjacent to Loading Dock	Y	W3	Concrete	Blue & White	Chipping		0	Negative
8020	1	B802001-1	G	H01B	Circulation (Hallway)	Hallway in Wing D adjacent to Loading Dock	Y	W4	Concrete	Blue & White	Chipping		0	Negative
8020	1	B802001-1	G	12	Computer - Senior High	Classroom 12 Wing D	Y	W1	Concrete	Peach	Chipping		0	Negative
8020	1	B802001-1	G	12	Computer - Senior High	Classroom 12 Wing D	Y	W2	Concrete	Peach	Chipping		0	Negative
8020	1	B802001-1	G	12	Computer - Senior High	Classroom 12 Wing D	Y	W3	Concrete	Peach	Chipping		0	Negative
8020	1	B802001-1	G	12	Computer - Senior High	Classroom 12 Wing D	Y	W4	Concrete	Peach	Chipping		0	Negative
8020	1	B802001-1	G	13	Senior High	Classroom 13	Y	W1	Concrete	Beige	None	0	0	Negative
8020	1	B802001-1	G	13	Senior High	Classroom 13	Y	W2	Concrete	Beige	None	0	N/A	N/A
8020	1	B802001-1	G	13	Senior High	Classroom 13	Y	W3	Concrete	Beige/Dark Grey	None	0	0	Negative
8020	1	B802001-1	G	13	Senior High	Classroom 13	Y	W4	Concrete	Beige	None	0	N/A	N/A
8020	1	B802001-1	G	15	Computer - Senior High	Classroom 15	Y	W1	Concrete	Peach/White	Chipping		0	Negative
8020	1	B802001-1	G	15	Computer - Senior High	Classroom 15	Y	W2	Concrete	Peach	None	0	N/A	N/A
8020	1	B802001-1	G	15	Computer - Senior High	Classroom 15	Y	W3	Concrete	Peach	Chipping		0	Negative
8020	1	B802001-1	G	15	Computer - Senior High	Classroom 15	Y	W4	Concrete	Peach	None	0	N/A	N/A
8020	1	B802001-1	G	015A	Storage	Storage Room in Classroom 15	Y	W1	Concrete	Light blue/White	None	0	N/A	N/A
8020	1	B802001-1	G	015A	Storage	Storage Room in Classroom 15	Y	W2	Concrete	Light blue/White	Chipping		0	Negative
8020	1	B802001-1	G	015A	Storage	Storage Room in Classroom 15	Y	W3	Concrete	Light blue/White	None	0	N/A	N/A
8020	1	B802001-1	G	015A	Storage	Storage Room in Classroom 15	Y	W4	Concrete	Light blue/White	Chipping		0	Negative
8020	1	B802001-1	G	H02	Circulation (Hallway)	Hallway in Wing D between Loading Dock Hallway and Classroom 016	Y	W1	Concrete	Blue & White	Chipping		0	Negative
8020	1	B802001-1	G	H02	Circulation (Hallway)	Hallway in Wing D between Loading Dock Hallway and Classroom 016	Y	W2	Concrete	Blue & White	Chipping		0	Negative
8020	1	B802001-1	G	H02	Circulation (Hallway)	Hallway in Wing D between Loading Dock Hallway and Classroom 016	Y	W3	Concrete	Blue & White	Chipping		0	Negative
8020	1	B802001-1	G	H02	Circulation (Hallway)	Hallway in Wing D between Loading Dock Hallway and Classroom 016	Y	W4	Concrete	Blue & White	Chipping		0	Negative
8020	1	B802001-1	G	015B	Female (4-12)	Girl's Restroom across the Hallway from Classroom 16B	Y	W1	Concrete	Peach/White	Chipping		0	Negative
8020	1	B802001-1	G	015B	Female (4-12)	Girl's Restroom across the Hallway from Classroom 16B	Y	W2	Concrete	Peach/White	None	0	N/A	N/A
8020	1	B802001-1	G	015B	Female (4-12)	Girl's Restroom across the Hallway from Classroom 16B	Y	W3	Concrete	Peach/White	None	0	N/A	N/A
8020	1	B802001-1	G	015B	Female (4-12)	Girl's Restroom across the Hallway from Classroom 16B	Y	W4	Concrete	Peach/White	None	0	N/A	N/A
8020	1	B802001-1	G	021J	(4-12)	Boy's Restroom across the Hallway from Classroom 17C	Y	W1	Concrete	Peach & White	None	0	0.05	Negative
8020	1	B802001-1	G	021J	(4-12)	Boy's Restroom across the Hallway from Classroom 17C	Y	W2	Concrete	Peach & White	None	0	N/A	N/A
8020	1	B802001-1	G	021J	(4-12)	Boy's Restroom across the Hallway from Classroom 17C	Y	W3	Concrete	Peach & White	None	0	0	Negative
8020	1	B802001-1	G	021J	(4-12)	Boy's Restroom across the Hallway from Classroom 17C	Y	W4	Concrete	Peach & White	None	0	N/A	N/A
8020	1	B802001-1	G	018C	Senior High	Classroom 18C	Y	W1	Sheetrock	Peach & White	Cracking		0	Negative
8020	1	B802001-1	G	018C	Senior High	Classroom 18C	Y	W2	Sheetrock	Peach & White	Cracking		0	Negative
8020	1	B802001-1	G	018C	Senior High	Classroom 18C	Y	W3	Sheetrock	Peach & White	Cracking		0	Negative
8020	1	B802001-1	G	018C	Senior High	Classroom 18C	Y	W4	Sheetrock	Peach & White	Cracking		0	Negative
8020	1	B802001-1	G	019B	Senior High	Classroom 19B	Y	W1	Concrete	Peach & White	None	0	0	Negative
8020	1	B802001-1	G	019B	Senior High	Classroom 19B	Y	W2	Concrete	Peach & White	None	0	N/A	N/A
8020	1	B802001-1	G	019B	Senior High	Classroom 19B	Y	W3	Concrete	Peach & White	None	0	0	Negative
8020	1	B802001-1	G	019B	Senior High	Classroom 19B	Y	W4	Concrete	Peach & White	None	0	N/A	N/A
8020	1	B802001-1	G	017B	Senior High	Classroom 17B	Y	W1	Sheetrock	Peach & White	Chipping		0	Negative

ULCS#	Element	ID	Floor	Space #	Space Type	On-Site Room Name	Teacher	Component	Substrate Material	Color	Description of Damage	(sf)	(mg/cm2)	(positive/ negative)
8020	1	B802001-1	G	017B	Senior High	Classroom 17B	Y	W2	Sheetrock	Peach & White	Chipping		0	Negative
8020	1	B802001-1	G	017B	Senior High	Classroom 17B	Y	W3	Concrete	Peach & White	Chipping		0	Negative
8020	1	B802001-1	G	017B	Senior High	Classroom 17B	Y	W4	Concrete	Peach & White	Chipping		0	Negative
8020	1	B802001-1	G	8	Senior High	Classroom 8	Y	W1	Concrete	Peach & White	None	0	N/A	N/A
8020	1	B802001-1	G	8	Senior High	Classroom 8	Y	W2	Concrete	Peach & White	None	0	N/A	N/A
8020	1	B802001-1	G	8	Senior High	Classroom 8	Y	W3	Concrete	Peach & White	None	0	N/A	N/A
8020	1	B802001-1	G	8	Senior High	Classroom 8	Y	W4	Concrete	Peach & White	None	0	N/A	N/A
8020	1	B802001-1	G	7	Senior High	Classroom 7	Y	W1	Concrete	Peach & White	Chipping		0	Negative
8020	1	B802001-1	G	7	Senior High	Classroom 7	Y	W2	Concrete	Peach & White	None	0	N/A	N/A
8020	1	B802001-1	G	7	Senior High	Classroom 7	Y	W3	Concrete	Peach & White	None	0	0	Negative
8020	1	B802001-1	G	7	Senior High	Classroom 7	Y	W4	Concrete	Peach & White	None	0	N/A	N/A
8020	1	B802001-1	G	6	Senior High	Classroom 6	Y	W1	Concrete	Peach & White	None	0	N/A	N/A
8020	1	B802001-1	G	6	Senior High	Classroom 6	Y	W2	Concrete	Peach & White	None	0	N/A	N/A
8020	1	B802001-1	G	6	Senior High	Classroom 6	Y	W3	Concrete	Peach & White	None	0	N/A	N/A
8020	1	B802001-1	G	6	Senior High	Classroom 6	Y	W4	Concrete	Peach & White	None	0	N/A	N/A
8020	1	B802001-1	G	55	Female (4-12)	Girl's Restroom adjacent to Classroom 6	Y	W1	Concrete	Beige & White	None	0	N/A	N/A
8020	1	B802001-1	G	55	Female (4-12)	Girl's Restroom adjacent to Classroom 6	Y	W2	Concrete	Beige & White	None	0	N/A	N/A
8020	1	B802001-1	G	55	Female (4-12)	Girl's Restroom adjacent to Classroom 6	Y	W3	Concrete	Beige & White	Cracking		0.01	Negative
8020	1	B802001-1	G	55	Female (4-12)	Girl's Restroom adjacent to Classroom 6	Y	W4	Concrete	Beige & White	None	0	N/A	N/A
8020	1	B802001-1	G	H01M	Circulation (Hallway)	Hallway between Classroom 8 and Classroom 6	Y	W1	Concrete	Yellow & White	Cracking		0.06	Negative
8020	1	B802001-1	G	H01M	Circulation (Hallway)	Hallway between Classroom 8 and Classroom 6	Y	W2	Concrete	Yellow & White	Cracking		0	Negative
8020	1	B802001-1	G	H01M	Circulation (Hallway)	Hallway between Classroom 8 and Classroom 6	Y	W3	Concrete	Yellow & White	Cracking		0.03	Negative
8020	1	B802001-1	G	H01M	Circulation (Hallway)	Hallway between Classroom 8 and Classroom 6	Y	W4	Concrete	Yellow & White	Cracking		0	Negative
8020	1	B802001-1	G	5	Senior High	Classroom 5	Y	W1	Concrete	Peach & White	Chipping		0	Negative
8020	1	B802001-1	G	5	Senior High	Classroom 5	Y	W2	Concrete	Peach & White	None	0	N/A	N/A
8020	1	B802001-1	G	5	Senior High	Classroom 5	Y	W3	Concrete	Peach & White	Chipping		0	Negative
8020	1	B802001-1	G	5	Senior High	Classroom 5	Y	W4	Concrete	Peach & White	None	0	N/A	N/A
8020	1	B802001-1	G	4	Senior High	Classroom 4	Y	W1	Concrete	Peach & White	None	0	N/A	N/A
8020	1	B802001-1	G	4	Senior High	Classroom 4	Y	W2	Concrete	Peach & White	None	0	N/A	N/A
8020	1	B802001-1	G	4	Senior High	Classroom 4	Y	W3	Concrete	Peach & White	None	0	N/A	N/A
8020	1	B802001-1	G	4	Senior High	Classroom 4	Y	W4	Concrete	Peach & White	None	0	N/A	N/A
8020	1	B802001-1	G	3	Senior High	Classroom 3	Y	W1	Concrete	Peach & White	None	0	0	Negative
8020	1	B802001-1	G	3	Senior High	Classroom 3	Y	W2	Concrete	Peach & White	None	0	N/A	N/A
8020	1	B802001-1	G	3	Senior High	Classroom 3	Y	W3	Concrete	Peach & White	Cracking		0	Negative
8020	1	B802001-1	G	3	Senior High	Classroom 3	Y	W4	Concrete	Peach & White	None	0	0	Negative
8020	1	B802001-1	G	2	Senior High	Classroom 2	Y	W1	Concrete	Peach & White	None	0	0	Negative
8020	1	B802001-1	G	2	Senior High	Classroom 2	Y	W2	Concrete	Peach & White	None	0	N/A	N/A
8020	1	B802001-1	G	2	Senior High	Classroom 2	Y	W3	Concrete	Peach & White	None	0	0	Negative
8020	1	B802001-1	G	2	Senior High	Classroom 2	Y	W4	Sheetrock	Peach & White	None	0	0	Negative
8020	1	B802001-1	G	1	Senior High	Classroom 1	Y	W1	Concrete	Peach & White	None	0	N/A	N/A
8020	1	B802001-1	G	1	Senior High	Classroom 1	Y	W2	Concrete	Peach & White	None	0	N/A	N/A
8020	1	B802001-1	G	1	Senior High	Classroom 1	Y	W3	Concrete	Peach & White	None	0	N/A	N/A
8020	1	B802001-1	G	1	Senior High	Classroom 1	Y	W4	Concrete	Peach & White	None	0	N/A	N/A
8020	1	B802001-1	G	H01M	Circulation (Hallway)	Hallway between Classroom 8 and Classroom 6	Y	Door Frame	Metal	Yellow	Peeling	1	0.04	Negative
8020	1	B802001-1	G	H01N	Circulation (Hallway)	Hallway between Classroom 1 and Classroom 5	Y	W1	Concrete	Yellow & White	Cracking		0.01	Negative
8020	1	B802001-1	G	H01N	Circulation (Hallway)	Hallway between Classroom 1 and Classroom 5	Y	W2	Concrete	Yellow & White	Cracking		0.03	Negative
8020	1	B802001-1	G	H01N	Circulation (Hallway)	Hallway between Classroom 1 and Classroom 5	Y	W3	Concrete	Yellow & White	Cracking		0.03	Negative
8020	1	B802001-1	G	H01N	Circulation (Hallway)	Hallway between Classroom 1 and Classroom 5	Y	W4	Concrete	Yellow & White	Cracking		0	Negative
8020	1	B802001-1	G	25	Senior High	Office 25	Y	W1	Concrete	Peach/White	Cracking		0	Negative
8020	1	B802001-1	G	25	Senior High	Office 25	Y	W2	Concrete	Peach/White	None	0	N/A	N/A
8020	1	B802001-1	G	25	Senior High	Office 25	Y	W3	Concrete	Peach/White	None	0	0	Negative
8020	1	B802001-1	G	25	Senior High	Office 25	Y	W4	Concrete	Peach/White	None	0	N/A	N/A
8020	1	B802001-1	G	24	Senior High	Classroom 24	Y	W1	Concrete	Peach & White	None	0	0	Negative
8020	1	B802001-1	G	24	Senior High	Classroom 24	Y	W2	Concrete	Peach & White	None	0	N/A	N/A
8020	1	B802001-1	G	24	Senior High	Classroom 24	Y	W3	Concrete	Peach & White	None	0	0	Negative
8020	1	B802001-1	G	24	Senior High	Classroom 24	Y	W4	Concrete	Peach & White	None	0	N/A	N/A
8020	1	B802001-1	G	23	Senior High	Classroom 23	Y	W1	Concrete	Peach/White	None	0	0	Negative
8020	1	B802001-1	G	23	Senior High	Classroom 23	Y	W2	Concrete	Peach/White	None	0	N/A	N/A
8020	1	B802001-1	G	23	Senior High	Classroom 23	Y	W3	Concrete	Peach/White	Alligating		0	Negative
8020	1	B802001-1	G	23	Senior High	Classroom 23	Y	W4	Concrete	Peach/White	None	0	N/A	N/A
8020	1	B802001-1	G	23A	(4-12)	Boy's Restroom adjacent to Cafeteria	Y	W1	Concrete	Yellow	Cracking		0	Negative
8020	1	B802001-1	G	23A	(4-12)	Boy's Restroom adjacent to Cafeteria	Y	W1	Concrete	White	Cracking		0.07	Negative
8020	1	B802001-1	G	H02A	Circulation (Hallway)	Hallway between Stairwell M and Office 25	Y	W1	Concrete	Yellow	Cracking		0.09	Negative
8020	1	B802001-1	G	H02A	Circulation (Hallway)	Hallway between Stairwell M and Office 25	Y	W2	Concrete	Yellow	Cracking		0	Negative
8020	1	B802001-1	G	H02A	Circulation (Hallway)	Hallway between Stairwell M and Office 25	Y	W2	Concrete	White	Cracking		0.03	Negative
8020	1	B802001-1	G	H02A	Circulation (Hallway)	Hallway between Stairwell M and Office 25	Y	W3	Concrete	White	None	0	N/A	N/A
8020	1	B802001-1	G	H02A	Circulation (Hallway)	Hallway between Stairwell M and Office 25	Y	W4	Concrete	Yellow	Cracking		0	Negative
8020	1	B802001-1	G	H02A	Circulation (Hallway)	Hallway between Stairwell M and Office 25	Y	W4	Concrete	White	Cracking		0.01	Negative
8020	1	B802001-1	G	44	Cafeteria (Dining Area)	Cafeteria	Y	W1	Ceramic Tile	Gray	Cracking	1	>1	Positive
8020	1	B802001-1	G	44	Cafeteria (Dining Area)	Cafeteria	Y	W2	Concrete	Blue	Cracking		0	Negative
8020	1	B802001-1	G	44	Cafeteria (Dining Area)	Cafeteria	Y	W4	Concrete	Blue	Cracking		0	Negative
8020	1	B802001-1	G	44	Cafeteria (Dining Area)	Cafeteria	Y	Column	Concrete	Orange	Chipping		0	Negative

ULCS#	Element	ID	Floor	Space #	Space Type	On-Site Room Name	Teacher	Component	Substrate Material	Color	Description of Damage	(sf)	(mg/cm2)	(positive/ negative)
8020	1	B802001-1	G	020C	(4-12)	Boy's Restroom at Appreciate Ave and J Stairwell	Y	W1	Concrete	Yellow/White	Cracking		0	Negative
8020	1	B802001-1	G	020C	(4-12)	Boy's Restroom at Appreciate Ave and J Stairwell	Y	W2	Concrete	Yellow/White	None	0	N/A	N/A
8020	1	B802001-1	G	020C	(4-12)	Boy's Restroom at Appreciate Ave and J Stairwell	Y	W3	Concrete	Yellow/White	None	0	0	Negative
8020	1	B802001-1	G	020C	(4-12)	Boy's Restroom at Appreciate Ave and J Stairwell	Y	W4	Concrete	Yellow/White	None	0	N/A	N/A
8020	1	B802001-1	G	H01	Circulation (Hallway)	Hallway between Room 21C and Cafeteria	Y	W1	Concrete	Yellow/White	Cracking		0	Negative
8020	1	B802001-1	G	H01	Circulation (Hallway)	Hallway between Room 21C and Cafeteria	Y	W2	Concrete	Yellow/White	Cracking		0	Negative
8020	1	B802001-1	G	H01	Circulation (Hallway)	Hallway between Room 21C and Cafeteria	Y	W3	Concrete	Yellow/White	Cracking		0.01	Negative
8020	1	B802001-1	G	H01	Circulation (Hallway)	Hallway between Room 21C and Cafeteria	Y	W4	Concrete	Yellow	Cracking		0.01	Negative
8020	1	B802001-1	G	H01	Circulation (Hallway)	Hallway between Room 21C and Cafeteria	Y	W4	Concrete	White	Cracking		0	Negative
8020	1	B802001-1	G	22	Female (4-12)	Girl's Restroom adjacent to Cafeteria Kitchen	Y	W1	Concrete	White	Chipping		0	Negative
8020	1	B802001-2	G	33	Senior High	Classroom 33	Y	W1	Concrete	Peach	Chipping		0	Negative
8020	1	B802001-2	G	33	Senior High	Classroom 33	Y	W2	Sheetrock	Peach	Chipping		0	Negative
8020	1	B802001-2	G	33	Senior High	Classroom 33	Y	W3	Concrete	Peach	Chipping		0	Negative
8020	1	B802001-2	G	33	Senior High	Classroom 33	Y	W4	Concrete	Peach	None	0	N/A	N/A
8020	1	B802001-2	G	35	Administrative Office	Office 35	Y	W1	Concrete	Peach	Chipping		0	Negative
8020	1	B802001-2	G	35	Administrative Office	Office 35	Y	W2	Concrete	Peach	None	0	N/A	N/A
8020	1	B802001-2	G	35	Administrative Office	Office 35	Y	W3	Concrete	Peach	Chipping		0	Negative
8020	1	B802001-2	G	35	Administrative Office	Office 35	Y	W4	Concrete	Peach	None	0	N/A	N/A
8020	1	B802001-2	G	34	Senior High	Classroom 34	Y	W1	Concrete	Peach & White	None	0	0	Negative
8020	1	B802001-2	G	34	Senior High	Classroom 34	Y	W2	Sheetrock	Peach & White	None	0	0	Negative
8020	1	B802001-2	G	34	Senior High	Classroom 34	Y	W3	Concrete	Peach & White	None	0	0	Negative
8020	1	B802001-2	G	34	Senior High	Classroom 34	Y	W4	Sheetrock	Peach & White	None	0	0	Negative
8020	1	B802001-1	1	162	Senior High	Classroom 162	Y	W1	Concrete	Tan	None	0	N/A	N/A
8020	1	B802001-1	1	162	Senior High	Classroom 162	Y	W2	Concrete	Tan	None	0	N/A	N/A
8020	1	B802001-1	1	162	Senior High	Classroom 162	Y	W3	Concrete	Tan	None	0	N/A	N/A
8020	1	B802001-1	1	162	Senior High	Classroom 162	Y	W4	Concrete	Tan	None	0	N/A	N/A
8020	1	B802001-1	1	109	Senior High -- Science Lab	Classroom 109	Y	W1	Concrete	Peach	None	0	0	Negative
8020	1	B802001-1	1	109	Senior High -- Science Lab	Classroom 109	Y	W2	Concrete	Peach	None	0	N/A	N/A
8020	1	B802001-1	1	109	Senior High -- Science Lab	Classroom 109	Y	W3	Concrete	Peach	Chipping		0	Negative
8020	1	B802001-1	1	109	Senior High -- Science Lab	Classroom 109	Y	W4	Concrete	Peach	None	0	N/A	N/A
8020	1	B802001-1	1	111	Senior High -- Science Lab	Classroom 111	Y	W1	Concrete	Peach	None	0	0	Negative
8020	1	B802001-1	1	111	Senior High -- Science Lab	Classroom 111	Y	W2	Concrete	Peach	None	0	N/A	N/A
8020	1	B802001-1	1	111	Senior High -- Science Lab	Classroom 111	Y	W3	Concrete	Peach	Chipping		0	Negative
8020	1	B802001-1	1	111	Senior High -- Science Lab	Classroom 111	Y	W4	Concrete	Peach	None	0	N/A	N/A
8020	1	B802001-1	1	H17	Circulation (Hallway)	Hallway between Classroom 109 and Classroom 111	Y	W1	Concrete	Beige & White	Chipping		0	Negative
8020	1	B802001-1	1	H17	Circulation (Hallway)	Hallway between Classroom 109 and Classroom 111	Y	W2	Concrete	Beige & White	Chipping		0.03	Negative
8020	1	B802001-1	1	H17	Circulation (Hallway)	Hallway between Classroom 109 and Classroom 111	Y	W3	Concrete	Beige & White	Chipping		0	Negative
8020	1	B802001-1	1	H17	Circulation (Hallway)	Hallway between Classroom 109 and Classroom 111	Y	W4	Concrete	Beige & White	Chipping	10	1	Positive
8020	1	B802001-1	1	107	Mail Room	Room 107 Mail Room	Y	W1	Concrete	Beige & White	None	0	N/A	N/A
8020	1	B802001-1	1	107	Mail Room	Room 107 Mail Room	Y	W2	Concrete	Beige & White	None	0	N/A	N/A
8020	1	B802001-1	1	107	Mail Room	Room 107 Mail Room	Y	W3	Concrete	Beige & White	None	0	N/A	N/A
8020	1	B802001-1	1	107	Mail Room	Room 107 Mail Room	Y	W4	Concrete	Beige & White	None	0	N/A	N/A
8020	1	B802001-1	1	105	Administrative Office	Room 105	Y	W1	No Access	No Access	No Access	No Access	No Access	No Access
8020	1	B802001-1	1	105	Administrative Office	Room 105	Y	W2	No Access	No Access	No Access	No Access	No Access	No Access
8020	1	B802001-1	1	105	Administrative Office	Room 105	Y	W3	No Access	No Access	No Access	No Access	No Access	No Access
8020	1	B802001-1	1	105	Administrative Office	Room 105	Y	W4	No Access	No Access	No Access	No Access	No Access	No Access
8020	1	B802001-1	1	101	Reception Area	Main Office Open Area	Y	W1	Concrete	Peach & White	None	0	0	Negative
8020	1	B802001-1	1	101	Reception Area	Main Office Open Area	Y	W2	Concrete	Peach & White	None	0	0	Negative
8020	1	B802001-1	1	101	Reception Area	Main Office Open Area	Y	W3	Concrete	Peach & White	None	0	0	Negative
8020	1	B802001-1	1	101	Reception Area	Main Office Open Area	Y	W4	Concrete	Peach & White	None	0	0	Negative
8020	1	B802001-1	1	H13A	Circulation (Hallway)	Hallway between Main Office and Counselor's 103 Suites	Y	W1	Concrete	Beige & White	Chipping	10	1.07	Positive
8020	1	B802001-1	1	H13A	Circulation (Hallway)	Hallway between Main Office and Counselor's 103 Suites	Y	W2	Concrete	Beige & White	Chipping	10	1	Positive
8020	1	B802001-1	1	H13A	Circulation (Hallway)	Hallway between Main Office and Counselor's 103 Suites	Y	W3	Concrete	Beige & White	Chipping	10	1.25	Positive
8020	1	B802001-1	1	H13A	Circulation (Hallway)	Hallway between Main Office and Counselor's 103 Suites	Y	W4	Concrete	Beige & White	Chipping	10	1	Positive
8020	1	B802001-1	1	100	Administrative Office	School Services Room 100	Y	W1	Concrete	Blue	None	0	0	Negative
8020	1	B802001-1	1	100	Administrative Office	School Services Room 100	Y	W2	Sheetrock	Blue	None	0	N/A	N/A
8020	1	B802001-1	1	100	Administrative Office	School Services Room 100	Y	W3	Sheetrock	Blue	None	0	N/A	N/A
8020	1	B802001-1	1	100	Administrative Office	School Services Room 100	Y	W4	Concrete	Blue	None	0	0	Negative
8020	1	B802001-1	1	102	Administrative Office	Room 102 Roster Office	Y	W1	Concrete	Peach & White	None	0	0	Negative
8020	1	B802001-1	1	102	Administrative Office	Room 102 Roster Office	Y	W2	Concrete	Peach & White	None	0	N/A	N/A
8020	1	B802001-1	1	102	Administrative Office	Room 102 Roster Office	Y	W3	Concrete	Peach & White	None	0	0	None
8020	1	B802001-1	1	102	Administrative Office	Room 102 Roster Office	Y	W4	Concrete	Peach & White	None	0	N/A	N/A
8020	1	B802001-1	1	104	Administrative Office	College and Career Room 104	Y	W1	Concrete	Peach	None	0	0	Negative
8020	1	B802001-1	1	104	Administrative Office	College and Career Room 104	Y	W2	Concrete	Peach	None	0	N/A	N/A
8020	1	B802001-1	1	104	Administrative Office	College and Career Room 104	Y	W3	Concrete	Peach	None	0	0	Negative
8020	1	B802001-1	1	104	Administrative Office	College and Career Room 104	Y	W4	Concrete	Peach	None	0	N/A	N/A
8020	1	B802001-1	1	108	Senior High -- Science Lab	Classroom 108	Y	W1	Concrete	Peach & White	Chipping		0	Negative
8020	1	B802001-1	1	108	Senior High -- Science Lab	Classroom 108	Y	W2	Concrete	Peach & White	None	0	N/A	N/A
8020	1	B802001-1	1	108	Senior High -- Science Lab	Classroom 108	Y	W3	Concrete	Peach & White	Chipping		0	Negative
8020	1	B802001-1	1	108	Senior High -- Science Lab	Classroom 108	Y	W4	Concrete	Peach & White	None	0	N/A	N/A
8020	1	B802001-1	1	112	Senior High -- Science Lab	Classroom 112	Y	W1	Concrete	Peach & White	None	0	N/A	N/A
8020	1	B802001-1	1	112	Senior High -- Science Lab	Classroom 112	Y	W2	Concrete	Peach & White	None	0	N/A	N/A

ULCS#	Element	ID	Floor	Space #	Space Type	On-Site Room Name	Teacher	Component	Substrate Material	Color	Description of Damage	(sf)	(mg/cm2)	(positive/ negative)
8020	1	B802001-1	1	112	Senior High -- Science Lab	Classroom 112	Y	W3	Concrete	Peach & White	None	0	N/A	N/A
8020	1	B802001-1	1	112	Senior High -- Science Lab	Classroom 112	Y	W4	Concrete	Peach & White	None	0	N/A	N/A
8020	1	B802001-1	1	106	Senior High -- Science Lab	Classroom 106	Y	W1	Concrete	Peach & White	Chipping		0	Negative
8020	1	B802001-1	1	106	Senior High -- Science Lab	Classroom 106	Y	W2	Concrete	Peach & White	None	0	N/A	N/A
8020	1	B802001-1	1	106	Senior High -- Science Lab	Classroom 106	Y	W3	Concrete	Peach & White	Chipping		0	Negative
8020	1	B802001-1	1	106	Senior High -- Science Lab	Classroom 106	Y	W4	Concrete	Peach & White	None	0	N/A	N/A
8020	1	B802001-1	1	110	Senior High -- Science Lab	Classroom 110	Y	W1	Concrete	Peach & White	Chipping		0	Negative
8020	1	B802001-1	1	110	Senior High -- Science Lab	Classroom 110	Y	W2	Concrete	Peach & White	None	0	N/A	N/A
8020	1	B802001-1	1	110	Senior High -- Science Lab	Classroom 110	Y	W3	Concrete	Peach & White	Chipping		0	Negative
8020	1	B802001-1	1	110	Senior High -- Science Lab	Classroom 110	Y	W4	Concrete	Peach & White	None	0	N/A	N/A
8020	1	B802001-1	1	114	Senior High -- Science Lab	Classroom 114	Y	W1	Concrete	Peach & White	None	0	N/A	N/A
8020	1	B802001-1	1	114	Senior High -- Science Lab	Classroom 114	Y	W2	Concrete	Peach & White	None	0	N/A	N/A
8020	1	B802001-1	1	114	Senior High -- Science Lab	Classroom 114	Y	W3	Concrete	Peach & White	None	0	N/A	N/A
8020	1	B802001-1	1	114	Senior High -- Science Lab	Classroom 114	Y	W4	Concrete	Peach & White	None	0	N/A	N/A
8020	1	B802001-1	1	116	Senior High -- Science Lab	Classroom 116	Y	W1	Concrete	Peach & White	None	0	N/A	N/A
8020	1	B802001-1	1	116	Senior High -- Science Lab	Classroom 116	Y	W2	Concrete	Peach & White	None	0	N/A	N/A
8020	1	B802001-1	1	116	Senior High -- Science Lab	Classroom 116	Y	W3	Concrete	Peach & White	None	0	N/A	N/A
8020	1	B802001-1	1	116	Senior High -- Science Lab	Classroom 116	Y	W4	Concrete	Peach & White	None	0	N/A	N/A
8020	1	B802001-1	1	118	Senior High -- Science Lab	Classroom 118	Y	W1	Concrete	Peach & White	None	0	N/A	N/A
8020	1	B802001-1	1	118	Senior High -- Science Lab	Classroom 118	Y	W2	Concrete	Peach & White	None	0	N/A	N/A
8020	1	B802001-1	1	118	Senior High -- Science Lab	Classroom 118	Y	W3	Concrete	Peach & White	None	0	N/A	N/A
8020	1	B802001-1	1	118	Senior High -- Science Lab	Classroom 118	Y	W4	Concrete	Peach & White	None	0	N/A	N/A
8020	1	B802001-1	1	120A	Administrative Office	Room 120A	Y	W1	Concrete	Peach & White	None	0	N/A	N/A
8020	1	B802001-1	1	120A	Administrative Office	Room 120A	Y	W2	Concrete	Peach & White	None	0	N/A	N/A
8020	1	B802001-1	1	120A	Administrative Office	Room 120A	Y	W3	Concrete	Peach & White	None	0	N/A	N/A
8020	1	B802001-1	1	120A	Administrative Office	Room 120A	Y	W4	Concrete	Peach & White	None	0	N/A	N/A
8020	1	B802001-1	1	120	Senior High	Classroom 120	Y	W1	Concrete	Peach & White	None	0	N/A	N/A
8020	1	B802001-1	1	120	Senior High	Classroom 120	Y	W2	Concrete	Peach & White	None	0	N/A	N/A
8020	1	B802001-1	1	120	Senior High	Classroom 120	Y	W3	Concrete	Peach & White	None	0	N/A	N/A
8020	1	B802001-1	1	120	Senior High	Classroom 120	Y	W4	Concrete	Peach & White	None	0	N/A	N/A
8020	1	B802001-1	1	122	Art - Senior High	Classroom 122	Y	W1	Concrete	Peach & White	None	0	0	Negative
8020	1	B802001-1	1	122	Art - Senior High	Classroom 122	Y	W2	Concrete	Peach & White	None	0	0	Negative
8020	1	B802001-1	1	122	Art - Senior High	Classroom 122	Y	W2	Concrete	None (Paint Scales)	None	0	1	Positive
8020	1	B802001-1	1	122	Art - Senior High	Classroom 122	Y	W3	Concrete	Peach & White	None	0	0	Negative
8020	1	B802001-1	1	122	Art - Senior High	Classroom 122	Y	W4	Concrete	Peach & White	None	0	0	Negative
8020	1	B802001-1	1	134	Conference Room	SLC Coordinator Room	Y	W1	Concrete	Blue	None	0	0	Negative
8020	1	B802001-1	1	134	Conference Room	SLC Coordinator Room	Y	W2	Concrete	Blue	None	0	N/A	N/A
8020	1	B802001-1	1	134	Conference Room	SLC Coordinator Room	Y	W3	Concrete	Blue	None	0	0	Negative
8020	1	B802001-1	1	134	Conference Room	SLC Coordinator Room	Y	W4	Concrete	Blue	None	0	N/A	N/A
8020	1	B802001-1	1	140	Senior High	Classroom 140	Y	W1	Concrete	Peach	None	0	0	Negative
8020	1	B802001-1	1	140	Senior High	Classroom 140	Y	W2	Concrete	Peach	None	0	N/A	N/A
8020	1	B802001-1	1	140	Senior High	Classroom 140	Y	W3	Concrete	Peach	Chipping		0	Negative
8020	1	B802001-1	1	140	Senior High	Classroom 140	Y	W4	Concrete	Peach	None	0	N/A	N/A
8020	1	B802001-1	1	132	Senior High	Classroom 132	Y	W1	Concrete	Blue	None	0	0	Negative
8020	1	B802001-1	1	132	Senior High	Classroom 132	Y	W2	Concrete	Blue	None	0	N/A	N/A
8020	1	B802001-1	1	132	Senior High	Classroom 132	Y	W3	Concrete	Blue	None	0	0	Negative
8020	1	B802001-1	1	132	Senior High	Classroom 132	Y	W4	Concrete	Blue	None	0	N/A	N/A
8020	1	B802001-1	1	126	Senior High	Classroom 126	Y	W1	Concrete	Peach	Efflorescence		0	Negative
8020	1	B802001-1	1	126	Senior High	Classroom 126	Y	W2	Concrete	Peach	None	0	N/A	N/A
8020	1	B802001-1	1	126	Senior High	Classroom 126	Y	W3	Concrete	Peach	None	0	0	Negative
8020	1	B802001-1	1	126	Senior High	Classroom 126	Y	W4	Concrete	Peach	None	0	N/A	N/A
8020	1	B802001-1	1	124	Art - Senior High	Classroom 124	Y	W1	Concrete	Peach & White	None	0	N/A	N/A
8020	1	B802001-1	1	124	Art - Senior High	Classroom 124	Y	W2	Concrete	Peach & White	None	0	N/A	N/A
8020	1	B802001-1	1	124	Art - Senior High	Classroom 124	Y	W3	Concrete	Peach & White	None	0	N/A	N/A
8020	1	B802001-1	1	124	Art - Senior High	Classroom 124	Y	W4	Concrete	Peach & White	None	0	N/A	N/A
8020	1	B802001-3	1	150	Senior High	Classroom 150	Y	W1	Concrete	Peach	Chipping		0.01	Negative
8020	1	B802001-3	1	150	Senior High	Classroom 150	Y	W2	Concrete	Peach	None	0	N/A	N/A
8020	1	B802001-3	1	150	Senior High	Classroom 150	Y	W3	Concrete	Peach	Ijjsvwgirgi		0.02	Negative
8020	1	B802001-3	1	150	Senior High	Classroom 150	Y	W4	Concrete	Peach	None	0	N/A	N/A
8020	1	B802001-3	1	152A	Senior High	Classroom 152A	Y	W1	Concrete	Peach	None	0	0	Negative
8020	1	B802001-3	1	152A	Senior High	Classroom 152A	Y	W2	Concrete	Peach	None	0	N/A	N/A
8020	1	B802001-3	1	152A	Senior High	Classroom 152A	Y	W3	Concrete	Peach	None	0	0	Negative
8020	1	B802001-3	1	152A	Senior High	Classroom 152A	Y	W4	Concrete	Peach	None	0	N/A	N/A
8020	1	B802001-3	1	154	Senior High	Classroom 154	Y	W1	Concrete	Peach	Chipping		0	Negative
8020	1	B802001-3	1	154	Senior High	Classroom 154	Y	W2	Concrete	Peach	None	0	N/A	N/A
8020	1	B802001-3	1	154	Senior High	Classroom 154	Y	W3	Concrete	Peach	Ijjsvwgirgi		0.02	Negative
8020	1	B802001-3	1	154	Senior High	Classroom 154	Y	W4	Concrete	Peach	None	0	N/A	N/A
8020	1	B802001-3	1	156	Senior High	Classroom 156	Y	W1	Concrete	Peach	None	0	0	Negative
8020	1	B802001-3	1	156	Senior High	Classroom 156	Y	W2	Concrete	Peach	None	0	N/A	N/A
8020	1	B802001-3	1	156	Senior High	Classroom 156	Y	W3	Concrete	Peach	None	0	0.02	Negative
8020	1	B802001-3	1	156	Senior High	Classroom 156	Y	W4	Concrete	Peach	None	0	N/A	N/A
8020	1	B802001-3	1	158	Senior High	Classroom 158	Y	W1	Concrete	Blue	None	0	0	Negative

ULCS#	Element	ID	Floor	Space #	Space Type	On-Site Room Name	Teacher	Component	Substrate Material	Color	Description of Damage	(sf)	(mg/cm2)	(positive/ negative)
8020	1	B802001-3	1	158	Senior High	Classroom 158	Y	W2	Concrete	Blue	None	0	N/A	N/A
8020	1	B802001-3	1	158	Senior High	Classroom 158	Y	W3	Concrete	Blue	Ijjsvwiwgi rgi		0.01	Negative
8020	1	B802001-3	1	158	Senior High	Classroom 158	Y	W4	Concrete	Blue		0	N/A	N/A
8020	1	B802001-3	1	160	Senior High	Classroom 160	Y	W1	Concrete	Blue	None	0	0	Negative
8020	1	B802001-3	1	160	Senior High	Classroom 160	Y	W2	Concrete	Blue	None	0	N/A	N/A
8020	1	B802001-3	1	160	Senior High	Classroom 160	Y	W3	Concrete	Blue	Ijjsvwiwgi rgi		0.1	Negative
8020	1	B802001-3	1	160	Senior High	Classroom 160	Y	W4	Concrete	Blue			0	Negative
8020	1	B802001-1	1	H12J	Circulation (Hallway)	Hallway between Classroom 160 and Classroom 152A	Y	W1	Concrete	Blue	None	0	0	Negative
8020	1	B802001-1	1	H12J	Circulation (Hallway)	Hallway between Classroom 160 and Classroom 152A	Y	W2	Concrete	Blue	None	0	0	Negative
8020	1	B802001-1	1	H12J	Circulation (Hallway)	Hallway between Classroom 160 and Classroom 152A	Y	W3	Concrete	Blue	None	0	0	Negative
8020	1	B802001-1	1	H12J	Circulation (Hallway)	Hallway between Classroom 160 and Classroom 152A	Y	W4	Concrete	Blue	None	0	0	Negative
8020	1	B802001-1	1	H19	Circulation (Hallway)	Hallway between Classroom 108 and Classroom 118	Y	W1	Concrete	Beige & White	Chipping		0.01	Negative
8020	1	B802001-1	1	H19	Circulation (Hallway)	Hallway between Classroom 108 and Classroom 118	Y	W2	Concrete	Beige & White	Chipping		0	Negative
8020	1	B802001-1	1	H19	Circulation (Hallway)	Hallway between Classroom 108 and Classroom 118	Y	W3	Concrete	Beige & White	Chipping		0	Negative
8020	1	B802001-1	1	H19	Circulation (Hallway)	Hallway between Classroom 108 and Classroom 118	Y	W4	Concrete	Beige & White	Chipping		0	Negative
8020	1	B802001-1	1	H19A	Circulation (Hallway)	Hallway between Classroom 120 and Room 120A	Y	W1	Concrete	Beige & White	Chipping		0	Negative
8020	1	B802001-1	1	H19A	Circulation (Hallway)	Hallway between Classroom 120 and Room 120A	Y	W2	Concrete	Beige & White	Chipping		0.1	Negative
8020	1	B802001-1	1	H19A	Circulation (Hallway)	Hallway between Classroom 120 and Room 120A	Y	W3	Concrete	Beige & White	Chipping		0	Negative
8020	1	B802001-1	1	H19A	Circulation (Hallway)	Hallway between Classroom 120 and Room 120A	Y	W4	Concrete	Beige & White	Chipping		0	Negative
8020	1	B802001-1	1	H11	Circulation (Hallway)	Hallway between Classroom 138 and Classroom 130	Y	W1	Concrete	Purple/Blue	Chipping		0.02	Negative
8020	1	B802001-1	1	H11	Circulation (Hallway)	Hallway between Classroom 138 and Classroom 130	Y	W2	Concrete	Purple/Blue	Chipping		0	Negative
8020	1	B802001-1	1	H11	Circulation (Hallway)	Hallway between Classroom 138 and Classroom 130	Y	W3	Concrete	Purple/Blue	Chipping		0.01	Negative
8020	1	B802001-1	1	H11	Circulation (Hallway)	Hallway between Classroom 138 and Classroom 130	Y	W4	Concrete	Purple/Blue	Chipping		0	Negative
8020	1	B802001-1	1	H11A	Circulation (Hallway)	Hallway between Classroom 126 and Room 126A	Y	W1	Concrete	Purple/Blue	Chipping		0.01	Negative
8020	1	B802001-1	1	H11A	Circulation (Hallway)	Hallway between Classroom 126 and Room 126A	Y	W2	Concrete	Purple/Blue	Chipping		0	Negative
8020	1	B802001-1	1	H11A	Circulation (Hallway)	Hallway between Classroom 126 and Room 126A	Y	W3	Concrete	Purple/Blue	Chipping		0	Negative
8020	1	B802001-1	1	H11A	Circulation (Hallway)	Hallway between Classroom 126 and Room 126A	Y	W4	Concrete	Purple/Blue	Chipping		0.02	Negative
8020	1	B802001-1	1	113	Senior High	Classroom 113	Y	W1	Concrete	Peach	None	0	0	Negative
8020	1	B802001-1	1	113	Senior High	Classroom 113	Y	W2	Concrete	Peach	None	0	N/A	N/A
8020	1	B802001-1	1	113	Senior High	Classroom 113	Y	W3	Concrete	Peach	Chipping		0	Negative
8020	1	B802001-1	1	113	Senior High	Classroom 113	Y	W4	Concrete	Peach	None	0	N/A	N/A
8020	1	B802001-1	1	115	Senior High	Classroom 115	Y	W1	Concrete	Peach	None	0	0	Negative
8020	1	B802001-1	1	115	Senior High	Classroom 115	Y	W2	Concrete	Peach	None	0	N/A	N/A
8020	1	B802001-1	1	115	Senior High	Classroom 115	Y	W3	Concrete	Peach	Chipping		0	Negative
8020	1	B802001-1	1	115	Senior High	Classroom 115	Y	W4	Concrete	Peach	None	0	N/A	N/A
8020	1	B802001-1	1	H14C	Circulation (Hallway)	Hallway from Classroom 115 to Stairwell Q	Y	W1	Concrete	Beige & White	Chipping		0	Negative
8020	1	B802001-1	1	H14C	Circulation (Hallway)	Hallway from Classroom 115 to Stairwell Q	Y	W2	Concrete	Beige & White	Chipping		0.03	Negative
8020	1	B802001-1	1	H14C	Circulation (Hallway)	Hallway from Classroom 115 to Stairwell Q	Y	W3	Concrete	Beige & White	Chipping		0	Negative
8020	1	B802001-1	1	H14C	Circulation (Hallway)	Hallway from Classroom 115 to Stairwell Q	Y	W4	Concrete	Beige & White	Chipping	10	1	Positive
8020	1	B802001-1	1	H14	Circulation (Hallway)	Hallway from Classroom 117 to Classroom 131	Y	W1	Concrete	Blue	Cracking		0.03	Negative
8020	1	B802001-1	1	H14	Circulation (Hallway)	Hallway from Classroom 117 to Classroom 131	Y	W2	Concrete	Blue	Cracking		0.01	Negative
8020	1	B802001-1	1	H14	Circulation (Hallway)	Hallway from Classroom 117 to Classroom 131	Y	W3	Concrete	Blue	Cracking		0.02	Negative
8020	1	B802001-1	1	H14	Circulation (Hallway)	Hallway from Classroom 117 to Classroom 131	Y	W4	Concrete	Blue	Cracking		0	Negative
8020	1	B802001-1	1	117	Senior High	Classroom 117	Y	W1	Concrete	Peach	None	0	0	Negative
8020	1	B802001-1	1	117	Senior High	Classroom 117	Y	W2	Concrete	Peach	None	0	N/A	N/A
8020	1	B802001-1	1	117	Senior High	Classroom 117	Y	W3	Concrete	Peach	Cracking		0	Negative
8020	1	B802001-1	1	117	Senior High	Classroom 117	Y	W4	Concrete	Peach	None	0	N/A	N/A
8020	1	B802001-1	1	119	Senior High	Classroom 119	Y	W1	Concrete	Peach	None	0	0	Negative
8020	1	B802001-1	1	119	Senior High	Classroom 119	Y	W2	Concrete	Peach	None	0	N/A	N/A
8020	1	B802001-1	1	119	Senior High	Classroom 119	Y	W3	Concrete	Peach	Chipping		0	Negative
8020	1	B802001-1	1	119	Senior High	Classroom 119	Y	W4	Concrete	Peach	None	0	N/A	N/A
8020	1	B802001-1	1	121	Senior High	Classroom 121	Y	W1	Concrete	Peach	None	0	N/A	N/A
8020	1	B802001-1	1	121	Senior High	Classroom 121	Y	W2	Concrete	Peach	None	0	N/A	N/A
8020	1	B802001-1	1	121	Senior High	Classroom 121	Y	W3	Concrete	Peach	None	0	N/A	N/A
8020	1	B802001-1	1	121	Senior High	Classroom 121	Y	W4	Concrete	Peach	None	0	N/A	N/A
8020	1	B802001-1	1	123	Senior High	Classroom 123	Y	W1	Concrete	Peach	None	0	N/A	N/A
8020	1	B802001-1	1	123	Senior High	Classroom 123	Y	W2	Concrete	Peach	None	0	N/A	N/A
8020	1	B802001-1	1	123	Senior High	Classroom 123	Y	W3	Concrete	Peach	None	0	N/A	N/A
8020	1	B802001-1	1	123	Senior High	Classroom 123	Y	W4	Concrete	Peach	None	0	N/A	N/A
8020	1	B802001-1	1	125	Senior High	Classroom 125	Y	W1	Concrete	Peach	None	0	0	Negative
8020	1	B802001-1	1	125	Senior High	Classroom 125	Y	W2	Concrete	Peach	None	0	N/A	N/A
8020	1	B802001-1	1	125	Senior High	Classroom 125	Y	W3	Concrete	Peach	None	0	0	Negative
8020	1	B802001-1	1	125	Senior High	Classroom 125	Y	W4	Concrete	Peach	None	0	N/A	N/A
8020	1	B802001-1	1	127	Senior High	Classroom 127	Y	W1	Concrete	Peach	None	0	N/A	N/A
8020	1	B802001-1	1	127	Senior High	Classroom 127	Y	W2	Concrete	Peach	None	0	N/A	N/A
8020	1	B802001-1	1	127	Senior High	Classroom 127	Y	W3	Concrete	Peach	None	0	N/A	N/A
8020	1	B802001-1	1	127	Senior High	Classroom 127	Y	W4	Concrete	Peach	None	0	N/A	N/A
8020	1	B802001-1	1	133	Music	Chorus Room 133	Y	W1	Concrete	Peach	None	0	0	Negative
8020	1	B802001-1	1	133	Music	Chorus Room 133	Y	W2	Concrete	Peach	None	0	0	Negative
8020	1	B802001-1	1	133	Music	Chorus Room 133	Y	W3	Concrete	Peach	Cracking		0	Negative
8020	1	B802001-1	1	133	Music	Chorus Room 133	Y	W4	Concrete	Peach	Chipping		0	Negative
8020	1	B802001-1	1	H13	Circulation (Hallway)	Hallway from Chorus Room 133 to Classroom 131	Y	W1	Concrete	Blue	Chipping		0.03	Negative

ULCS#	Element	ID	Floor	Space #	Space Type	On-Site Room Name	Teacher	Component	Substrate Material	Color	Description of Damage	(sf)	(mg/cm2)	(positive/ negative)
8020	1	B802001-1	1	H13	Circulation (Hallway)	Hallway from Chorus Room 133 to Classroom 131	Y	W2	Concrete	Blue	Chipping		0.01	Negative
8020	1	B802001-1	1	H13	Circulation (Hallway)	Hallway from Chorus Room 133 to Classroom 131	Y	W3	Concrete	Blue	Chipping		0.02	Negative
8020	1	B802001-1	1	H13	Circulation (Hallway)	Hallway from Chorus Room 133 to Classroom 131	Y	W4	Concrete	Blue	Chipping		0	Negative
8020	1	B802001-1	1	137	Senior High	Classroom 137	Y	W1	Concrete	Peach	None	0	0	Negative
8020	1	B802001-1	1	137	Senior High	Classroom 137	Y	W2	Concrete	Peach	None	0	N/A	N/A
8020	1	B802001-1	1	137	Senior High	Classroom 137	Y	W3	Concrete	Peach	Chipping		0	Negative
8020	1	B802001-1	1	137	Senior High	Classroom 137	Y	W4	Concrete	Peach	None	0	N/A	N/A
8020	1	B802001-1	1	141	Storage	Classroom 141	Y	W1	Concrete	Tan	None	0	0	Negative
8020	1	B802001-1	1	141	Storage	Classroom 141	Y	W2	Concrete	Tan	None	0	N/A	N/A
8020	1	B802001-1	1	141	Storage	Classroom 141	Y	W3	Concrete	Tan	Chipping		0	Negative
8020	1	B802001-1	1	141	Storage	Classroom 141	Y	W4	Concrete	Tan	None	0	N/A	N/A
8020	1	B802001-1	1	141C	Administrative Office	Nurse's Office 145	Y	W1	Concrete	Peach	None	0	N/A	N/A
8020	1	B802001-1	1	141C	Administrative Office	Nurse's Office 145	Y	W2	Concrete	Peach	None	0	N/A	N/A
8020	1	B802001-1	1	141C	Administrative Office	Nurse's Office 145	Y	W3	Concrete	Peach	None	0	N/A	N/A
8020	1	B802001-1	1	141C	Administrative Office	Nurse's Office 145	Y	W4	Concrete	Peach	None	0	N/A	N/A
8020	1	B802001-1	1	141G	Circulation (Hallway)	Hallway from Nurse's Office to Copy Room	Y	W1	Concrete	Beige & White	Cracking		0	Negative
8020	1	B802001-1	1	141G	Circulation (Hallway)	Hallway from Nurse's Office to Copy Room	Y	W2	Concrete	Beige & White	Chipping		0	Negative
8020	1	B802001-1	1	141G	Circulation (Hallway)	Hallway from Nurse's Office to Copy Room	Y	W3	Concrete	Beige & White	Cracking		0	Negative
8020	1	B802001-1	1	141G	Circulation (Hallway)	Hallway from Nurse's Office to Copy Room	Y	W4	Concrete	Beige & White	Chipping		0	Negative
8020	1	B802001-1	1	141H	Circulation (Hallway)	Hallway from Nurse's Office to Speech and Hearing Room	Y	W1	Concrete	Beige & White	Cracking		0	Negative
8020	1	B802001-1	1	141H	Circulation (Hallway)	Hallway from Nurse's Office to Speech and Hearing Room	Y	W2	Concrete	Beige & White	Chipping		0	Negative
8020	1	B802001-1	1	141H	Circulation (Hallway)	Hallway from Nurse's Office to Speech and Hearing Room	Y	W3	Concrete	Beige & White	Cracking		0	Negative
8020	1	B802001-1	1	141H	Circulation (Hallway)	Hallway from Nurse's Office to Speech and Hearing Room	Y	W4	Concrete	Beige & White	Chipping		0	Negative
8020	1	B802001-1	1	H12	Circulation (Hallway)	Hallway from Classroom 137 to Main Office	Y	W1	Concrete	Beige & White	Cracking		0	Negative
8020	1	B802001-1	1	H12	Circulation (Hallway)	Hallway from Classroom 137 to Main Office	Y	W2	Concrete	Beige & White	Chipping		0	Negative
8020	1	B802001-1	1	H12	Circulation (Hallway)	Hallway from Classroom 137 to Main Office	Y	W3	Concrete	Beige & White	Cracking		0	Negative
8020	1	B802001-1	1	H12	Circulation (Hallway)	Hallway from Classroom 137 to Main Office	Y	W4	Concrete	Beige & White	Chipping		0	Negative
8020	1	B802001-1	1	143	Administrative Office	Alumni Office 143	Y	W1	Concrete	Tan	None	0	0	Negative
8020	1	B802001-1	1	143	Administrative Office	Alumni Office 143	Y	W2	Concrete	Tan	None	0	0	Negative
8020	1	B802001-1	1	143	Administrative Office	Alumni Office 143	Y	W3	Concrete	Tan	None	0	0	Negative
8020	1	B802001-1	1	143	Administrative Office	Alumni Office 143	Y	W4	Concrete	Tan	None	0	0	Negative
8020	1	B802001-1	1	147	Auditorium	Auditorium Stage	Y	W1	Concrete	Beige	None	0	0	Negative
8020	1	B802001-1	1	147	Auditorium	Auditorium Stage	Y	W2	Concrete	Beige	None	0	0	Negative
8020	1	B802001-1	1	147	Auditorium	Auditorium Stage	Y	W3	Concrete	Beige	None	0	0	Negative
8020	1	B802001-1	1	147	Auditorium	Auditorium Stage	Y	W4	Concrete	Beige	None	0	0	Negative
8020	1	B802001-1	1	147B	Circulation (Hallway)	Auditorium Stage Hallway	Y	W1	Concrete	Blue	Cracking		0.03	Negative
8020	1	B802001-1	1	147B	Circulation (Hallway)	Auditorium Stage Hallway	Y	W2	Concrete	Blue	Cracking		0.01	Negative
8020	1	B802001-1	1	147B	Circulation (Hallway)	Auditorium Stage Hallway	Y	W3	Concrete	Blue	Cracking		0.02	Negative
8020	1	B802001-1	1	147B	Circulation (Hallway)	Auditorium Stage Hallway	Y	W4	Concrete	Blue	Cracking		0	Negative
8020	1	B802001-1	2	219B	Senior High	Classroom 219B	Y	W1	Concrete	Peach & White	None	0	N/A	N/A
8020	1	B802001-1	2	219B	Senior High	Classroom 219B	Y	W2	Concrete	Peach & White	None	0	N/A	N/A
8020	1	B802001-1	2	219B	Senior High	Classroom 219B	Y	W3	Concrete	Peach & White	None	0	N/A	N/A
8020	1	B802001-1	2	219B	Senior High	Classroom 219B	Y	W4	Concrete	Peach & White	None	0	N/A	N/A
8020	1	B802001-1	2	219A	Senior High	Classroom 219A	Y	W1	Concrete	Peach & White	None	0	0	Negative
8020	1	B802001-1	2	219A	Senior High	Classroom 219A	Y	W2	Concrete	Peach & White	None	0	N/A	N/A
8020	1	B802001-1	2	219A	Senior High	Classroom 219A	Y	W3	Concrete	Peach & White	None	0	0	Negative
8020	1	B802001-1	2	219A	Senior High	Classroom 219A	Y	W4	Concrete	Peach & White	None	0	N/A	N/A
8020	1	B802001-1	2	221A	Senior High	Classroom 221A	Y	W1	Concrete	Peach & White	None	0	N/A	N/A
8020	1	B802001-1	2	221A	Senior High	Classroom 221A	Y	W2	Concrete	Peach & White	None	0	N/A	N/A
8020	1	B802001-1	2	221A	Senior High	Classroom 221A	Y	W3	Concrete	Peach & White	None	0	N/A	N/A
8020	1	B802001-1	2	221A	Senior High	Classroom 221A	Y	W4	Concrete	Peach & White	None	0	N/A	N/A
8020	1	B802001-1	2	221B	Senior High	Classroom 221B	Y	W1	Concrete	Peach & White	None	0	N/A	N/A
8020	1	B802001-1	2	221B	Senior High	Classroom 221B	Y	W2	Concrete	Peach & White	None	0	N/A	N/A
8020	1	B802001-1	2	221B	Senior High	Classroom 221B	Y	W3	Concrete	Peach & White	None	0	N/A	N/A
8020	1	B802001-1	2	221B	Senior High	Classroom 221B	Y	W4	Concrete	Peach & White	None	0	N/A	N/A
8020	1	B802001-1	2	223C	Senior High	Classroom 223C	Y	W1	Concrete	Peach & White	None	0	0	Negative
8020	1	B802001-1	2	223C	Senior High	Classroom 223C	Y	W2	Concrete	Peach & White	None	0	N/A	N/A
8020	1	B802001-1	2	223C	Senior High	Classroom 223C	Y	W3	Concrete	Peach & White	None	0	0	Negative
8020	1	B802001-1	2	223C	Senior High	Classroom 223C	Y	W4	Concrete	Peach & White	None	0	N/A	N/A
8020	1	B802001-1	2	223A	Senior High	Classroom 223A	Y	W1	Concrete	Peach & White	None	0	0	Negative
8020	1	B802001-1	2	223A	Senior High	Classroom 223A	Y	W2	Concrete	Peach & White	None	0	N/A	N/A
8020	1	B802001-1	2	223A	Senior High	Classroom 223A	Y	W3	Concrete	Peach & White	None	0	0	Negative
8020	1	B802001-1	2	223A	Senior High	Classroom 223A	Y	W4	Concrete	Peach & White	None	0	N/A	N/A
8020	1	B802001-1	2	227A	Senior High	Classroom 227A	Y	W1	Concrete	Peach & White	None	0	N/A	N/A
8020	1	B802001-1	2	227A	Senior High	Classroom 227A	Y	W2	Concrete	Peach & White	None	0	N/A	N/A
8020	1	B802001-1	2	227A	Senior High	Classroom 227A	Y	W3	Concrete	Peach & White	None	0	N/A	N/A
8020	1	B802001-1	2	227A	Senior High	Classroom 227A	Y	W4	Concrete	Peach & White	None	0	N/A	N/A
8020	1	B802001-1	2	227B	Senior High	Classroom 227B	Y	W1	Concrete	Peach & White	None	0	N/A	N/A
8020	1	B802001-1	2	227B	Senior High	Classroom 227B	Y	W2	Concrete	Peach & White	None	0	N/A	N/A
8020	1	B802001-1	2	227B	Senior High	Classroom 227B	Y	W3	Concrete	Peach & White	Cracking	1		
8020	1	B802001-1	2	227B	Senior High	Classroom 227B	Y	W4	Concrete	Peach & White	None	0	N/A	N/A
8020	1	B802001-1	2	H27B	Circulation (Hallway)	Second Floor Hallway from Stairwell J to Stairwell K	Y	W1	Concrete	White	None	0	0.1	Negative

ULCS#	Element	ID	Floor	Space #	Space Type	On-Site Room Name	Teacher	Component	Substrate Material	Color	Description of Damage	(sf)	(mg/cm2)	(positive/ negative)
8020	1	B802001-1	2	H27B	Circulation (Hallway)	Second Floor Hallway from Stairwell J to Stairwell K	Y	W2	Concrete	White	None	0	0	Negative
8020	1	B802001-1	2	H27B	Circulation (Hallway)	Second Floor Hallway from Stairwell J to Stairwell K	Y	W3	Concrete	White	None	0	0.01	Negative
8020	1	B802001-1	2	H27B	Circulation (Hallway)	Second Floor Hallway from Stairwell J to Stairwell K	Y	W4	Concrete	White	None	0	0.02	Negative
8020	1	B802001-1	2	H27A	Circulation (Hallway)	Second Floor Hallway from Stairwell K to Classroom 227A	Y	W1	Concrete	White	None	0	0	Negative
8020	1	B802001-1	2	H27A	Circulation (Hallway)	Second Floor Hallway from Stairwell K to Classroom 227A	Y	W2	Concrete	White	None	0	0	Negative
8020	1	B802001-1	2	H27A	Circulation (Hallway)	Second Floor Hallway from Stairwell K to Classroom 227A	Y	W3	Concrete	White	None	0	0.01	Negative
8020	1	B802001-1	2	H27A	Circulation (Hallway)	Second Floor Hallway from Stairwell K to Classroom 227A	Y	W4	Concrete	White	None	0	0	Negative
8020	1	B802001-1	2	229C	Senior High	Classroom 229C	Y	W1	Concrete	Peach & White	None	0	0	Negative
8020	1	B802001-1	2	229C	Senior High	Classroom 229C	Y	W2	Concrete	Peach & White	None	0	N/A	N/A
8020	1	B802001-1	2	229C	Senior High	Classroom 229C	Y	W3	Concrete	Peach & White	None	0	0	Negative
8020	1	B802001-1	2	229C	Senior High	Classroom 229C	Y	W4	Concrete	Peach & White	None	0	N/A	N/A
8020	1	B802001-1	2	229B	Senior High	Classroom 229B	Y	W1	Concrete	Peach & White	None	0	0	Negative
8020	1	B802001-1	2	229B	Senior High	Classroom 229B	Y	W2	Concrete	Peach & White	None	0	N/A	N/A
8020	1	B802001-1	2	229B	Senior High	Classroom 229B	Y	W3	Concrete	Peach & White	None	0	0	Negative
8020	1	B802001-1	2	229B	Senior High	Classroom 229B	Y	W4	Concrete	Peach & White	None	0	N/A	N/A
8020	1	B802001-1	2	231	Senior High	Classroom 231	Y	W1	Concrete	Peach & White	None	0	N/A	N/A
8020	1	B802001-1	2	231	Senior High	Classroom 231	Y	W2	Concrete	Peach & White	None	0	N/A	N/A
8020	1	B802001-1	2	231	Senior High	Classroom 231	Y	W3	Concrete	Peach & White	None	0	N/A	N/A
8020	1	B802001-1	2	231	Senior High	Classroom 231	Y	W4	Concrete	Peach & White	None	0	N/A	N/A
8020	1	B802001-1	2	233	Senior High	Classroom 233	Y	W1	Concrete	Peach & White	None	0	N/A	N/A
8020	1	B802001-1	2	233	Senior High	Classroom 233	Y	W2	Concrete	Peach & White	None	0	N/A	N/A
8020	1	B802001-1	2	233	Senior High	Classroom 233	Y	W3	Concrete	Peach & White	None	0	N/A	N/A
8020	1	B802001-1	2	233	Senior High	Classroom 233	Y	W4	Concrete	Peach & White	None	0	N/A	N/A
8020	1	B802001-1	2	235	Senior High	Classroom 235	Y	W1	Concrete	Peach & White	None	0	0	Negative
8020	1	B802001-1	2	235	Senior High	Classroom 235	Y	W2	Concrete	Peach & White	None	0	N/A	N/A
8020	1	B802001-1	2	235	Senior High	Classroom 235	Y	W3	Concrete	Peach & White	None	0	0	Negative
8020	1	B802001-1	2	235	Senior High	Classroom 235	Y	W4	Concrete	Peach & White	None	0	N/A	N/A
8020	1	B802001-1	2	H27A	Circulation (Hallway)	Second Floor Hallway Classroom 227A to Teacher's Lounge	Y	W1	Concrete	White	None	0	N/A	N/A
8020	1	B802001-1	2	H27A	Circulation (Hallway)	Second Floor Hallway Classroom 227A to Teacher's Lounge	Y	W2	Concrete	White	None	0	N/A	N/A
8020	1	B802001-1	2	H27A	Circulation (Hallway)	Second Floor Hallway Classroom 227A to Teacher's Lounge	Y	W3	Concrete	White	None	0	N/A	N/A
8020	1	B802001-1	2	H27A	Circulation (Hallway)	Second Floor Hallway Classroom 227A to Teacher's Lounge	Y	W4	Concrete	White	None	0	N/A	N/A
8020	1	B802001-1	2	214	Senior High	Classroom 214	Y	W1	Concrete	Peach & White	None	0	N/A	N/A
8020	1	B802001-1	2	214	Senior High	Classroom 214	Y	W2	Concrete	Peach & White	None	0	N/A	N/A
8020	1	B802001-1	2	214	Senior High	Classroom 214	Y	W3	Concrete	Peach & White	None	0	N/A	N/A
8020	1	B802001-1	2	214	Senior High	Classroom 214	Y	W4	Concrete	Peach & White	None	0	N/A	N/A
8020	1	B802001-1	2	H29	Circulation (Hallway)	Second Floor Hallway from Stairwell C to Classroom 214	Y	W1	Concrete	White	None	0	0.01	Negative
8020	1	B802001-1	2	H29	Circulation (Hallway)	Second Floor Hallway from Stairwell C to Classroom 214	Y	W2	Concrete	White	None	0	0.05	Negative
8020	1	B802001-1	2	H29	Circulation (Hallway)	Second Floor Hallway from Stairwell C to Classroom 214	Y	W3	Concrete	White	None	0	0.04	Negative
8020	1	B802001-1	2	H29	Circulation (Hallway)	Second Floor Hallway from Stairwell C to Classroom 214	Y	W4	Concrete	White	None	0	0.02	Negative
8020	1	B802001-1	2	216	Senior High	Classroom 216	Y	W1	Concrete	Peach & White	None	0	0	Negative
8020	1	B802001-1	2	216	Senior High	Classroom 216	Y	W2	Concrete	Peach & White	None	0	N/A	N/A
8020	1	B802001-1	2	216	Senior High	Classroom 216	Y	W3	Concrete	Peach & White	None	0	0	Negative
8020	1	B802001-1	2	216	Senior High	Classroom 216	Y	W4	Concrete	Peach & White	None	0	N/A	N/A
8020	1	B802001-1	2	218	Senior High	Classroom 218	Y	W1	Concrete	Peach & White	None	0	0	Negative
8020	1	B802001-1	2	218	Senior High	Classroom 218	Y	W2	Concrete	Peach & White	None	0	N/A	N/A
8020	1	B802001-1	2	218	Senior High	Classroom 218	Y	W3	Concrete	Peach & White	None	0	0	Negative
8020	1	B802001-1	2	218	Senior High	Classroom 218	Y	W4	Concrete	Peach & White	None	0	N/A	N/A
8020	1	B802001-1	2	220	Senior High	Classroom 220	Y	W1	Concrete	Peach & White	None	0	N/A	N/A
8020	1	B802001-1	2	220	Senior High	Classroom 220	Y	W2	Concrete	Peach & White	None	0	N/A	N/A
8020	1	B802001-1	2	220	Senior High	Classroom 220	Y	W3	Concrete	Peach & White	None	0	N/A	N/A
8020	1	B802001-1	2	220	Senior High	Classroom 220	Y	W4	Concrete	Peach & White	None	0	N/A	N/A
8020	1	B802001-1	2	222	Senior High	Classroom 222	Y	W1	Concrete	Peach & White	None	0	N/A	N/A
8020	1	B802001-1	2	222	Senior High	Classroom 222	Y	W2	Concrete	Peach & White	None	0	N/A	N/A
8020	1	B802001-1	2	222	Senior High	Classroom 222	Y	W3	Concrete	Peach & White	None	0	N/A	N/A
8020	1	B802001-1	2	222	Senior High	Classroom 222	Y	W4	Concrete	Peach & White	None	0	N/A	N/A
8020	1	B802001-1	2	226	IMC (Library)	Library	Y	W1	Concrete	Peach & White	None	0	0	Negative
8020	1	B802001-1	2	226	IMC (Library)	Library	Y	W2	Concrete	Peach & White	None	0	0	Negative
8020	1	B802001-1	2	226	IMC (Library)	Library	Y	W3	Concrete	Peach & White	None	0	0	Negative
8020	1	B802001-1	2	226	IMC (Library)	Library	Y	W4	Concrete	Peach & White	None	0	0	Negative
8020	1	B802001-1	2	H26	Circulation (Hallway)	Second Floor Hallway from Stairwell B to Library	Y	W1	Concrete	White	None	0	0	Negative
8020	1	B802001-1	2	H26	Circulation (Hallway)	Second Floor Hallway from Stairwell B to Library	Y	W2	Concrete	White	None	0	1	Positive
8020	1	B802001-1	2	H26	Circulation (Hallway)	Second Floor Hallway from Stairwell B to Library	Y	W3	Concrete	White	None	0	1	Positive
8020	1	B802001-1	2	H26	Circulation (Hallway)	Second Floor Hallway from Stairwell B to Library	Y	W4	Concrete	White	None	0	0	Negative
8020	1	B802001-1	2	H28	Circulation (Hallway)	Second Floor Hallway from Stairwell C to Library	Y	W1	Concrete	White	None	0	0.02	Negative
8020	1	B802001-1	2	H28	Circulation (Hallway)	Second Floor Hallway from Stairwell C to Library	Y	W2	Concrete	White	None	0	0.02	Negative
8020	1	B802001-1	2	H28	Circulation (Hallway)	Second Floor Hallway from Stairwell C to Library	Y	W3	Concrete	White	None	0	0	Negative
8020	1	B802001-1	2	H28	Circulation (Hallway)	Second Floor Hallway from Stairwell C to Library	Y	W4	Concrete	White	None	0	0	Negative
8020	1	B802001-1	2	228	Senior High	Classroom 228	Y	W1	Concrete	Peach & White	None	0	0	Negative
8020	1	B802001-1	2	228	Senior High	Classroom 228	Y	W2	Concrete	Peach & White	None	0	N/A	N/A
8020	1	B802001-1	2	228	Senior High	Classroom 228	Y	W3	Concrete	Peach & White	None	0	0	Negative
8020	1	B802001-1	2	228	Senior High	Classroom 228	Y	W4	Concrete	Peach & White	None	0	N/A	N/A
8020	1	B802001-1	2	230	Senior High	Classroom 230	Y	W1	Concrete	Peach & White	None	0	N/A	N/A

ULCS#	Element	ID	Floor	Space #	Space Type	On-Site Room Name	Teacher	Component	Substrate Material	Color	Description of Damage	(sf)	(mg/cm2)	(positive/ negative)
8020	1	B802001-1	2	230	Senior High	Classroom 230	Y	W2	Concrete	Peach & White	None	0	N/A	N/A
8020	1	B802001-1	2	230	Senior High	Classroom 230	Y	W3	Concrete	Peach & White	None	0	N/A	N/A
8020	1	B802001-1	2	230	Senior High	Classroom 230	Y	W4	Concrete	Peach & White	None	0	N/A	N/A
8020	1	B802001-1	2	232	Senior High	Classroom 232	Y	W1	Concrete	Peach & White	None	0	N/A	N/A
8020	1	B802001-1	2	232	Senior High	Classroom 232	Y	W2	Concrete	Peach & White	None	0	N/A	N/A
8020	1	B802001-1	2	232	Senior High	Classroom 232	Y	W3	Concrete	Peach & White	None	0	N/A	N/A
8020	1	B802001-1	2	232	Senior High	Classroom 232	Y	W4	Concrete	Peach & White	None	0	N/A	N/A
8020	1	B802001-1	2	236	Senior High	Classroom 236	Y	W1	Concrete	Peach & White	None	0	N/A	N/A
8020	1	B802001-1	2	236	Senior High	Classroom 236	Y	W2	Concrete	Peach & White	None	0	N/A	N/A
8020	1	B802001-1	2	236	Senior High	Classroom 236	Y	W3	Concrete	Peach & White	None	0	N/A	N/A
8020	1	B802001-1	2	236	Senior High	Classroom 236	Y	W4	Concrete	Peach & White	None	0	N/A	N/A
8020	1	B802001-1	2	H27C	Circulation (Hallway)	Second Floor Hallway from Stairwell B to Classroom 236	Y	W1	Concrete	White	None	0	0	Negative
8020	1	B802001-1	2	H27C	Circulation (Hallway)	Second Floor Hallway from Stairwell B to Classroom 236	Y	W2	Concrete	White	None	0	0.01	Negative
8020	1	B802001-1	2	H27C	Circulation (Hallway)	Second Floor Hallway from Stairwell B to Classroom 236	Y	W3	Concrete	White	None	0	1	Positive
8020	1	B802001-1	2	H27C	Circulation (Hallway)	Second Floor Hallway from Stairwell B to Classroom 236	Y	W4	Concrete	White	None	0	0	Negative
8020	1	B802001-1	2	234	Senior High	Classroom 234	Y	W1	Concrete	Peach & White	None	0	0	Negative
8020	1	B802001-1	2	234	Senior High	Classroom 234	Y	W2	Concrete	Peach & White	None	0	N/A	N/A
8020	1	B802001-1	2	234	Senior High	Classroom 234	Y	W3	Concrete	Peach & White	None	0	0	Negative
8020	1	B802001-1	2	234	Senior High	Classroom 234	Y	W4	Concrete	Peach & White	None	0	N/A	N/A
8020	1	B802001-1	2	238	Senior High	Classroom 238	Y	W1	Concrete	Peach & White	None	0	N/A	N/A
8020	1	B802001-1	2	238	Senior High	Classroom 238	Y	W2	Concrete	Peach & White	None	0	N/A	N/A
8020	1	B802001-1	2	238	Senior High	Classroom 238	Y	W3	Concrete	Peach & White	None	0	N/A	N/A
8020	1	B802001-1	2	238	Senior High	Classroom 238	Y	W4	Concrete	Peach & White	None	0	N/A	N/A
8020	1	B802001-1	2	240	Senior High	Classroom 240	Y	W1	Concrete	Peach & White	None	0	0	Negative
8020	1	B802001-1	2	240	Senior High	Classroom 240	Y	W2	Concrete	Peach & White	None	0	N/A	N/A
8020	1	B802001-1	2	240	Senior High	Classroom 240	Y	W3	Concrete	Peach & White	None	0	0	Negative
8020	1	B802001-1	2	240	Senior High	Classroom 240	Y	W4	Concrete	Peach & White	None	0	N/A	N/A
8020	1	B802001-1	2	H27	Circulation (Hallway)	Second Floor Hallway from Classroom 240 to Middle Hallway	Y	W1	Concrete	Grey/Cream and White				
8020	1	B802001-1	2	H27	Circulation (Hallway)	Second Floor Hallway from Classroom 240 to Middle Hallway	Y	W2	Concrete	Grey/Cream and White				
8020	1	B802001-1	2	H27	Circulation (Hallway)	Second Floor Hallway from Classroom 240 to Middle Hallway	Y	W3	Concrete	Grey/Cream and White				
8020	1	B802001-1	2	H27	Circulation (Hallway)	Second Floor Hallway from Classroom 240 to Middle Hallway	Y	W4	Concrete	Grey/Cream and White				
8020	1	B802001-1	2	242	Senior High	Classroom 242	Y	W1	Concrete	Peach & White	None	0	N/A	N/A
8020	1	B802001-1	2	242	Senior High	Classroom 242	Y	W2	Concrete	Peach & White	None	0	N/A	N/A
8020	1	B802001-1	2	242	Senior High	Classroom 242	Y	W3	Concrete	Peach & White	None	0	N/A	N/A
8020	1	B802001-1	2	242	Senior High	Classroom 242	Y	W4	Concrete	Peach & White	None	0	N/A	N/A
8020	1	B802001-1	2	244	Senior High	Classroom 244	Y	W1	Concrete	Peach & White	None	0	N/A	N/A
8020	1	B802001-1	2	244	Senior High	Classroom 244	Y	W2	Concrete	Peach & White	None	0	N/A	N/A
8020	1	B802001-1	2	244	Senior High	Classroom 244	Y	W3	Concrete	Peach & White	None	0	N/A	N/A
8020	1	B802001-1	2	244	Senior High	Classroom 244	Y	W4	Concrete	Peach & White	None	0	N/A	N/A
8020	1	B802001-1	2	246B	Restrooms, Staff - Male	Men's Bathroom within Faculty area across from Classroom 201	Y	W1	Concrete	Beige/Tan	None	0	0	Negative
8020	1	B802001-1	2	246B	Restrooms, Staff - Male	Men's Bathroom within Faculty area across from Classroom 201	Y	W2	Concrete	Beige/Tan	None	0	N/A	N/A
8020	1	B802001-1	2	246B	Restrooms, Staff - Male	Men's Bathroom within Faculty area across from Classroom 201	Y	W3	Concrete	Beige/Tan	None	0	0	Negative
8020	1	B802001-1	2	246B	Restrooms, Staff - Male	Men's Bathroom within Faculty area across from Classroom 201	Y	W4	Concrete	Beige/Tan	None	0	0	Negative
8020	1	B802001-1	2	201C	(4-12)	Boy's Restroom adjacent to Classroom 200	Y	W1	Concrete	Beige & White	Cracking	1	1.11	Positive
8020	1	B802001-1	2	201C	(4-12)	Boy's Restroom adjacent to Classroom 200	Y	W2	Concrete	Beige & White	Cracking	1	1.21	Positive
8020	1	B802001-1	2	201C	(4-12)	Boy's Restroom adjacent to Classroom 200	Y	W3	Concrete	Beige & White	None	0	1.04	Positive
8020	1	B802001-1	2	201C	(4-12)	Boy's Restroom adjacent to Classroom 200	Y	W4	Concrete	Beige & White	None	0	N/A	N/A
8020	1	B802001-1	2	201	Senior High	Classroom 201	Y	W1	Concrete	w/Green	Chipping	10	0	Negative
8020	1	B802001-1	2	201	Senior High	Classroom 201	Y	W2	Concrete	w/Green	Chipping	10	0	Negative
8020	1	B802001-1	2	201	Senior High	Classroom 201	Y	W3	Concrete	w/Green	None	0	N/A	N/A
8020	1	B802001-1	2	201	Senior High	Classroom 201	Y	W4	Concrete	w/Green	None	0	N/A	N/A
8020	1	B802001-1	2	203	Senior High	Classroom 203	Y	W1	Concrete	Peach & White	None	0	N/A	N/A
8020	1	B802001-1	2	203	Senior High	Classroom 203	Y	W2	Concrete	Peach & White	None	0	N/A	N/A
8020	1	B802001-1	2	203	Senior High	Classroom 203	Y	W3	Concrete	Peach & White	None	0	N/A	N/A
8020	1	B802001-1	2	203	Senior High	Classroom 203	Y	W4	Concrete	Peach & White	None	0	N/A	N/A
8020	1	B802001-1	2	203A	Senior High	Classroom 203A	Y	W1	Concrete	Peach & White	None	0	N/A	N/A
8020	1	B802001-1	2	203A	Senior High	Classroom 203A	Y	W2	Concrete	Peach & White	None	0	N/A	N/A
8020	1	B802001-1	2	203A	Senior High	Classroom 203A	Y	W3	Concrete	Peach & White	None	0	N/A	N/A
8020	1	B802001-1	2	203A	Senior High	Classroom 203A	Y	W4	Concrete	Peach & White	None	0	N/A	N/A
8020	1	B802001-1	2	200	Senior High	Classroom 200	Y	W1	Concrete	Peach & White	None	0	N/A	N/A
8020	1	B802001-1	2	200	Senior High	Classroom 200	Y	W2	Concrete	Peach & White	None	0	N/A	N/A
8020	1	B802001-1	2	200	Senior High	Classroom 200	Y	W3	Concrete	Peach & White	None	0	N/A	N/A
8020	1	B802001-1	2	200	Senior High	Classroom 200	Y	W4	Concrete	Peach & White	None	0	N/A	N/A
8020	1	B802001-1	2	202	Senior High	Classroom 202	Y	W1	Concrete	Peach & White	None	0	0	Negative
8020	1	B802001-1	2	202	Senior High	Classroom 202	Y	W2	Concrete	Peach & White	None	0	N/A	N/A
8020	1	B802001-1	2	202	Senior High	Classroom 202	Y	W3	Concrete	Peach & White	None	0	0	Negative
8020	1	B802001-1	2	202	Senior High	Classroom 202	Y	W4	Concrete	Peach & White	None	0	N/A	N/A
8020	1	B802001-1	2	205	Senior High	Classroom 205	Y	W1	Concrete	Peach & White	None	0	N/A	N/A
8020	1	B802001-1	2	205	Senior High	Classroom 205	Y	W2	Concrete	Peach & White	None	0	N/A	N/A
8020	1	B802001-1	2	205	Senior High	Classroom 205	Y	W3	Concrete	Peach & White	None	0	N/A	N/A
8020	1	B802001-1	2	205	Senior High	Classroom 205	Y	W4	Concrete	Peach & White	None	0	N/A	N/A
8020	1	B802001-1	2	204	Senior High	Classroom 204	Y	W1	Concrete	Peach & White	None	0	0	Negative

ULCS#	Element	ID	Floor	Space #	Space Type	On-Site Room Name	Teacher	Component	Substrate Material	Color	Description of Damage	(sf)	(mg/cm2)	(positive/ negative)
8020	1	B802001-1	2	204	Senior High	Classroom 204	Y	W2	Concrete	Peach & White	None	0	N/A	N/A
8020	1	B802001-1	2	204	Senior High	Classroom 204	Y	W3	Concrete	Peach & White	None	0	0	Negative
8020	1	B802001-1	2	204	Senior High	Classroom 204	Y	W4	Concrete	Peach & White	None	0	N/A	N/A
8020	1	B802001-1	2	H25	Circulation (Hallway)	Second Floor Middle Hallway from Classroom 201 to Classroom 205	Y	W1	Concrete	White	None	0	0	Negative
8020	1	B802001-1	2	H25	Circulation (Hallway)	Second Floor Middle Hallway from Classroom 201 to Classroom 205	Y	W2	Concrete	White	None	0	0.03	Negative
8020	1	B802001-1	2	H25	Circulation (Hallway)	Second Floor Middle Hallway from Classroom 201 to Classroom 205	Y	W3	Concrete	White	None	0	0.02	Negative
8020	1	B802001-1	2	H25	Circulation (Hallway)	Second Floor Middle Hallway from Classroom 201 to Classroom 205	Y	W4	Concrete	White	None	0	0.06	Negative
8020	1	B802001-1	2	206	Senior High	Classroom 206	Y	W1	Concrete	Peach & White	None	0	N/A	N/A
8020	1	B802001-1	2	206	Senior High	Classroom 206	Y	W2	Concrete	Peach & White	None	0	N/A	N/A
8020	1	B802001-1	2	206	Senior High	Classroom 206	Y	W3	Concrete	Peach & White	None	0	N/A	N/A
8020	1	B802001-1	2	206	Senior High	Classroom 206	Y	W4	Concrete	Peach & White	None	0	N/A	N/A
8020	1	B802001-1	2	H25	Circulation (Hallway)	Second Floor Hallway from Classroom 210 to Middle Hallway	Y	W1	Concrete	White	None	0	N/A	N/A
8020	1	B802001-1	2	H25	Circulation (Hallway)	Second Floor Hallway from Classroom 210 to Middle Hallway	Y	W2	Concrete	White	None	0	N/A	N/A
8020	1	B802001-1	2	H25	Circulation (Hallway)	Second Floor Hallway from Classroom 210 to Middle Hallway	Y	W3	Concrete	White	None	0	N/A	N/A
8020	1	B802001-1	2	H25	Circulation (Hallway)	Second Floor Hallway from Classroom 210 to Middle Hallway	Y	W4	Concrete	White	None	0	N/A	N/A
8020	1	B802001-1	2	208	Senior High	Classroom 208	Y	W1	Concrete	Peach & White	None	0	N/A	N/A
8020	1	B802001-1	2	208	Senior High	Classroom 208	Y	W2	Concrete	Peach & White	None	0	N/A	N/A
8020	1	B802001-1	2	208	Senior High	Classroom 208	Y	W3	Concrete	Peach & White	None	0	N/A	N/A
8020	1	B802001-1	2	208	Senior High	Classroom 208	Y	W4	Concrete	Peach & White	None	0	N/A	N/A
8020	1	B802001-1	2	210	Senior High	Classroom 210	Y	W1	Concrete	Peach & White	None	0	0	Negative
8020	1	B802001-1	2	210	Senior High	Classroom 210	Y	W2	Concrete	Peach & White	None	0	N/A	N/A
8020	1	B802001-1	2	210	Senior High	Classroom 210	Y	W3	Concrete	Peach & White	None	0	0	Negative
8020	1	B802001-1	2	210	Senior High	Classroom 210	Y	W4	Concrete	Peach & White	None	0	N/A	N/A
8020	1	B802001-1	2	212	Senior High	Classroom 212	Y	W1	Concrete	Peach & White	None	0	N/A	N/A
8020	1	B802001-1	2	212	Senior High	Classroom 212	Y	W2	Concrete	Peach & White	None	0	N/A	N/A
8020	1	B802001-1	2	212	Senior High	Classroom 212	Y	W3	Concrete	Peach & White	None	0	N/A	N/A
8020	1	B802001-1	2	212	Senior High	Classroom 212	Y	W4	Concrete	Peach & White	None	0	N/A	N/A
8020	1	B802001-1	2	211	Senior High	Classroom 211	Y	W1	Concrete	Peach & White	None	0	0	Negative
8020	1	B802001-1	2	211	Senior High	Classroom 211	Y	W2	Concrete	Peach & White	None	0	N/A	N/A
8020	1	B802001-1	2	211	Senior High	Classroom 211	Y	W3	Concrete	Peach & White	None	0	0	Negative
8020	1	B802001-1	2	211	Senior High	Classroom 211	Y	W4	Concrete	Peach & White	None	0	N/A	N/A
8020	1	B802001-1	2	213	Senior High	Classroom 213	Y	W1	Concrete	Peach & White	None	0	0	Negative
8020	1	B802001-1	2	213	Senior High	Classroom 213	Y	W2	Concrete	Peach & White	None	0	N/A	N/A
8020	1	B802001-1	2	213	Senior High	Classroom 213	Y	W3	Concrete	Peach & White	None	0	0	Negative
8020	1	B802001-1	2	213	Senior High	Classroom 213	Y	W4	Concrete	Peach & White	None	0	N/A	N/A
8020	1	B802001-1	2	215B	Administrative Office	Office 215B	Y	W1	Sheetrock	Peach & White	None	0	0	Negative
8020	1	B802001-1	2	215B	Administrative Office	Office 215B	Y	W2	Sheetrock	Peach & White	None	0	N/A	N/A
8020	1	B802001-1	2	215B	Administrative Office	Office 215B	Y	W3	Concrete	Peach & White	None	0	0	Negative
8020	1	B802001-1	2	215B	Administrative Office	Office 215B	Y	W4	Sheetrock	Peach & White	None	0	N/A	N/A
8020	1	B802001-1	2	H215	Circulation (Hallway)	Office 215 Hallway	Y	W1	Concrete	White	None	0	0	Negative
8020	1	B802001-1	2	H215	Circulation (Hallway)	Office 215 Hallway	Y	W2	Sheetrock	White	None	0	0	Negative
8020	1	B802001-1	2	H215	Circulation (Hallway)	Office 215 Hallway	Y	W3	Sheetrock	White	None	0	0	Negative
8020	1	B802001-1	2	H215	Circulation (Hallway)	Office 215 Hallway	Y	W4	Sheetrock	White	None	0	0	Negative
8020	1	B802001-1	2	217	Senior High	Classroom 217	Y	W1	Concrete	Peach & White	None	0	N/A	N/A
8020	1	B802001-1	2	217	Senior High	Classroom 217	Y	W2	Concrete	Peach & White	None	0	N/A	N/A
8020	1	B802001-1	2	217	Senior High	Classroom 217	Y	W3	Concrete	Peach & White	None	0	N/A	N/A
8020	1	B802001-1	2	217	Senior High	Classroom 217	Y	W4	Concrete	Peach & White	None	0	N/A	N/A
8020	1	B802001-1	2	H27C	Circulation (Hallway)	Second Floor Hallway from Stairwell J to Office 215	Y	W1	Concrete	White	None	0	N/A	N/A
8020	1	B802001-1	2	H27C	Circulation (Hallway)	Second Floor Hallway from Stairwell J to Office 215	Y	W2	Concrete	White	None	0	N/A	N/A
8020	1	B802001-1	2	H27C	Circulation (Hallway)	Second Floor Hallway from Stairwell J to Office 215	Y	W3	Concrete	White	None	0	N/A	N/A
8020	1	B802001-1	2	H27C	Circulation (Hallway)	Second Floor Hallway from Stairwell J to Office 215	Y	W4	Concrete	White	None	0	N/A	N/A
8020	1	B802001-1	2	H27	Circulation (Hallway)	Second Floor Hallway from Stairwell J to Stairwell Q	Y	W1	Concrete	White	None	0	0.05	Negative
8020	1	B802001-1	2	H27	Circulation (Hallway)	Second Floor Hallway from Stairwell J to Stairwell Q	Y	W2	Concrete	White	None	0	0.05	Negative
8020	1	B802001-1	2	H27	Circulation (Hallway)	Second Floor Hallway from Stairwell J to Stairwell Q	Y	W3	Concrete	White	None	0	0.03	Negative
8020	1	B802001-1	2	H27	Circulation (Hallway)	Second Floor Hallway from Stairwell J to Stairwell Q	Y	W4	Concrete	White	None	0	0.04	Negative
8020	1	B802001-1	2	209	Senior High	Classroom 209	Y	W1	Concrete	Peach & White	None	0	N/A	N/A
8020	1	B802001-1	2	209	Senior High	Classroom 209	Y	W2	Concrete	Peach & White	None	0	N/A	N/A
8020	1	B802001-1	2	209	Senior High	Classroom 209	Y	W3	Concrete	Peach & White	None	0	N/A	N/A
8020	1	B802001-1	2	209	Senior High	Classroom 209	Y	W4	Concrete	Peach & White	None	0	N/A	N/A
8020	1	B802001-1	2	H211	Circulation (Hallway)	Second Floor Hallway from Storage Room 207A to Classroom 209	Y	W1	Concrete	White	None	0	N/A	N/A
8020	1	B802001-1	2	H211	Circulation (Hallway)	Second Floor Hallway from Storage Room 207A to Classroom 209	Y	W2	Concrete	White	None	0	N/A	N/A
8020	1	B802001-1	2	H211	Circulation (Hallway)	Second Floor Hallway from Storage Room 207A to Classroom 209	Y	W3	Concrete	White	None	0	N/A	N/A
8020	1	B802001-1	2	H211	Circulation (Hallway)	Second Floor Hallway from Storage Room 207A to Classroom 209	Y	W4	Concrete	White	None	0	N/A	N/A
8020	1	B802001-1	2	H213	Circulation (Hallway)	Second Floor Hallway from Storage Room 207A to Classroom 201	Y	W1	Concrete	White	None	0	N/A	N/A
8020	1	B802001-1	2	H213	Circulation (Hallway)	Second Floor Hallway from Storage Room 207A to Classroom 201	Y	W2	Concrete	White	None	0	0	Negative
8020	1	B802001-1	2	H213	Circulation (Hallway)	Second Floor Hallway from Storage Room 207A to Classroom 201	Y	W3	Concrete	White	None	0	N/A	N/A
8020	1	B802001-1	2	H213	Circulation (Hallway)	Second Floor Hallway from Storage Room 207A to Classroom 201	Y	W4	Concrete	White	None	0	N/A	N/A
8020	1	B802001-1	2	207	Senior High	Classroom 207	Y	W1	Concrete	Peach & White	None	0	0	Negative
8020	1	B802001-1	2	207	Senior High	Classroom 207	Y	W2	Concrete	Peach & White	None	0	N/A	N/A
8020	1	B802001-1	2	207	Senior High	Classroom 207	Y	W3	Concrete	Peach & White	None	0	0	Negative
8020	1	B802001-1	2	207	Senior High	Classroom 207	Y	W4	Concrete	Peach & White	None	0	N/A	N/A



City of Philadelphia - Department of Public Health
Air Management Services, 2nd Fl. Asbestos Control Unit
321 University Ave. Philadelphia, PA 19104

Office Use Only

Date Received L&I:

Date Received AMS:

Date Inspected

Inspector No.

Asbestos Inspection Report

1. Name of Building / Property:

North East High School

Address

1601 Cottman Avenue

2. Name of Building / Property Owner:

School District of Philadelphia

Address

440 N. Broad Street

Phone No.

(215) 400-4000

3. Name of Philadelphia Certified Investigator:

Suzanne Shourds

Certification No.

AIC-0624

Contact Information / Email / Phone No.

sshourds@repsg.com/215-729-3220

L&I Commercial Activity No. (Former Business Privilege License No.)

356481

Business Tax ID No.

20-3007762

4. Name of Philadelphia Licensed Laboratory:

EMSL

License No.

ALL-137

Phone No.

800-220-3675

5. Scope of Work: (Insert or attach a complete description of the portion of the subject property inspected and the anticipated work that will result in the disturbance of the identified Asbestos Containing Materials (ACMs) (e.g. demolition, asbestos abatement, and / or renovation activities.)

Renovations related the installation/upgrade of air conditioning units at CMU wall systems at specified areas throughout the school. All accessible areas within the proposed scope of work were inspected. Should any additional suspect ACMs be found during the course of renovation activities, or should the scope of work change, work should immediately stop in that area and REPSG should be contacted for further investigation and/or abatement.

6. ☐ Property has been declared to be in imminent danger (ID) of failure or collapse by the City of Philadelphia Department of Licenses & Inspections. Attached is a copy of the L&I Notice of Violation declaring the property I.D. **Note: INVESTIGATOR MUST BE ON SITE DURING DEMOLITION!

7. (ACMs) identified? ☒ Yes (List Below) ☐ No (explain)

8. Suspected ACM's sampled? ☒ Yes (attached are copies of the laboratory chain of custody and bulk sample results.) ☐ No (Why?)

9. List all identified ACM's located in the planned renovation/demolition areas. Damaged ACM must be listed and then repaired or removed prior to renovation. You (Investigator) must label all ACM that may be left in the work area. (Attached are add'l sheets)

Location	Description	Type (Code 1)	Amount		Condition (Code 2)	Action (Code 3)
			Square	Linear		
SEE ATTACHED						

Code 1

FRI - Friable

NF1 - Non-Friable, Cat. 1

NF2 - Non-Friable, Cat. 2

Code 2

DD - Deteriorated or
Delaminated

ND - Non-Damaged

Code 3

REM - Removal necessary prior to Demo/Reno

NRN - No removal necessary, label ACM

REP - Repair & Label ACM, removal not necessary

10. I hereby certify that the foregoing statements are true and the information contained in this report is true. This certification is made subject to the penalties set forth in 18 PA. C.S. S4904 relating to unsworn falsification to authorities. Furthermore I certify that the inspection, sampling, and labeling requirements of section X of the Asbestos Control Regulation (ACR) have been met. The building owner has been notified of the ACR requirements and given a copy of this report. If the inspection has revealed ACM which will be disturbed by the proposed work or if it has revealed ACM in bad condition, the building owner has been notified to remove or repair the ACM in accordance with the ACR prior to renovation or demolition activity.

11. Signature of Certified Asbestos Investigator:

Date:

5/14/2021

Signature of Building Owner:

Date:

		Northeast High School		School District of Philadelphia						
		1601 Cottman Avenue, Philadelphia, PA 19111		Asbestos Inspection Report (AIR)						
		ULCS# 8020		Project Name: North East High School (ULCS No. 8020)						
		Year Built: 1957		Date: 5/14/2021						
		Prepared By: Suzanne Shourds								
		Certification Number: AIC-0624								
E l e m e n t a r	F l o o r									
		On-Site Room Name	Material Description	Type (Code 1)	Confirmed/Assumed/NAD/Non Suspect ACM	Amount of Material	SF LF EA	Condition (Code 2)	Action (Code 3)	Comments
		1 1 Classroom 150	CMU Block Wall Paint	NF2	Confirmed	1840	SF	ND	REM	
		1 1 Classroom 152A	CMU Block Wall Paint	NF2	Assumed	1840	SF	ND	REM	
		1 1 Classroom 154	CMU Block Wall Paint	NF2	Confirmed	1840	SF	ND	REM	
		1 1 Classroom 156	CMU Block Wall Paint	NF2	Assumed	1840	SF	ND	REM	
		1 1 Classroom 158	CMU Block Wall Paint	NF2	Confirmed	1840	SF	DD	REM	Sporadic, Less than 5 LF of Damage
		1 1 Classroom 160	CMU Block Wall Paint	NF2	Confirmed	1840	SF	DD	REM	Sporadic, Less than 10LF of Damage
		1 1 Classroom 160	CMU Block Wall Paint	NF2	Confirmed	1840	SF	DD	REM	
		1 2 Classroom 201	CMU Block Wall Paint	NF2	Confirmed	950	SF	ND	REM	